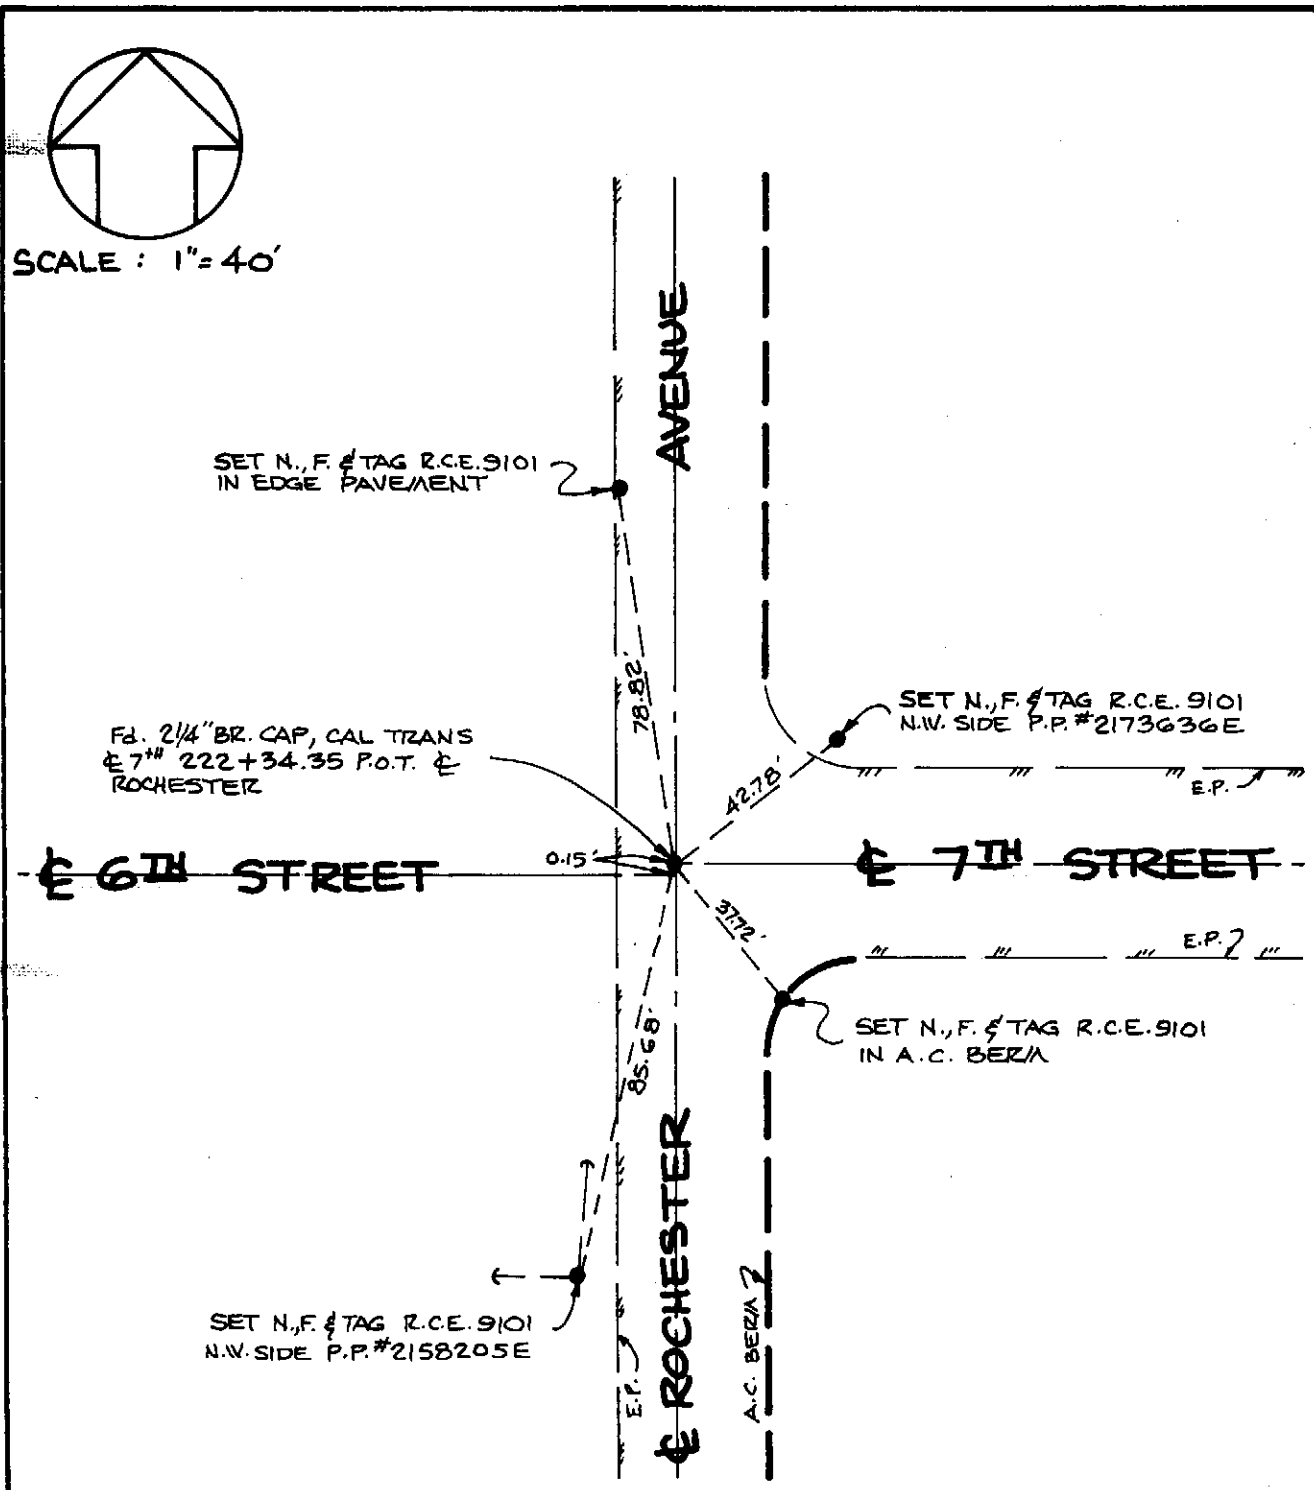

CITY OF RANCHO CUCAMONGA — STREET TIE	ASSESSMENT DISTRICT 82-1
LOCKWOOD ENGINEERING & SURVEYING COMPANY, INC. 380 W. FOOTHILL BLVD. RIALTO, CALIFORNIA	7TH STREET AT ROCHESTER AVENUE
CARLETON W. LOCKWOOD	FIELD REVIEW _____ DATE _____
R.C.E. NO. 9101, DATE 3-15-82	TIE BOOK 6 PAGE 1

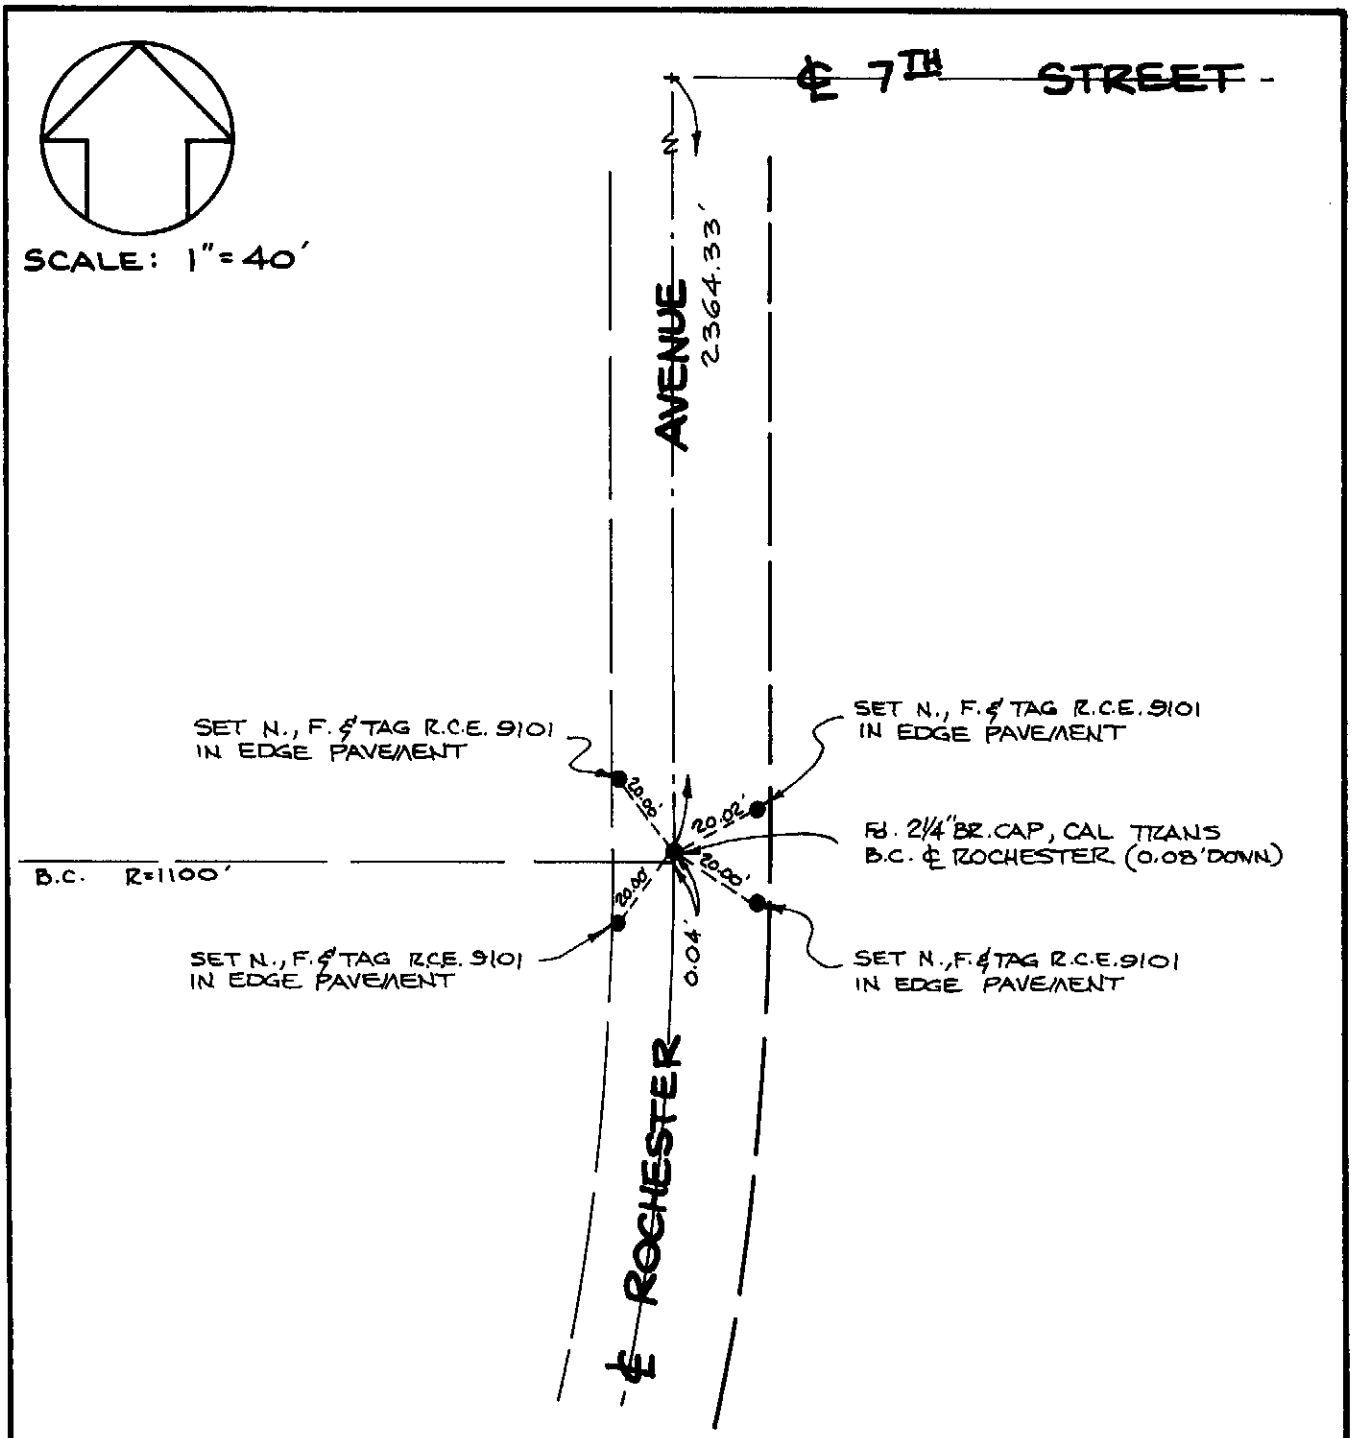

CITY OF RANCHO CUCAMONGA — STREET TIE	ASSESSMENT DISTRICT 82-1
LOCKWOOD ENGINEERING & SURVEYING COMPANY, INC. 380 W. FOOTHILL BLVD. RIALTO, CALIFORNIA	CURVE B.C. AT ROCHESTER AVENUE
CARLETON W. LOCKWOOD	FIELD REVIEW _____ DATE _____
R.C.E. NO. 9101, DATE 3-15-82	TIE BOOK 6 PAGE 3

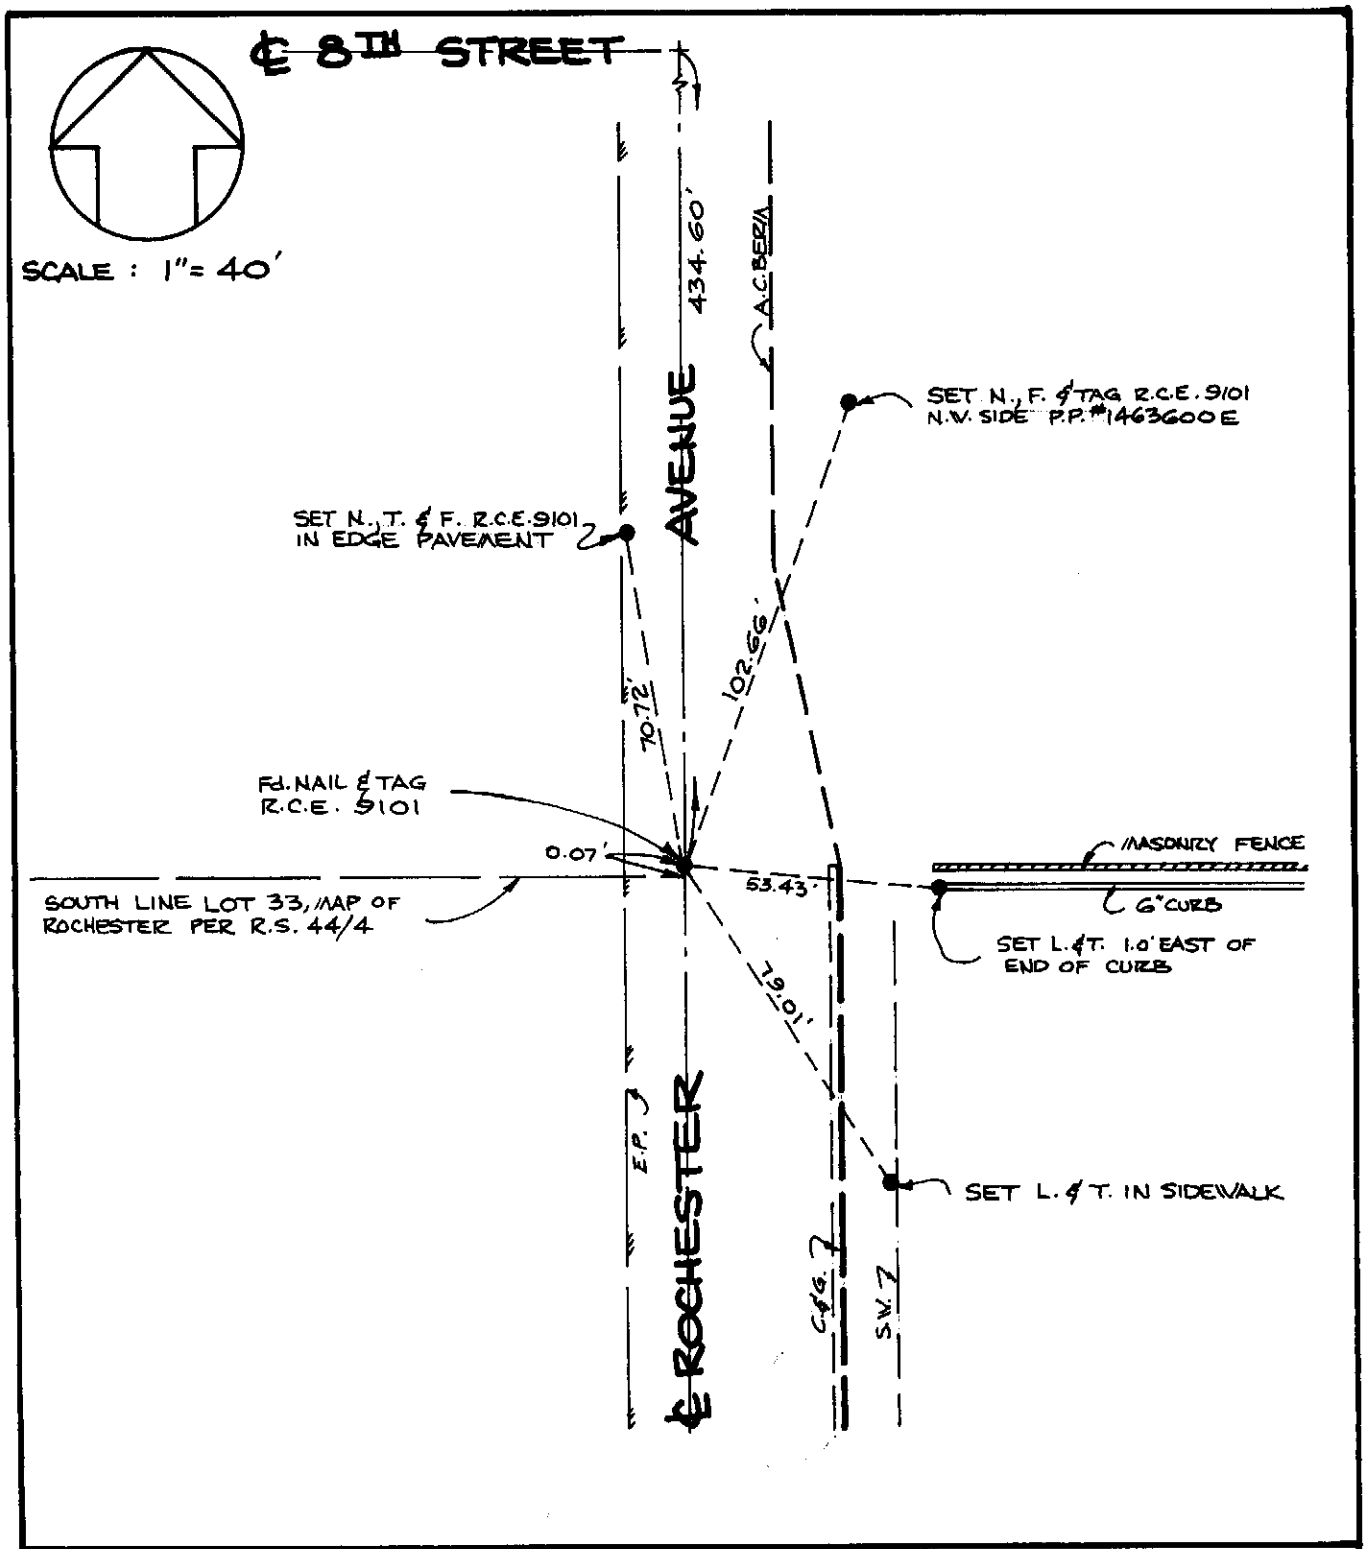

CITY OF RANCHO CUCAMONGA — STREET TIE	ASSESSMENT DISTRICT 82-1
LOCKWOOD ENGINEERING & SURVEYING COMPANY, INC. 380 W. FOOTHILL BLVD. RIALTO, CALIFORNIA	SOUTH LINE LOT 33 AT ROCHESTER AVENUE
Carleton W. Lockwood CARLETON W. LOCKWOOD	FIELD REVIEW _____ DATE _____
R.C.E. NO. 9101, DATE 3-15-82	TIE BOOK 6 PAGE 4

SCALE : 1" = 40'

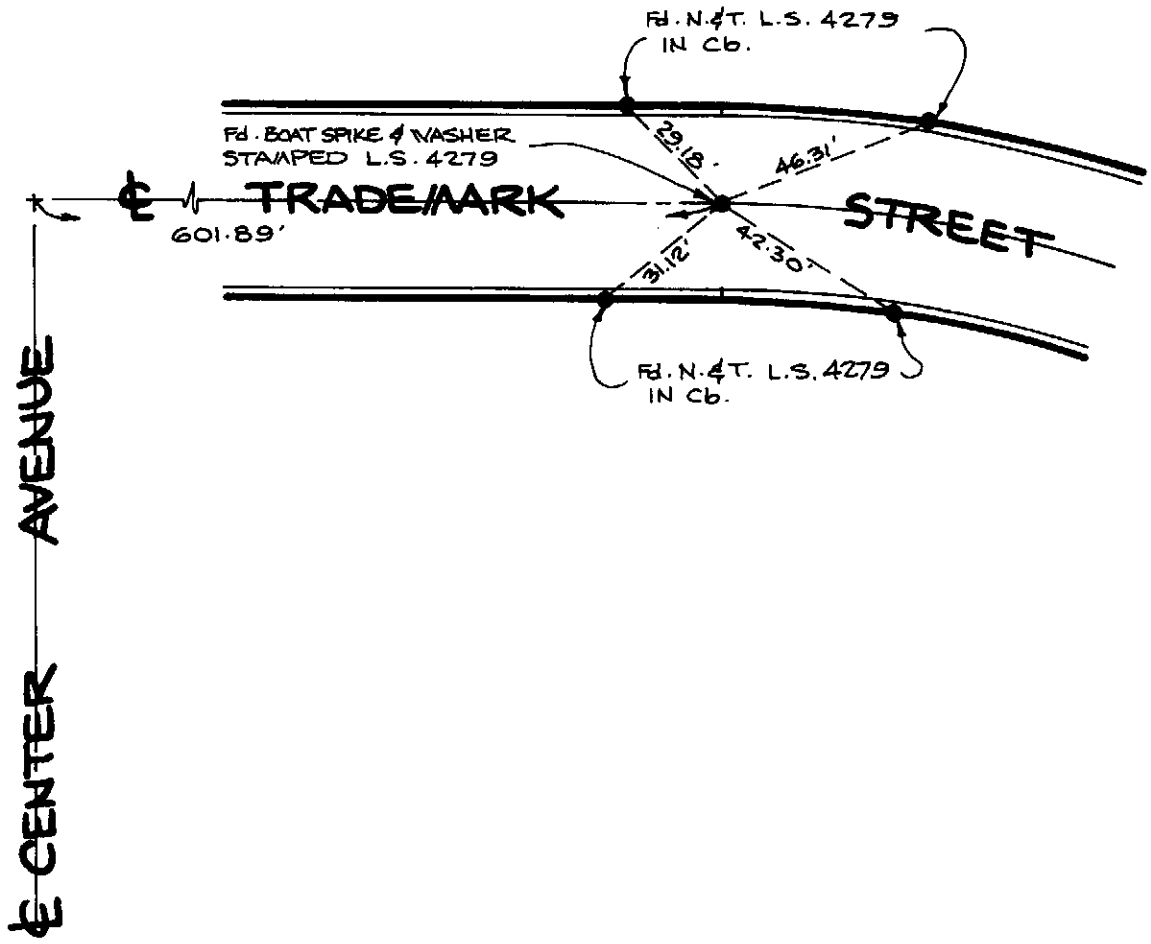

CITY OF RANCHO CUCAMONGA — STREET TIE	ASSESSMENT DISTRICT 82-1
LOCKWOOD ENGINEERING & SURVEYING COMPANY, INC. 380 W. FOOTHILL BLVD. RIALTO, CALIFORNIA	TRADEMARK STREET AT B.C. 601.89' EAST OF CENTER AVENUE
CARLETON W. LOCKWOOD	FIELD REVIEW _____ DATE _____
R.C.E. NO. 9101, DATE 3-15-82	TIE BOOK 6 PAGE 5

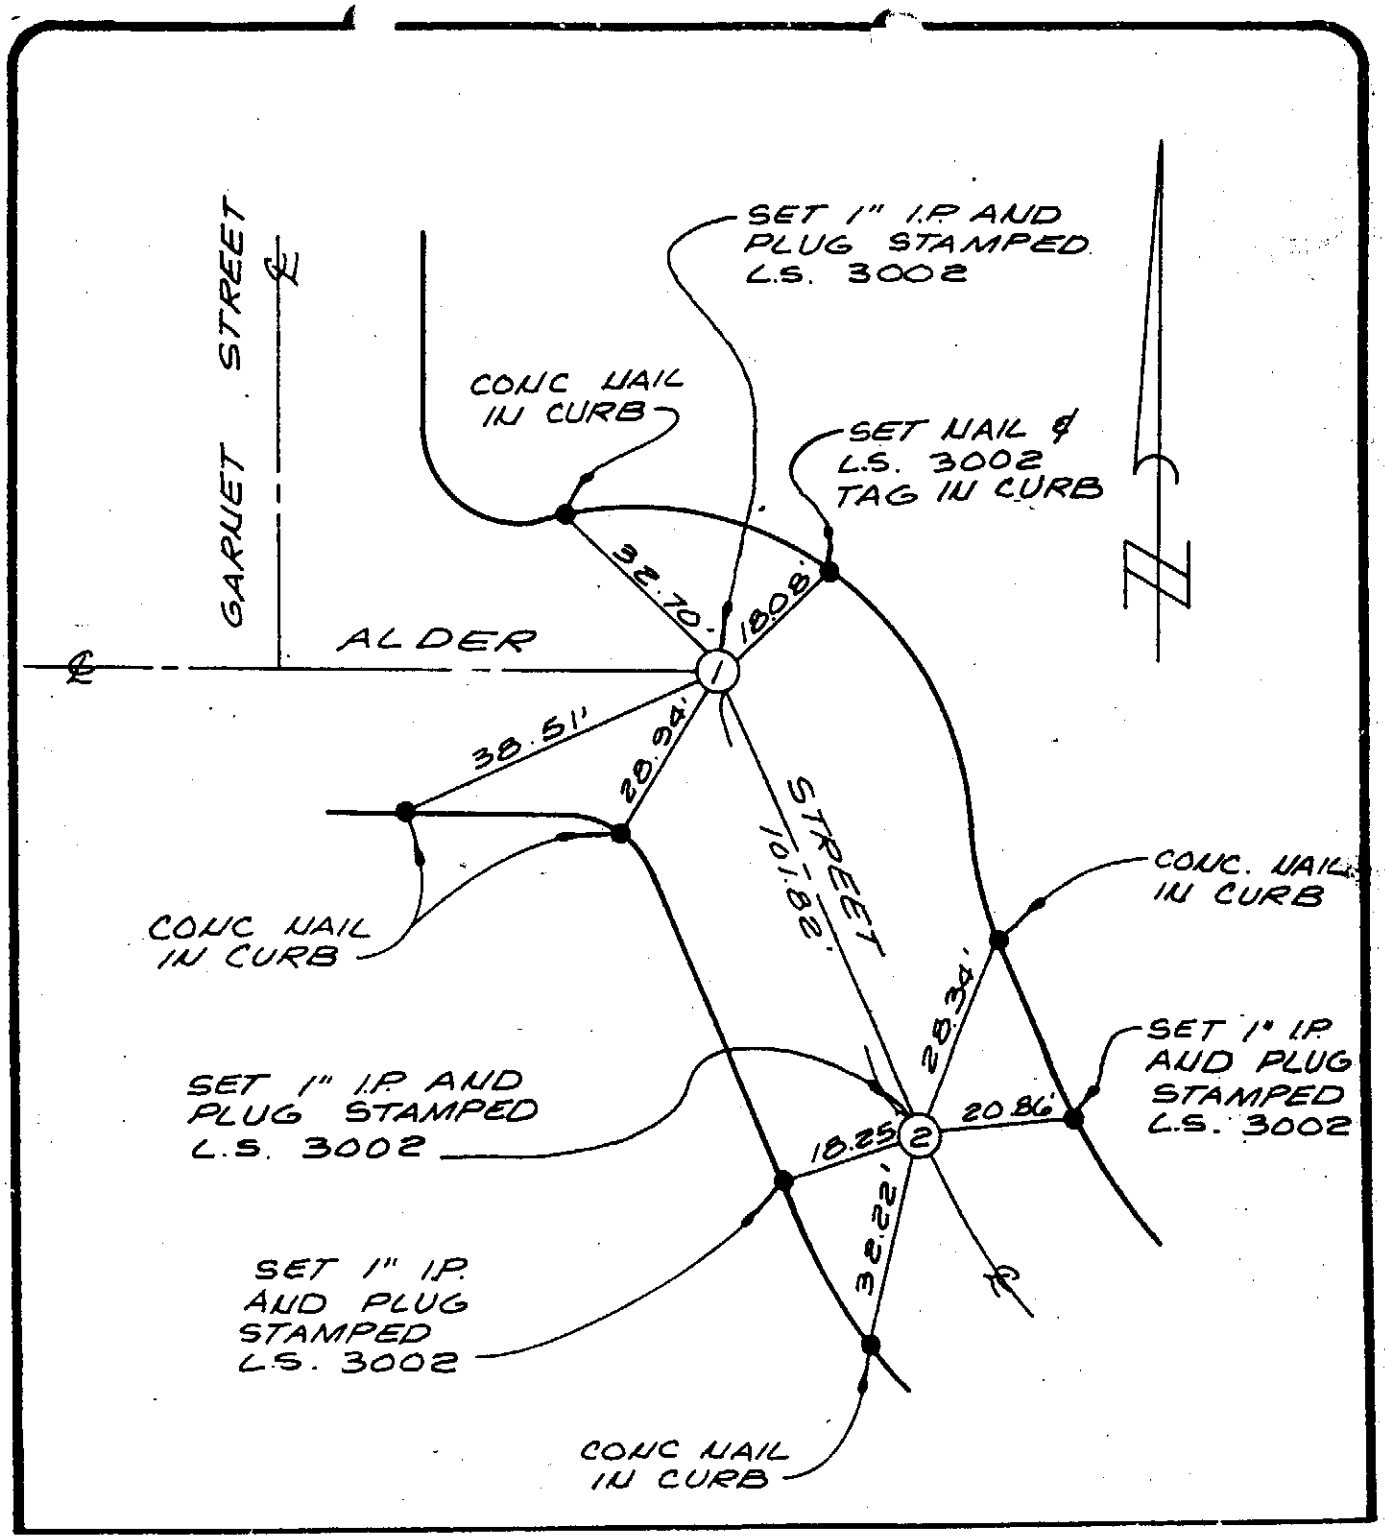

city of rancho cucamonga — STREET TIE	TRACT No. 9423
ASSOCIATED ENGINEERS 316 EAST E STREET ONTARIO, CA. 91764 (714) 986-5818	1 - ANGLE POINT ON ℄ ALDER ST 100' ± E OF GARNET STREET. 2 - B.C. ON ℄ ALDER STREET, 200' ±' E OF GARNET ST.
L.S. L.H. NOREEN	FIELD REVIEW _____ DATE _____
L.S. No. 3002 DATE 11/3/80	TIE BOOK 6 PAGE 6

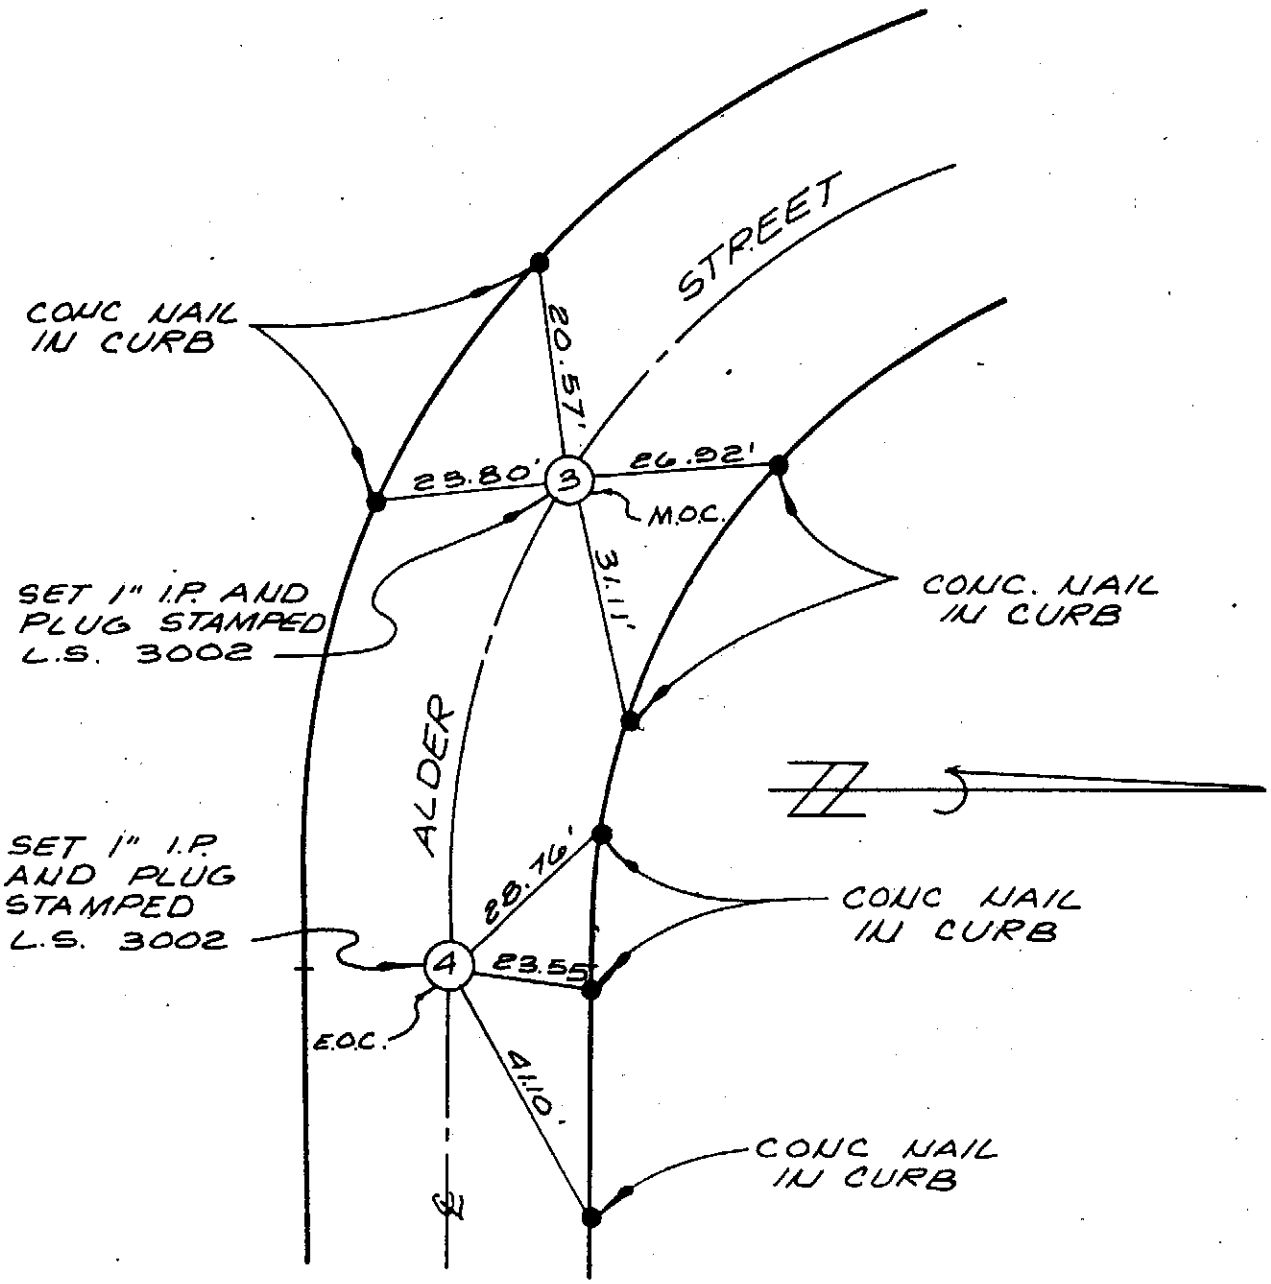

city of: rancho cucamonga — STREET TIE	TRACT No. 9423
ASSOCIATED ENGINEERS 316 EAST E STREET ONTARIO, CA. 91764 (714) 986-5818	3 - M.O.C. ON ℄ ALDER ST., 200' WEST OF BERYL ST. 4 - B.C. ON ℄ ALDER STREET 200'± WEST OF BERYL ST.
L.S. L.H. NOREEN	FIELD REVIEW _____ DATE _____
L.S. No. 3002 DATE 11/3/80	TIE BOOK 6 PAGE 7

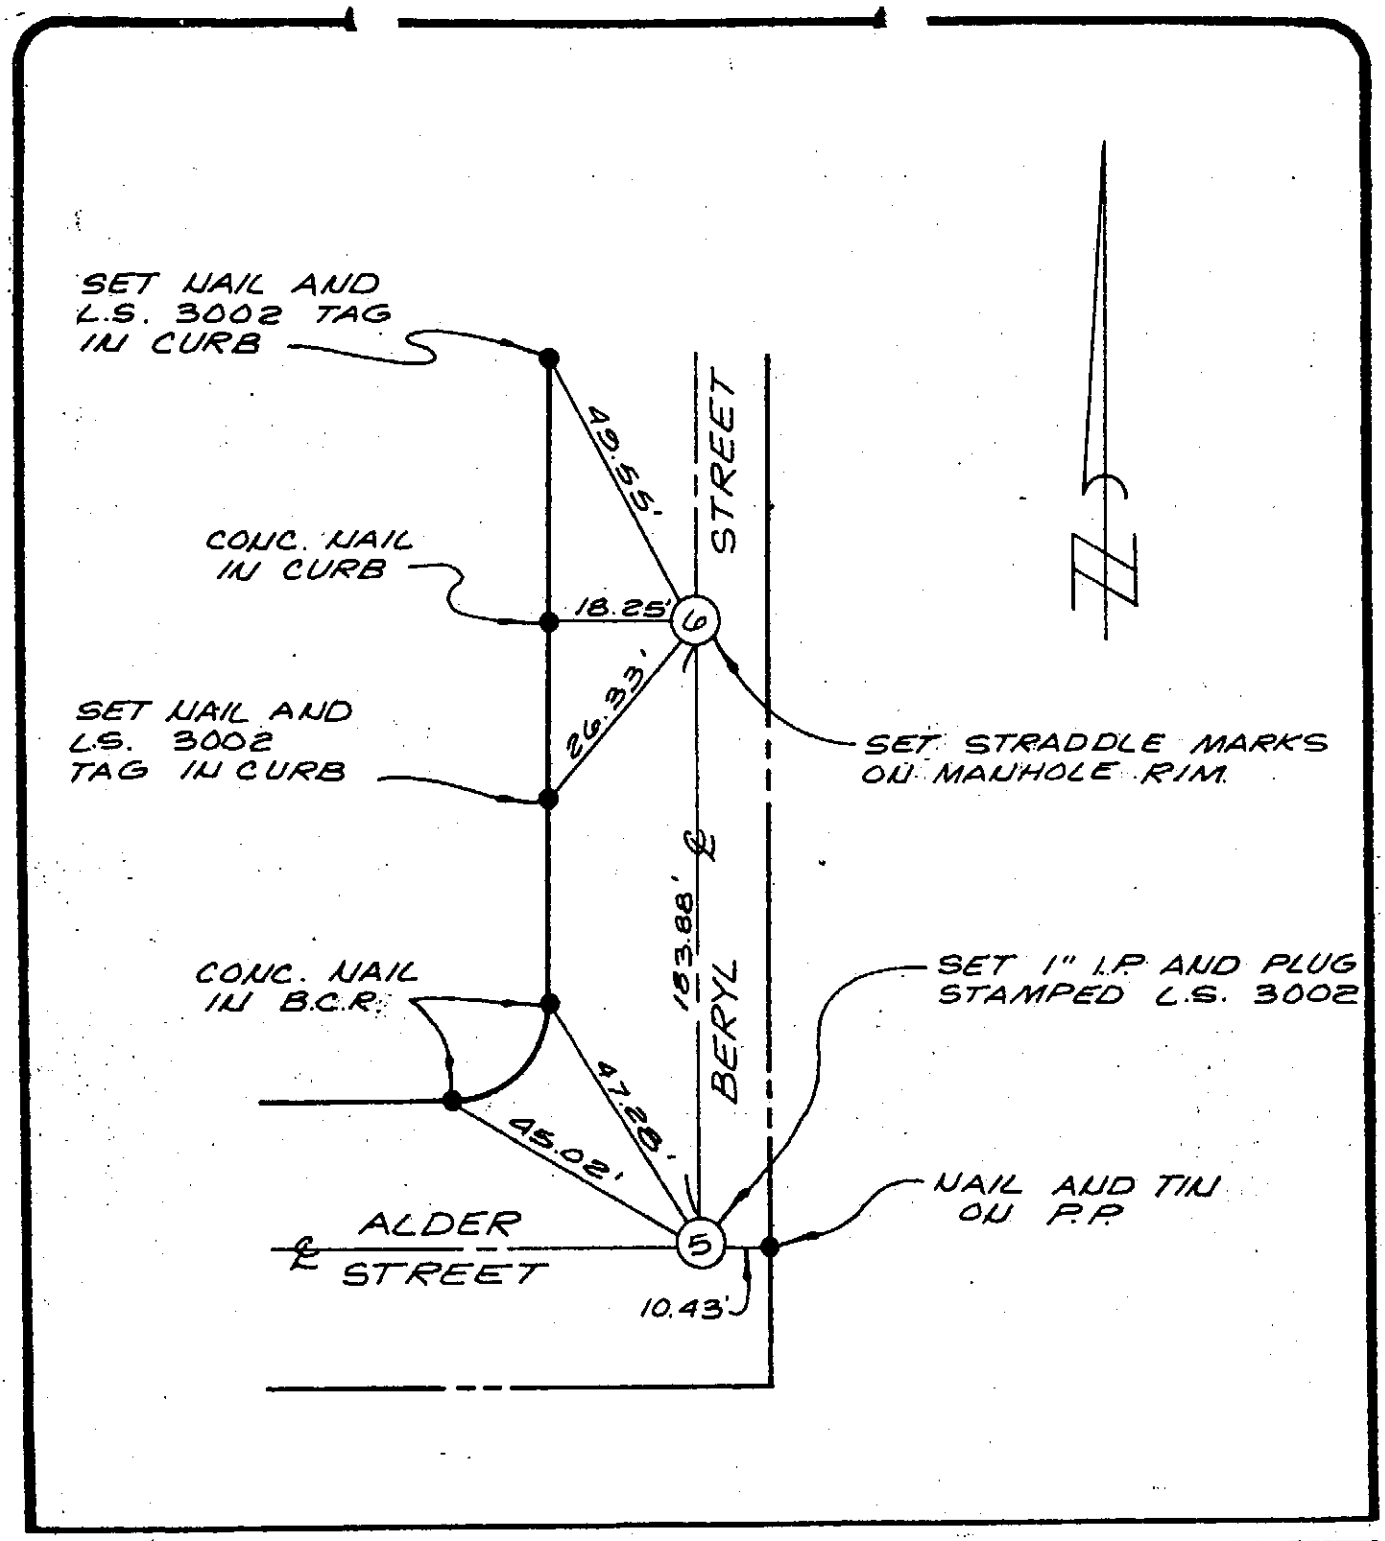

city of rancho cucamonga — STREET TIE	TRACT No. 9423
ASSOCIATED ENGINEERS 316 EAST E STREET ONTARIO, CA. 91764 (714) 986-5818	5 - ℄ INT OF ALDER STREET AND BERYL STREET 6 - ANGLE POINT ON ℄ BERYL ST., 200'± N OF ALDER ST.
L.S. L.H. NOREEN	FIELD REVIEW _____ DATE _____
L.S. No. 3002 DATE 11/3/80	TIE BOOK 6 PAGE 8

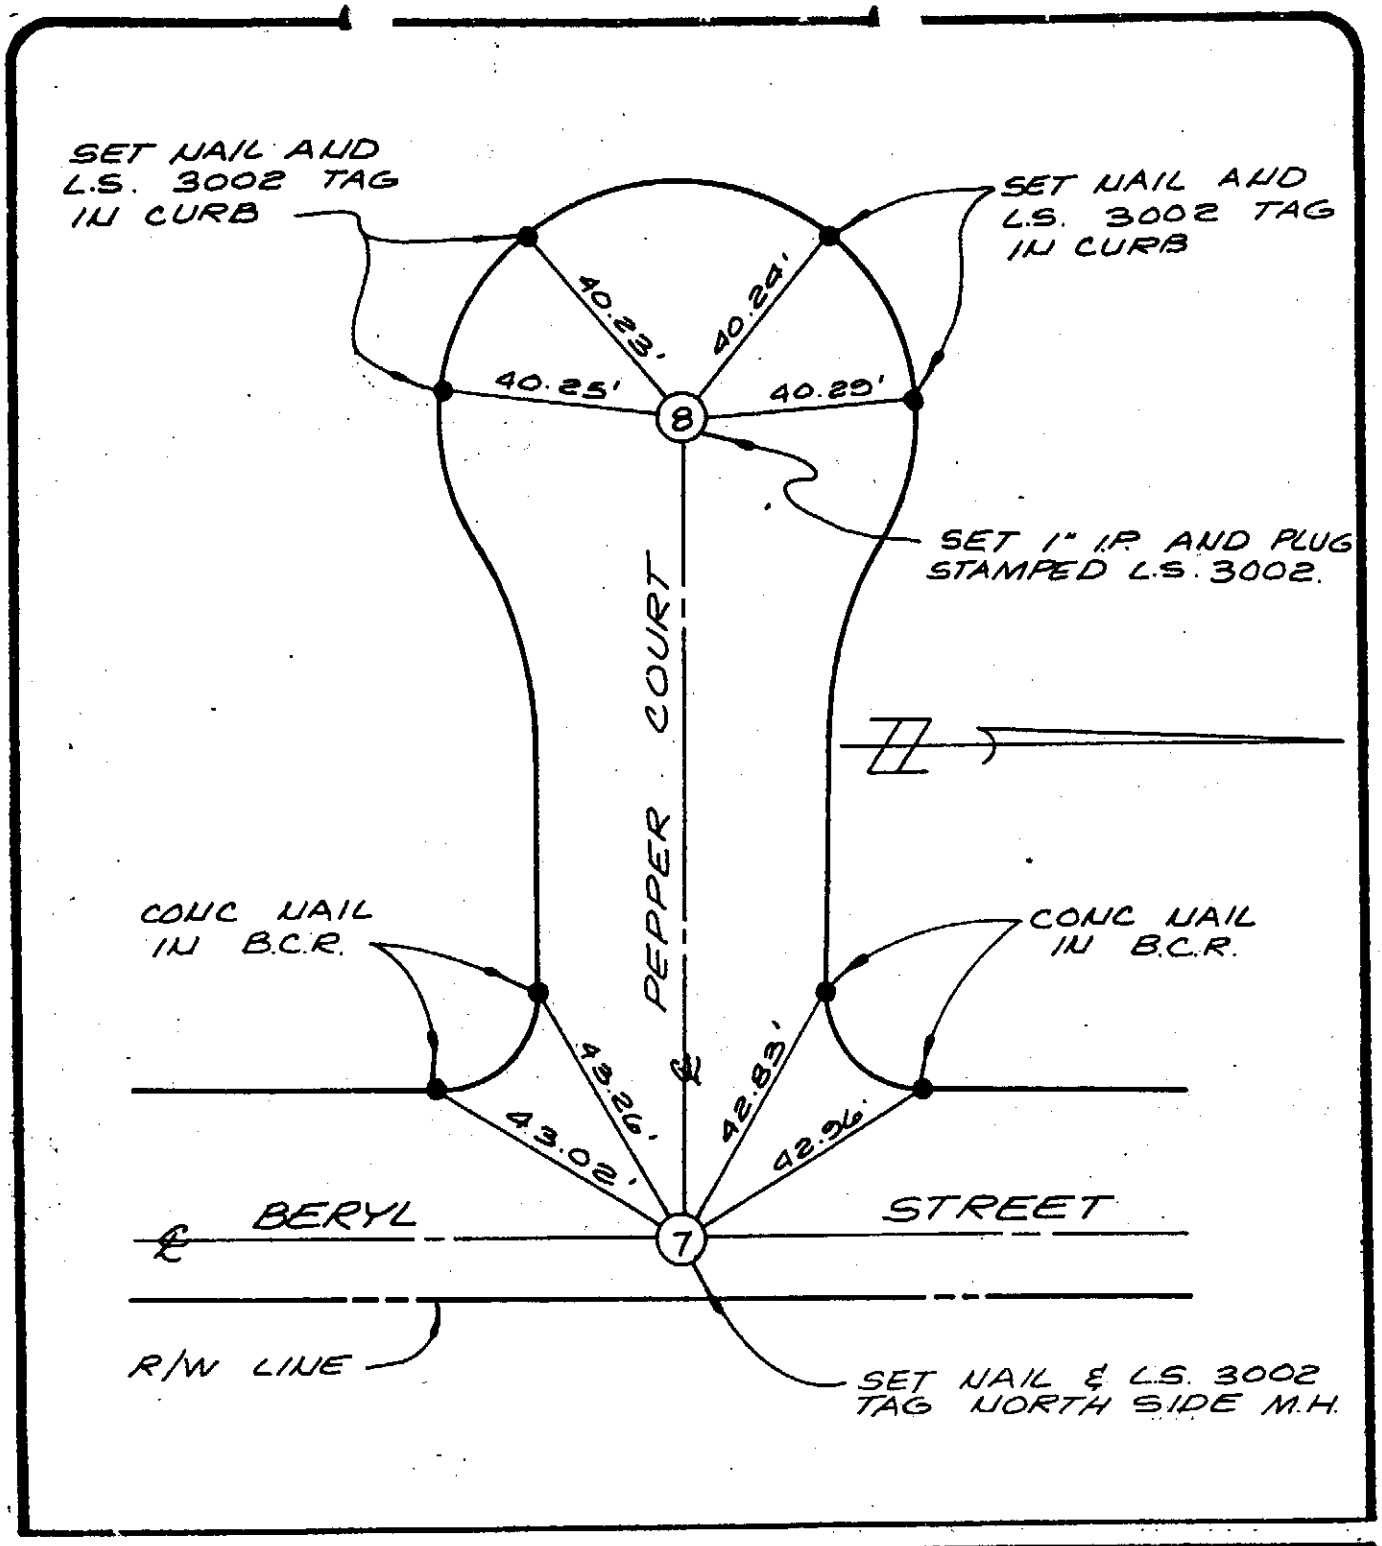

city of rancho cucamonga — STREET TIE	TRACT No. 9423
ASSOCIATED ENGINEERS 316 EAST E STREET ONTARIO, CA. 91764 (714) 986-5818	7 - ℄ INT BERYL STREET AND PEPPER COURT. 8 - RADIUS POINT OF PEPPER COURT CUL-DE-SAC
L.S. L.H. NOREEN	FIELD REVIEW _____ DATE _____
L.S. No. 3002 DATE 11/3/80	TIE BOOK 6 PAGE 9

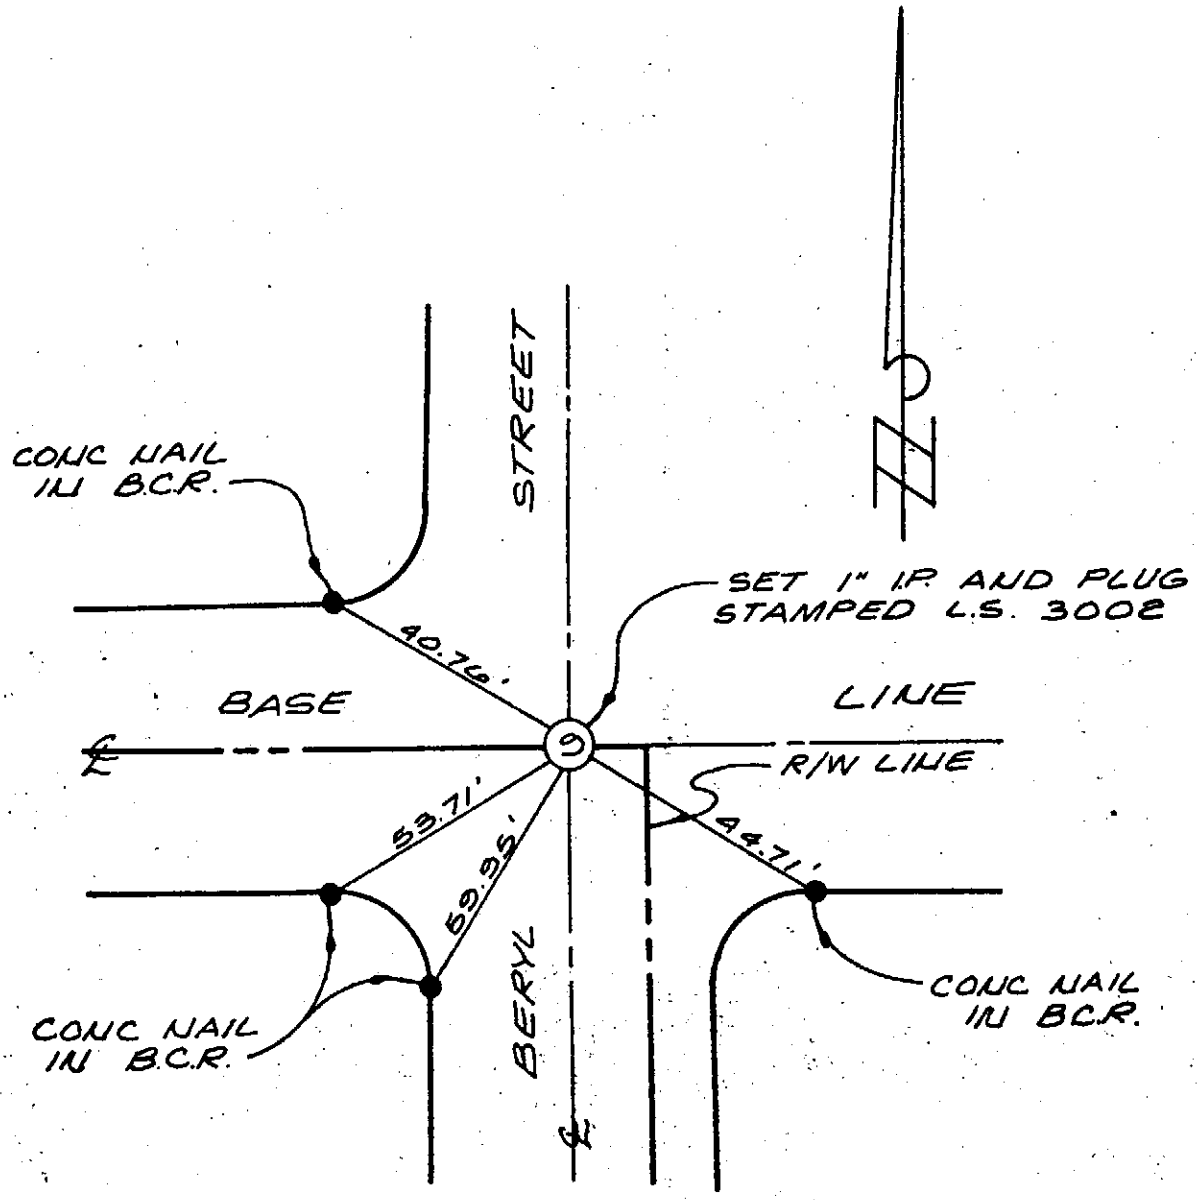

city of rancho cucamonga — STREET TIE	TRACT No. 9423
ASSOCIATED ENGINEERS 316 EAST E STREET ONTARIO, CA. 91764 (714) 986-5818	9 - ℄ INT. OF BASE LINE AND BERYL STREET
L.S. L.H. NOREEN	FIELD REVIEW _____ DATE _____
L.S. No. 3002 DATE 11/3/80	TIE BOOK 6 PAGE 10

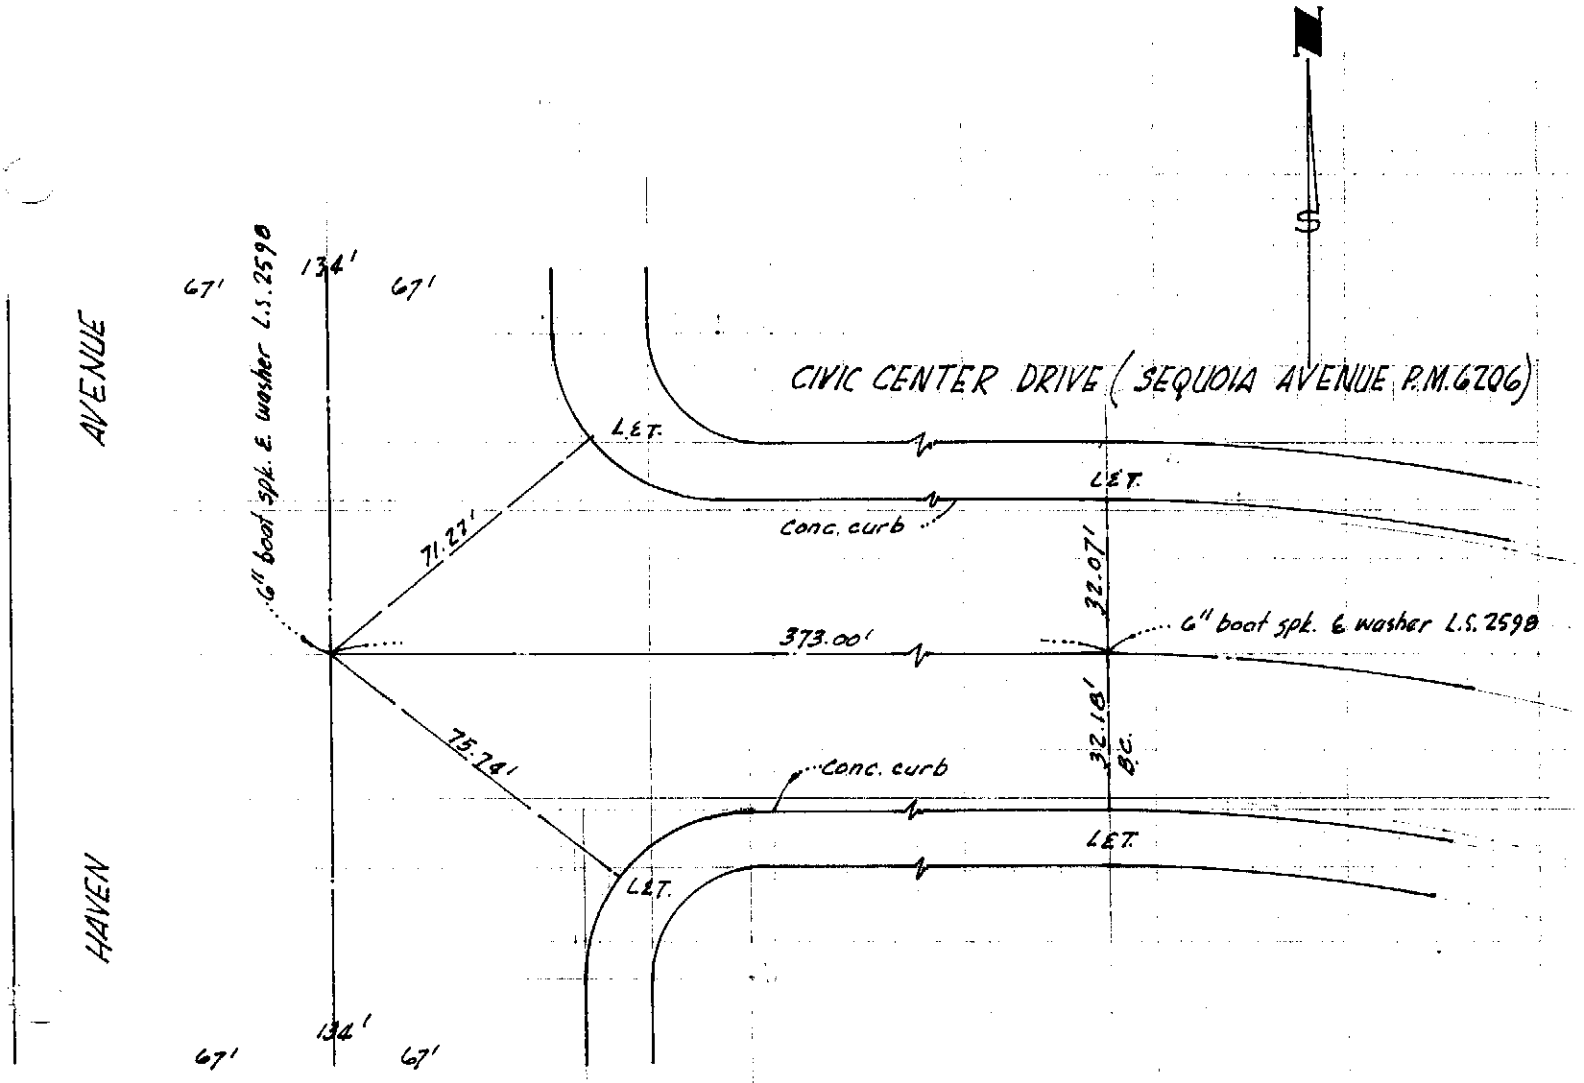

CITY OF RANCHO CUCAMONGA
P.M. No. 6206 CENTERLINE TIES
Frank V. Scarborough L.S. 2598 132 Laburnum Ln. Fountain Valley, Ca. 92708 (714) 964-4485

Tie Book 6 Page 11 1 of 9

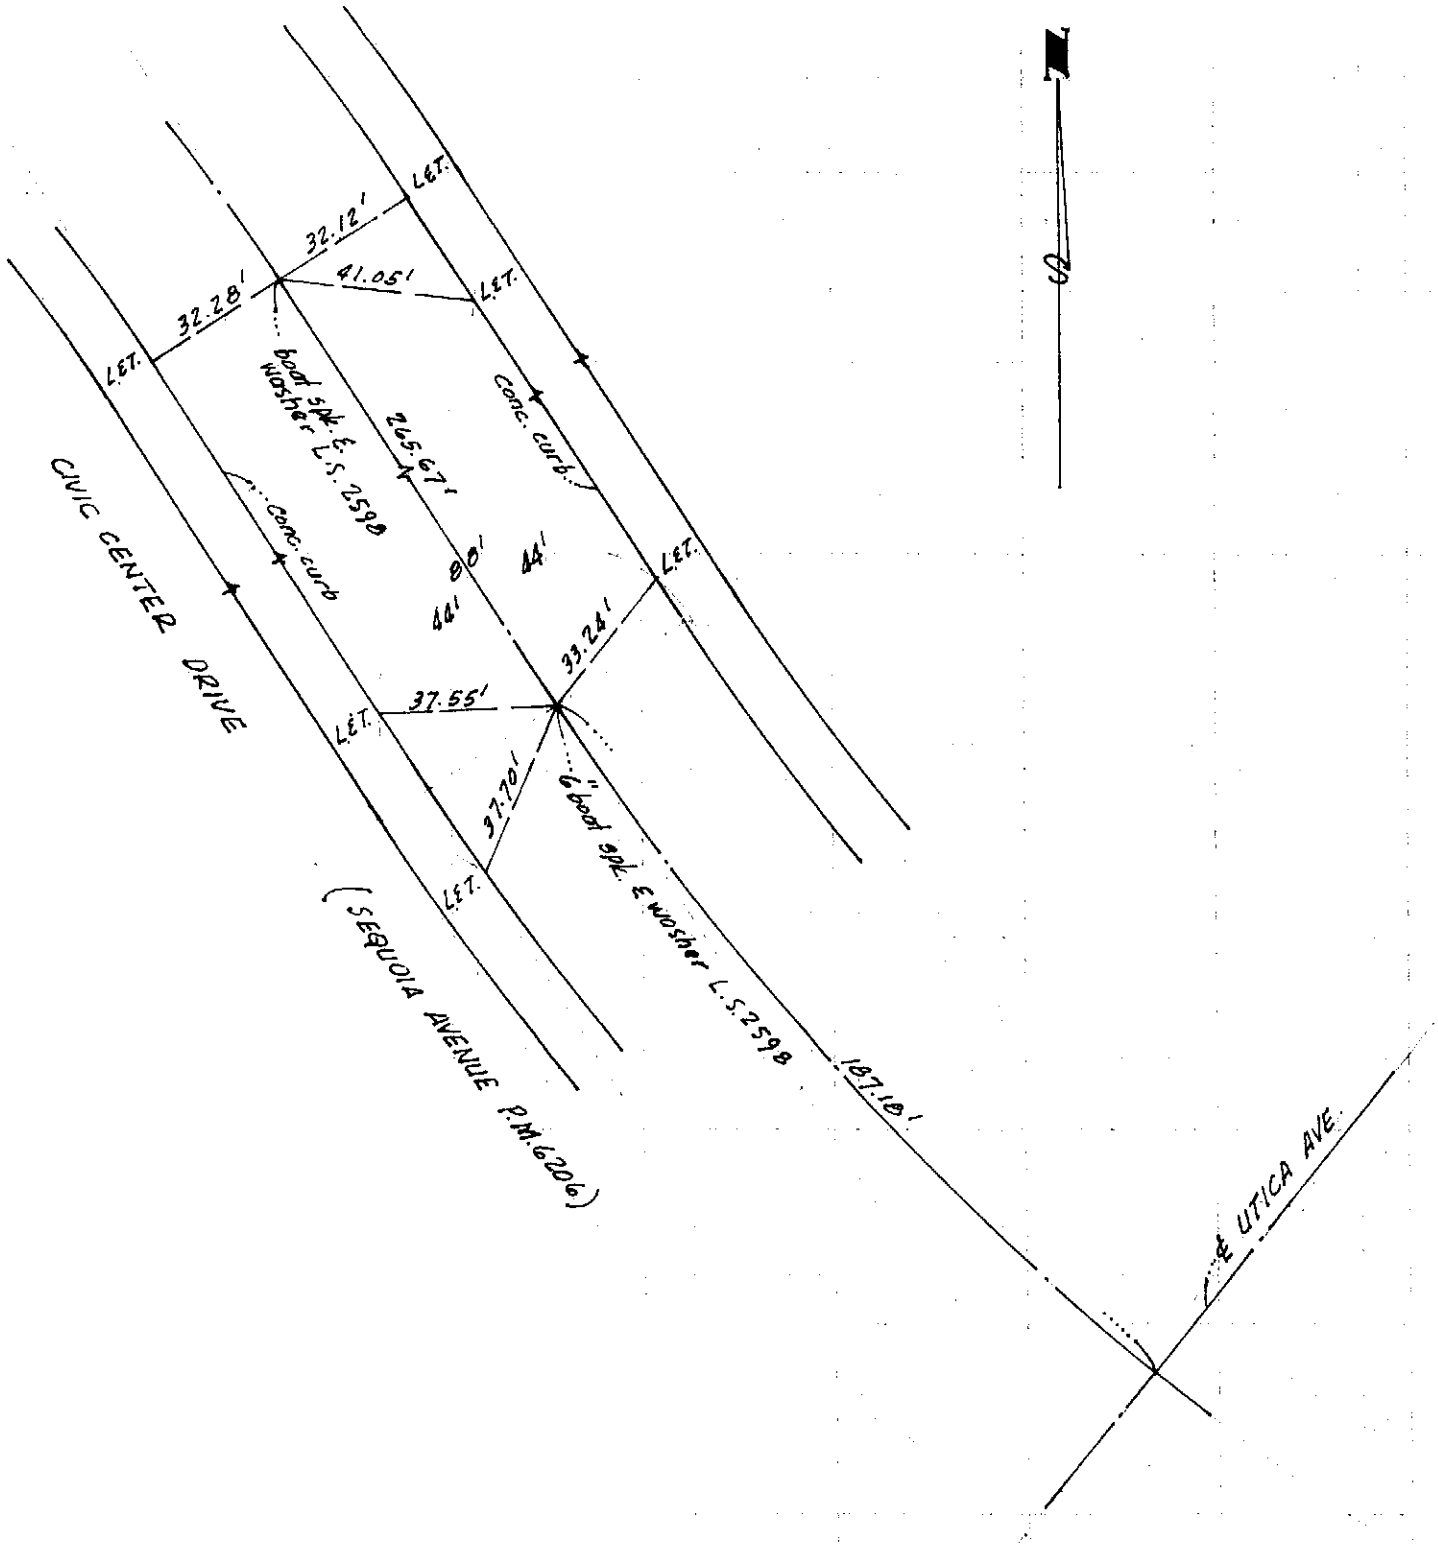

CITY OF RANCHO CUCAMONGA
P.M. No. 6206 CENTERLINE TIES
Frank V. Scarborough L.S. 2598 132 Laburnum Ln. Fountain Valley, Ca. 92708 (714) 964-4485

Tie Book 6 Page 12 2 of 9

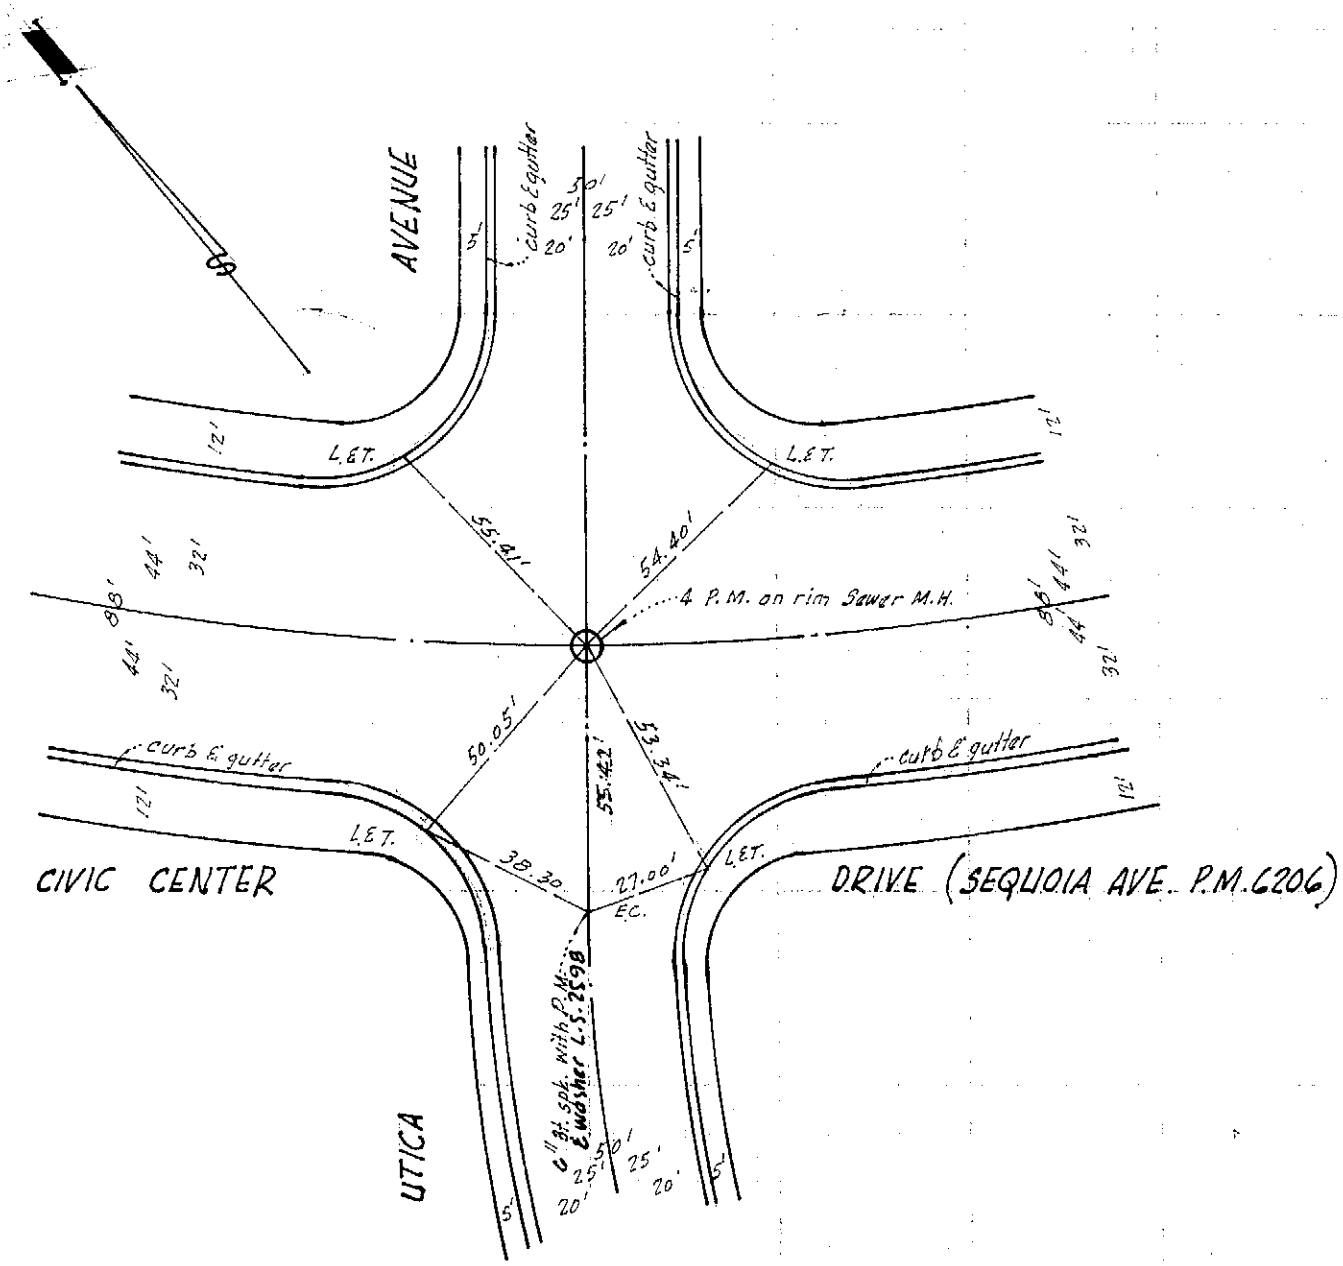

CITY OF RANCHO CUCAMONGA
P.M. No. 6206 CENTERLINE TIES
Frank V. Scarborough. L.S. 2598 132. Laburnum Ln. Fountain Valley, Ca. 92708 (714) 964-4485

Tie Book 6 Page 13 3 of 9

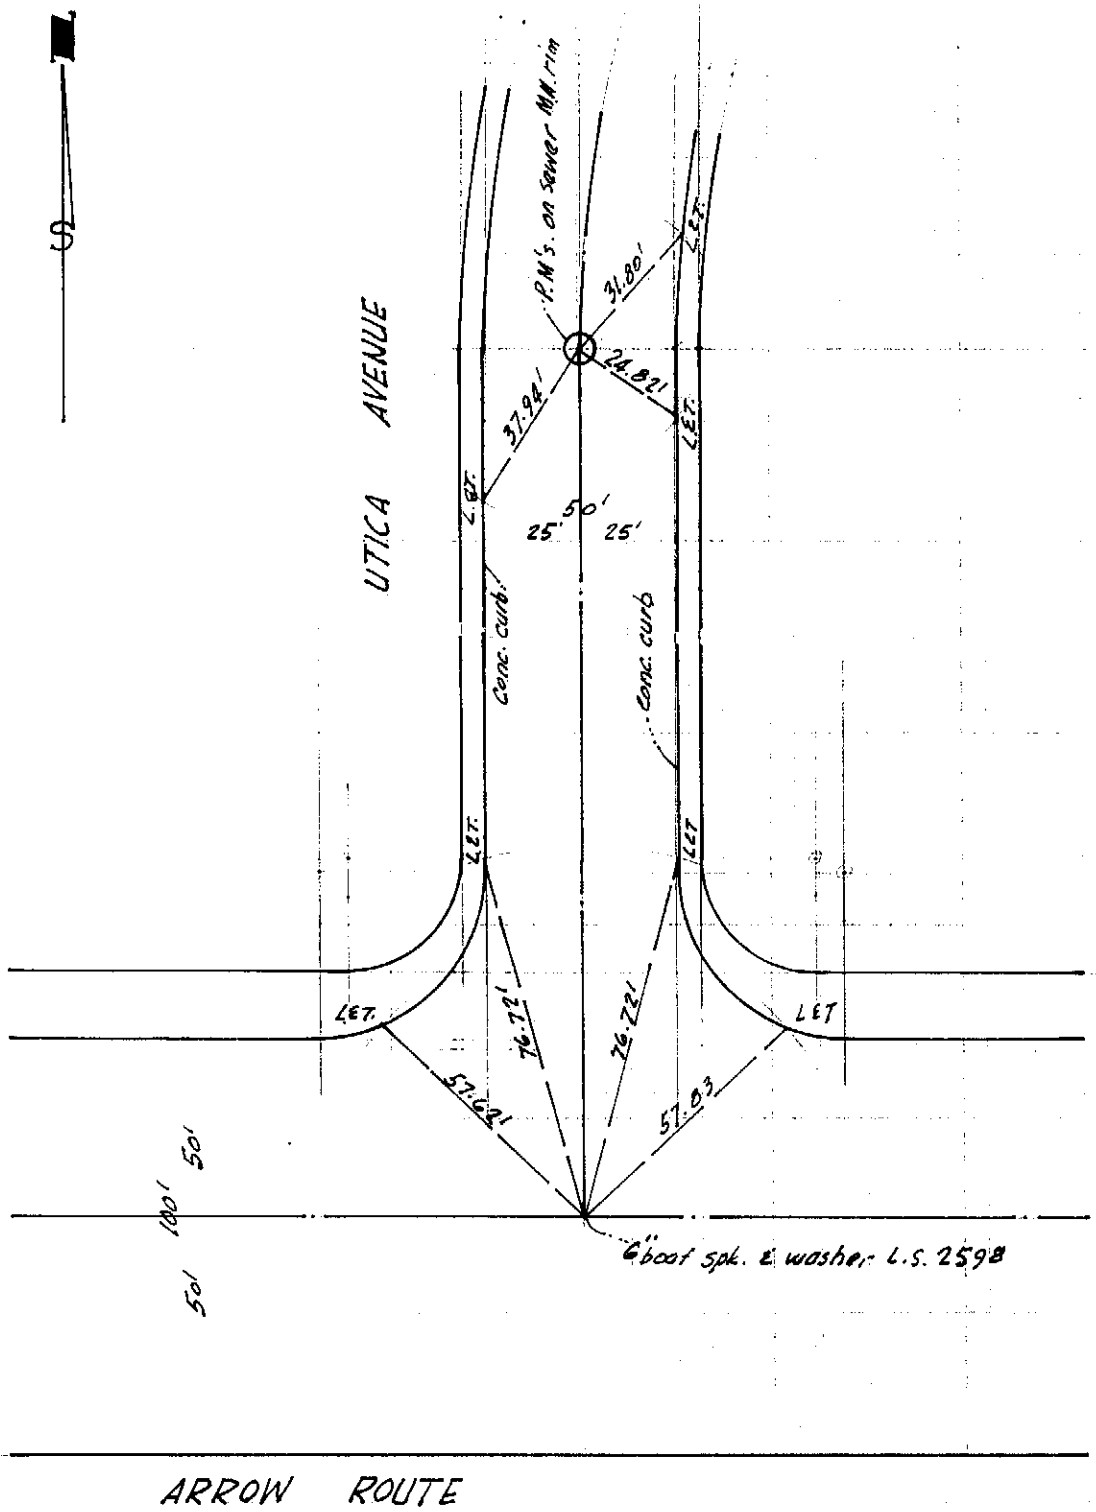

ARROW ROUTE

CITY OF RANCHO CUCAMONGA
P.M. No. 6206 CENTERLINE TIES
Frank V. Scarborough L.S. 2598 132 Laburnum Ln. Fountain Valley, Ca. 92708 (714) 964-4485

Tie Book 6 Page 14

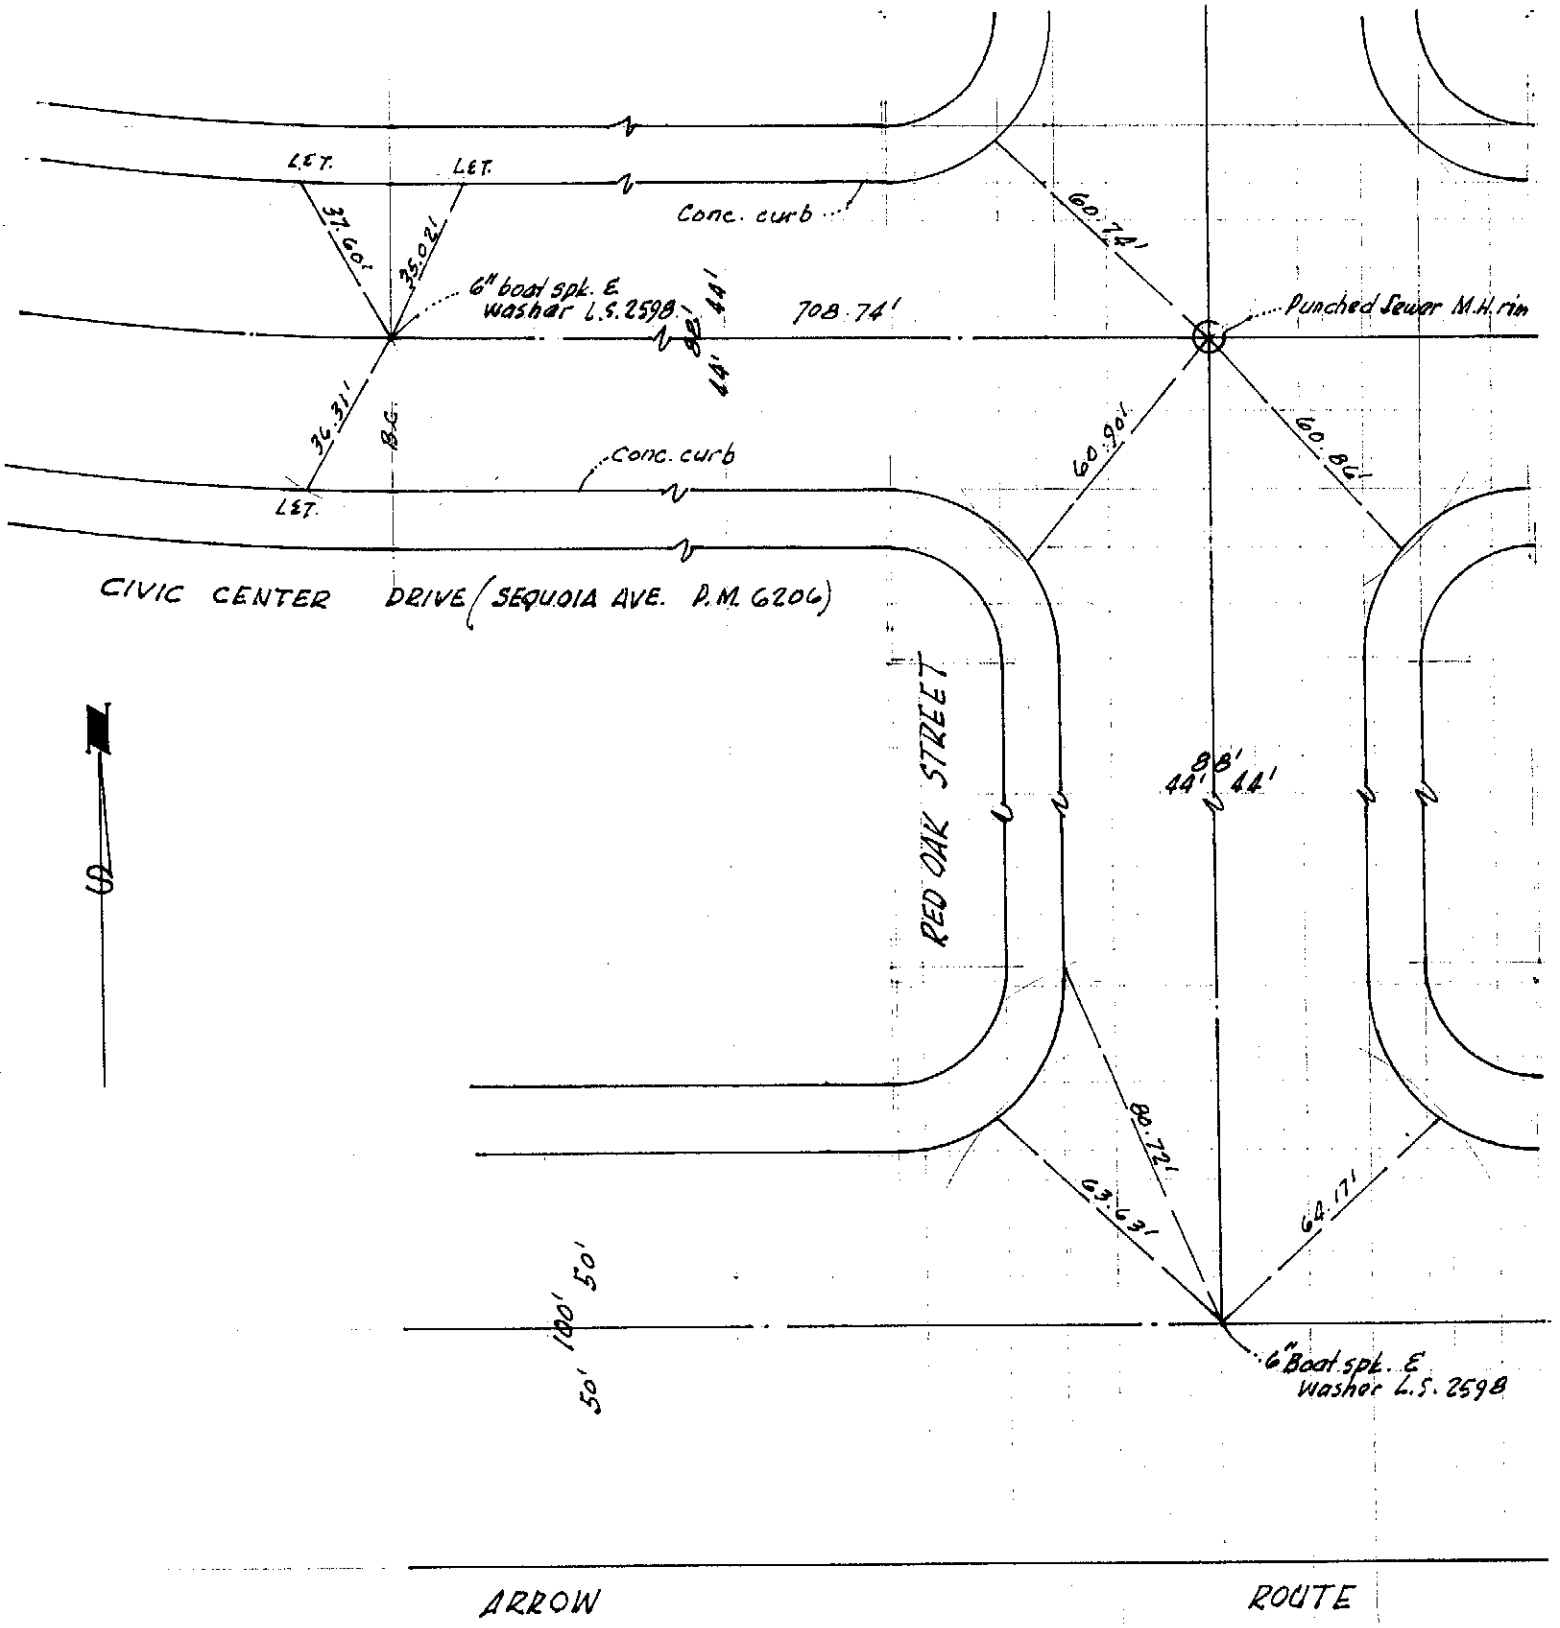

CITY OF RANCHO CUCAMONGA

P.M. No. 6206
CENTERLINE TIES

Frank V. Scarborough. L.S. 2598
132 Laburnum Ln.
Fountain Valley, Ca. 92708
(714) 964-4485

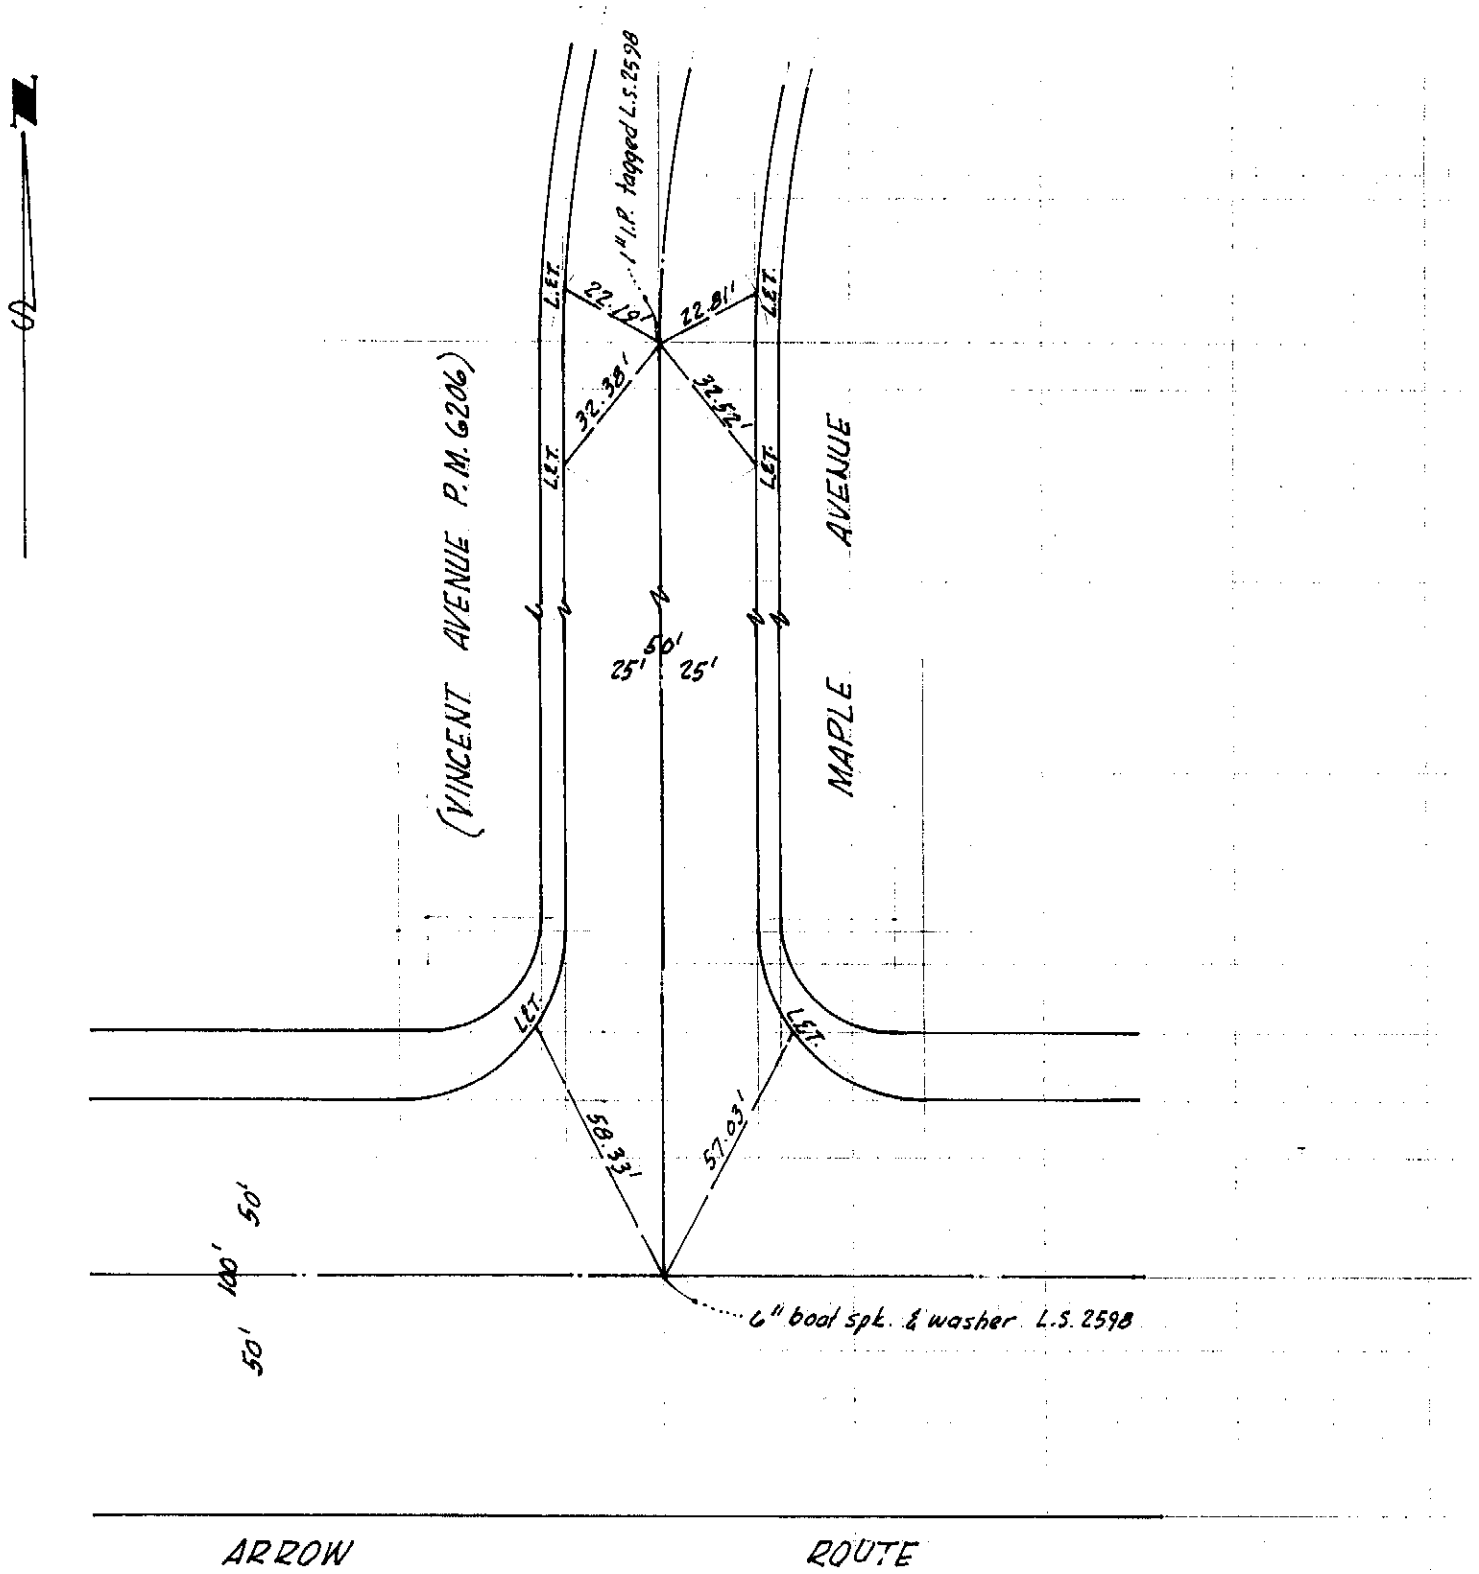

CITY OF RANCHO CUCAMONGA
P.M. No. 6206 CENTERLINE TIES
Frank V. Scarborough L.S. 2598 132 Laburnum Ln. Fountain Valley, Ca. 92708 (714) 964-4485

Tie Book 6 Page 16 6 of 9

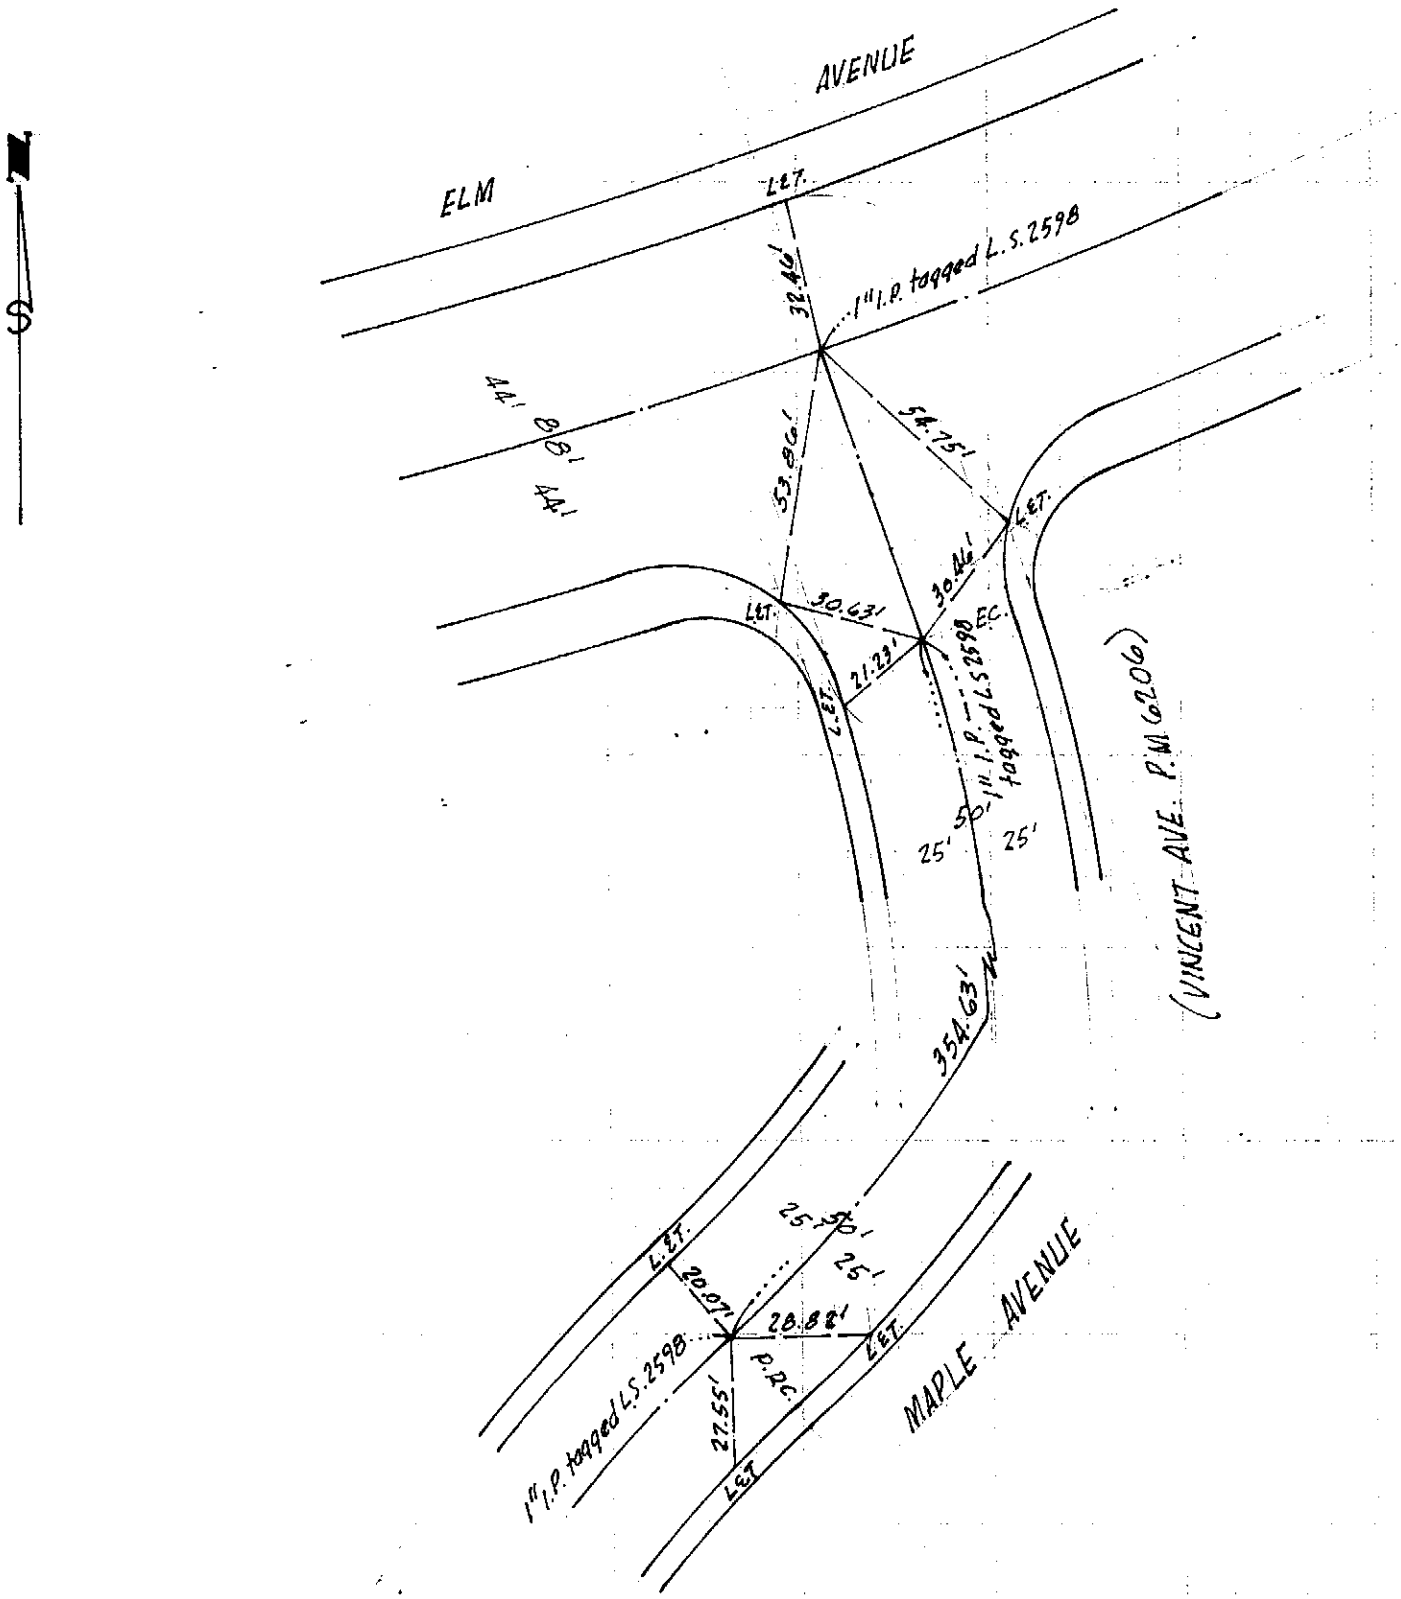

CITY OF RANCHO CUCAMONGA
P.M. No. 6206 CENTERLINE TIES
Frank V. Scarborough L.S. 2598 132 Laburnum Ln. Fountain Valley, Ca. 92708 (714) 964-4485

Tie Book 6 Page 17

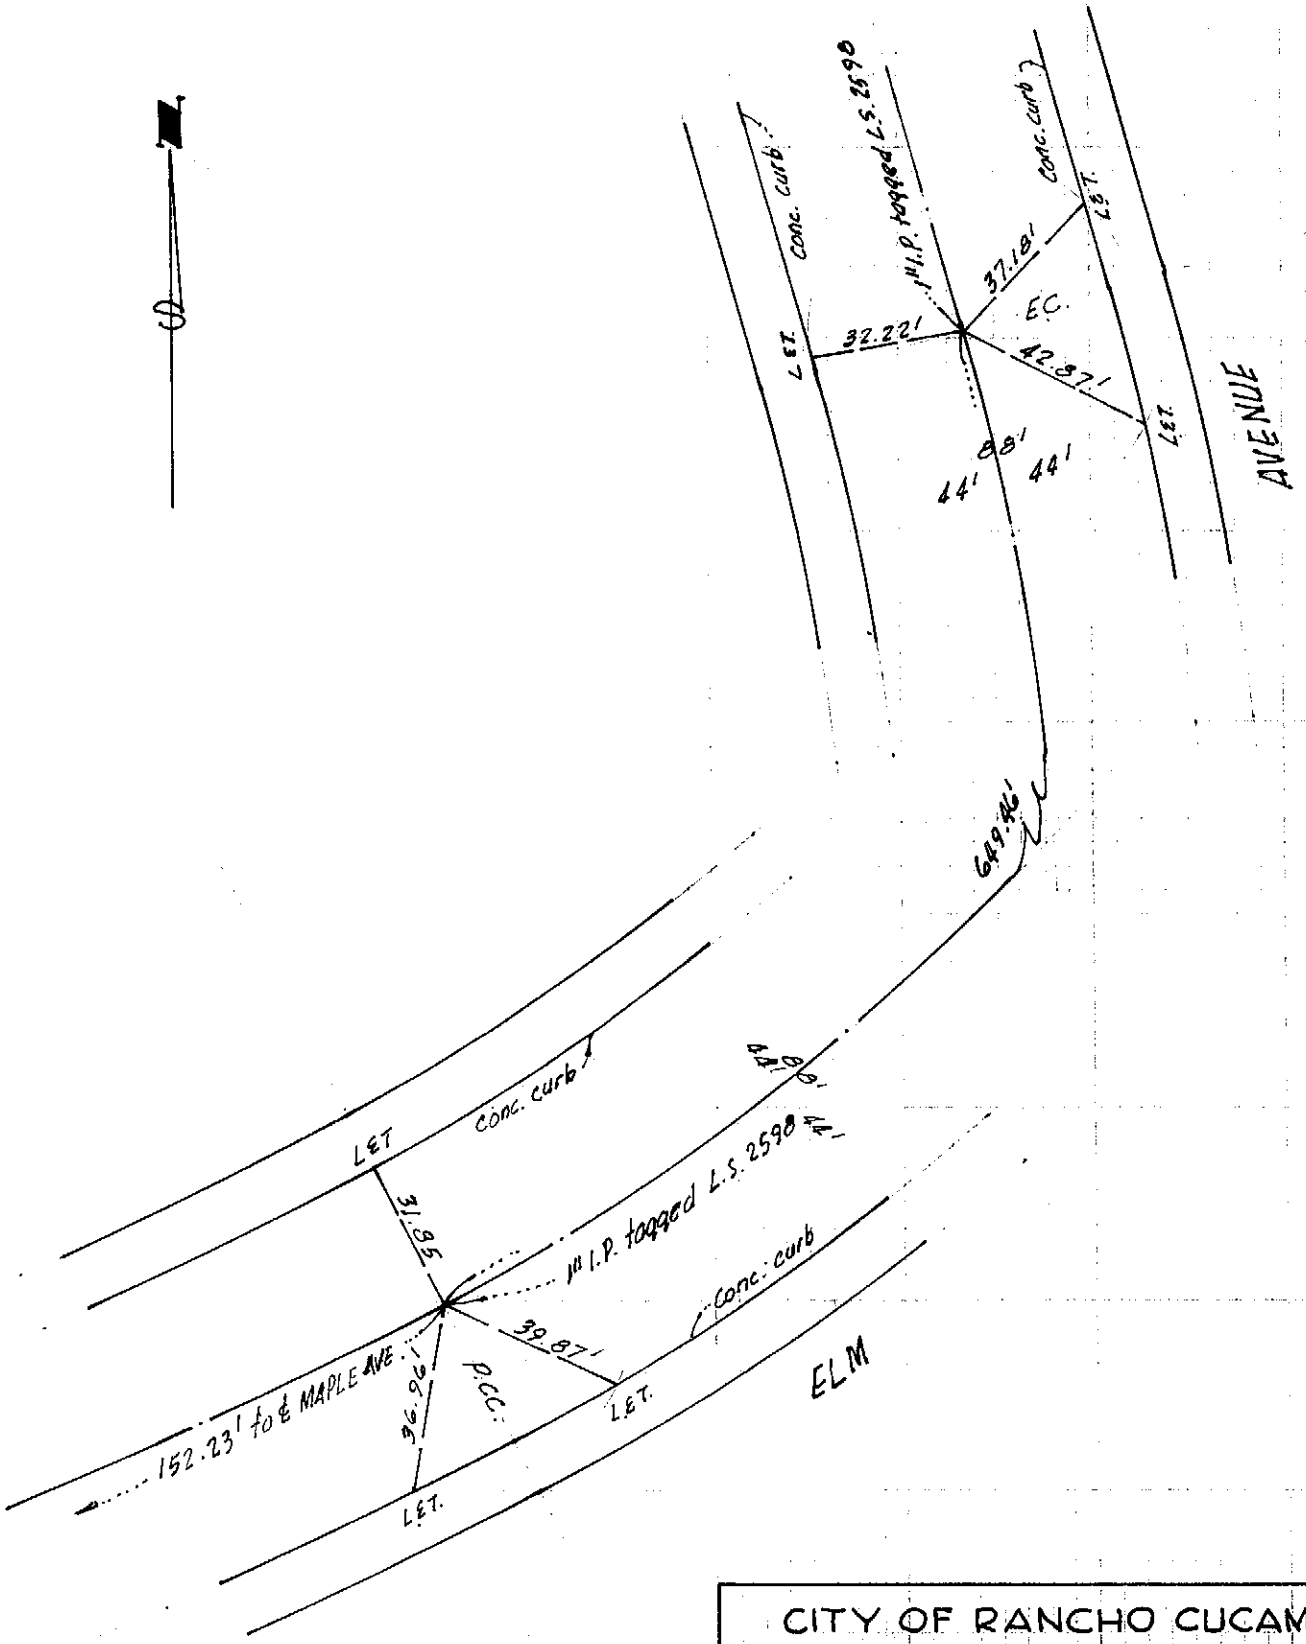

CITY OF RANCHO CUCAMONGA
P.M. No. 6206 CENTERLINE TIES
Frank V. Scarborough L.S. 2598 132 Laburnum Ln. Fountain Valley, Ca. 92708 (714) 964-4485

Tie Book 6 Page 18 8 of 9

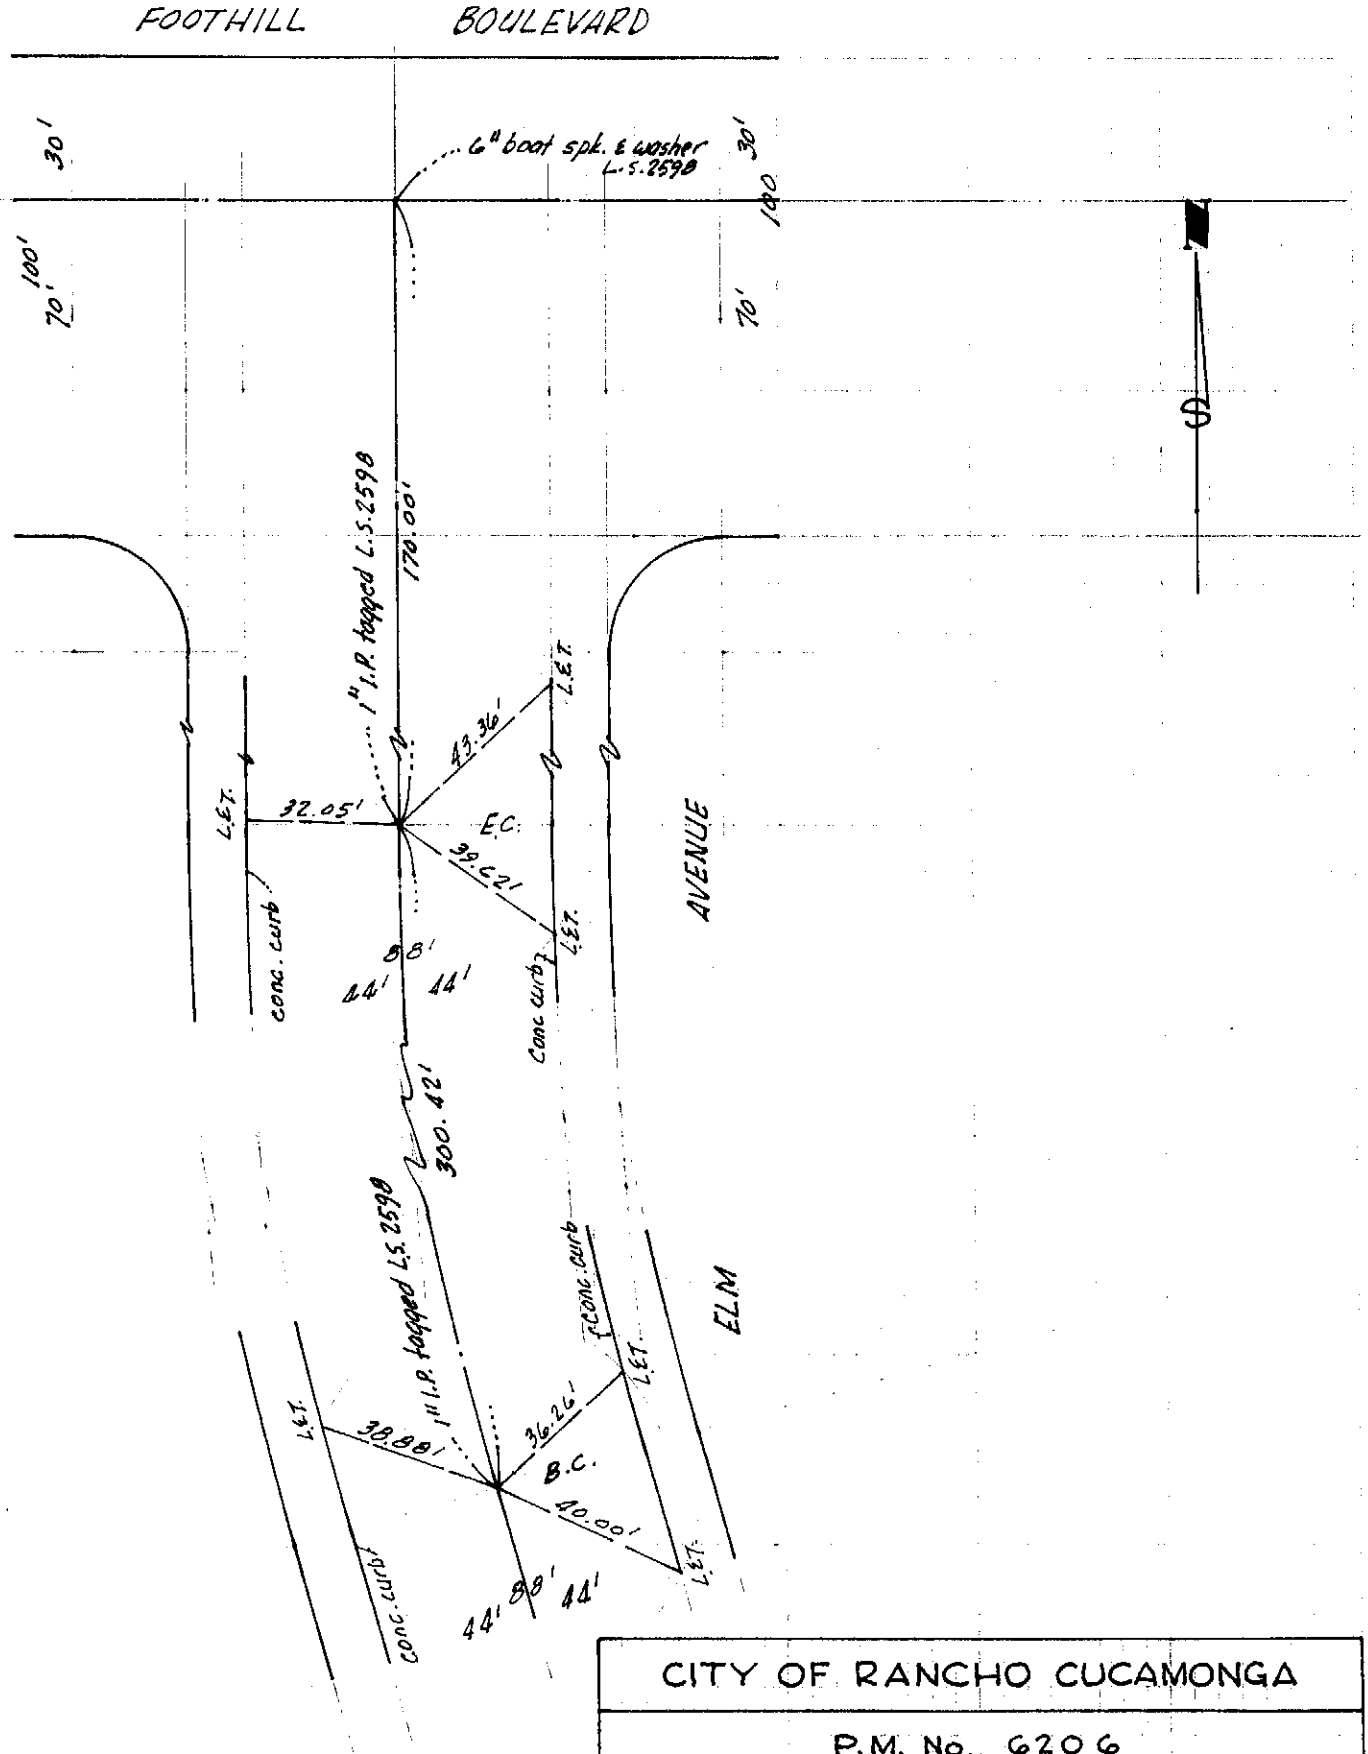

CITY OF RANCHO CUCAMONGA

P.M. No. 6206

CENTERLINE TIES

Frank V. Scarborough L.S. 2598
132 Laburnum Ln.
Fountain Valley, Ca 92708
(714) 964-4485

Tie Book 6 Page 19 9 of 9

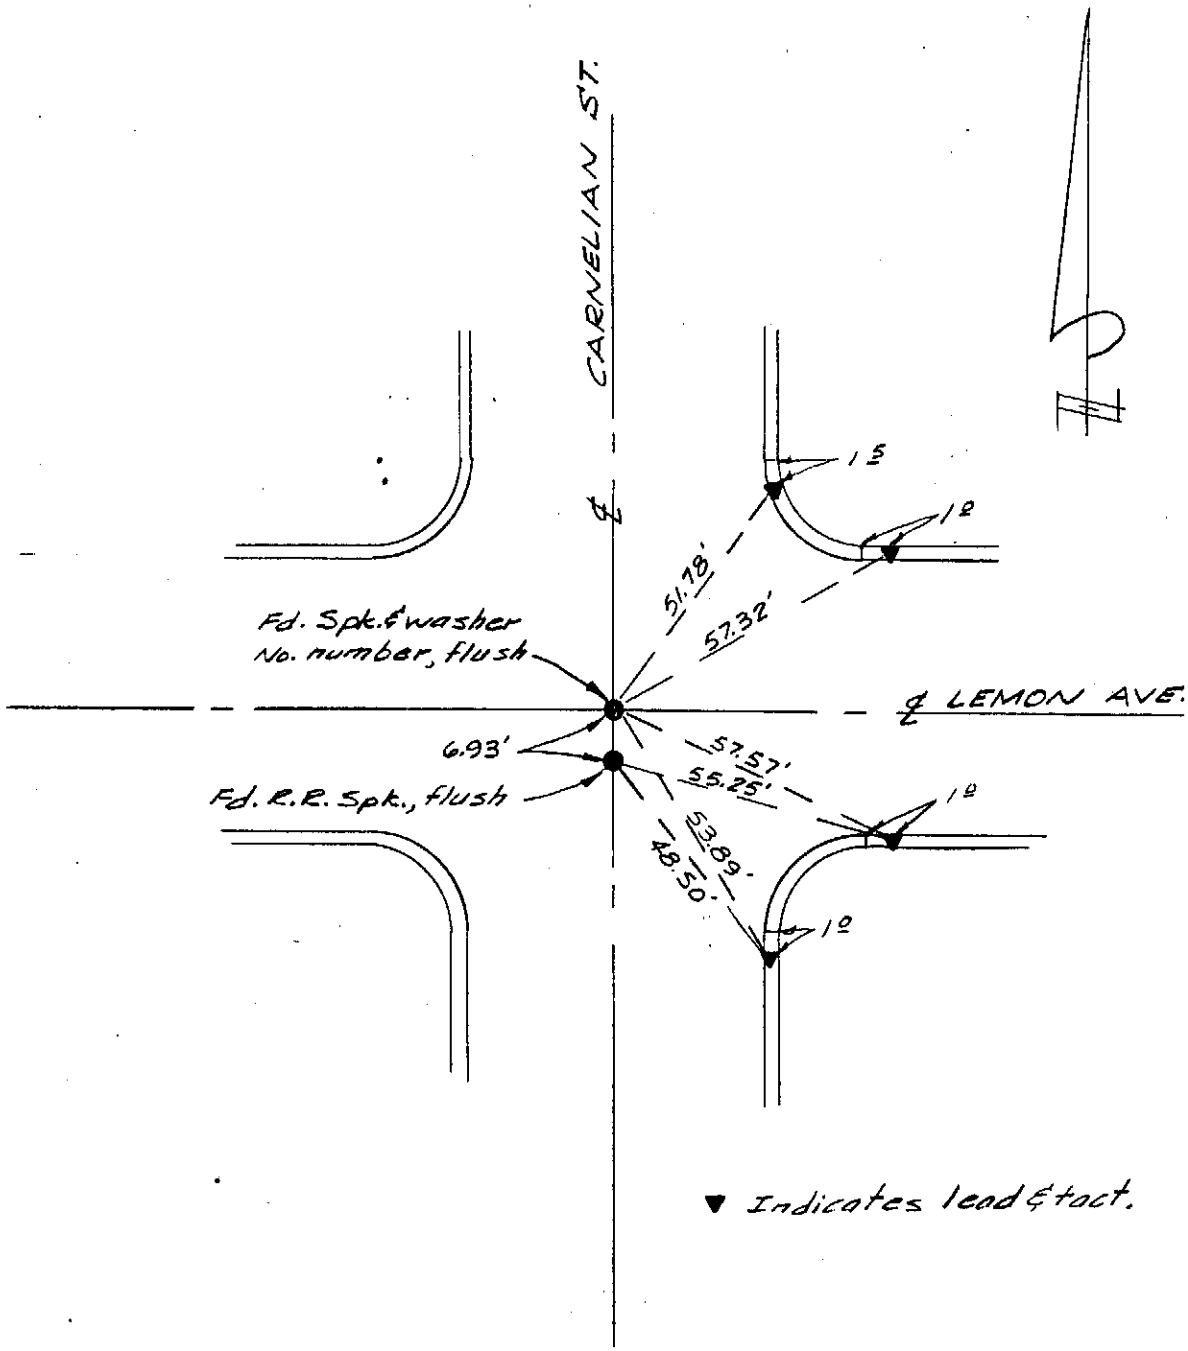

city of rancho cucamonga STREET TIE	
	CARNELIAN ST. & LEMON AVE.
ENGR. / L.S. ROBERT A. HORN	FIELD REVIEW _____ DATE _____
~~R.C.E.~~ / L.S. No. 4563 DATE DEC.82	TIE BOOK 6 PAGE 20

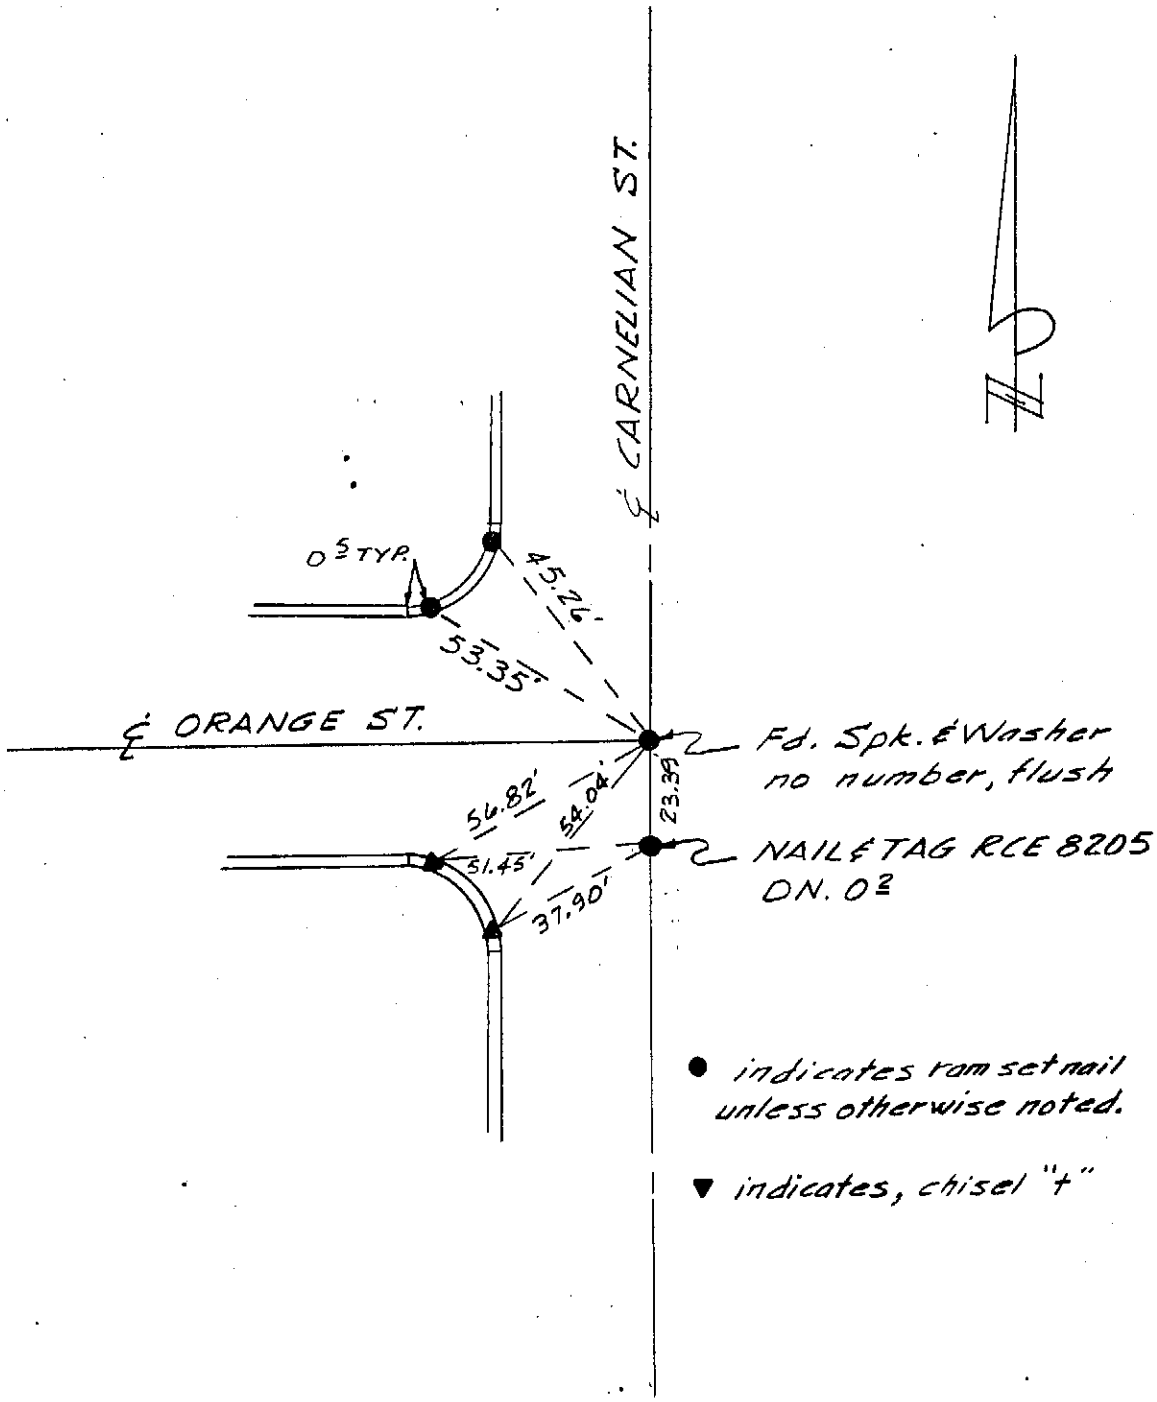

city of rancho cucamonga STREET TIE	
	CARNELIAN ST. & ORANGE ST.
ENGR. / L.S. ROBERT A. HORN	FIELD REVIEW _____ DATE _____
R.C.E. / L.S. No. 4563 DATE DEC. 82	TIE BOOK 6 PAGE 21

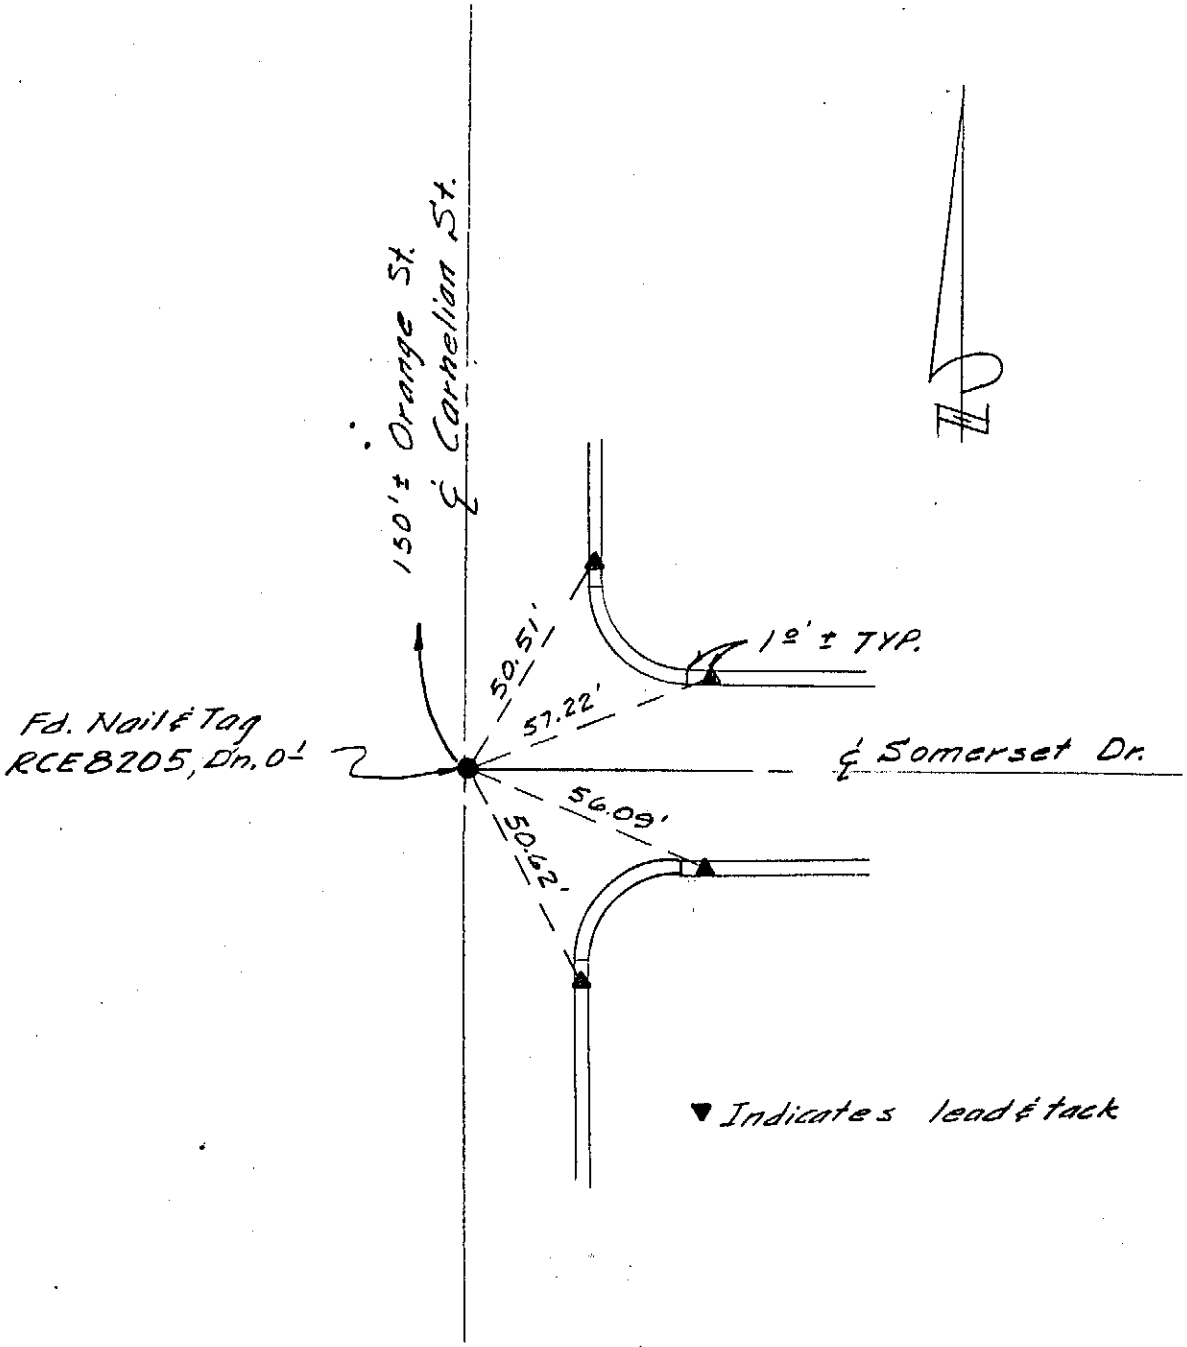

city of rancho cucamonga — STREET TIE	
	CARNELIAN ST. ℄ SOMERSET DR.
ENGR. / L.S. ROBERT A. HORN	FIELD REVIEW _____ DATE _____
R.C.E. / L.S. No. 4563 DATE DEC. 82	TIE BOOK 6 PAGE 22

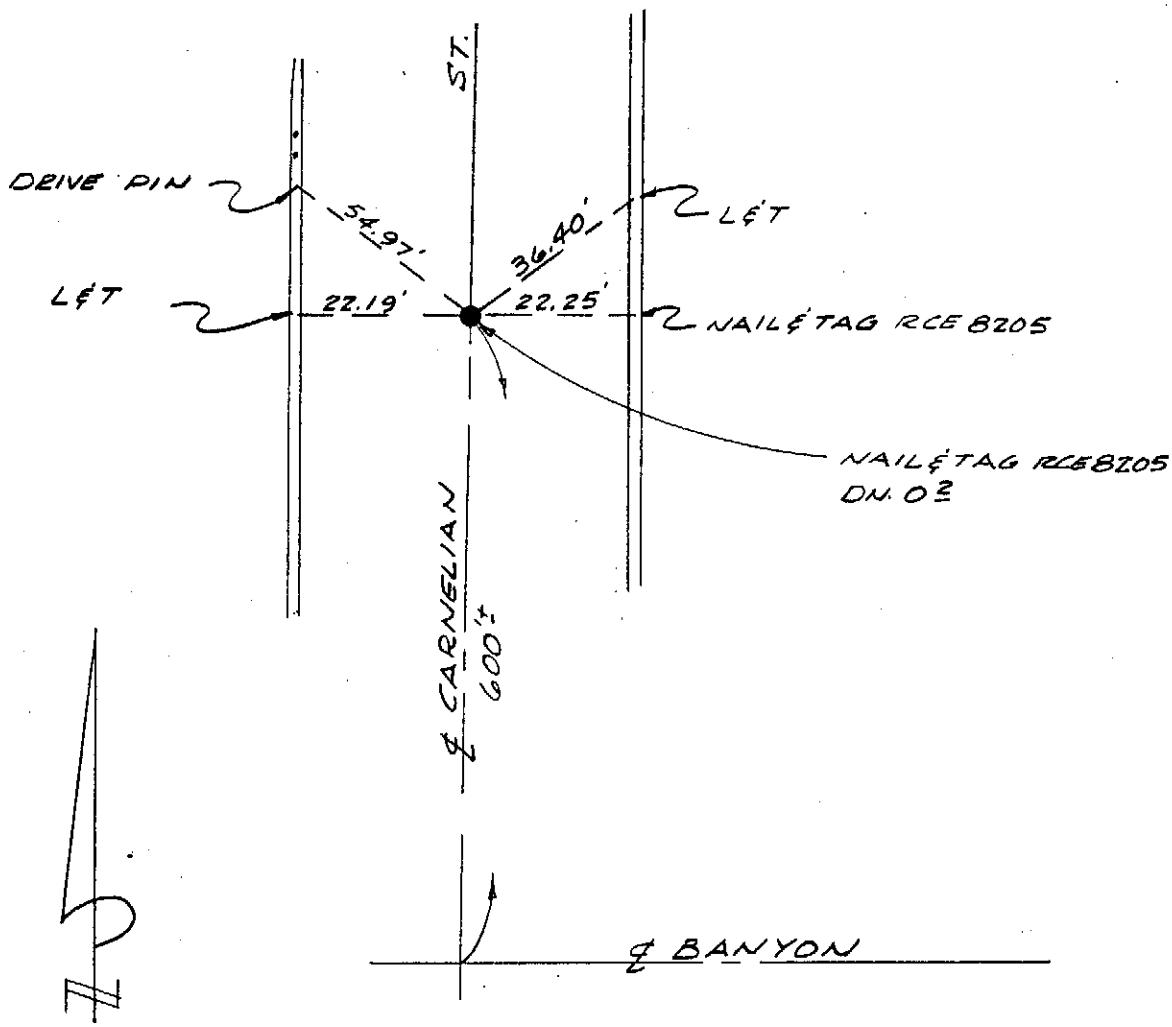

city of rancho cucamonga — STREET TIE	
	CARNELIAN ST.
ENGR./L.S. ROBERT A. HORN	FIELD REVIEW _____ DATE _____
~~R.C.E.~~/L.S. No. 4563 DATE DEC 82	TIE BOOK 6 PAGE 23

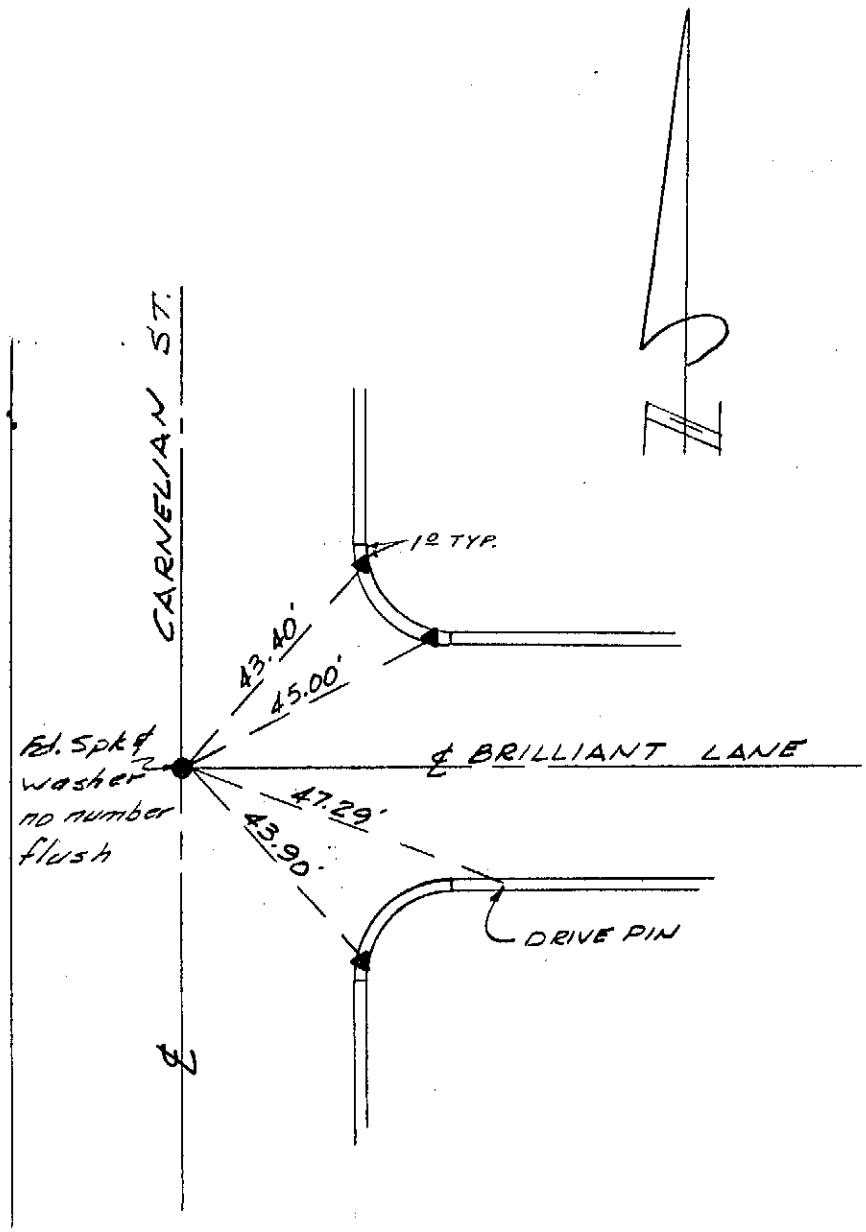

▲ Indicates chisel "+"

city of: rancho cucamonga — STREET TIE	
	CARNELIAN ST. & BRILLIANT LANE
~~ENGR.~~ / L.S. ROBERT A. HORN	FIELD REVIEW _____ DATE _____
~~R.C.E.~~ / L.S. No. 4563 DATE DEC 82	TIE BOOK 6 PAGE 24

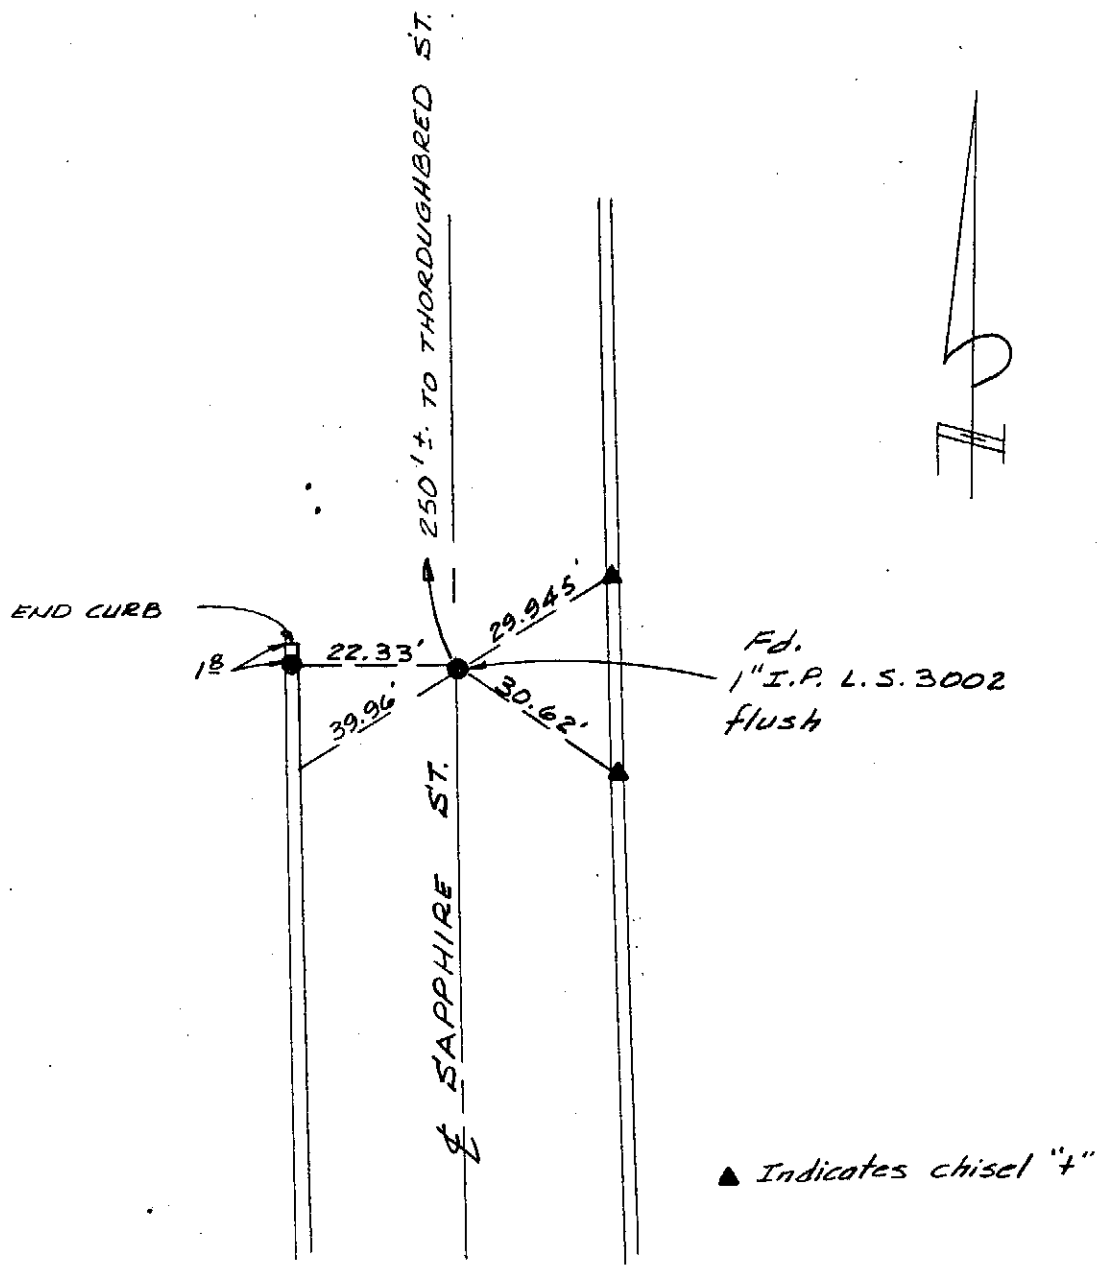

city of rancho cucamonga — STREET TIE	
	SAPPHIRE ST.
~~ENGR.~~ / L.S. ROBERT A. HORN	FIELD REVIEW _____ DATE _____
~~R.C.E.~~ / L.S. No. 4563 DATE DEC 82	TIE BOOK 6 PAGE 25

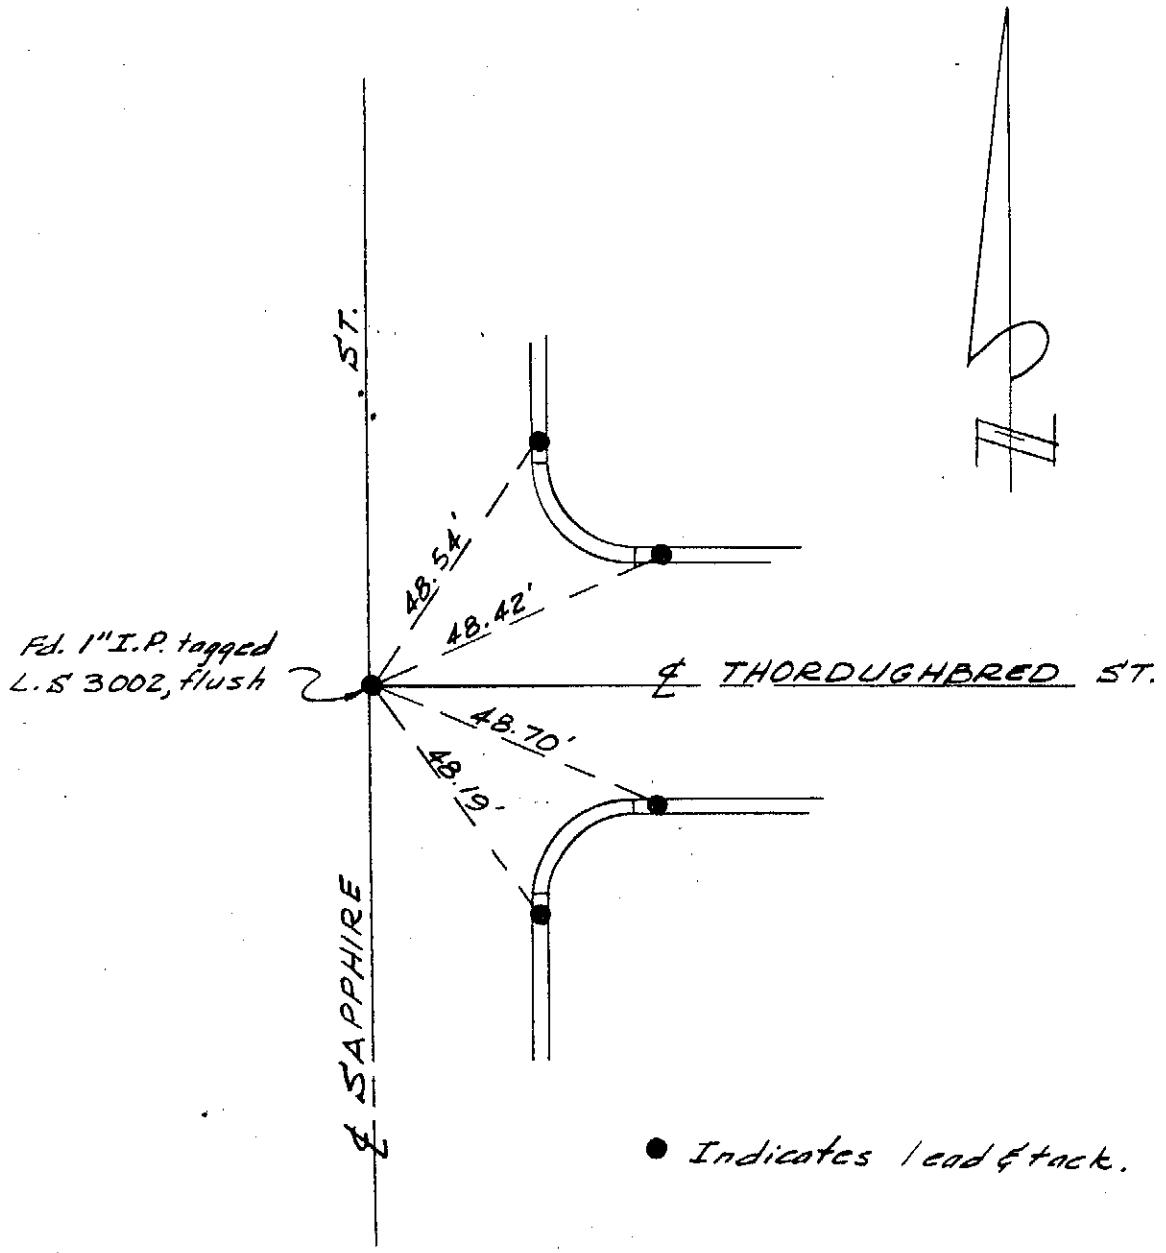

city of rancho cucamonga STREET TIE	
	SAPPHIRE ST. & THORDUGHBRED ST.
~~ENGR.~~ / L.S. ROBERT A HORN	FIELD REVIEW _____ DATE _____
~~R.O.E.~~ / L.S. No. 4563 DATE DEC 82	TIE BOOK 6 PAGE 26

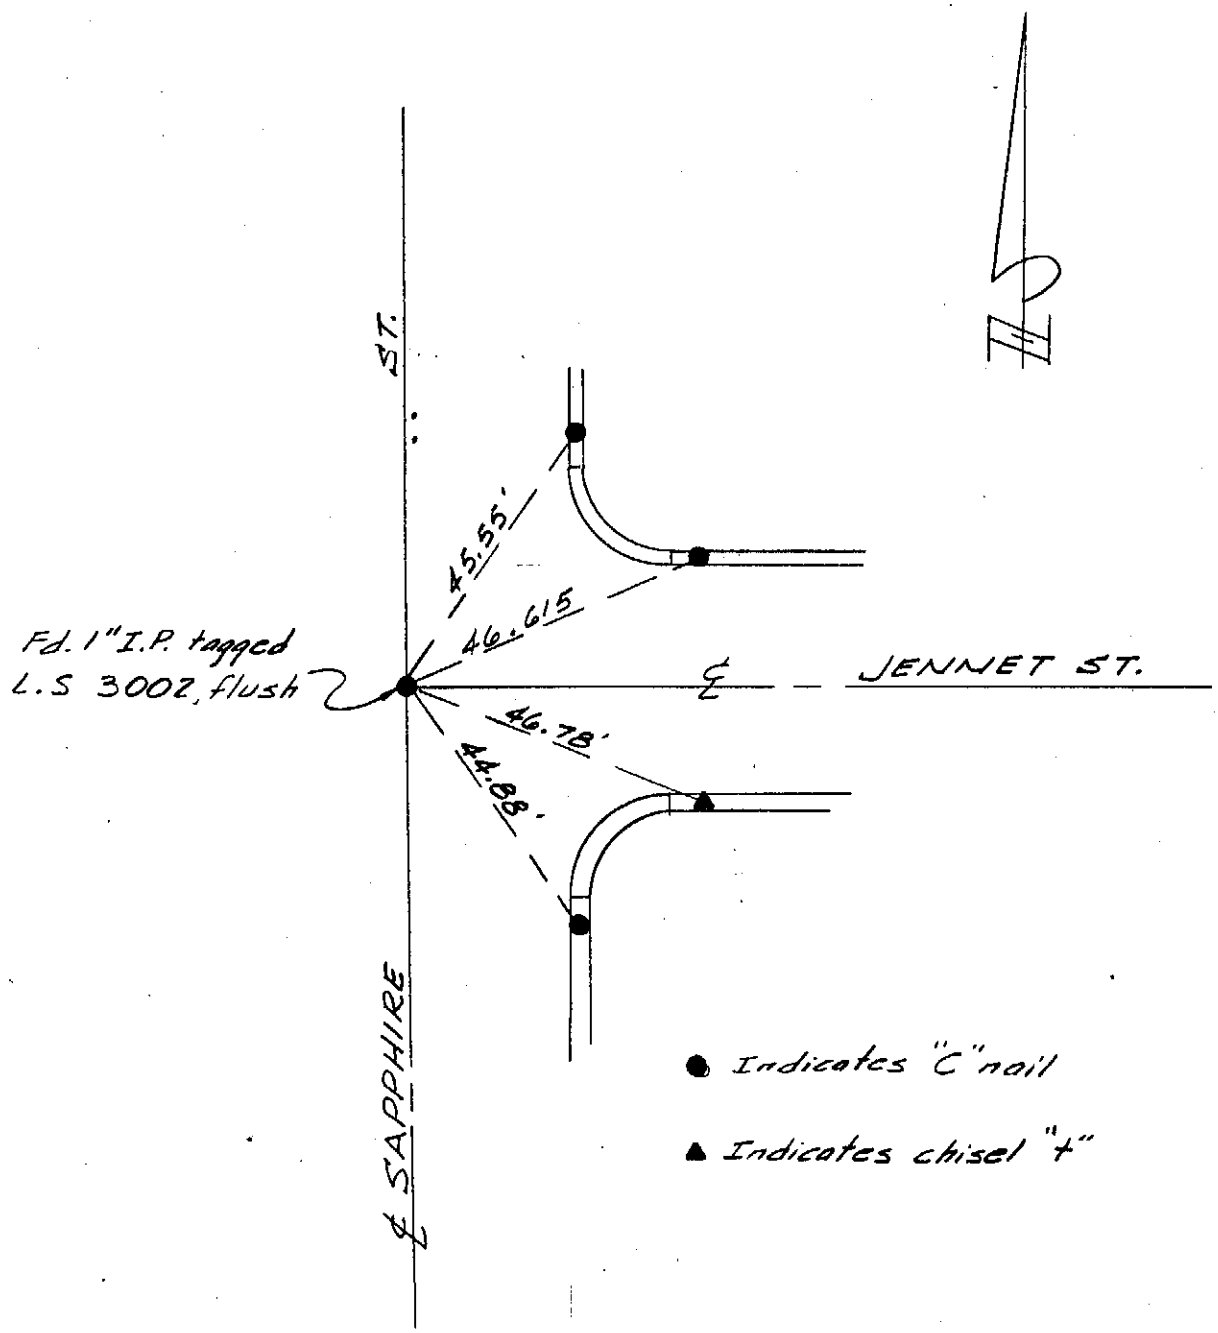

city of rancho cucamonga — STREET TIE	
	SAPPHIRE ST. ℄ JENNET ST.
~~ENGR.~~ / L.S. ROBERT A. HORN	FIELD REVIEW _____ DATE _____
~~R.C.E.~~ / L.S. No. 4563 DATE DEC 82	TIE BOOK 6 PAGE 27

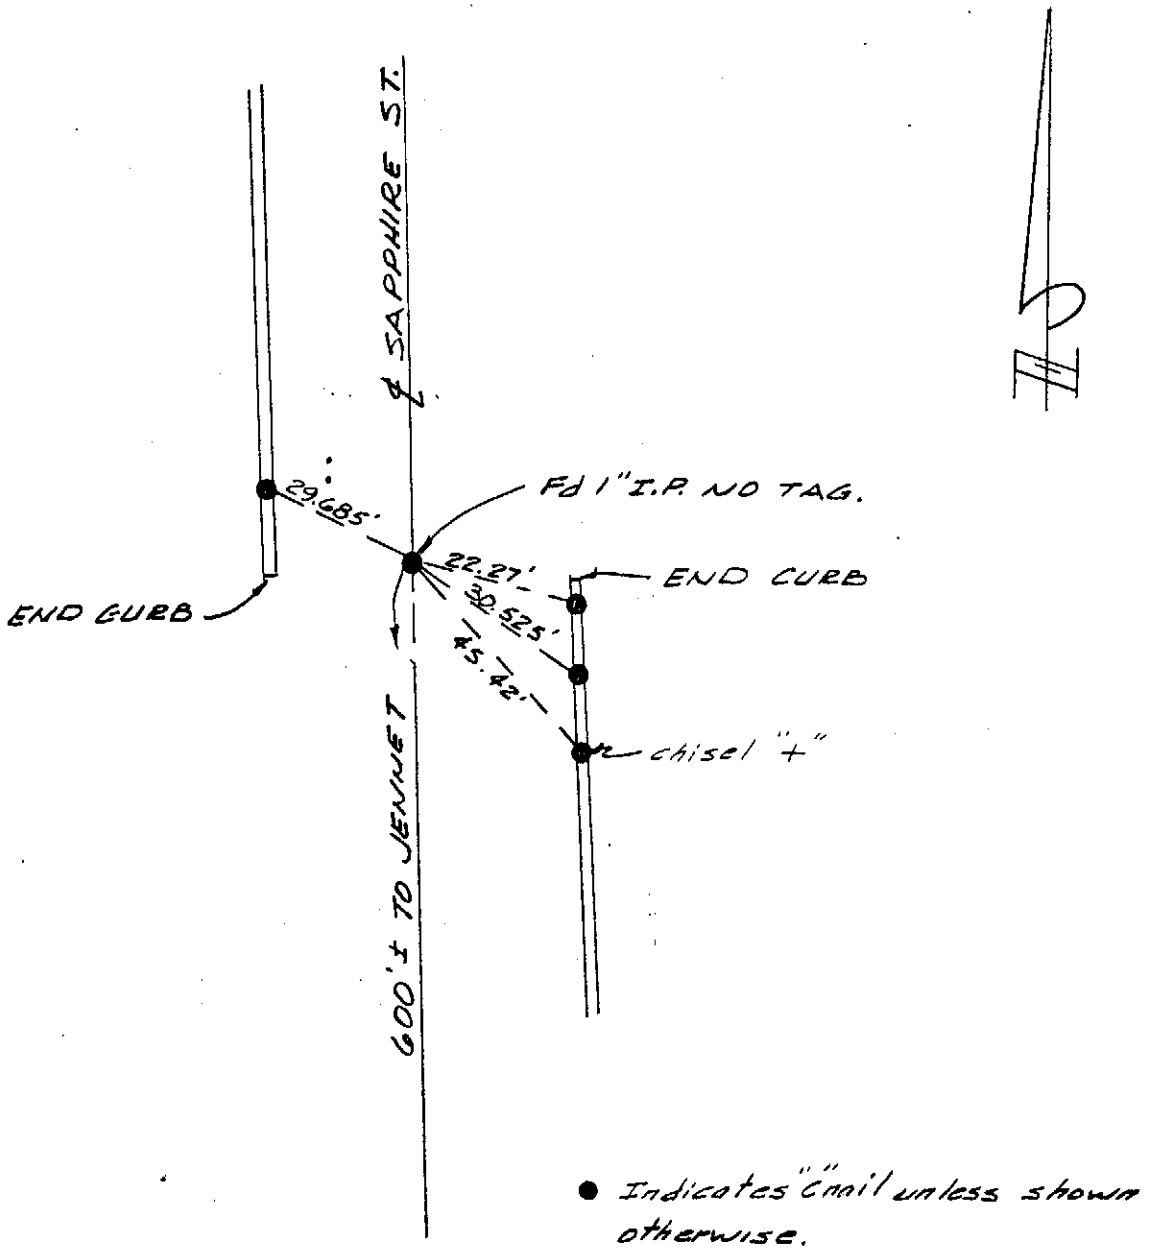

city of rancho cucamonga — STREET TIE	
	SAPPHIRE ST.
~~ENGR.~~ / L.S. ROBERT A. HORN	FIELD REVIEW _____ DATE _____
~~R.C.E.~~ / L.S. No. 4563 DATE DEC 82	TIE BOOK 6 PAGE 28

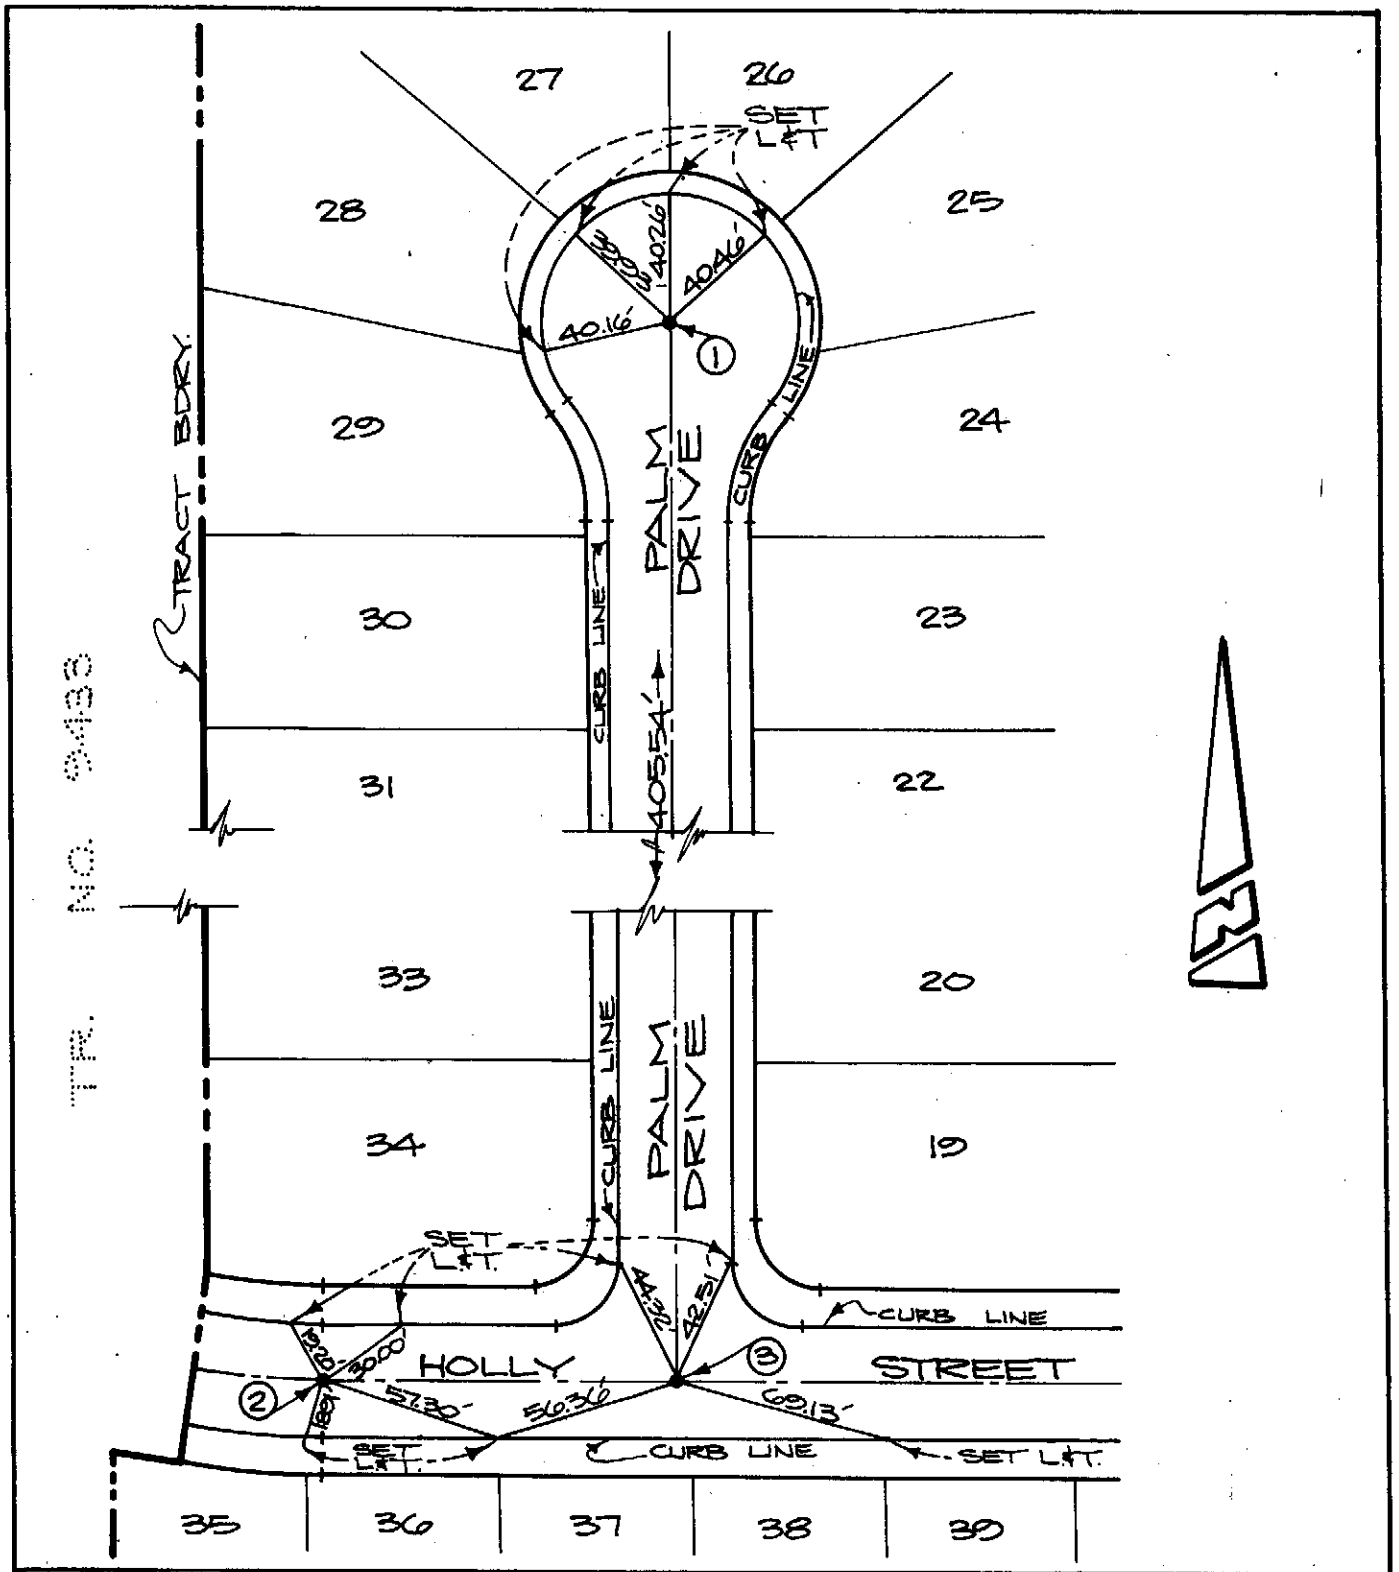

CITY of RANCHO CUCAMONGA — STREET TIE	TRACT No. **9435**
Madole & Associates, Inc. Consulting Civil Engineering and Land Planning 1820 E. 16th Street, Santa Ana, CA 92701 (714) 835-2548	PALM DRIVE AND HOLLY STREET MON. NO. 1, 2, 3
ENGINEER: J. M. Madole J. M. MADOLE R.C.E. 14814 DATE 8-16-83	FIELD REVIEW _____ DATE _____ TIE BOOK 6 PAGE 29

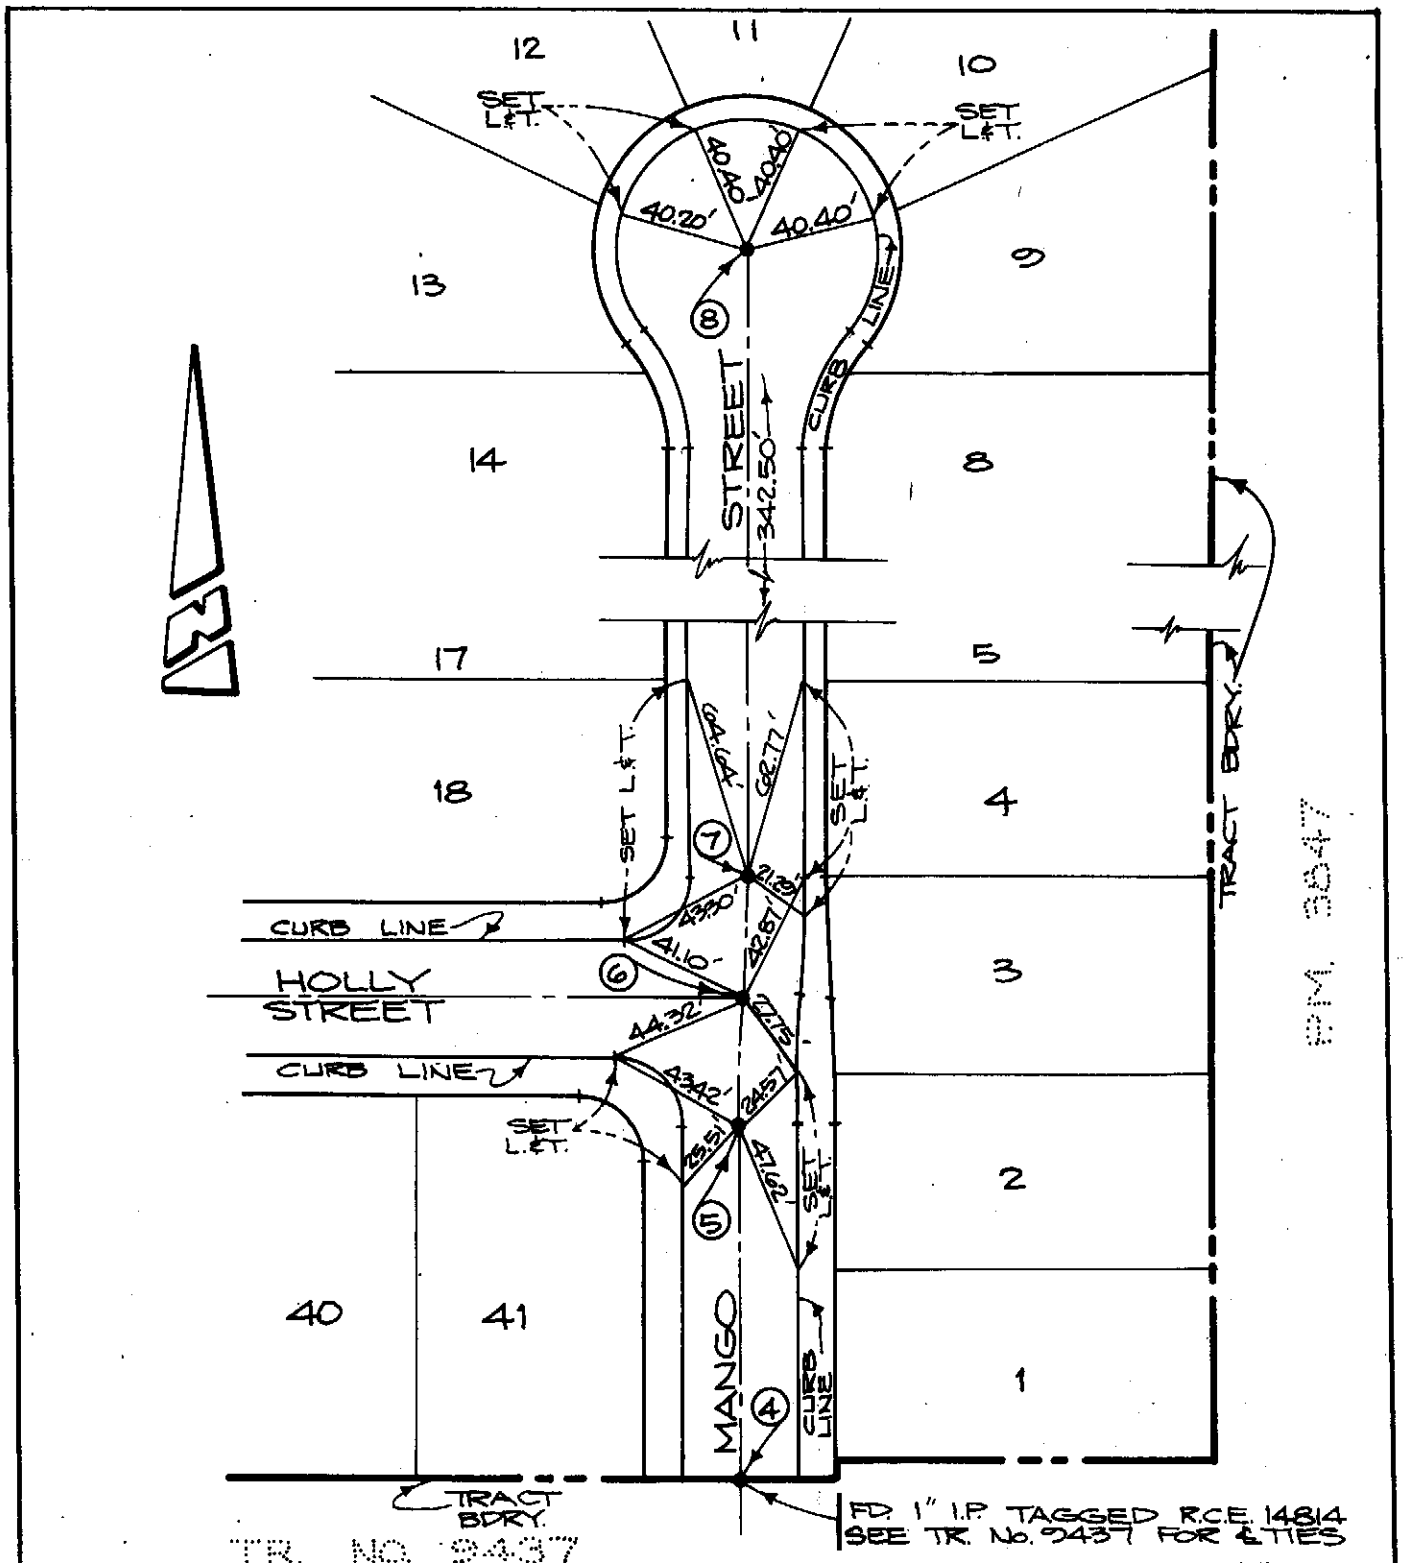

CITY of RANCHO CUCAMONGA — STREET TIE	TRACT No. **9435**
Madole & Associates, Inc. Consulting Civil Engineering and Land Planning 1820 E. 16th Street, Santa Ana, CA 92701 (714) 835-2548	MANGO STREET MON. NO. 4, 5, 6, 7, 8
ENGINEER: J. M. Madole J. M. MADOLE R.C.E. 14814 DATE 8-16-83	FIELD REVIEW _____ DATE _____ TIE BOOK 6 PAGE 30

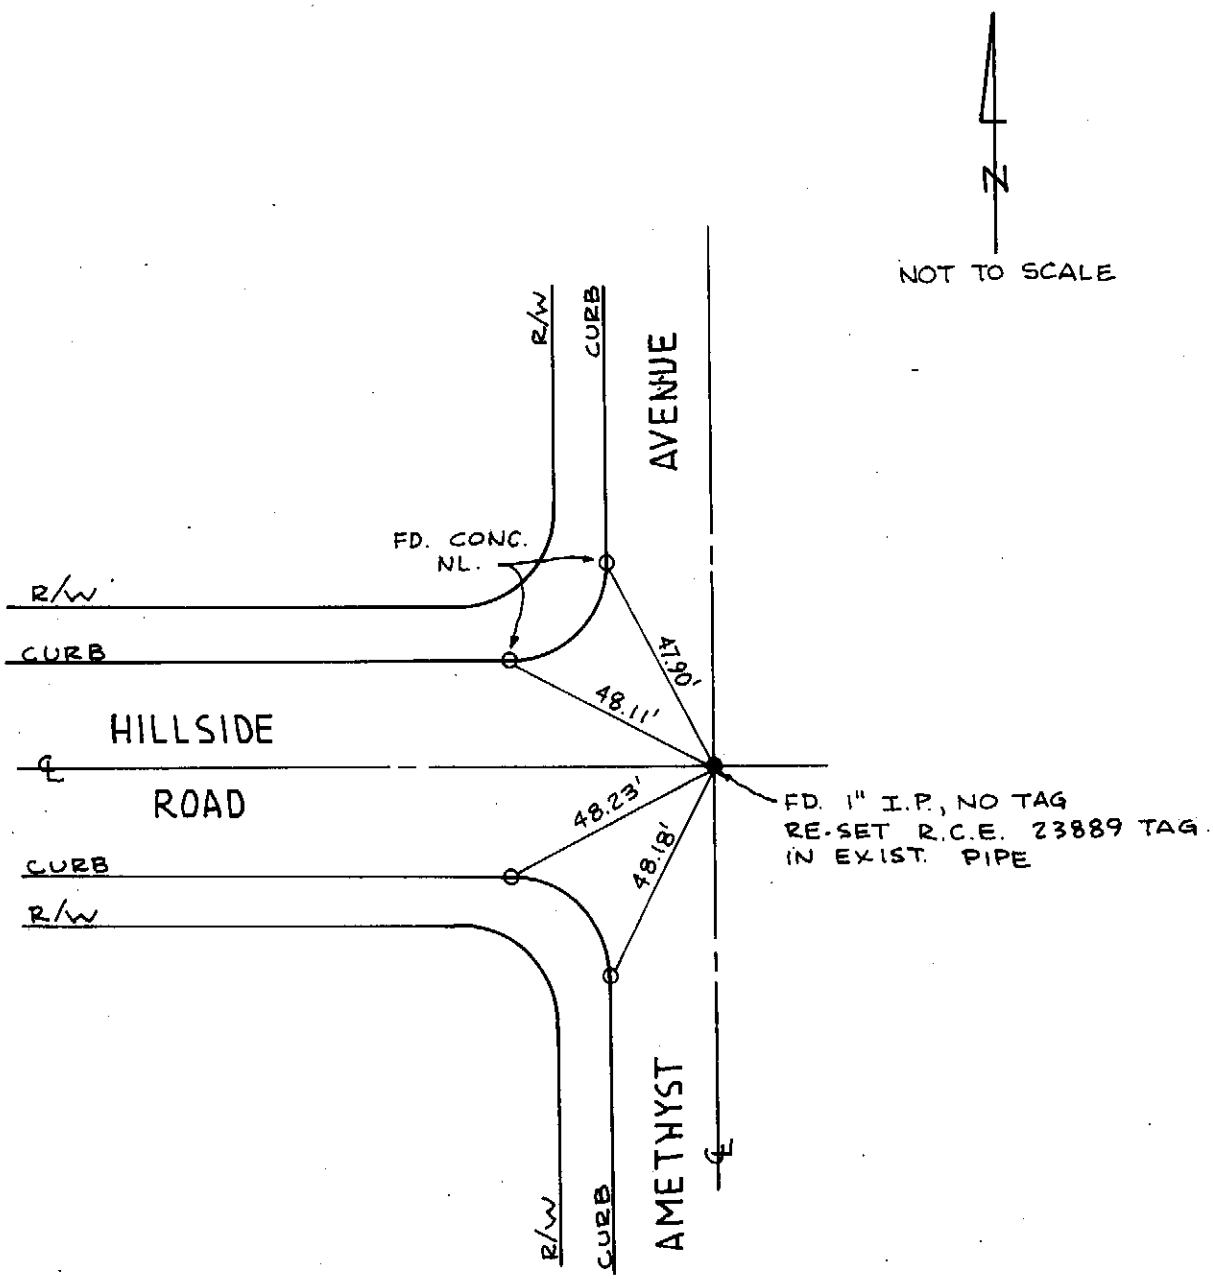

city of rancho cucamonga — STREET TIE	TRACT No. 9397
ASSOCIATED ENGINEERS 316 EAST E STREET ONTARIO, CA. 91764 (714) 986-5818	Centerline P.I., Hillside Rd. & Amethyst Ave.
ENGR/LLS. L.H. NOREEN	FIELD REVIEW ____ DATE ____
RCE/LLS. No. 3002 DATE 6/83	TIE BOOK 6 PAGE 31

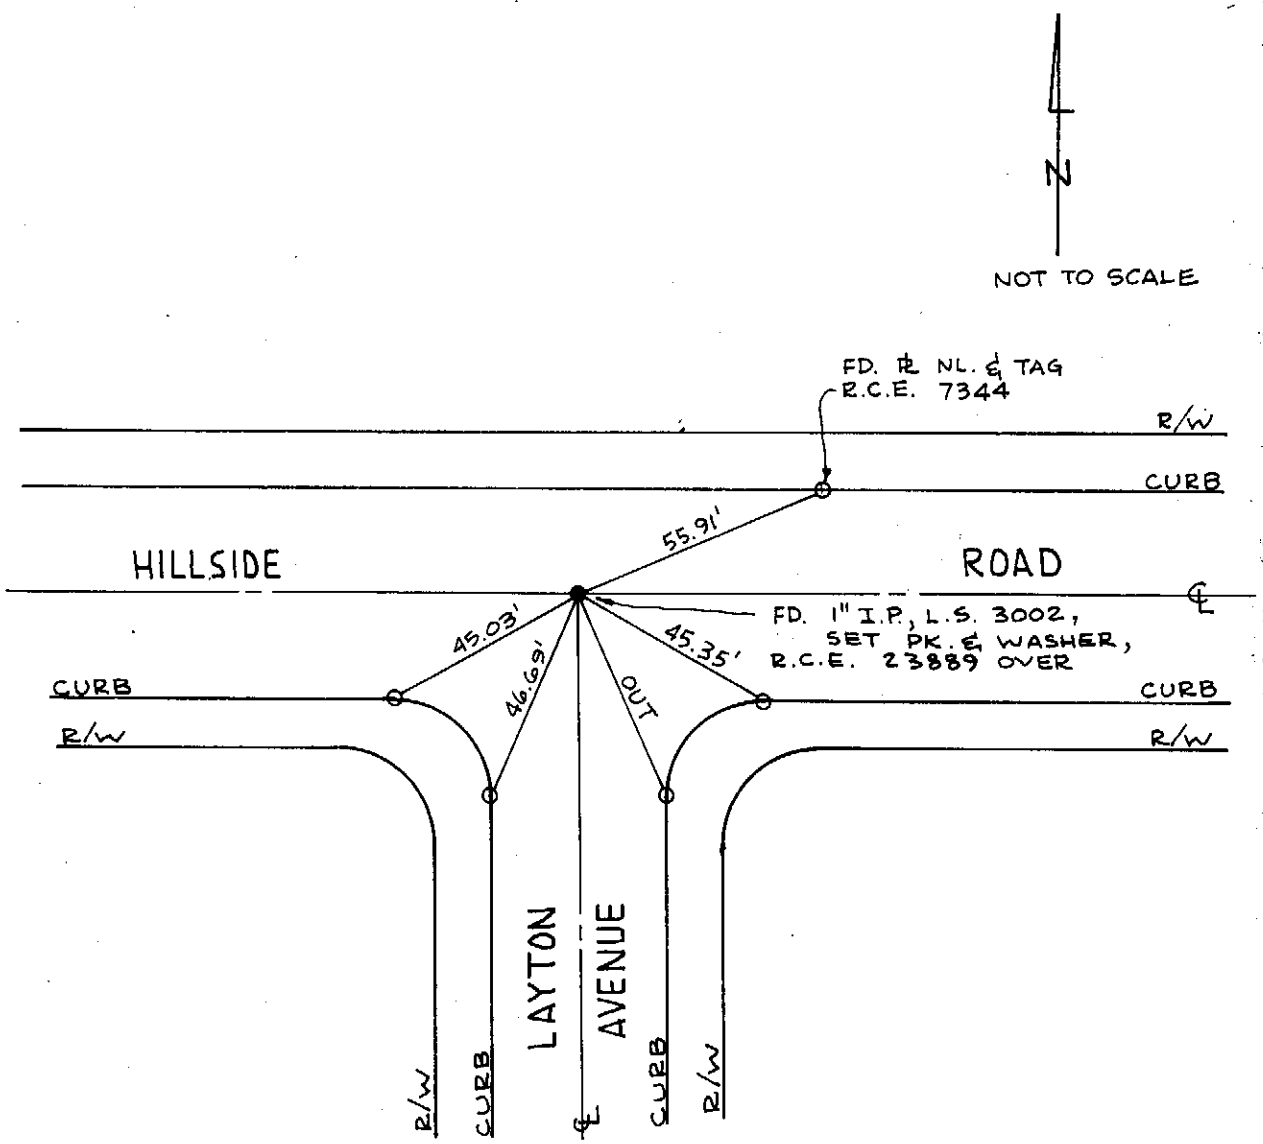

city of rancho cucamonga — STREET TIE	TRACT No. 9397
ASSOCIATED ENGINEERS 316 EAST E STREET ONTARIO, CA. 91764 (714) 986-5818	Centerline P.I., Hillside Rd. & Layton Ave.
~~ENGR.~~/L.S. L.H. NOREEN	FIELD REVIEW _____ DATE _____
~~R.C.E.~~/L.S. No. 3002 DATE 6/83	TIE BOOK 6 PAGE 32

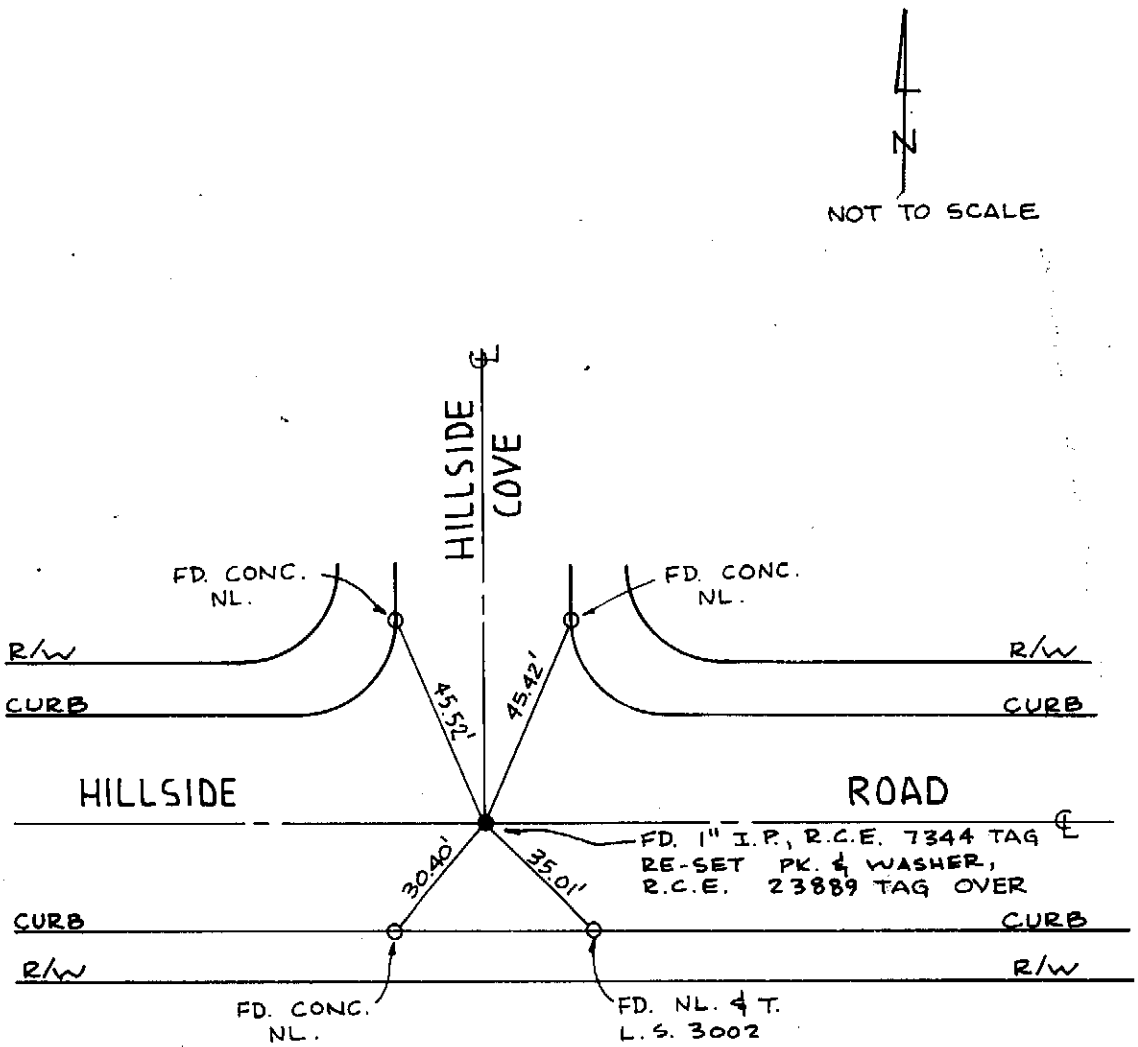

city of rancho cucamonga STREET TIE	TRACT No. 9397
ASSOCIATED ENGINEERS 316 EAST E STREET ONTARIO, CA. 91764 (714) 986-5818	Centerline P.I., Hillside Rd. & Hillside Cove
ENGR. / L.S. L.H. NOREEN	FIELD REVIEW _____ DATE _____
R.C.E. / L.S. No. 3002 DATE 6/83	TIE BOOK 6 PAGE 33

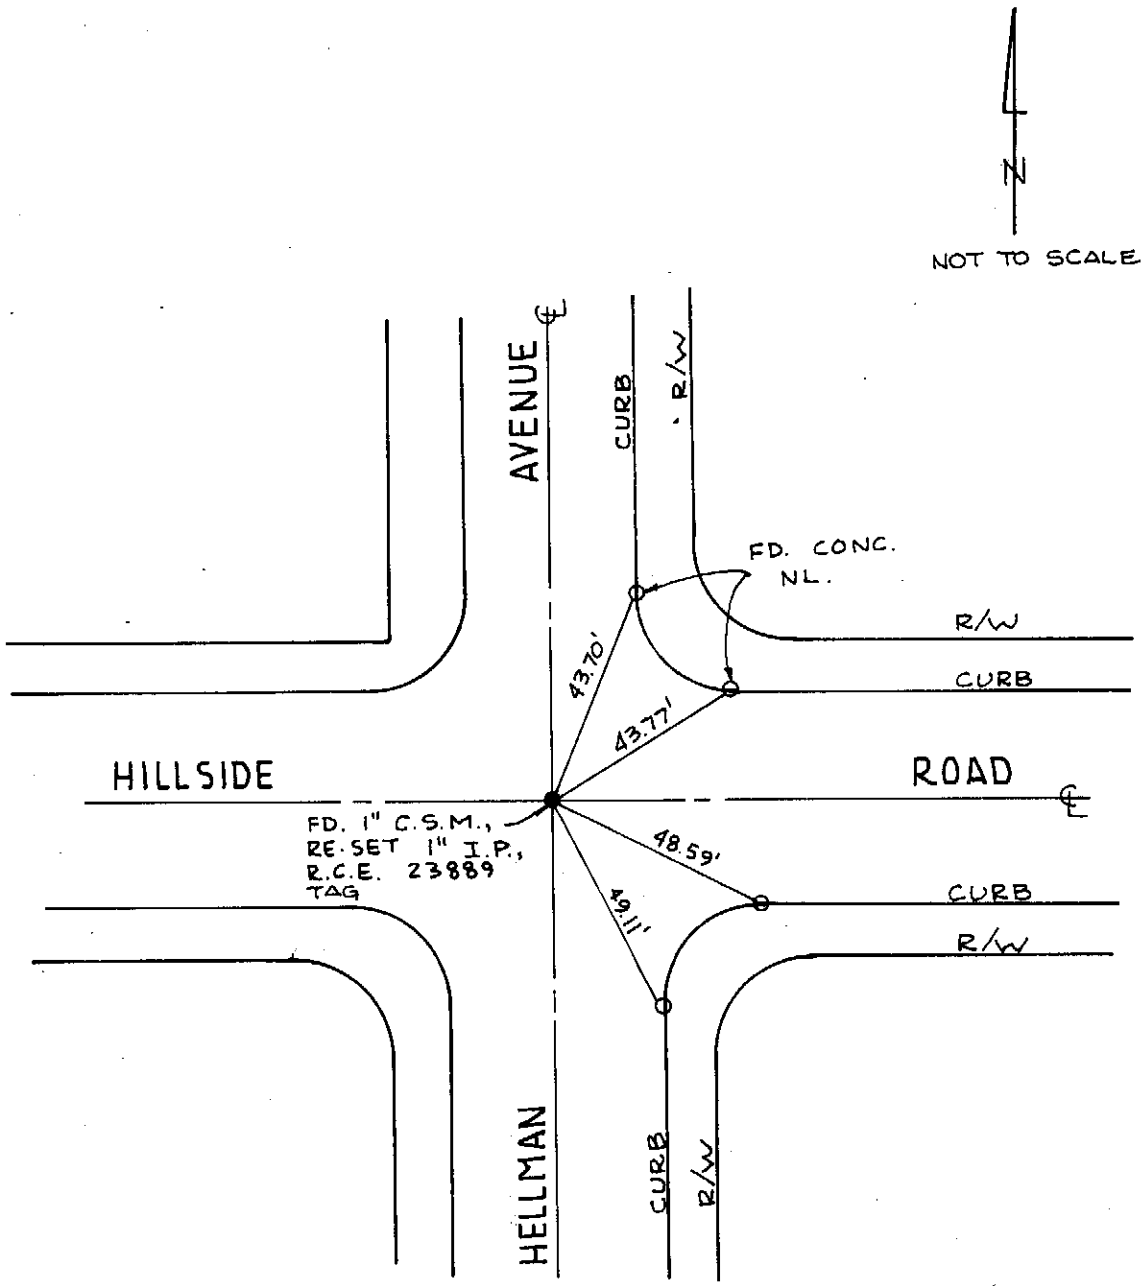

city of rancho cucamonga — STREET TIE	TRACT No. 9397
ASSOCIATED ENGINEERS 316 EAST E STREET ONTARIO, CA. 91764 (714) 986-5818	Centerline P.I., Hillside Rd. & Hellman Ave.
ENGR/L.S. L.H. NOREEN	FIELD REVIEW _____ DATE _____
R.C.E./L.S. No. 3002 DATE 6/83	TIE BOOK 6 PAGE 34

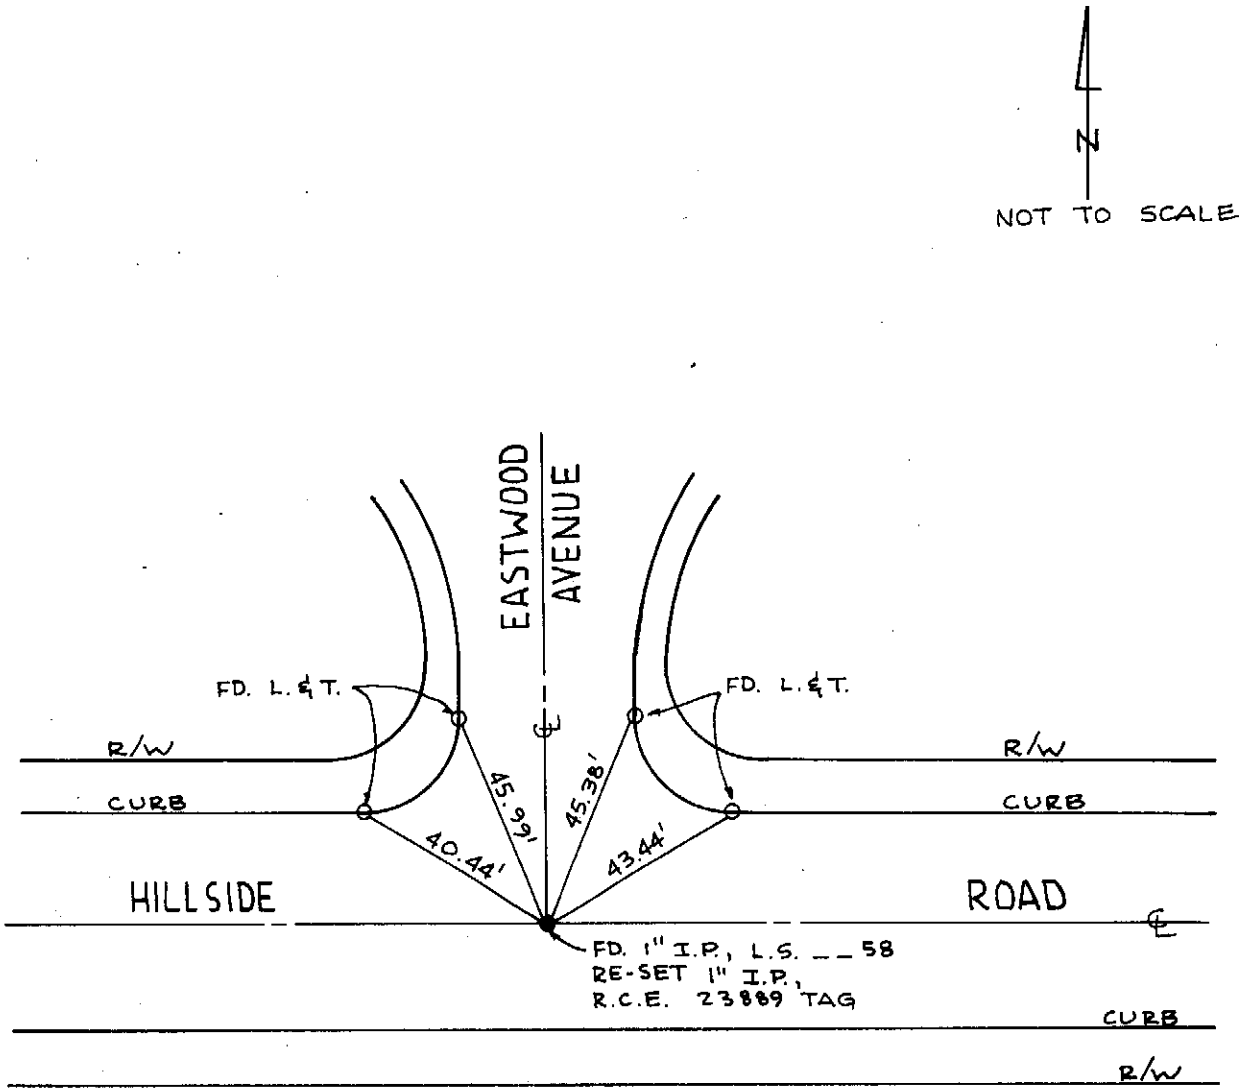

city of rancho cucamonga — STREET TIE	TRACT No. 9397
ASSOCIATED ENGINEERS 316 EAST E STREET ONTARIO, CA 91764 (714) 986-5818	Centerline P.I., Hillside Rd. & Eastwood Ave.
ENGR./L.S. L.H. NOREEN	FIELD REVIEW ____ DATE ____
R.C.E./L.S. No. 3002 DATE 6/83	TIE BOOK 6 PAGE 35

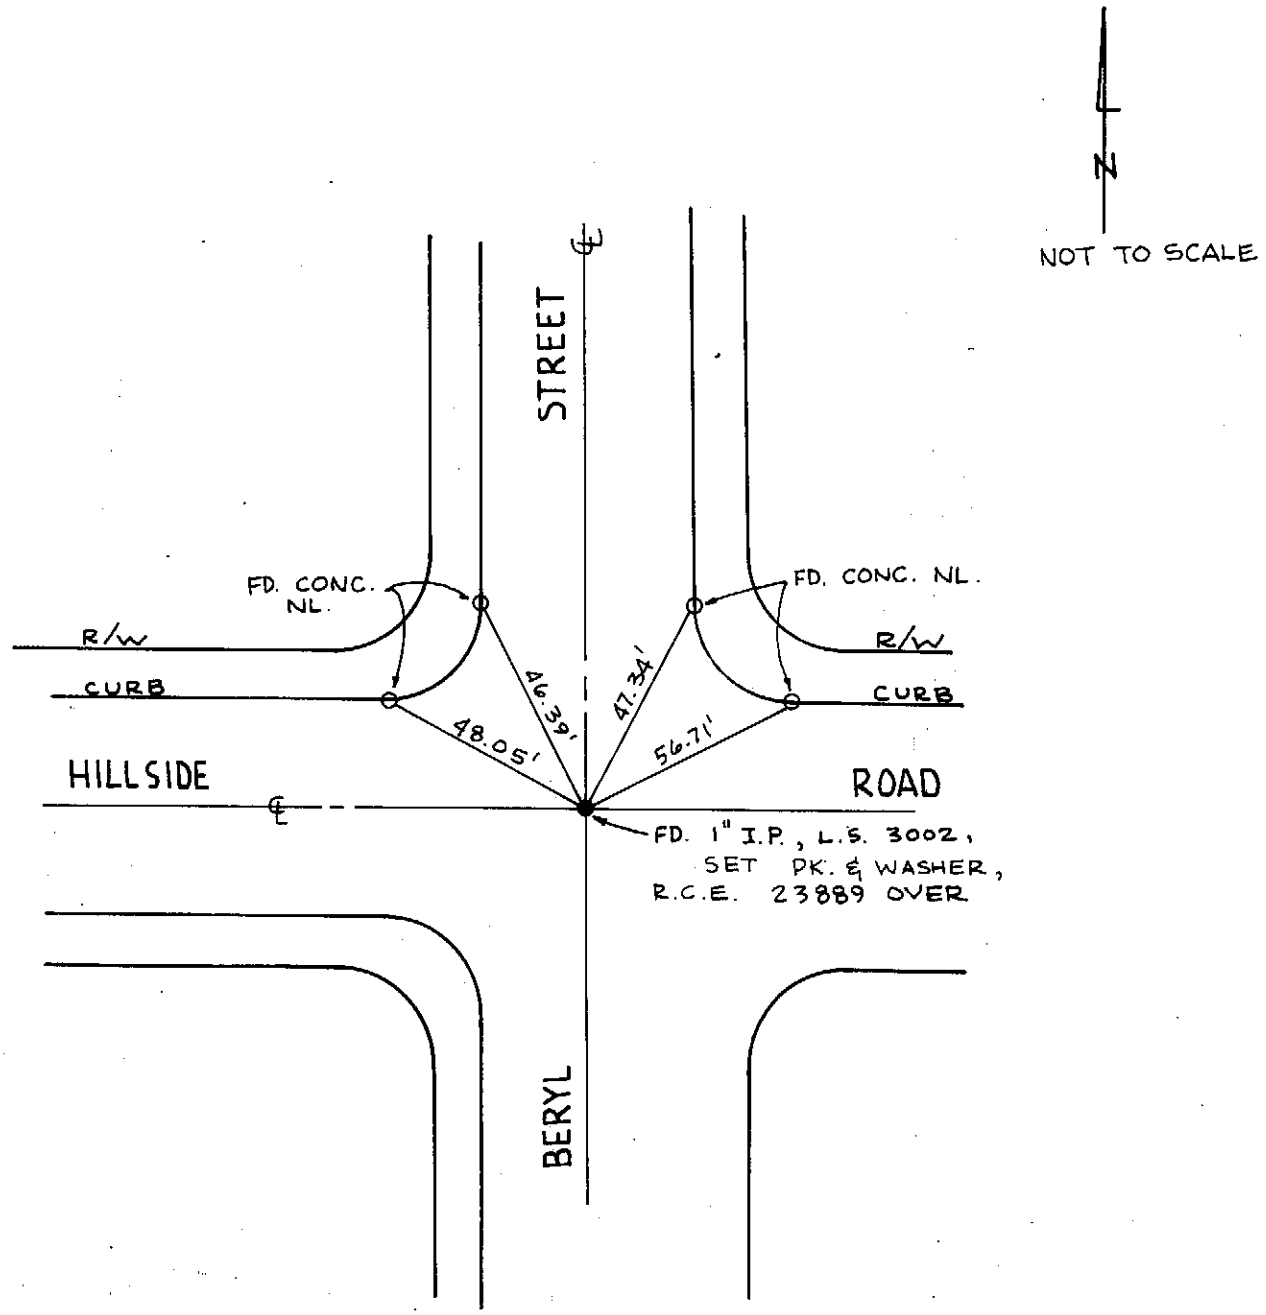

city of rancho cucamonga — STREET TIE	TRACT No. 9397
ASSOCIATED ENGINEERS 316 EAST E STREET ONTARIO, CA. 91764 (714) 986-5818	Centerline P.I., Hillside Rd. & Beryl St.
ENGR./L.S. L.H. NOREEN	FIELD REVIEW _____ DATE _____
R.C.E./L.S. No. 3002 DATE 6/83	TIE BOOK 6 PAGE 36

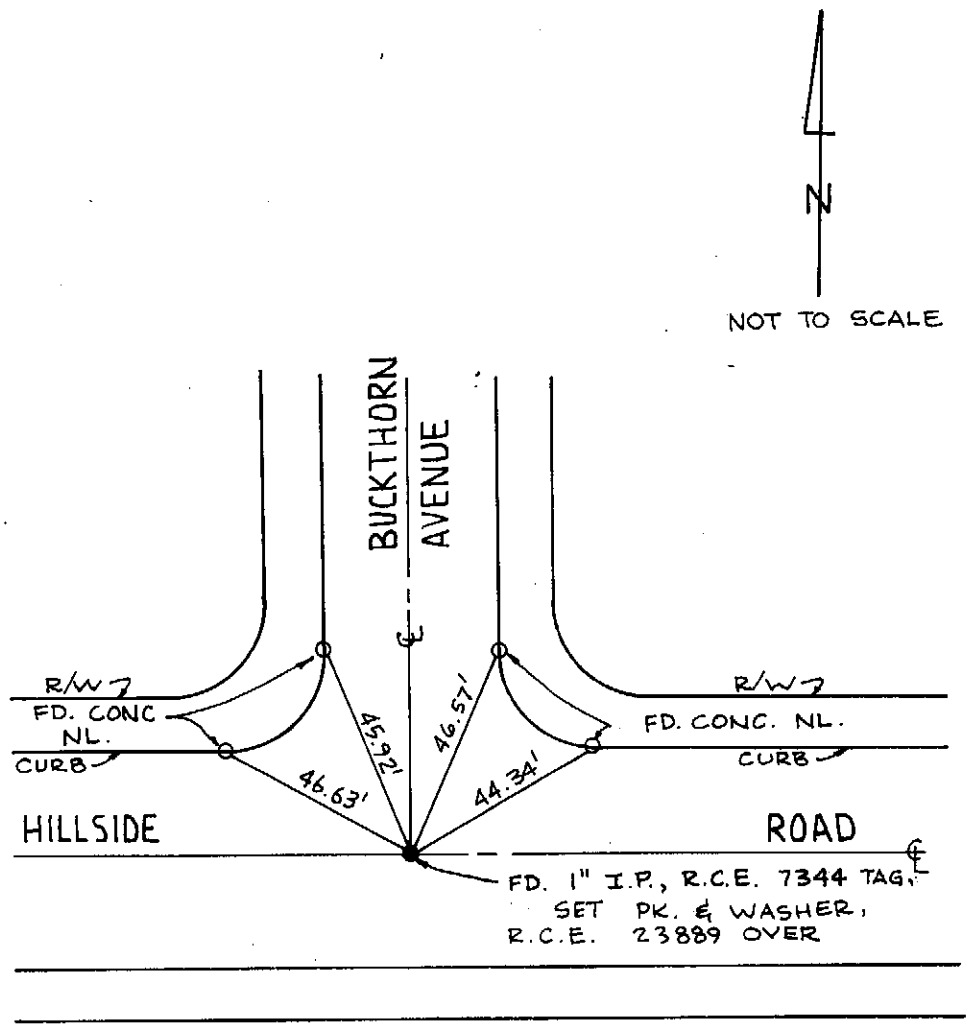

city of rancho cucamonga STREET TIE	TRACT No. 9397
ASSOCIATED ENGINEERS 316 EAST E STREET ONTARIO, CA. 91764 (714) 986-5818	Centerline P.I., Hillside Rd. & Buckthorn Ave.
ENGR. / L.S. L.H. NOREEN	FIELD REVIEW _____ DATE _____
R.C.E. / L.S. No. 3002 DATE 6/83	TIE BOOK 6 PAGE 37

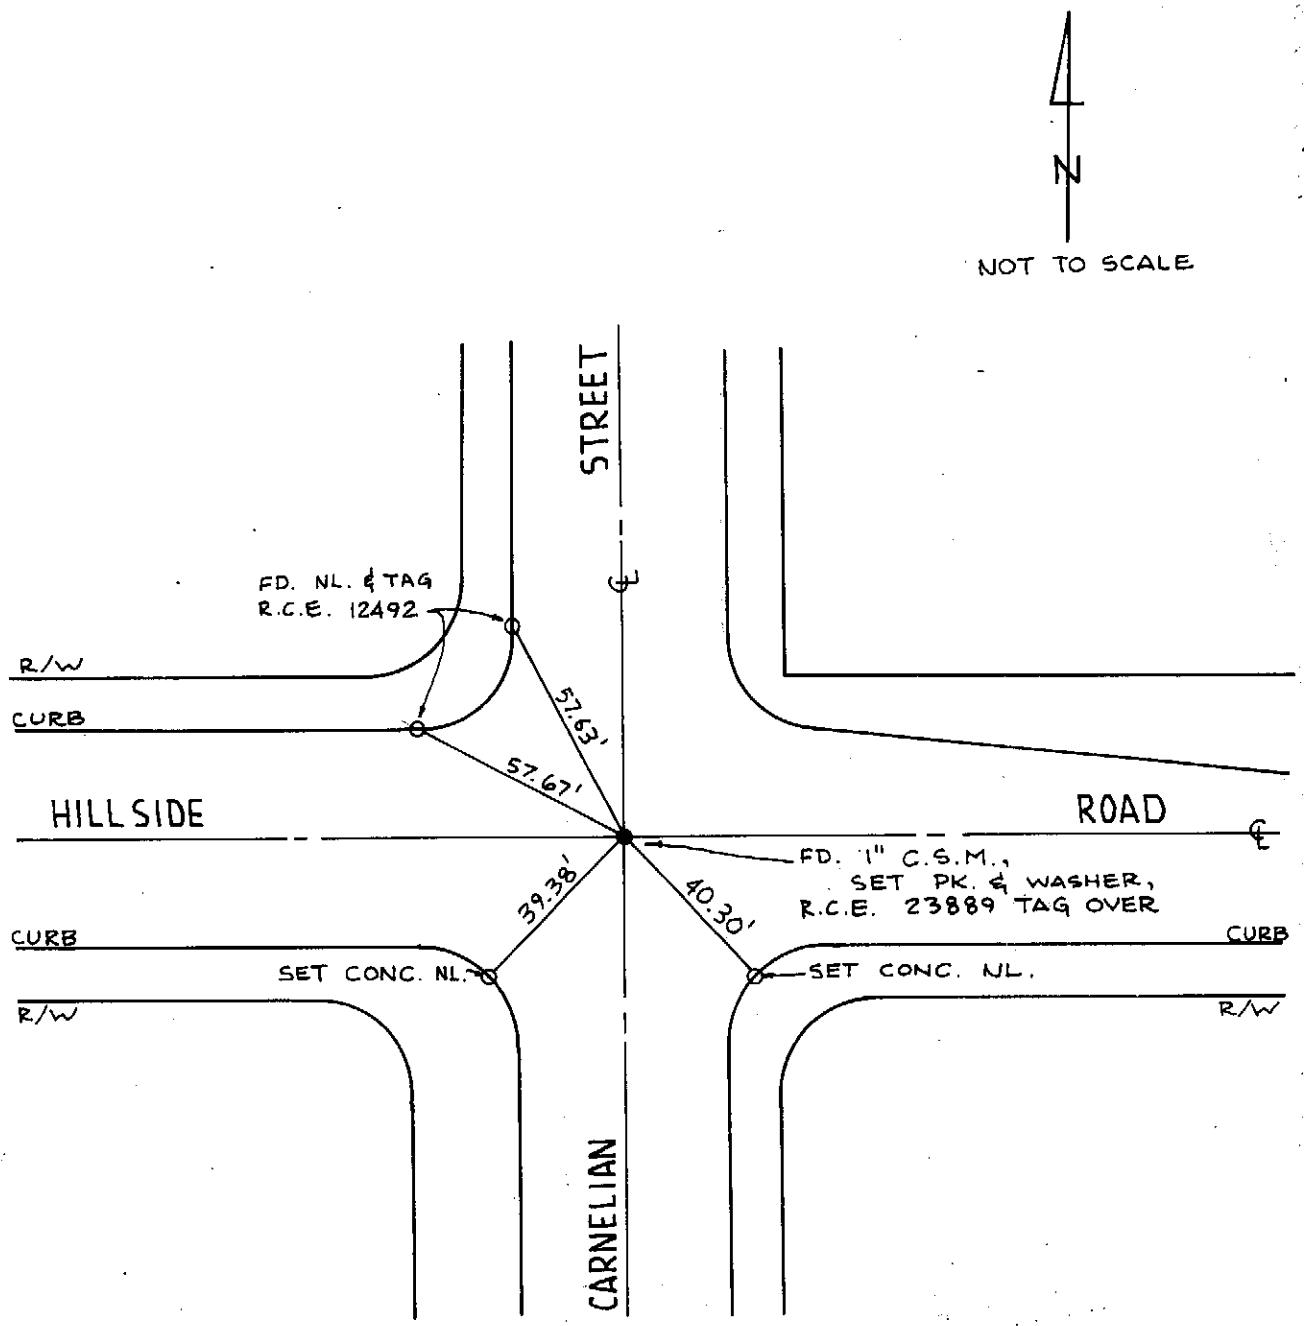

city of rancho cucamonga — STREET TIE	TRACT No. 9397
ASSOCIATED ENGINEERS 316 EAST E STREET ONTARIO, CA. 91764 (714) 986-5818	Centerline P.I., Hillside Rd. & Carnelian St.
~~ENGR.~~ / L.S. L.H. NOREEN	FIELD REVIEW _____ DATE _____
~~R.C.E.~~ / L.S. No. 3002 DATE 6/83	TIE BOOK 6 PAGE 38

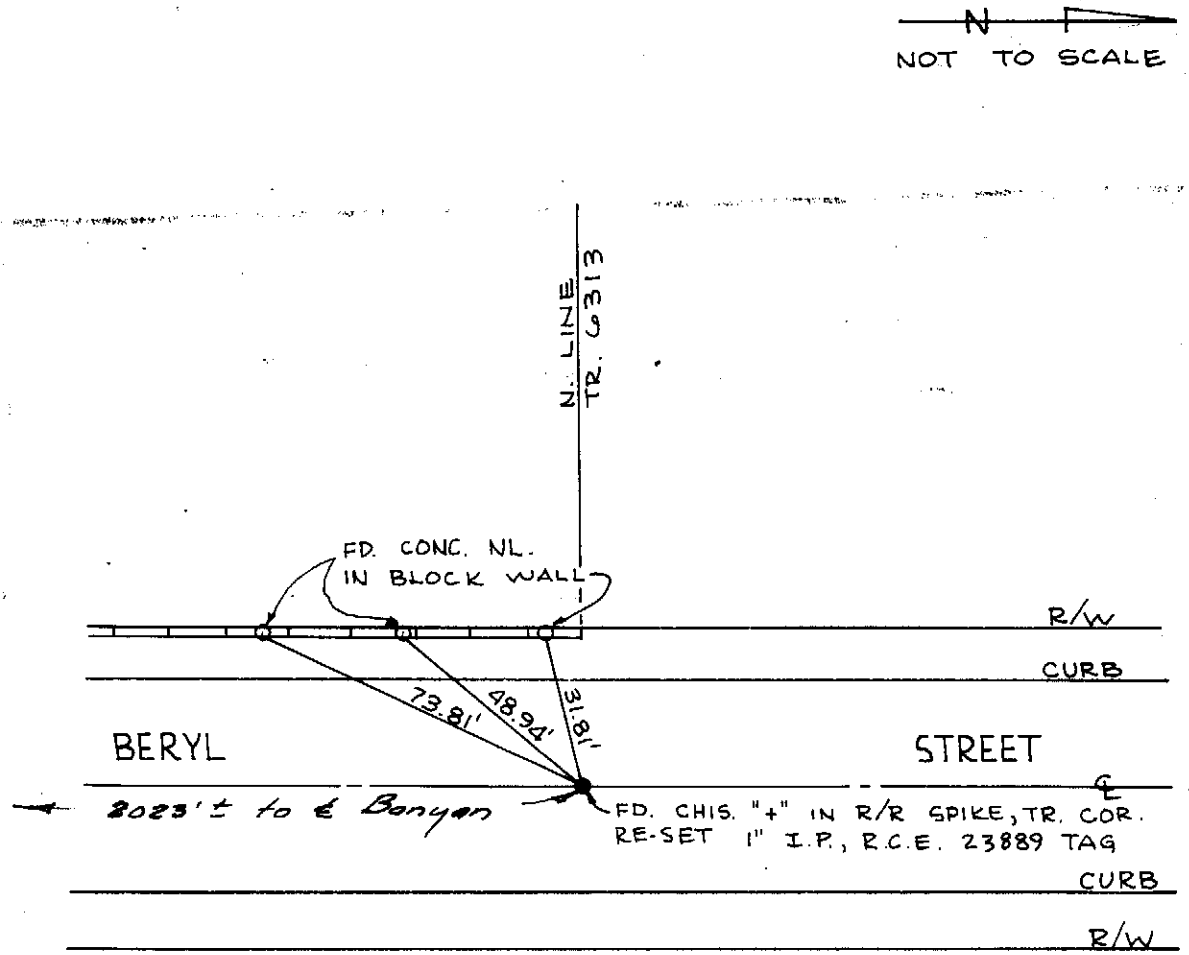

city of rancho cucamonga — STREET TIE	TRACT No. ~~9322~~
ASSOCIATED ENGINEERS 316 EAST E STREET ONTARIO, CA. 91764 (714) 986-5818	℄ Beryl St., midway between Banyan St. & Hillside Rd.
~~ENGR.~~ / L.S. L.H. NOREEN	FIELD REVIEW _____ DATE _____
~~R.C.E.~~ / L.S. No. 3002 DATE 6/83	TIE BOOK 6 PAGE 39

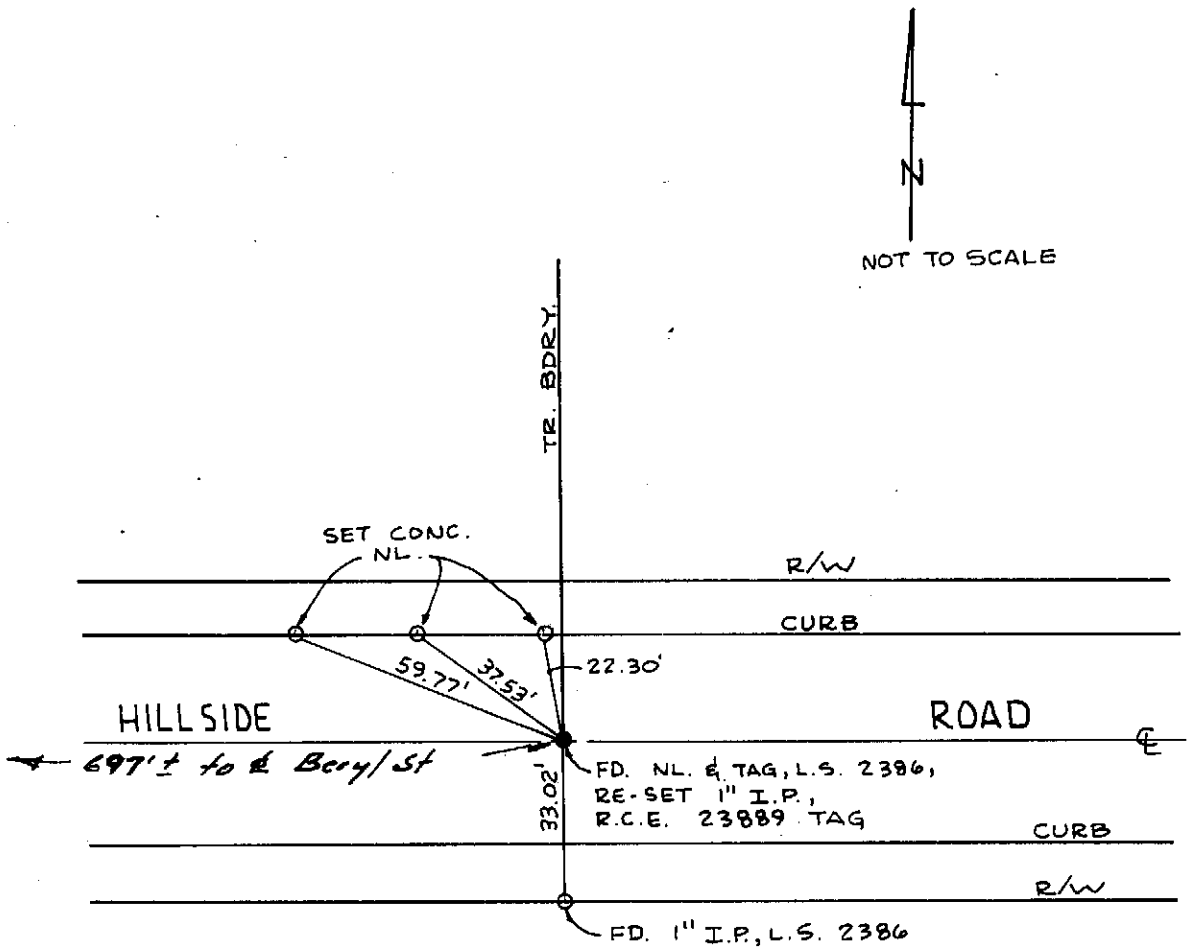

City of Rancho Cucamonga STREET TIE	TRACT No. 9397
ASSOCIATED ENGINEERS 316 EAST E STREET ONTARIO, CA. 91764 (714) 986-5818	℄ Hillside Rd., midway between Carnelian & Beryl Sts.
ENGR/LS.S. L.H. NOREEN	FIELD REVIEW ____ DATE ____
RCE/LS.S. No. 3002 DATE 6/83	TIE BOOK 6 PAGE 40

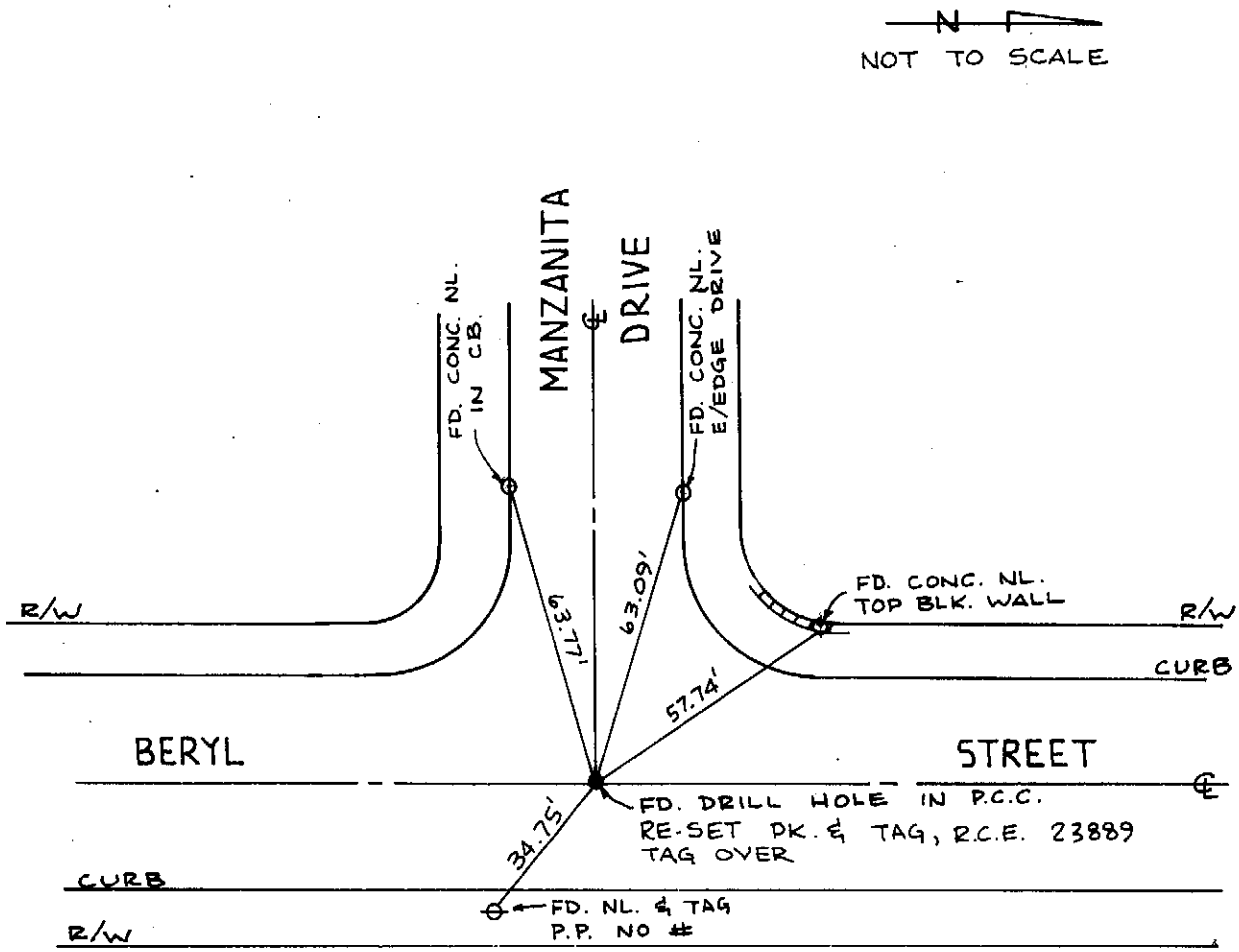

city of rancho cucamonga — STREET TIE	TRACT No. 9397
ASSOCIATED ENGINEERS 316 EAST E STREET ONTARIO, CA. 91764 (714) 986-5818	Centerline P.I., Beryl St. & Manzanita Dr.
~~ENGR.~~/L.S. L.H. NOREEN	FIELD REVIEW _____ DATE _____
~~R.C.E.~~/L.S. No. 3002 DATE 6/83	TIE BOOK 6 PAGE 41

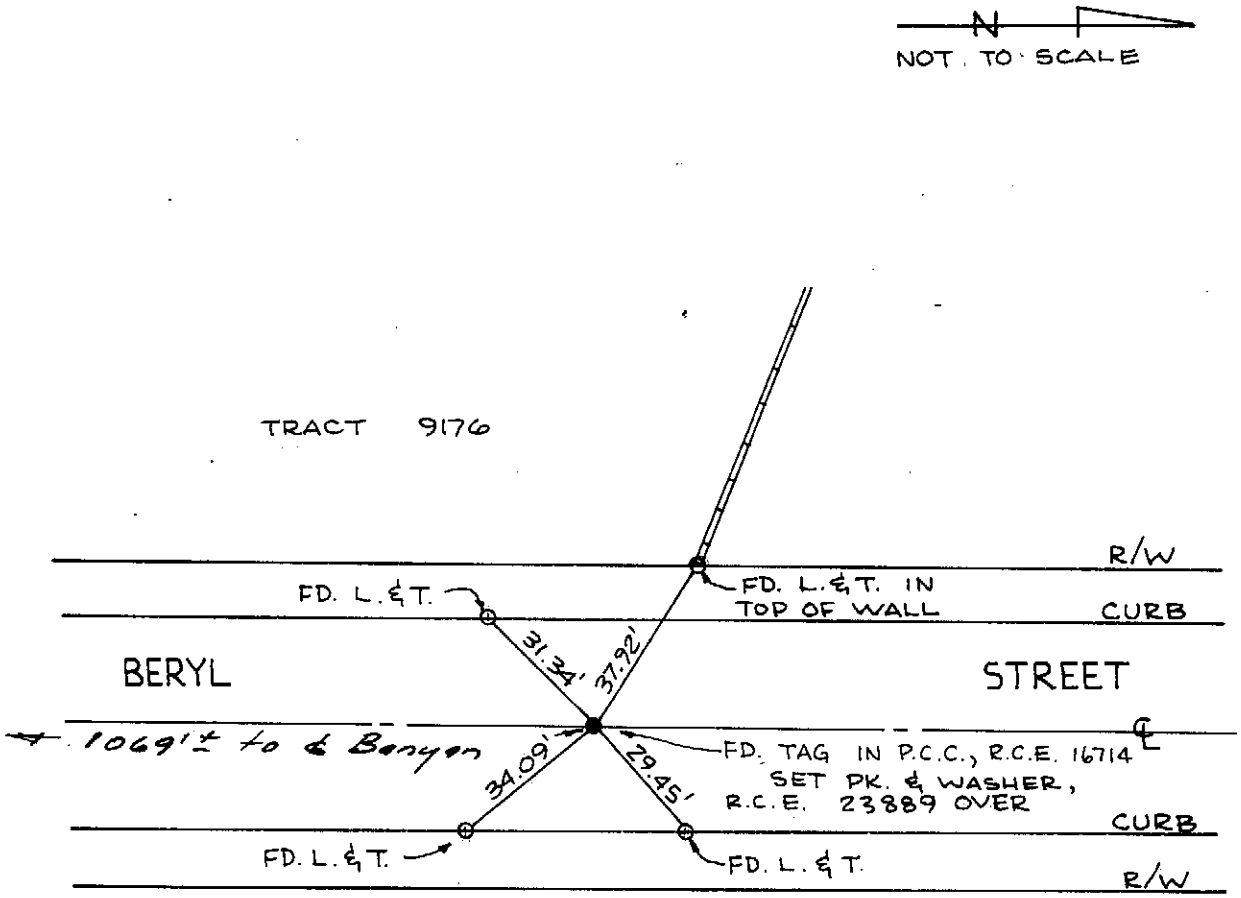

city of rancho cucamonga — STREET TIE	TRACT No. 9397
ASSOCIATED ENGINEERS 316 EAST E STREET ONTARIO, CA. 91764 (714) 986-5818	℄ Beryl St., approx. 1000' North of Banyan St.
ENGR./L.S. L.H. NOREEN	FIELD REVIEW _____ DATE _____
R.C.E./L.S. No. 3002 DATE 6/83	TIE BOOK 6 PAGE 42

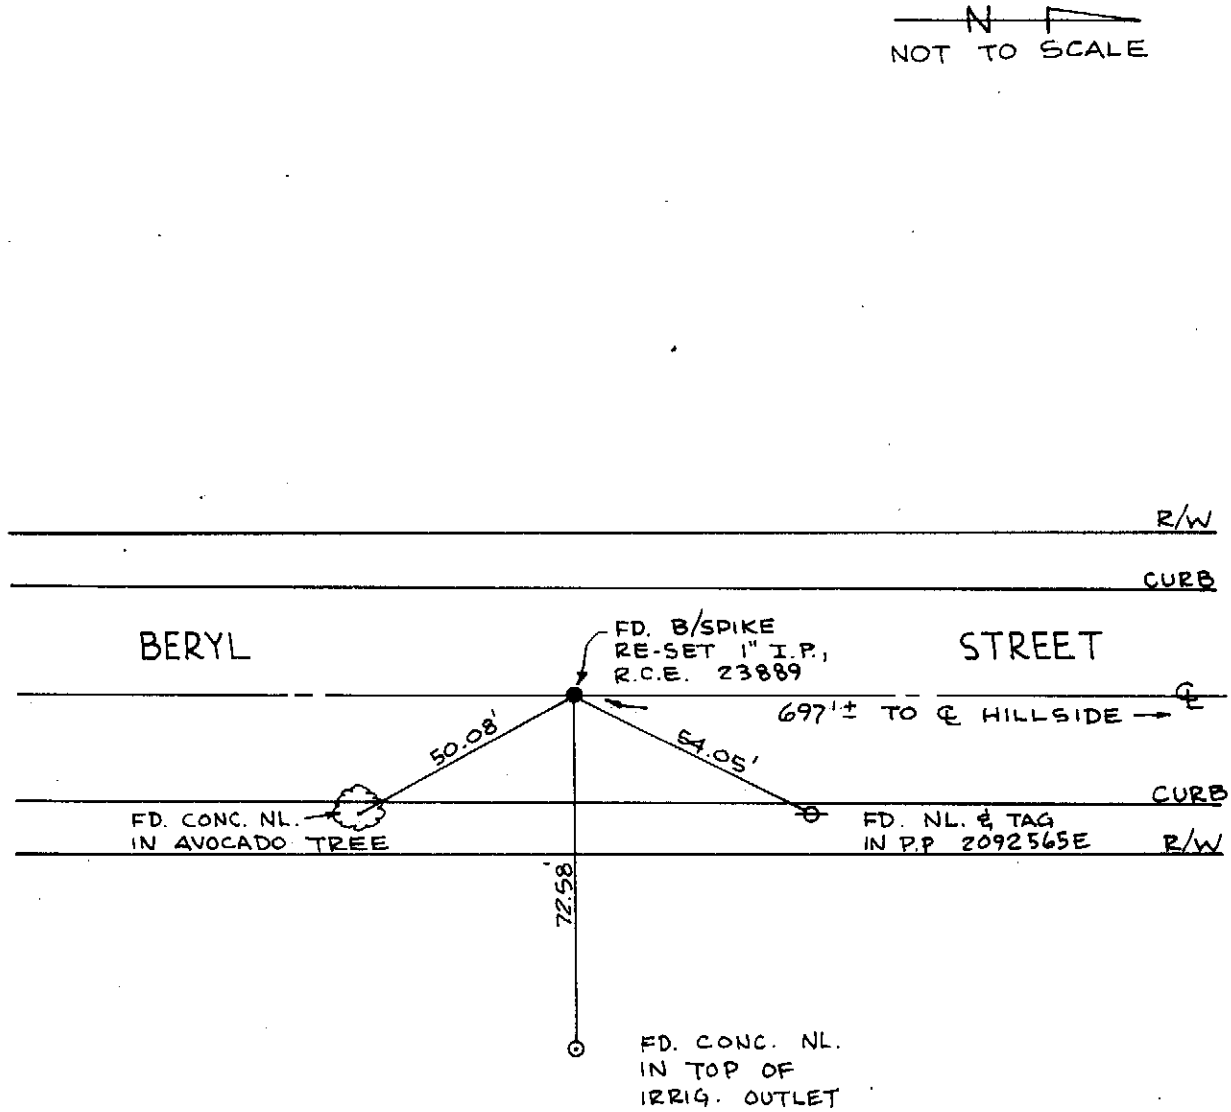

city of rancho cucamonga — STREET TIE	TRACT No. 9397
ASSOCIATED ENGINEERS 316 EAST E STREET ONTARIO, CA. 91764 (714) 986-5818	℄ Beryl St., approx. 700' South of Hillside Rd.
~~ENGR.~~ / L.S. L.H. NOREEN	FIELD REVIEW _____ DATE _____
~~R.C.E.~~ / L.S. No. 3002 DATE 6/83	TIE BOOK 6 PAGE 43

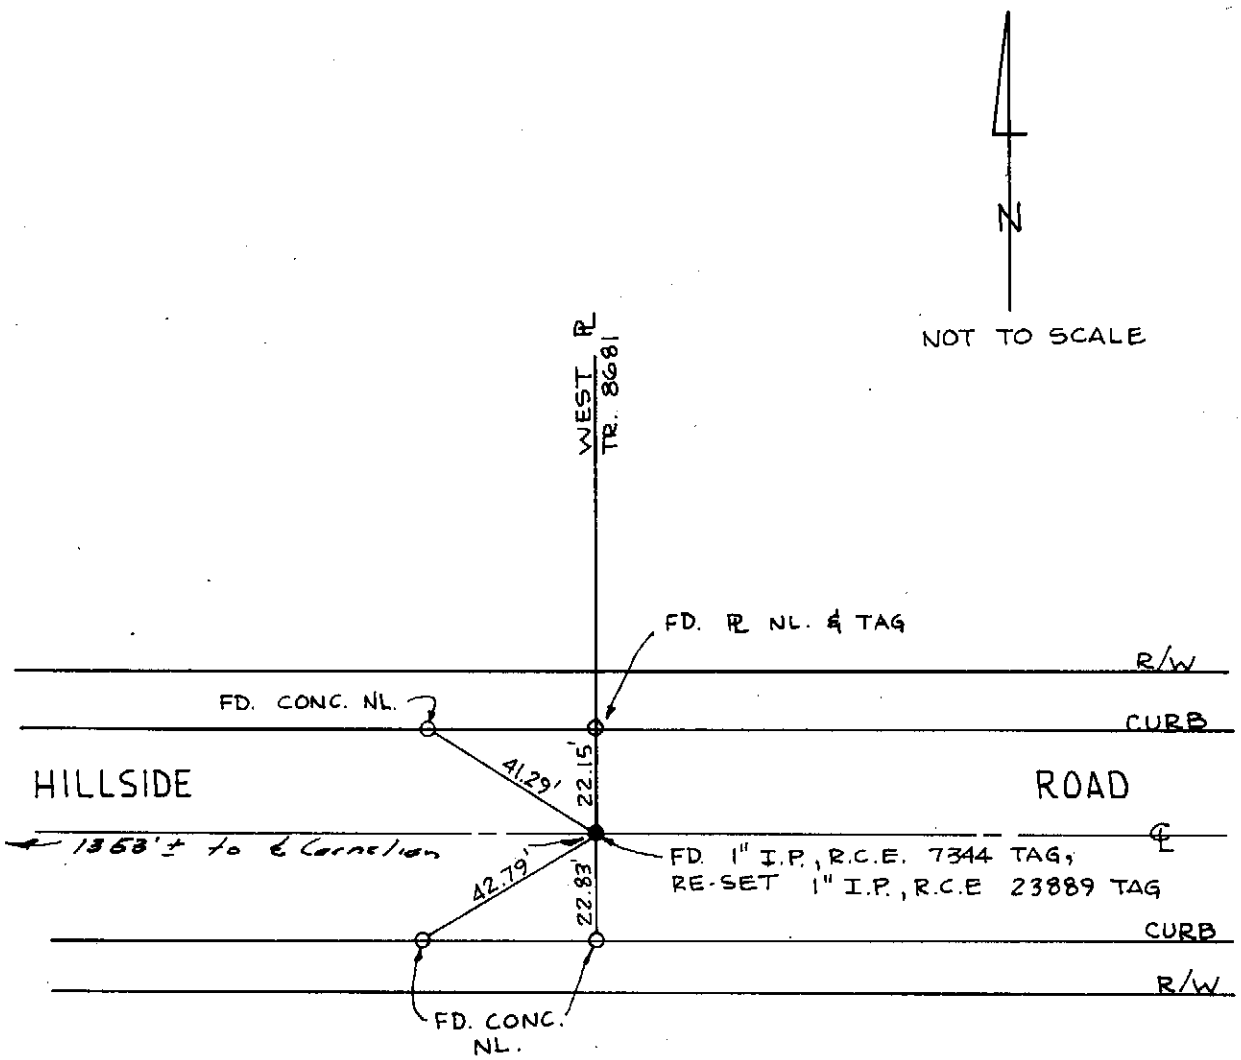

city of rancho cucamonga — STREET TIE	TRACT No. 9397
ASSOCIATED ENGINEERS 316 EAST E STREET ONTARIO, CA. 91764 (714) 986-5818	Centerline P.I., Hillside Rd.
~~ENGR.~~/L.S. L.H. NOREEN	FIELD REVIEW _____ DATE _____
~~R.C.E.~~/L.S. No. 3002 DATE 6/83	TIE BOOK 6 PAGE 44

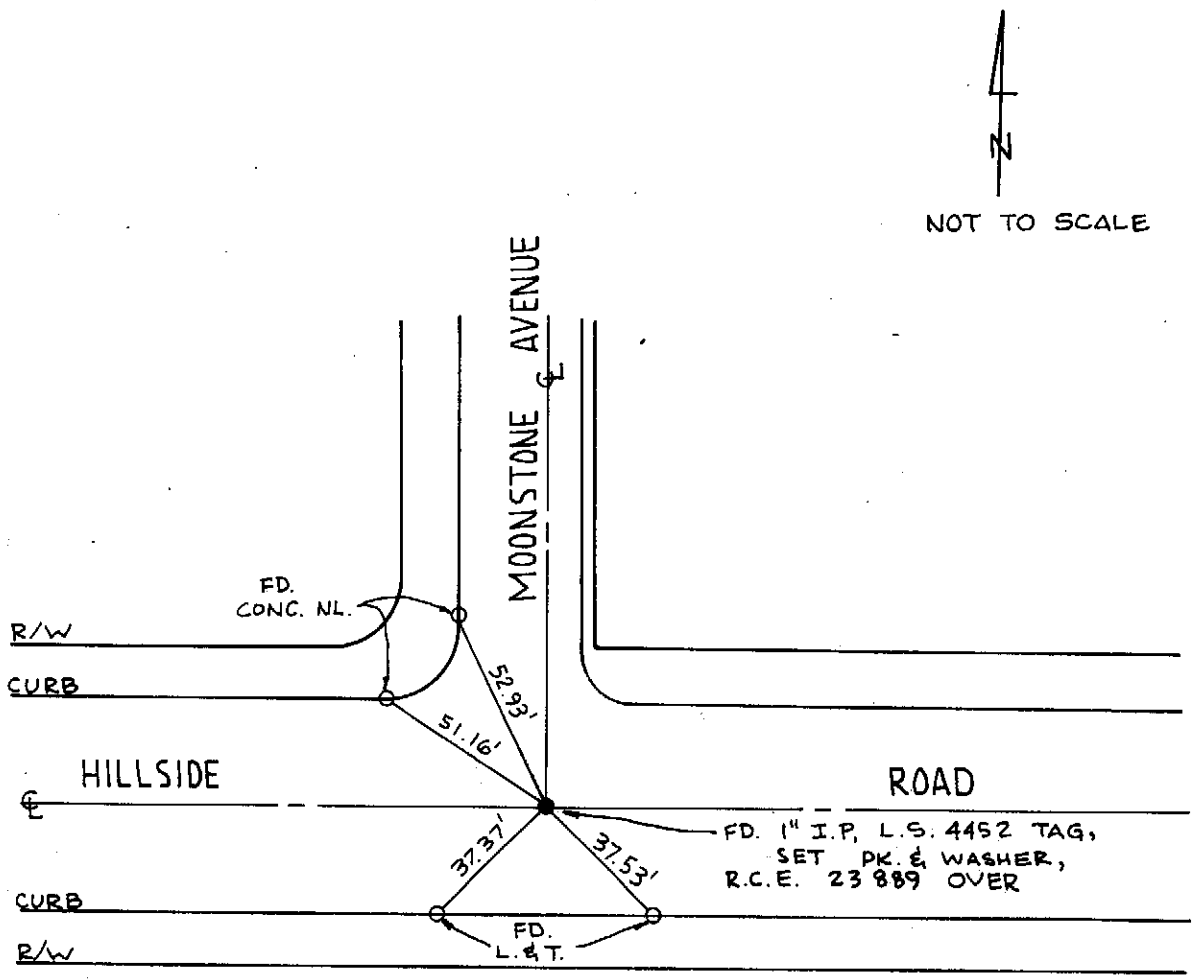

city of rancho cucamonga — STREET TIE	TRACT No. 9397
ASSOCIATED ENGINEERS 316 EAST E STREET ONTARIO, CA. 91764 (714) 986-5818	Centerline P.I., Hillside Rd. & Moonstone Ave.
~~ENGR.~~ / L.S. L.H. NOREEN	FIELD REVIEW _____ DATE _____
~~R.C.E.~~ / L.S. No. 3002 DATE 6/83	TIE BOOK 6 PAGE 45

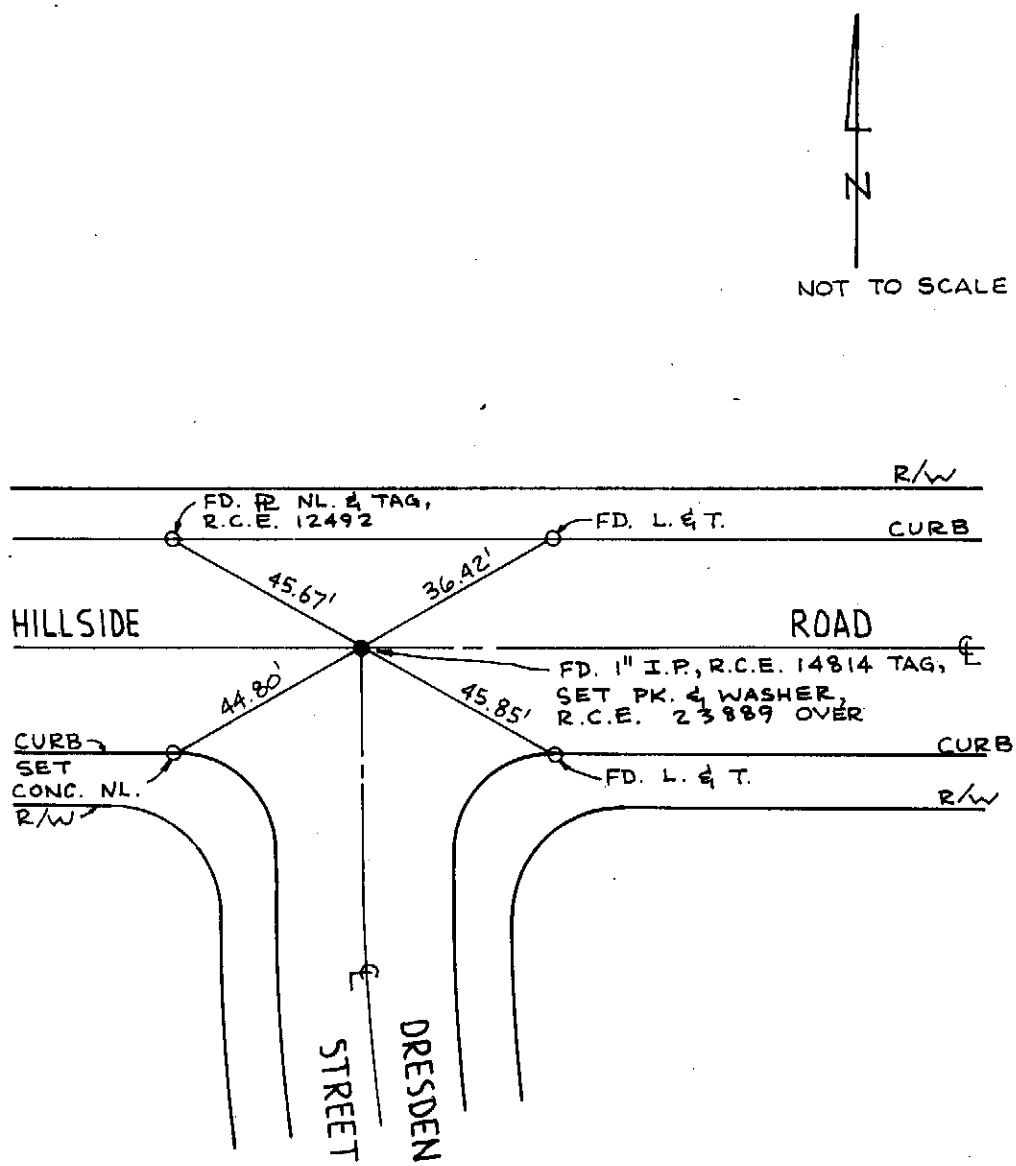

city of rancho cucamonga STREET TIE	TRACT No. 9397
ASSOCIATED ENGINEERS 316 EAST E STREET ONTARIO, CA. 91764 (714) 986-5818	Centerline P.I., Hillside Rd. & Dresden St.
ENGR./L.S. L.H. NOREEN	FIELD REVIEW _____ DATE _____
R.C.E./L.S. No. 3002 DATE 6/83	TIE BOOK 6 PAGE 46

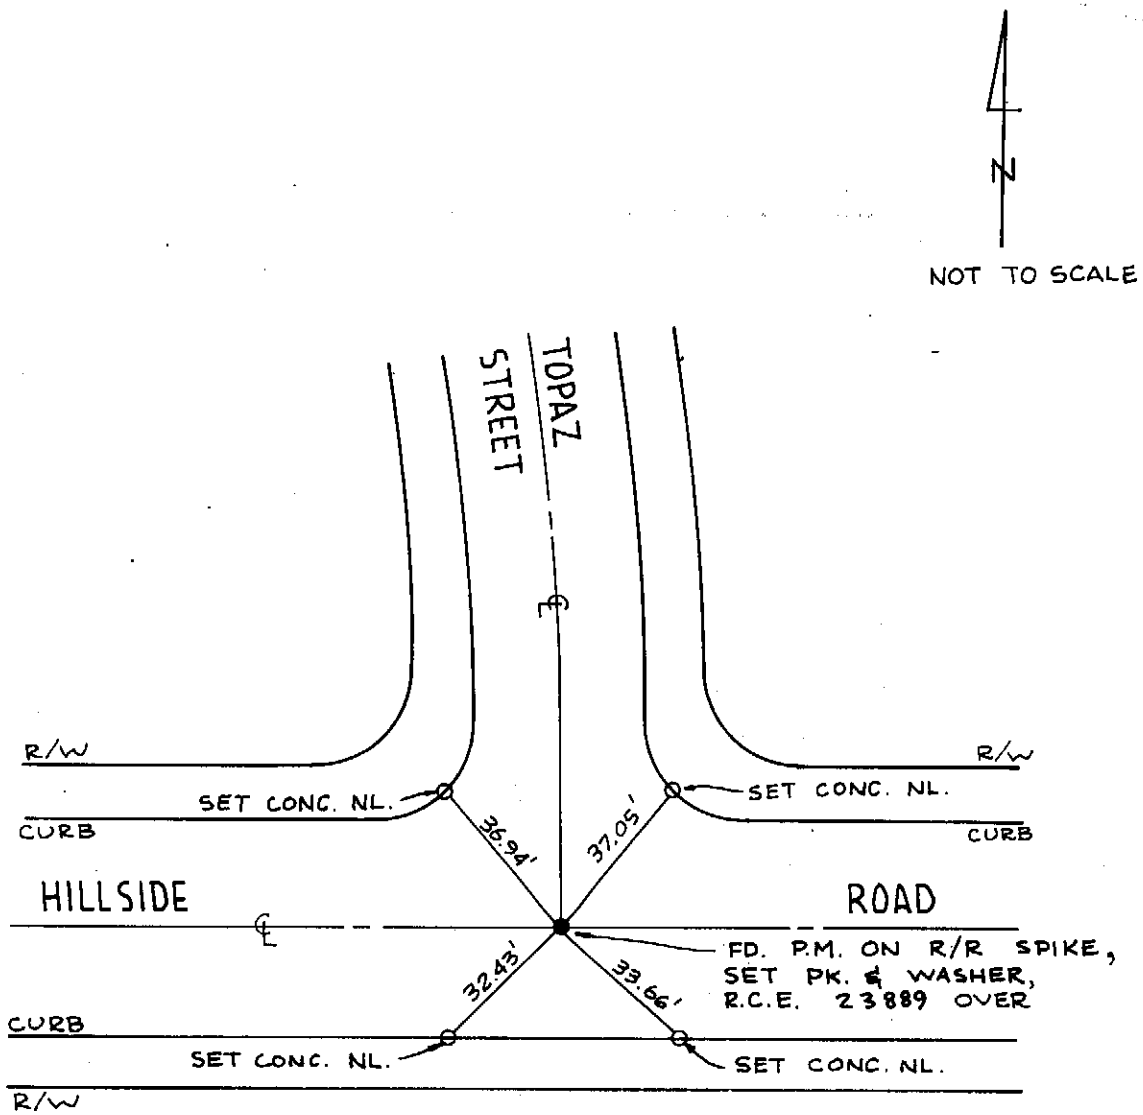

city of rancho cucamonga — STREET TIE	TRACT No. 9397
ASSOCIATED ENGINEERS 316 EAST E STREET ONTARIO, CA. 91764 (714) 986-5818	Centerline P.I., Hillside Rd. & Topaz St.
ENGR. / L.S. L.H. NOREEN	FIELD REVIEW ____ DATE ____
R.C.E. / L.S. No. 3002 DATE 6/83	TIE BOOK 6 PAGE 47

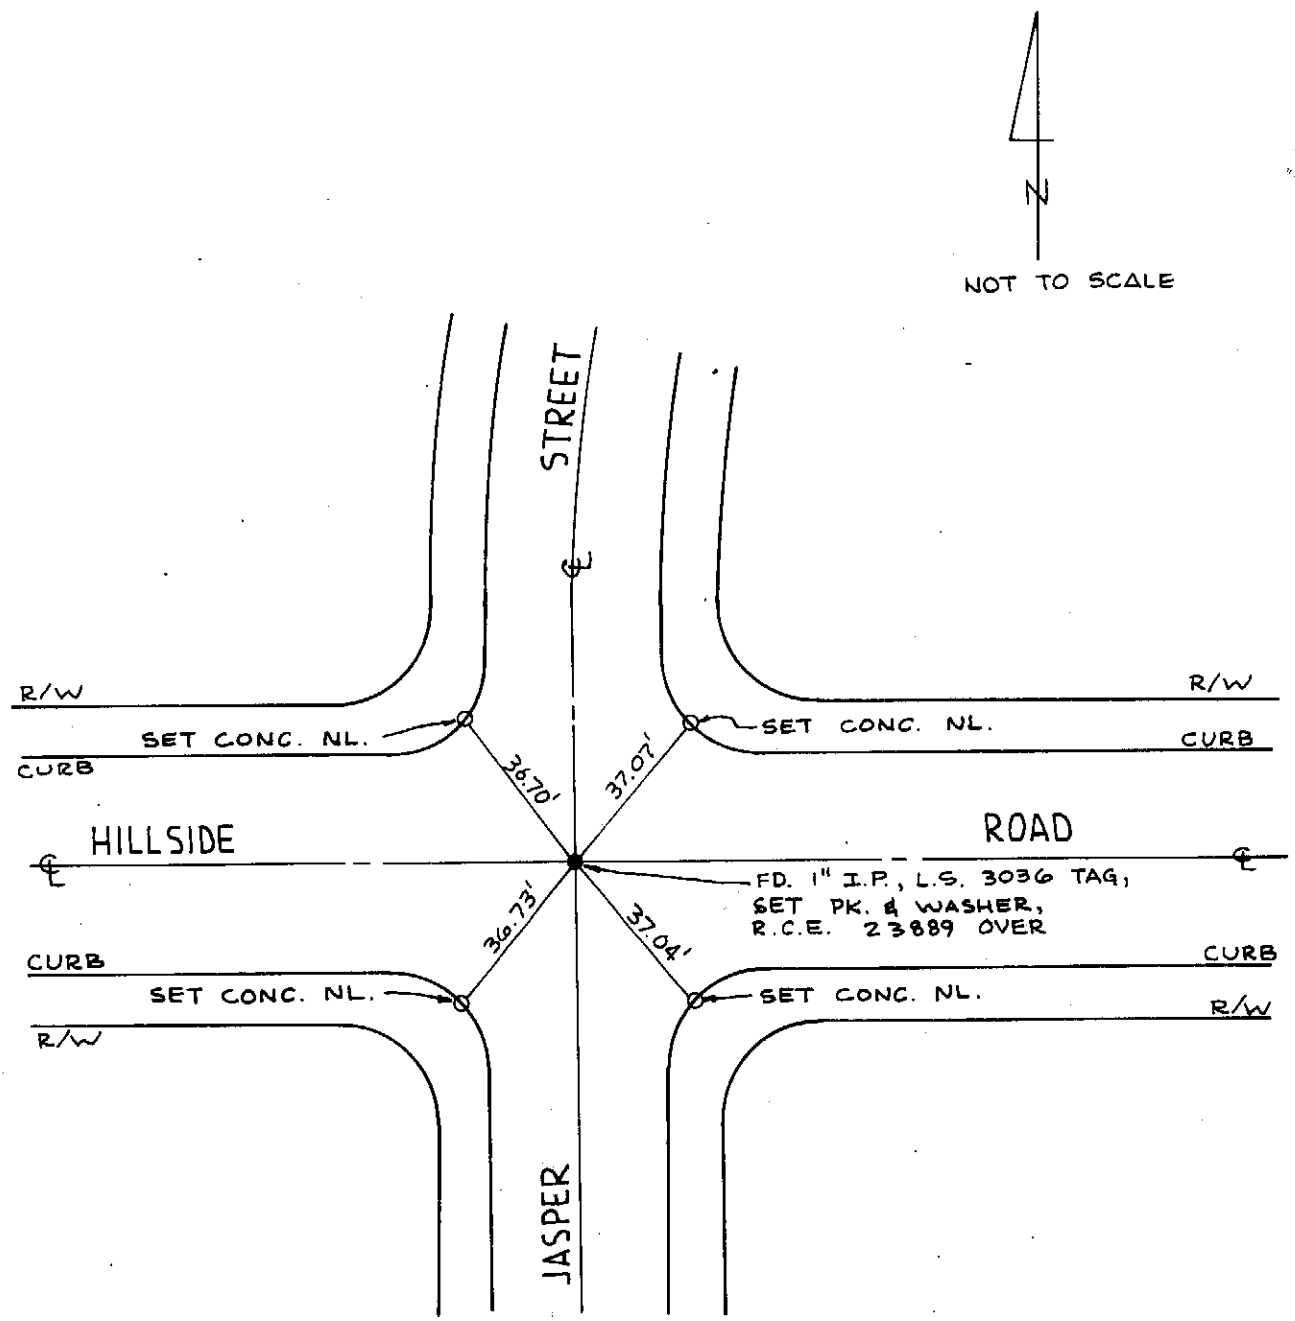

city of rancho cucamonga — STREET TIE	TRACT No. 9397
ASSOCIATED ENGINEERS 316 EAST E STREET ONTARIO, CA. 91764 (714) 986-5818	Centerline P.I., Hillside Rd. & Jasper St.
~~ENGR.~~ / L.S. L.H. NOREEN	FIELD REVIEW _____ DATE _____
~~R.C.E.~~ / L.S. No. 3002 DATE 6/83	TIE BOOK 6 PAGE 48

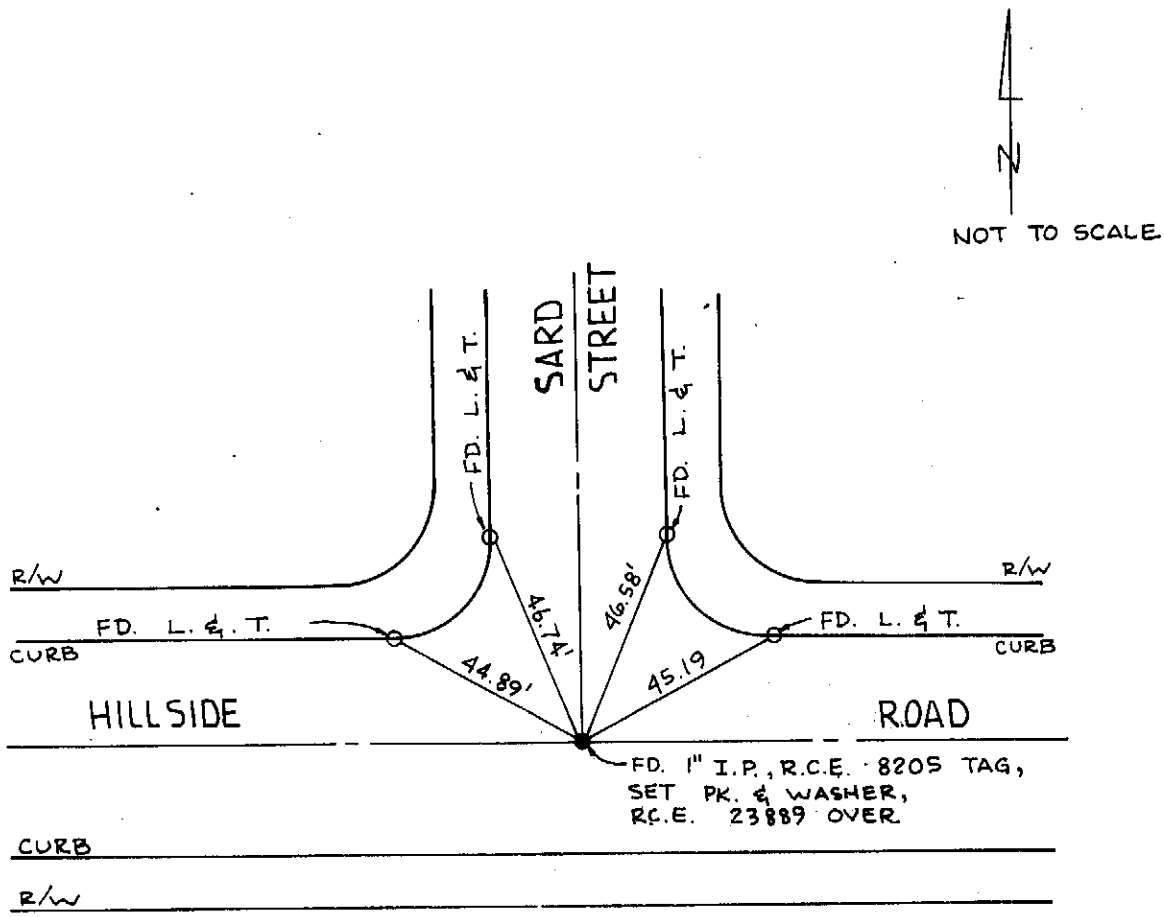

city of rancho cucamonga — STREET TIE	TRACT No. 9397
ASSOCIATED ENGINEERS 316 EAST E STREET ONTARIO, CA. 91764 (714) 986-5818	Centerline P.I., Hillside Rd. & Sard St.
~~ENGR.~~/L.S. L.H. NOREEN	FIELD REVIEW _____ DATE _____
~~R.C.E.~~/L.S. No. 3002 DATE 6/83	TIE BOOK 6 PAGE 49

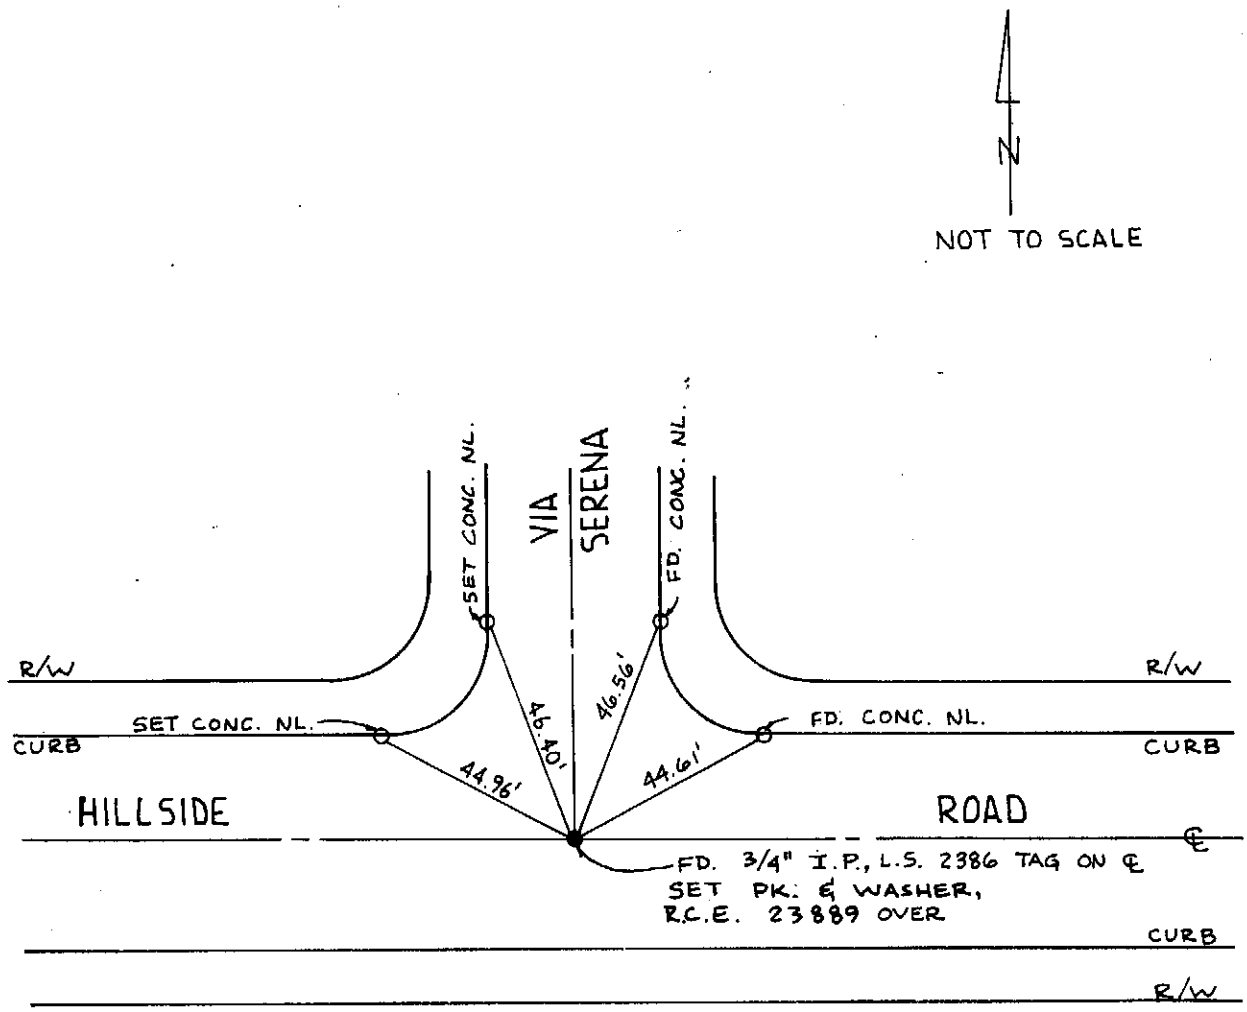

city of rancho cucamonga — STREET TIE	TRACT No. 9397
ASSOCIATED ENGINEERS 316 EAST E STREET ONTARIO, CA. 91764 (714) 986-5818	Centerline P.I., Hillside Rd. & Via Serena
~~ENGR.~~/L.S. L.H. NOREEN	FIELD REVIEW _____ DATE _____
~~R.C.E.~~/L.S. No. 3002 DATE 6/83	TIE BOOK 6 PAGE 50

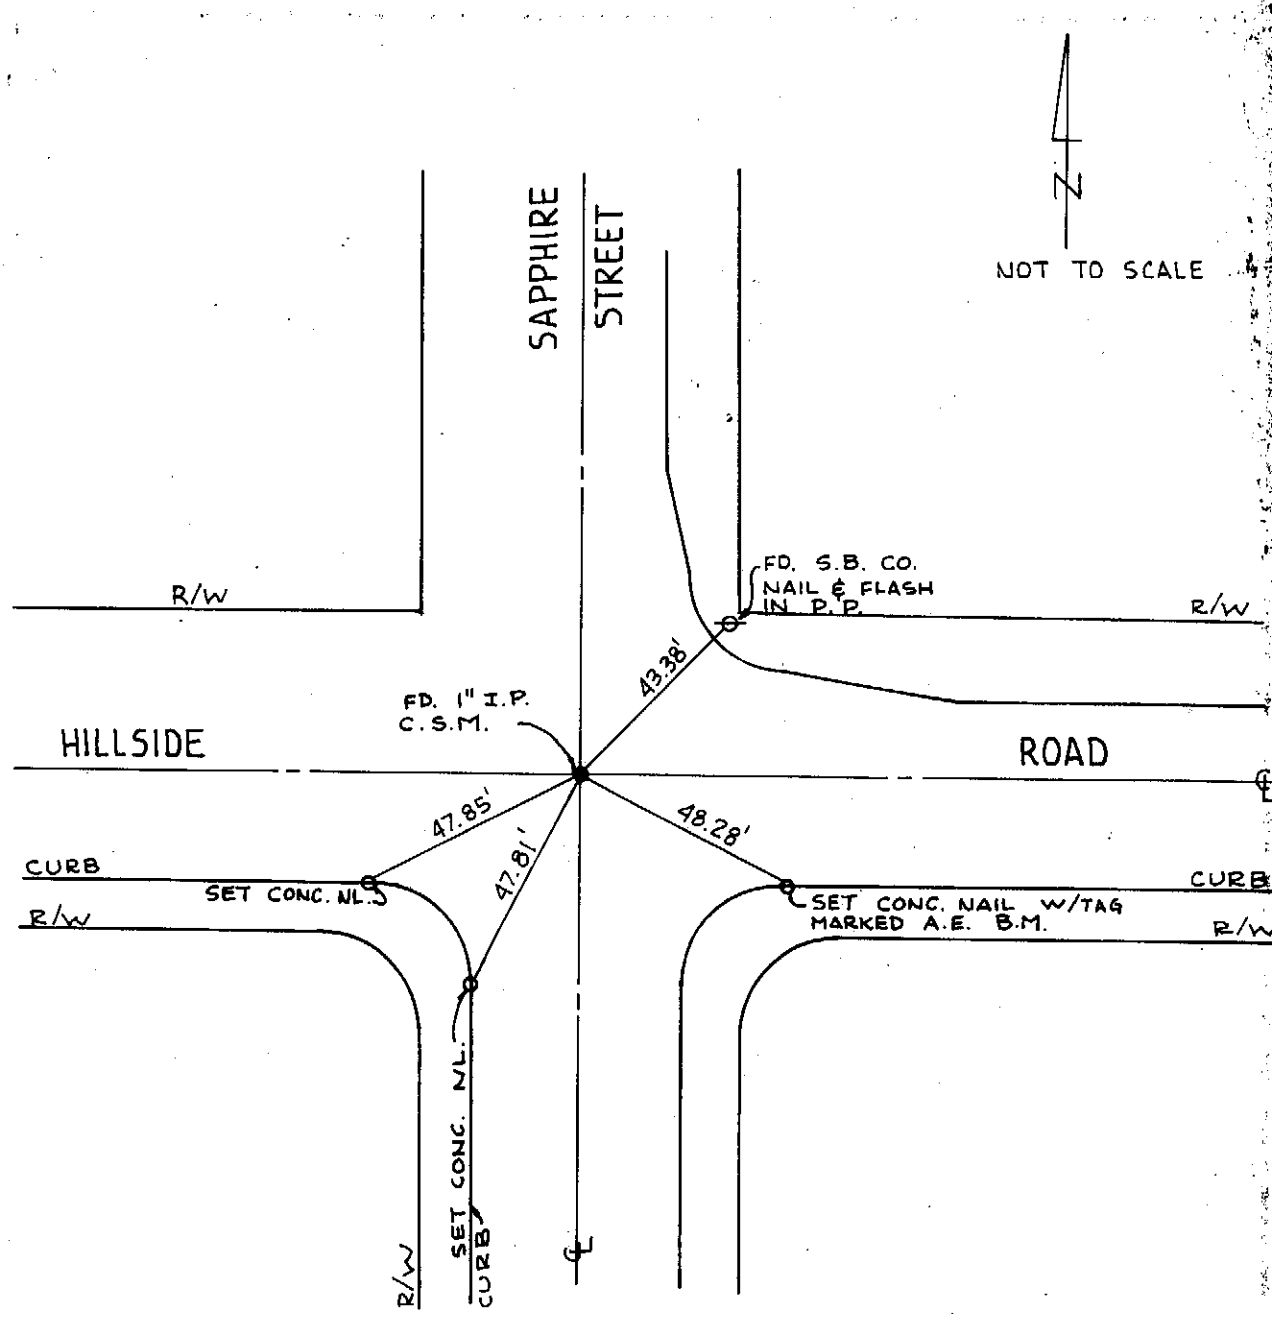

city of rancho cucamonga — STREET TIE	TRACT No. 6297
ASSOCIATED ENGINEERS 316 EAST E STREET ONTARIO, CA. 91764 (714) 986-5818	Centerline P.I., Hillside Rd. & Sapphire St.
~~ENGR.~~ / L.S. L.H. NOREEN	FIELD REVIEW ____ DATE ____
~~R.C.E.~~ / L.S. No. 3002 DATE 6/83	TIE BOOK ____ PAGE ____

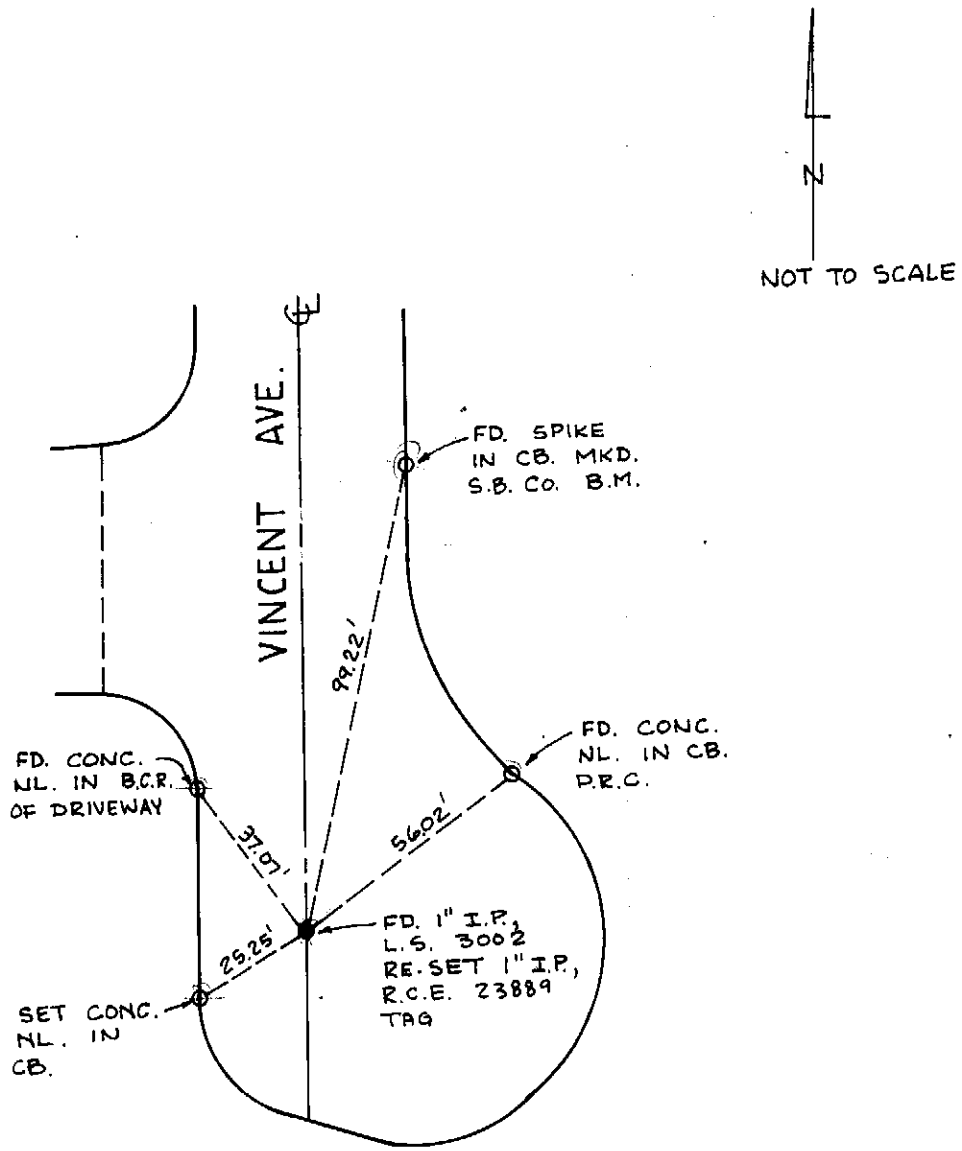

city of rancho cucamonga — STREET TIE	TRACT No.
ASSOCIATED ENGINEERS 316 EAST E STREET ONTARIO, CA. 91764 (714) 986-5818	CENTERLINE OF VINCENT AVE. APPROX. 875'± SOUTH OF JERSEY BLVD.
ENGR. / L.S. L. A. NOREEN	FIELD REVIEW ____ DATE ____
R.C.E. / L.S. No. 3002 DATE 7/83	TIE BOOK 6 PAGE ____

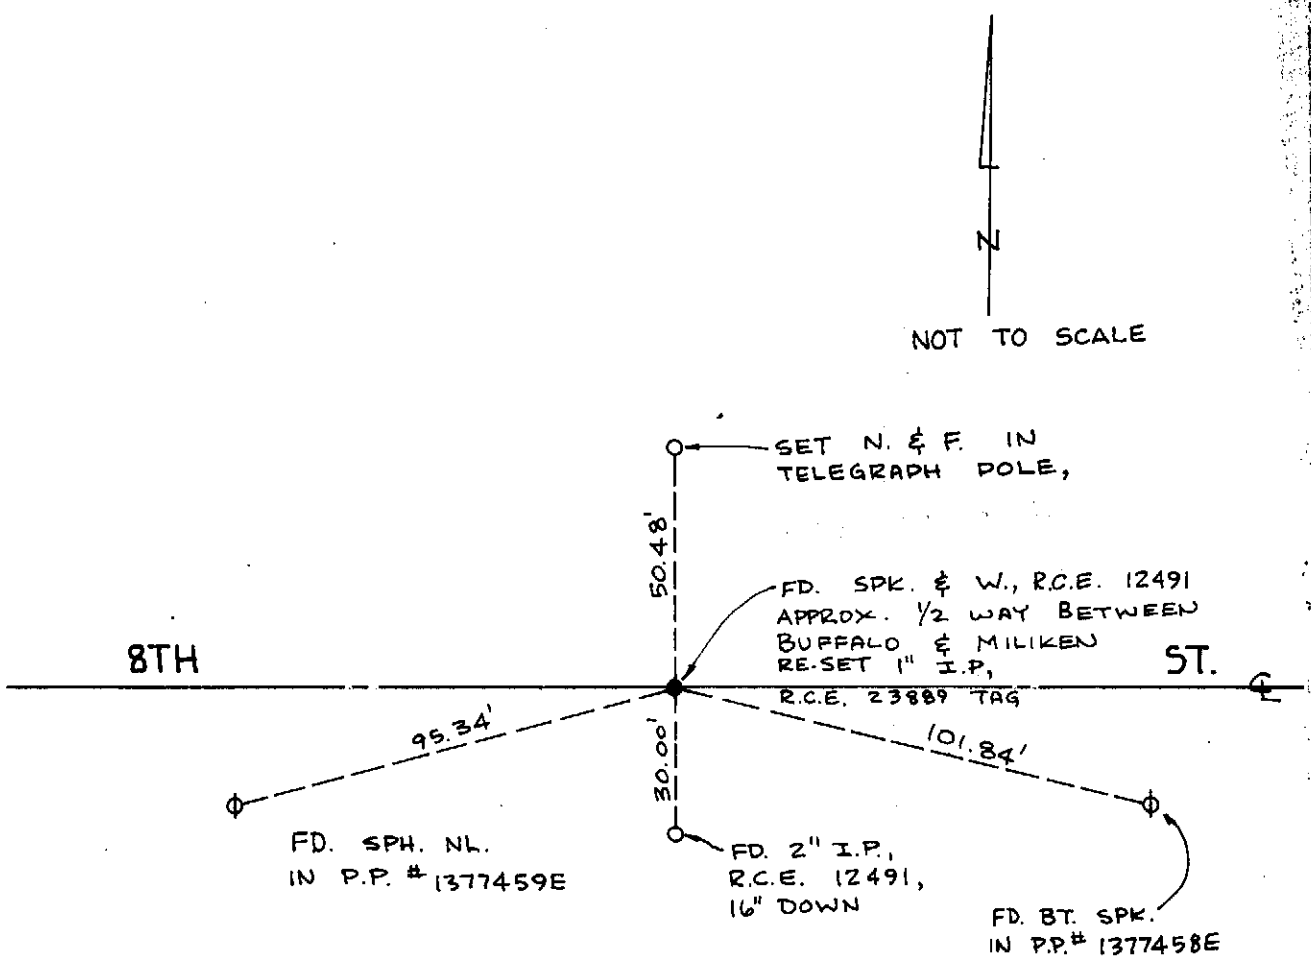

city of rancho cucamonga — STREET TIE	TRACT No.
ASSOCIATED ENGINEERS 316 EAST E STREET ONTARIO, CA. 91764 (714) 986-5818	CENTERLINE OF 8TH ST., APPROX. MIDWAY BETWEEN BUFFALO AVE. AND MILLIKEN AVE.
~~ENGR.~~ / L.S. L.H. NOREEN	FIELD REVIEW _____ DATE _____
~~R.C.E.~~ / L.S. No. 3002 DATE 7/83	TIE BOOK 6 PAGE 53

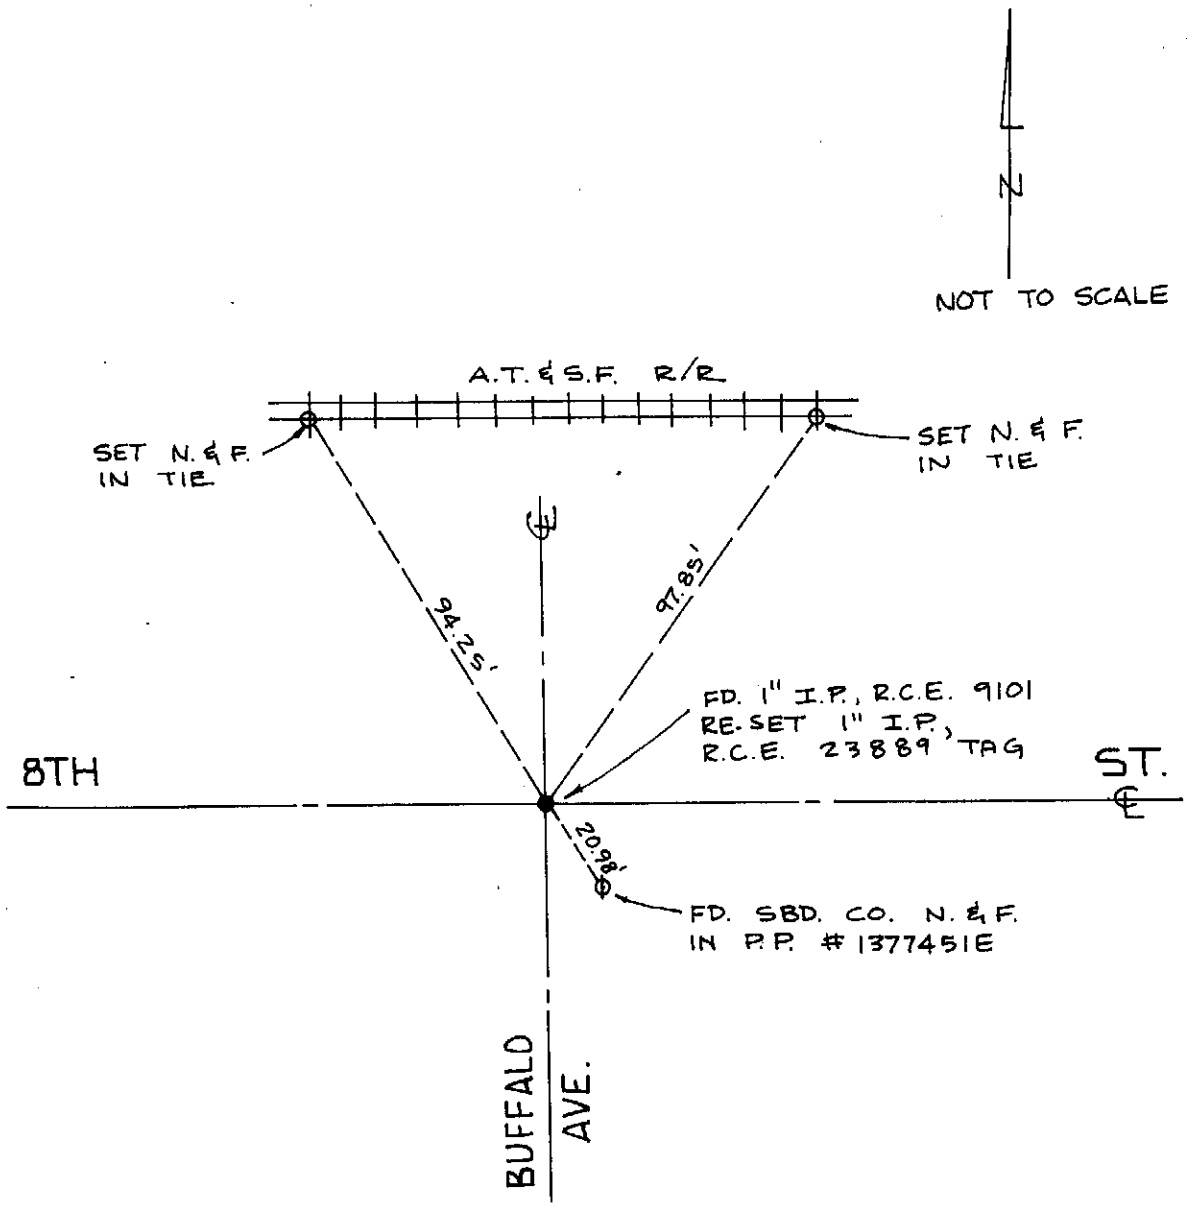

city of rancho cucamonga — STREET TIE	TRACT No.
ASSOCIATED ENGINEERS 316 EAST E STREET ONTARIO, CA. 91764 (714) 986-5818	CENTERLINE P.I. OF 8TH ST. AND BUFFALD AVENUE
~~ENGR.~~ / L.S. L.H. NOREEN	FIELD REVIEW _____ DATE _____
~~R.C.E.~~ / L.S. No. 3002 DATE 7/13	TIE BOOK 6 PAGE 54

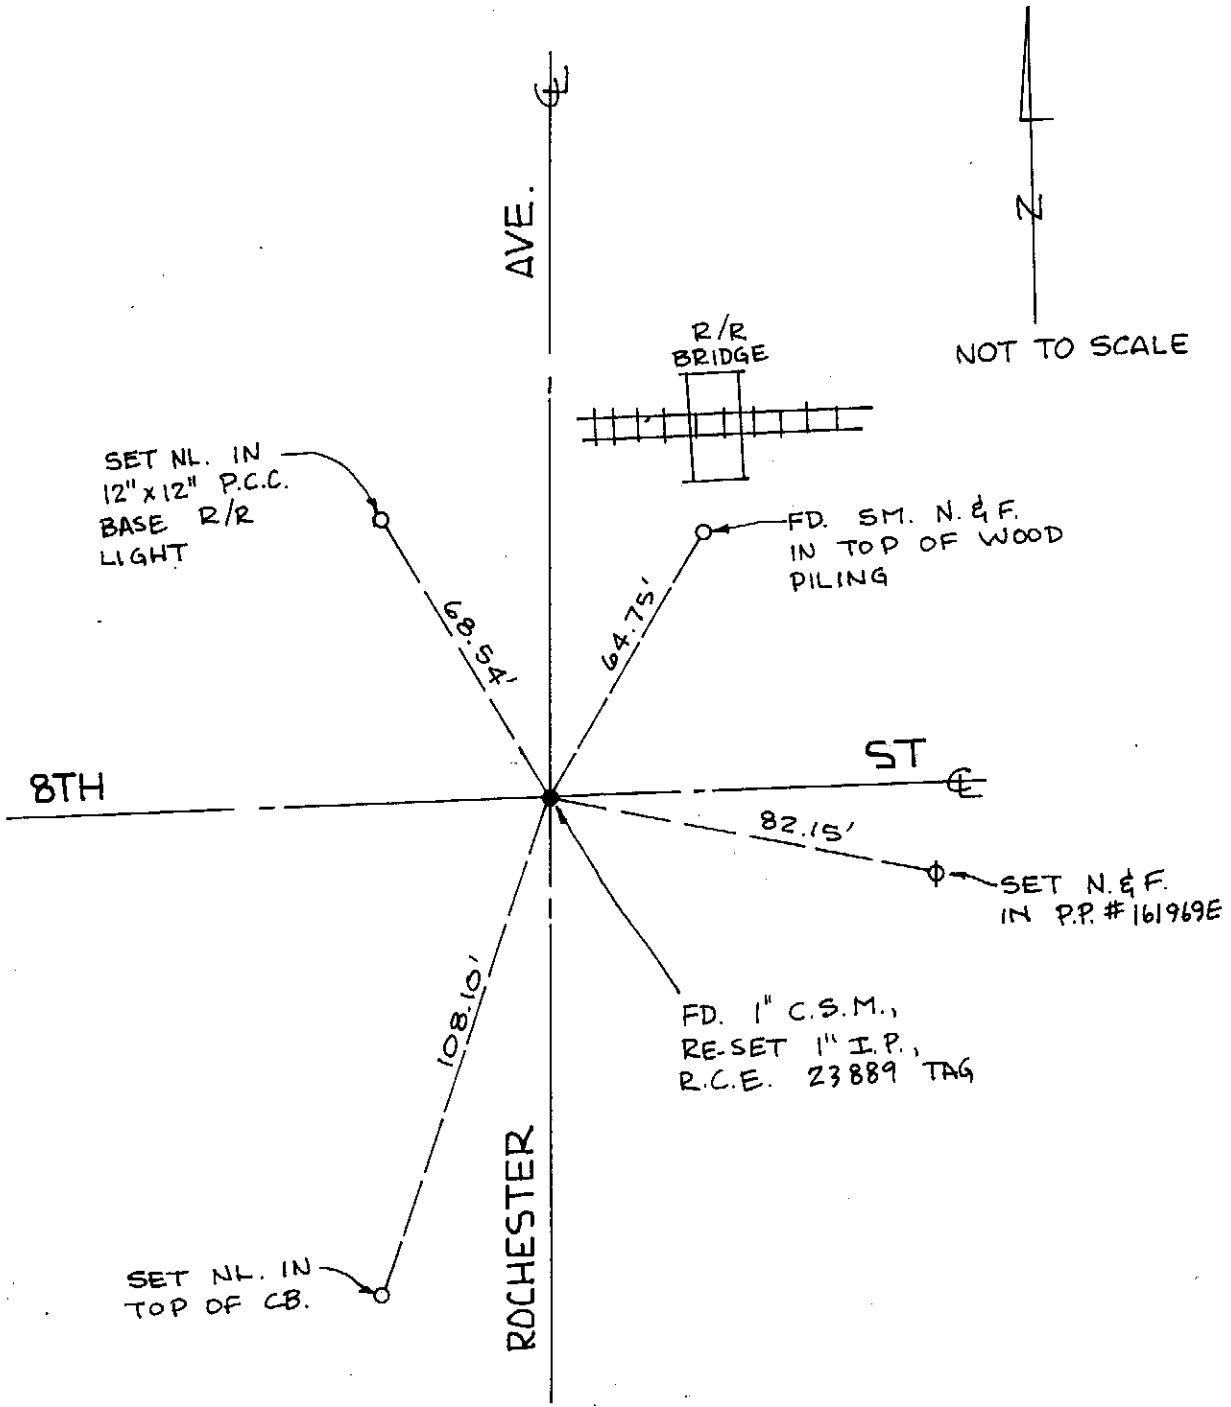

city of rancho cucamonga — STREET TIE	TRACT No.
ASSOCIATED ENGINEERS 316 EAST E STREET ONTARIO, CA. 91764 (714) 986-5818	CENTERLINE P.I. OF 8TH ST. AND ROCHESTER AVE.
~~ENGR.~~ / L.S. L.H. NOREEN	FIELD REVIEW _____ DATE _____
~~R.C.E.~~ / L.S. No. 3002 DATE 7/83	FIELD BOOK 6 PAGE 55

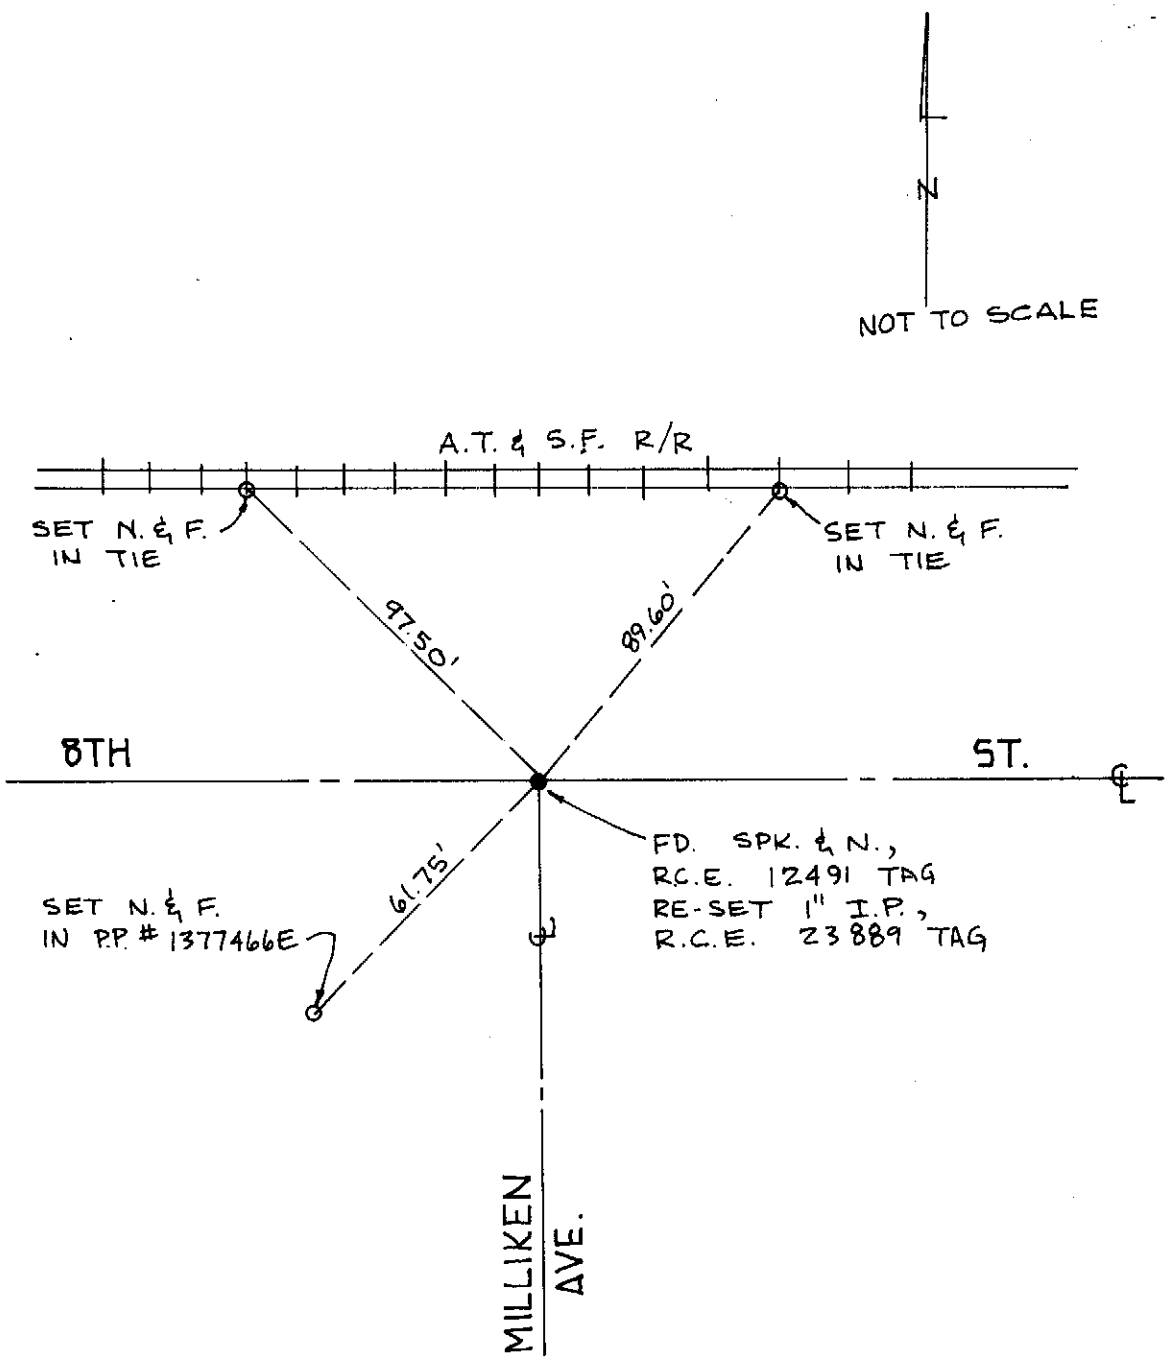

city of rancho cucamonga — STREET TIE	TRACT No.
ASSOCIATED ENGINEERS 316 EAST E STREET ONTARIO, CA. 91764 (714) 986-5818	CENTERLINE P.I. OF 8TH ST. AND MILLIKEN AVE.
~~ENGR.~~ / L.S. L.H. NOREEN	FIELD REVIEW _____ DATE _____
~~R.C.E.~~ / L.S. No. 3002 DATE 7/83	TIE BOOK 6 PAGE 56

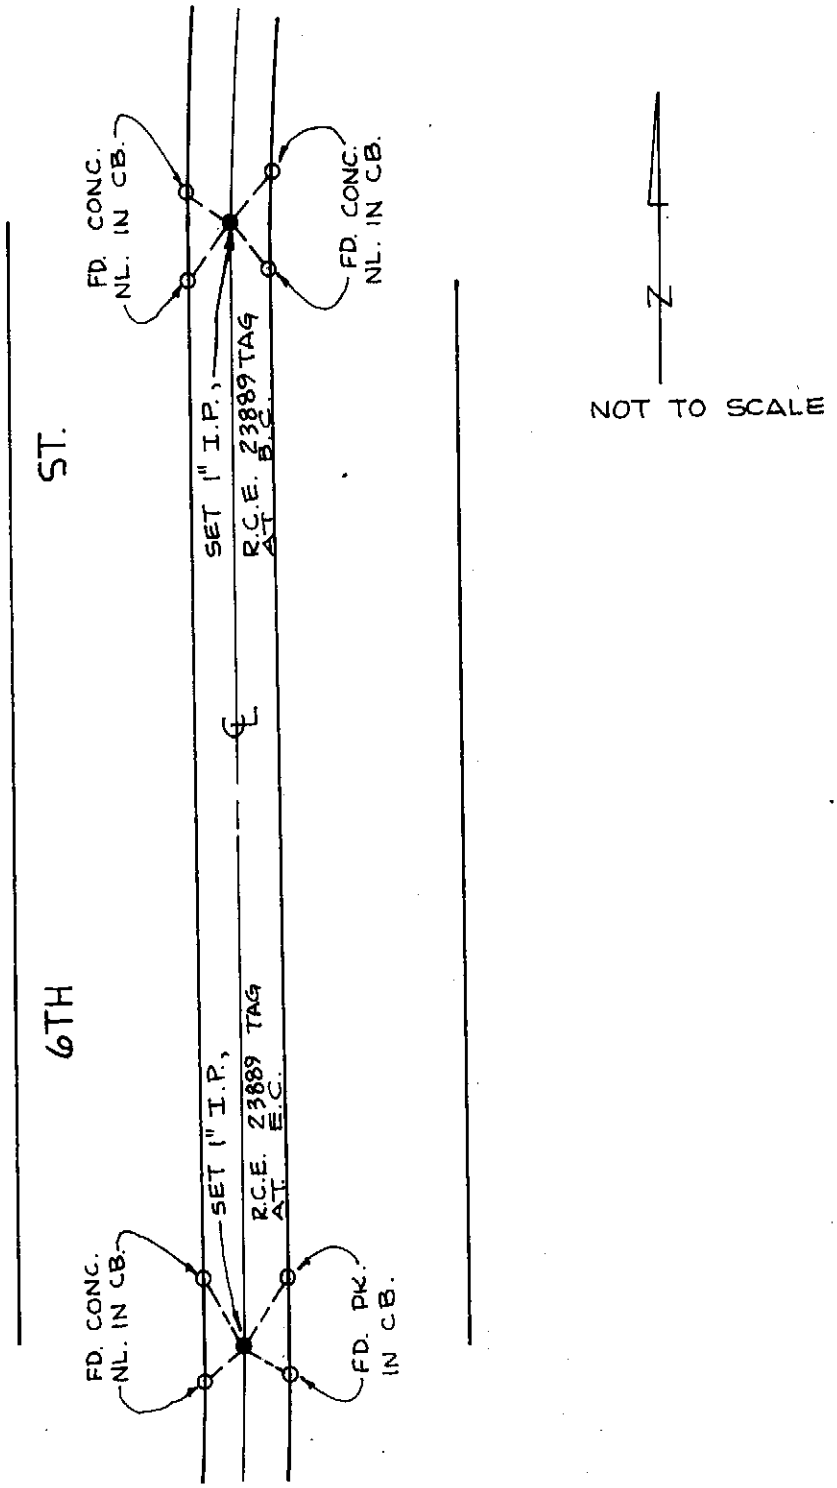

city of rancho cucamonga — STREET TIE	TRACT No.
ASSOCIATED ENGINEERS 316 EAST E STREET ONTARIO, CA. 91764 (714) 986-5818	CENTERLINE OF 6TH ST. 420'± NORTH OF BUFFALO AVENUE
~~ENGR.~~ / L.S. L.H. NOREEN	FIELD REVIEW _____ DATE _____
~~R.C.E.~~ / L.S. No. 3002 DATE 7/83	TIE BOOK 6 PAGE 57

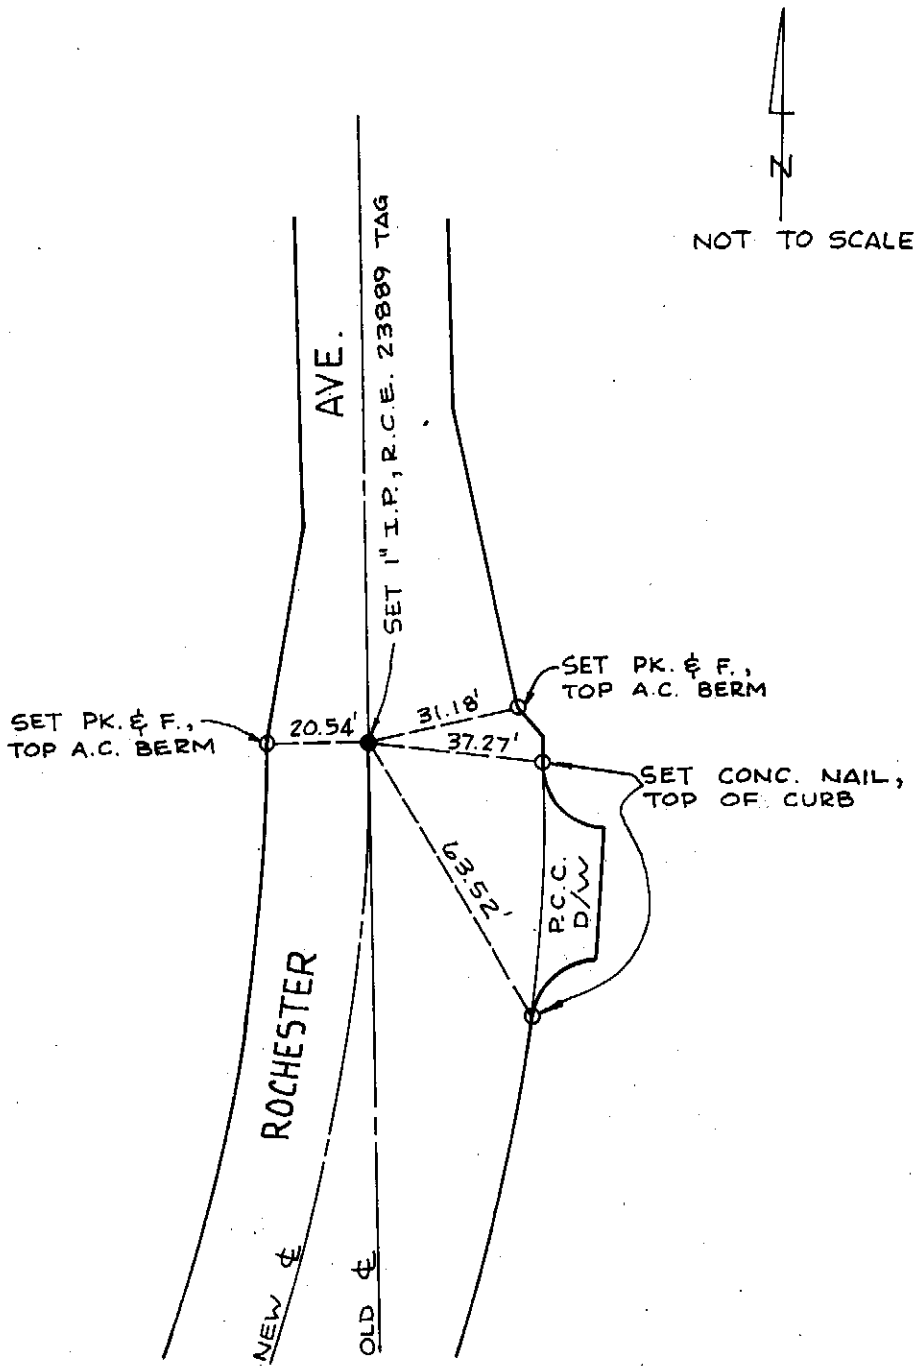

city of rancho cucamonga — STREET TIE	TRACT No.
ASSOCIATED ENGINEERS 316 EAST E STREET ONTARIO, CA. 91764 (714) 986-5818	CENTERLINE OF ROCHESTER AVE. 1212' ± NORTH OF 6TH ST.
~~ENGR.~~ / L.S. L.H. NOREEN	FIELD REVIEW _____ DATE _____
~~R.C.E.~~ / L.S. No. 3002 DATE 7/83	TIE BOOK 6 PAGE 58

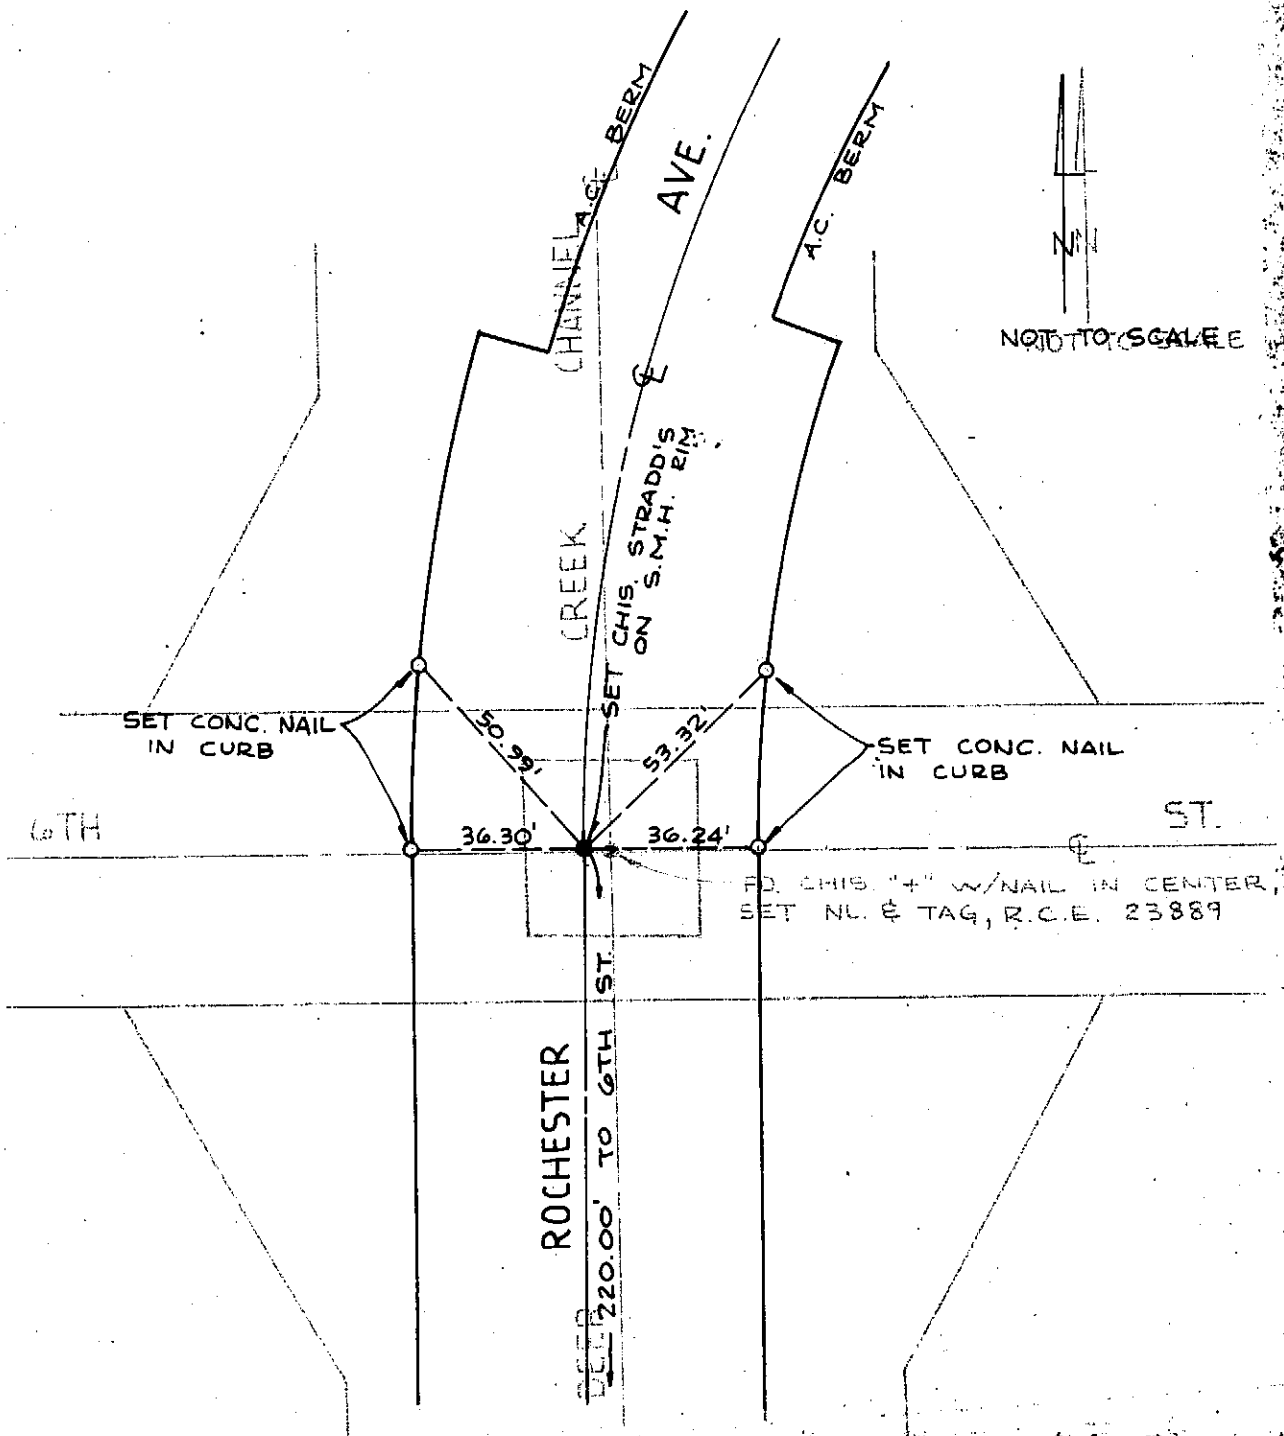

city of rancho Cucamonga STREET TIE	TRACT No.
ASSOCIATED ENGINEERS 365 EAST E STREET ONTARIO CA. 91764	CENTERLINE OF ROCHESTER AVE., 220' NORTH OF 6TH ST.
ENGR./L.S. L.H. NOREEN	
R.C.E./L.S. No. 3802 DATE 7/93	

TIE BOOK 6 PAGE 59

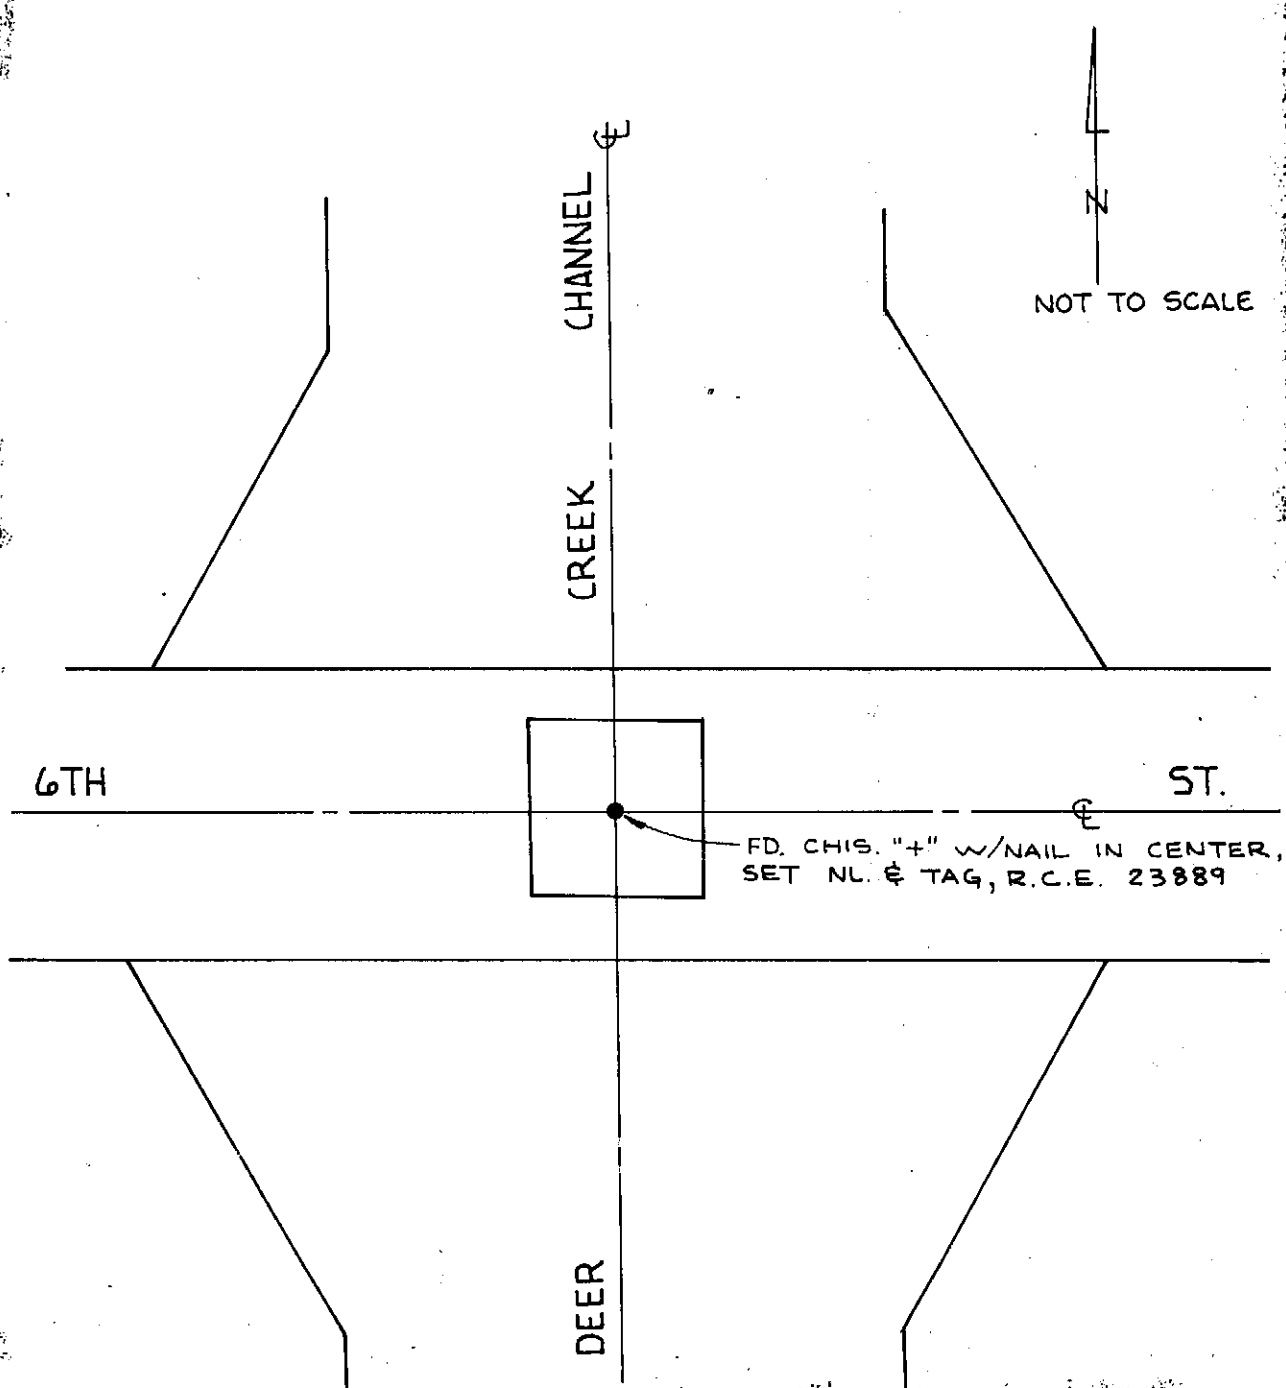

city of rancho cucamonga STREET

TRACT No.

CENTERLINE OF 6TH ST. AT DEER CREEK CHANNEL

ASSOCIATED ENGINEERS
[illegible] STREET
[illegible]

ENGR./L.S. I.H. [illegible]

R.C.E./L.S. 3002 DATE 7/83

T.E. BOOK Book 6 Page 60

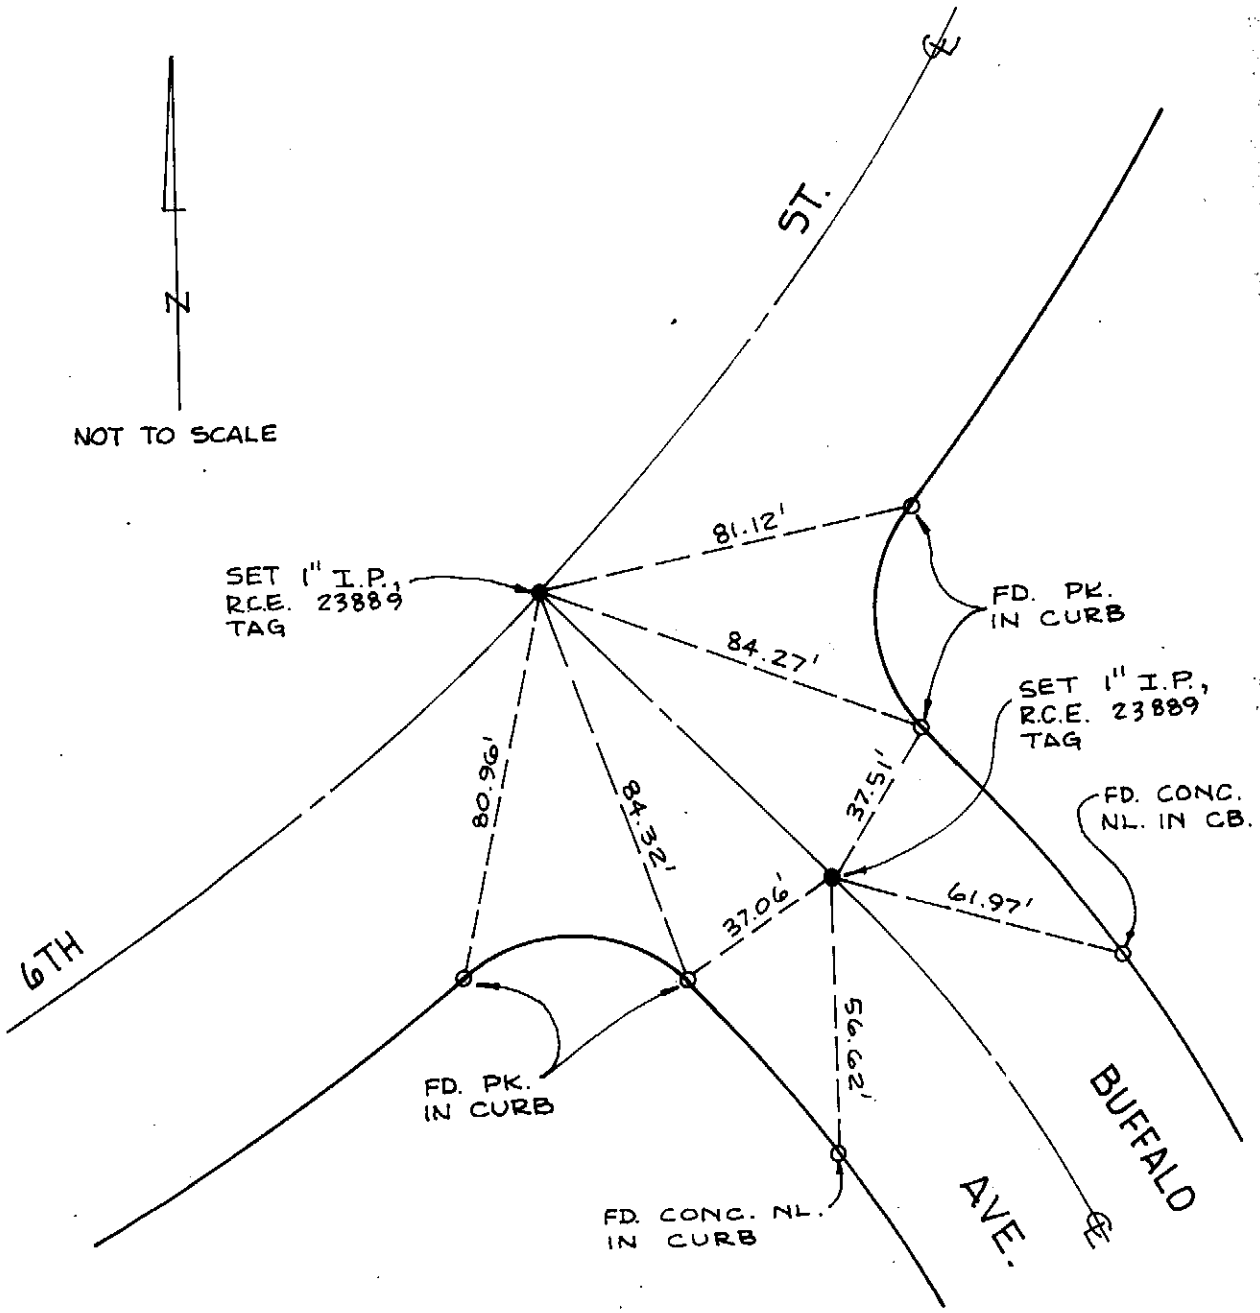

city of: rancho cucamonga — STREET TIE	TRACT No.
ASSOCIATED ENGINEERS 316 EAST E STREET ONTARIO, CA. 91764 (714) 986-5818	CENTERLINE P.I. OF 6TH ST. AND BUFFALO AVE.
~~ENGR.~~ / L.S. L.H. NOREEN	FIELD REVIEW _____ DATE _____
~~R.C.E.~~ / L.S. No. 3002 DATE 7/83	TIE BOOK 6 PAGE 61

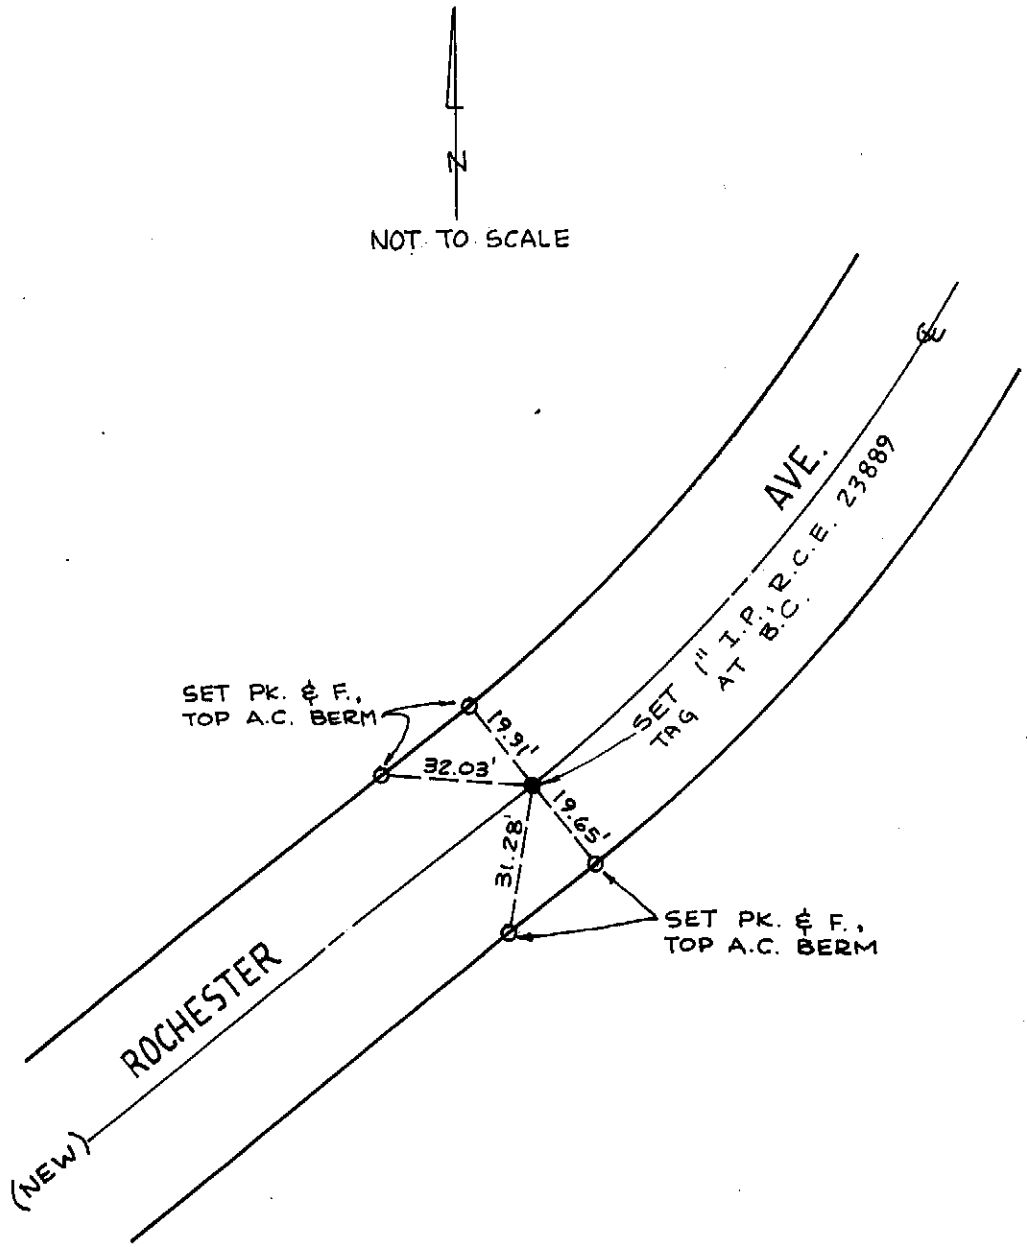

city of rancho cucamonga — STREET TIE	TRACT No.
ASSOCIATED ENGINEERS 316 EAST E STREET ONTARIO, CA. 91764 (714) 986-5818	CENTERLINE OF ROCHESTER AVE., 889'± NORTH OF 6TH ST.
~~ENGR.~~ / L.S. L.H. NOREEN	FIELD REVIEW _____ DATE _____
~~R.C.E.~~ / L.S. No. 3002 DATE 7/83	TIE BOOK 6 PAGE 62

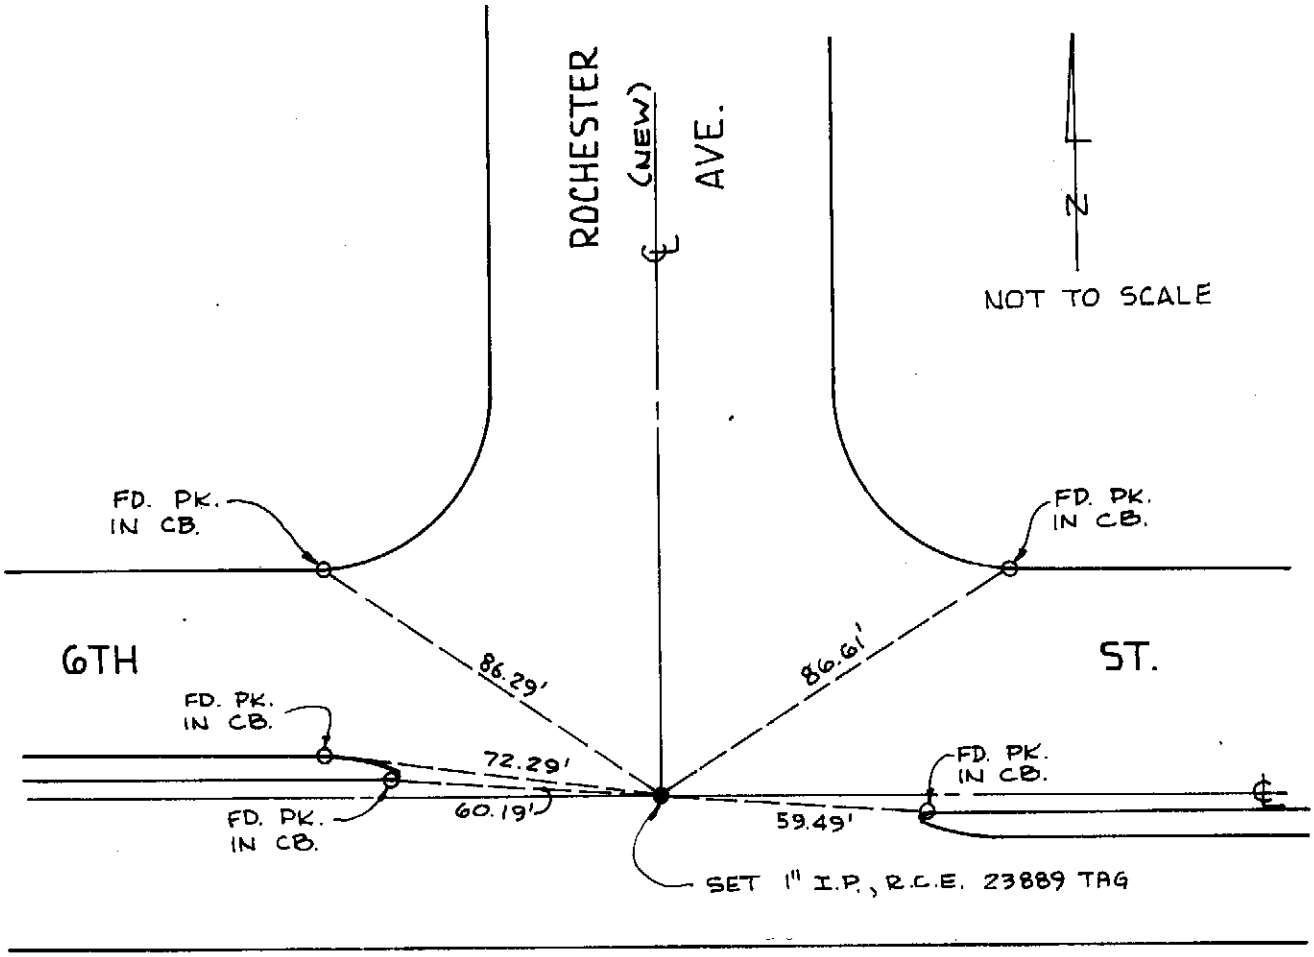

city of rancho cucamonga — STREET TIE	TRACT No.
ASSOCIATED ENGINEERS 316 EAST E STREET ONTARIO, CA. 91764 (714) 986-5818	CENTERLINE P.I. OF 6TH ST. AND ROCHESTER AVE.
~~ENGR.~~ / L.S. L.H. NOREEN	FIELD REVIEW _____ DATE _____
~~R.C.E.~~ / L.S. No. 3002 DATE 7/83	TIE BOOK 6 PAGE 63

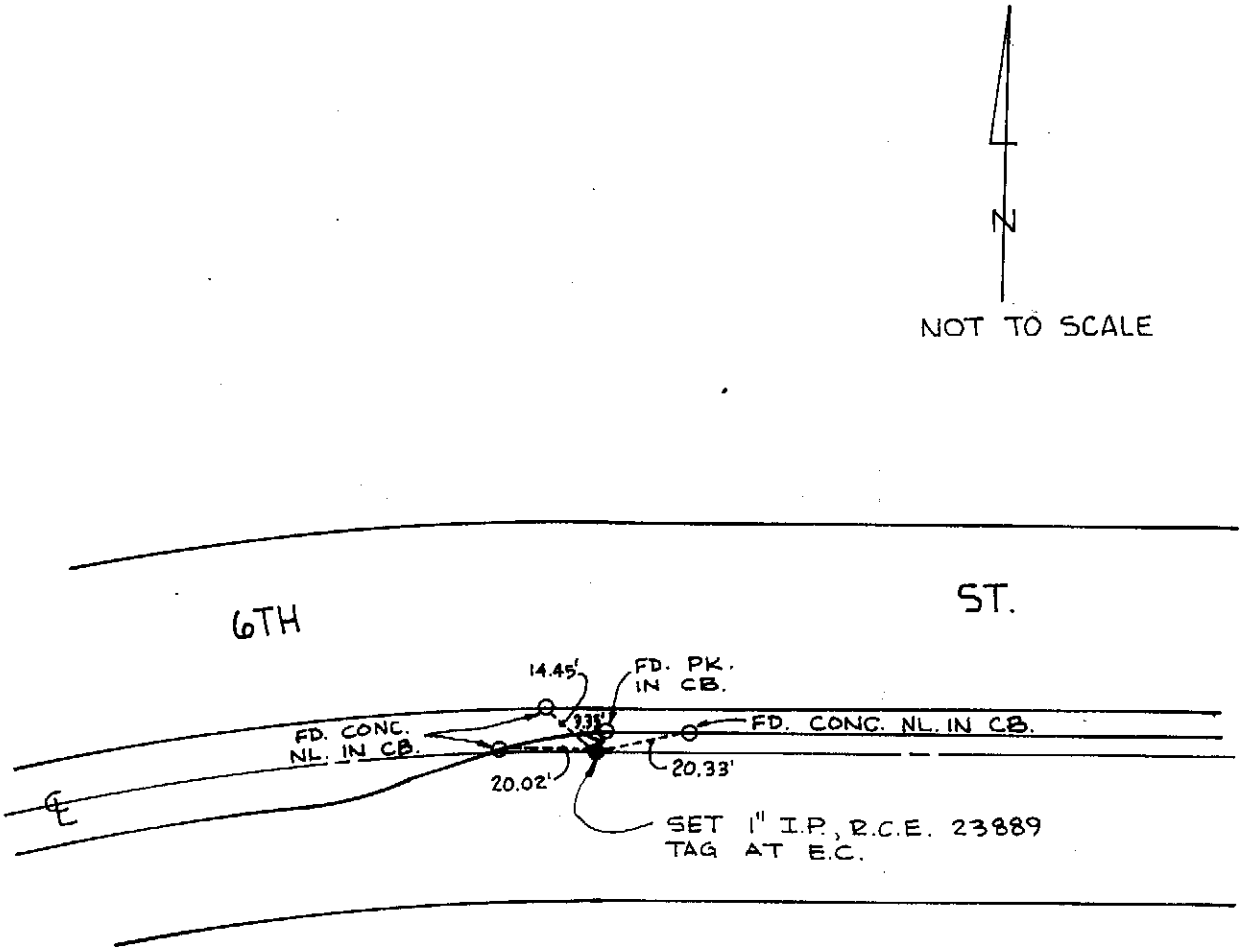

city of rancho cucamonga — STREET TIE	TRACT No.
ASSOCIATED ENGINEERS 316 EAST E STREET ONTARIO, CA. 91764 (714) 986-5818	CENTERLINE OF 6TH ST. 201'± WEST OF ROCHESTER AVE.
~~ENGR.~~ / L.S. L.H. NOREEN	FIELD REVIEW _____ DATE _____
~~R.C.E.~~ / L.S. No. 3002 DATE 7/83	TIE BOOK 6 PAGE 64

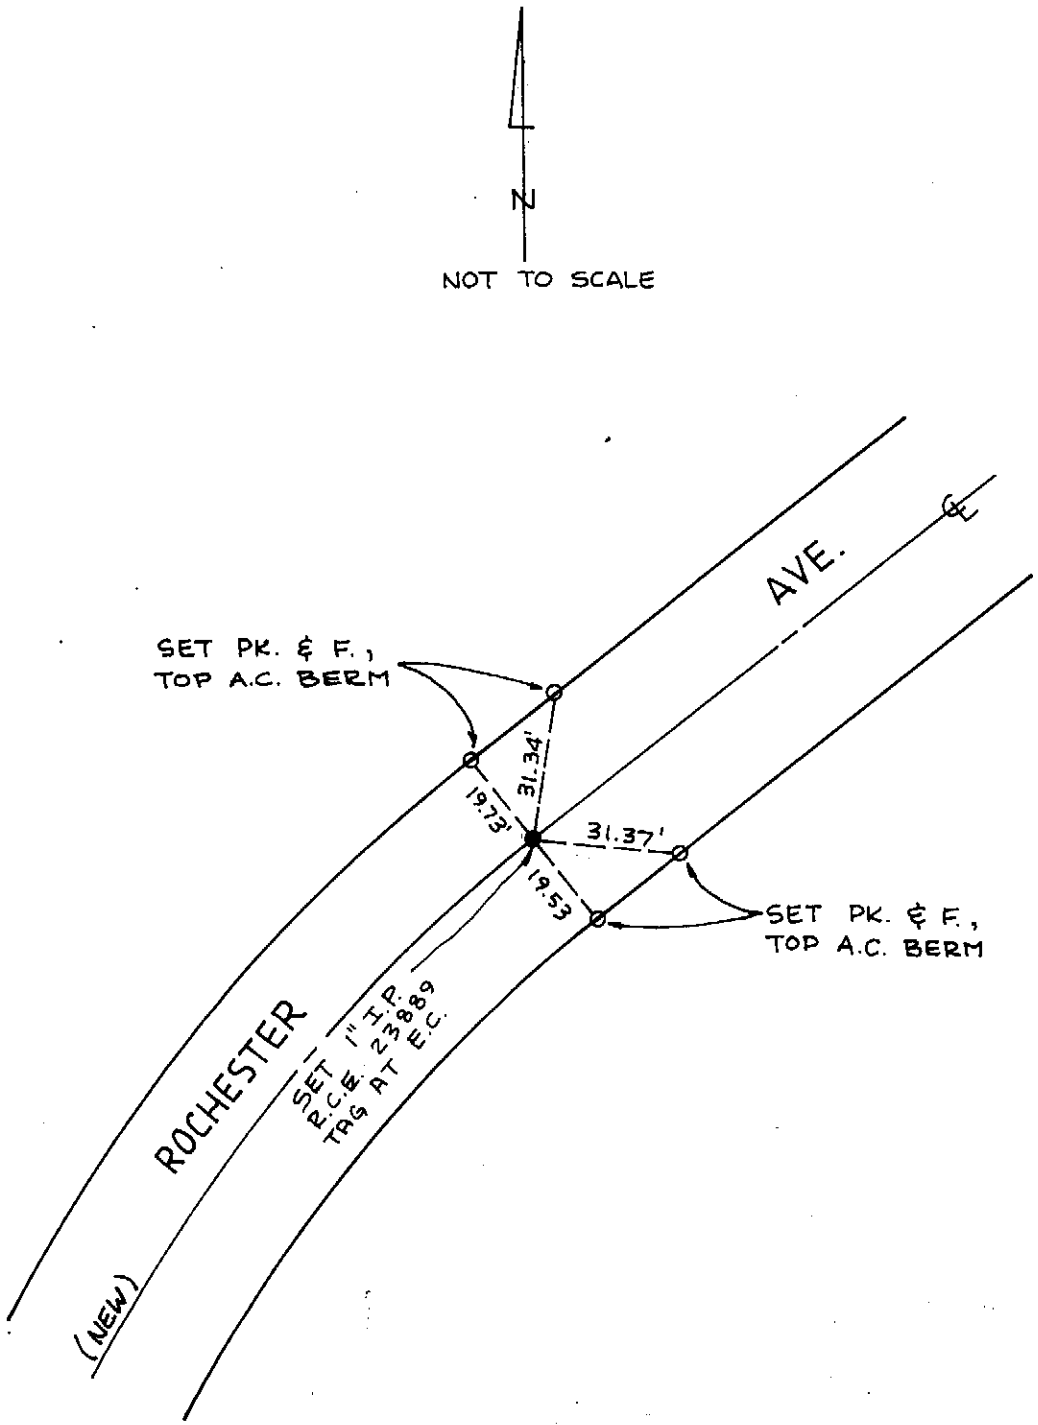

city of rancho cucamonga — STREET TIE	TRACT No.
ASSOCIATED ENGINEERS 316 EAST E STREET ONTARIO, CA. 91764 (714) 986-5818	CENTERLINE OF ROCHESTER AVE., 545'± NORTH OF 6TH ST.
~~ENGR.~~ / L.S. L.H. NOREEN	FIELD REVIEW _____ DATE _____
~~R.C.E.~~ / L.S. No. 3002 DATE 7/83	TIE BOOK 6 PAGE 65

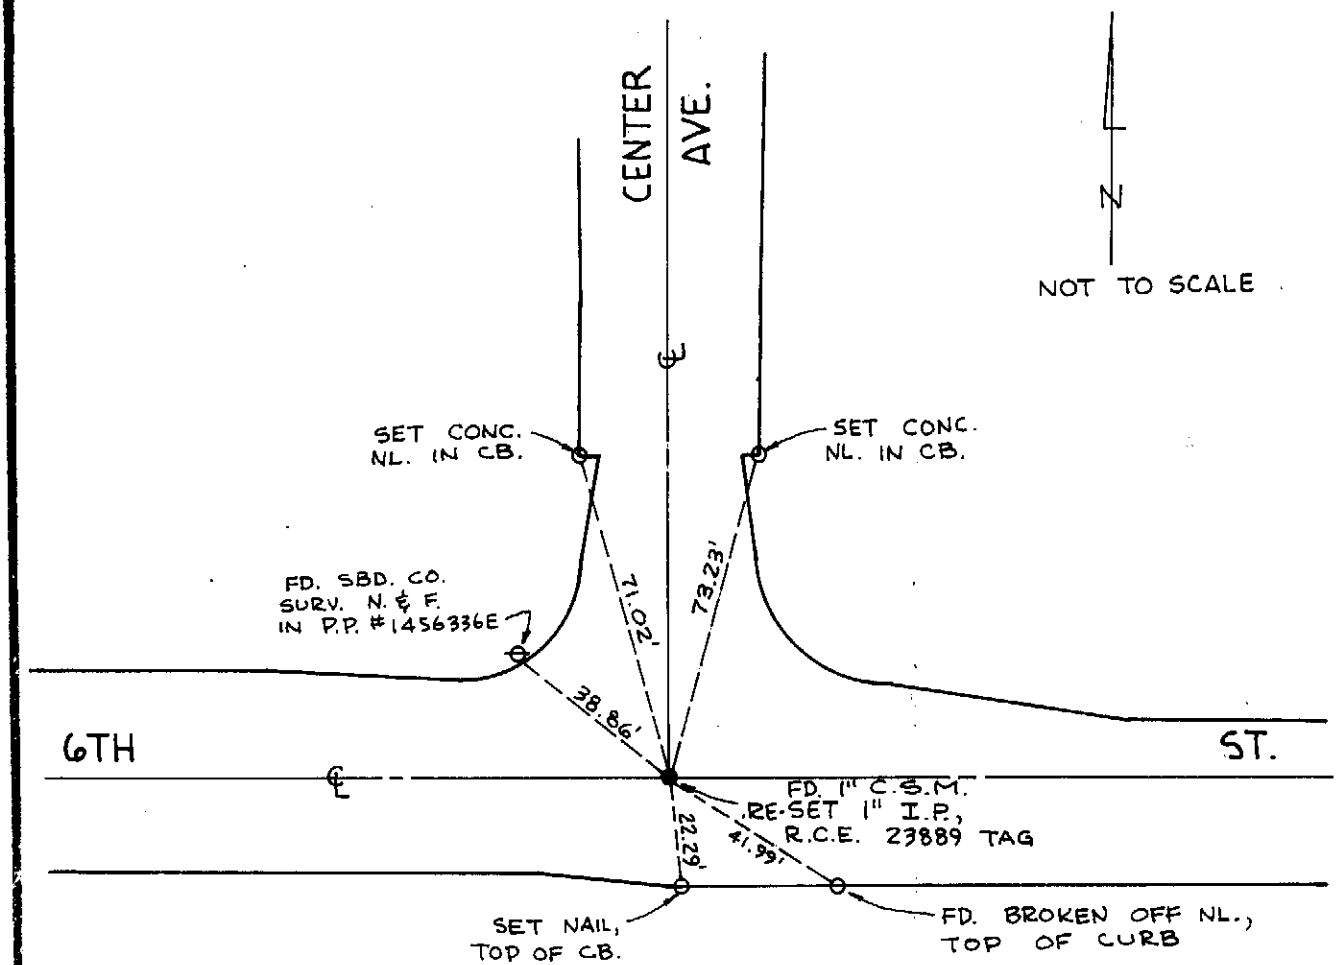

city of rancho cucamonga — STREET TIE	TRACT No.
ASSOCIATED ENGINEERS 316 EAST E STREET ONTARIO, CA. 91764 (714) 986-5818	CENTERLINE P.I. OF 6TH ST. AND CENTER AVE.
~~ENGR.~~ / L.S. L.H. NOREEN	FIELD REVIEW _____ DATE _____
~~R.C.E.~~ / L.S. No. 3002 DATE 7/83	TIE BOOK 6 PAGE 66

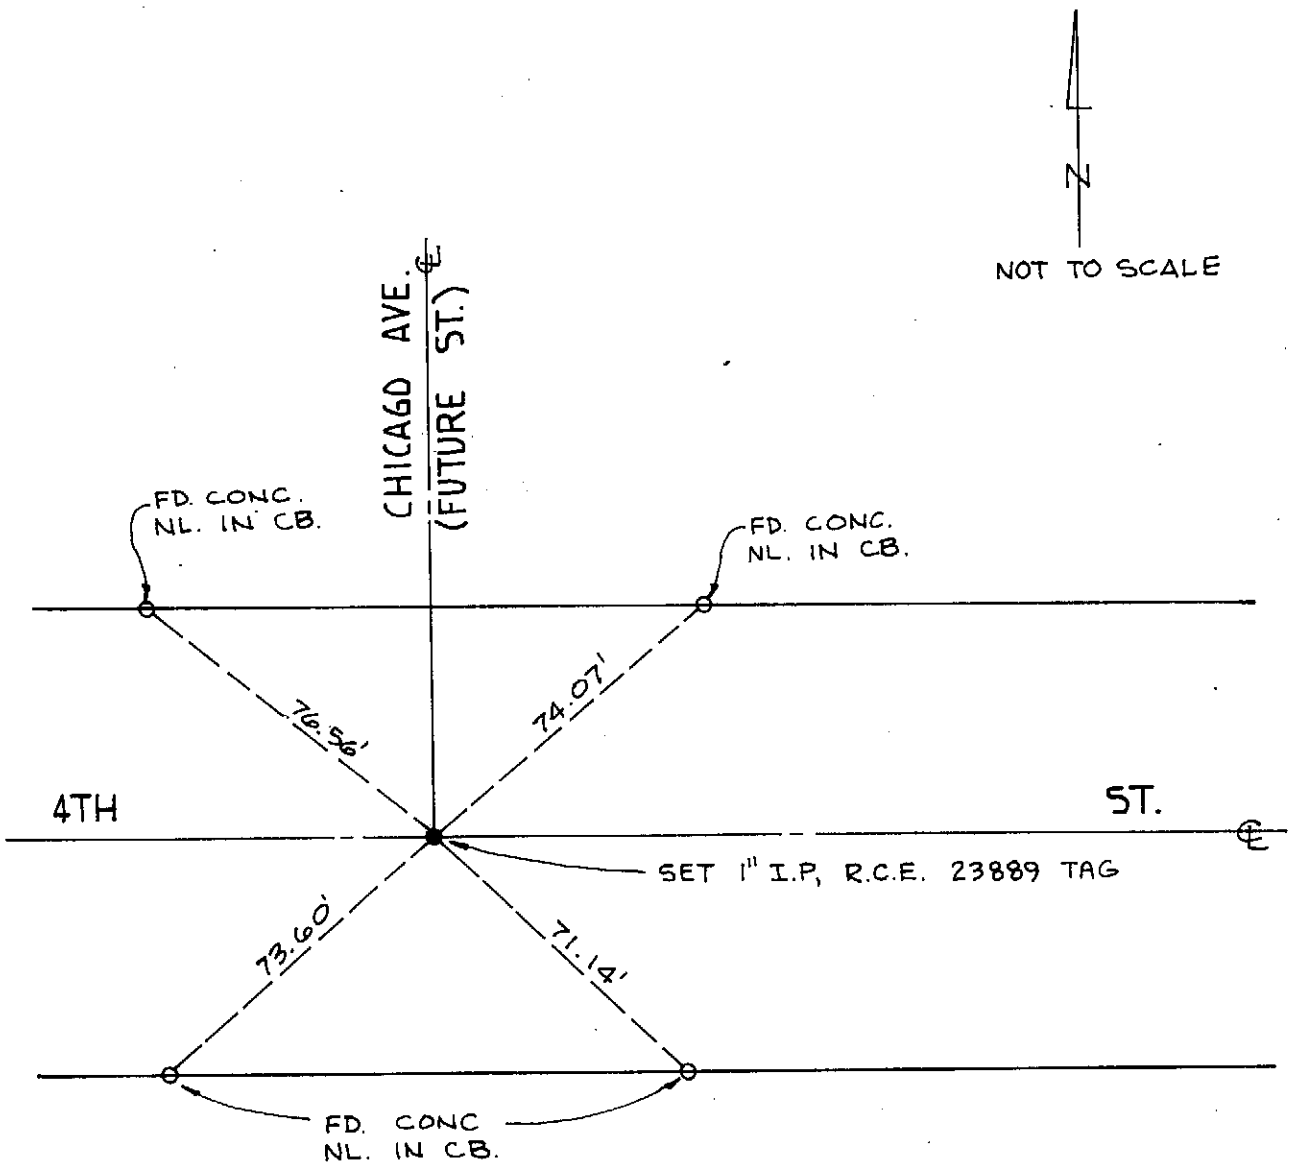

city of rancho cucamonga — STREET TIE	TRACT No.
ASSOCIATED ENGINEERS 316 EAST E STREET ONTARIO, CA. 91764 (714) 986-5818	CENTERLINE OF 4TH ST. 843' ± WEST OF BUFFALO AVE.
~~ENGR.~~/L.S. L.H. NOREEN	FIELD REVIEW _____ DATE _____
~~R.C.E.~~/L.S. No. 3002 DATE 7/83	TIE BOOK 6 PAGE 62

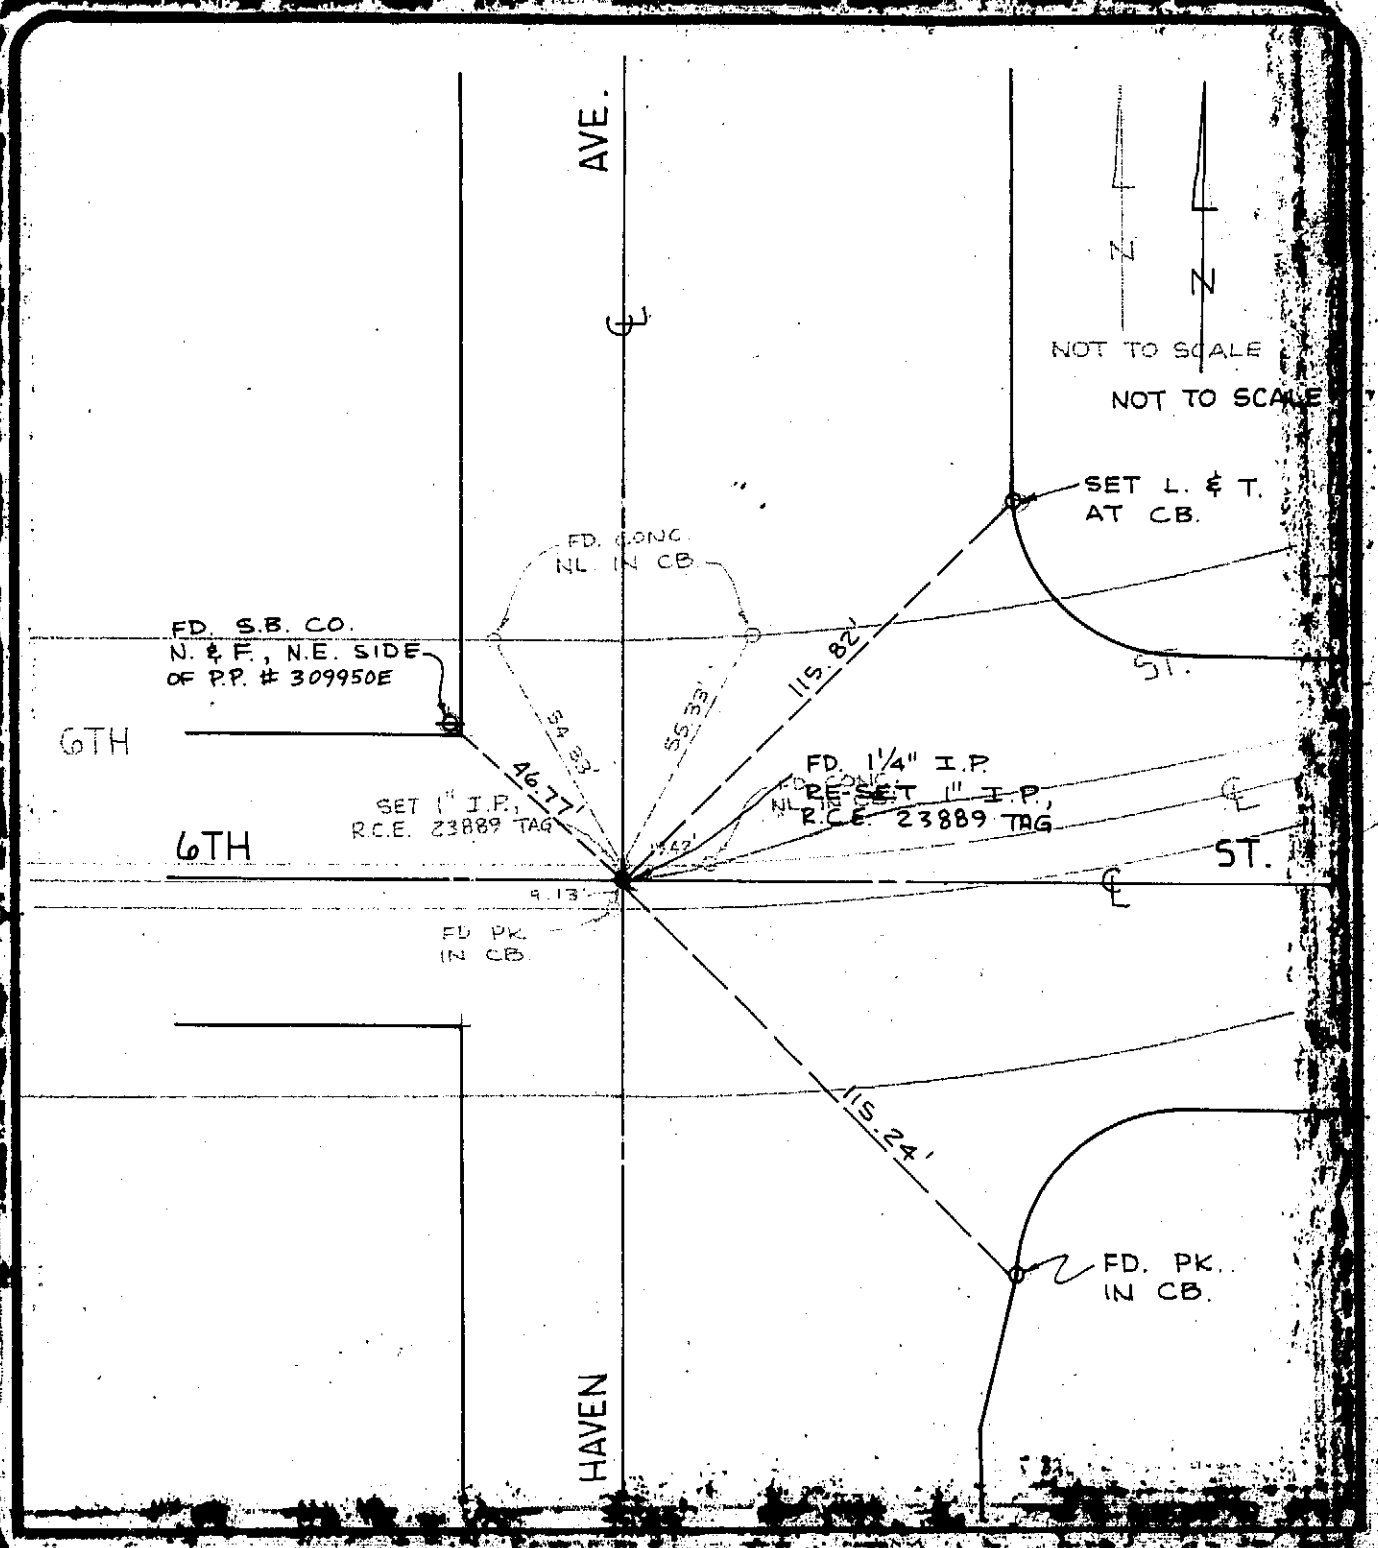

CITY OF RANCHO CUCAMONGA — STREET TIE	TRACT No.
ASSOCIATED ENGINEERS 316 EAST E STREET ONTARIO, CA 91764 (714) 986-5818	CENTERLINE OF 6TH ST. CENTERLINE P.I. OF 6TH ST. AND HAVEN AVE.
ENGR. L. H. NOREEN	
R.C.E. / L.S. No. 3002 DATE	

BOOK 6 PAGE 68

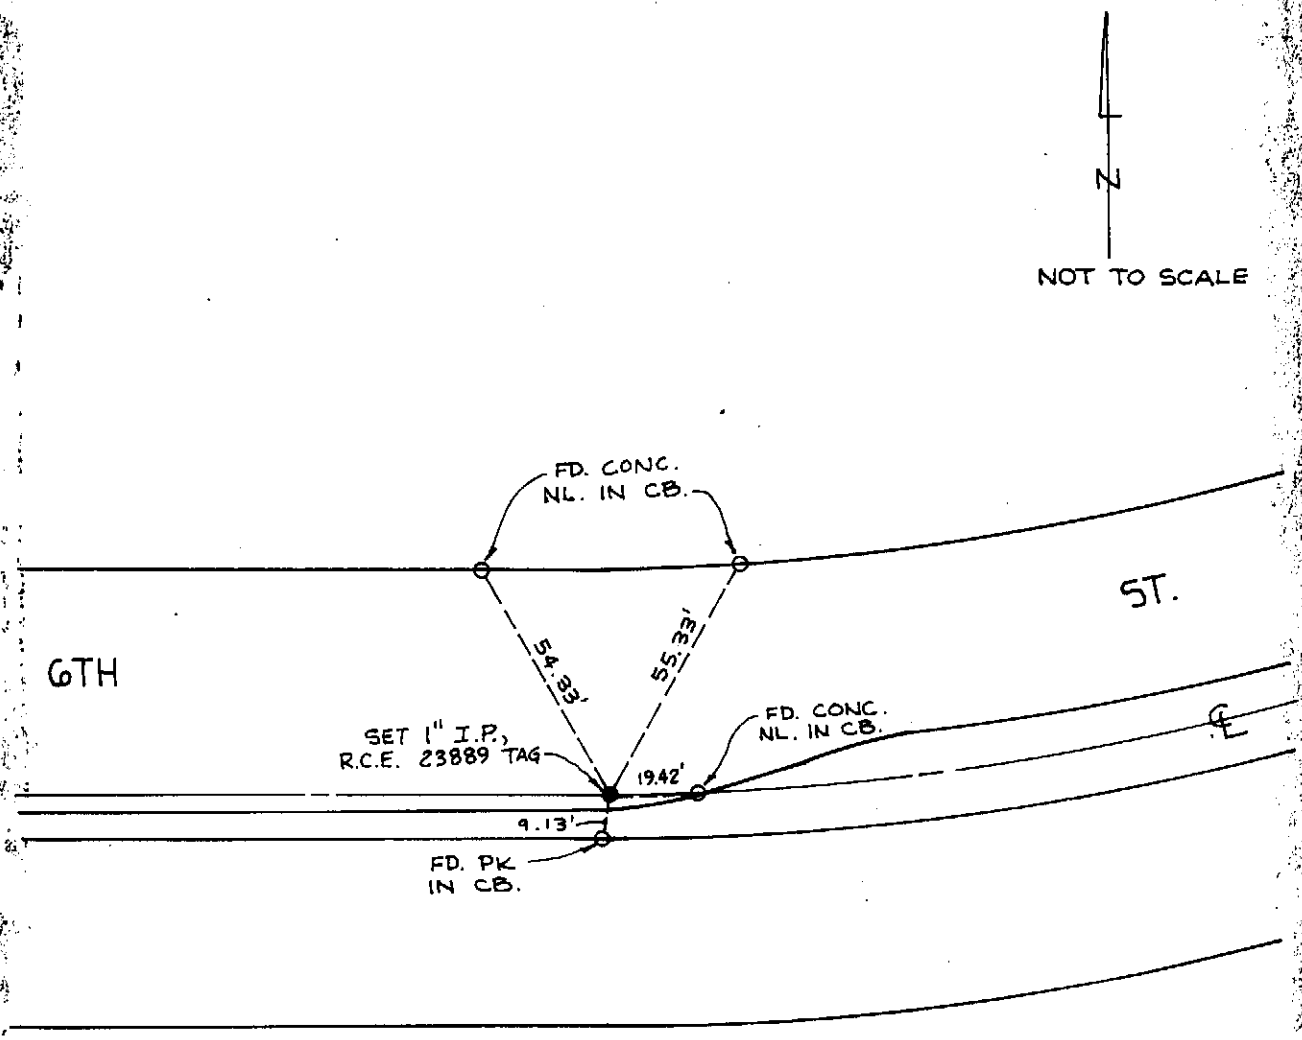

city of
rancho cuc
TRE
TIE

ASSO ATED
216 AST E
RIO, CA
(14) 986-5

ENGR. L.H. REEN

R.C.E. 02 7/83

TRACT No.

CENTERLINE OF 6TH ST.
APPROX. 1155'± EAST OF
PITTSBURGH AVE.

Book 6 Pg 69

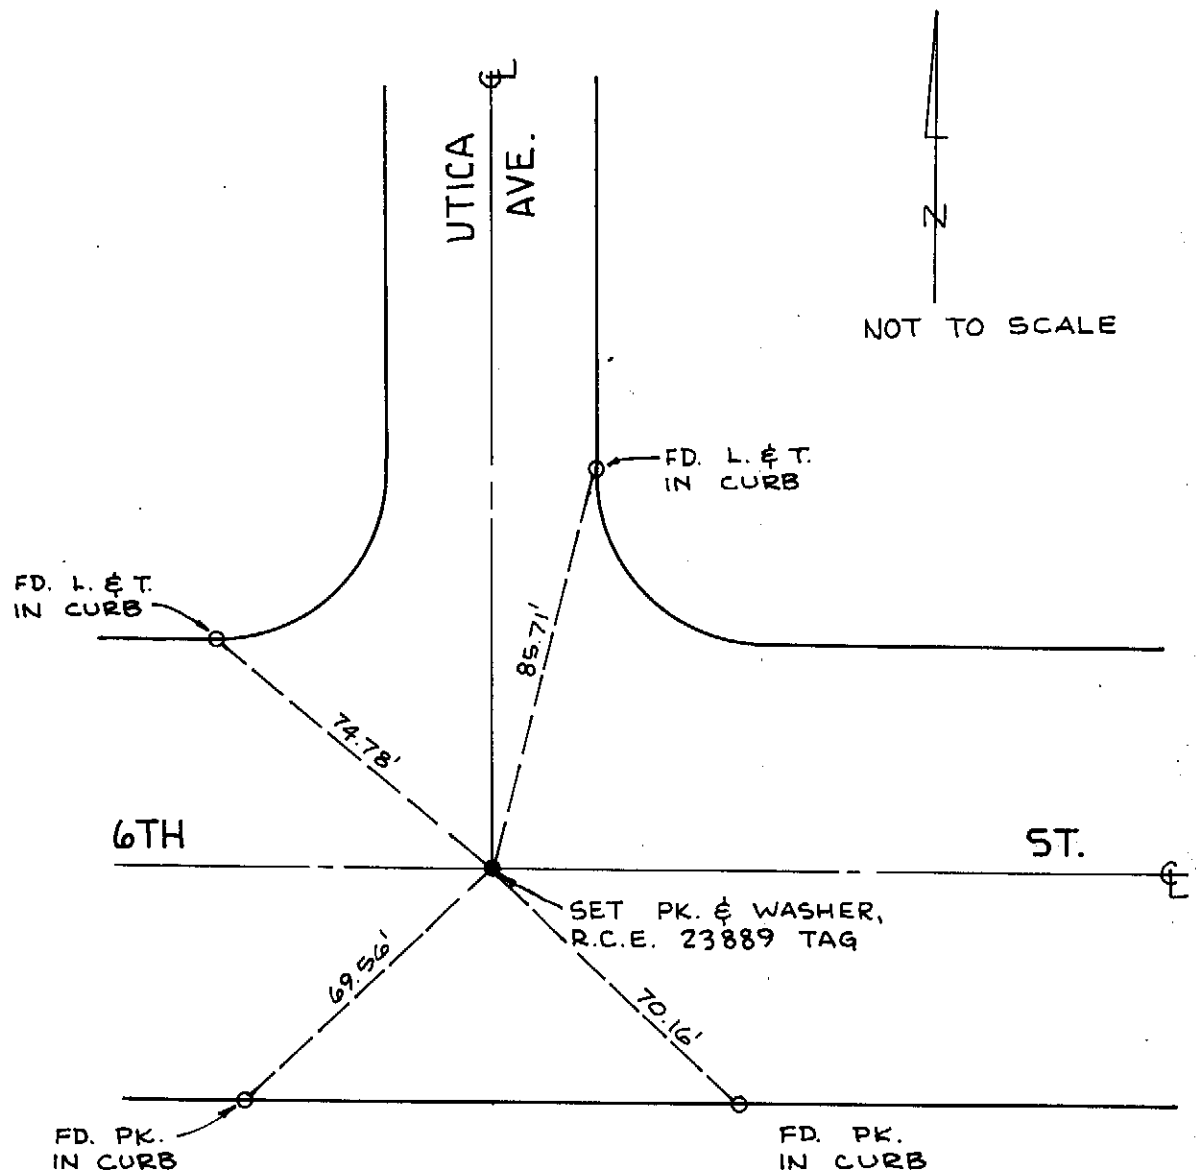

city of rancho cucamonga — STREET TIE	TRACT No.
ASSOCIATED ENGINEERS 316 EAST E STREET ONTARIO, CA. 91764 (714) 986-5818	CENTERLINE OF 6TH ST. AND UTICA AVE.
ENGR./L.S. L.H. NOREEN	FIELD REVIEW ____ DATE ____
R.C.E./L.S. No. 3002 DATE 7/83	TIE BOOK 6 PAGE 70

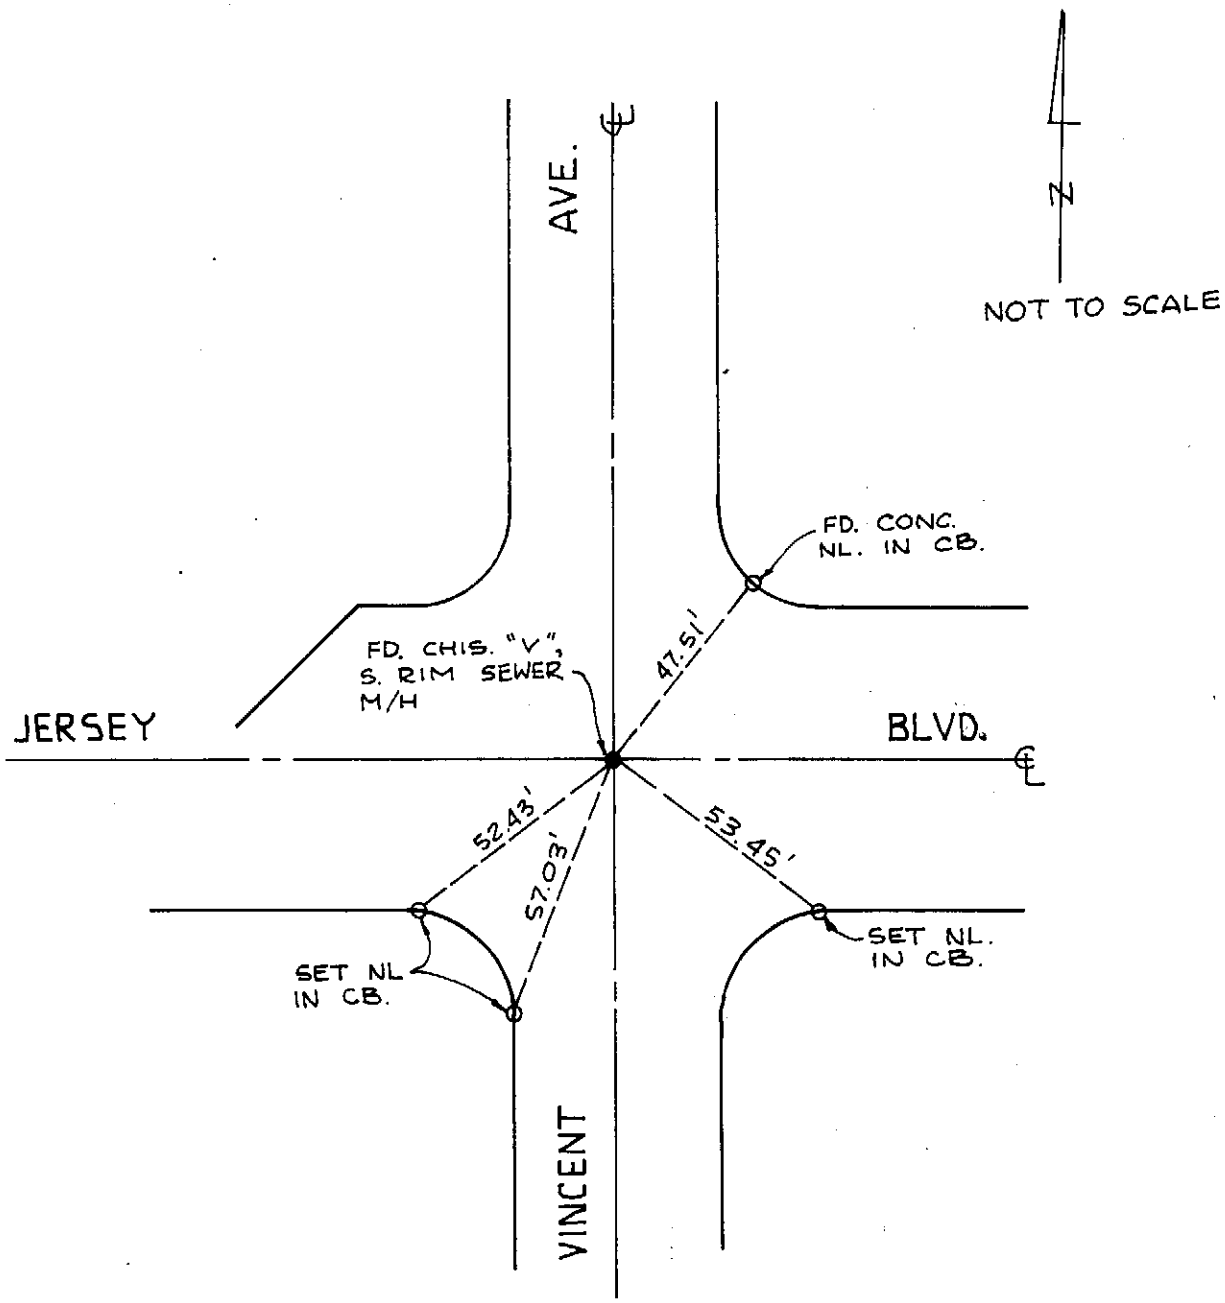

city of rancho cucamonga — STREET TIE	TRACT No.
ASSOCIATED ENGINEERS 316 EAST E STREET ONTARIO, CA. 91764 (714) 986-5818	CENTERLINE P.I. OF VINCENT AVE. AND JERSEY BLVD.
~~ENGR.~~ / L.S. L.H. NOREEN	FIELD REVIEW _____ DATE _____
~~R.C.E.~~ / L.S. No. 3002 DATE 7/83	TIE BOOK 6 PAGE 71

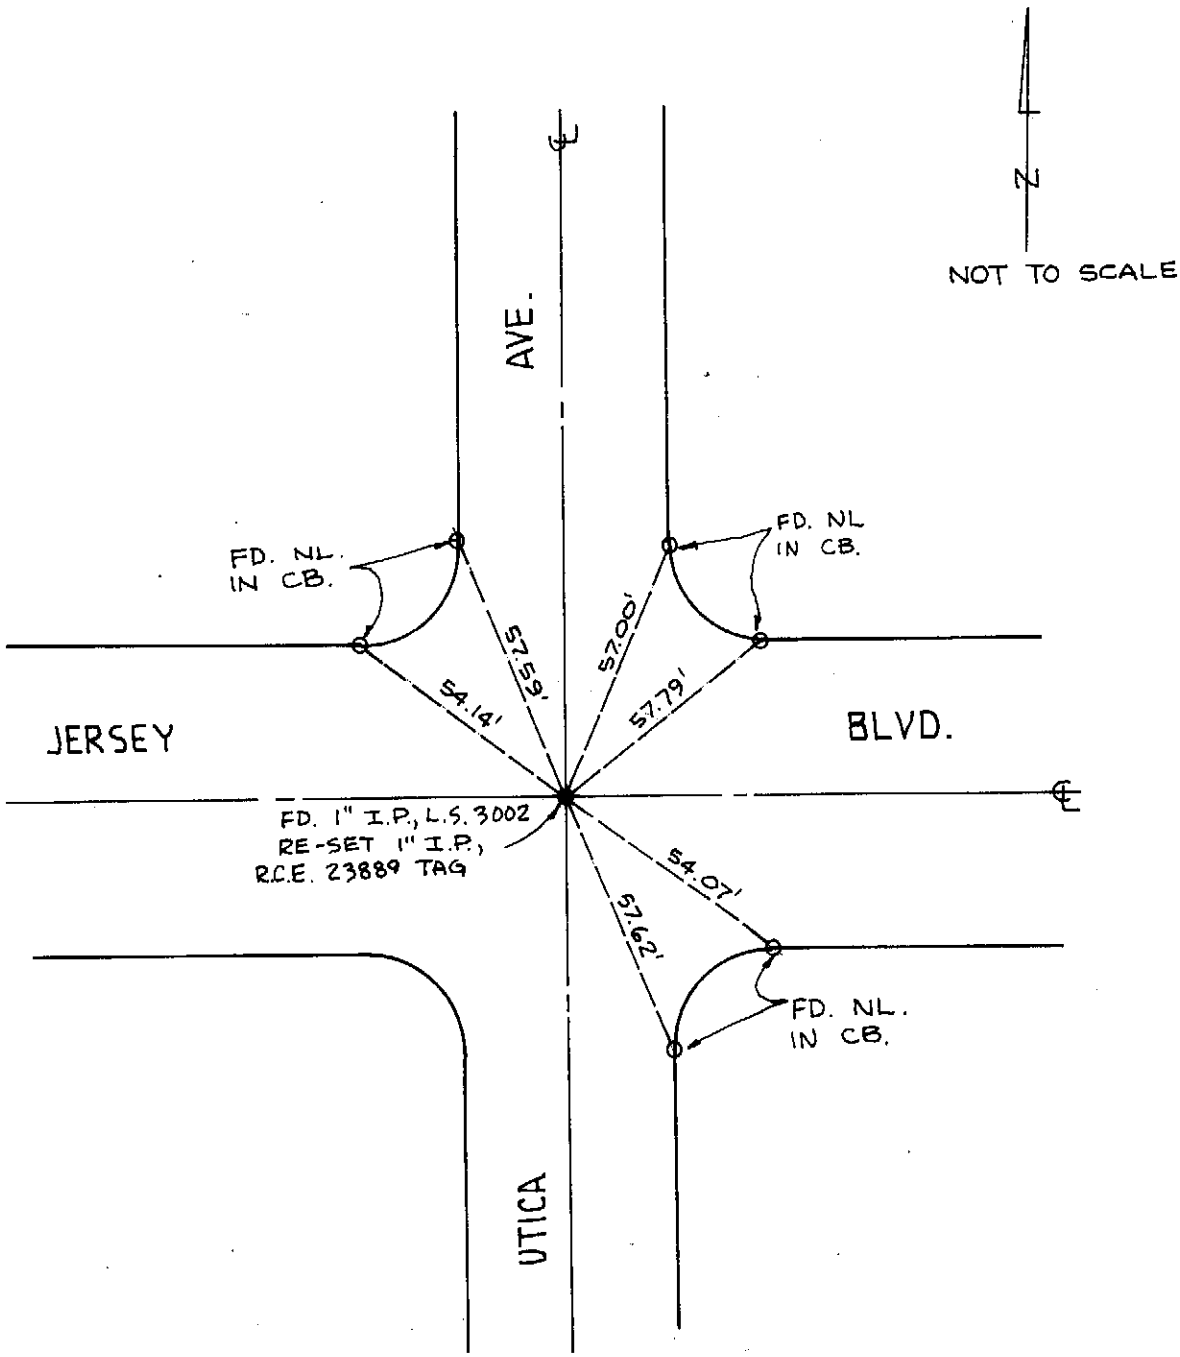

city of rancho cucamonga — STREET TIE	TRACT No.
ASSOCIATED ENGINEERS 316 EAST E STREET ONTARIO, CA. 91764 (714) 986-5818	CENTERLINE P.I. OF UTICA AVE. AND JERSEY BLVD.
ENGR./L.S. L.H. NOREEN	FIELD REVIEW _____ DATE _____
R.C.E./L.S. No. 3002 DATE 7/83	TIE BOOK 6 PAGE 72

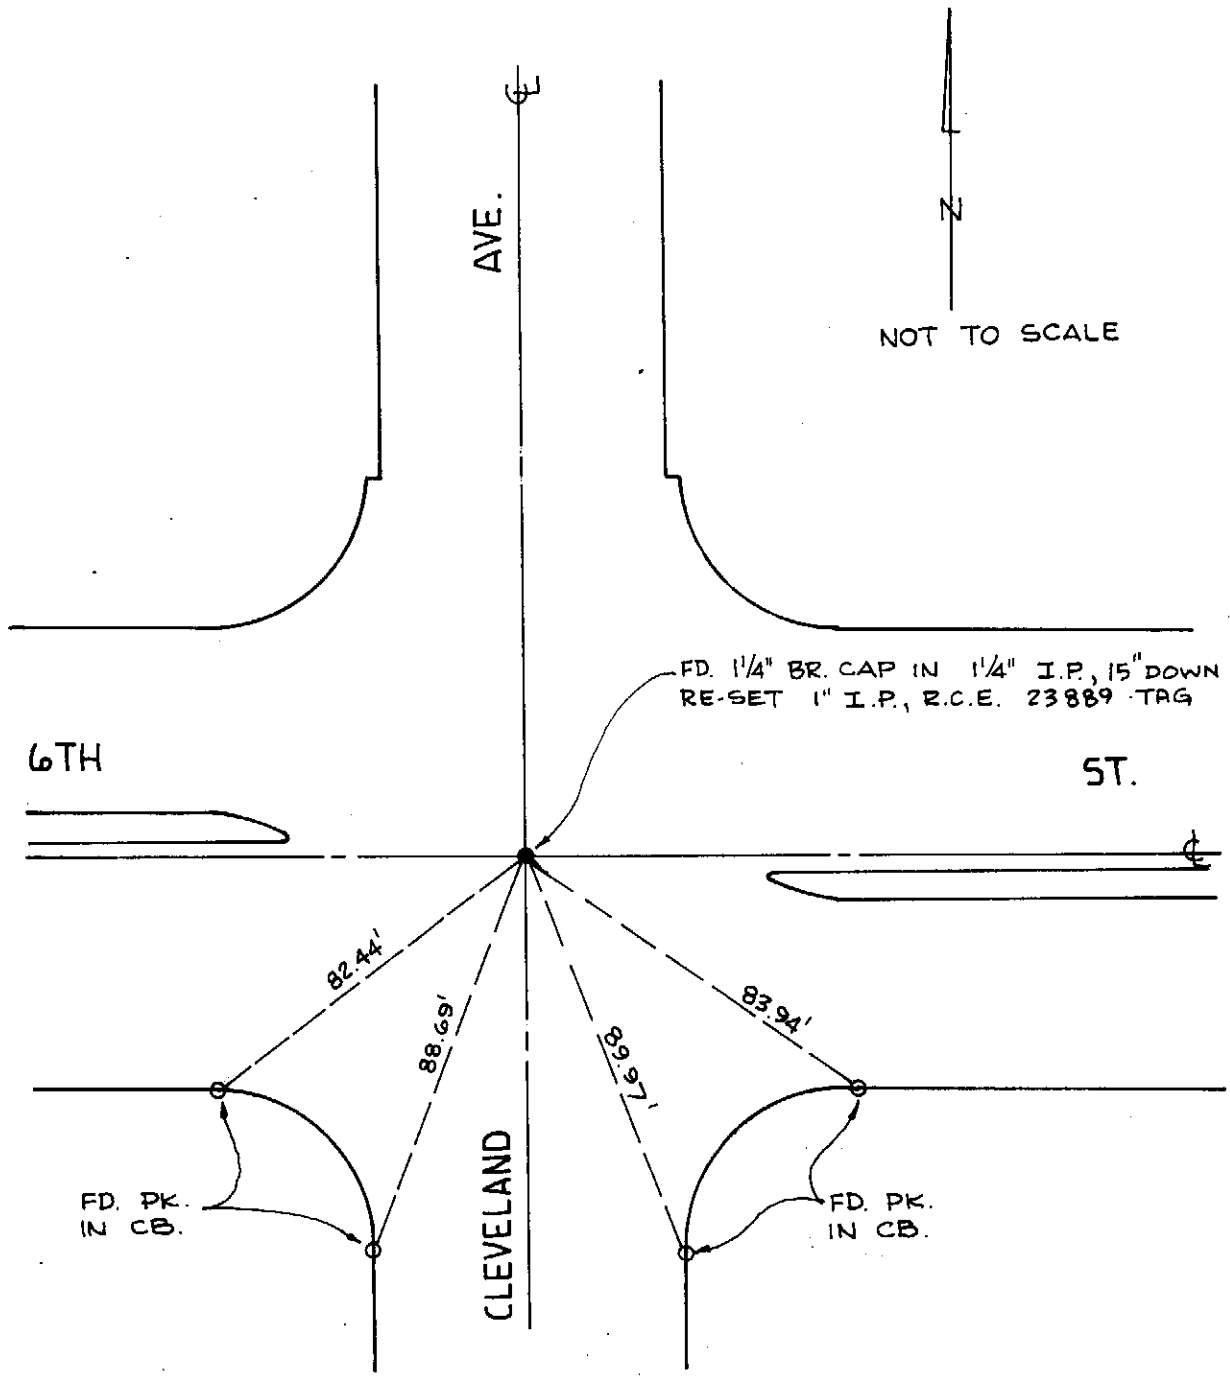

city of rancho cucamonga — STREET TIE	TRACT No.
ASSOCIATED ENGINEERS 316 EAST E STREET ONTARIO, CA. 91764 (714) 986-5818	CENTERLINE P.I. OF 6TH ST. AND CLEVELAND AVE.
ENGR./L.S. L.H. NOREEN	FIELD REVIEW _____ DATE _____
R.C.E./L.S. No. 3002 DATE _____	TIE BOOK 6 PAGE 73

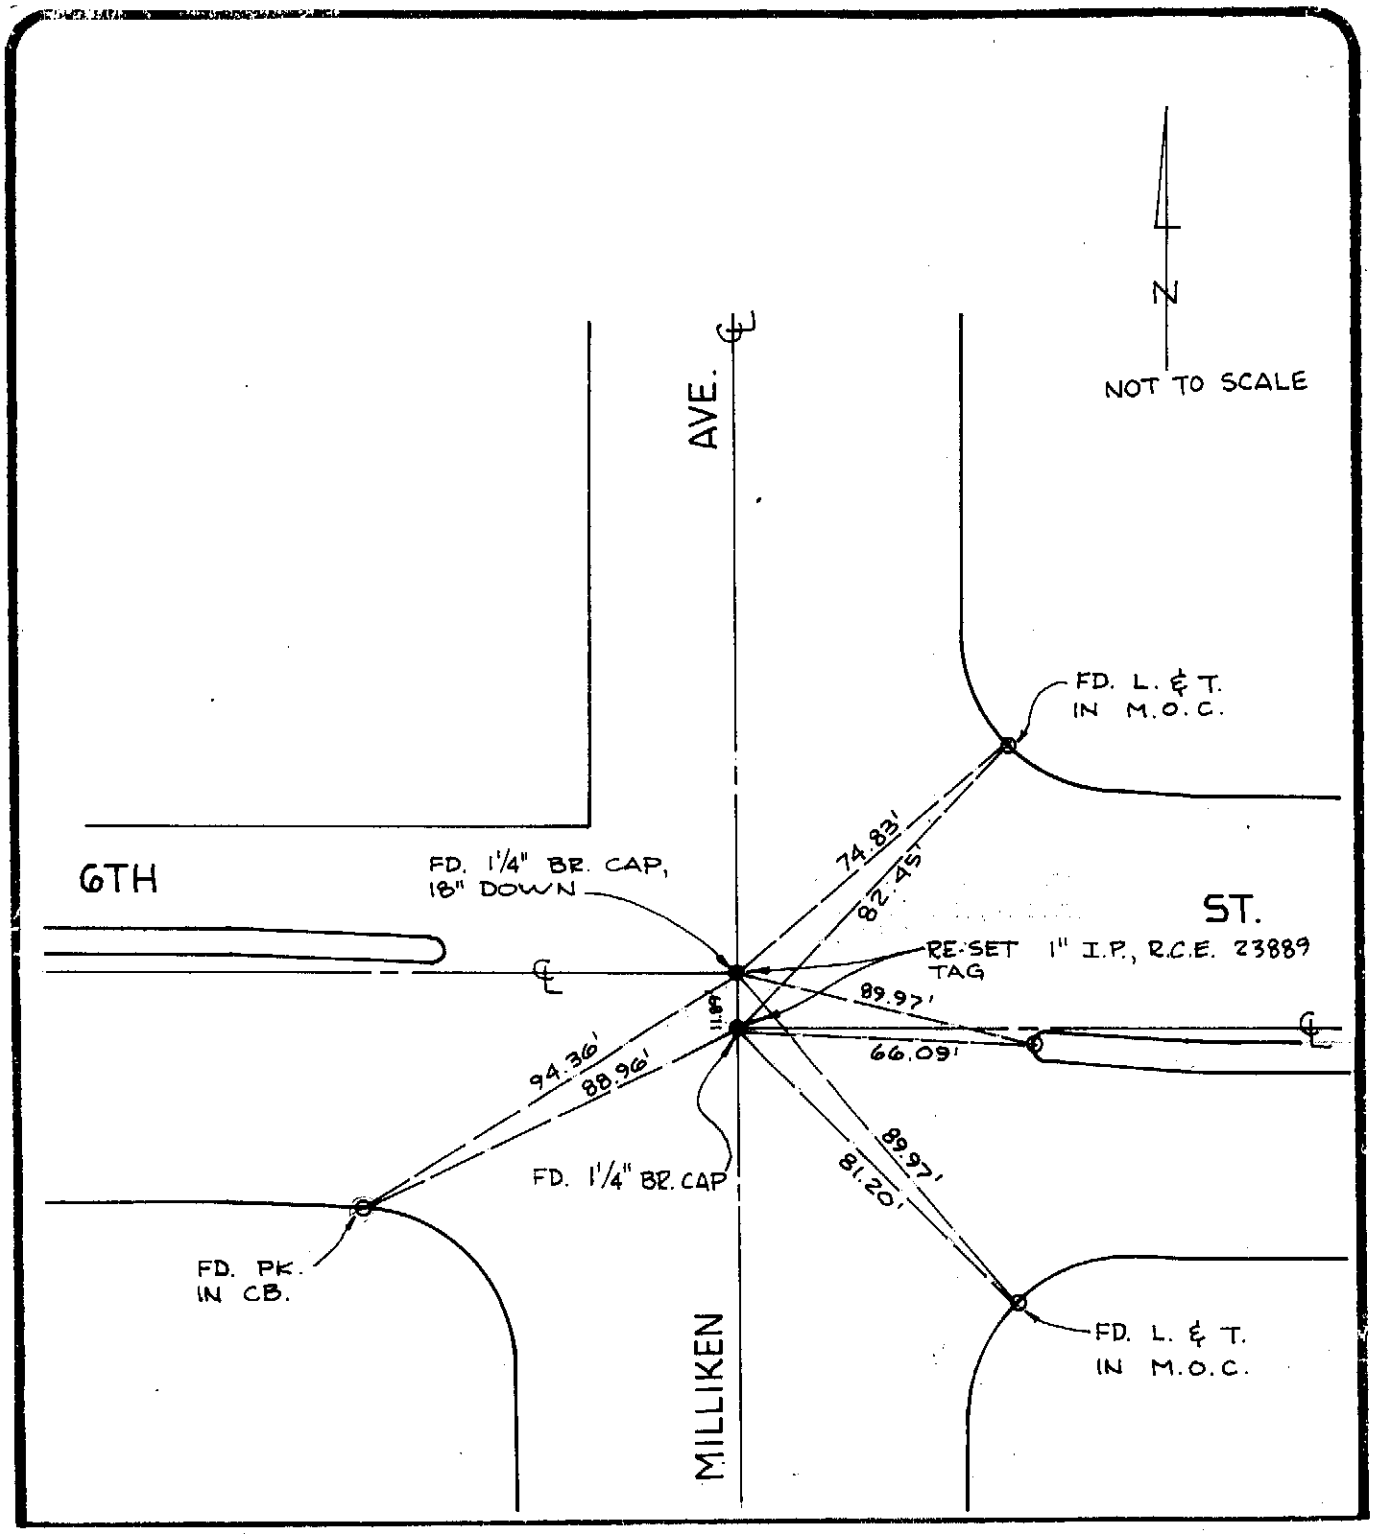

city of rancho cucamonga — STREET TIE	TRACT No.
ASSOCIATED ENGINEERS 316 EAST E STREET ONTARIO, CA. 91764 (714) 986-5818	CENTERLINE P.I. OF 6TH ST. AND MILLIKEN AVE.
ENGR./L.S. L.H. NOREEN	FIELD REVIEW _____ DATE _____
R.C.E./L.S. No. 3002 DATE 7/83	TIE BOOK 6 PAGE 74

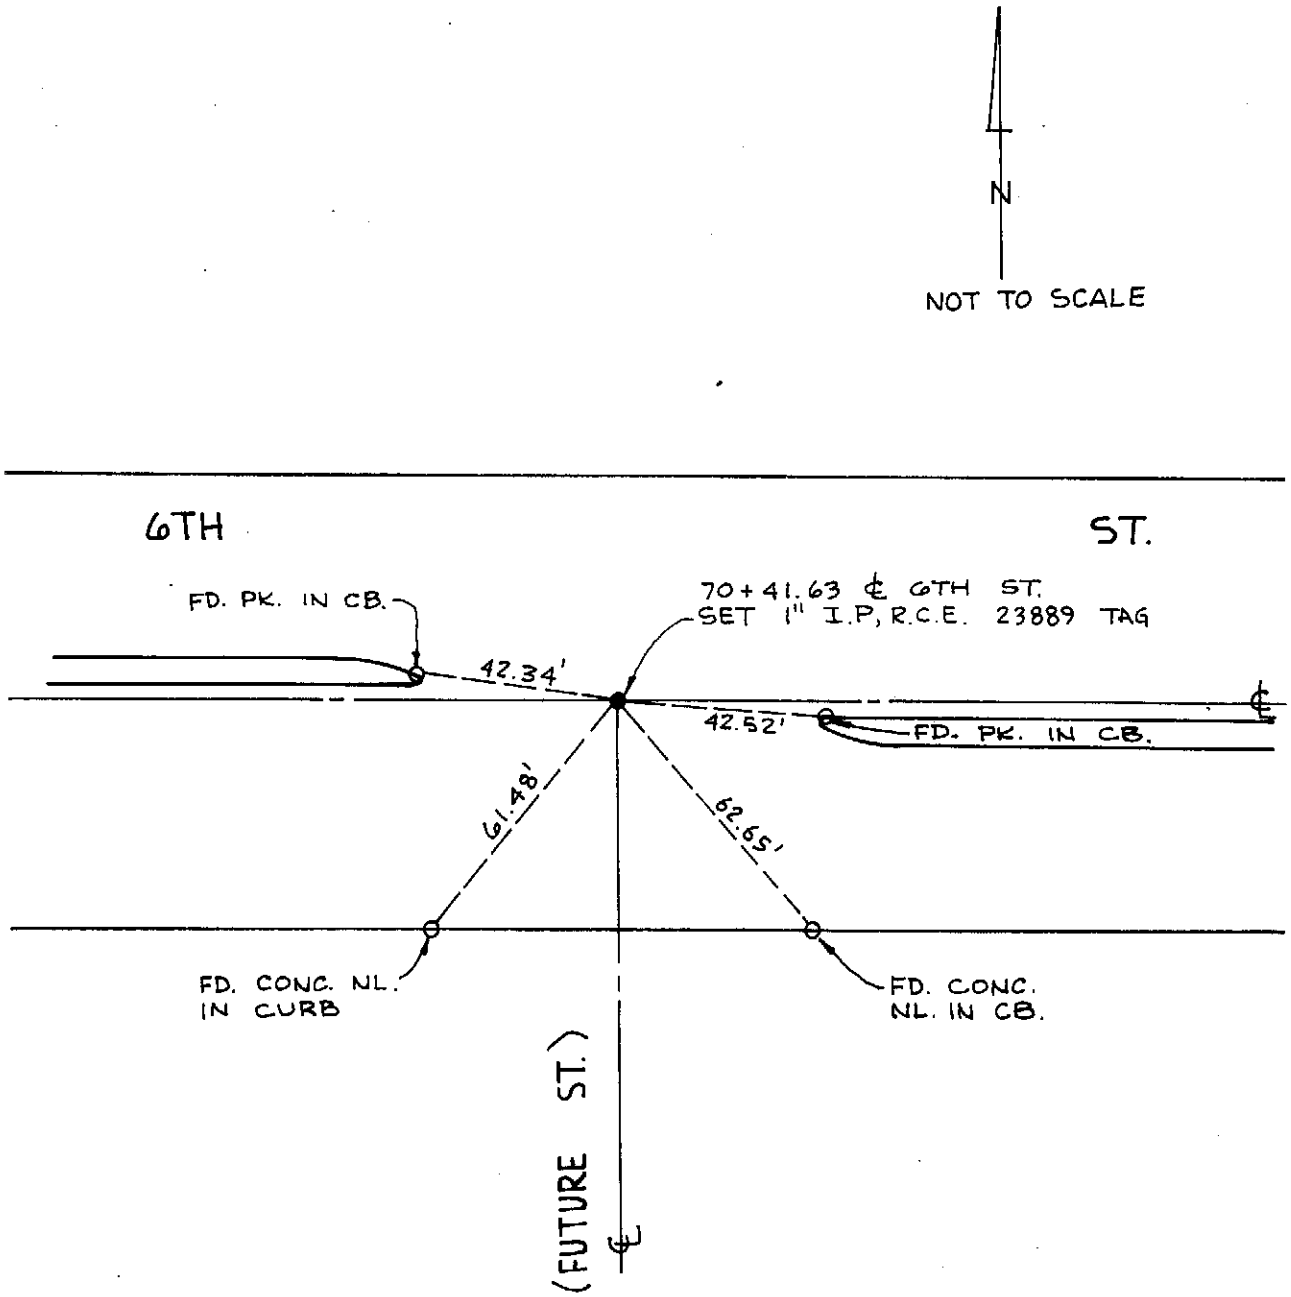

city of rancho cucamonga — STREET TIE	TRACT No.
ASSOCIATED ENGINEERS 316 EAST E STREET ONTARIO, CA. 91764 (714) 986-5818	CENTERLINE OF 6TH ST., 1327'± EAST OF CLEVELAND AVE.
~~ENGR.~~/L.S. L.H. NOREEN	FIELD REVIEW _____ DATE _____
~~R.C.E.~~/L.S. No. 3002 DATE 7/83	TIE BOOK 6 PAGE 75

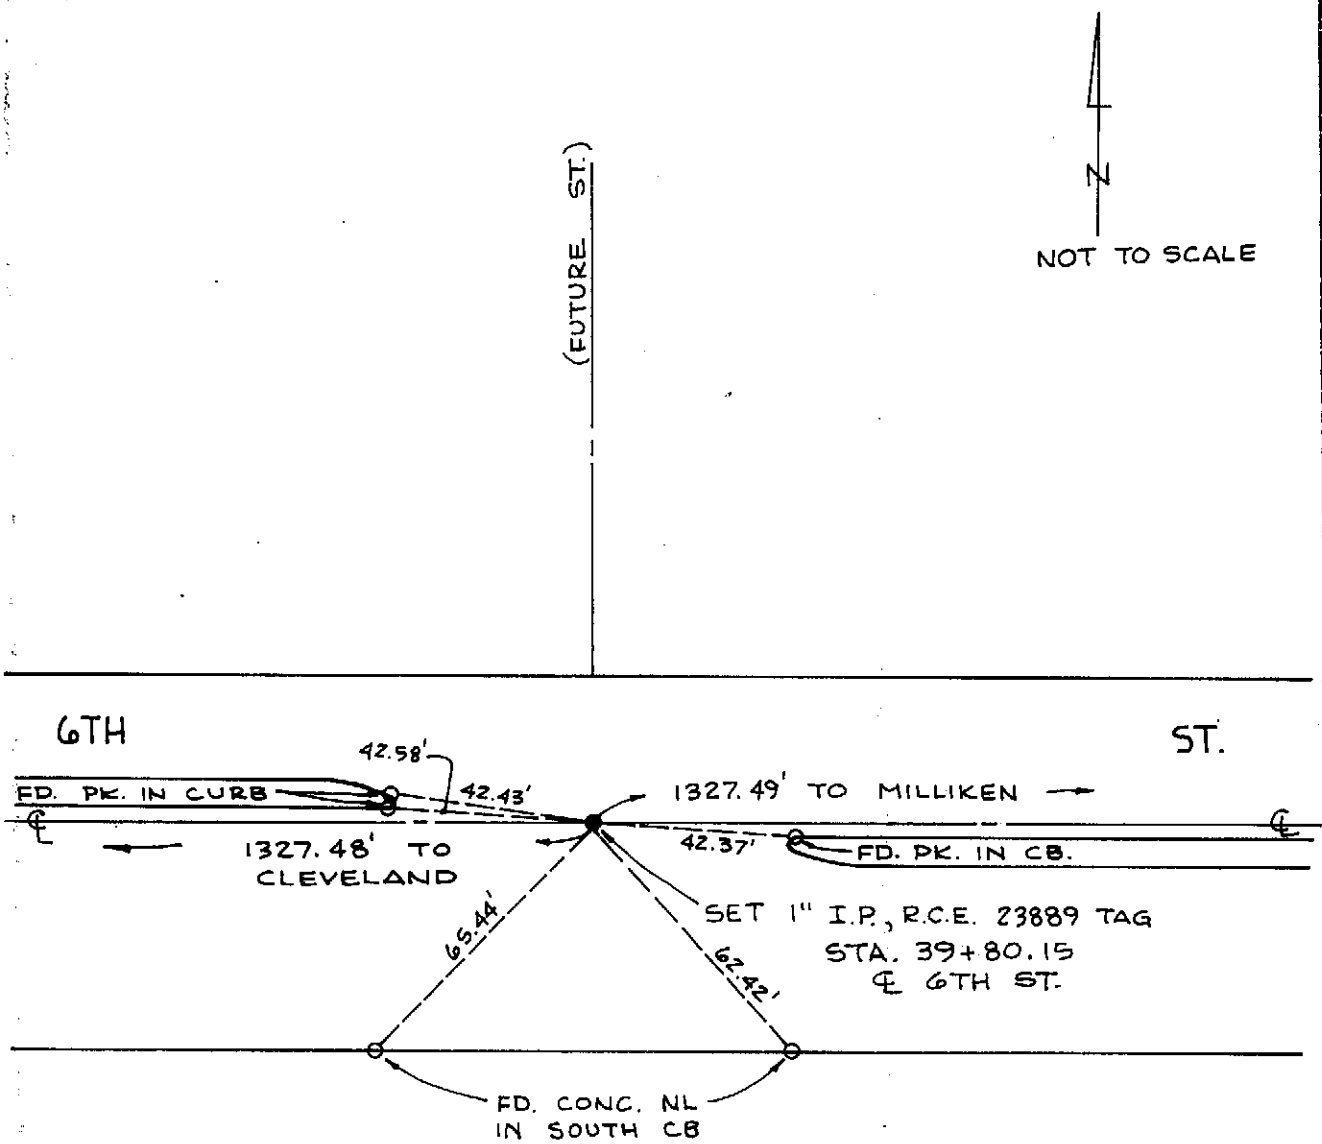

city of rancho cucamonga — STREET TIE	TRACT No.
ASSOCIATED ENGINEERS 316 EAST E STREET ONTARIO, CA. 91764 (714) 986-5818	CENTERLINE OF 6TH ST., 1327'± WEST OF MILLIKEN AVE.
~~ENGR.~~/L.S. L.H. NOREEN	FIELD REVIEW _____ DATE _____
~~R.C.E.~~/L.S. No. 3002 DATE 7/83	TIE BOOK 6 PAGE 76

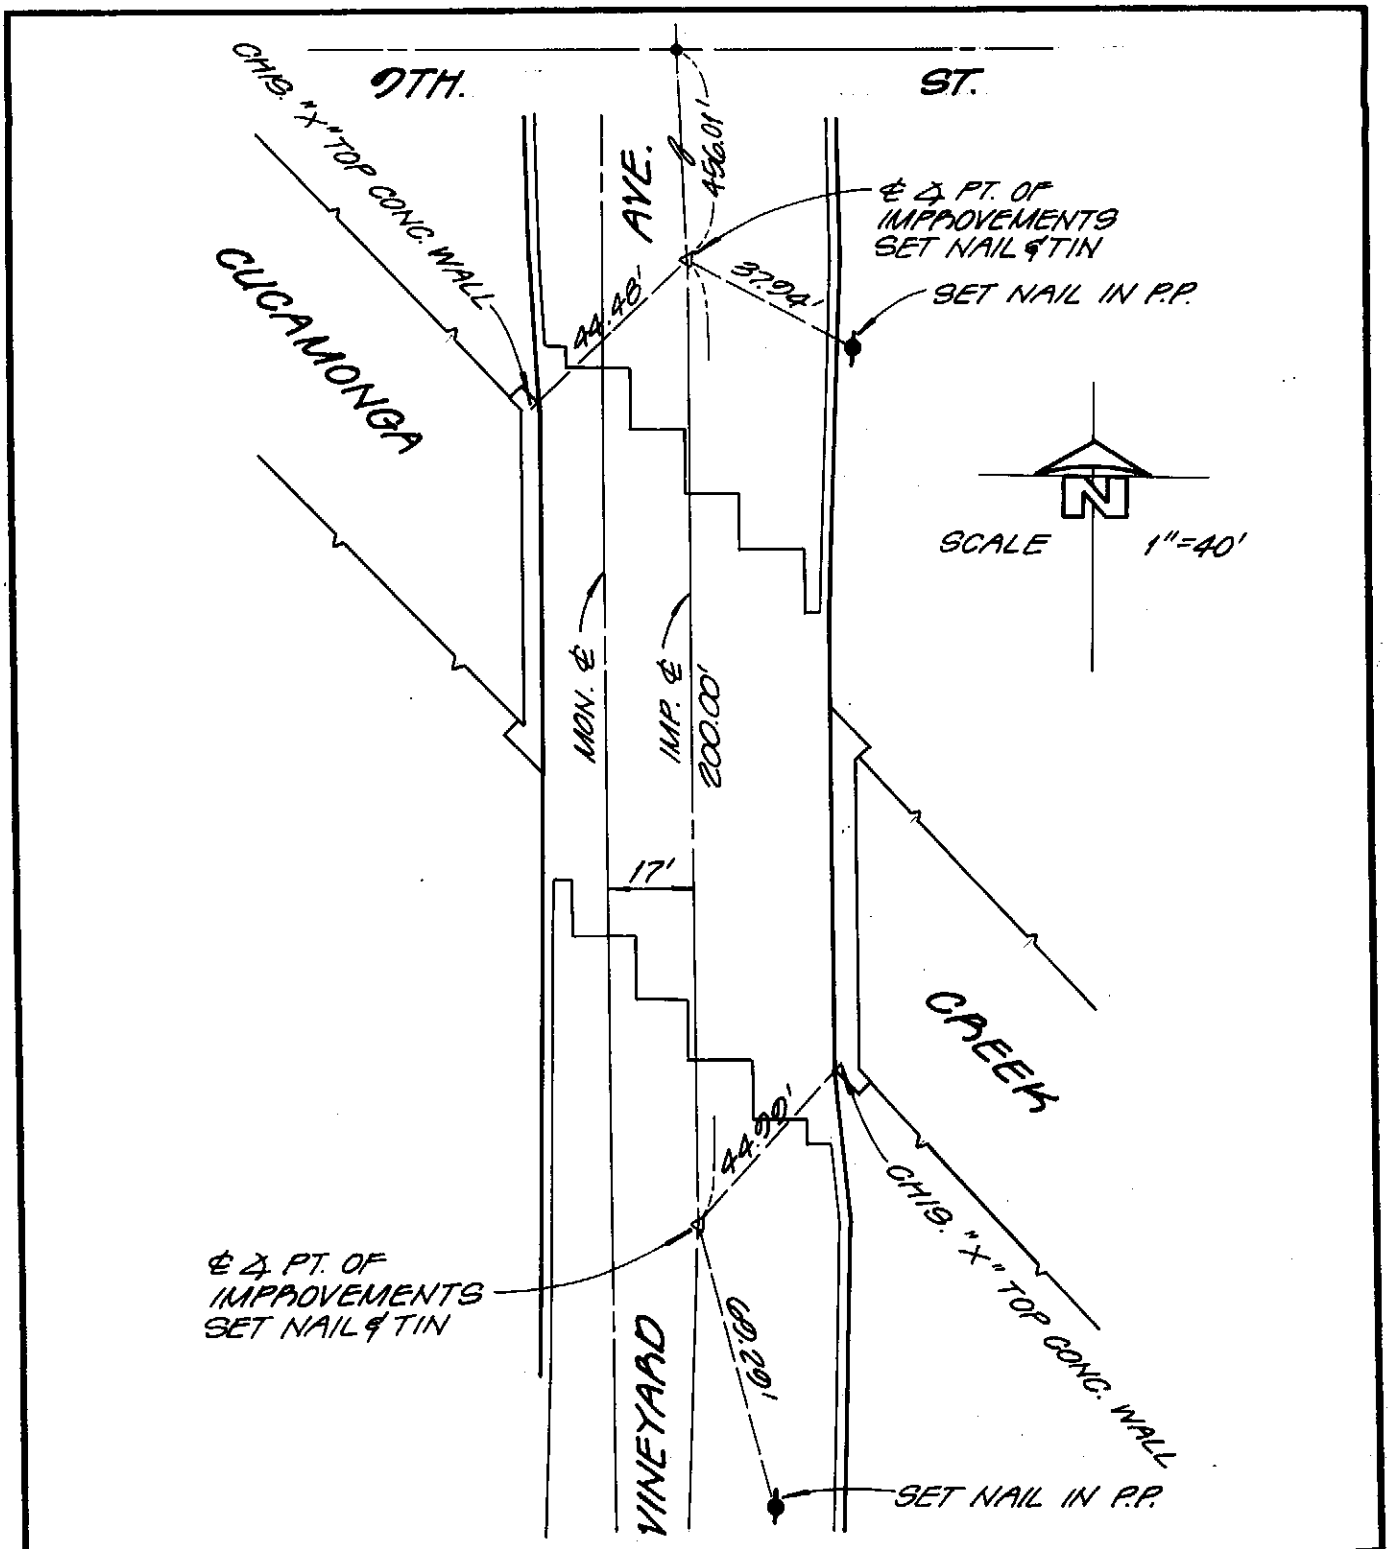

city of rancho cucamonga

STREET TIE

CG ENGINEERING
Planning and Engineering
2827 SO. WATERMAN AVE., SUITE E, SAN BERNARDINO, CA 92408

VINEYARD AVENUE AND CUCAMONGA CREEK

ENGR. David Barbian

FIELD REVIEW _____ DATE _____

R.C.E. No. 28931 DATE 11-21-83

TIE BOOK 6 PAGE 78

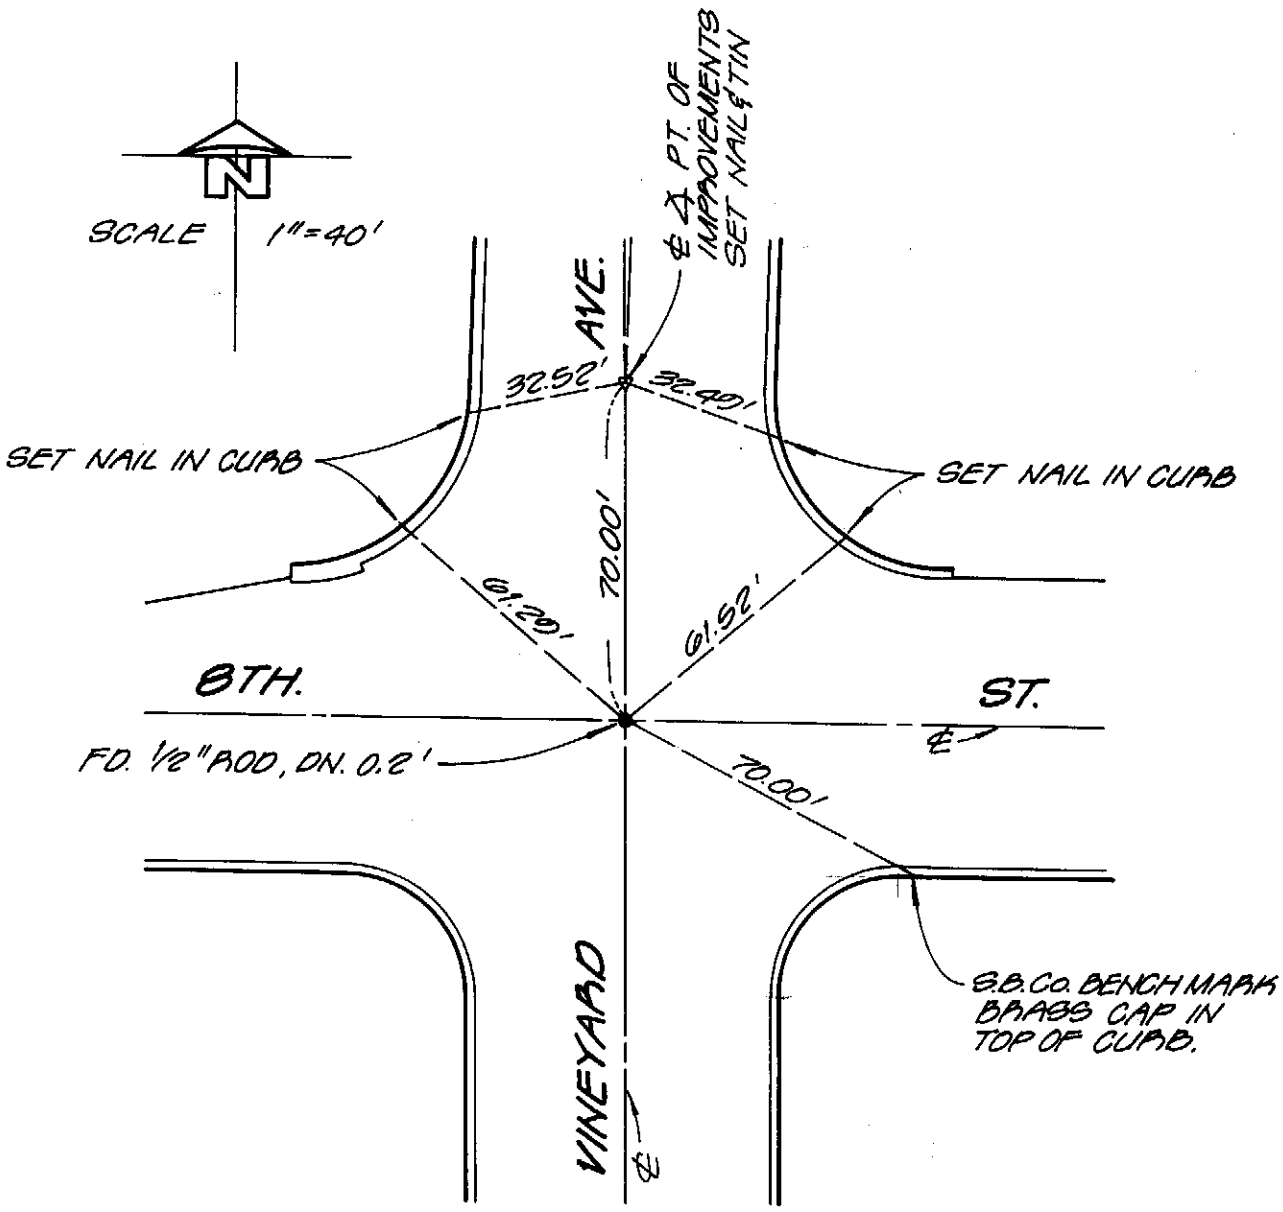

city of rancho cucamonga — STREET TIE	
CG ENGINEERING *Planning and Engineering* 2627 SO WATERMAN AVE., SUITE E, SAN BERNARDINO, CA 92408	VINEYARD AVENUE AND EIGHTH STREET
ENGR. David Barkin	FIELD REVIEW _____ DATE _____
R.C.E. No. 28931 DATE 11-21-83	TIE BOOK 6 PAGE 79

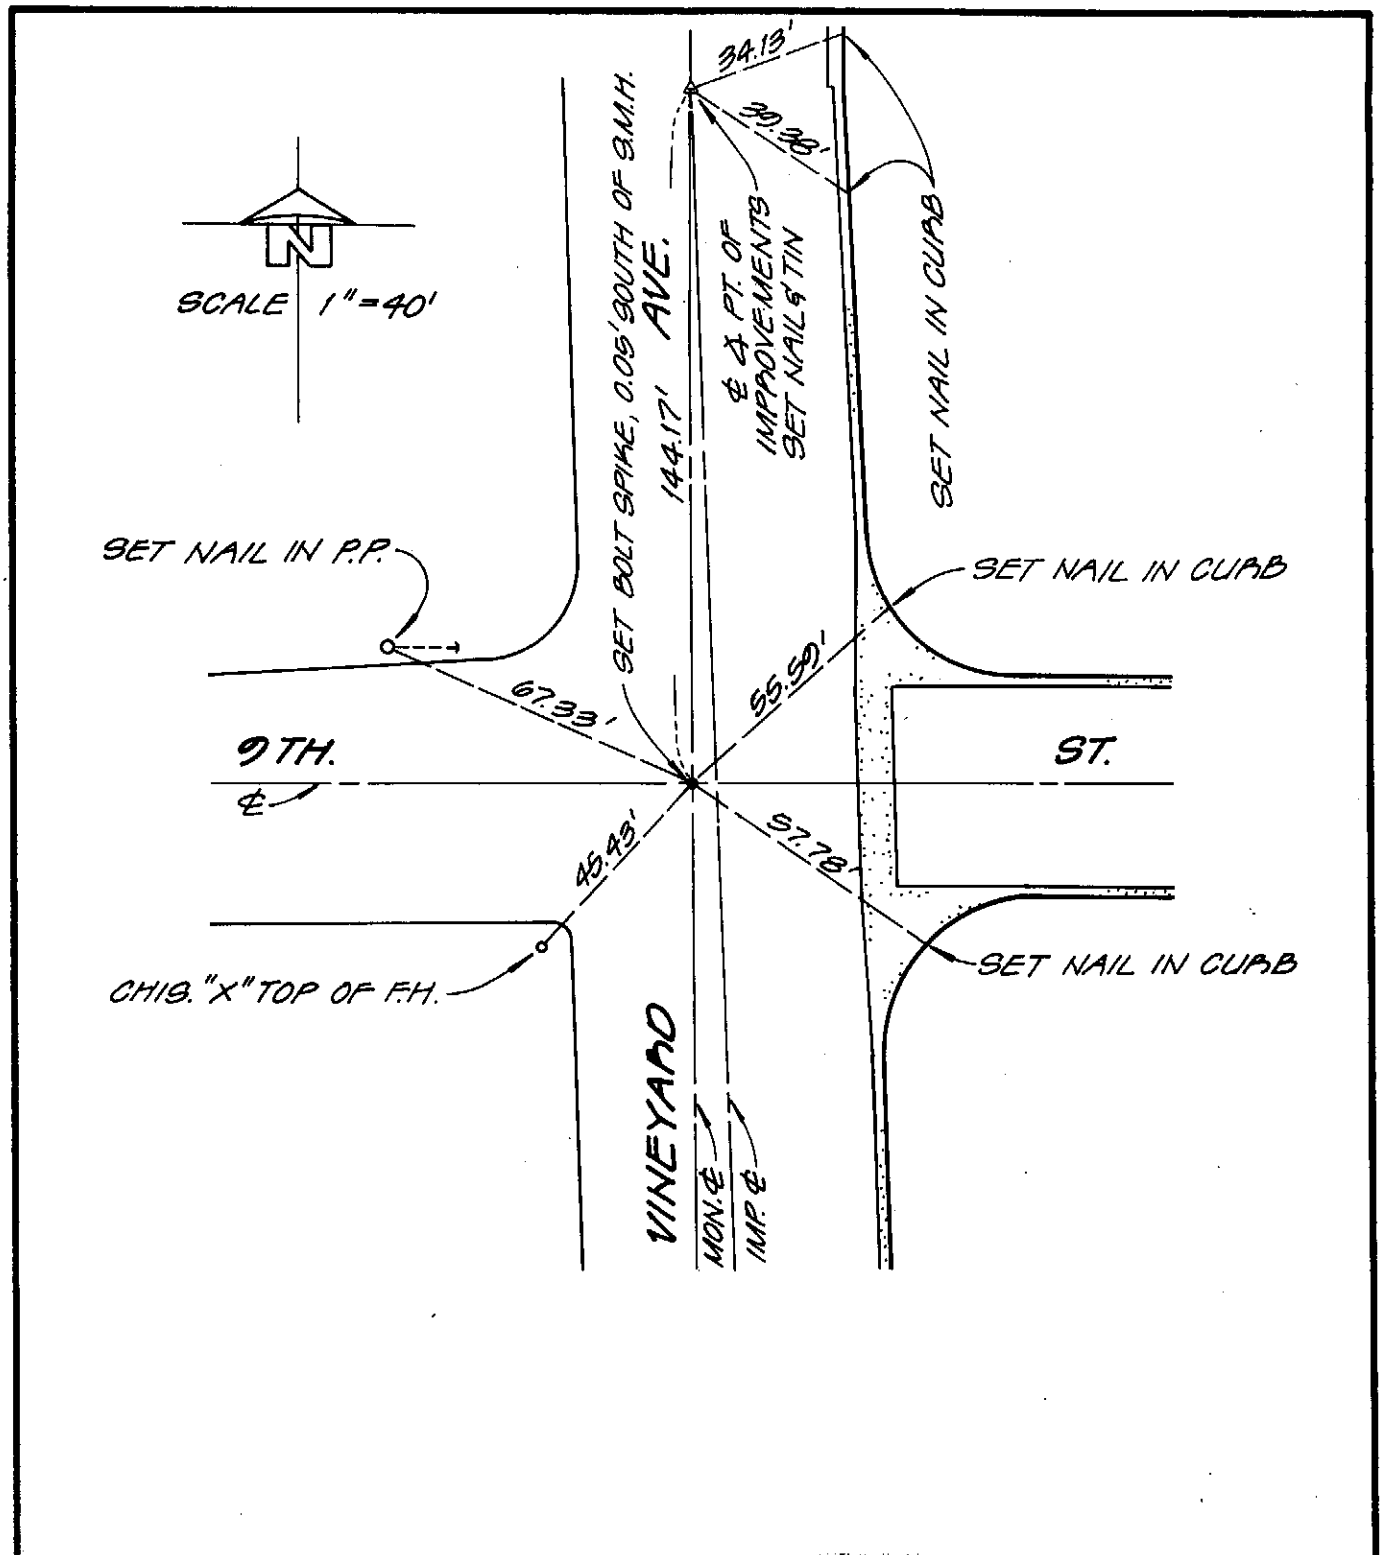

city of rancho cucamonga — STREET TIE	
CG ENGINEERING *Planning and Engineering* 2827 SO WATERMAN AVE., SUITE E, SAN BERNARDINO, CA 92408	VINEYARD AVENUE AND NINTH STREET
ENGR. David Bashian	FIELD REVIEW _____ DATE _____
R.C.E. No. 28931 DATE 11-21-83	TIE BOOK 6 PAGE 80

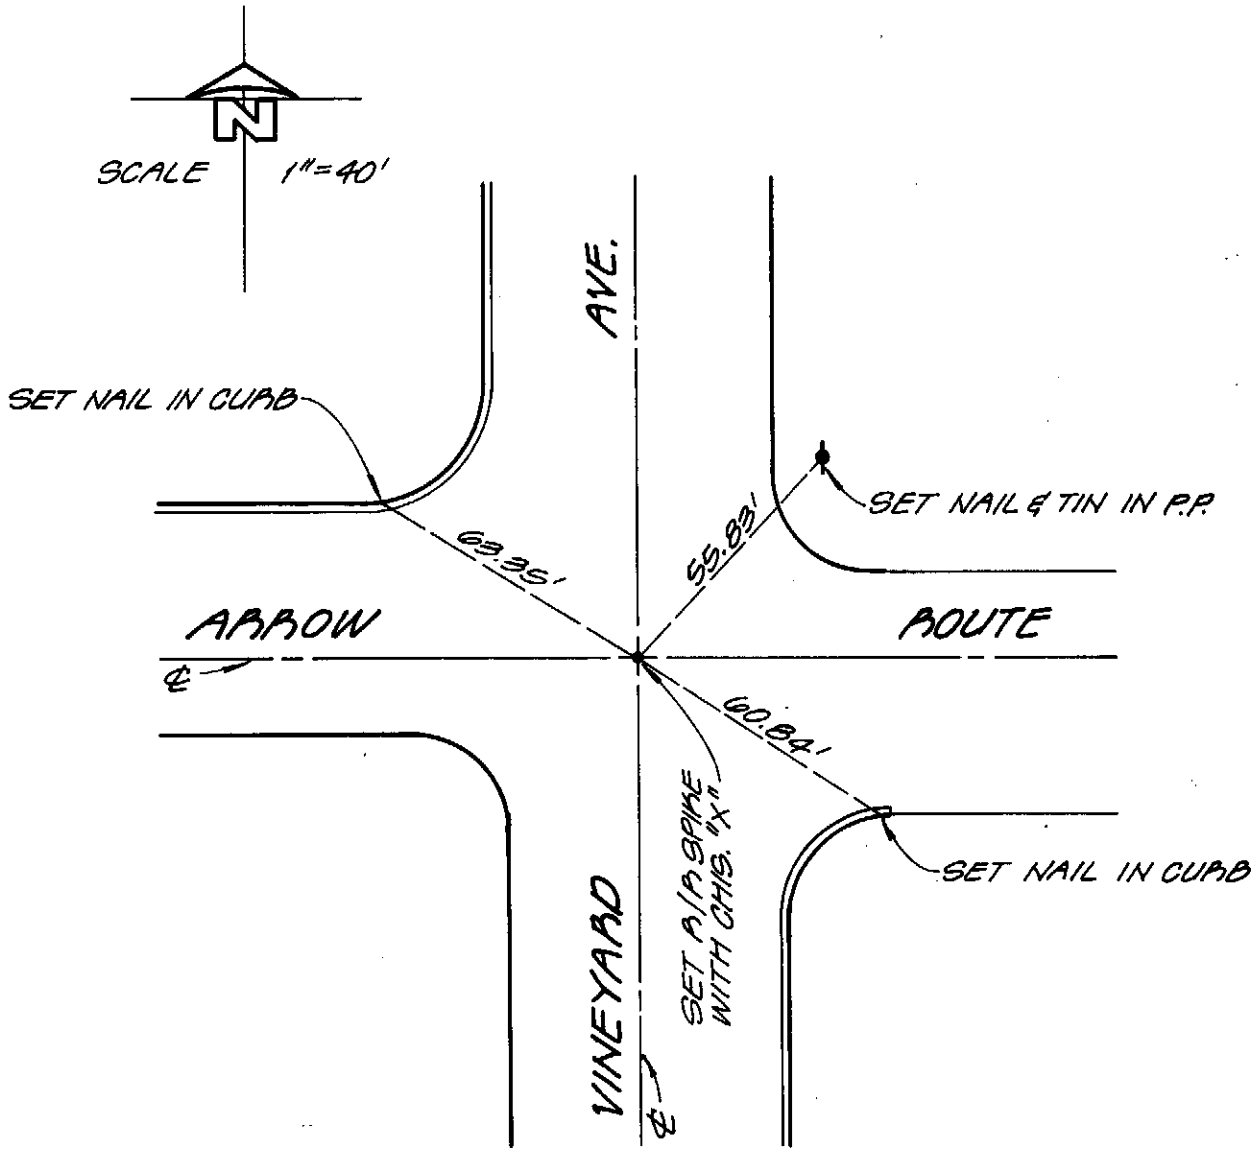

city of rancho cucamonga — STREET TIE	
CG ENGINEERING *Planning and Engineering* 2627 SO. WATERMAN AVE. SUITE E, SAN BERNARDINO, CA 92408	VINEYARD AVENUE AND ARROW ROUTE
ENGR. David Berlin	FIELD REVIEW _____ DATE _____
R.C.E. No. 28931 DATE 11-21-83	TIE BOOK 6 PAGE 81

▲ INDICATES LEAD & TACK

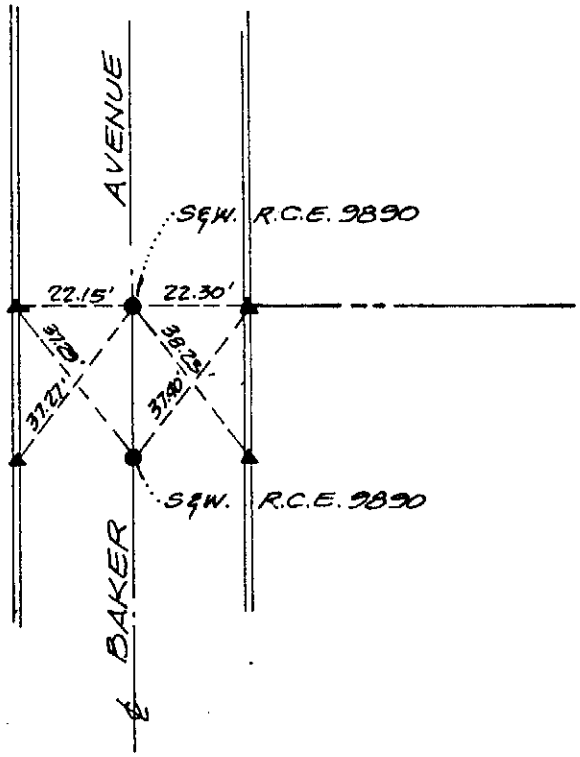

N.T.S.

REF. : TR. 9658 – M.B. 165 / 83 – 86

city of rancho cucamonga STREET TIE	
Sandalwood	BAKER AVENUE
ENGR. / L.S G.V.W.-McCUTCHAN, INC.	FIELD REVIEW _____ DATE _____
R.C.E. / L.S. No. 9890 DATE _____	TIE BOOK 6 PAGE 82

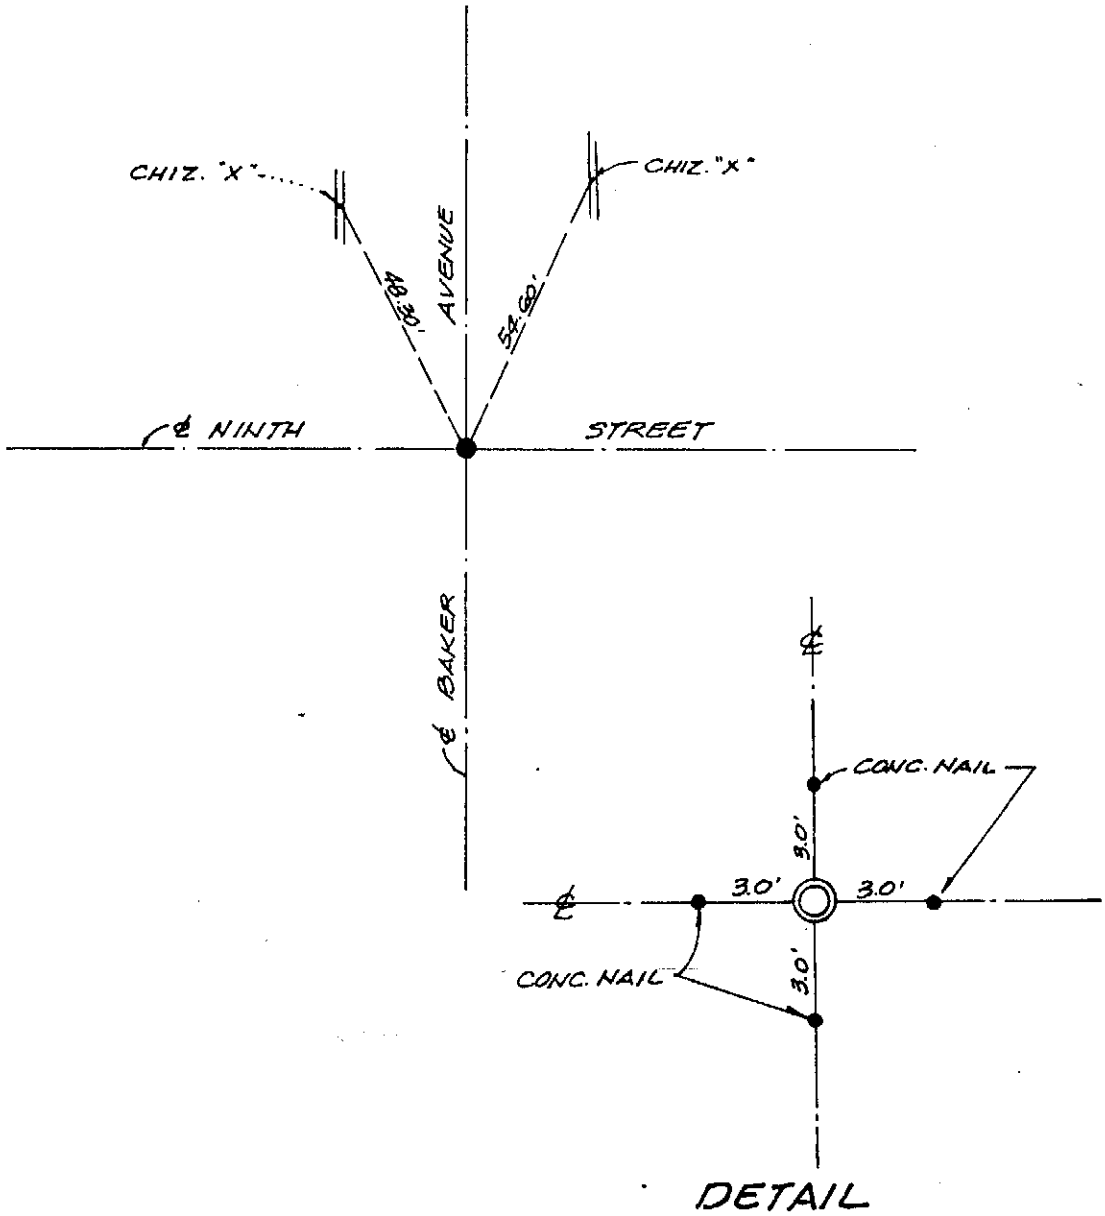

REF.: TR. 9658 - M.B. 165/83-86

city of rancho cucamonga — STREET TIE	
	NINTH STREET & BAKER AVENUE
ENGR./L.S. G.V.W.-McCUTCHAN, INC.	FIELD REVIEW _____ DATE _____
R.C.E./L.S. No. 9890 DATE _____	TIE BOOK 6 PAGE 83

▲ INDICATES LEAD & TACK

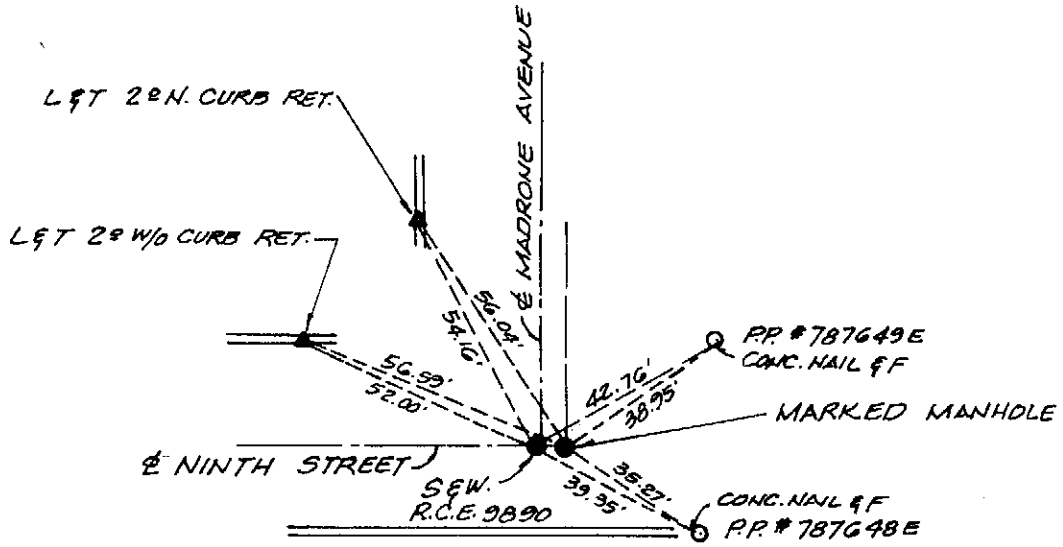

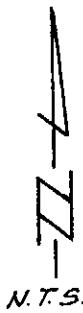

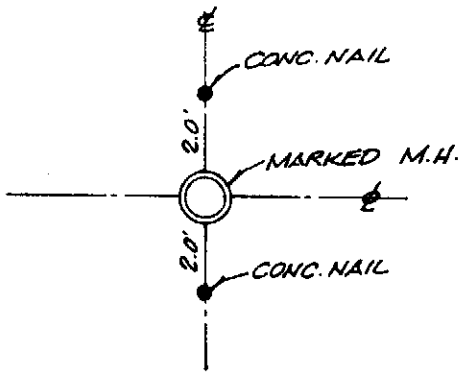

DETAIL

REF.: TR. 9658 – M.B. 165/83-86

city of rancho cucamonga — STREET TIE	
	MADRONE AVENUE & NINTH STREET
ENGR./L.S. G.V.W. - McCUTCHAN, INC.	FIELD REVIEW _____ DATE _____
R.C.E./L.S. No. 9890 DATE _____	TIE BOOK 6 PAGE 84

▲ INDICATES LEAD & TACK

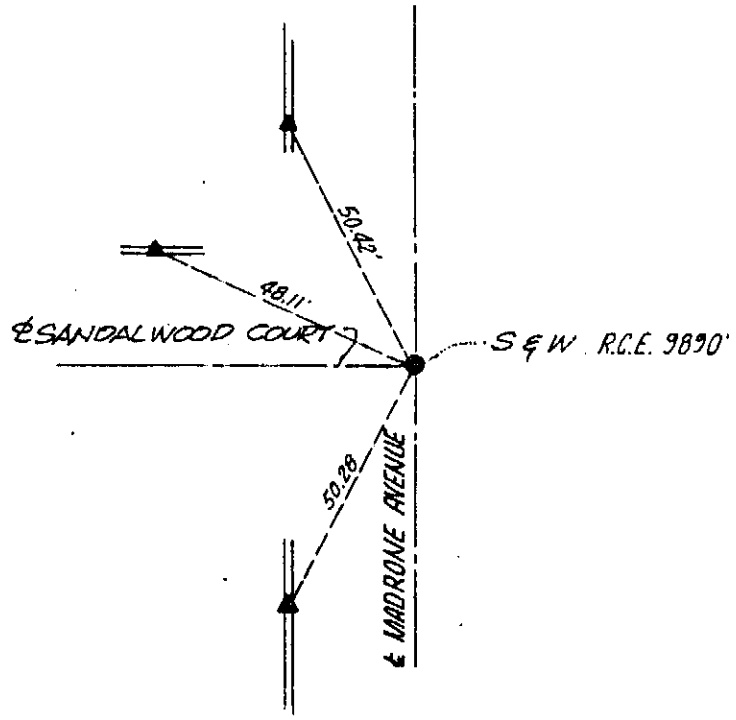

N.T.S.

REF.: TR. 9658-M.B. 165/83-86

city of rancho cucamonga — STREET TIE	
	SANDALWOOD COURT ℄ MADRONE AVENUE
ENGR./L.S. G.V.W.-McCUTCHAN, INC.	FIELD REVIEW _____ DATE _____
R.C.E./L.S. No. 9890 DATE _____	TIE BOOK 6 PAGE 85

▲ INDICATES LEAD & TACK

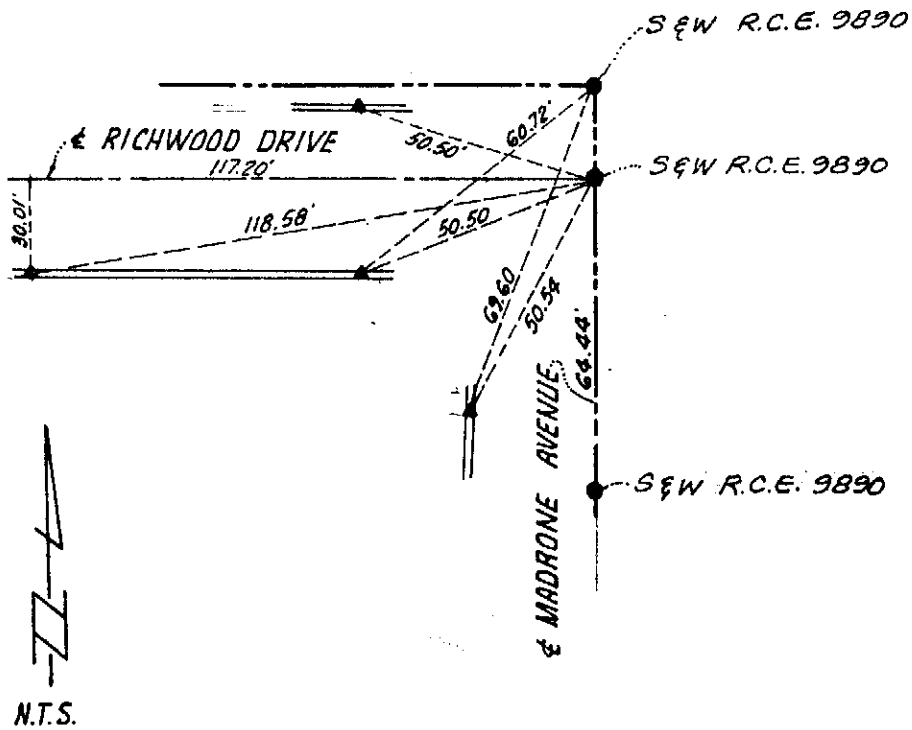

REF.: TR. 9658 - M.B. 165/83-86

city of rancho cucamonga STREET TIE	
	RICHWOOD DRIVE & MADRONE AVENUE
ENGR./L.S. G.V.W. - McCUTCHAN, INC.	FIELD REVIEW _____ DATE _____
R.C.E./L.S. No. 9890 DATE _____	TIE BOOK 6 PAGE 86

▲ INDICATES LEAD & TACK

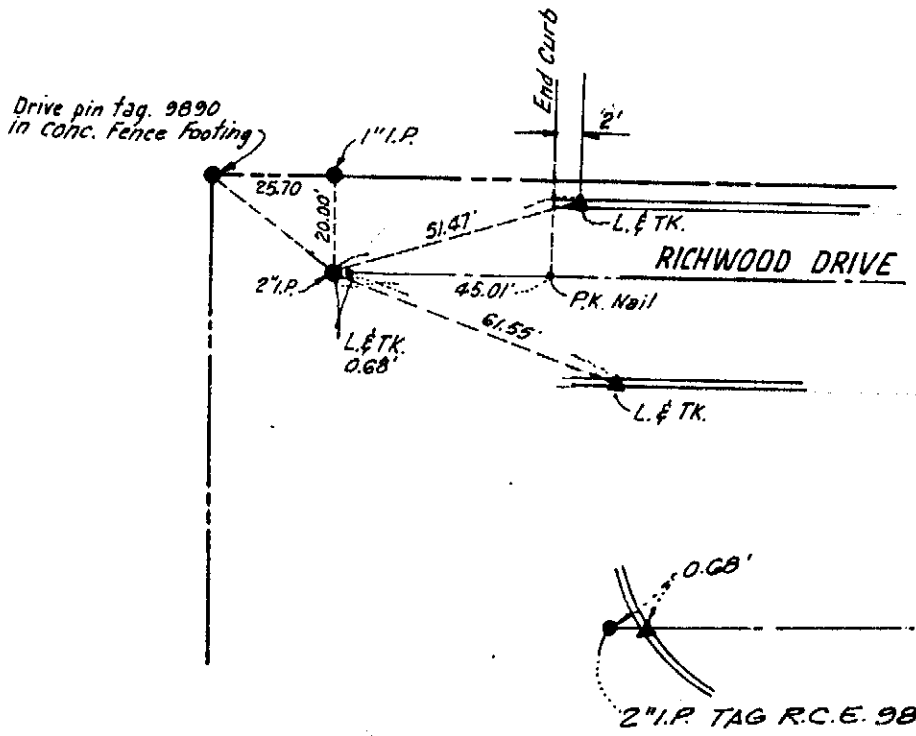

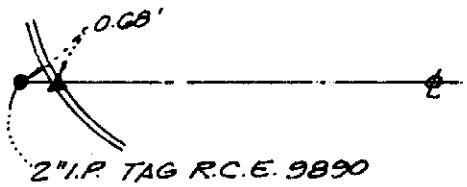

N.T.S.

DETAIL

REF.: TR. 9658 - M.B. 165/83-86

city of rancho cucamonga STREET TIE	
	RICHWOOD DRIVE
ENGR. / L.S. G.V.W. - McCUTCHAN, INC.	FIELD REVIEW _____ DATE _____
R.C.E. / L.S. No. 9890 DATE _____	TIE BOOK 6 PAGE 87

▲ INDICATES LEAD & TACK

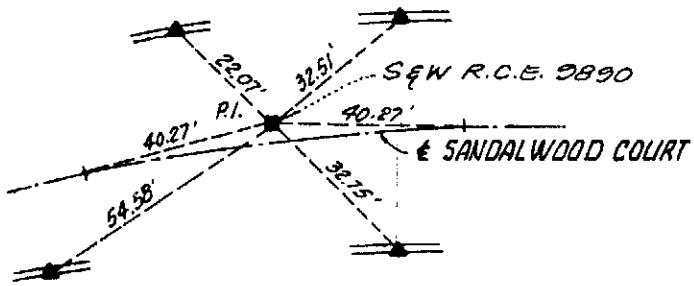

N.T.S.

REF.: TR. 9658 – M.B. 165/83-86

city of rancho cucamonga — STREET TIE	
	SANDALWOOD COURT
ENGR./L.S. G.V.W.-McCUTCHAN, INC.	FIELD REVIEW _____ DATE _____
R.C.E./L.S. No. 3890 DATE _____	TIE BOOK 6 PAGE 88

▲ INDICATES LEAD & TACK

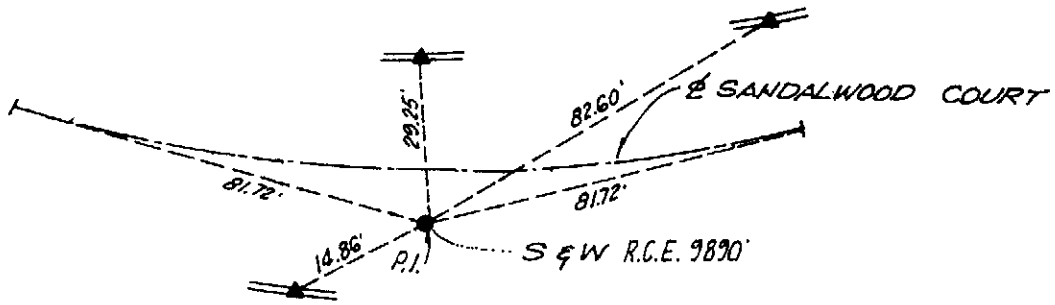

N.T.S.

REF.: TR. 9658 - M.B. 165/83-86

city of rancho cucamonga — STREET TIE	
	SANDALWOOD COURT
ENGR. / L.S. G.V.W.-McCUTCHAN, INC.	FIELD REVIEW _____ DATE _____
R.C.E. / L.S. No. 9890 DATE _____	TIE BOOK 6 PAGE 89

▲ INDICATES LEAD & TACK

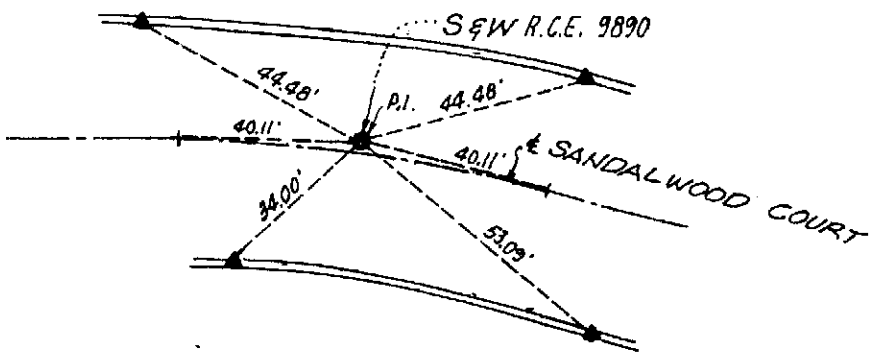

N.T.S.

REF.: TR. 9658 – M.B. 165 / 83-86

city of rancho cucamonga — STREET TIE	
	SANDALWOOD COURT
ENGR. / L.S. G.V.W-McCUTCHAN, INC.	FIELD REVIEW _____ DATE _____
R.C.E. / L.S. No. 9890 DATE _____	TIE BOOK 6 PAGE 90

▲ INDICATES LEAD & TACK

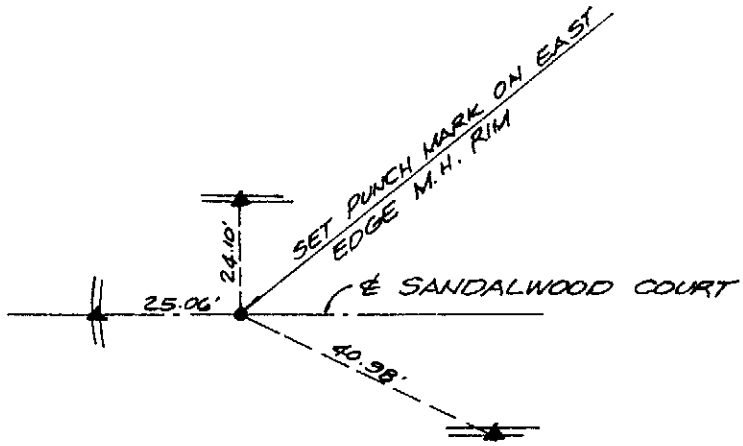

N.T.S.

REF.: TR. 9658 - M.B. 165 / 83-86

city of rancho cucamonga STREET TIE	
	SANDALWOOD COURT
ENGR. / L.S. G.V.W.-McCUTCHAN, INC.	FIELD REVIEW _____ DATE _____
R.C.E. / L.S. No. 9890 DATE _____	TIE BOOK 6 PAGE 91

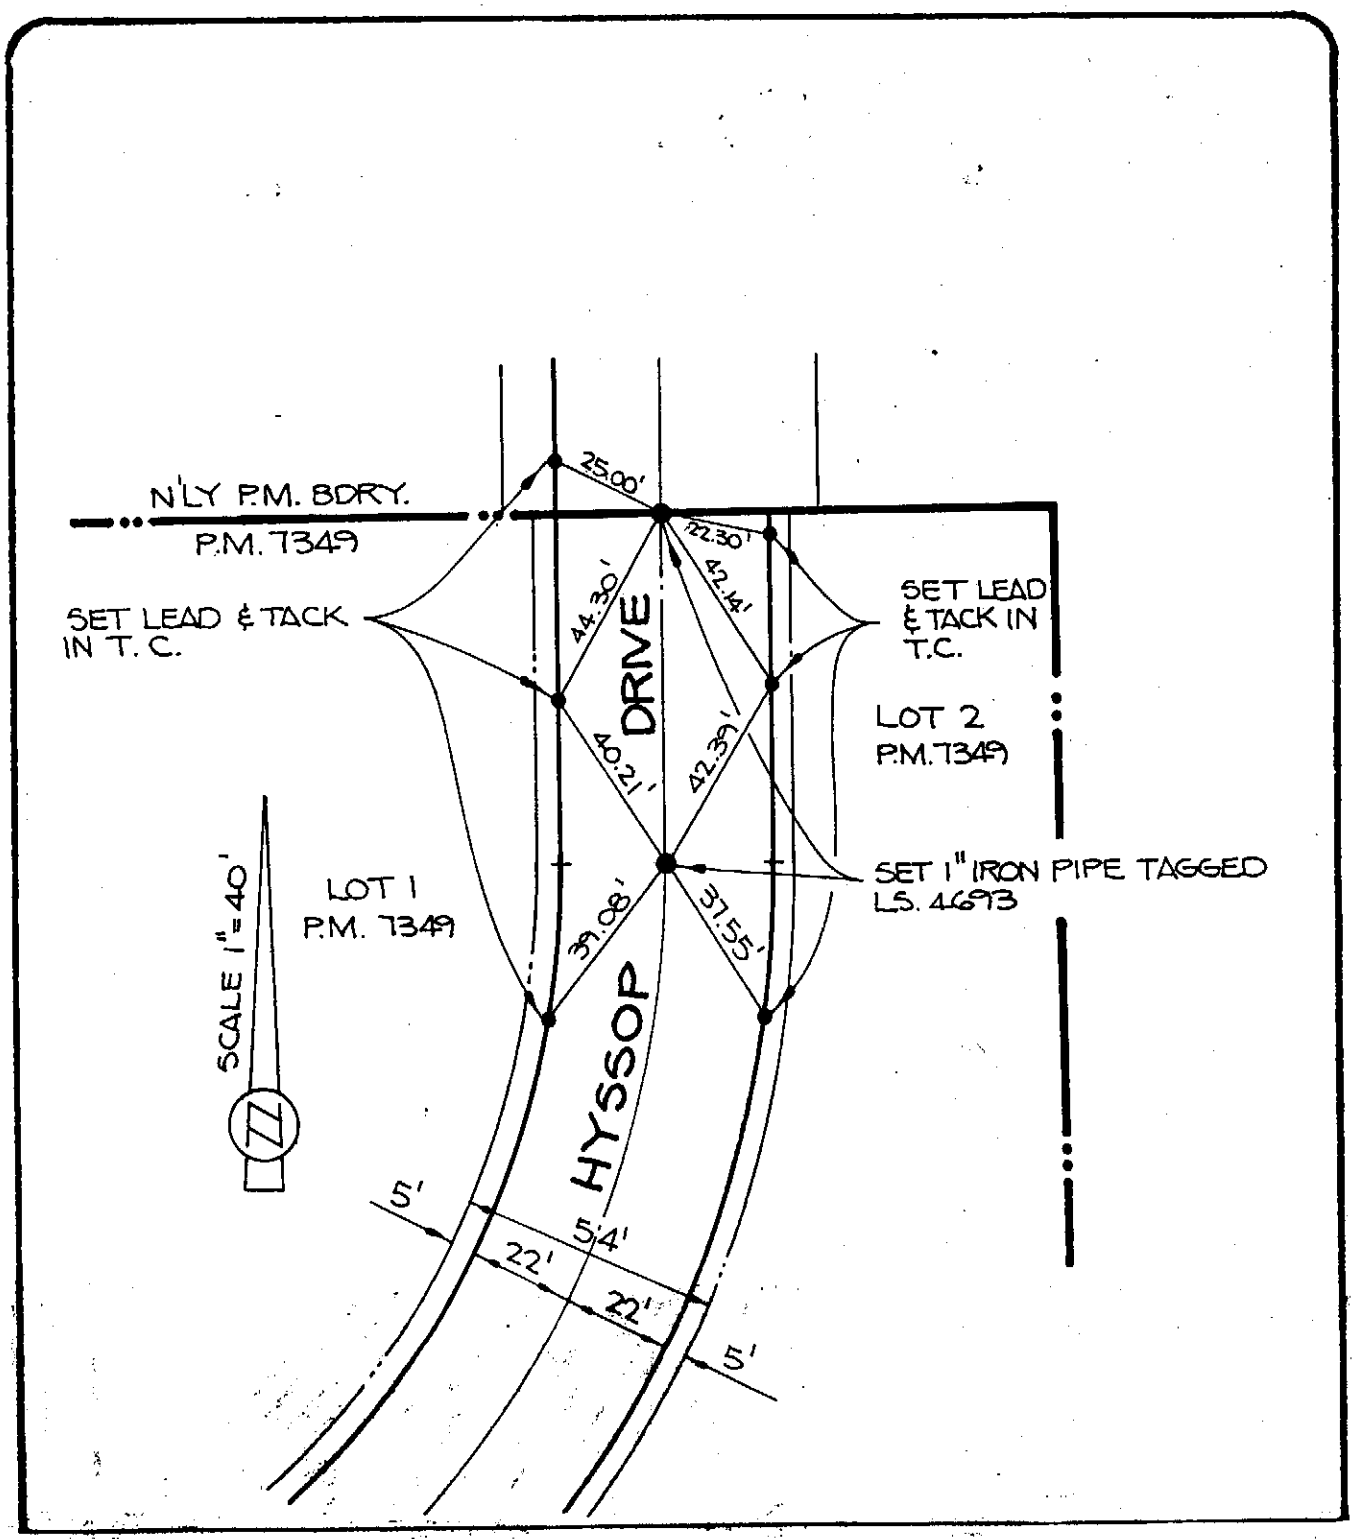

city of rancho cucamonga — STREET TIE	
HYSSOP DRIVE	STANLEY C. MORSE, C.C.E. 4860 IRVINE BLVD., STE. 201 IRVINE, CA. 92714-1299
ENGR. / L.S. GARY W. DOKICH	FIELD REVIEW _____ DATE 1-18-84
R.C.E. / L.S. No. 4693 DATE 1-18-84	TIE BOOK 6 PAGE 92

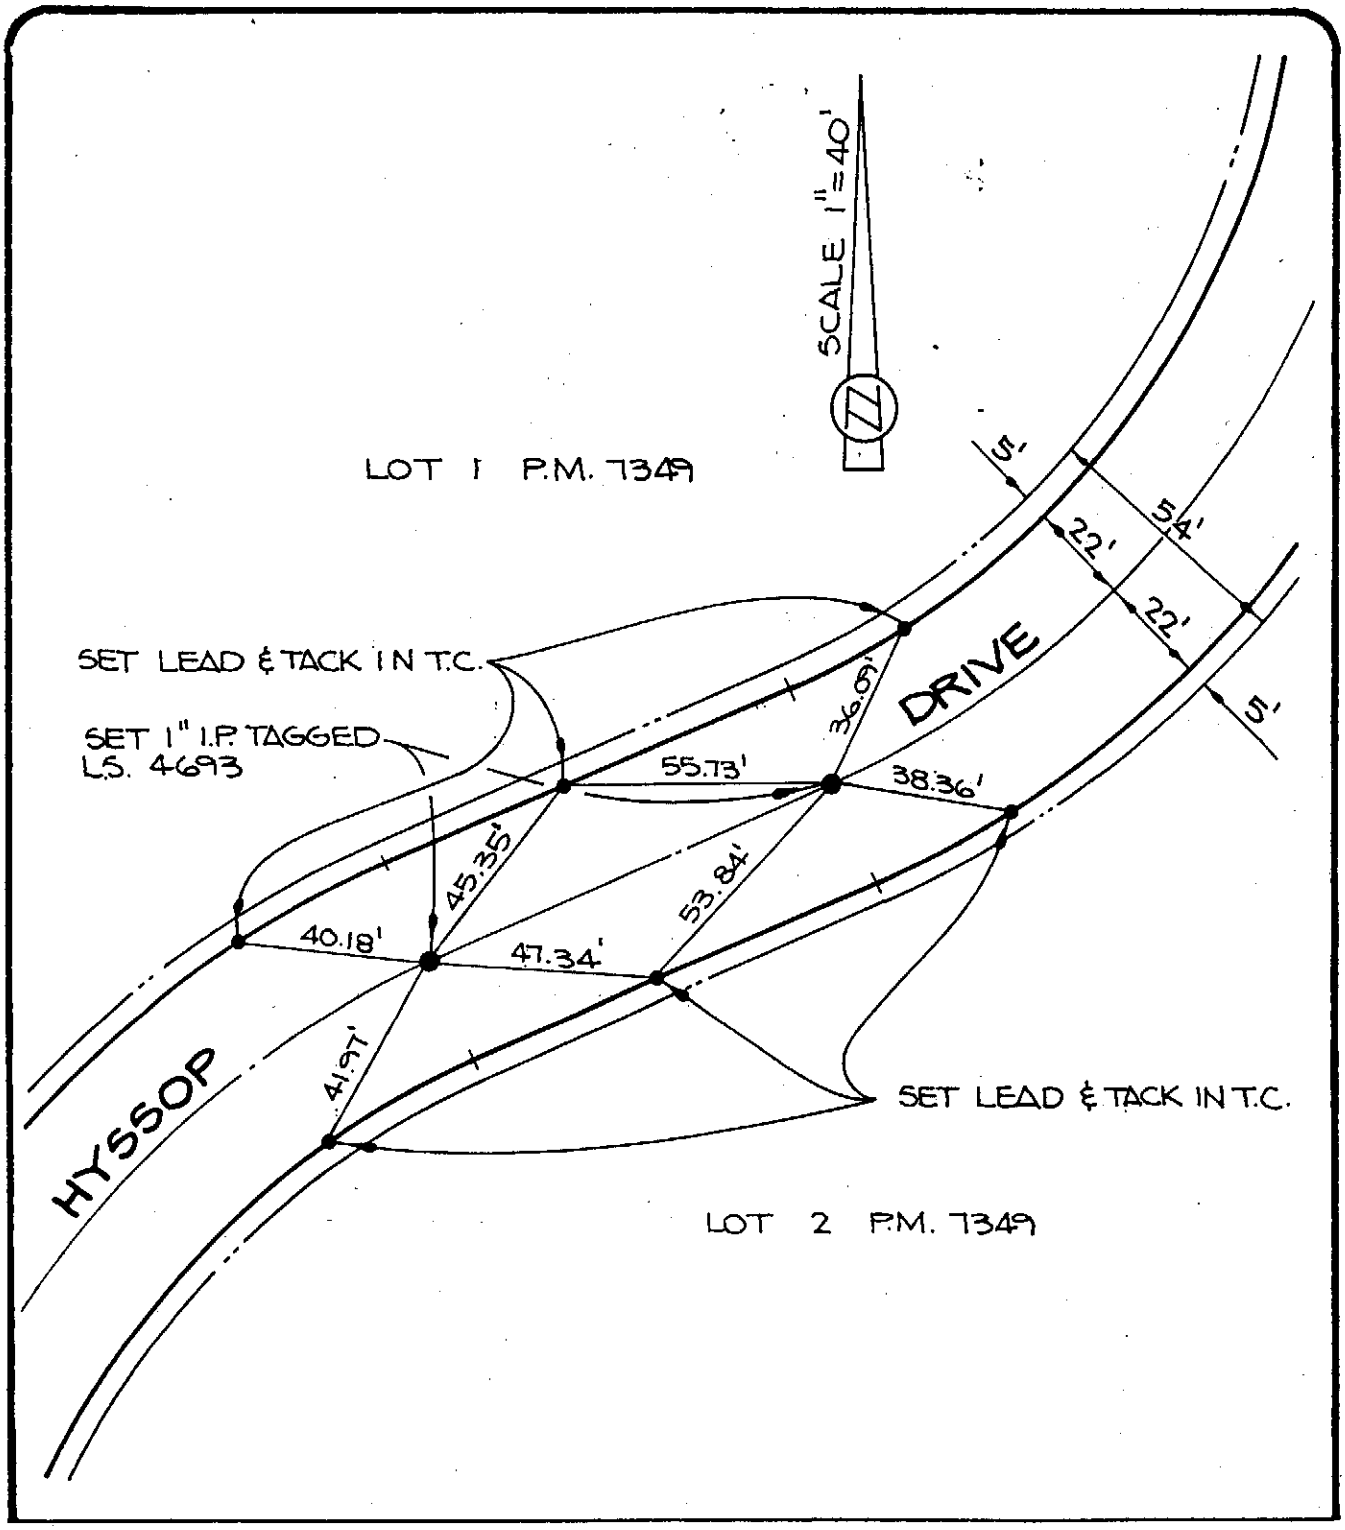

city of rancho cucamonga — STREET TIE	
HYSSOP DRIVE	STANLEY C. MORSE, C.C.E. 4860 IRVINE BLVD. STE. 201 IRVINE, CA. 92714-1299
ENGR./L.S. GARY W. DOKICH	FIELD REVIEW _____ DATE 1-18-84
R.C.E./L.S. No. 4693 DATE 1-18-84	TIE BOOK 6 PAGE 93

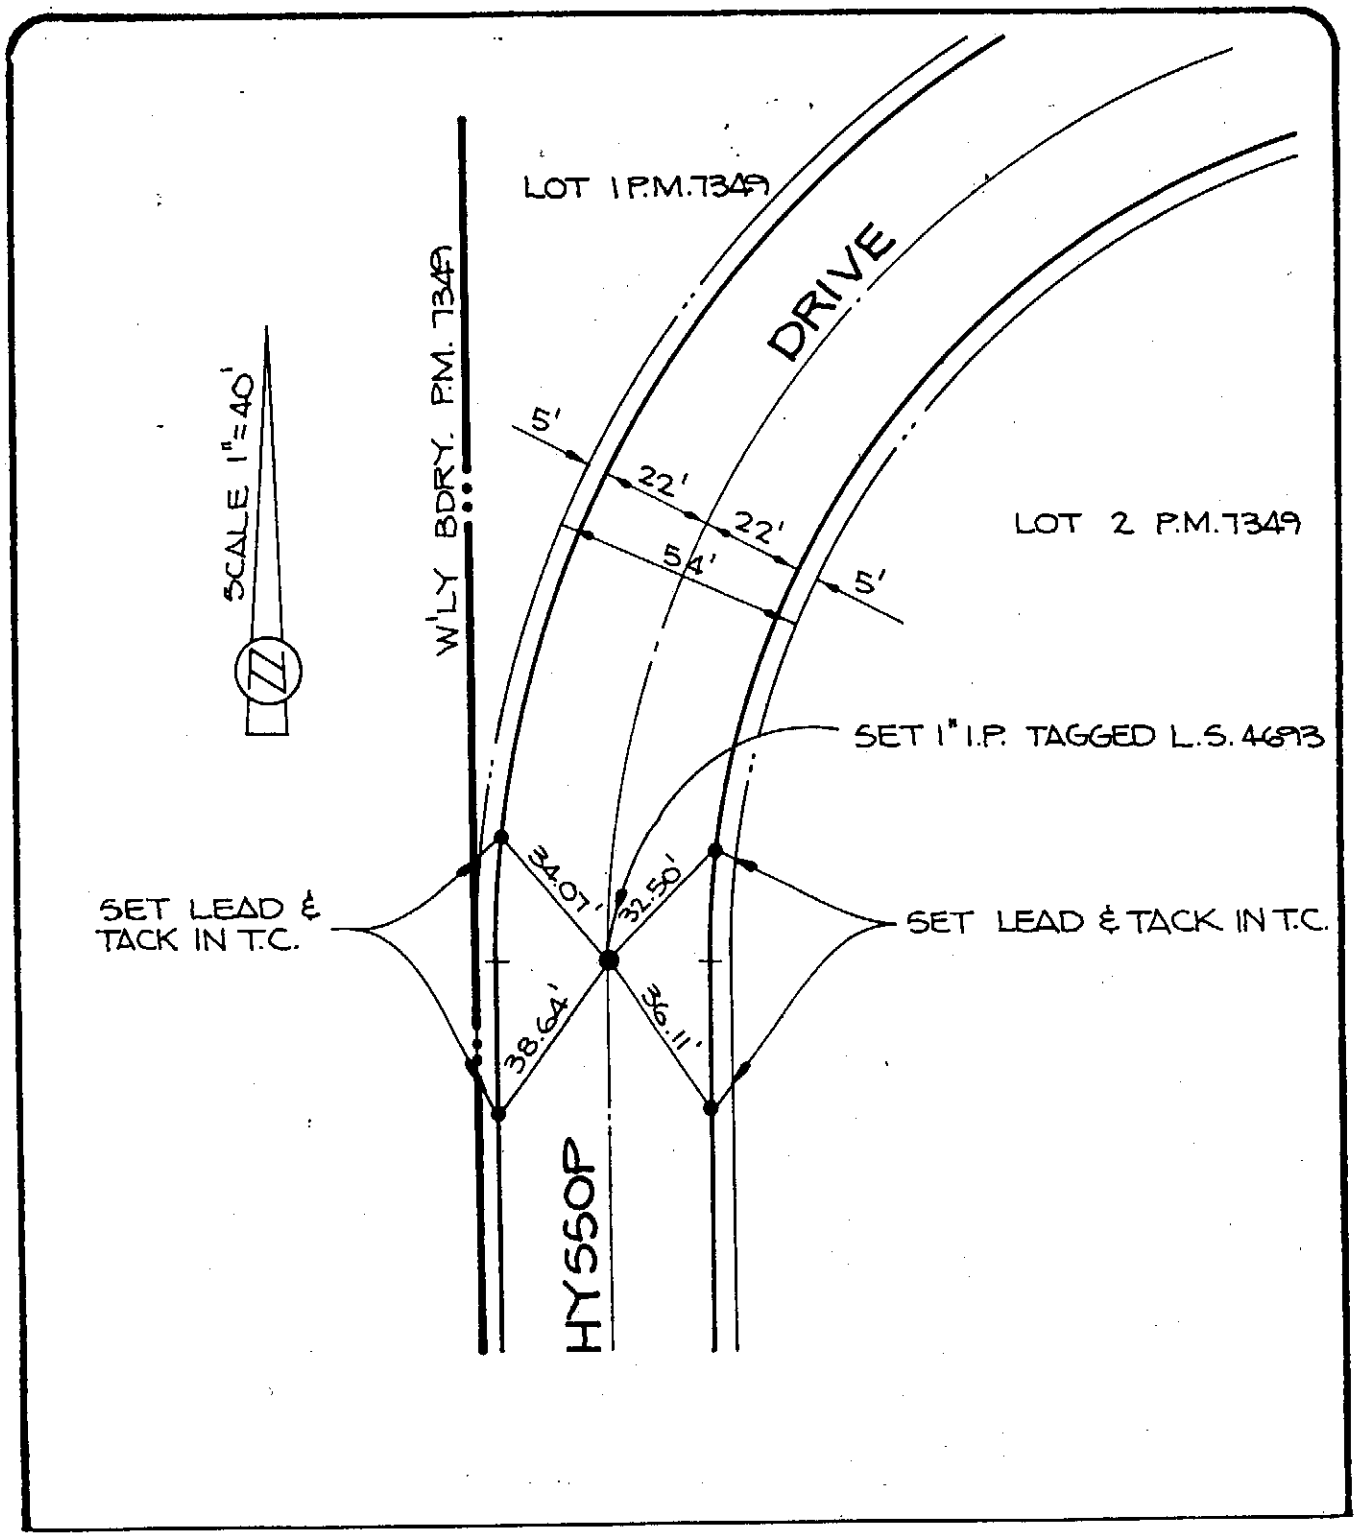

city of rancho cucamonga — STREET TIE	
HYSSOP DRIVE	STANLEY C. MORSE, C.C.E. 4860 IRVINE BLVD. STE. 201 IRVINE, CA. 92714-1299
ENGR./L.S. GARY W. DOKICH	FIELD REVIEW _____ DATE 1-18-84
R.C.E./L.S. No. 4693 DATE 1-18-84	TIE BOOK 6 PAGE 94

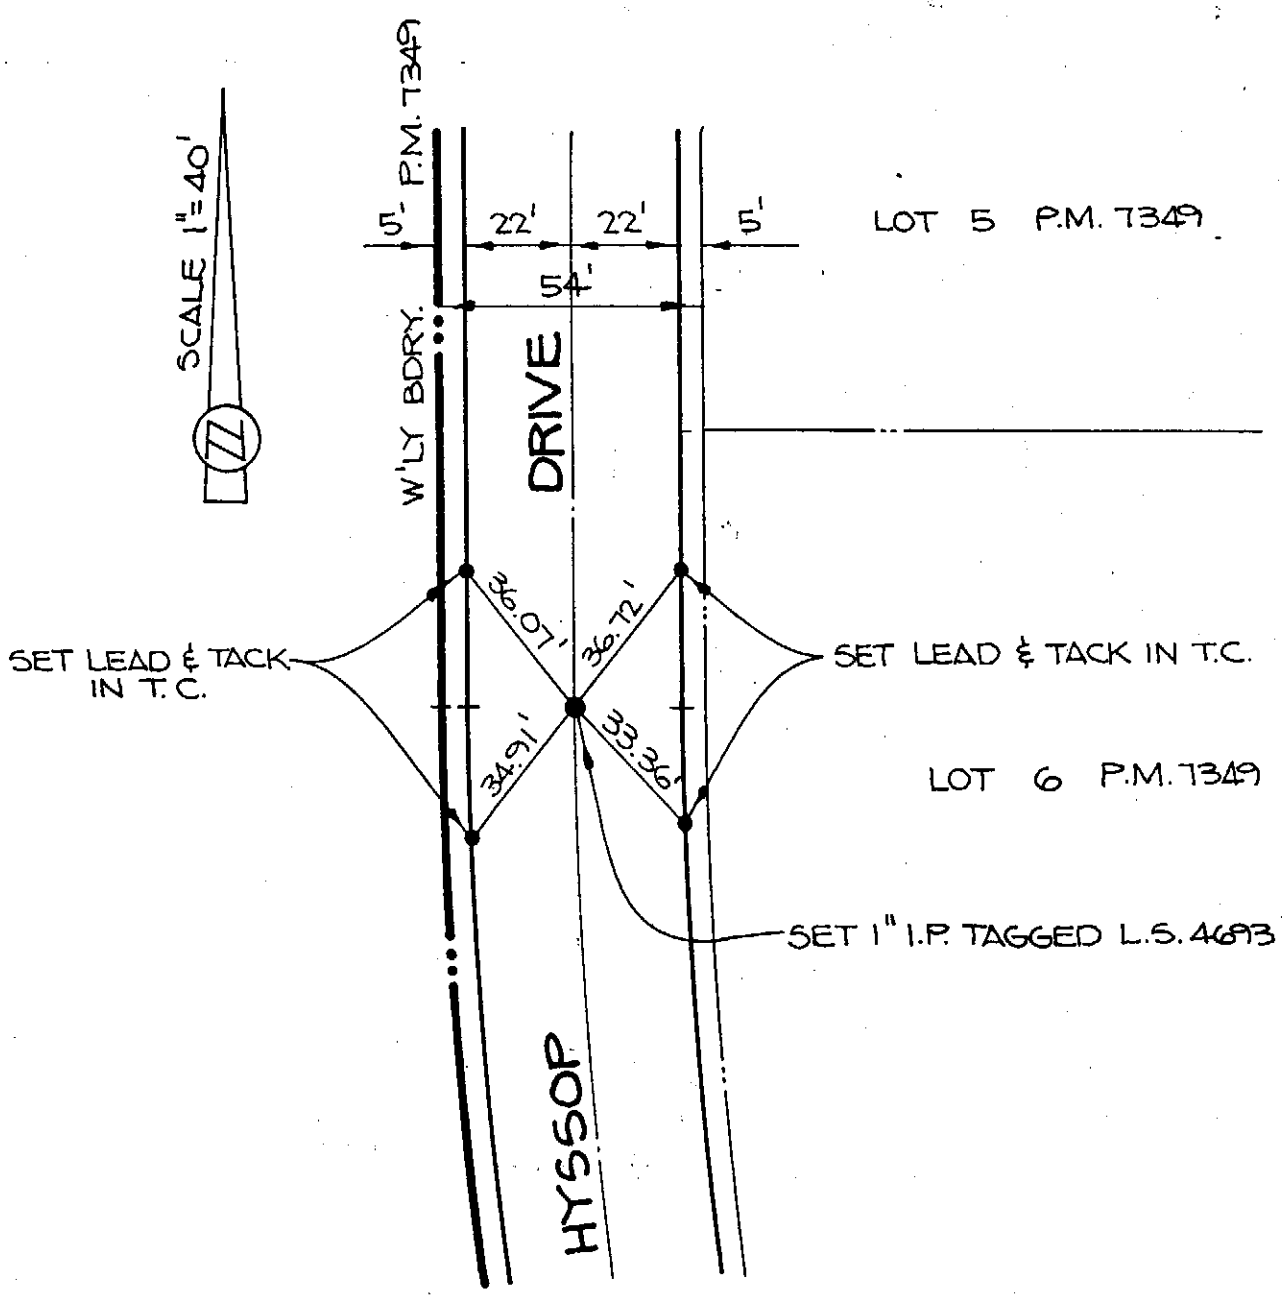

city of rancho cucamonga — STREET TIE	
HYSSOP DRIVE	STANLEY C. MORSE, C.C.E. 4860 IRVINE BLVD. STE. 201 IRVINE, CA. 92714-1299
ENGR. / L.S. GARY W. DOKICH	FIELD REVIEW _____ DATE 1-18-84
R.C.E. / L.S. No. 4693 DATE 1-18-84	TIE BOOK 6 PAGE 95

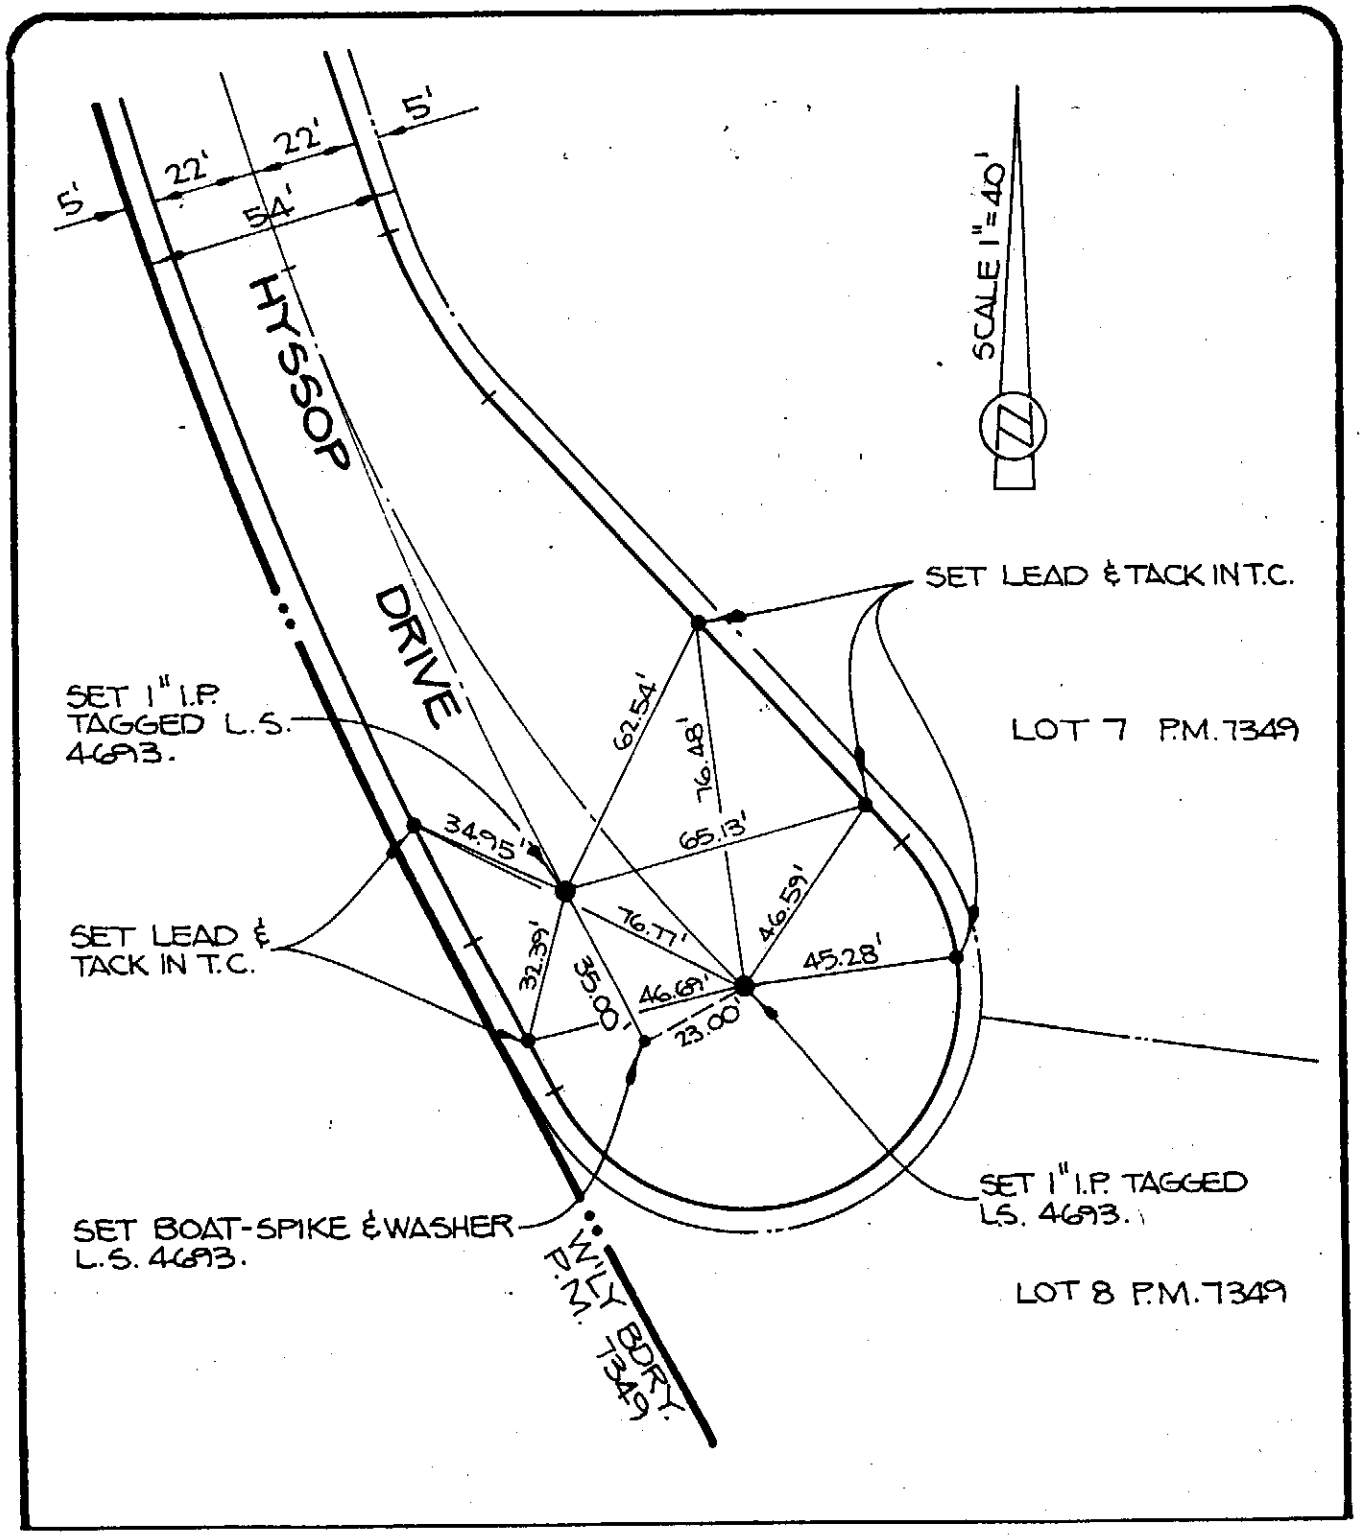

city of rancho cucamonga — STREET TIE	
HYSSOP DRIVE	STANLEY C. MORSE, C.C.E. 4860 IRVINE BLVD. STE. 201 IRVINE, CA. 92714-1299
ENGR. / L.S. GARY W. DOKICH	FIELD REVIEW _____ DATE 1-18-84
R.C.E. / L.S. No. 4693 DATE 1-18-84	TIE BOOK 6 PAGE 96

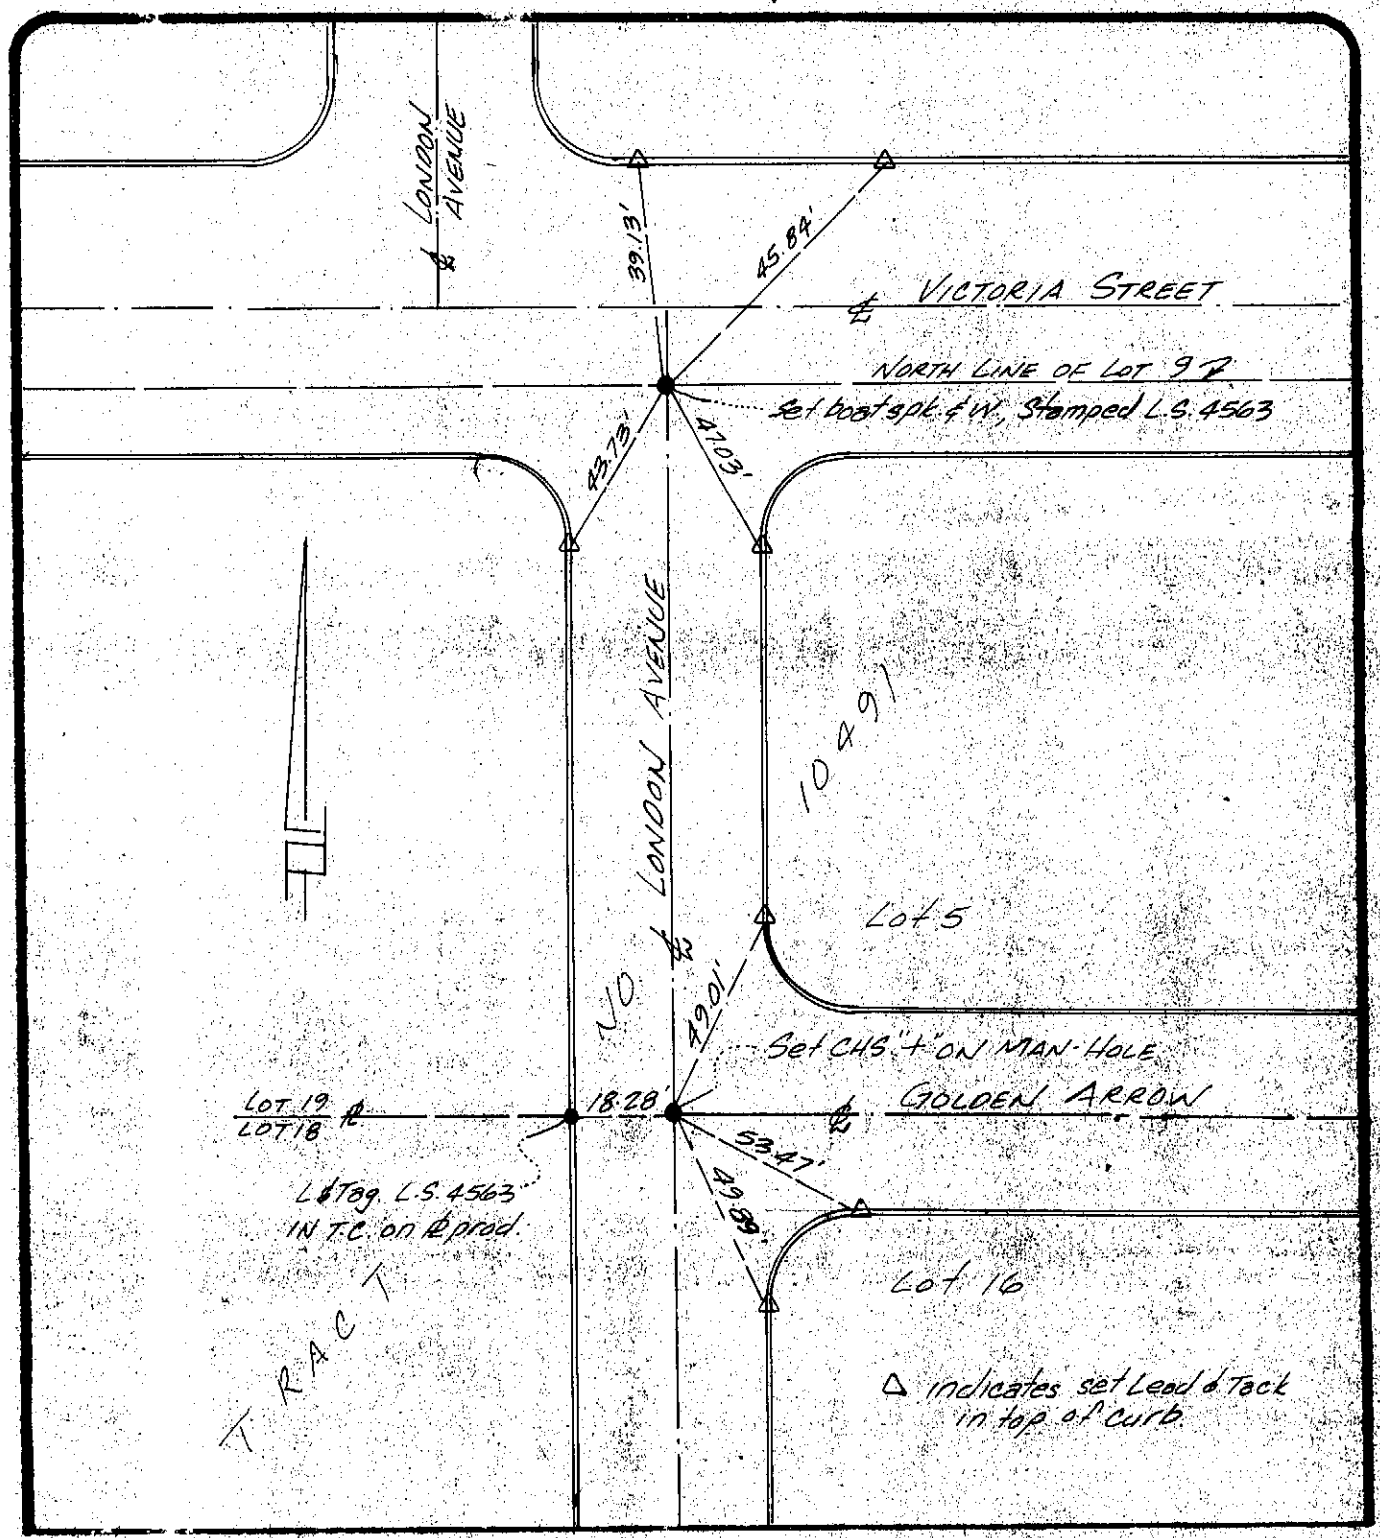

city of rancho cucamonga STREET TIE	TR 10491
HORN & ASSOCIATES 4650 ARROW HWY. SUITE E-4 MONTCLAIR, CA. 91763 (714) 624-1906 (714) 624-1280	
ENGR. / L. S. R.A. HORN	FIELD REVIEW _____ DATE _____
R.C.E. / L. S. No. L.S. 4563 DATE _____	TIE BOOK 6 PAGE 97

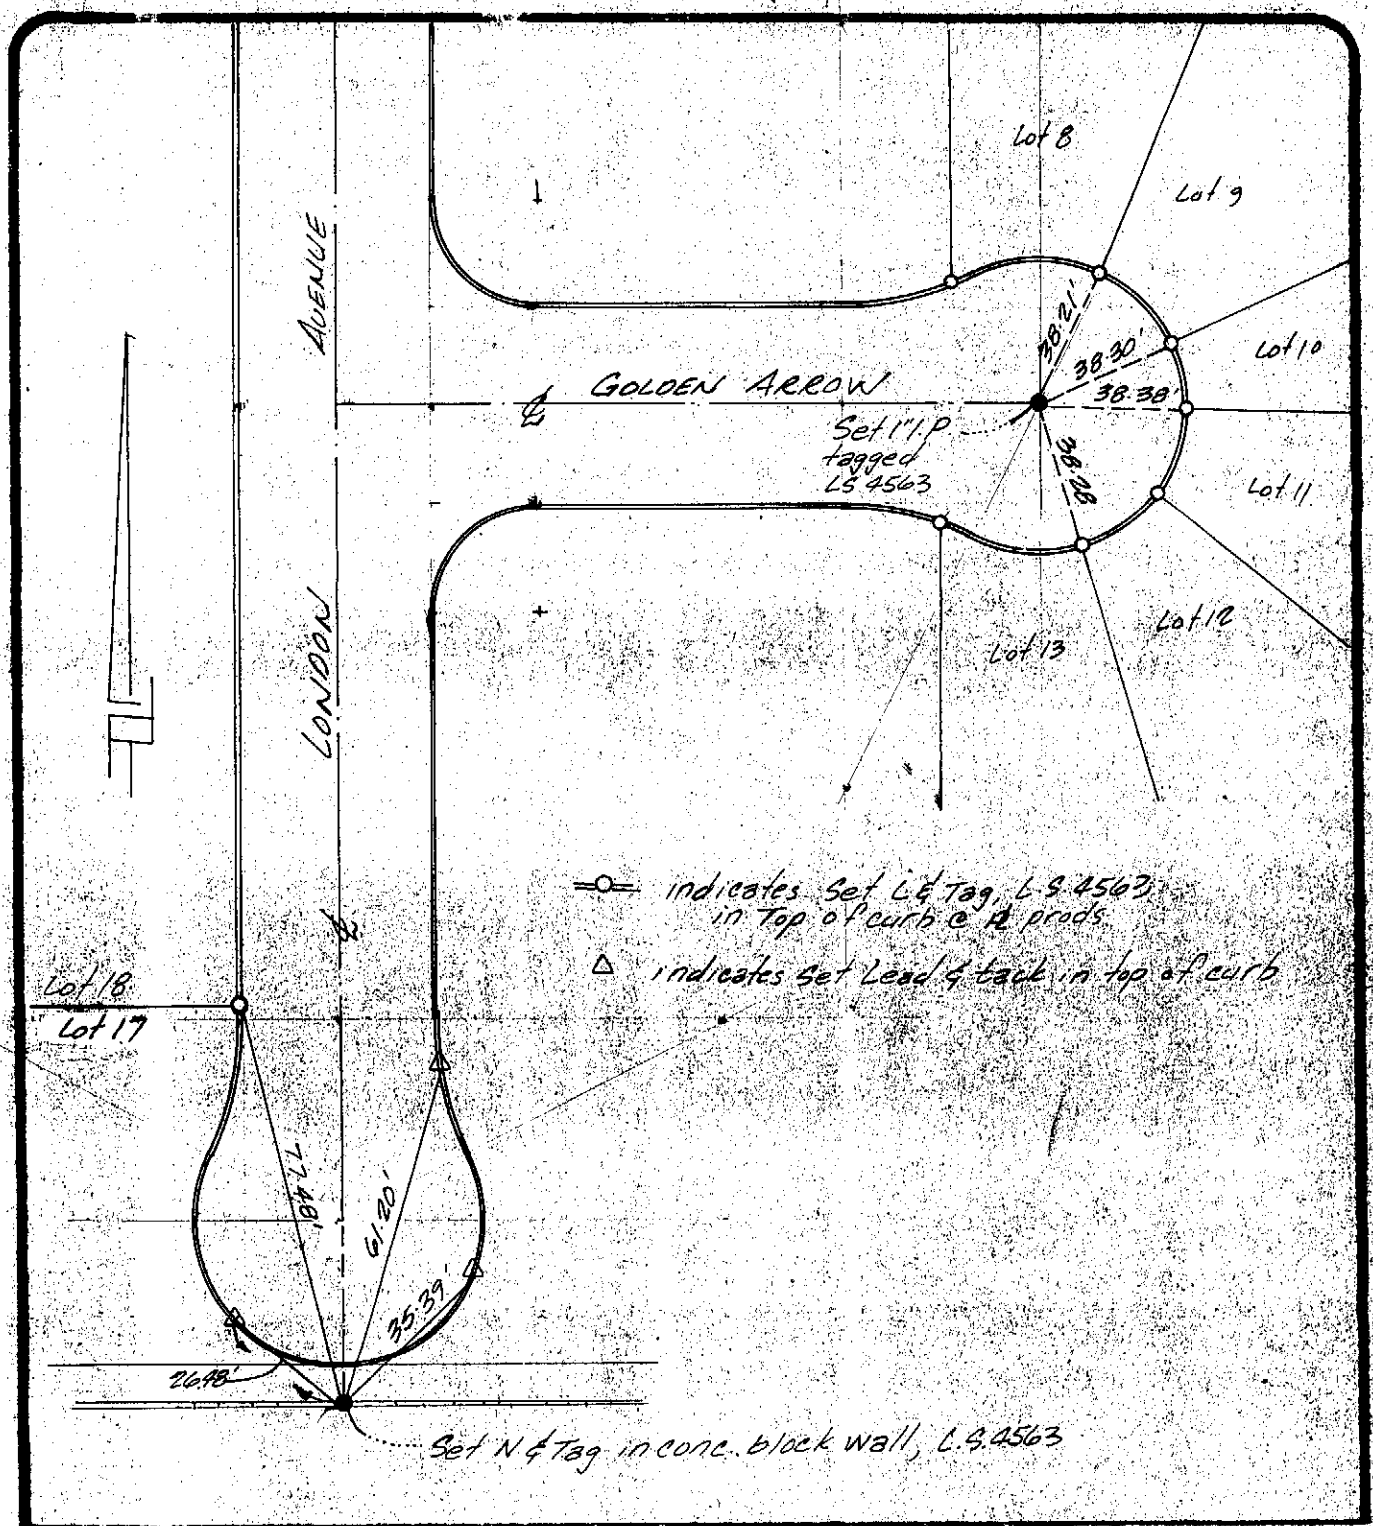

city of rancho cucamonga — STREET TIE	TR 10491
HORN & ASSOCIATES 4650 ARROW HWY. SUITE E-4 MONTCLAIR, CA. 91763 (714) 624-1906 (714) 624-1280	
ENGR. / L.S. R.A. HORN	FIELD REVIEW _____ DATE _____
R.C.E. / L.S. No. L.S. 4563 DATE _____	TIE BOOK 6 PAGE 98

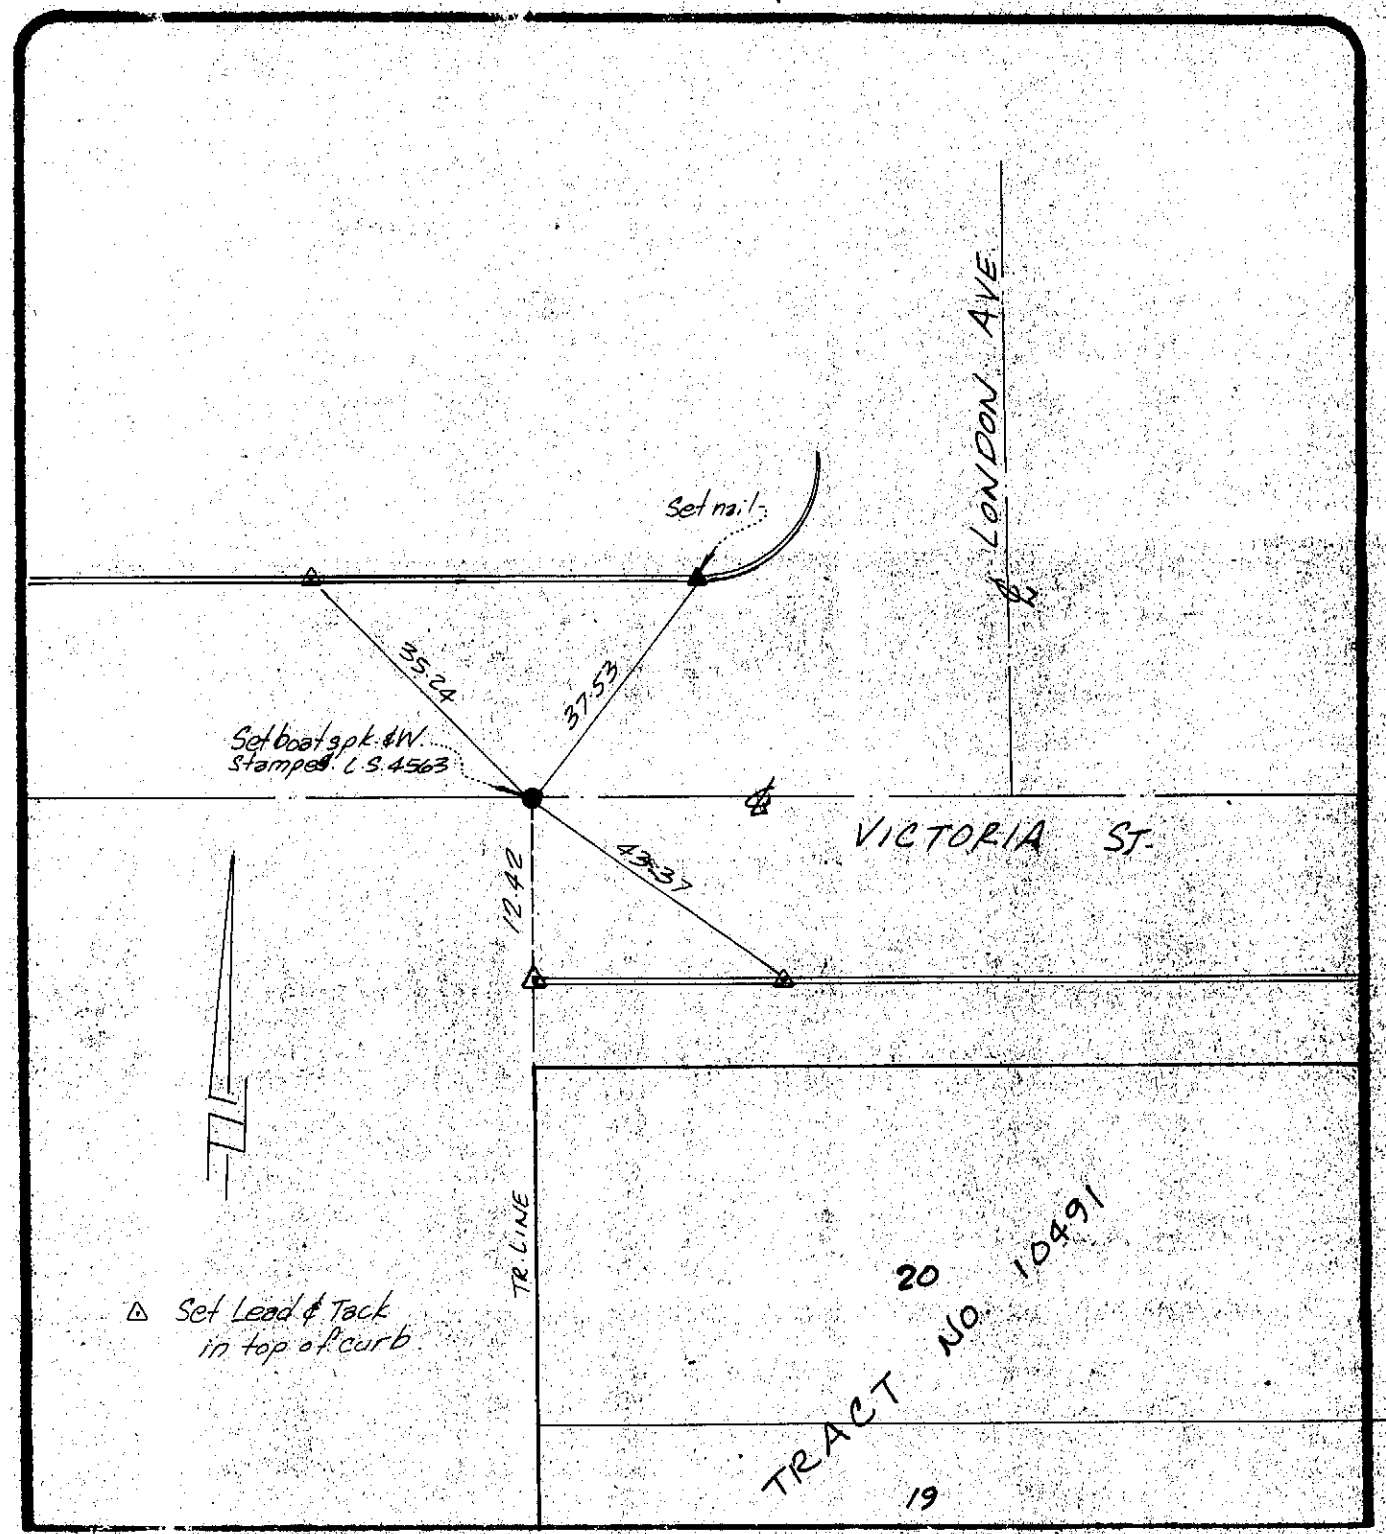

city of rancho cucamonga — STREET TIE	TR 10491
HORN & ASSOCIATES 4650 ARROW HWY. SUITE E-4 MONTCLAIR, CA. 91763 (714) 624-1906-(714) 624-1280	
ENGR./L.S. R.A. HORN	FIELD REVIEW _____ DATE _____
R.C.E./L.S. No. L.S. 4563 DATE _____	TIE BOOK 6 PAGE 99

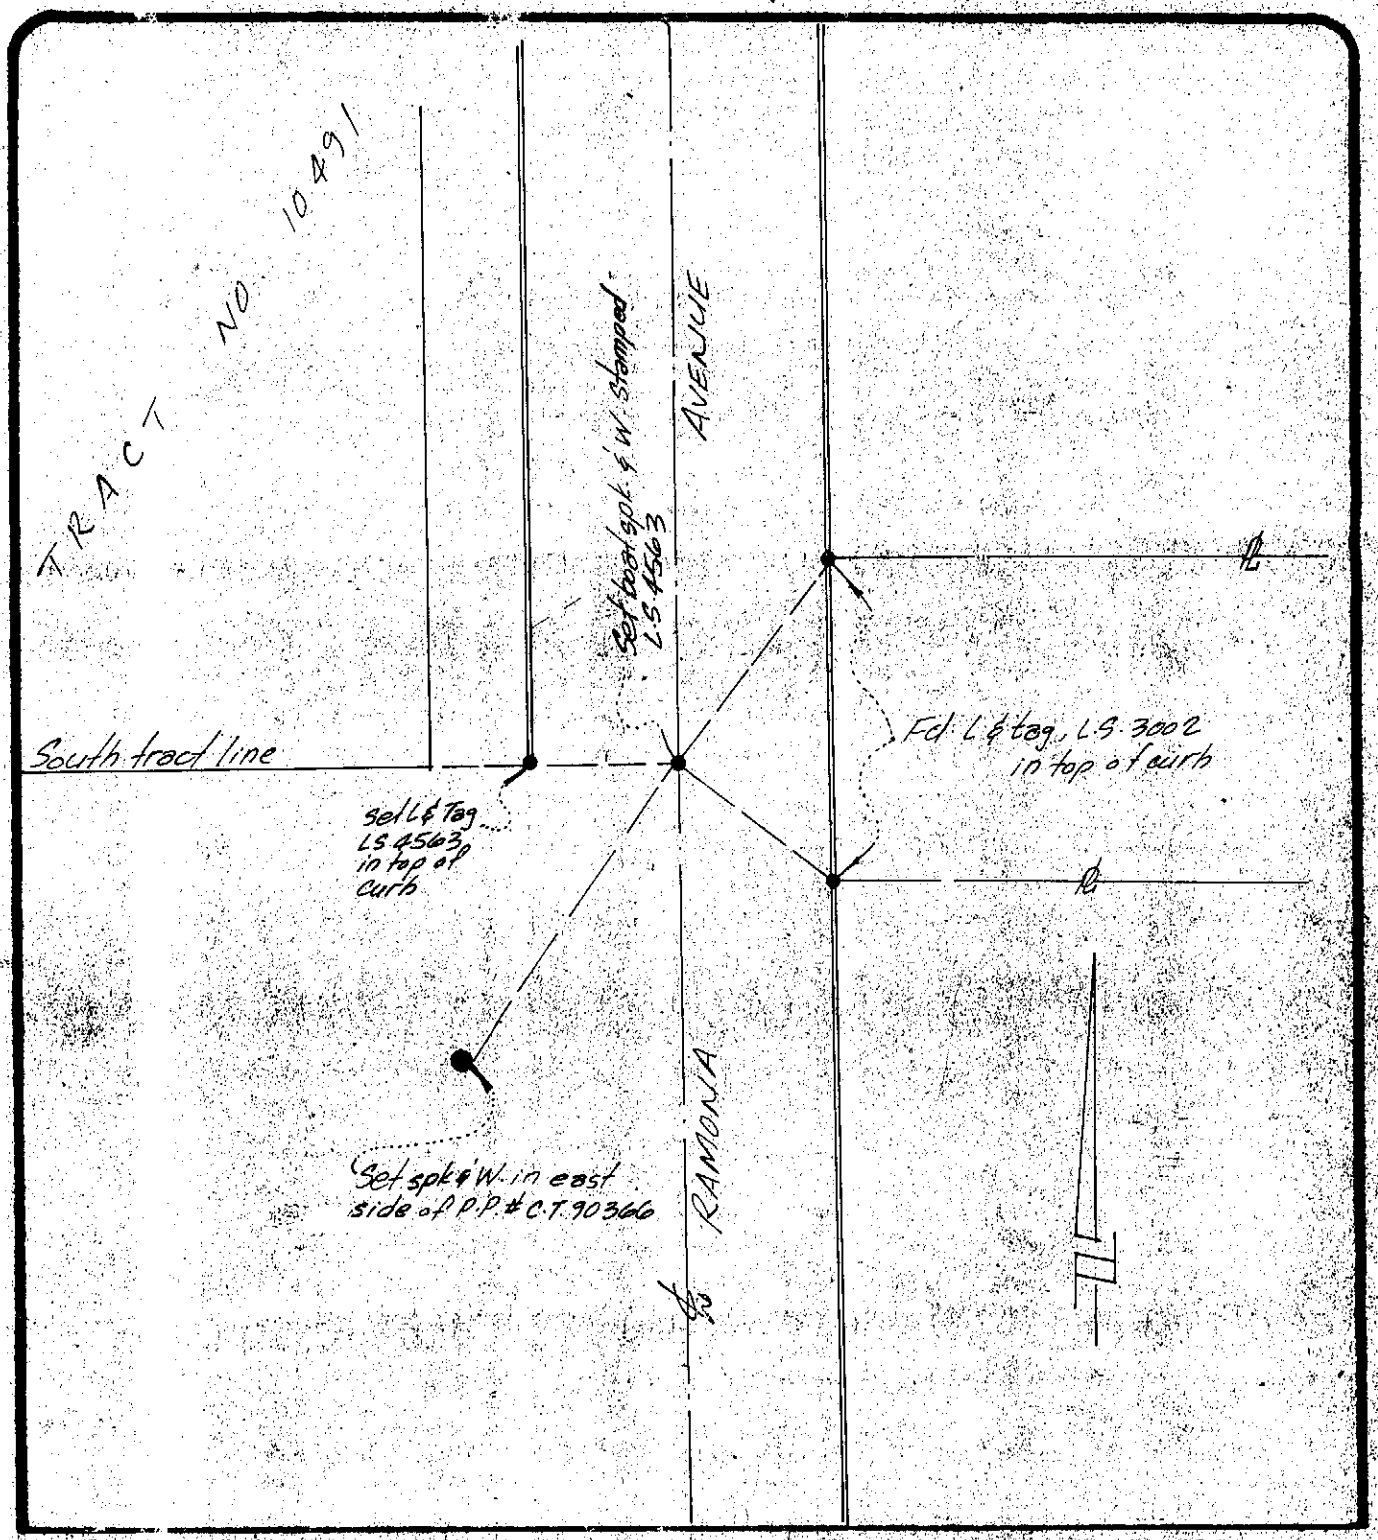

city of rancho cucamonga

STREET TIE

TR 10491

HORN & ASSOCIATES
4650 ARROW HWY. SUITE E-4
MONTCLAIR, CA. 91763
(714) 624-1906 (714) 624-1280

ENGR. / L.S. R.A. HORN

FIELD REVIEW _____ DATE _____

R.C.E. / L.S. No. L.S. 4563 DATE _____

TIE BOOK 6 PAGE 100

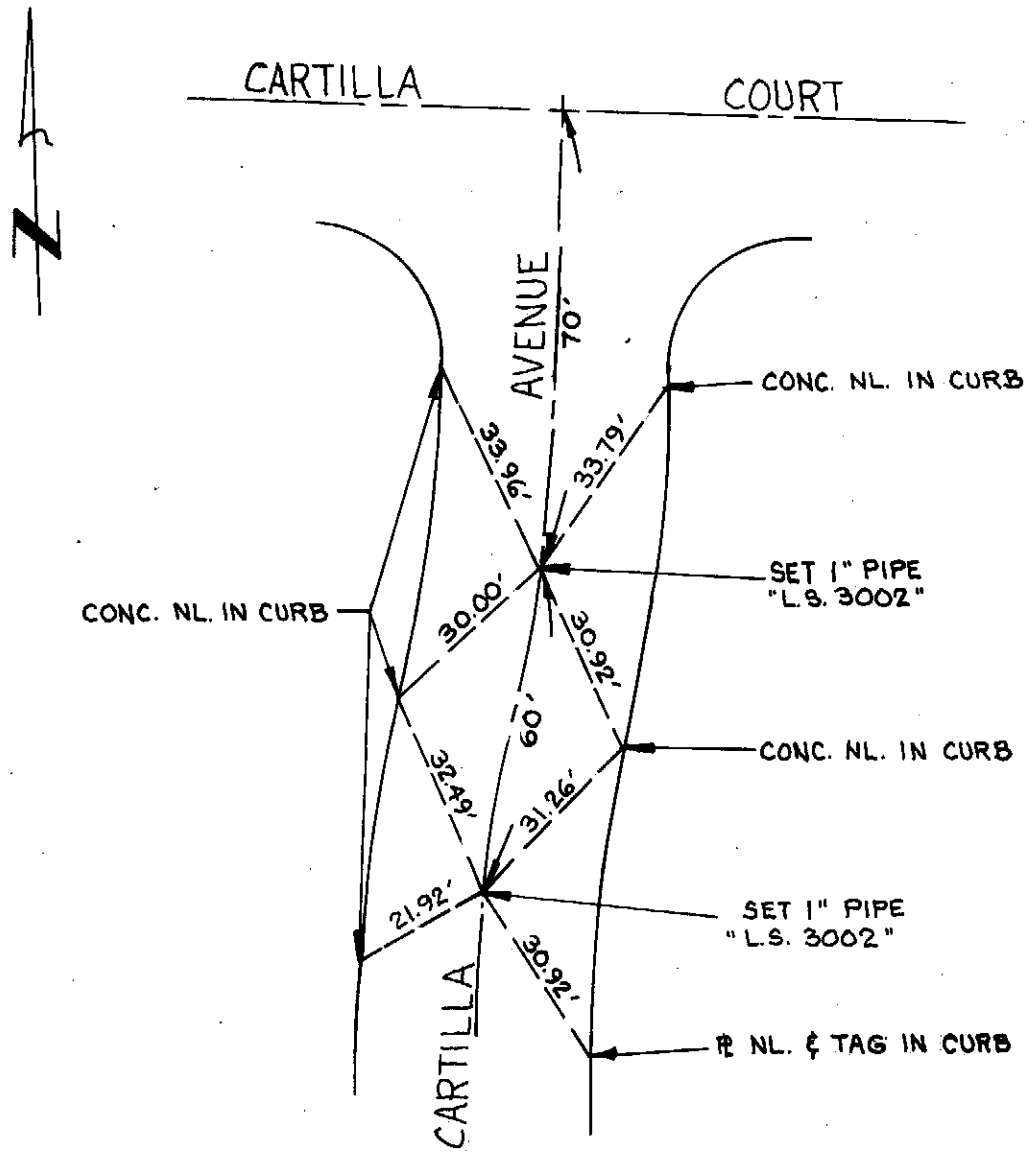

city of rancho cucamonga — STREET TIE	TRACT No. 9427
ASSOCIATED ENGINEERS 316 EAST E STREET ONTARIO, CA. 91764 (714) 986-5818	CARTILLA AVENUE REVERSE CURVES SOUTH OF CARTILLA COURT.
ENGR./L.S. L.H. NOREEN	FIELD REVIEW _____ DATE _____
R.C.E./L.S. No. 3002 DATE 12/1/79	TIE BOOK 6 PAGE 101

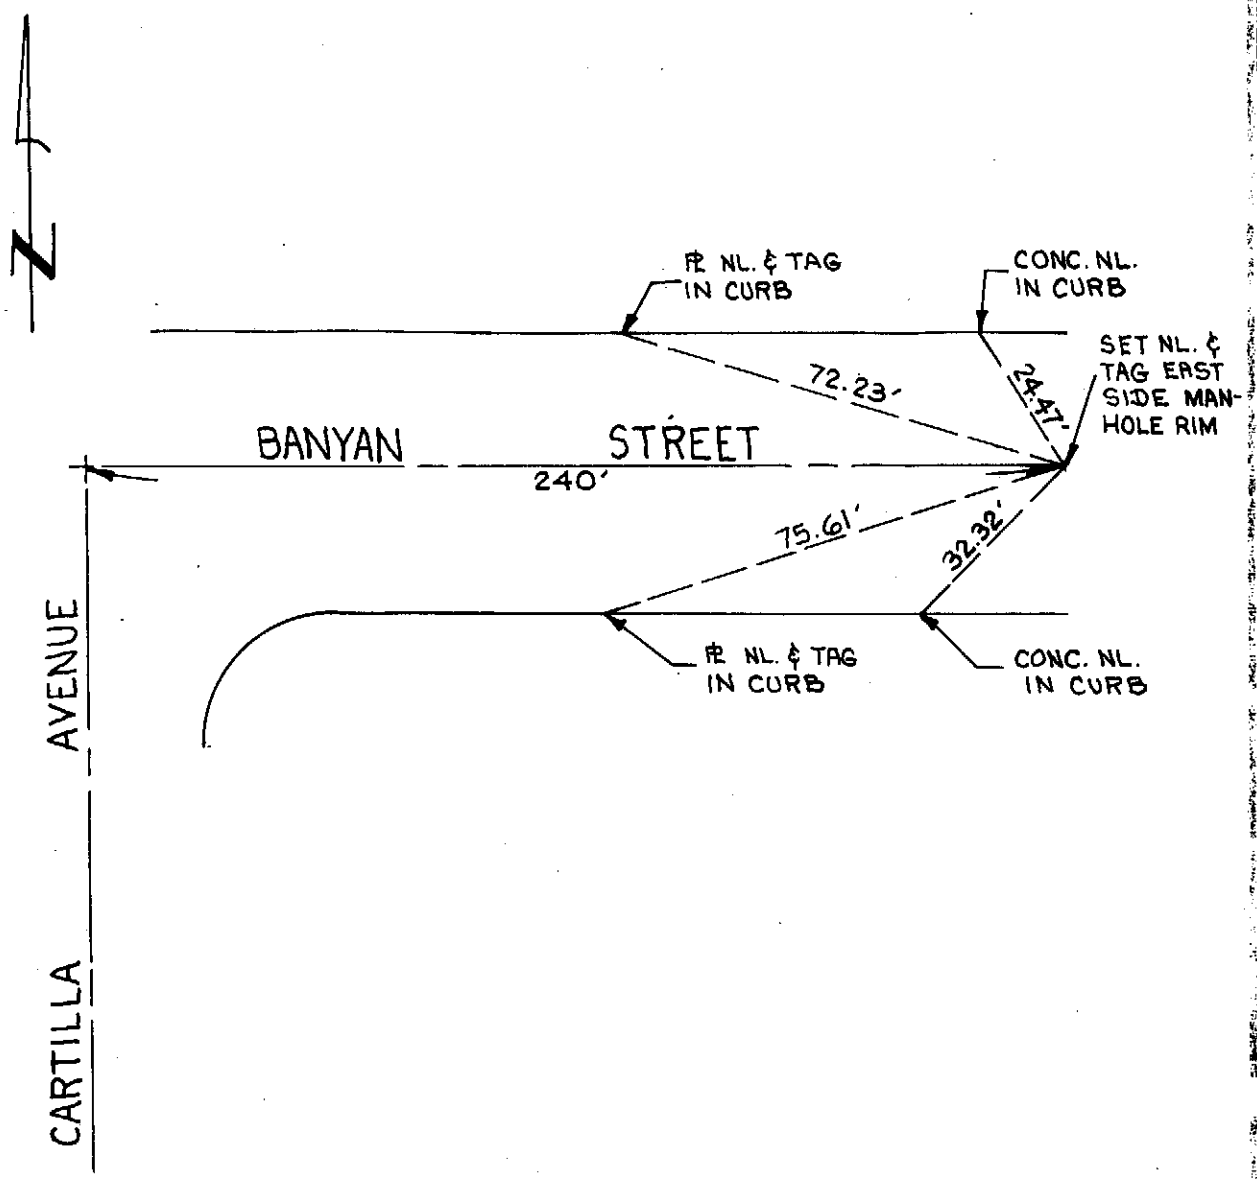

city of rancho cucamonga — STREET TIE	TRACT No. 9427
ASSOCIATED ENGINEERS 316 EAST E STREET ONTARIO, CA. 91764 (714) 986-5818	BANYAN STREET EAST OF CARTILLA AVENUE.
ENGR. / L.S. L.H. NOREEN	FIELD REVIEW _____ DATE _____
R.C.E. / L.S. No. 3002 DATE 12/1/79	TIE BOOK 6 PAGE 102

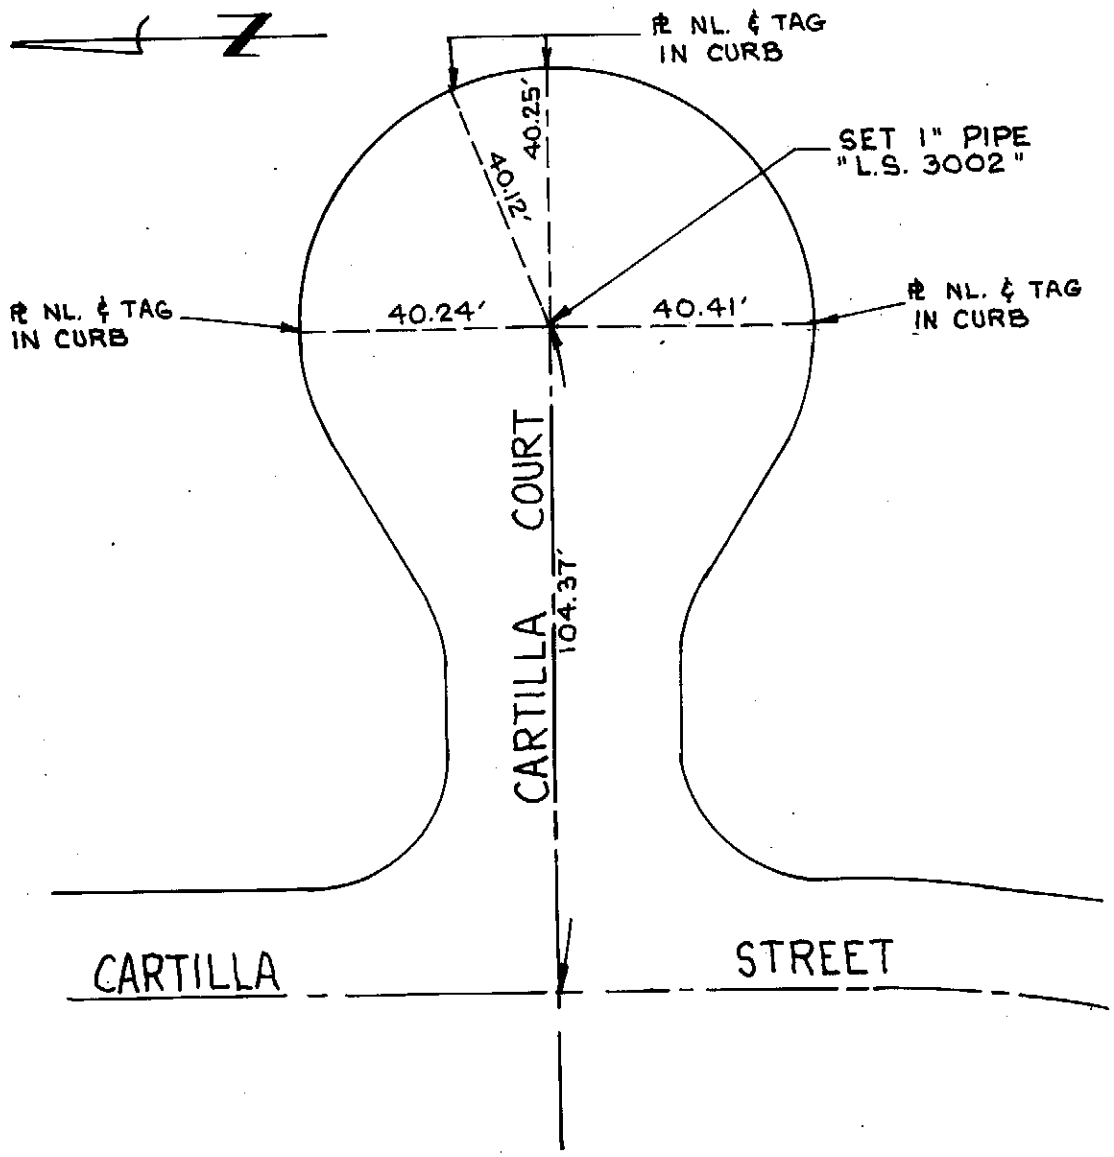

city of rancho cucamonga — STREET TIE	TRACT No. 9427
ASSOCIATED ENGINEERS 316 EAST E STREET ONTARIO, CA. 91764 (714) 986-5818	CARTILLA COURT EAST OF CARTILLA STREET.
ENGR. / L.S. L.H. NOREEN	FIELD REVIEW _____ DATE _____
R.C.E. / L.S. No. 3002 DATE 12/1/79	TIE BOOK 6 PAGE 103

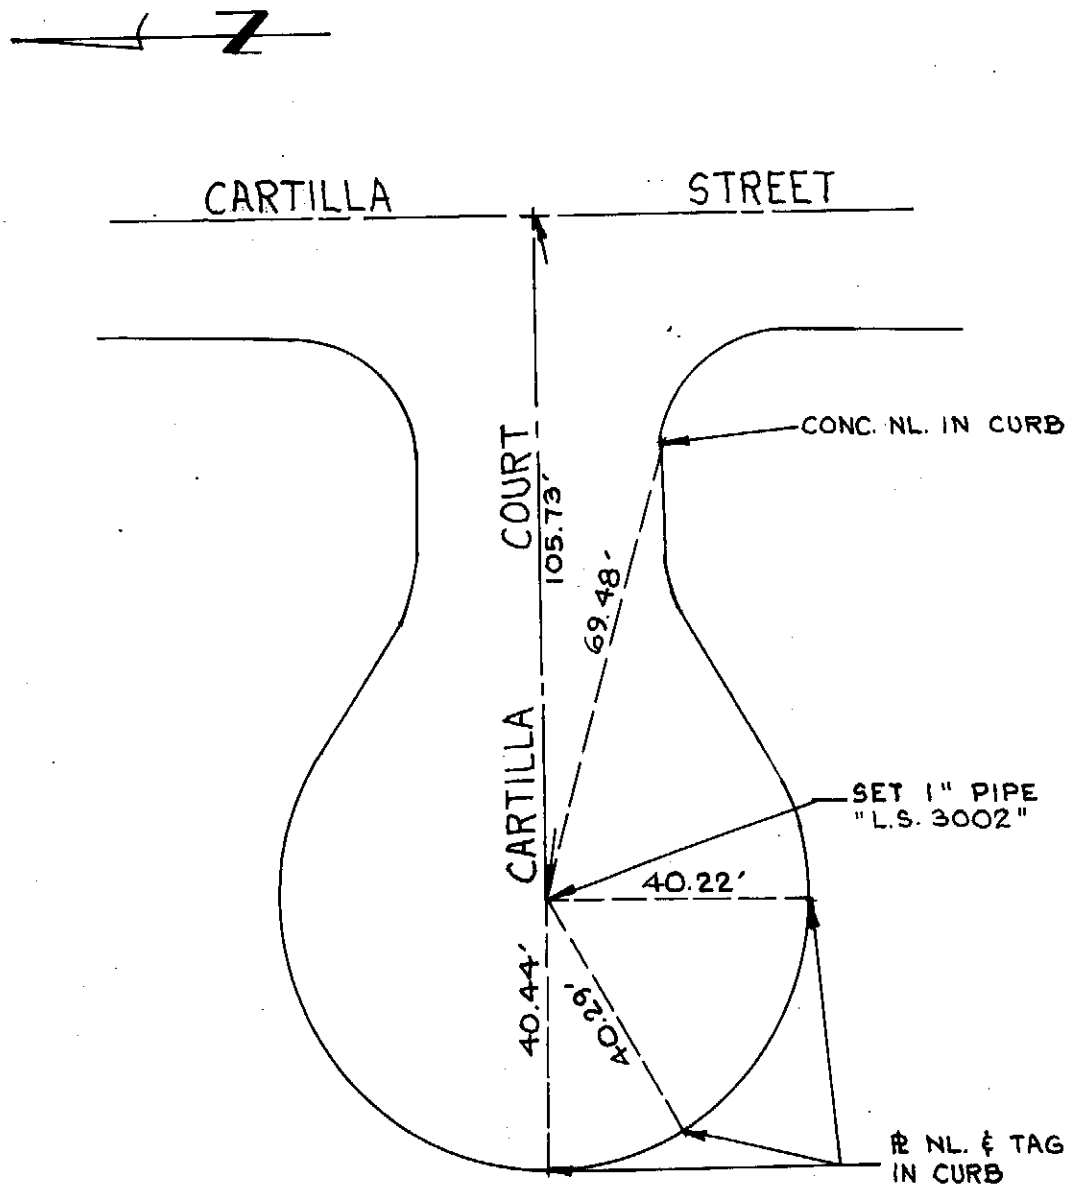

city of rancho cucamonga — STREET TIE	TRACT No. 9427
ASSOCIATED ENGINEERS 316 EAST E STREET ONTARIO, CA. 91764 (714) 986-5818	CARTILLA COURT WEST OF CARTILLA STREET.
ENGR./L.S. L.H. NOREEN	FIELD REVIEW _____ DATE _____
R.C.E./L.S. No. 3002 DATE 12/1/79	TIE BOOK 6 PAGE 104

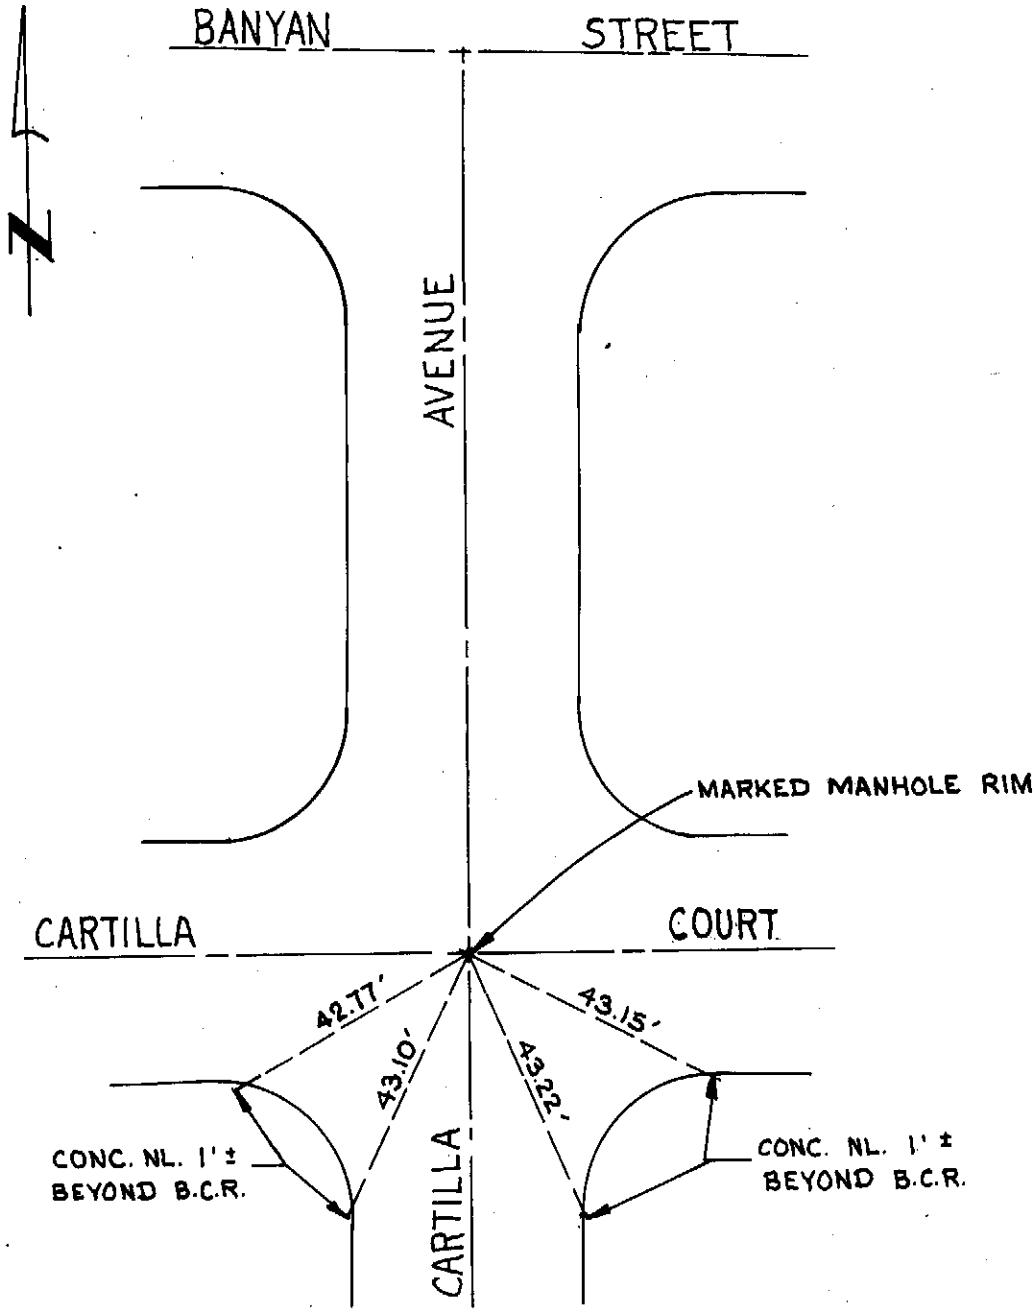

city of rancho cucamonga — STREET TIE	TRACT No. 9427
ASSOCIATED ENGINEERS 316 EAST E STREET ONTARIO, CA. 91764 (714) 986-5818	CARTILLA AVENUE SOUTH OF BANYAN STREET.
ENGR. / L.S. L.H. NOREEN	FIELD REVIEW _____ DATE _____
R.C.E. / L.S. No. 3002 DATE 12/1/79	TIE BOOK 6 PAGE 105

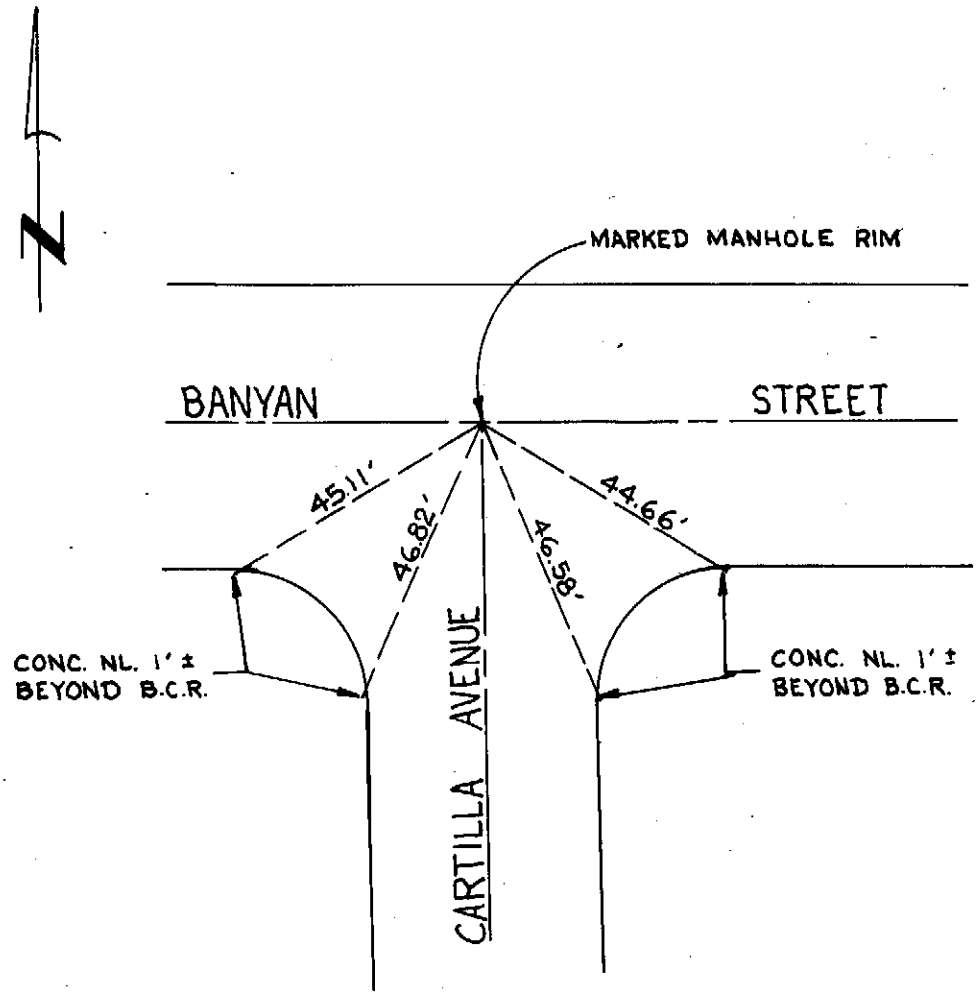

city of rancho cucamonga — STREET TIE	TRACT No. 9427
ASSOCIATED ENGINEERS 316 EAST E STREET ONTARIO, CA. 91764 (714) 986-5818	INTERSECTION OF BANYAN STREET AND CARTILLA AVENUE.
ENGR./L.S. L.H. NOREEN	FIELD REVIEW _____ DATE _____
R.C.E./L.S. No. 3002 DATE 12/1/79	TIE BOOK 6 PAGE 106

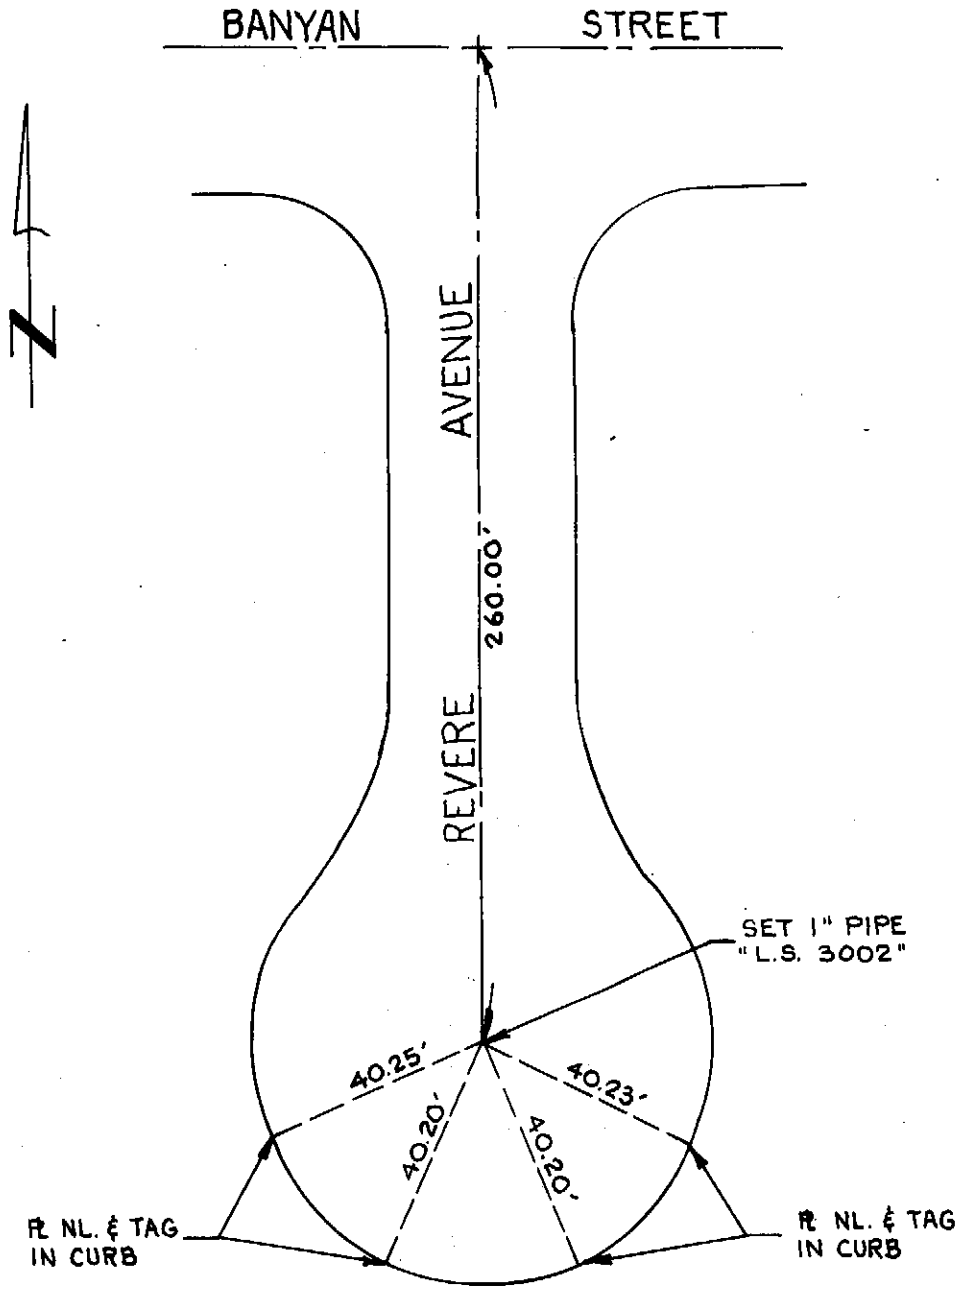

city of rancho cucamonga — STREET TIE	TRACT No. 9427
ASSOCIATED ENGINEERS 316 EAST E. STREET ONTARIO, CA. 91764 (714) 986-5818	REVERE AVENUE SOUTH OF BANYAN STREET.
ENGR. / L.S. L.H. NOREEN	FIELD REVIEW _____ DATE _____
R.C.E. / L.S. No. 3002 DATE 12/1/79	TIE BOOK 6 PAGE 107

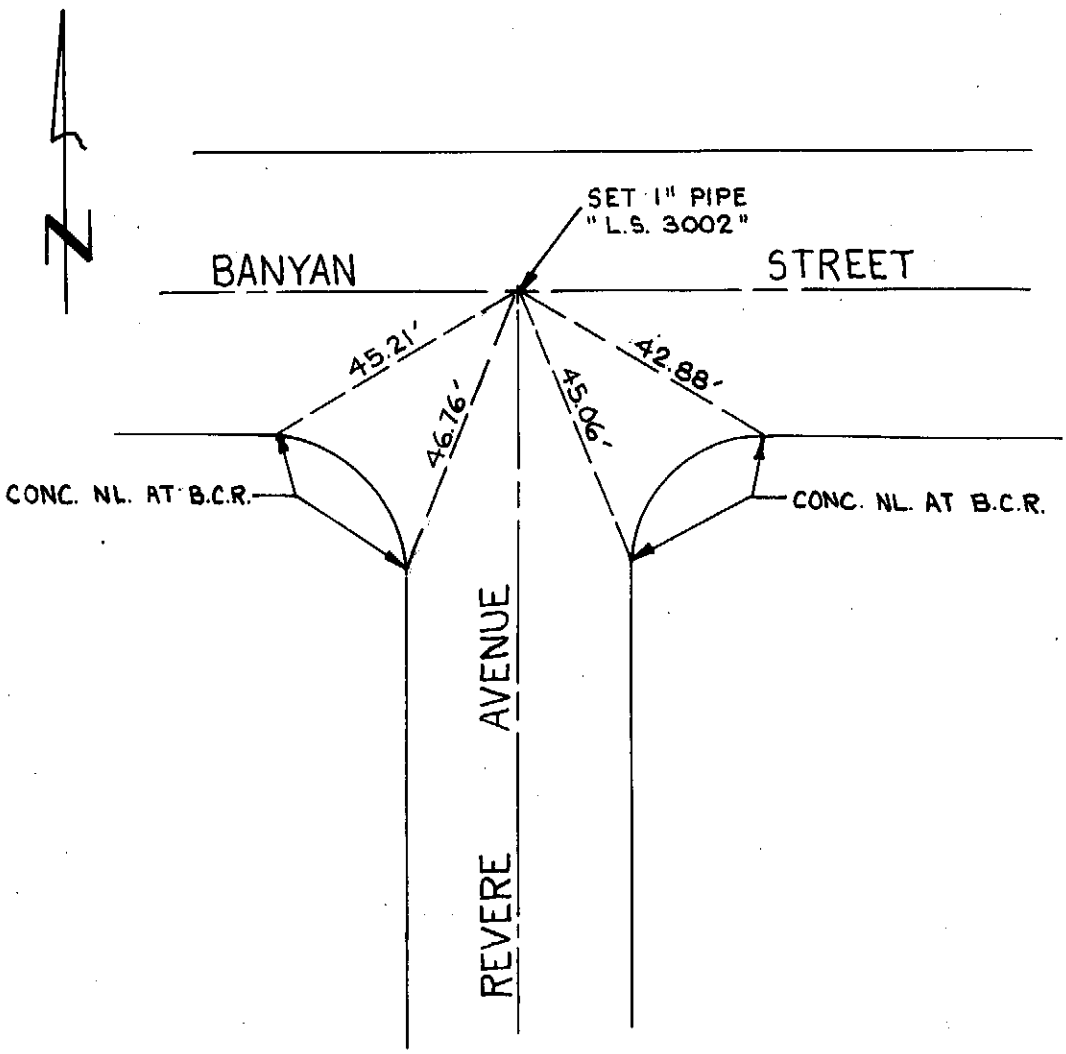

city of rancho cucamonga — STREET TIE	TRACT No. 9427
ASSOCIATED ENGINEERS 316 EAST E STREET ONTARIO, CA. 91764 (714) 986-5818	INTERSECTION OF BANYAN STREET AND REVERE AVENUE.
ENGR./L.S. L.H. NOREEN	FIELD REVIEW _____ DATE _____
R.C.E./L.S. No. 3002 DATE 12/1/79	TIE BOOK 6 PAGE 108

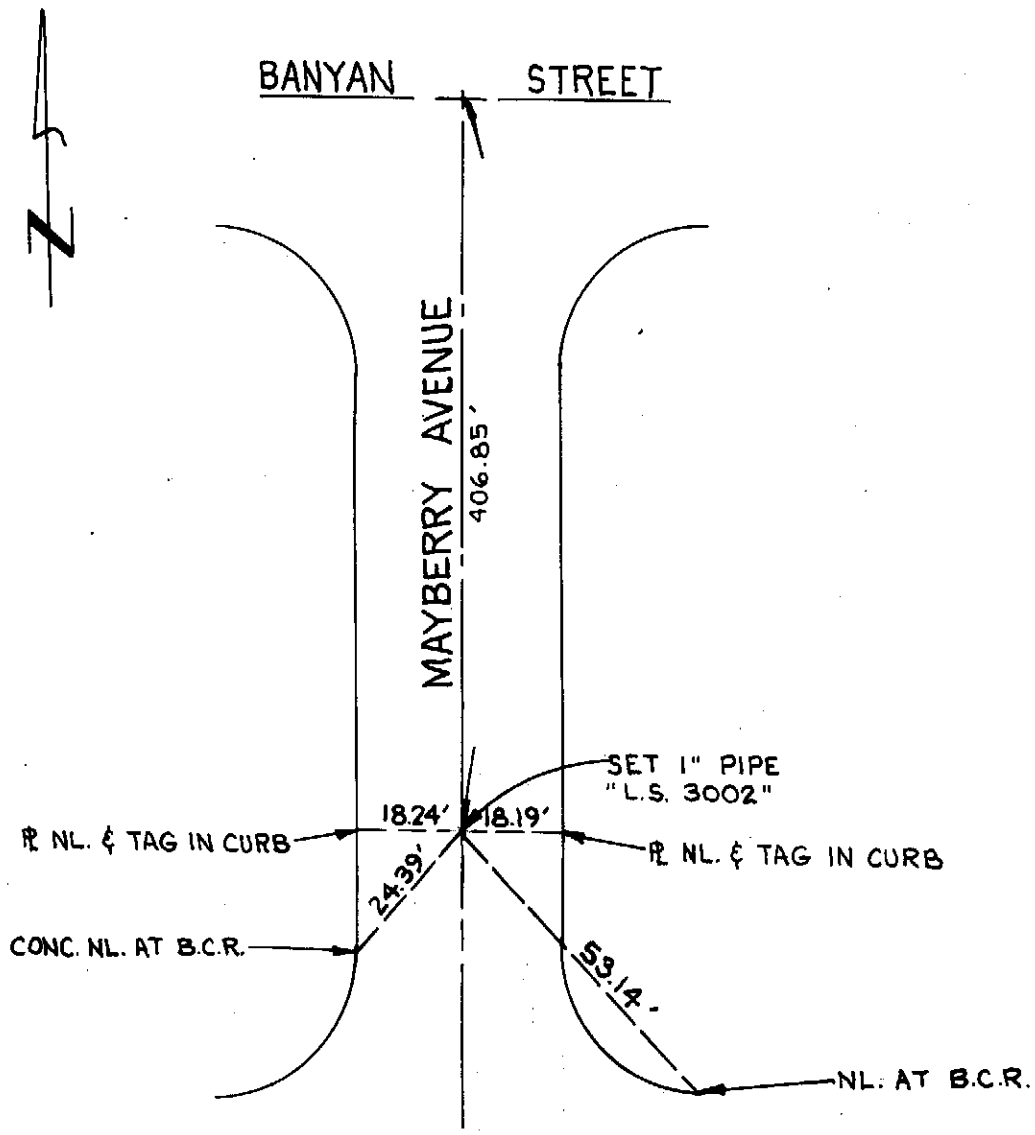

city of rancho cucamonga — STREET TIE	TRACT No. 9427
ASSOCIATED ENGINEERS 316 EAST E STREET ONTARIO, CA. 91764 (714) 986-5818	MAYBERRY AVENUE SOUTH OF BANYAN STREET.
ENGR./L.S. L.H. NOREEN	FIELD REVIEW _____ DATE _____
R.C.E./L.S. No. 3002 DATE 12/1/79	TIE BOOK 6 PAGE 109

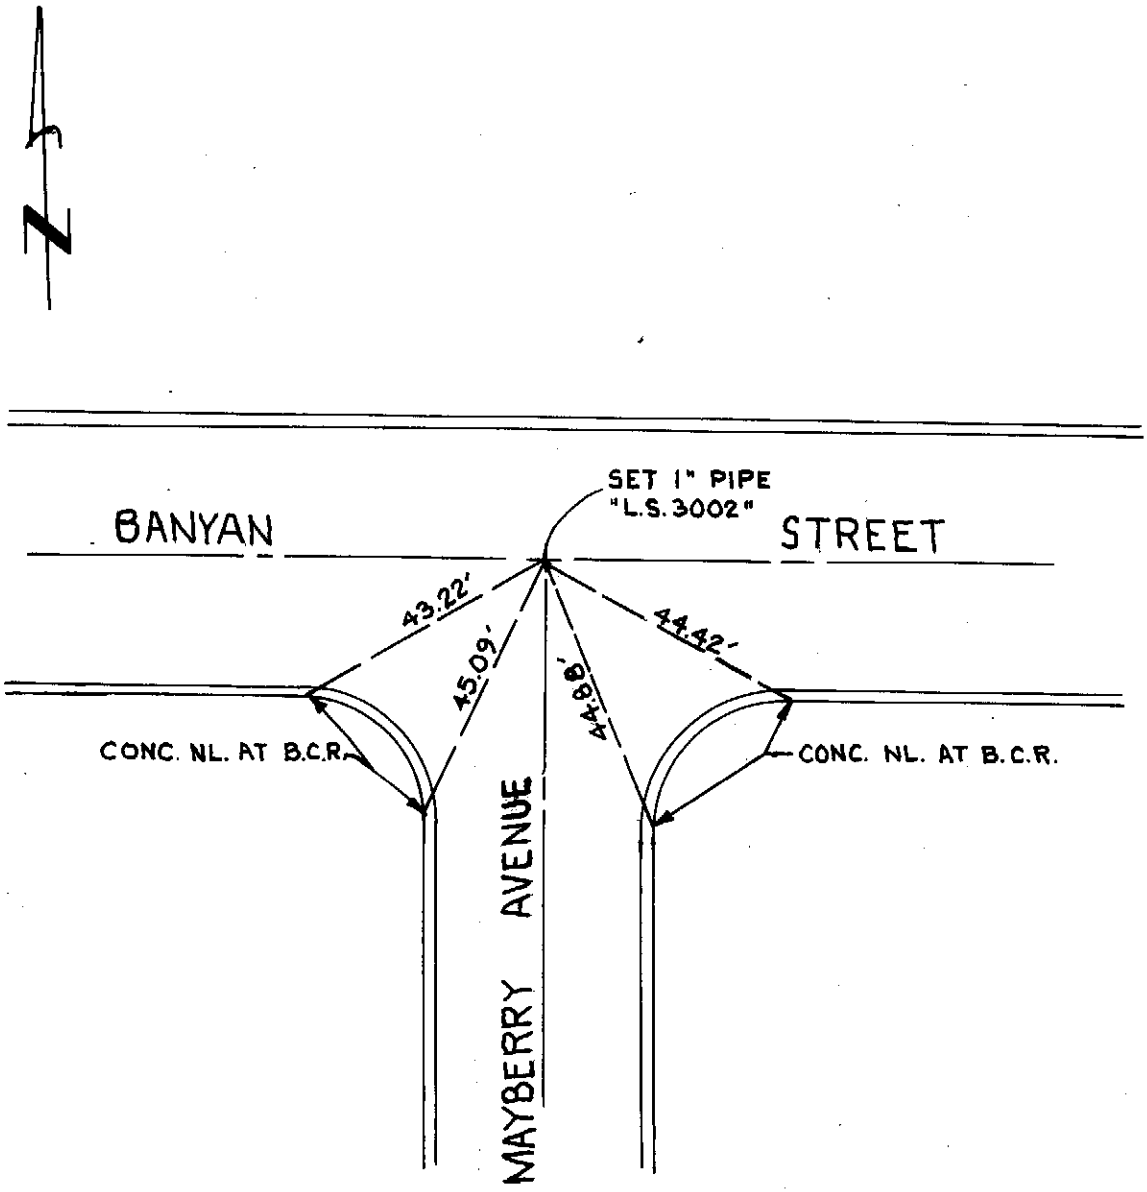

city of rancho cucamonga — STREET TIE	TRACT No. 9427
ASSOCIATED ENGINEERS 316 EAST E STREET ONTARIO, CA. 91764 (714) 986-5818	INTERSECTION OF BANYAN STREET AND MAYBERRY AVENUE.
ENGR./L.S. L.H. NOREEN	FIELD REVIEW _____ DATE _____
R.C.E./L.S. No. 3002 DATE 12/1/79	TIE BOOK 6 PAGE 110

LINVILLE-SANDERSON-HORN & ASSOCIATES
Civil Engineers & Land Surveyors
9587 Arrow Rt. Ste. H (714) 980-1211
RANCHO CUCAMONGA, CA 91730

JOB 79-055 PARCEL MAP NO. 5269
SHEET NO. _____ OF _____
CALCULATED BY GTS DATE 4-11-80
CHECKED BY _____ DATE _____
SCALE 1" = 20'

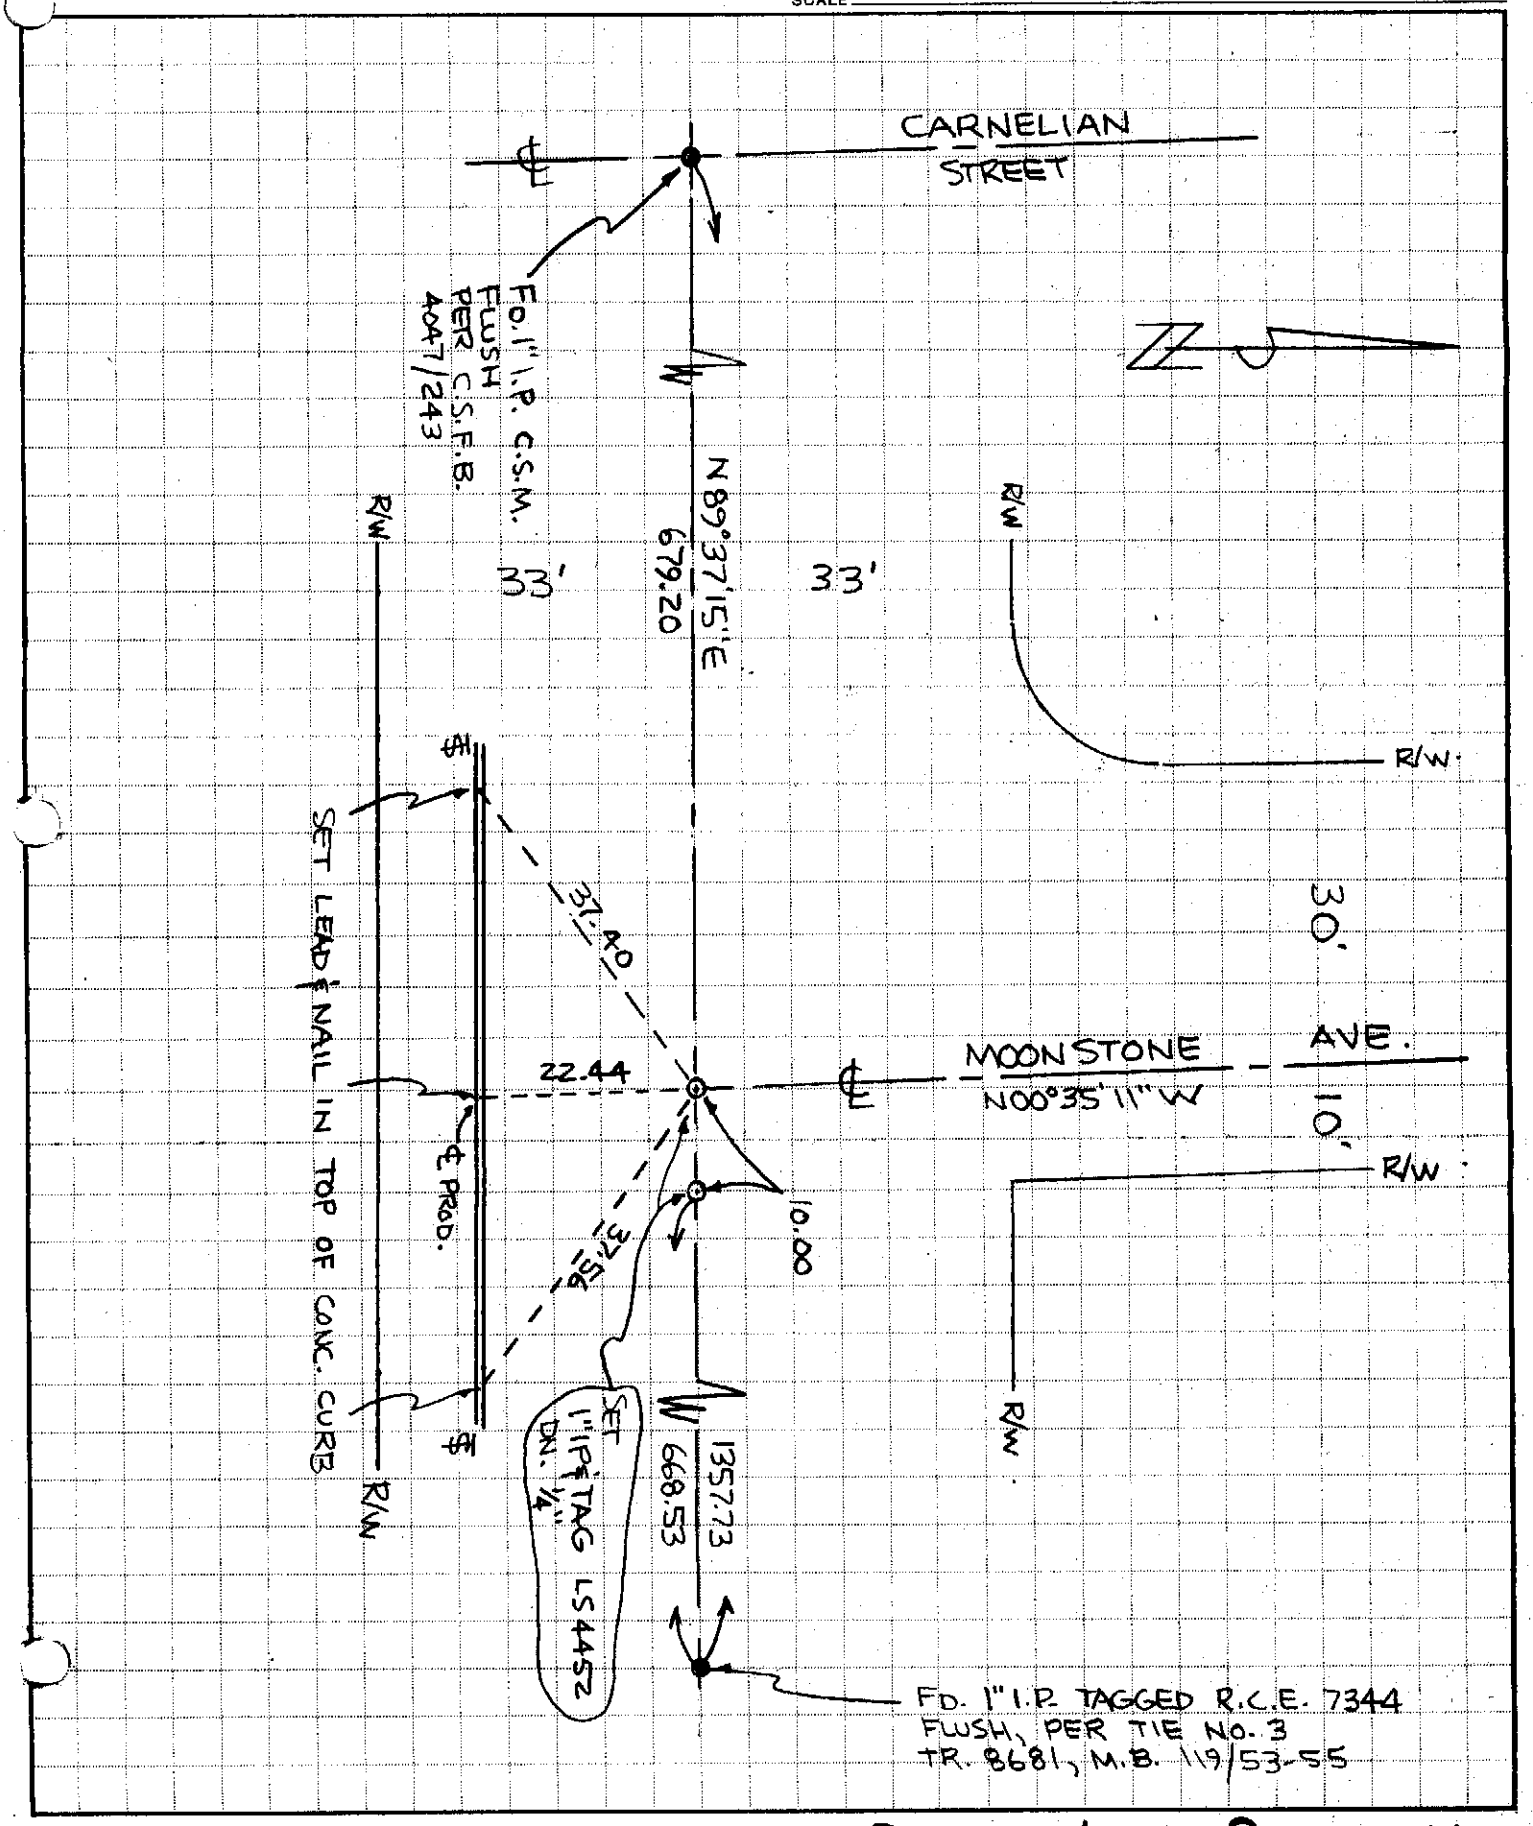

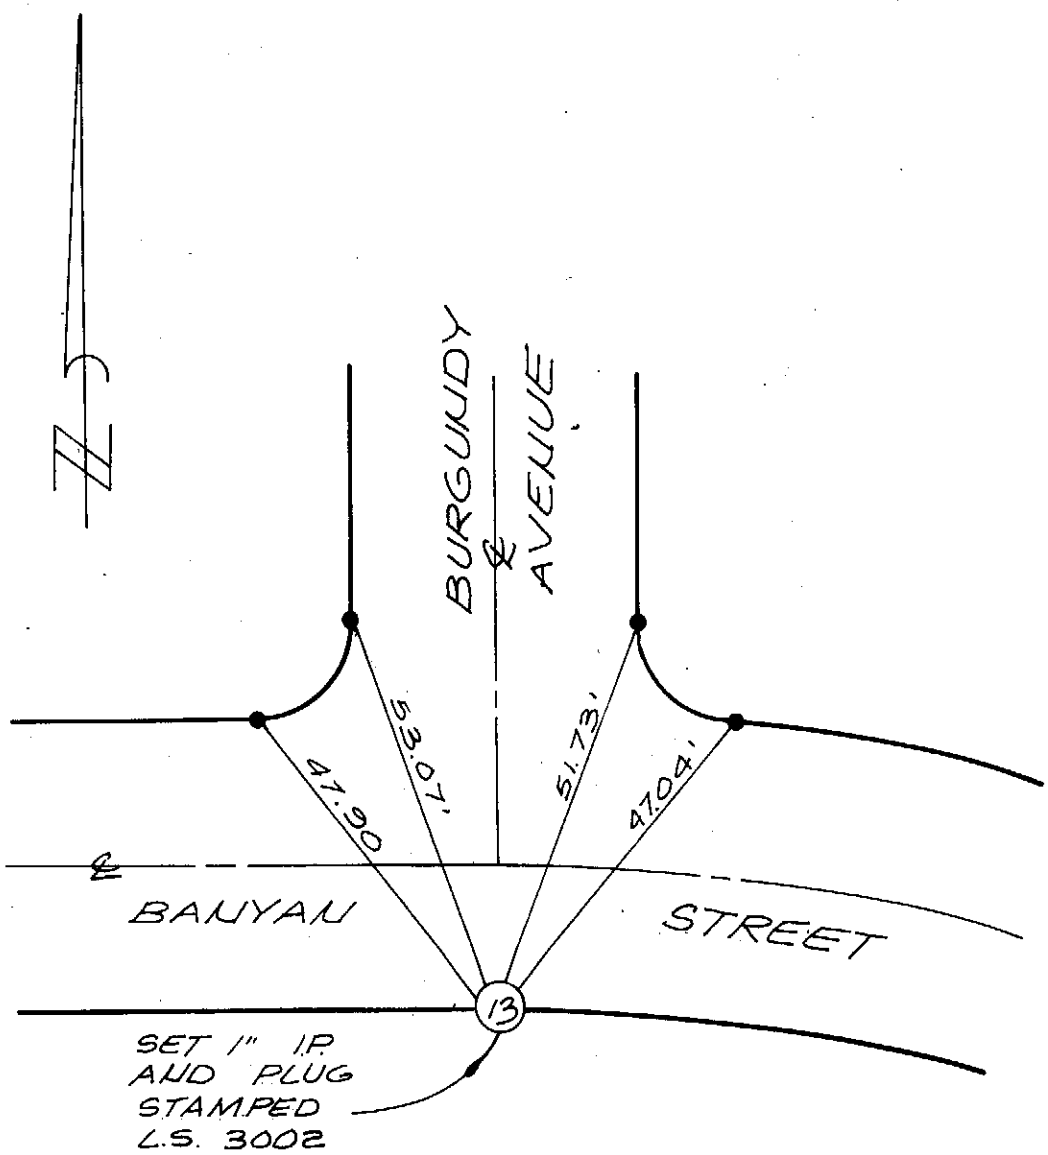

city of rancho cucamonga — STREET TIE	TRACT No. 9445
ASSOCIATED ENGINEERS 316 EAST E STREET ONTARIO, CA. 91764 (714) 986-5818	13 - INT. ℄ BURGUNDY AVE. AND SO. TRACT BOUNDARY
L.S. L.H. NOREEN	FIELD REVIEW _____ DATE _____
L.S. No. 3002 DATE 2/12/81	TIE BOOK 6 PAGE 112

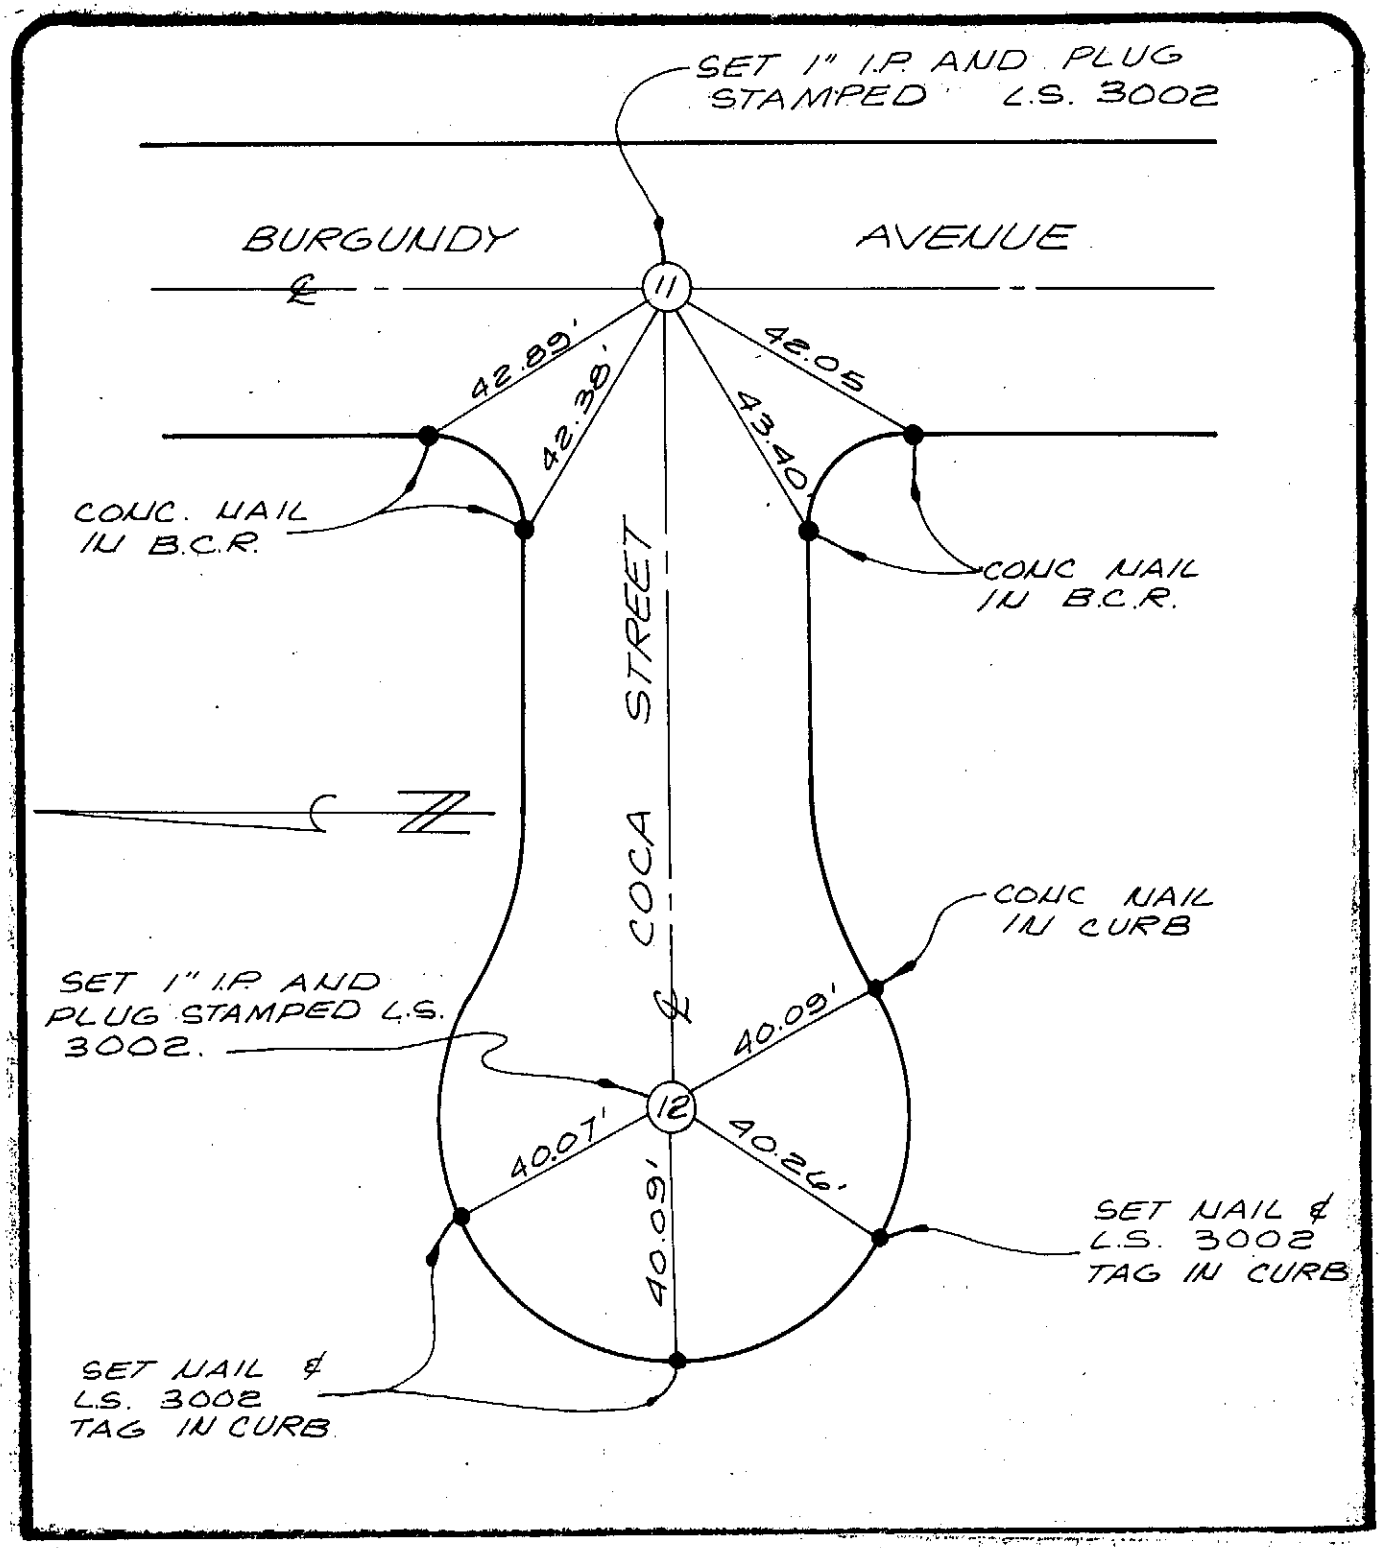

city of rancho cucamonga — STREET TIE	TRACT No. 9445
ASSOCIATED ENGINEERS 316 EAST E STREET ONTARIO, CA. 91764 (714) 986-5818	11 - ℄ INT OF BURGUNDY AVE. & COCA STREET CUL-DE-SAC 12 - RADIUS POINT OF COCA STREET CUL-DE-SAC.
L.S. L.H. NOREEN	FIELD REVIEW _____ DATE _____
L.S. No. 3002 DATE 2/12/81	TIE BOOK 6 PAGE 113

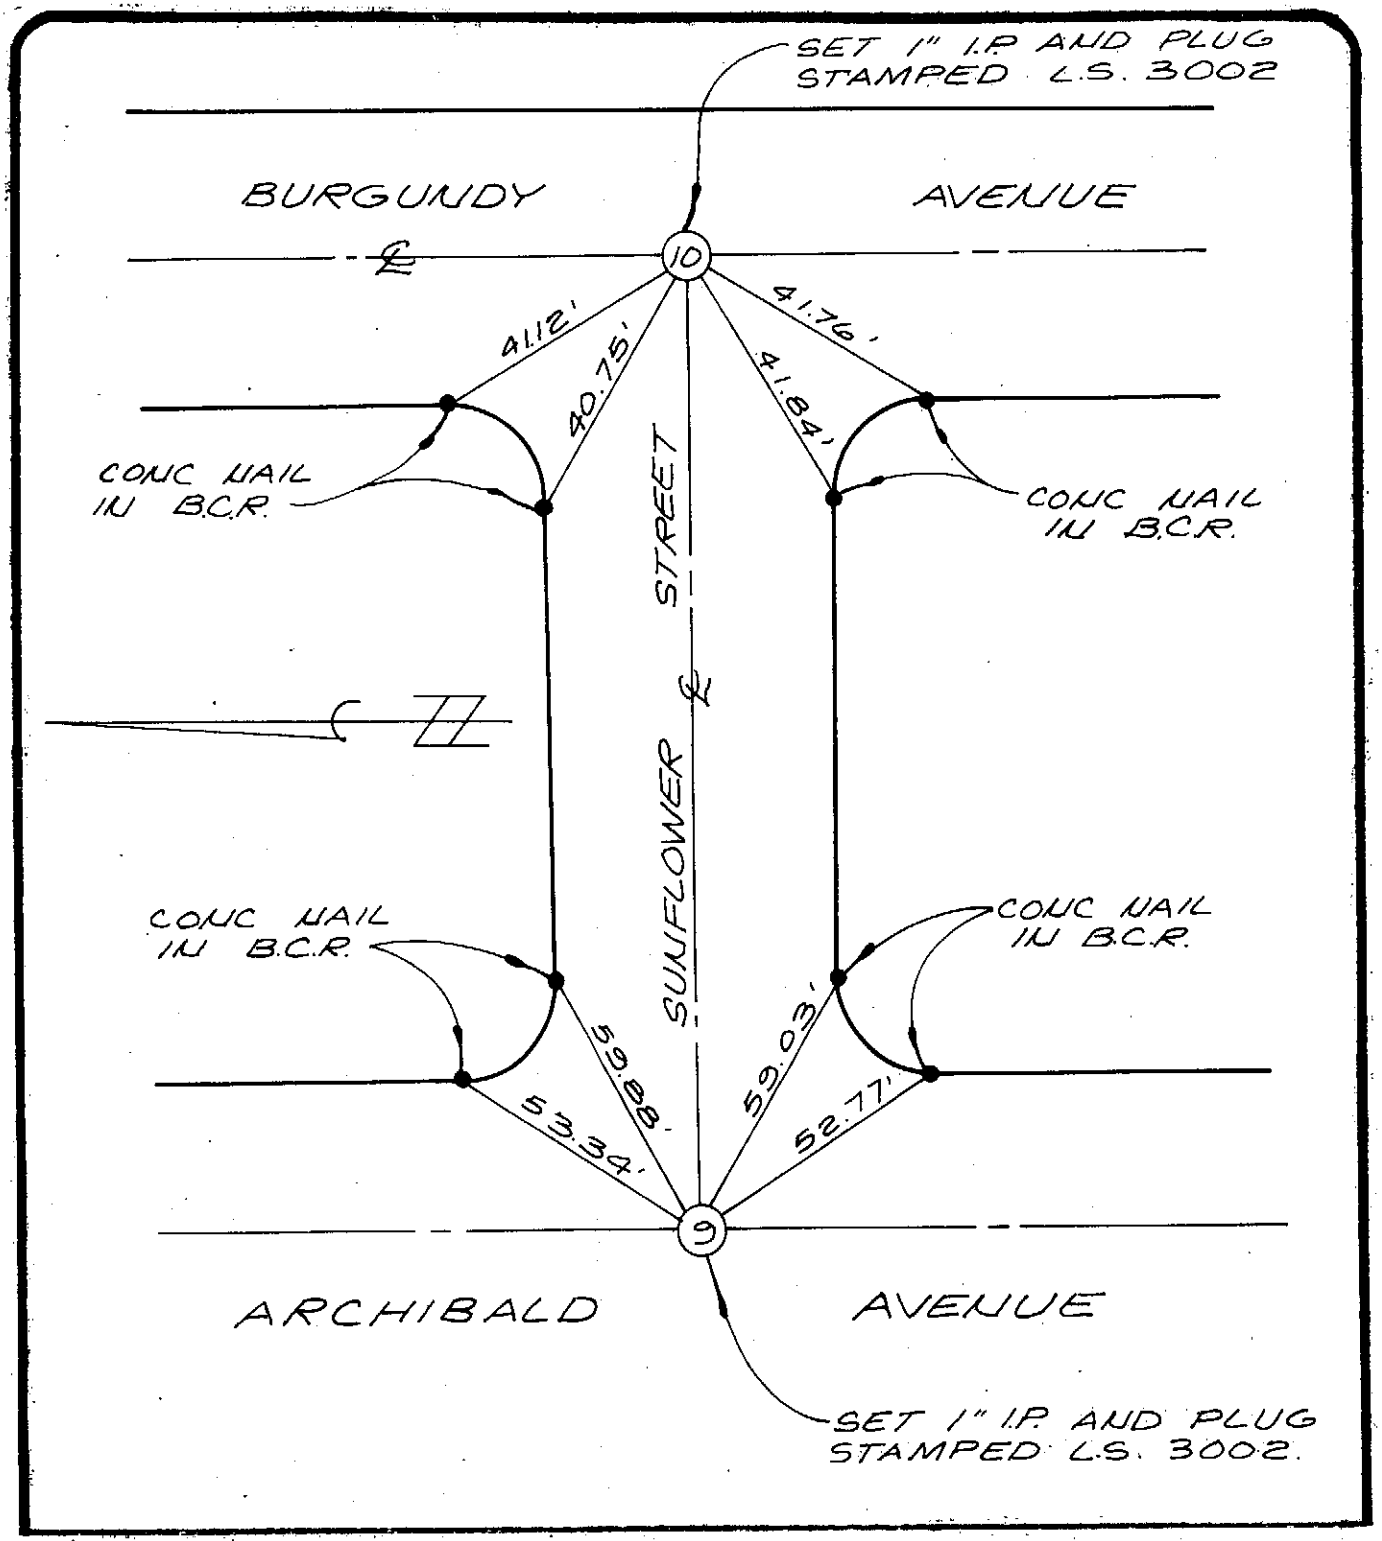

city of rancho cucamonga — STREET TIE	TRACT No. 9445
ASSOCIATED ENGINEERS 316 EAST E STREET ONTARIO, CA. 91764 (714) 986-5818	9 - ℄ INT OF BURGUNDY AVE & SUNFLOWER STREET 10 - ℄ INT OF SUNFLOWER STR. & ARCHIBALD AVE.
L.S. L.H. NOREEN	FIELD REVIEW _____ DATE _____
L.S. No. 3002 DATE 2/12/81	TIE BOOK 6 PAGE 119

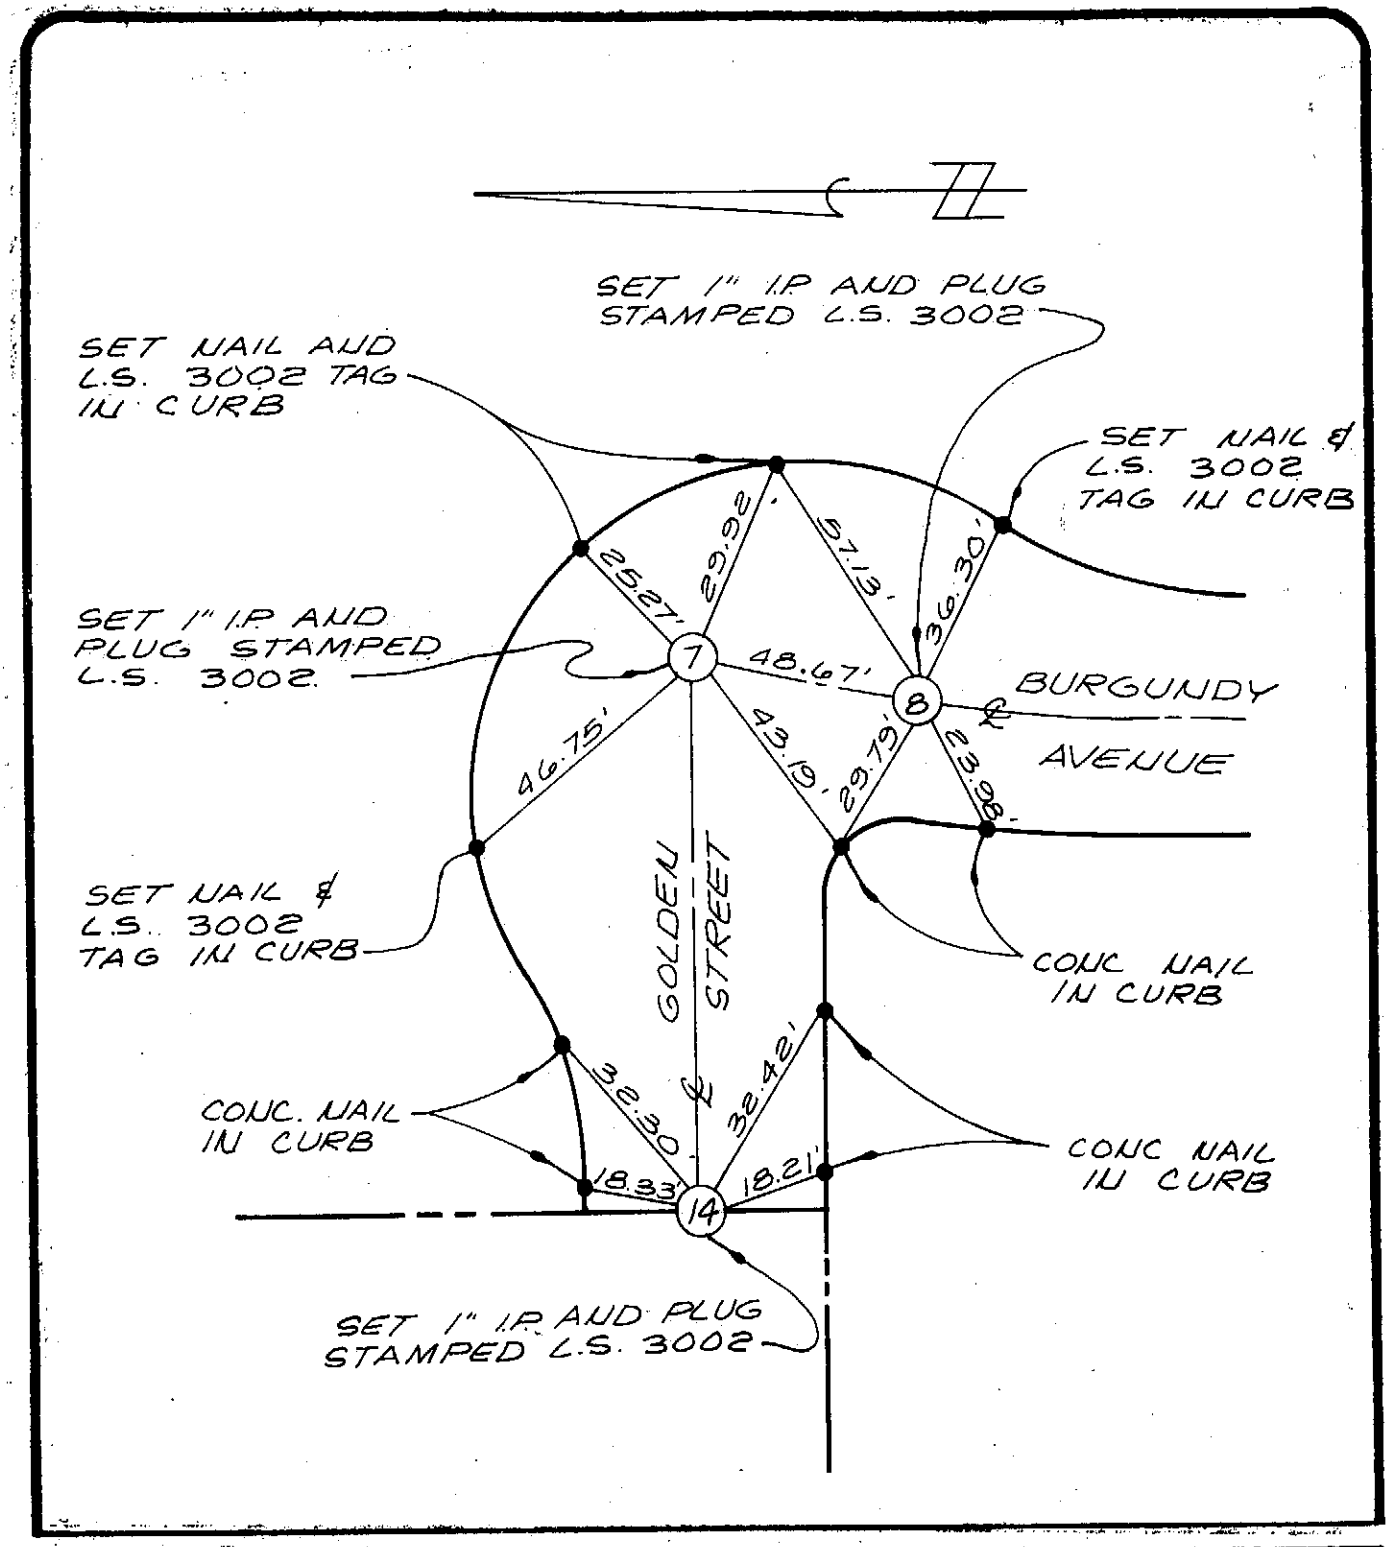

city of rancho cucamonga — STREET TIE	TRACT No. 9445
ASSOCIATED ENGINEERS 316 EAST E STREET ONTARIO, CA. 91764 (714) 986-5818	7 - ℄ INT. BURGUNDY AVE AND GOLDEN ST. 8 - ℄ P.I. IN BURGUNDY AVE 50 ± SO. OF ℄ GOLDEN ST. 14 - INT ℄ GOLDEN ST. AND TRACT BOUNDARY.
L.S. L.H. NOREEN	FIELD REVIEW _____ DATE _____
L.S. No. 3002 DATE 2/12/81	TIE BOOK 6 PAGE 115

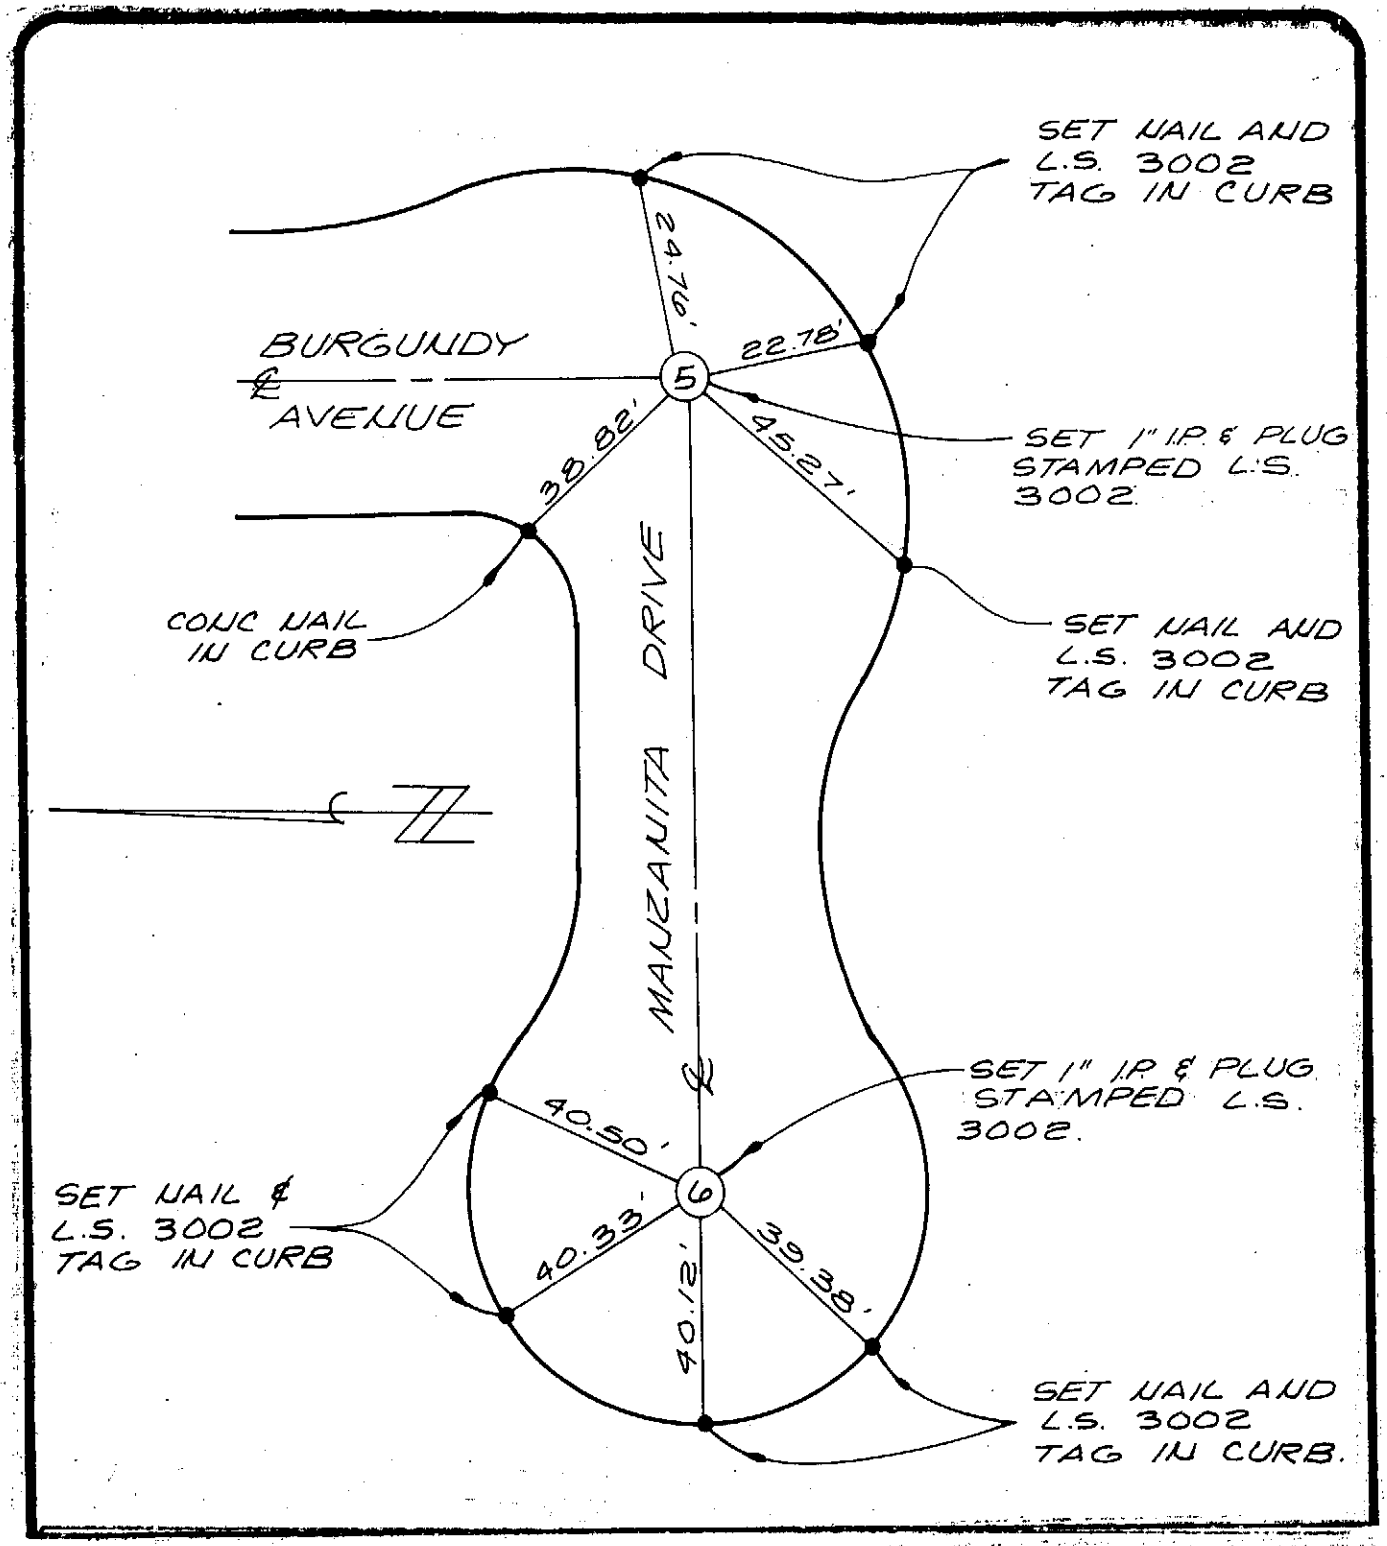

city of rancho cucamonga — STREET TIE	TRACT No. 9445
ASSOCIATED ENGINEERS 316 EAST E STREET ONTARIO, CA. 91764 (714) 986-5818	5 - ℄ INT. BURGUNDY STREET & MANZANITA CUL-DE-SAC 6 - RADIUS POINT OF MANZANITA DR. CUL-DE-SAC
L.S. L.H. NOREEN	FIELD REVIEW _____ DATE _____
L.S. No. 3002 DATE 2/12/81	TIE BOOK 6 PAGE 116

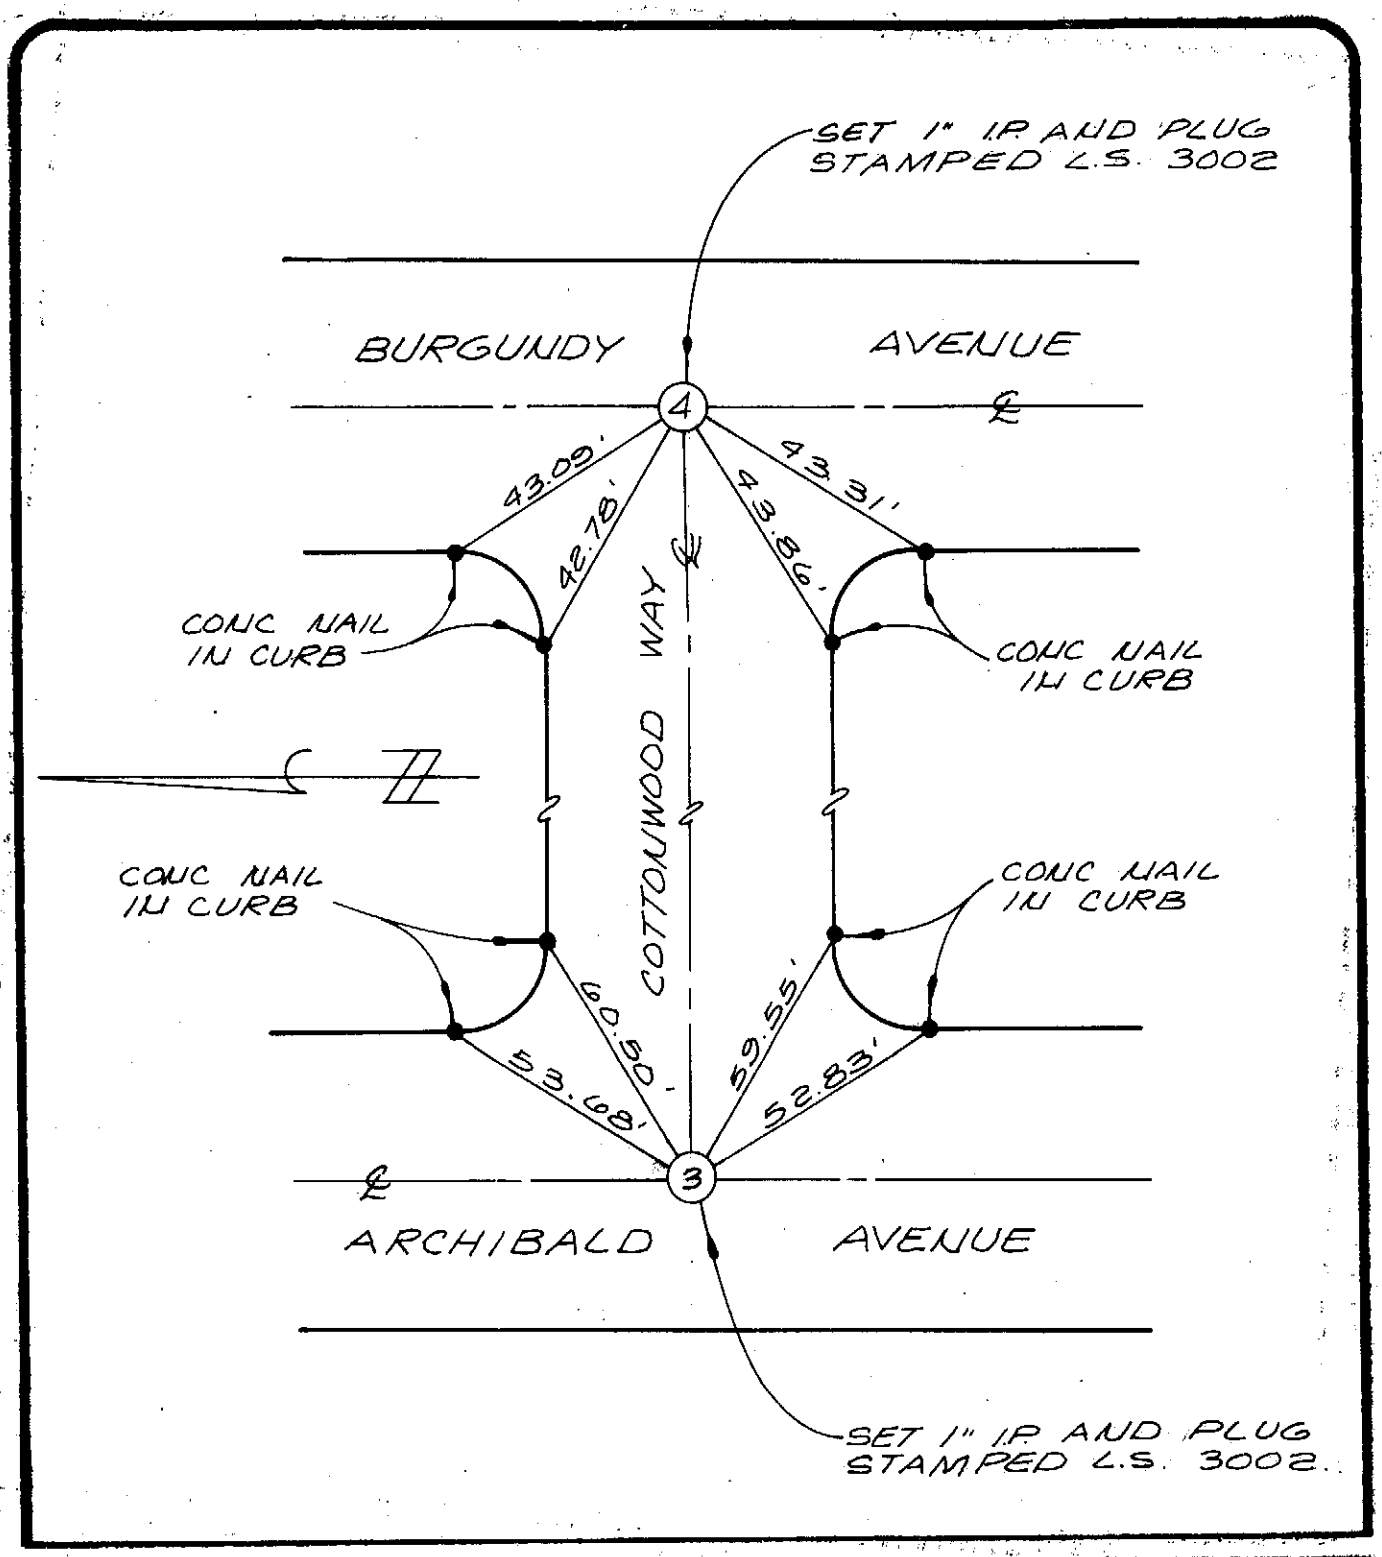

city of rancho cucamonga — STREET TIE	TRACT No. 9445
ASSOCIATED ENGINEERS 316 EAST E STREET ONTARIO, CA. 91764 (714) 986-5818	4 - ℄ INT. OF BURGUNDY AVE. & COTTONWOOD WAY 3 - ℄ INT OF COTTONWOOD WAY & ARCHIBALD AVE.
L.S. L.H. NOREEN	FIELD REVIEW _____ DATE _____
L.S. No. 3002 DATE 2/12/81	TIE BOOK 6 PAGE 117

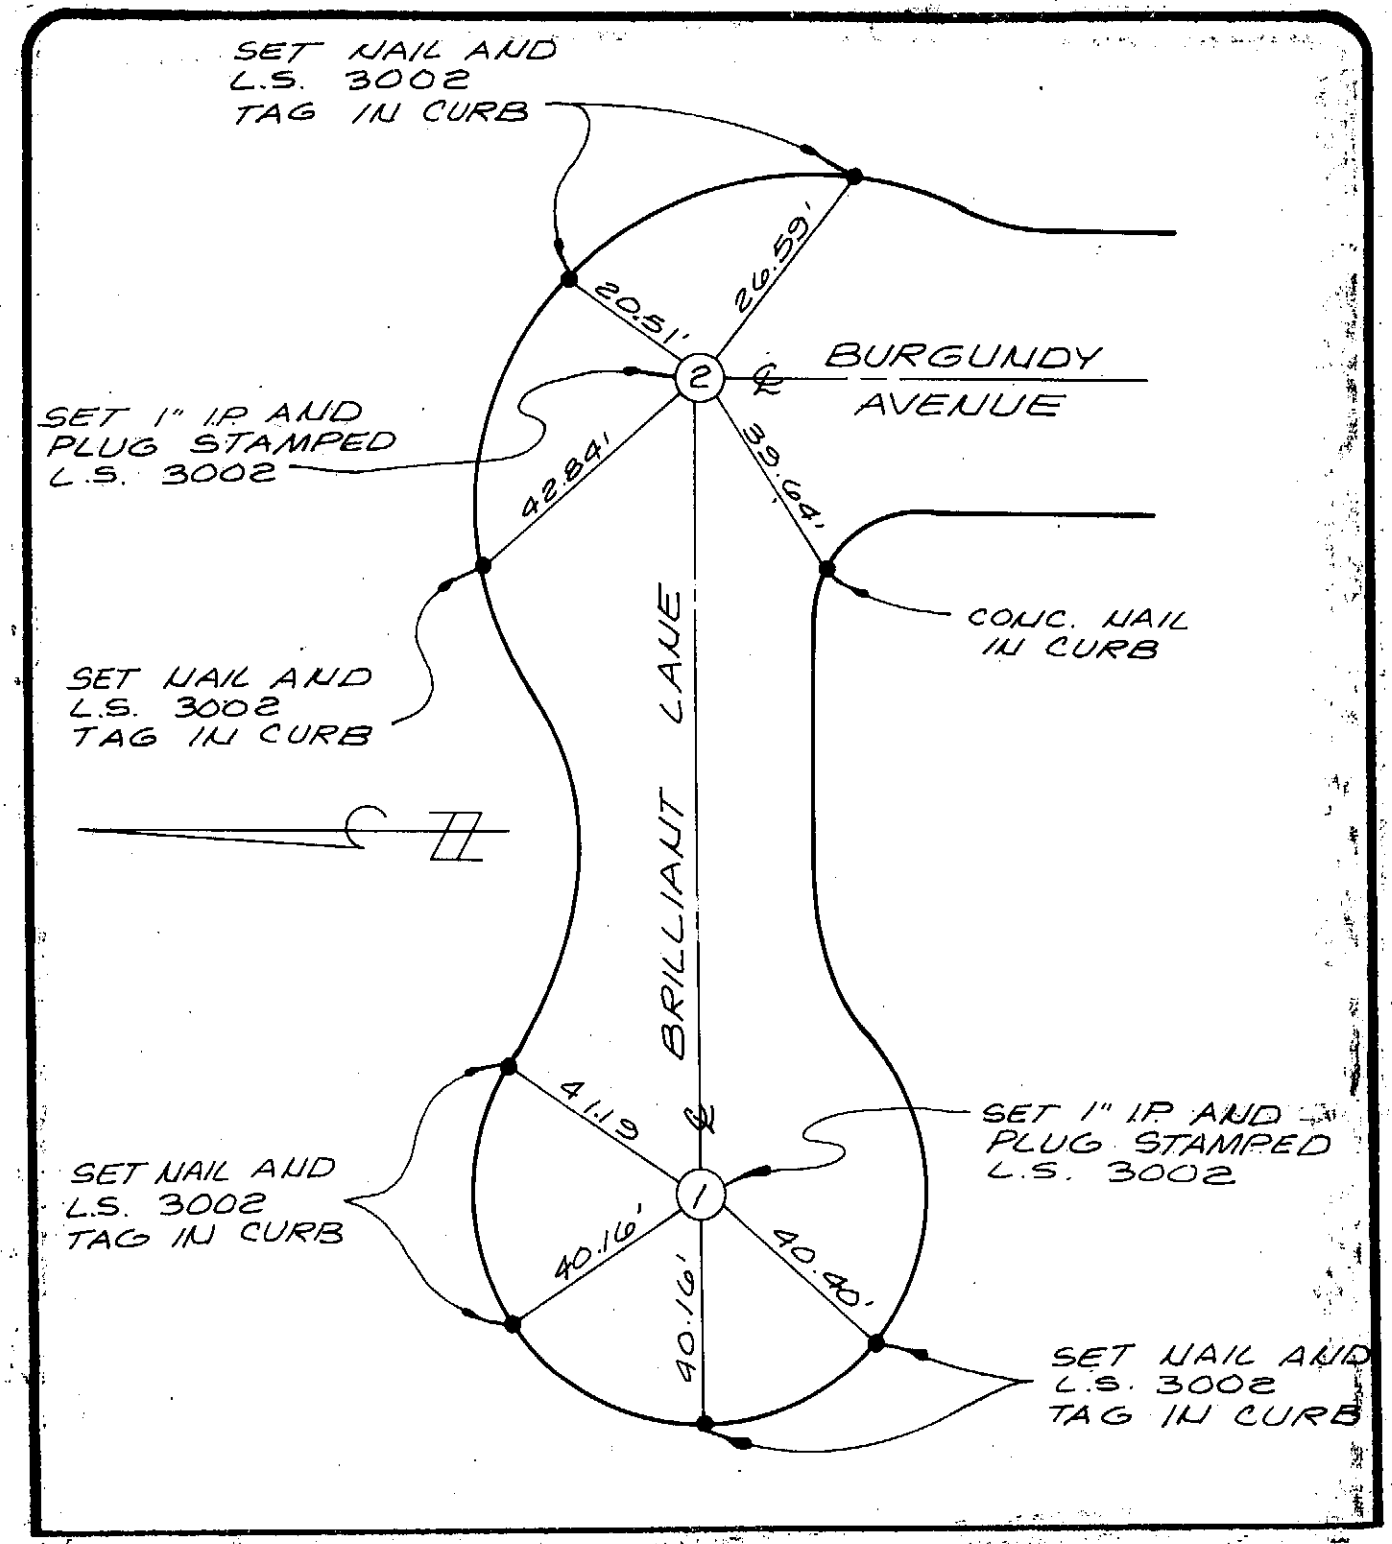

city of rancho cucamonga — STREET TIE	TRACT No. 9445
ASSOCIATED ENGINEERS 316 EAST E STREET ONTARIO, CA. 91764 (714) 986-5818	2 - ℄ INT. BURGUNDY AVE. & BRILLIANT LN. CUL-DE-SAC 1 - RADIUS POINT OF BRILLIANT LN. CUL-DE-SAC
L.S. L.H. NOREEN	FIELD REVIEW _____ DATE _____
L.S. No. 3002 DATE 2/12/81	TIE BOOK 6 PAGE 118

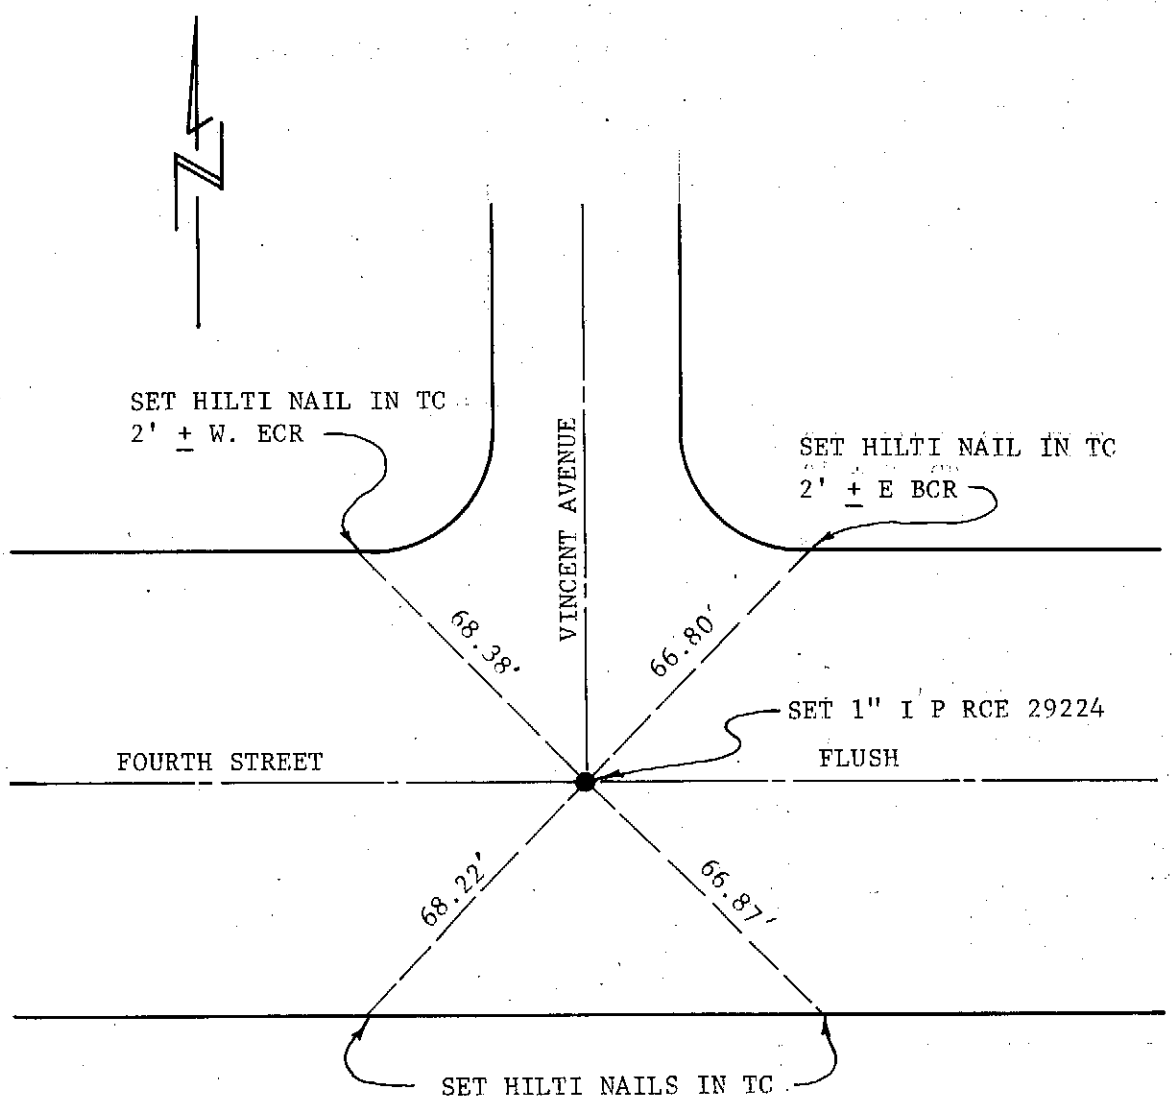

city of rancho cucamonga — STREET TIE	PARCEL MAP NO. 4907
DERBISH, GUERRA & ASSOCIATES, INC. 124 East F. Street Suite 12 Ontario, California 91764	FOURTH STREET & VINCENT AVENUE
ENGR./L.S. Daniel E. Guerra	FIELD REVIEW _____ DATE _____
R.C.E./L.S. No. RCE 29224 DATE 10/80	TIE BOOK 6 PAGE 119

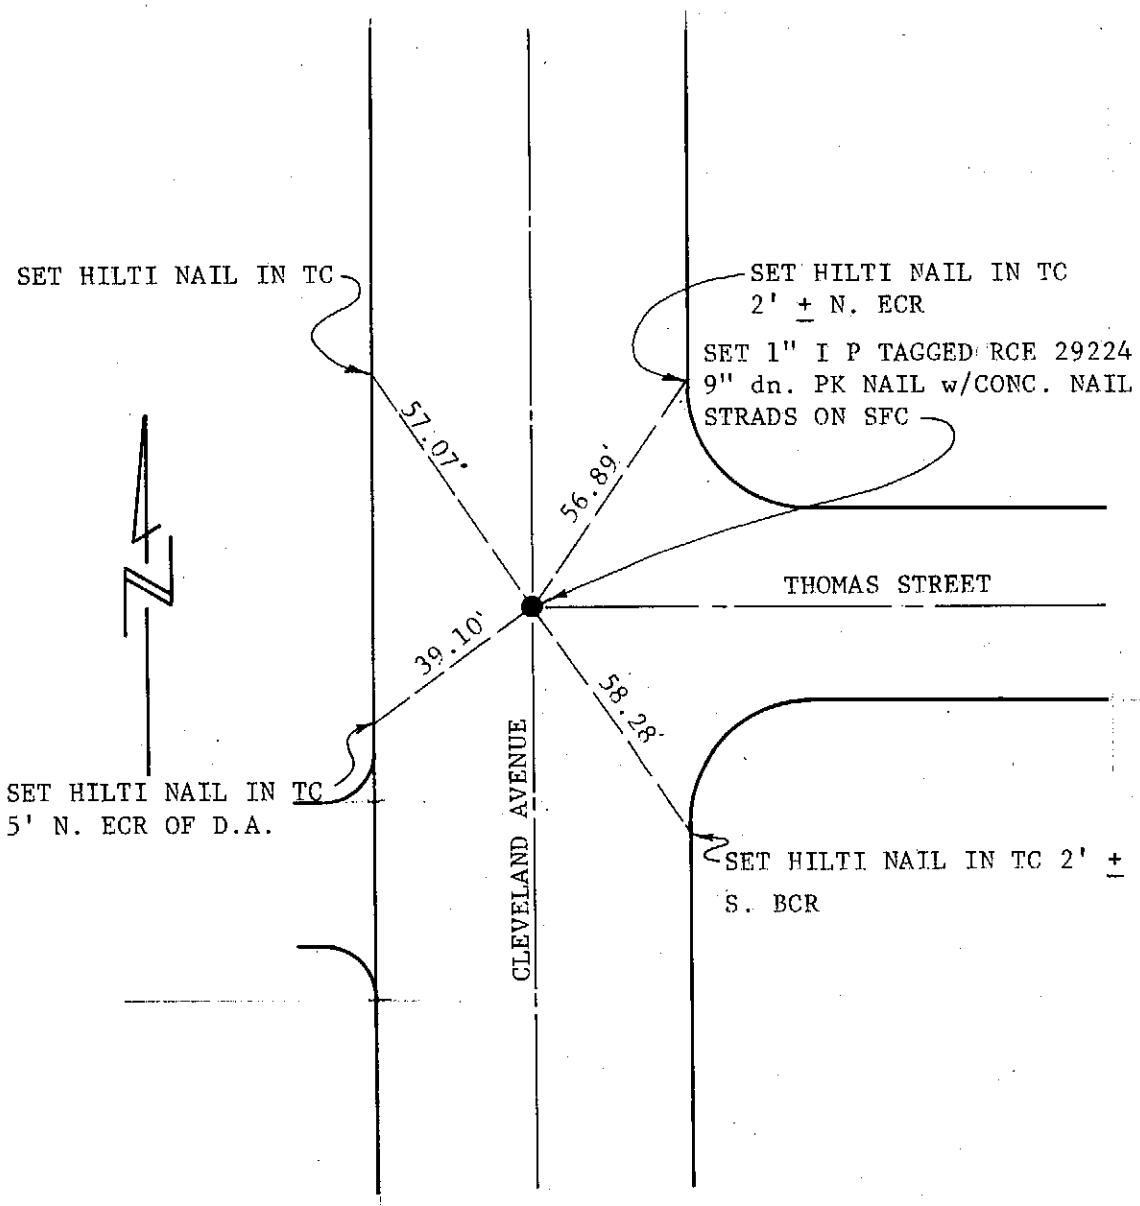

city of rancho cucamonga — STREET TIE	PARCEL MAP NO. 4907
DERBISH, GUERRA & ASSOCIATES, INC. 124 East F Street Suite 12 Ontario, California 91764	CLEVELAND AVENUE & THOMAS STREET
ENGR./L.S. DANIEL E. GUERRA	FIELD REVIEW _____ DATE _____
R.C.E./L.S. No. RCE 29224 DATE 10/80	TIE BOOK 6 PAGE 120

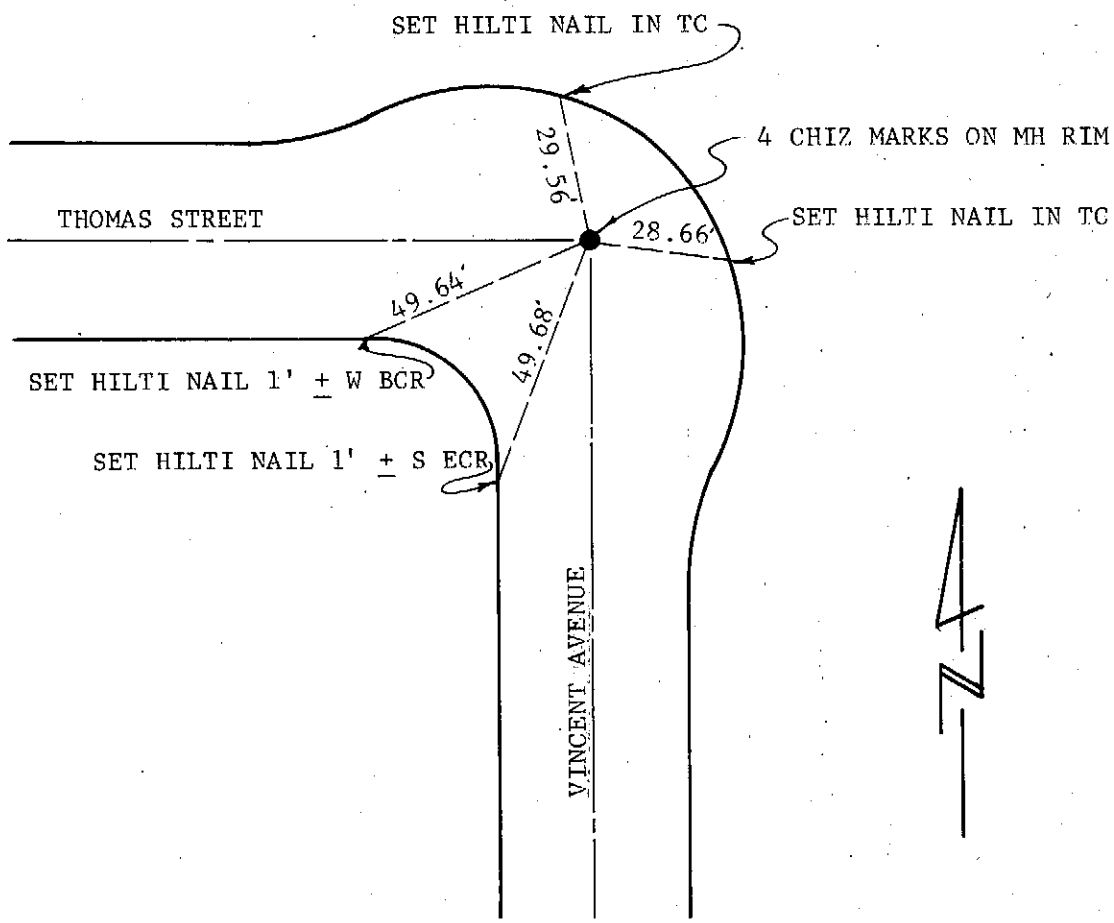

city of rancho cucamonga — STREET TIE	PARCEL MAP NO. 4907
DERBISH, GUERRA & ASSOCIATES, INC. 124 East F Street Suite 12 Ontario, California 91764	THOMAS STREET & VINCENT AVENUE
ENGR./L.S. DANIEL E. GUERRA	FIELD REVIEW _____ DATE _____
R.C.E./L.S. No. RCE. 29224 DATE 10/80	TIE BOOK 6 PAGE 121

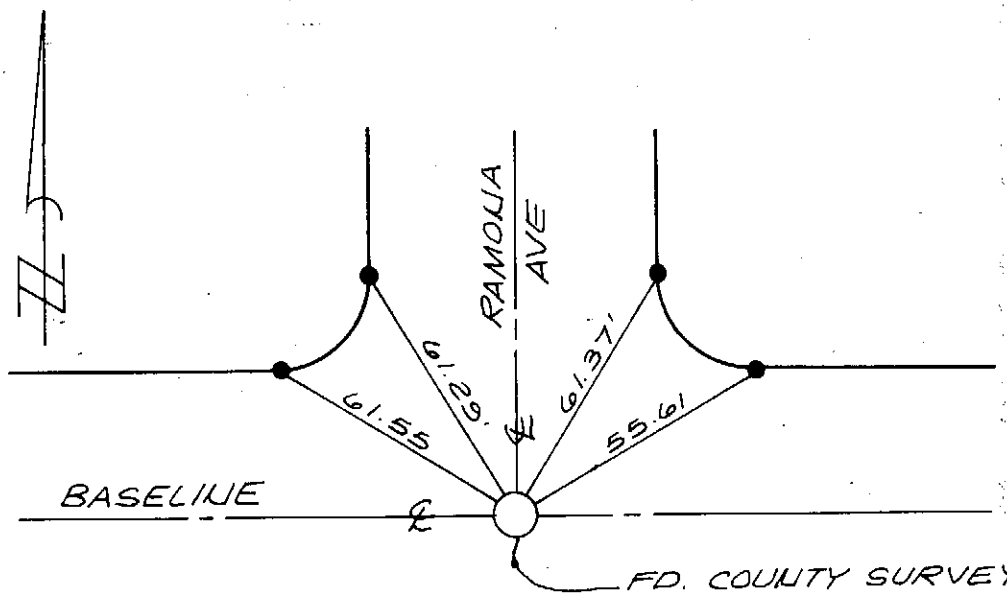

RESET P.K. NAIL AT EDGE OF MANHOLE WITH 2' TIES AFTER MANHOLE RAISED.

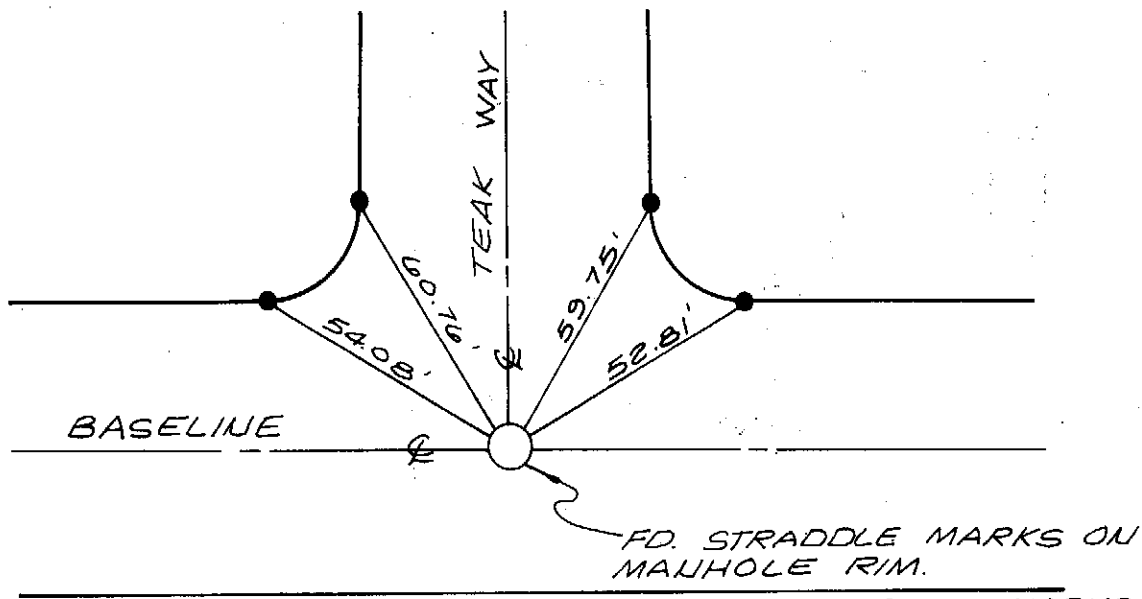

RESET STRADDLE MARKS ON MANHOLE RIM. AFTER MANHOLE RAISED.

city of rancho cucamonga — STREET TIE	TRACT No.
ASSOCIATED ENGINEERS 316 EAST E STREET ONTARIO, CA. 91764 (714) 986-5818	℄ INT. BASELINE AND RAMONA AVE ℄ INT. BASELINE AND TEAK WAY
L.S. L.H. NOREEN	FIELD REVIEW _____ DATE _____
L.S. No. 3002 DATE 10/80	TIE BOOK 6 PAGE 122

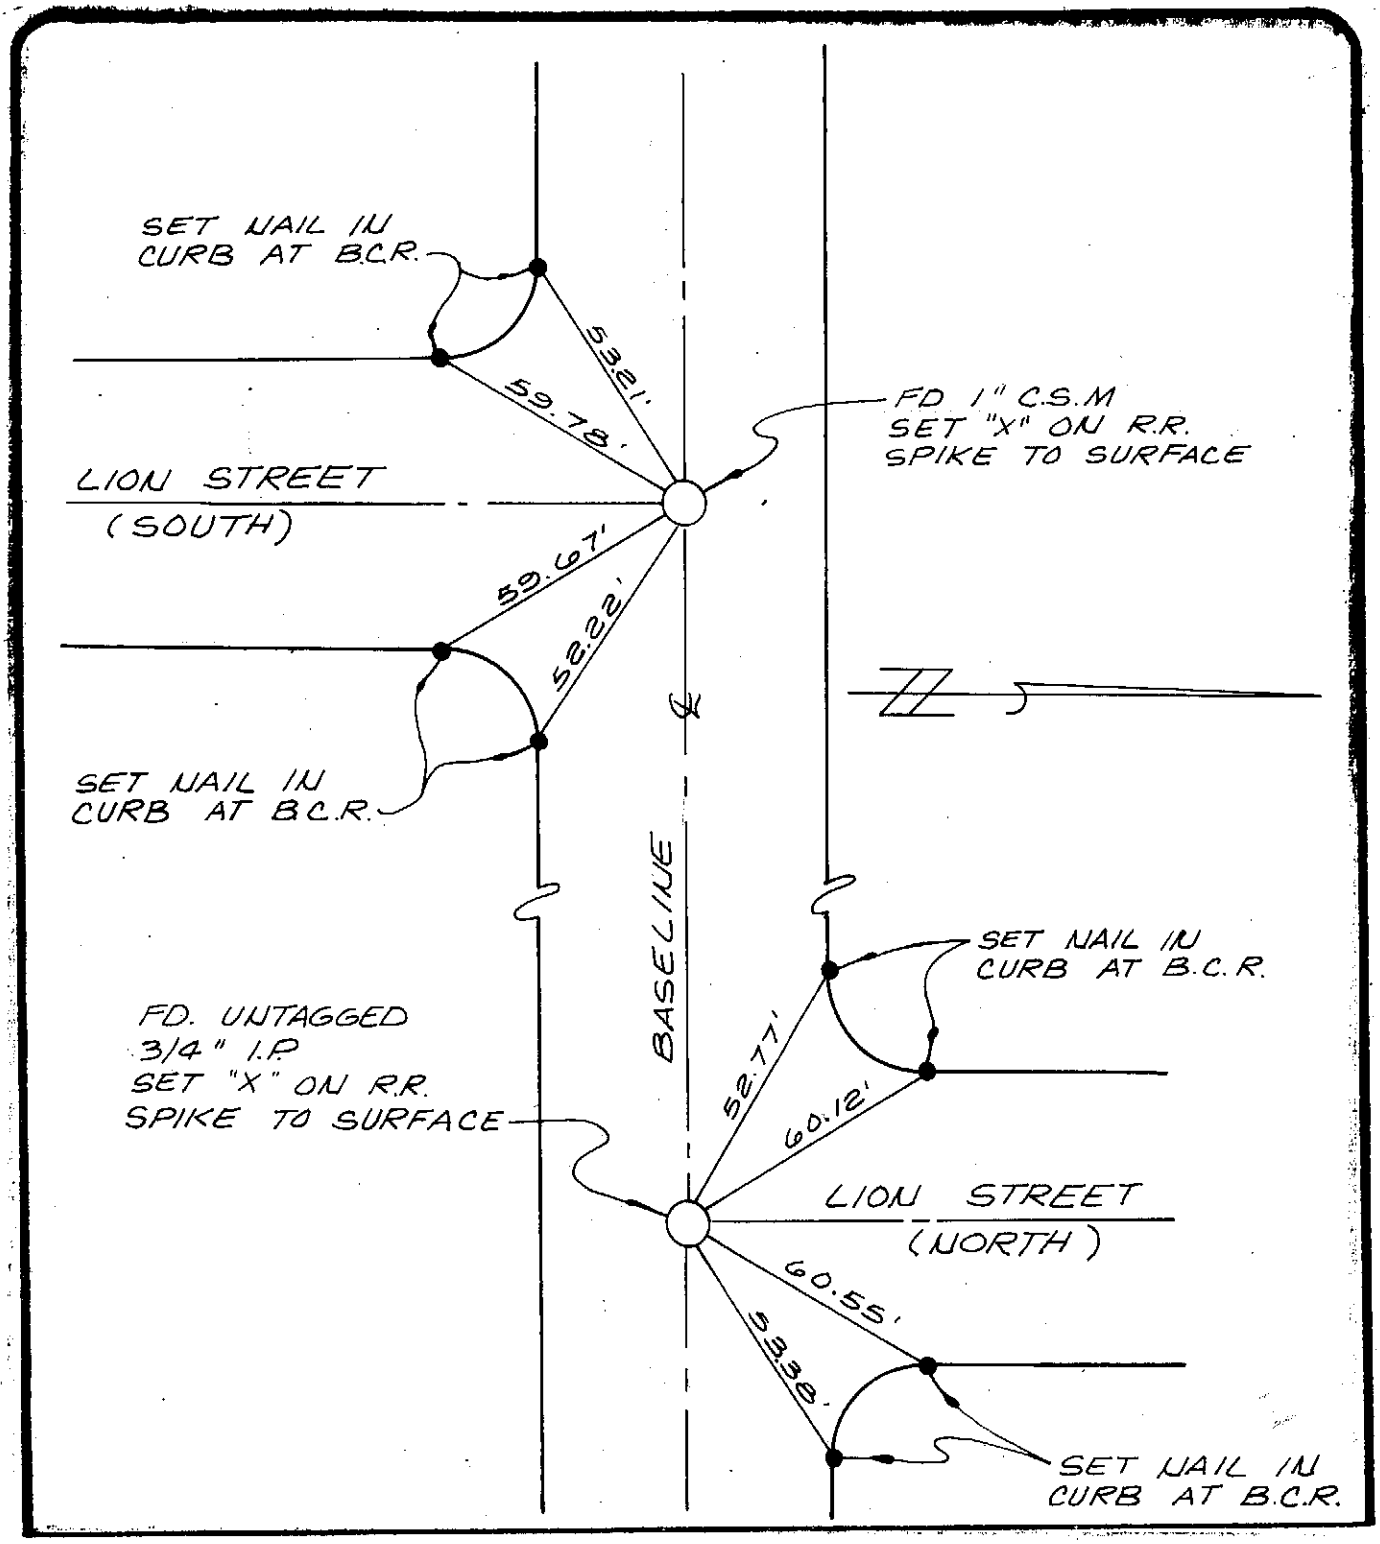

city of rancho cucamonga — STREET TIE	TRACT No.
ASSOCIATED ENGINEERS 316 EAST E STREET ONTARIO, CA. 91764 (714) 986-5818	℄ INT. LION STREET (SOUTH) AND BASELINE ℄ INT. LION STREET (NORTH) AND BASELINE
L.S. L.H. NOREEN	FIELD REVIEW _____ DATE _____
L.S. No. 3002 DATE 10/80	TIE BOOK 6 PAGE 123

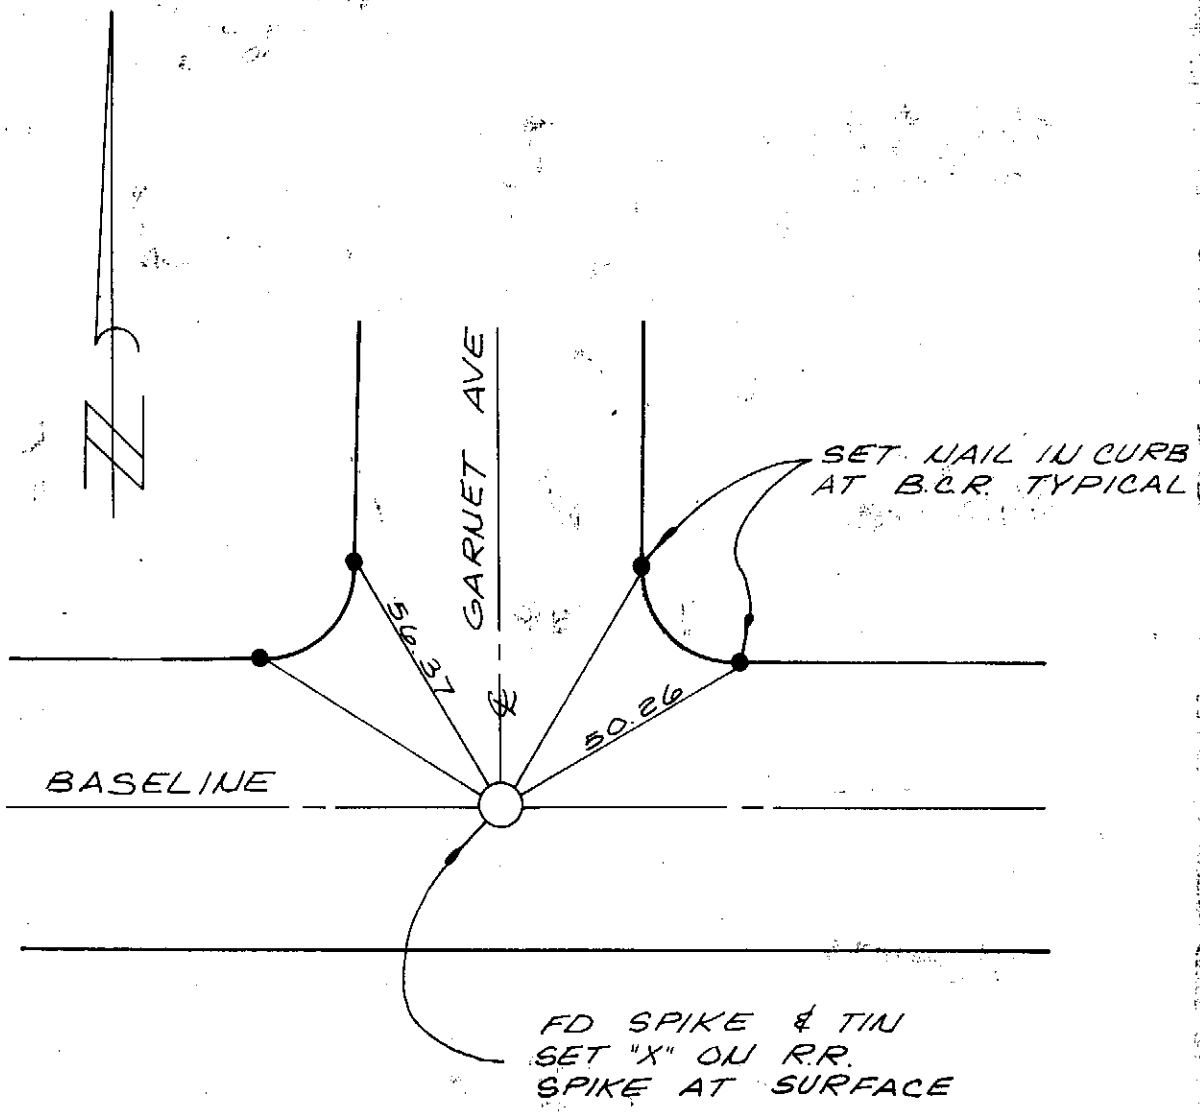

city of rancho cucamonga — STREET TIE	TRACT No.
ASSOCIATED ENGINEERS 316 EAST E STREET ONTARIO, CA. 91764 (714) 986-5818	℄ INT. GARNET AVE AND BASELINE
L.S. L.H. NOREEN	FIELD REVIEW _____ DATE _____
L.S. No. 3002 DATE 10/80	TIE BOOK 6 PAGE 129

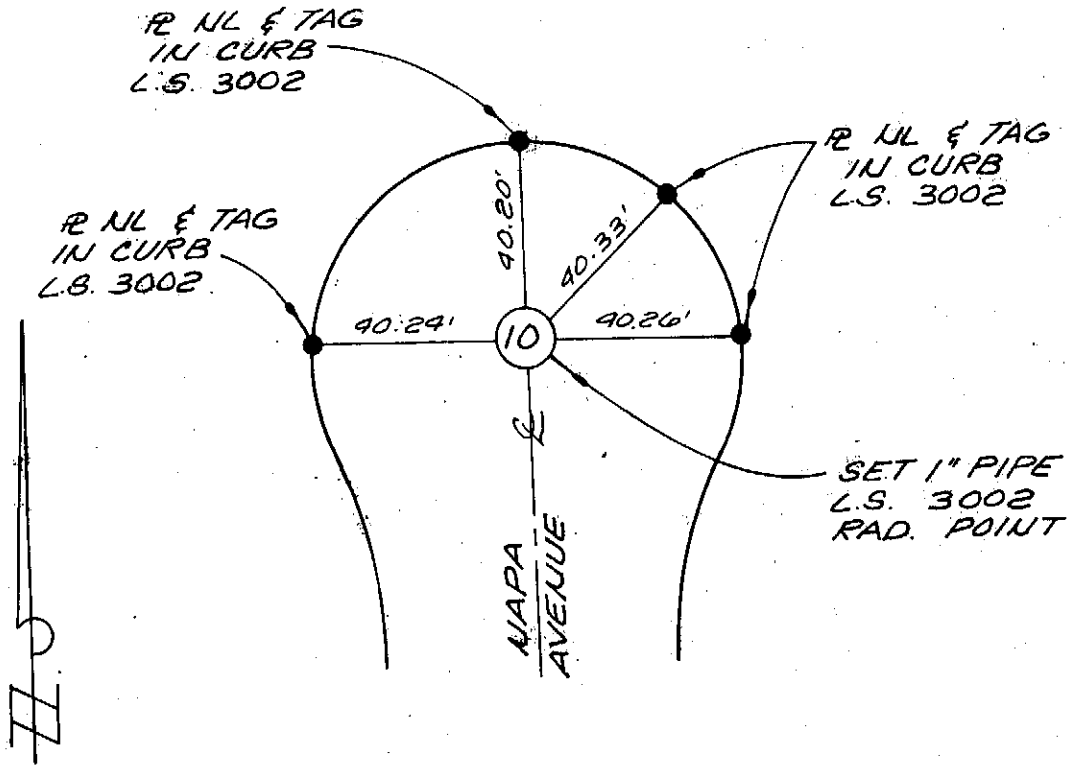

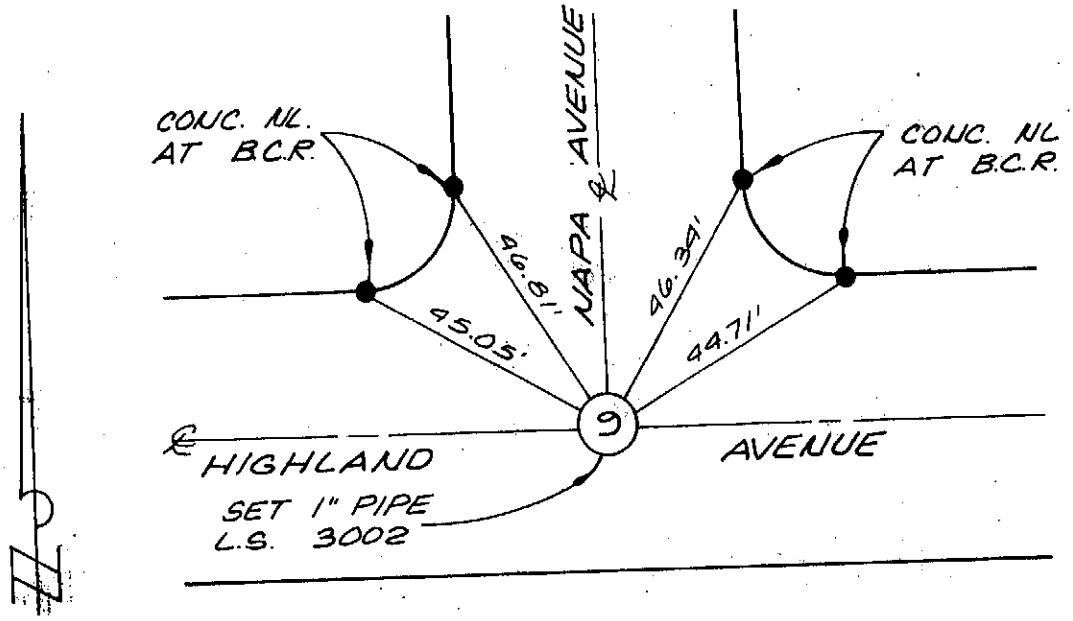

city of rancho cucamonga — STREET TIE	TRACT No. 9225
ASSOCIATED ENGINEERS 316 EAST E STREET ONTARIO, CA. 91764 (714) 986-5818	NO. 9 CENTERLINE P.I. OF NAPA AVENUE AND HIGHLAND AVENUE NO. 10 CUL-DE-SAC. RAD. POINT OF NAPA AVENUE
ENGR./L.S. L.H. NOREEN	FIELD REVIEW _____ DATE _____
R.C.E./L.S. No. 3002 DATE _____	TIE BOOK 6 PAGE 125

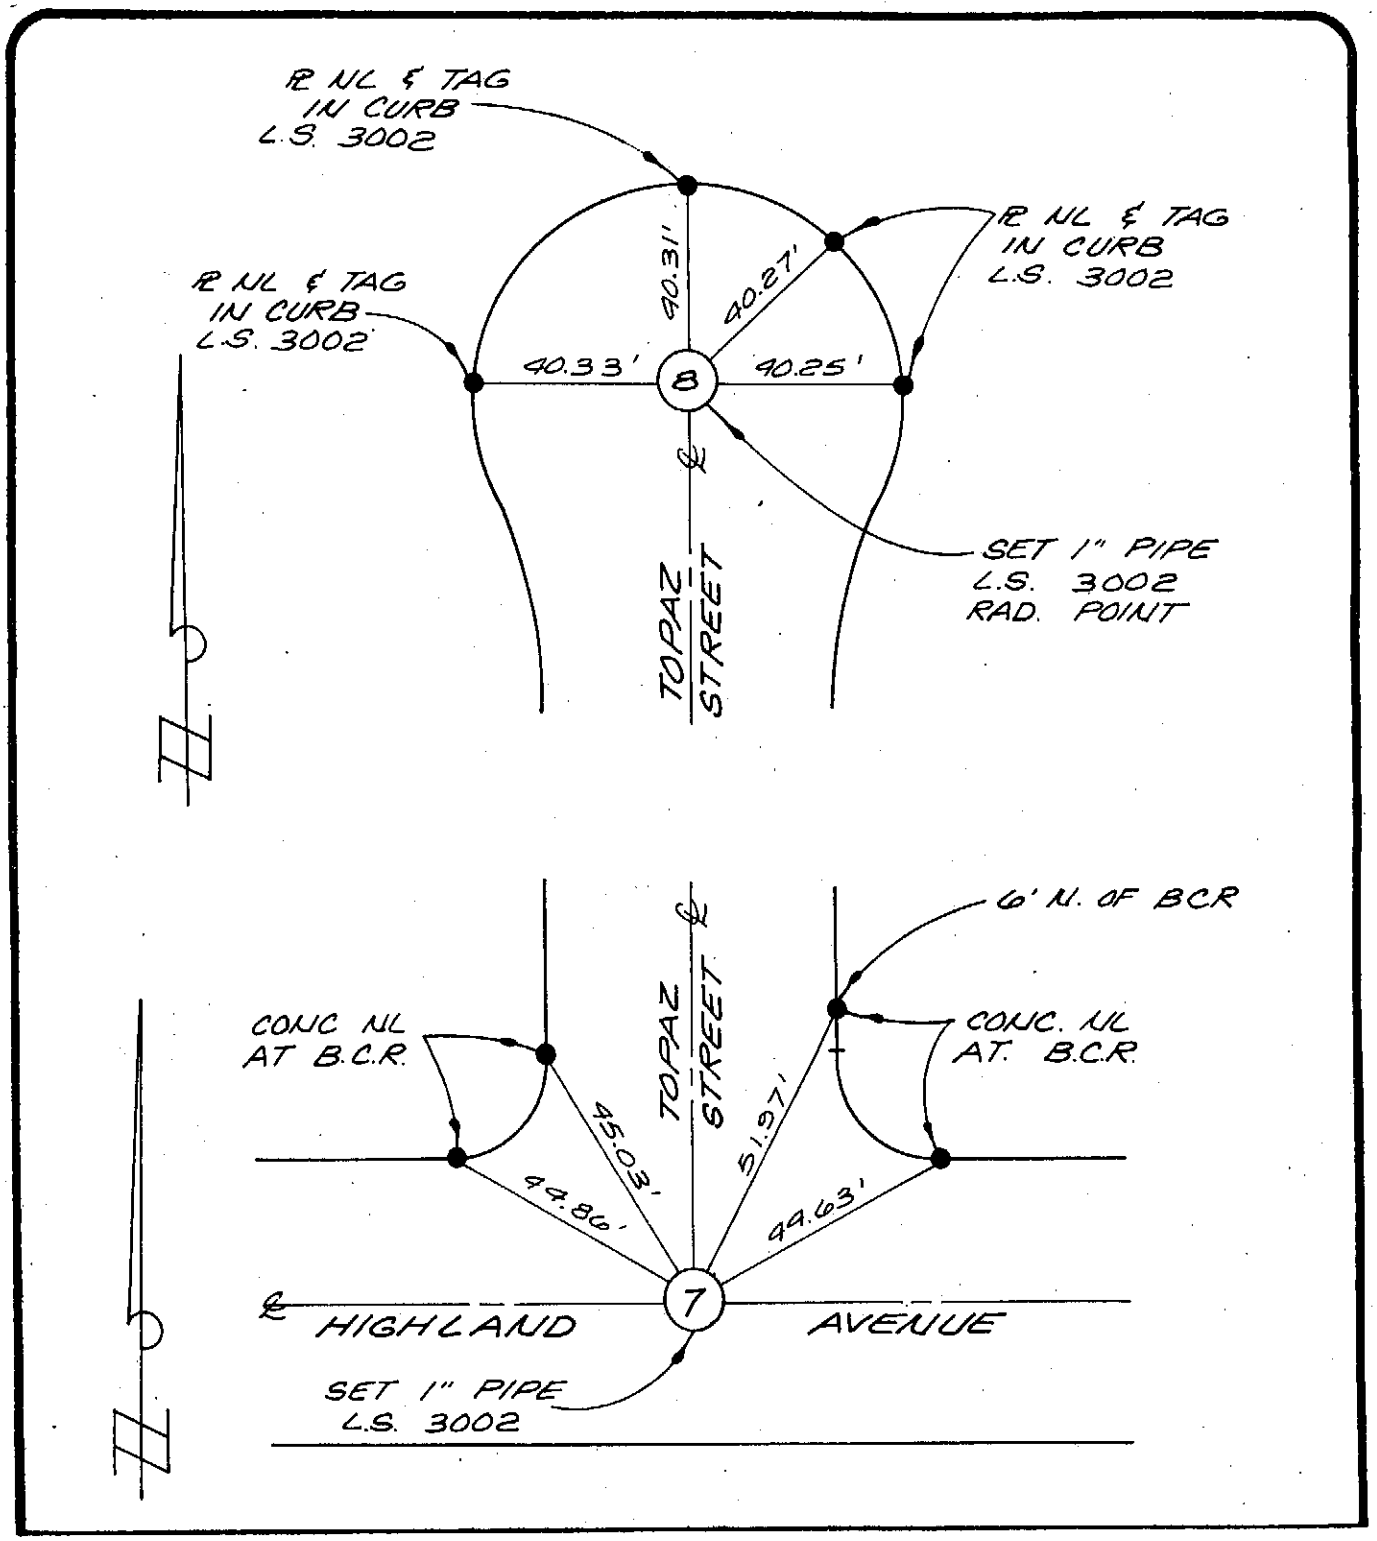

city of rancho cucamonga — STREET TIE	TRACT No. 9225
ASSOCIATED ENGINEERS 316 EAST E STREET ONTARIO, CA. 91764 (714) 986-5818	NO. 7 CENTERLINE P.I. OF TOPAZ STREET AND HIGHLAND AVE. NO. 8 CUL-DE-SAC RAD. POINT OF TOPAZ STREET.
ENGR./L.S. L.H. NOREEN	FIELD REVIEW _____ DATE _____
R.C.E./L.S. No. 3002 DATE _____	TIE BOOK 6 PAGE 126

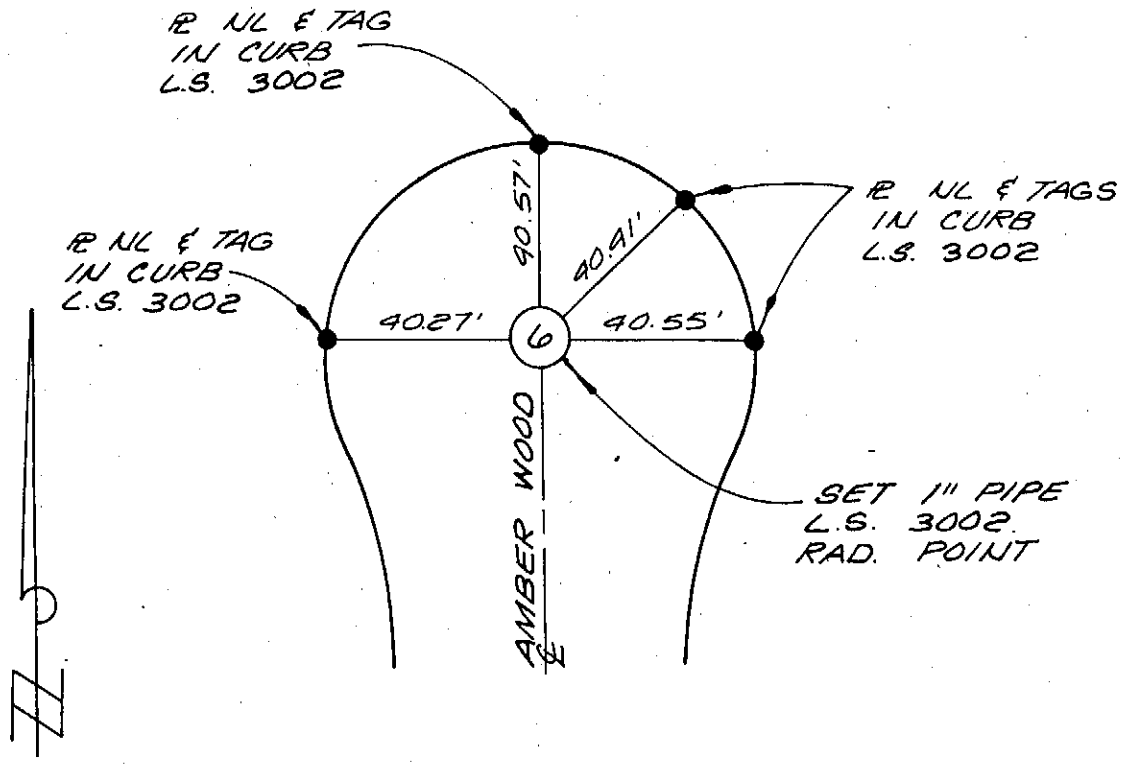

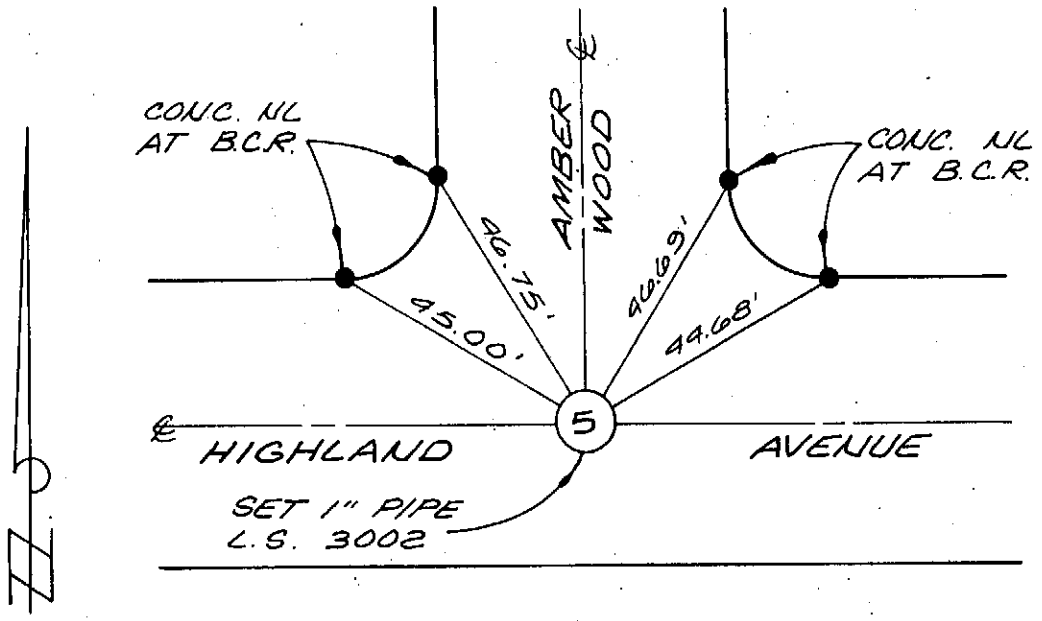

city of rancho cucamonga — STREET TIE	TRACT No. 9225
ASSOCIATED ENGINEERS 316 EAST E STREET ONTARIO, CA. 91764 (714) 986-5818	NO. 5 CENTERLINE P.I. OF AMBER WOOD AND HIGHLAND AVE. NO. 6 CUL-DE-SAC RAD. POINT OF AMBER WOOD
ENGR./L.S. L.H. NOREEN	FIELD REVIEW _____ DATE _____
R.C.E./L.S. No. 3002 DATE _____	TIE BOOK 6 PAGE 127

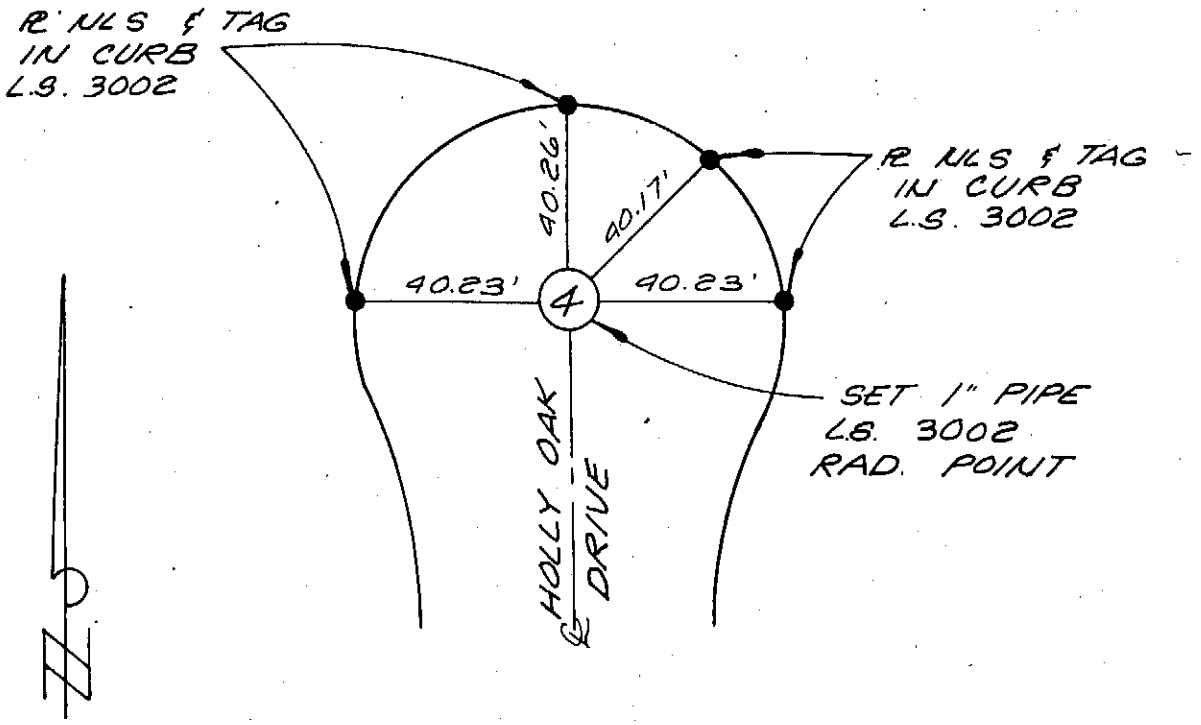

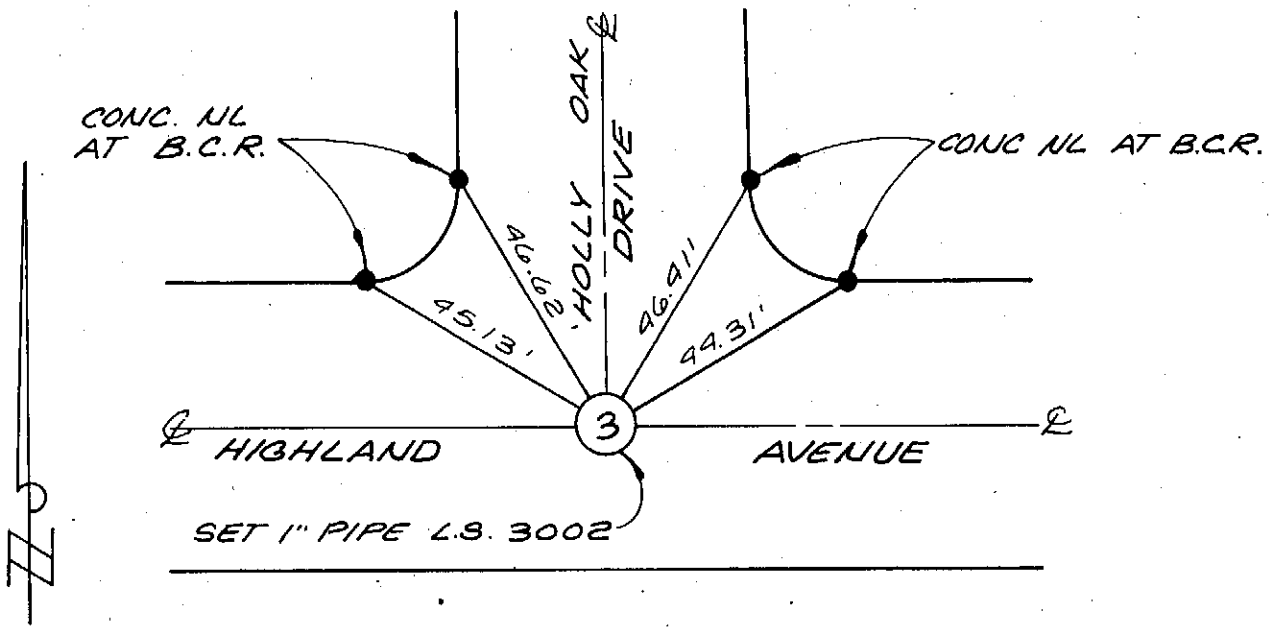

city of rancho cucamonga — STREET TIE	TRACT No. 9225
ASSOCIATED ENGINEERS 316 EAST E STREET ONTARIO, CA. 91764 (714) 986-5818	NO. 3 CENTERLINE P.I. OF HOLLY OAK DRIVE AND HIGHLAND AVE NO. 4 CUL-DE-SAC RAD. POINT OF HOLLY OAK DRIVE
ENGR./L.S. L.H. NOREEN	FIELD REVIEW _____ DATE _____
R.C.E./L.S. No. 3002 DATE _____	TIE BOOK 6 PAGE 128

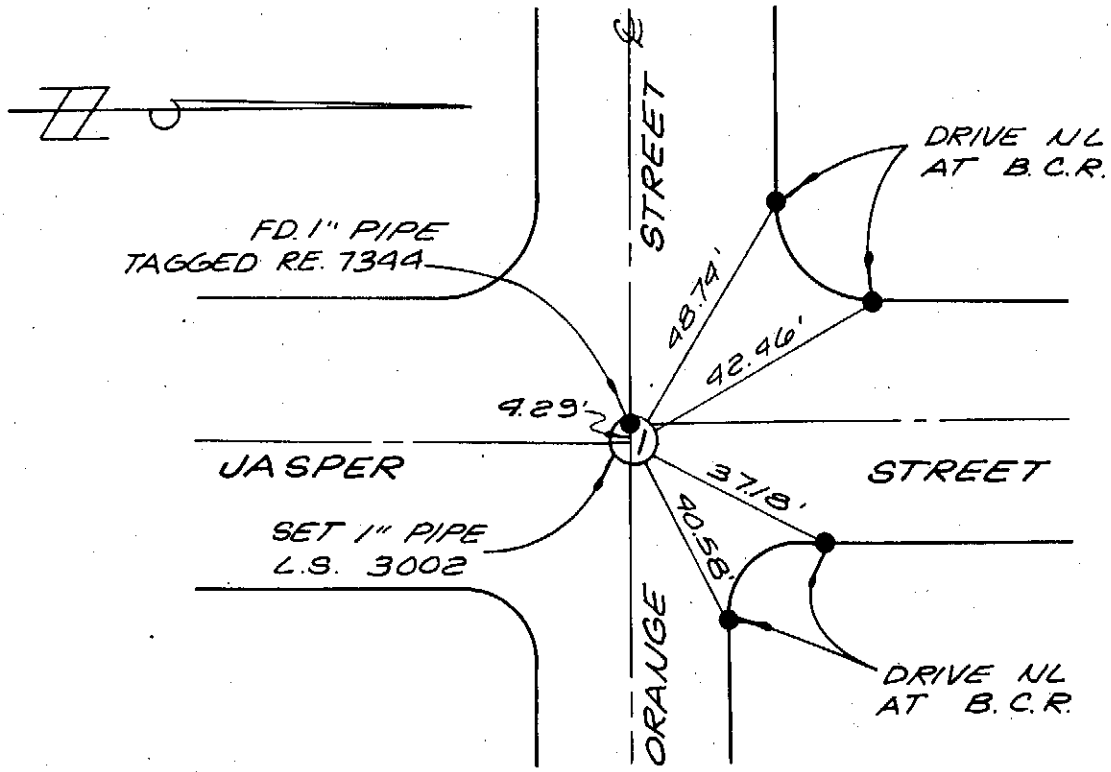

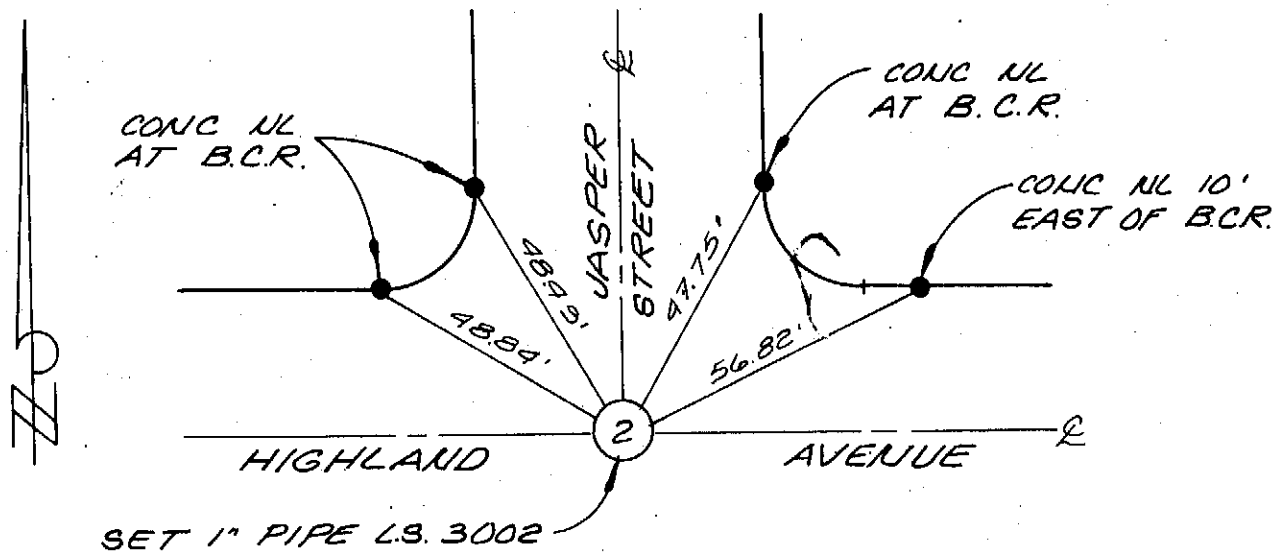

city of rancho cucamonga — STREET TIE	TRACT No. 9225
ASSOCIATED ENGINEERS 316 EAST E STREET ONTARIO, CA. 91764 (714) 986-5818	NO. 1, CENTERLINE P.I. OF JASPER ST. AND ORANGE ST. NO. 2 CENTERLINE P.I. OF JASPER ST. AND HIGHLAND AVE.
ENGR./L.S. L.H. NOREEN	FIELD REVIEW _____ DATE _____
R.C.E./L.S. No. 3002 DATE _____	TIE BOOK 6 PAGE 129

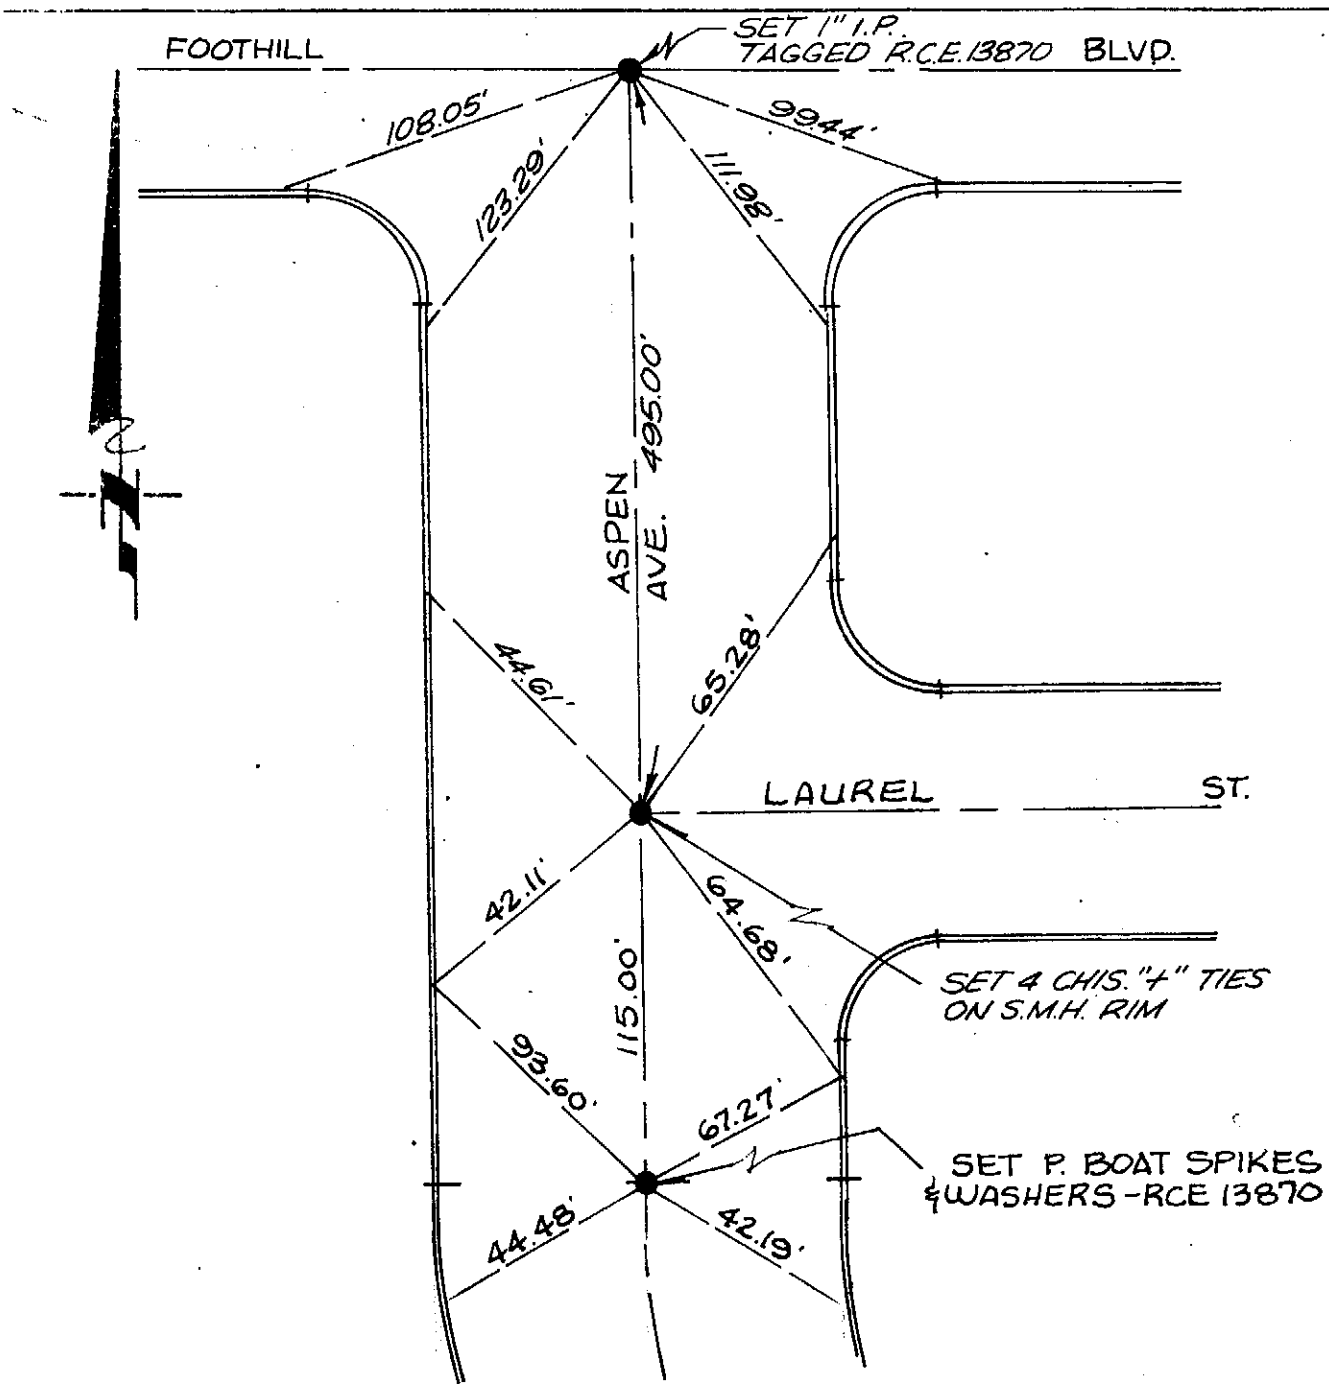

NOTE :
ALL TIE POINTS ARE RAMSET NAILS
ON TOP OF CURB ~ UNLESS OTHERWISE NOTED

CITY OF RANCHO CUCAMONGA — STREET TIES	PARCEL MAP NO. 6725
LDKING L.D. KING, INC. 517 N. EUCLID AVENUE ONTARIO, CALIF. (714) 988-5492	Aspen ~~ALDER~~ AVE. AT LAUREL ST.
ENGR. [signature]	FIELD REVIEW _____ DATE _____
R.C.E. NO. 13870 DATE 5-28-87	TIE BOOK 6 PAGE 130

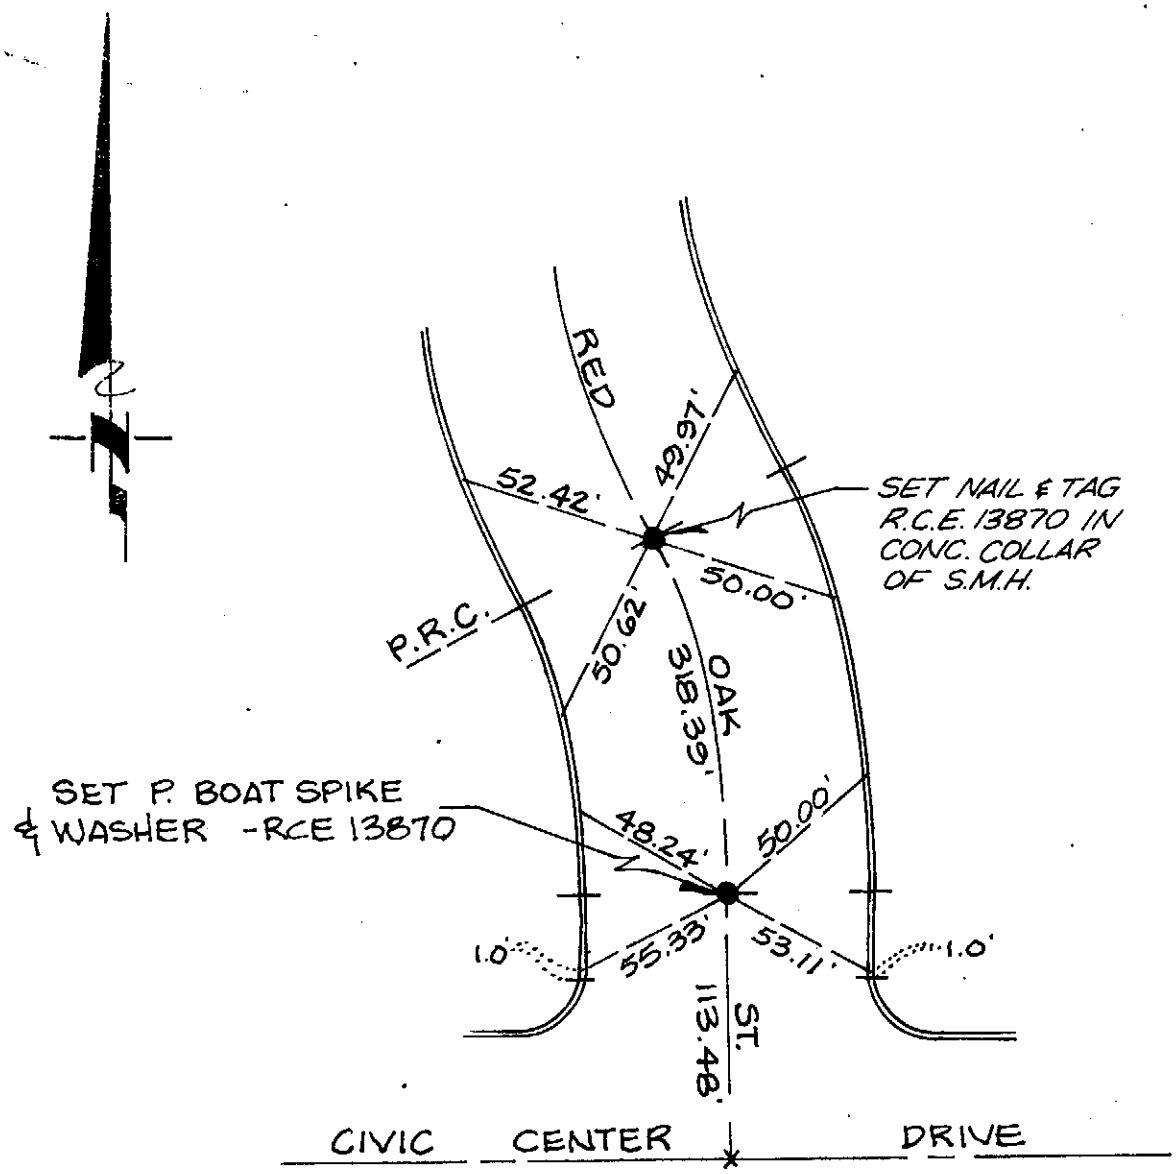

NOTE :
ALL TIE POINTS ARE RAMSET NAILS
ON TOP OF CURB ~ UNLESS OTHERWISE NOTED

CITY OF RANCHO CUCAMONGA — STREET TIES	PARCEL MAP NO. 6725
LDKING L.D. KING, INC. 517 N. EUCLID AVENUE ONTARIO, CALIF. (714) 988-5492	**RED OAK ST. NEAR CIVIC CENTER DR.**
ENGR: John Leonard	FIELD REVIEW _____ DATE _____
R.C.E. NO. 13870 DATE 5-28-87	TIE BOOK 6 PAGE 131

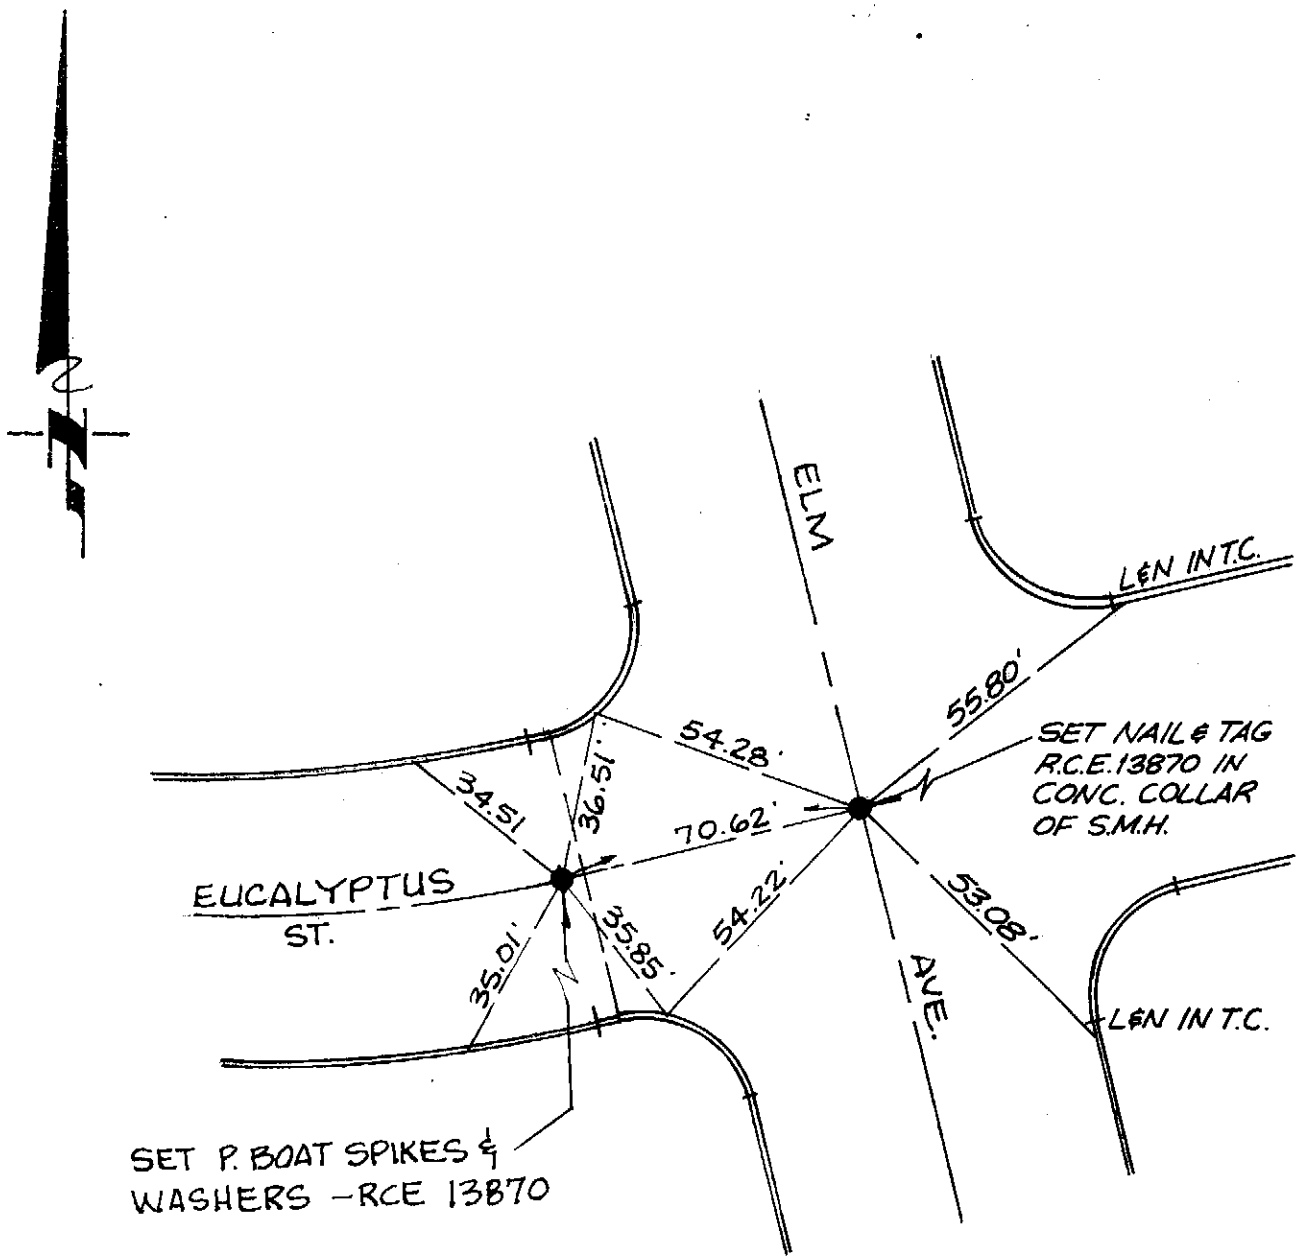

NOTE :

- ALL TIE POINTS ARE RAMSET NAILS ON TOP OF CURB ~ UNLESS OTHERWISE NOTED

CITY OF RANCHO CUCAMONGA — STREET TIES	PARCEL MAP NO. 6725
LDKING L.D. KING, INC. 517 N. EUCLID AVENUE ONTARIO, CALIF. (714) 988-5492	**EUCALYPTUS ST. AT ELM AVE.**
ENGR. [signature]	FIELD REVIEW _____ DATE _____
R.C.E. NO. 13870 DATE 5-28-87	TIE BOOK 6 PAGE 132

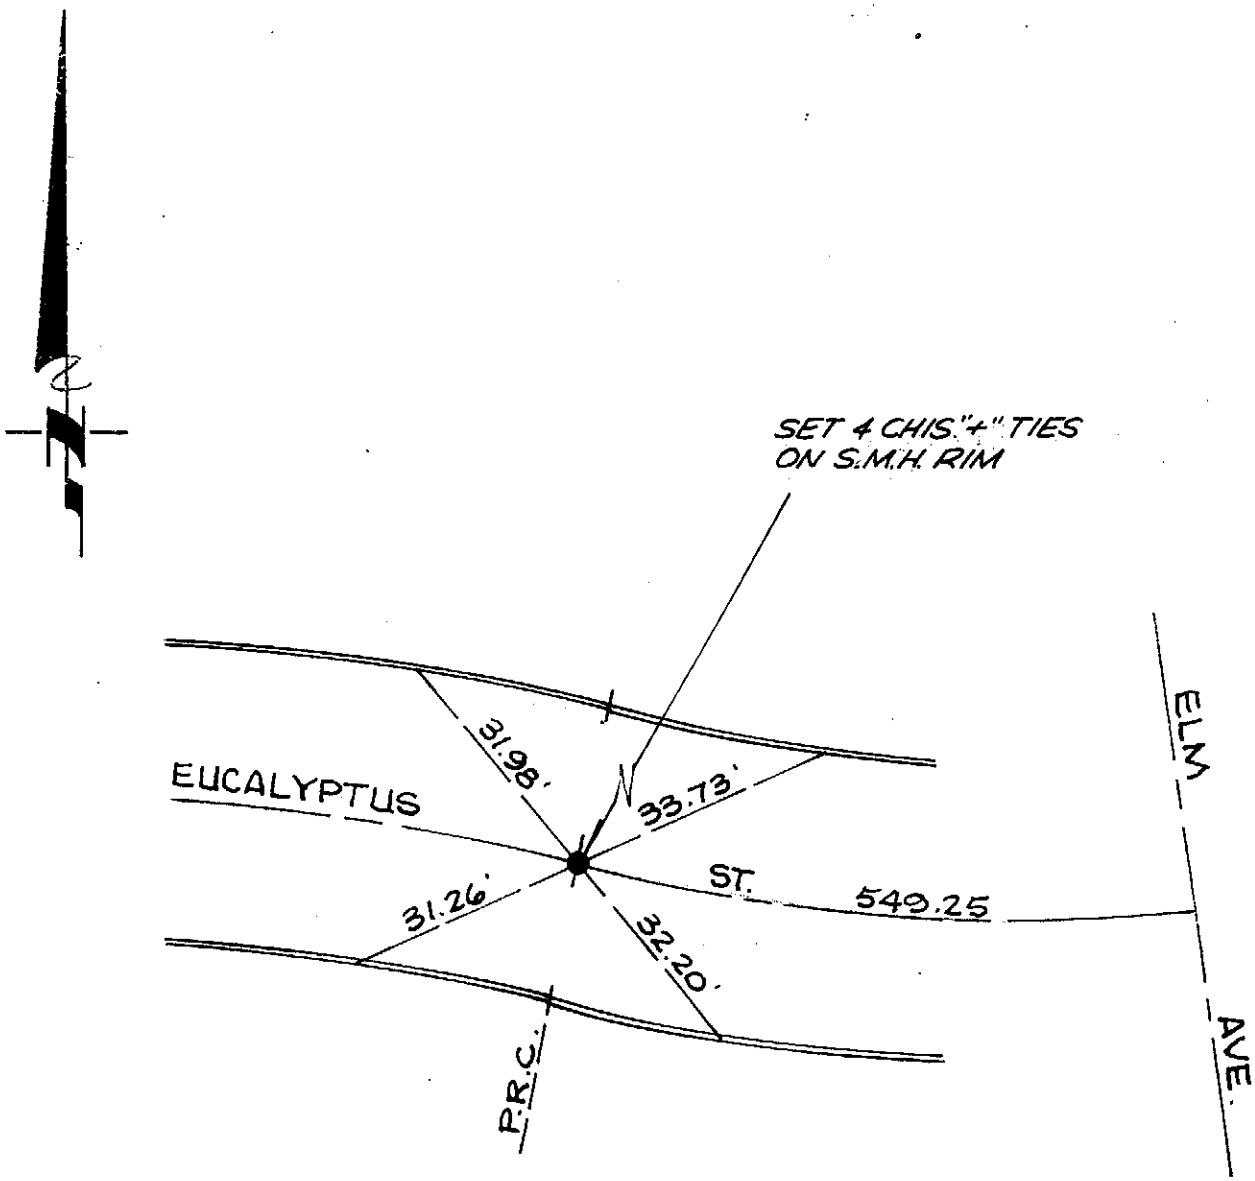

NOTE :

- ALL TIE POINTS ARE RAMSET NAILS ON TOP OF CURB ~ UNLESS OTHERWISE NOTED

CITY OF RANCHO CUCAMONGA — STREET TIES	PARCEL MAP NO. 6725
LDKING L.D. KING, INC. 517 N. EUCLID AVENUE ONTARIO, CALIF. (714) 988-5492	**EUCALYPTUS ST. NEAR ELM AVE.**
ENGR. [signature]	FIELD REVIEW _____ DATE _____
R.C.E. NO. 13870 DATE 5-28-87	TIE BOOK 6 PAGE 133

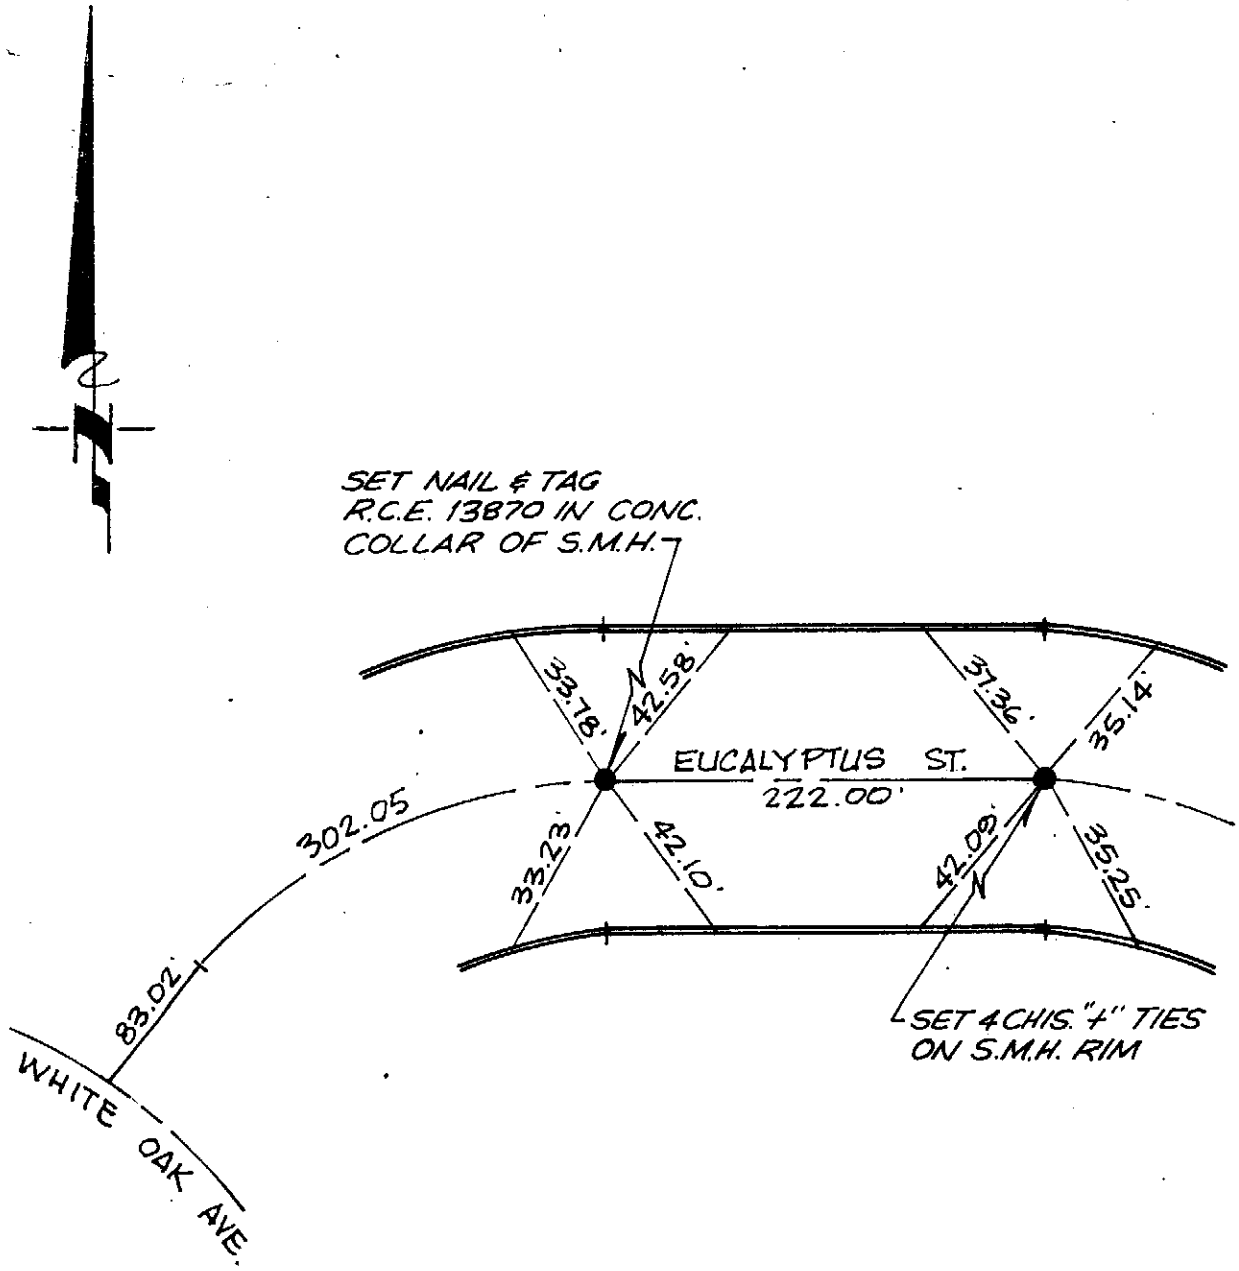

NOTE :
ALL TIE POINTS ARE RAMSET NAILS
ON TOP OF CURB ~ UNLESS OTHERWISE NOTED

CITY OF RANCHO CUCAMONGA — STREET TIES	PARCEL MAP NO. 6725
LDKING L.D. KING, INC. 517 N. EUCLID AVENUE ONTARIO, CALIF. (714) 988-5492	**EUCALYPTUS ST. NEAR WHITE OAK AVE.**
ENGR.	FIELD REVIEW _____ DATE _____
R.C.E. NO. 13870 DATE 5-28-87	TIE BOOK 6 PAGE 134

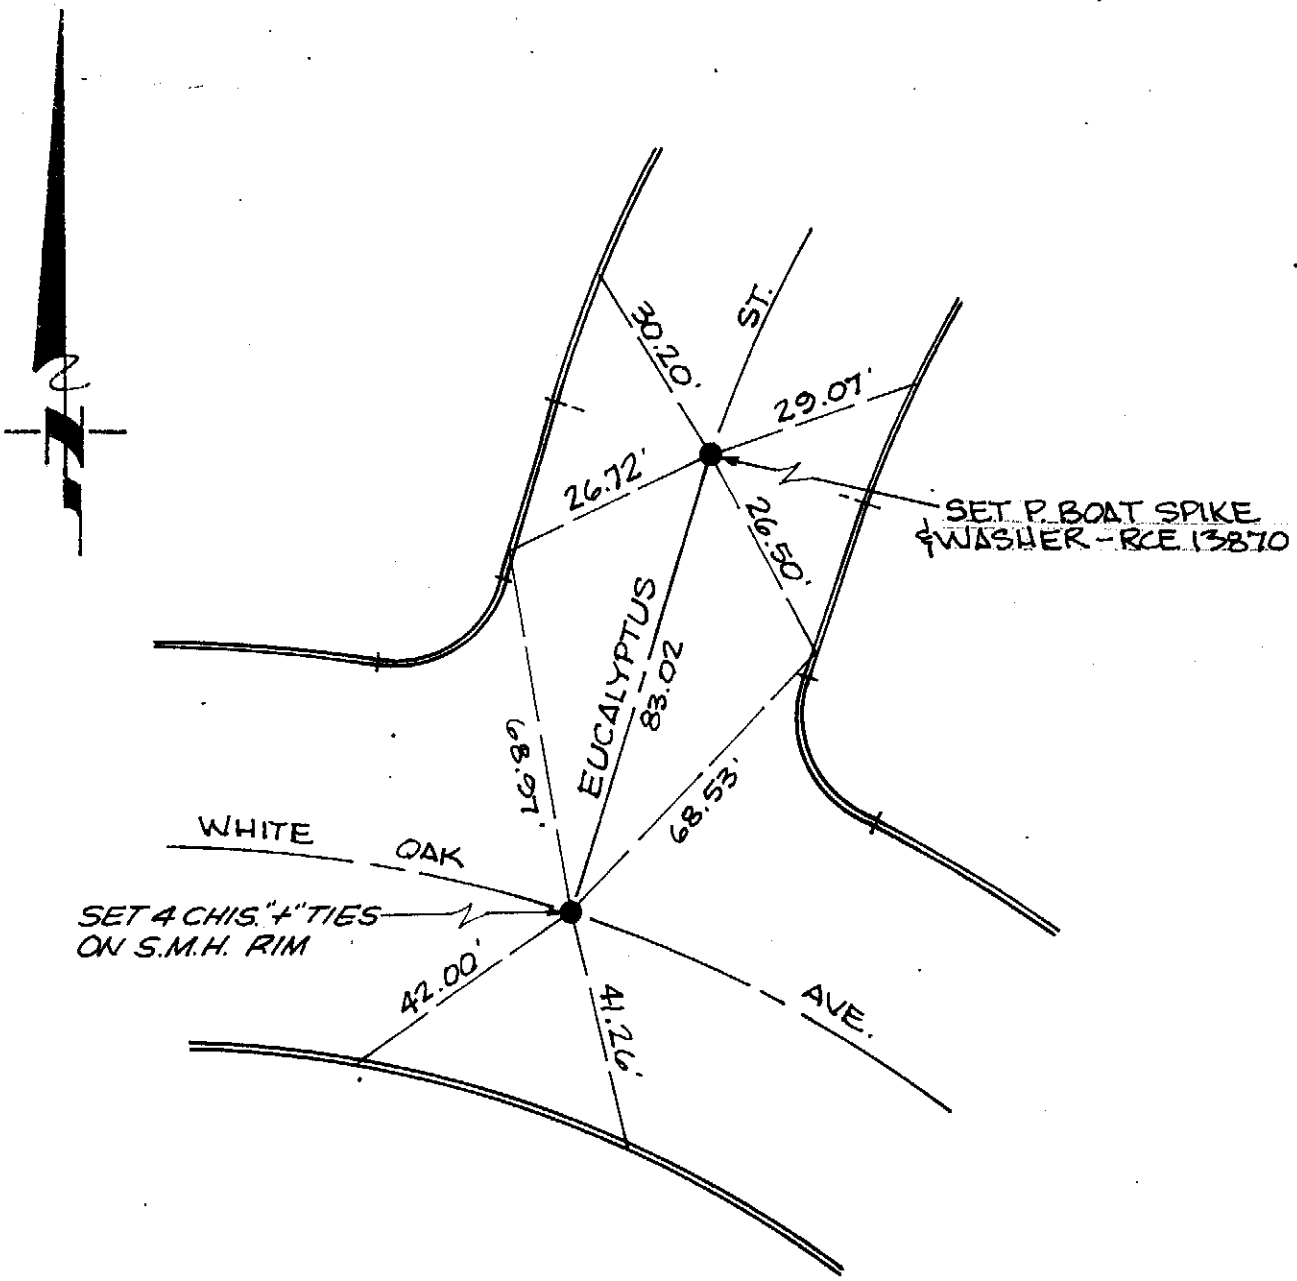

NOTE :
ALL TIE POINTS ARE RAMSET NAILS
ON TOP OF CURB ~ UNLESS OTHERWISE NOTED

CITY OF RANCHO CUCAMONGA — STREET TIES	PARCEL MAP NO. 6725
LDKING L.D. KING, INC. 517 N. EUCLID AVENUE ONTARIO, CALIF. (714) 988-5492	**EUCALYPTUS ST. AT WHITE OAK AVE.**
ENGR. [signature]	FIELD REVIEW _____ DATE _____
R.C.E. NO. 13870 DATE 5-28-87	TIE BOOK 6 PAGE 135

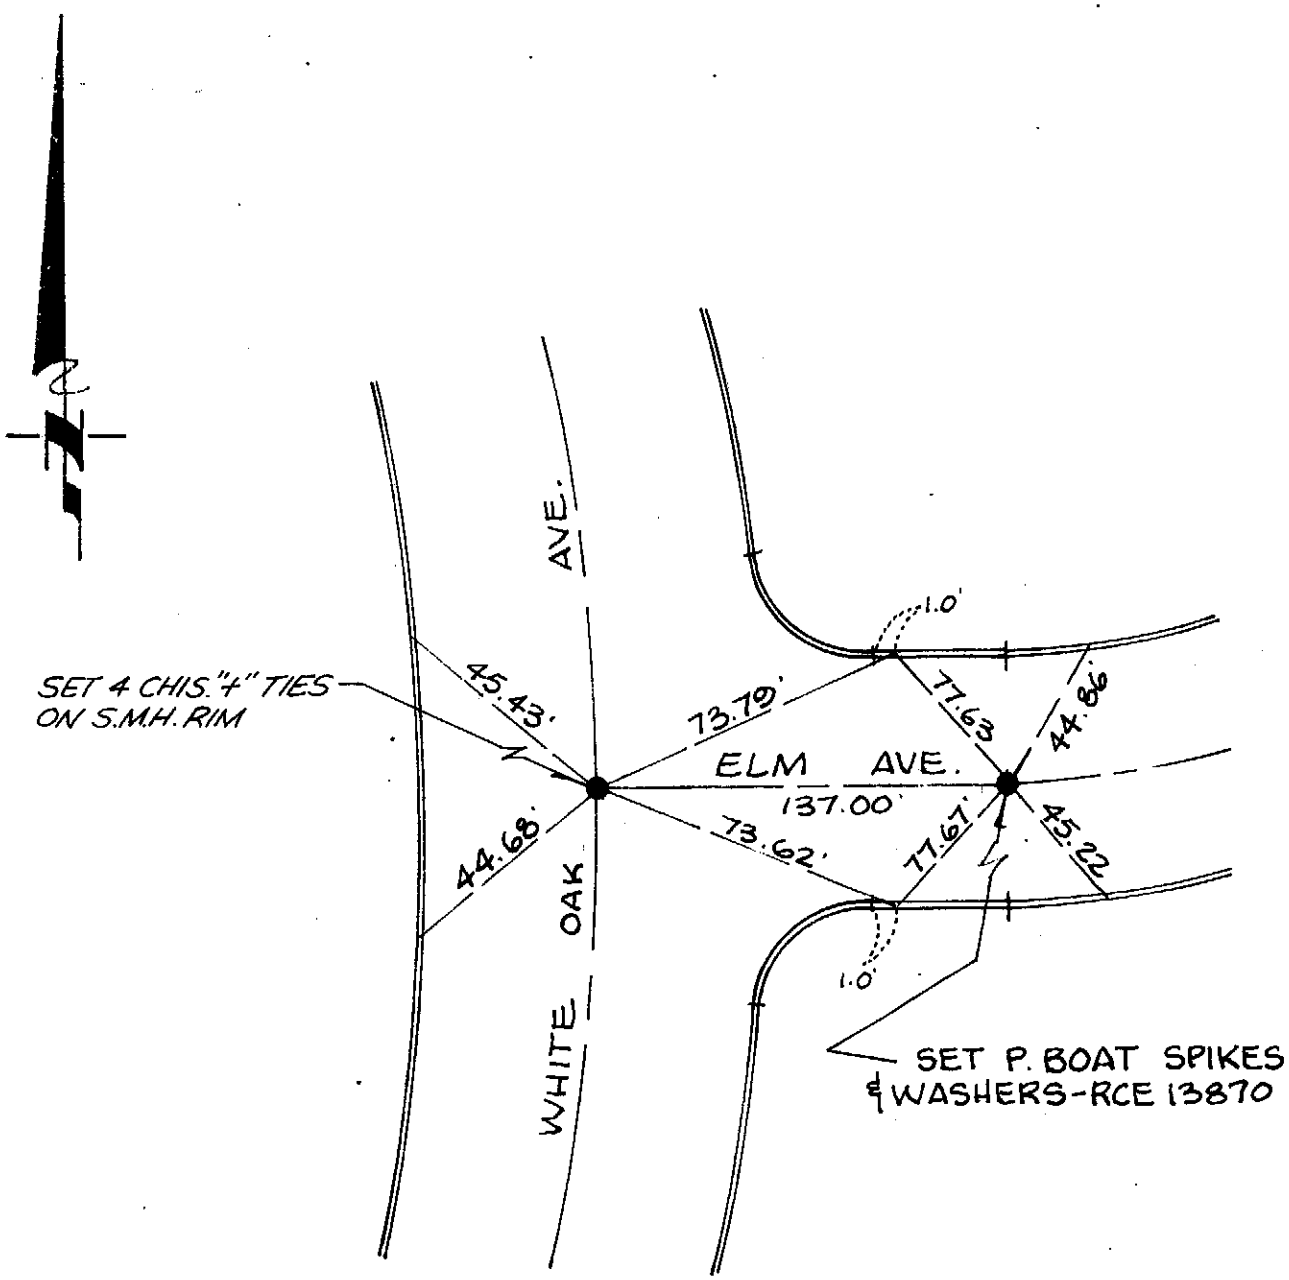

NOTE :
ALL TIE POINTS ARE RAMSET NAILS
ON TOP OF CURB ~ UNLESS OTHERWISE NOTED

CITY OF RANCHO CUCAMONGA — STREET TIES	PARCEL MAP NO. 6725
LDKING L.D. KING, INC. 517 N. EUCLID AVENUE ONTARIO, CALIF. (714) 988-5492	**ELM AVE. AT WHITE OAK AVE.**
ENGR	FIELD REVIEW _____ DATE _____
R.C.E. NO. 13870 DATE 5-28-87	TIE BOOK 6 PAGE 136

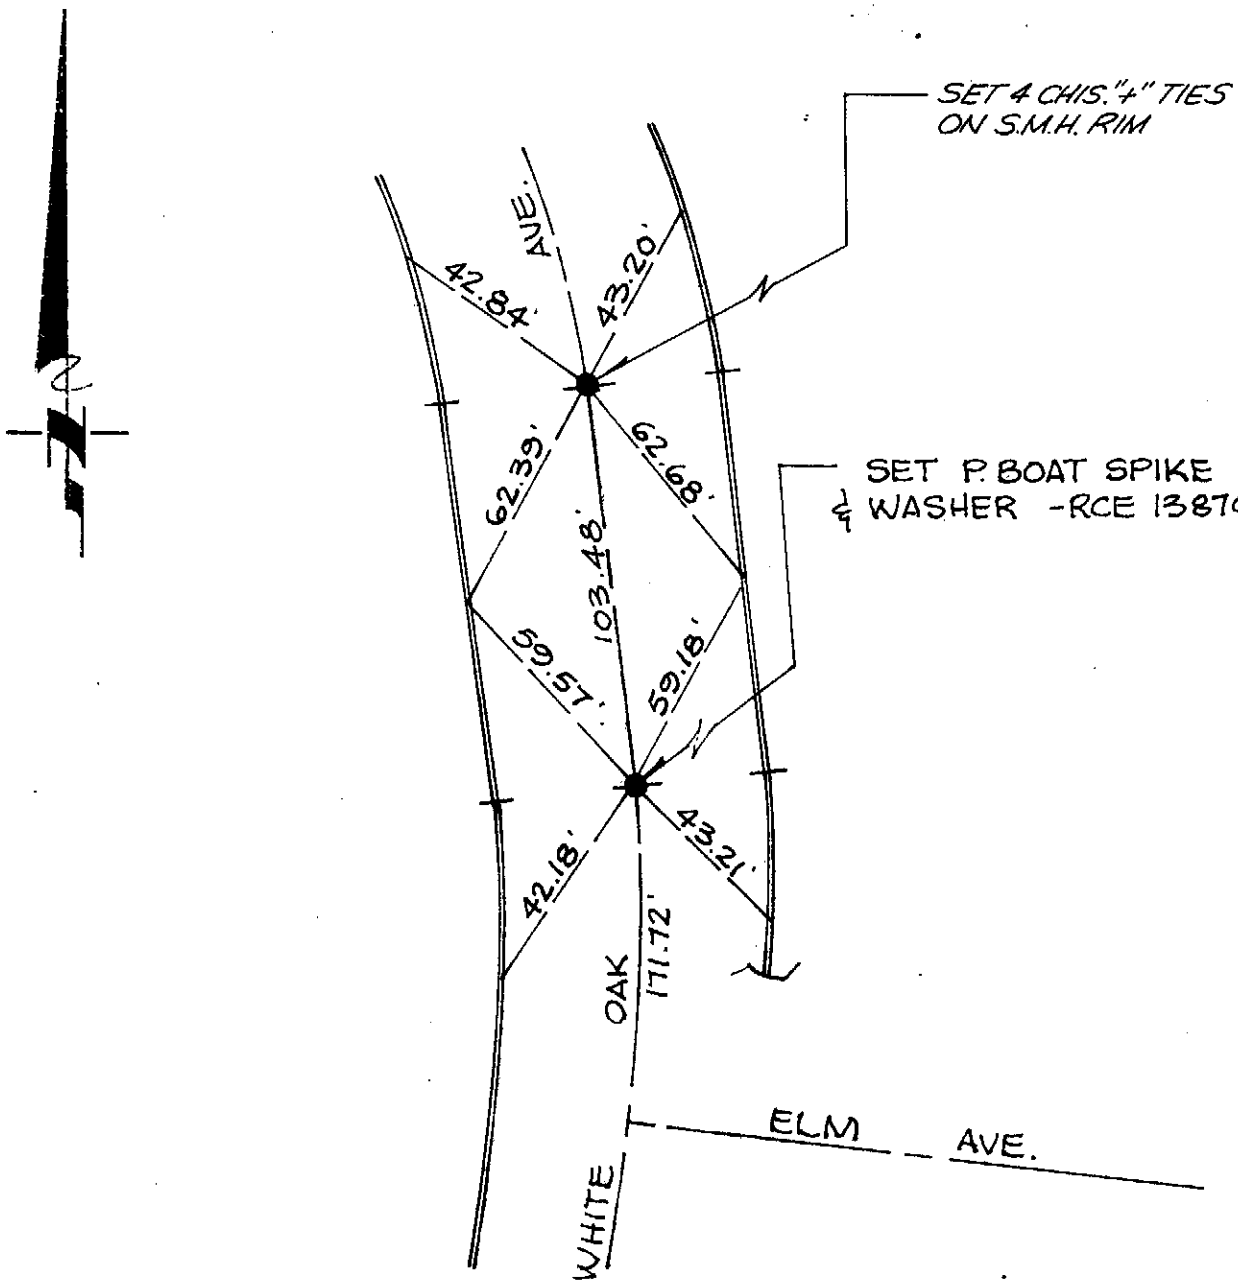

NOTE :

- ALL TIE POINTS ARE RAMSET NAILS ON TOP OF CURB ~ UNLESS OTHERWISE NOTED

CITY OF RANCHO CUCAMONGA — STREET TIES	PARCEL MAP NO. 6725
LDKING L.D. KING, INC. 517 N. EUCLID AVENUE ONTARIO, CALIF. (714) 988-5492	**WHITE OAK AVE. NEAR ELM AVE.**
ENGR.	FIELD REVIEW _____ DATE _____
R.C.E. NO. 13870 DATE 5-28-87	TIE BOOK 6 PAGE 137

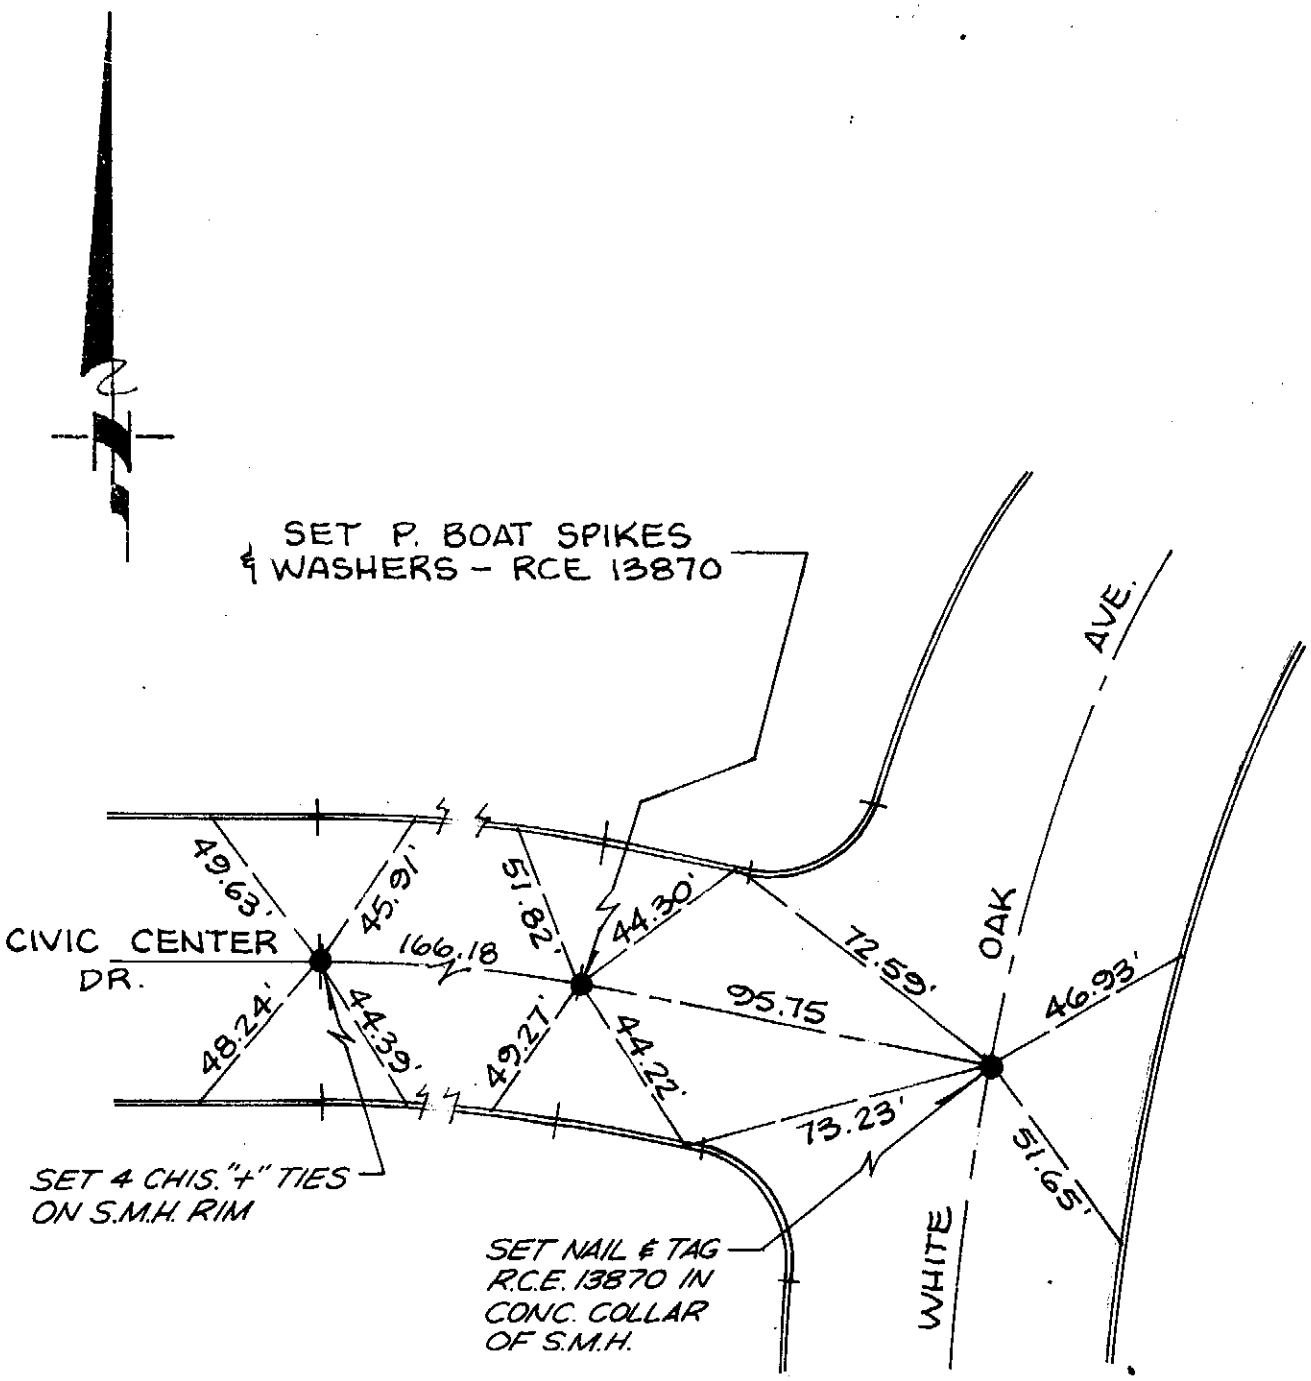

NOTE :

- ALL TIE POINTS ARE RAMSET NAILS ON TOP OF CURB ~ UNLESS OTHERWISE NOTED

CITY OF RANCHO CUCAMONGA — STREET TIES	PARCEL MAP NO. 6725
LDKING L.D. KING, INC. 517 N. EUCLID AVENUE ONTARIO, CALIF. (714) 988-5492	**CIVIC CENTER DR. NEAR AND AT WHITE OAK AVE.**
ENGR. [signature]	FIELD REVIEW _____ DATE _____
R.C.E. NO. 13870 DATE 5-28-87	TIE BOOK 6 PAGE 138

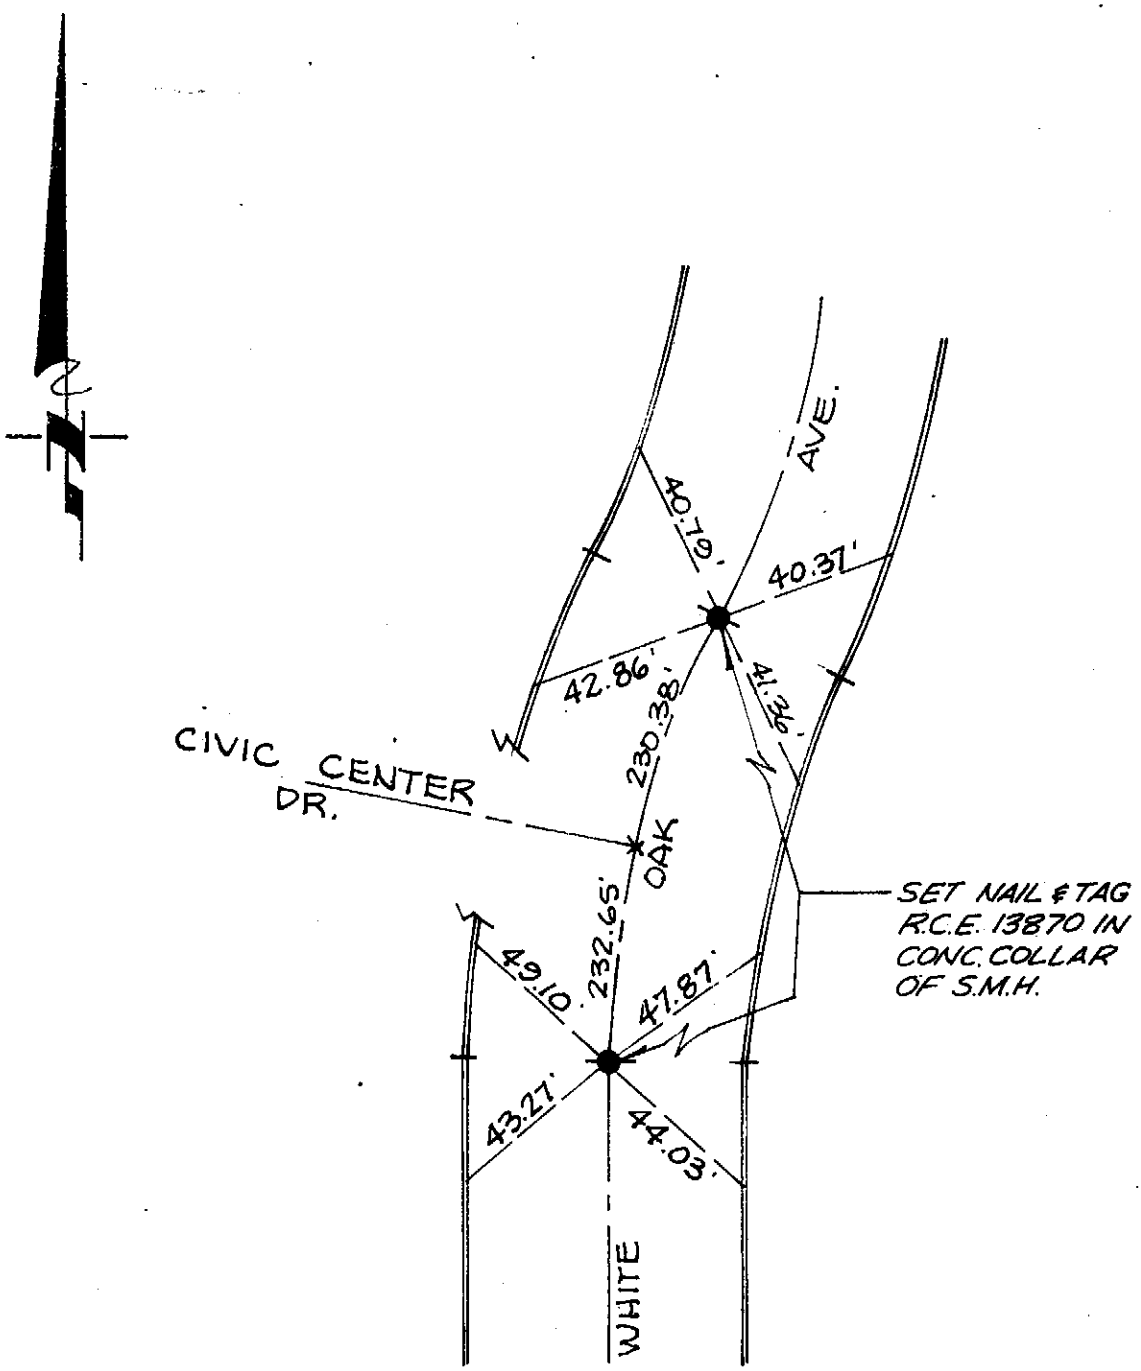

NOTE :
ALL TIE POINTS ARE RAMSET NAILS ON TOP OF CURB ~ UNLESS OTHERWISE NOTED

CITY OF RANCHO CUCAMONGA — STREET TIES	PARCEL MAP NO. 6725
LDKING L.D. KING, INC. 517 N. EUCLID AVENUE ONTARIO, CALIF. (714) 988-5492	**WHITE OAK AVE. NEAR CIVIC CENTER DR.**
ENGR. [signature]	FIELD REVIEW _____ DATE _____
R.C.E. NO. 13870 DATE 5-28-87	TIE BOOK 6 PAGE 139

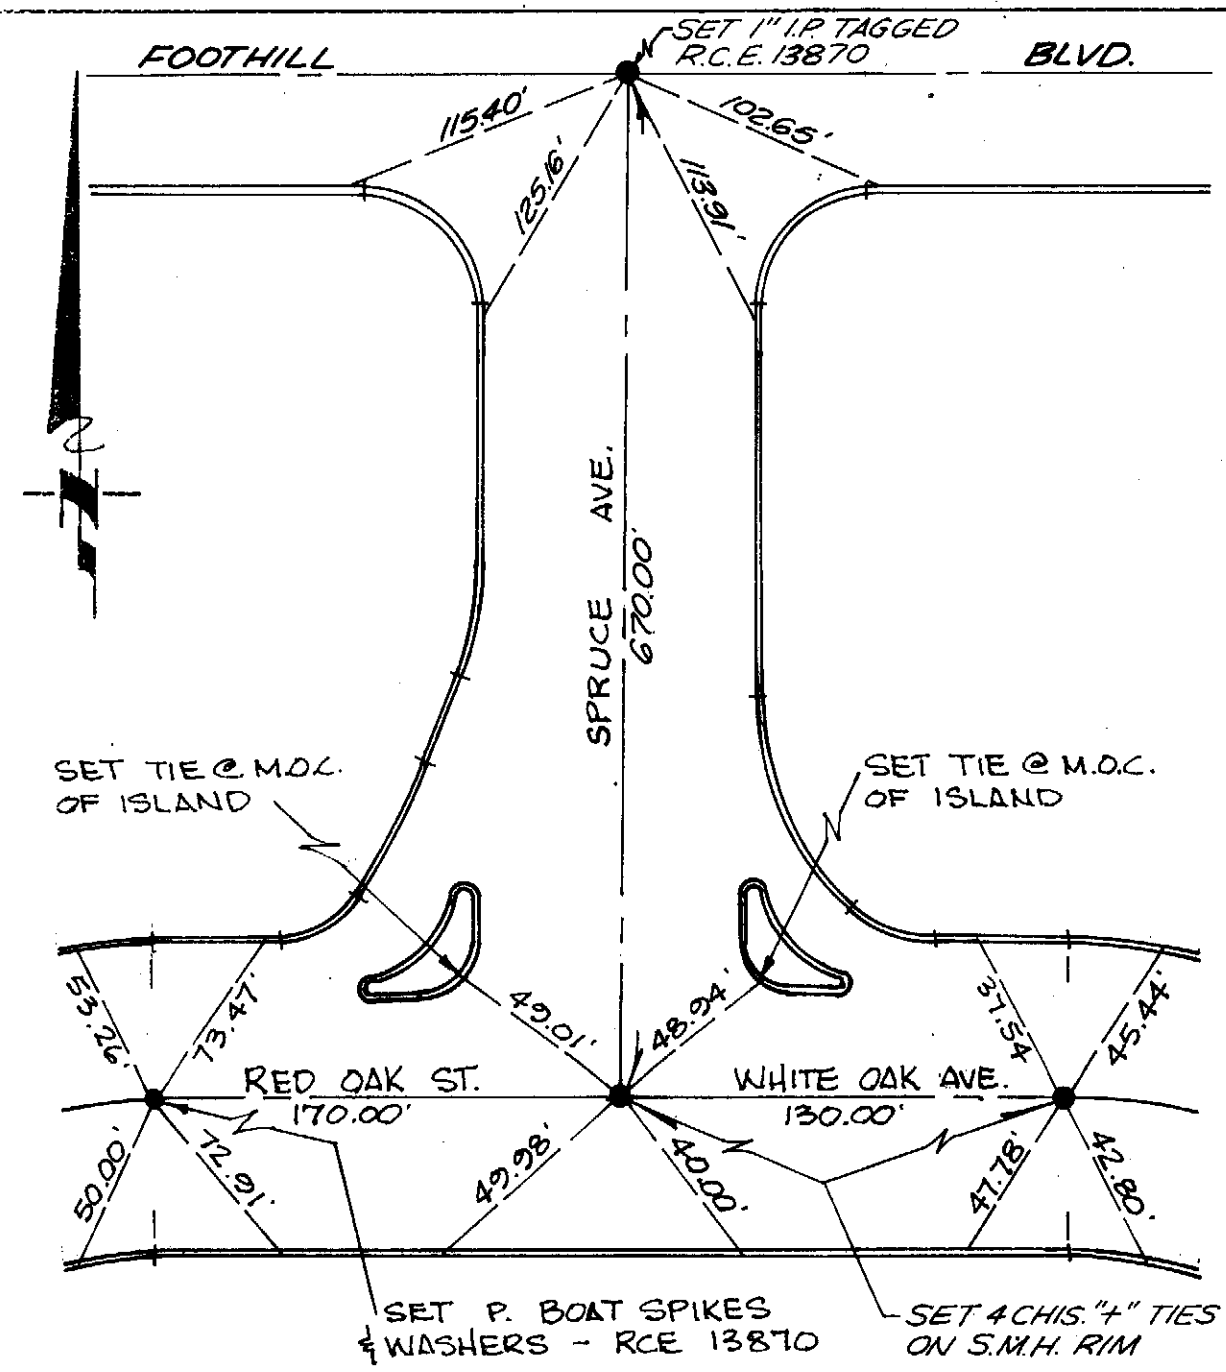

NOTE :

ALL TIE POINTS ARE RAMSET NAILS ON TOP OF CURB ~ UNLESS OTHERWISE NOTED

CITY OF RANCHO CUCAMONGA — STREET TIES	PARCEL MAP NO. 6725
LDKING L.D. KING, INC. 517 N. EUCLID AVENUE ONTARIO, CALIF. (714) 988-5492	**SPRUCE AVE. AT RED OAK ST. AND WHITE OAK AVE.**
ENGR. [signature]	FIELD REVIEW _____ DATE _____
R.C.E. NO. 13870 DATE 5-28-87	TIE BOOK 6 PAGE 190

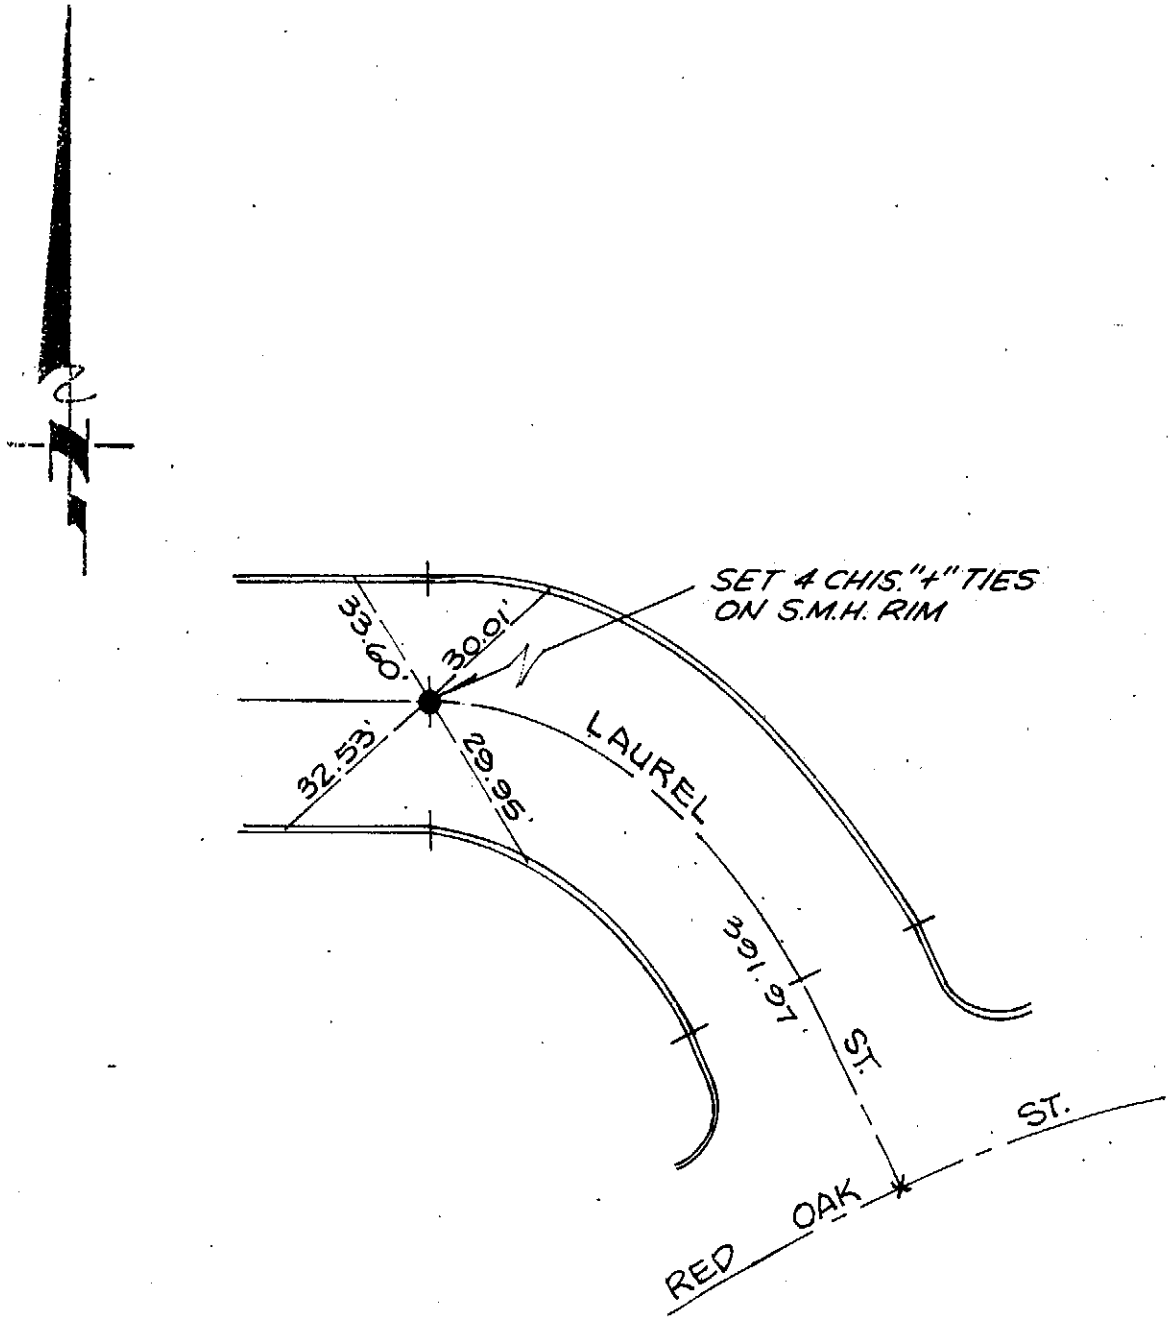

NOTE :
ALL TIE POINTS ARE RAMSET NAILS
ON TOP OF CURB ~ UNLESS OTHERWISE NOTED

CITY OF RANCHO CUCAMONGA — STREET TIES	PARCEL MAP NO. 6725
LDKING L.D. KING, INC. 517 N. EUCLID AVENUE ONTARIO, CALIF. (714) 986-5492	**LAUREL ST. NEAR RED OAK ST.**
ENGR. [signature]	FIELD REVIEW _____ DATE _____
R.C.E. NO. 13870 DATE 5-28-87	TIE BOOK 6 PAGE 141

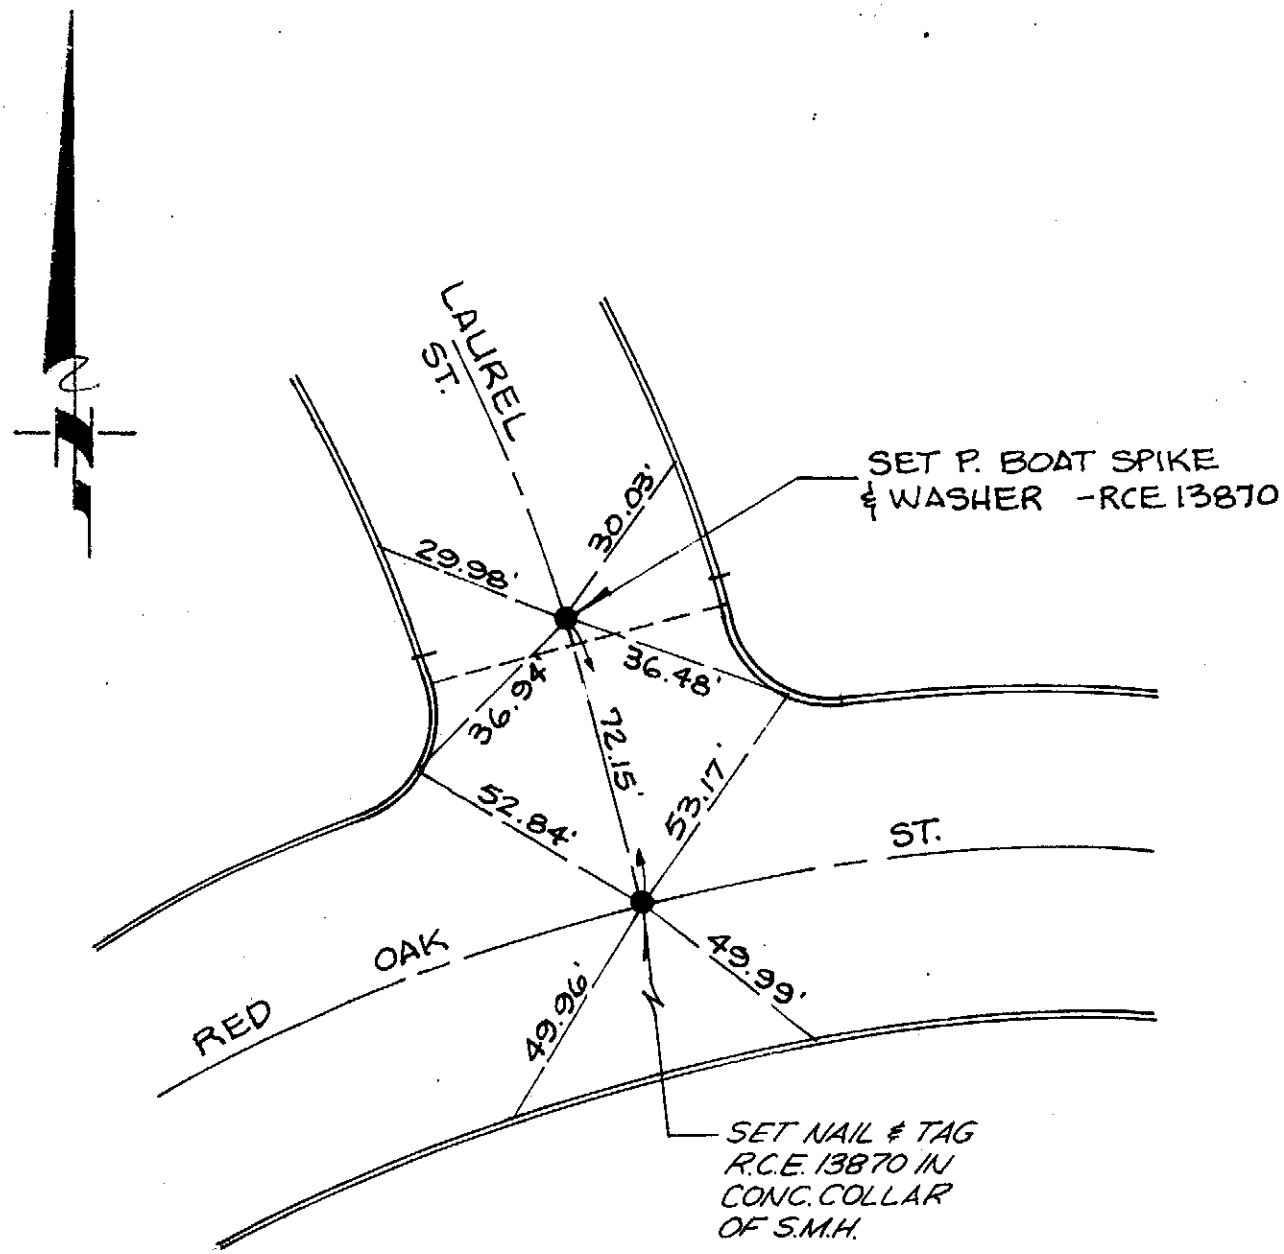

NOTE :

- ALL TIE POINTS ARE RAMSET NAILS ON TOP OF CURB ~ UNLESS OTHERWISE NOTED

CITY OF RANCHO CUCAMONGA — STREET TIES	PARCEL MAP NO. 6725
LDKING L.D. KING, INC. 517 N. EUCLID AVENUE ONTARIO, CALIF. (714) 988-5492	**LAUREL ST. AT RED OAK ST.**
ENGR. Walt Fenst	FIELD REVIEW _____ DATE _____
R.C.E. NO. 13870 DATE 5-28-87	TIE BOOK 6 PAGE 142

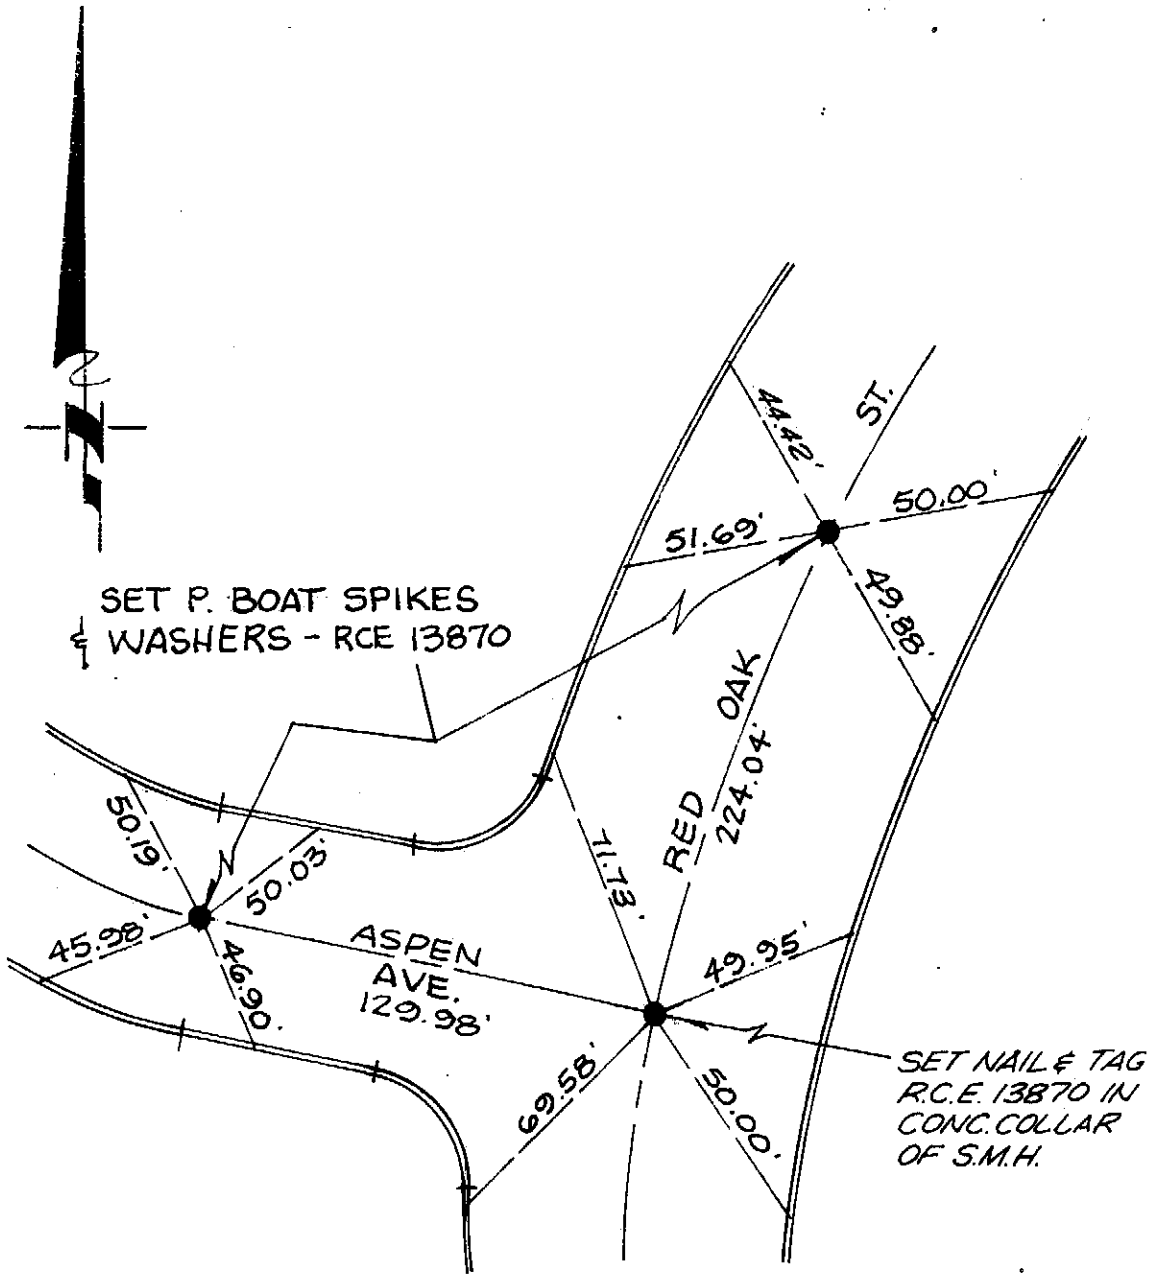

NOTE :

- ALL TIE POINTS ARE RAMSET NAILS ON TOP OF CURB ~ UNLESS OTHERWISE NOTED

CITY OF RANCHO CUCAMONGA — STREET TIES	PARCEL MAP NO. 6725
LDKING L.D. KING, INC. 517 N. EUCLID AVENUE ONTARIO, CALIF. (714) 988-5492	RED OAK ST. AND Aspen ~~ALDER~~ AVE.
ENGR. _____	FIELD REVIEW _____ DATE _____
R.C.E. NO. 13870 DATE _____	TIE BOOK 6 PAGE 143

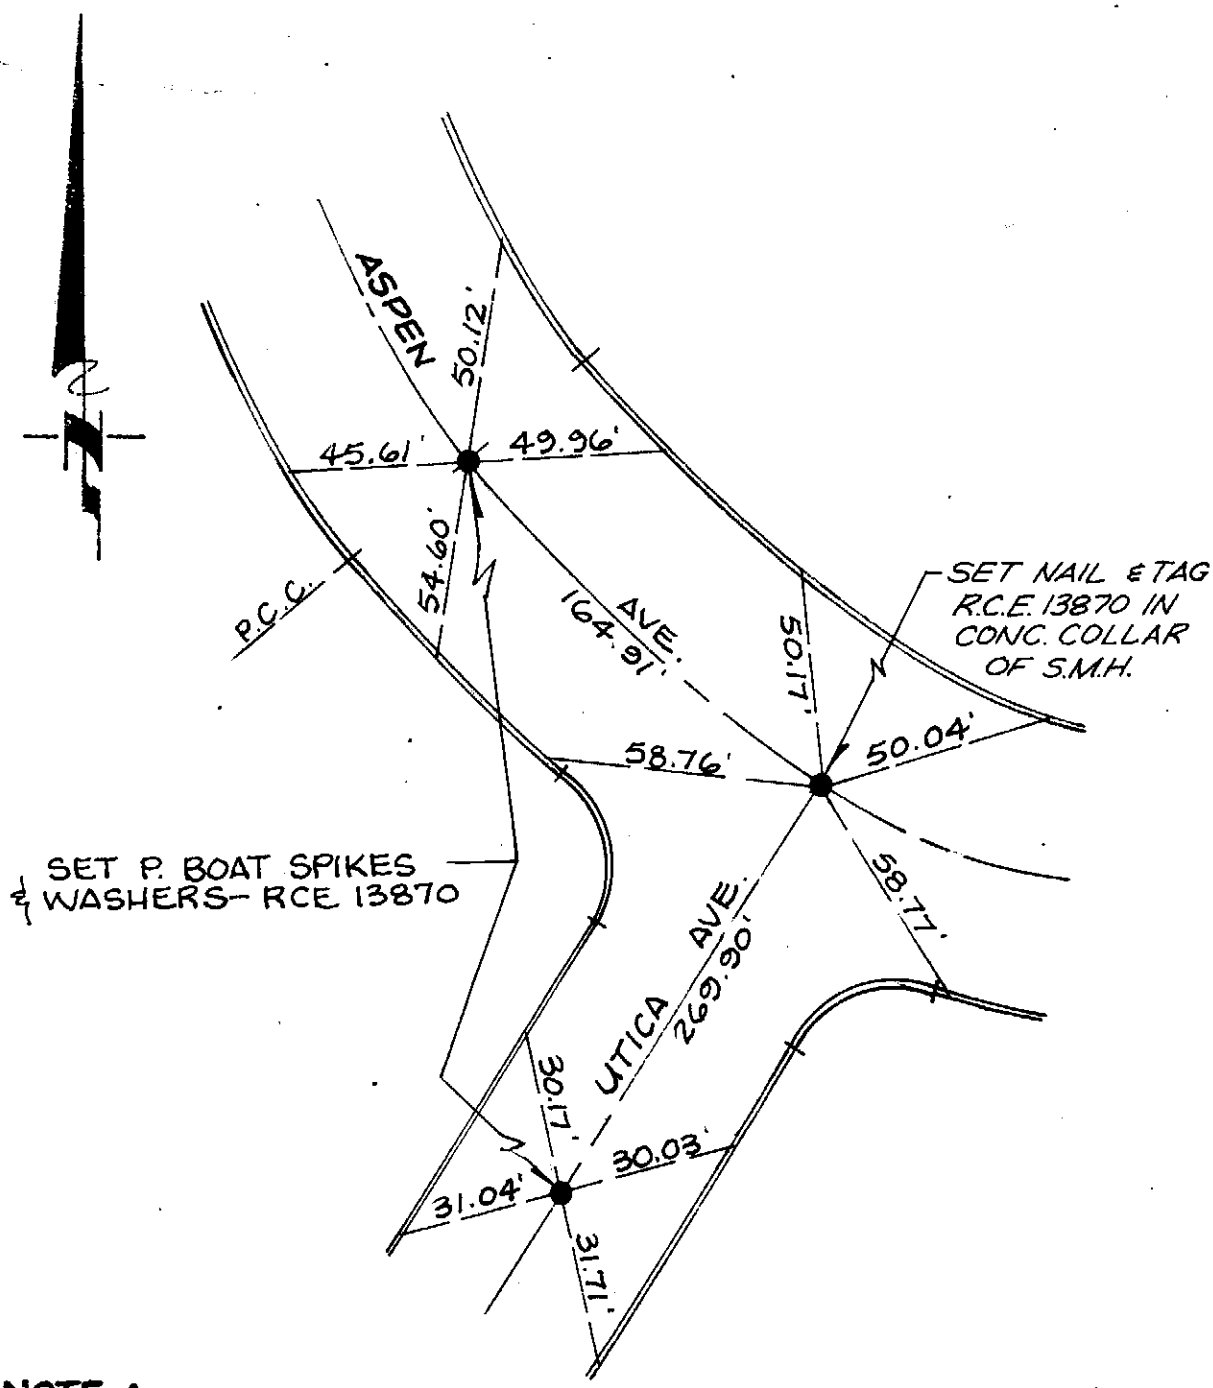

NOTE :
ALL TIE POINTS ARE RAMSET NAILS
ON TOP OF CURB ~ UNLESS OTHERWISE NOTED

CITY OF RANCHO CUCAMONGA — STREET TIES	PARCEL MAP NO. 6725
LDKING L.D. KING, INC. 517 N. EUCLID AVENUE ONTARIO, CALIF. (714) 988-5492	Aspen ~~ALDER~~ AVE. AND UTICA AVE.
ENGR.	FIELD REVIEW _____ DATE _____
R.C.E. NO. 13870 DATE 5-28-87	TIE BOOK 6 PAGE 144

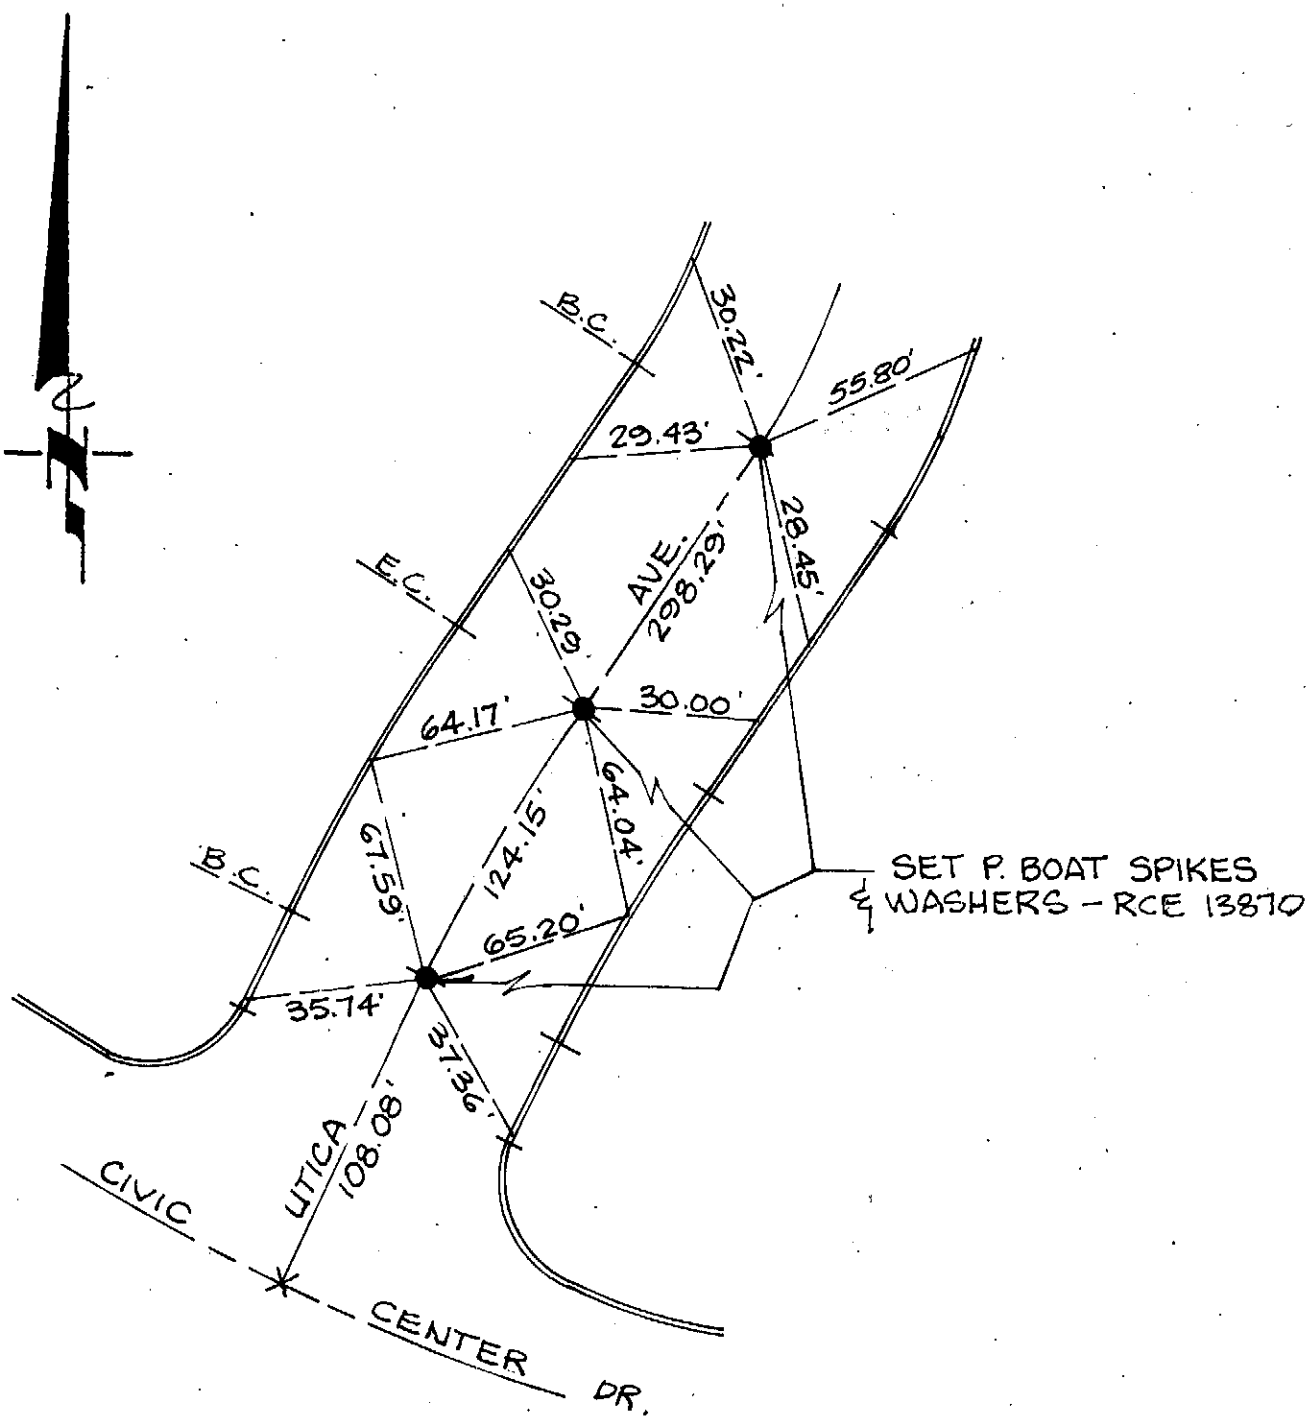

NOTE :
ALL TIE POINTS ARE RAMSET NAILS
ON TOP OF CURB ~ UNLESS OTHERWISE NOTED

CITY OF RANCHO CUCAMONGA — STREET TIES	PARCEL MAP NO. 6725
LDKING L.D. KING, INC. 517 N. EUCLID AVENUE ONTARIO, CALIF. (714) 988-5492	**UTICA AVE. NEAR CIVIC CENTER DR.**
ENGR. [signature]	FIELD REVIEW _____ DATE _____
R.C.E. NO. 13870 DATE 5-28-87	TIE BOOK 6 PAGE 143

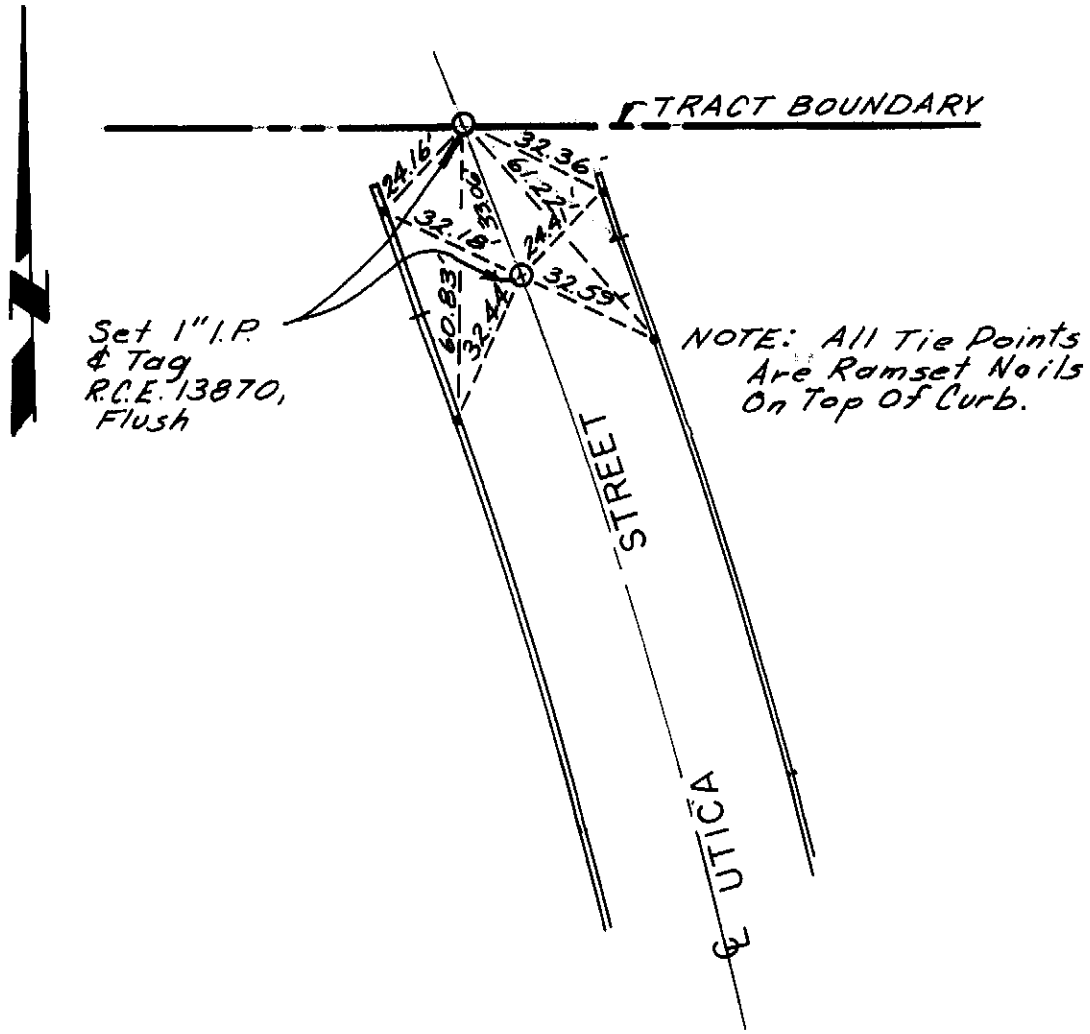

CITY OF RANCHO CUCAMONGA — STREET TIES	PARCEL MAP NO. 6544
LDKING L.D. KING, INC. 517 N. EUCLID AVENUE ONTARIO, CALIF. (714) 988-5492	UTICA STREET
ENGR. [signature]	FIELD REVIEW _____ DATE _____
R.C.E. NO. 13870 DATE 5-28-87	TIE BOOK 6 PAGE 146

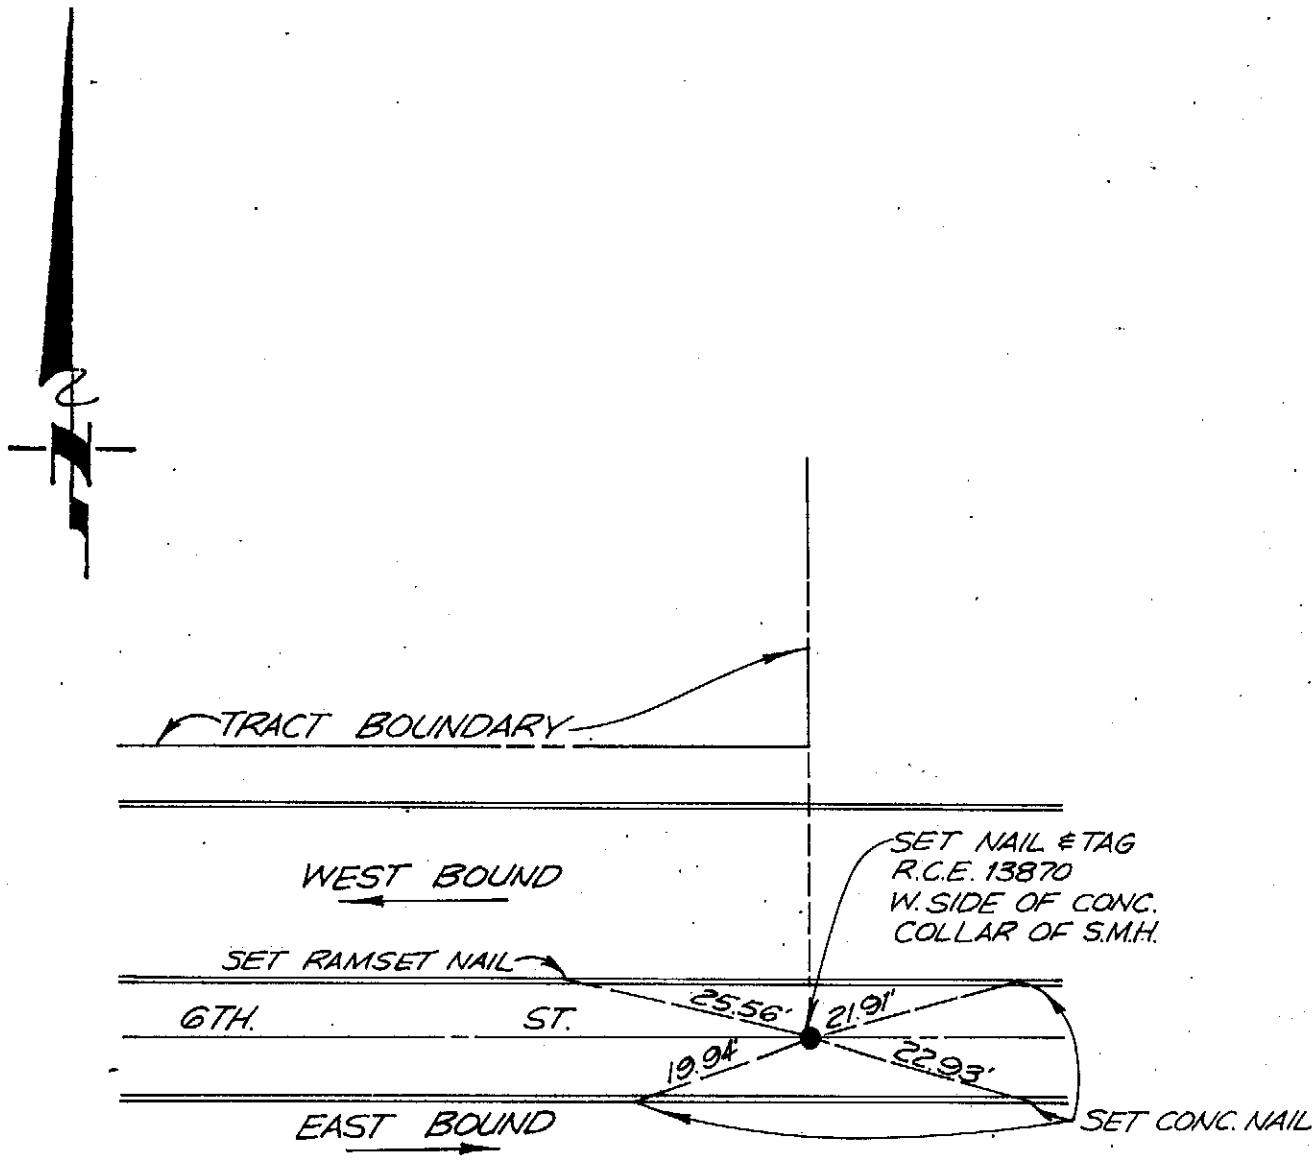

CITY OF RANCHO CUCAMONGA — STREET TIES	PARCEL MAP NO. 6544
LDKING L.D. KING, INC. 517 N. EUCLID AVENUE ONTARIO, CALIF. (714) 988-5492	6TH STREET
ENGR. [signature]	FIELD REVIEW _____ DATE _____
R.C.E. NO. 13870 DATE 5-28-87	TIE BOOK 6 PAGE 147

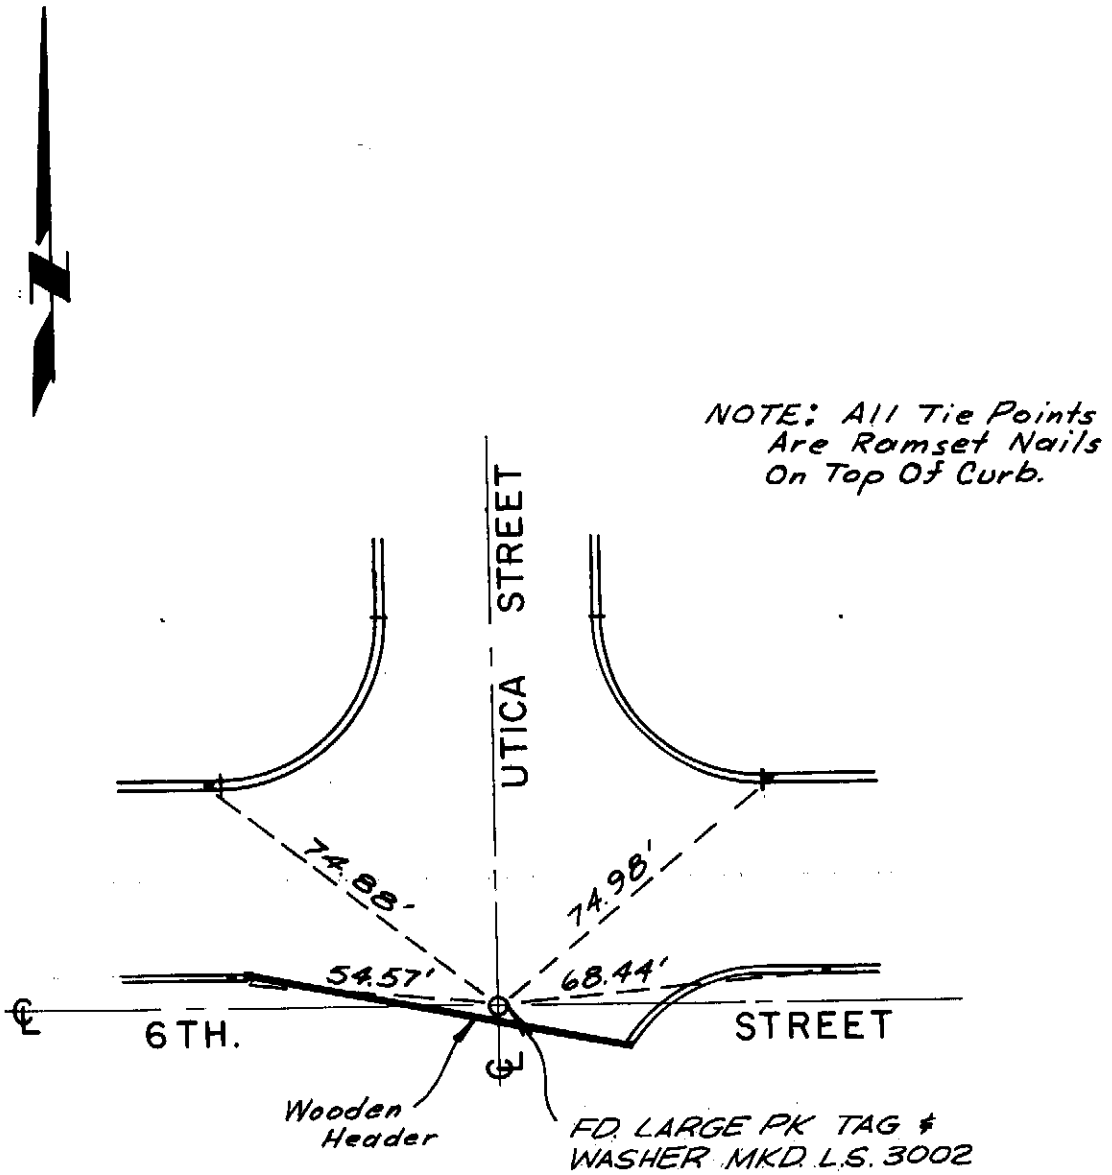

CITY OF RANCHO CUCAMONGA — STREET TIES	PARCEL MAP NO. 6544
LDKING L.D. KING, INC. 517 N. EUCLID AVENUE ONTARIO, CALIF. (714) 988-5492	6TH. STREET & UTICA STREET
ENGR.	FIELD REVIEW _____ DATE _____
R.C.E. NO. 13870 DATE 5-28-87	TIE BOOK 6 PAGE 198

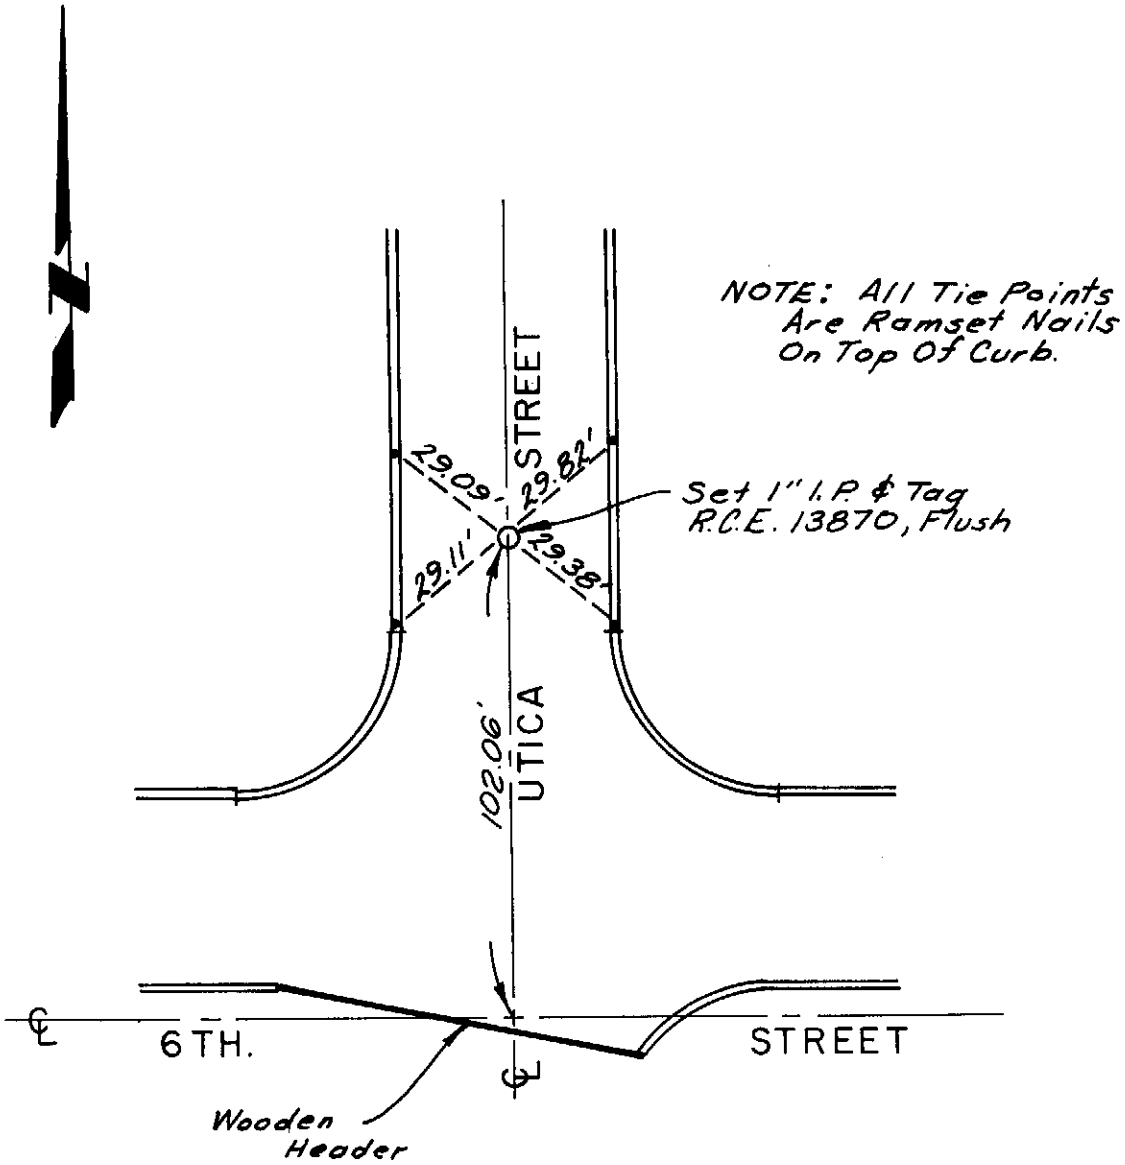

CITY OF RANCHO CUCAMONGA — STREET TIES	PARCEL MAP NO. 6544
LDKING L.D. KING, INC. 517 N. EUCLID AVENUE ONTARIO, CALIF. (714) 988-5492	UTICA STREET
ENGR. [signature]	FIELD REVIEW _____ DATE _____
R.C.E. NO. 13870 DATE 5-28-87	TIE BOOK 6 PAGE 149

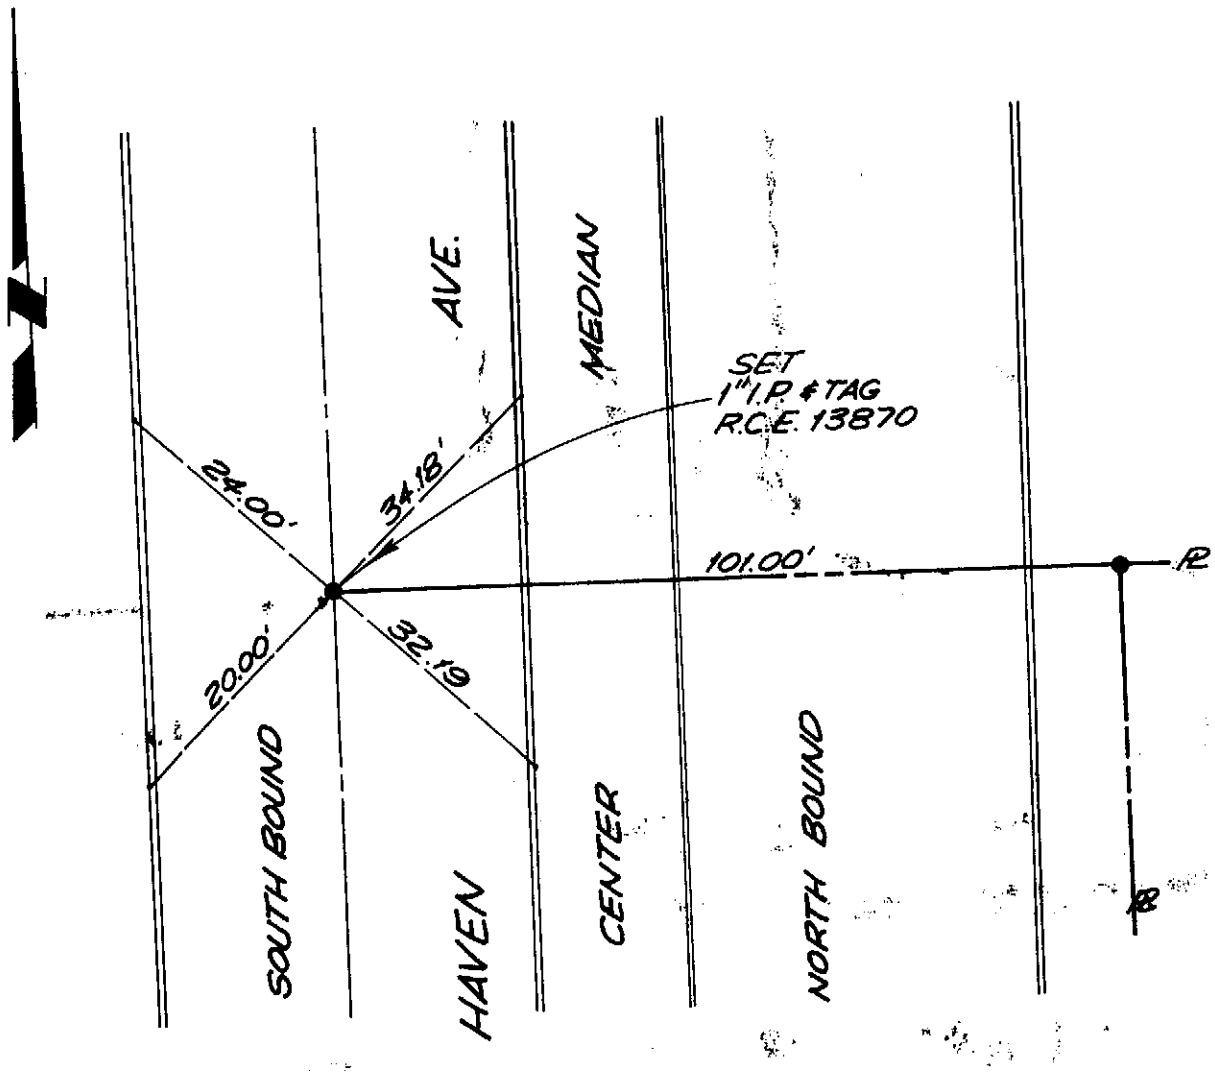

NOTE: ALL TIE POINTS ARE SET CONC. NAILS ON TOP OF CURB UNLESS OTHERWISE NOTED.

city of rancho cucamonga — STREET TIE	PARCEL MAP NO. 6544
L.D. KING, INC. 517 N. EUCLID AVENUE ONTARIO, CALIF. (714) 988-5492	HAVEN AVENUE / 6TH
ENGR. / L.S.	FIELD REVIEW _____ DATE _____
R.C.E. / L.S. No. 13870 DATE	TIE BOOK 6 PAGE 150

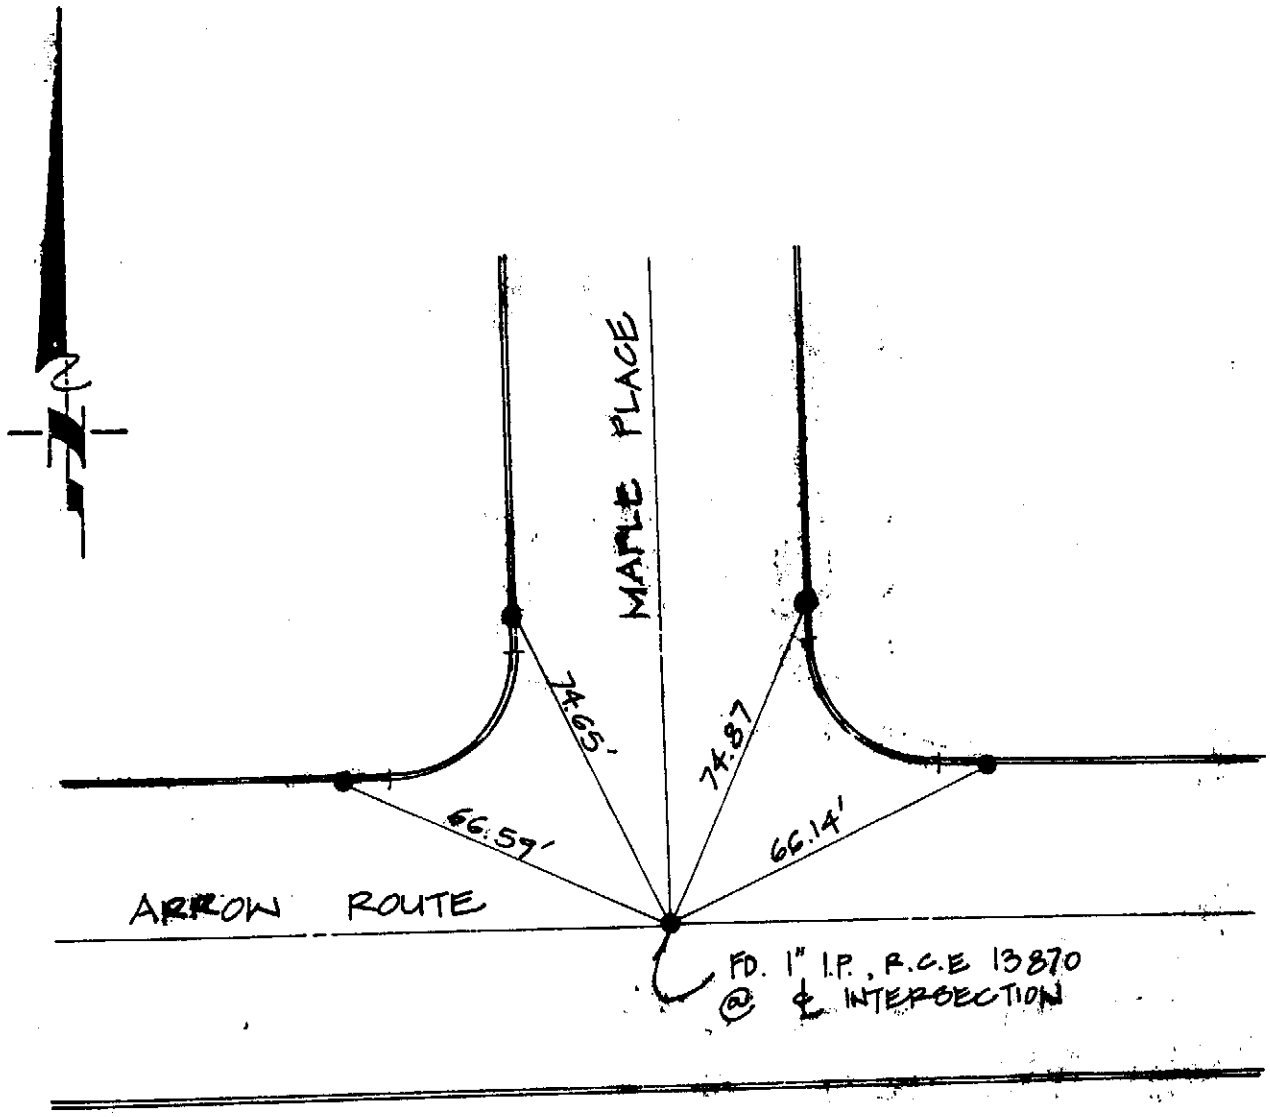

ALL TIE POINTS ARE RAMSET NAILS ON TOP OF CURB, 1' FROM CURB RETURN UNLESS OTHERWISE NOTED

CITY OF RANCHO CUCAMONGA — STREET TIES	PARCEL MAP NO. 6725
LDKING L.D. KING, INC. 517 N. EUCLID AVENUE ONTARIO, CALIF. (714) 988-6492	VINCENT AVE. MAPLE PLACE AT ARROW ROUTE
ENGR. _____	FIELD REVIEW _____ DATE _____
R.C.E. NO. 13870 DATE _____	TIE BOOK 6 PAGE 151

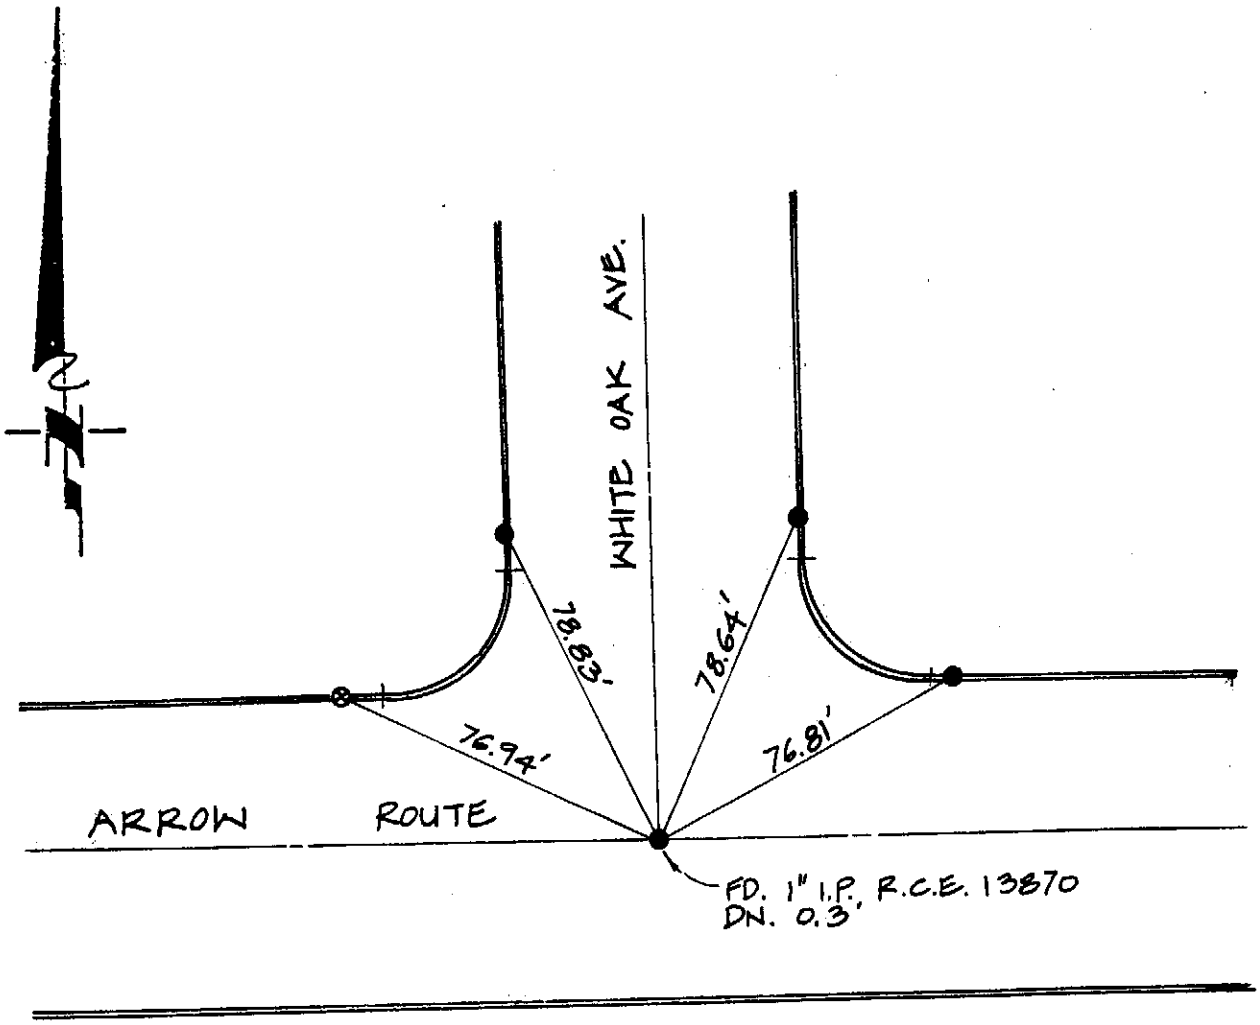

● ALL TIE POINTS ARE RAMSET NAILS ON TOP OF CURB UNLESS OTHERWISE NOTED

⊗ LEAD & TACK

CITY OF RANCHO CUCAMONGA — STREET TIES	PARCEL MAP NO. 6725
LDKING L.D. KING, INC. 517 N. EUCLID AVENUE ONTARIO, CALIF. (714) 988-5492	**WHITE OAK AVE. AT ARROW ROUTE**
ENGR. _____	FIELD REVIEW _____ DATE _____
R.C.E. NO. 13870 DATE _____	TIE BOOK 6 PAGE 152