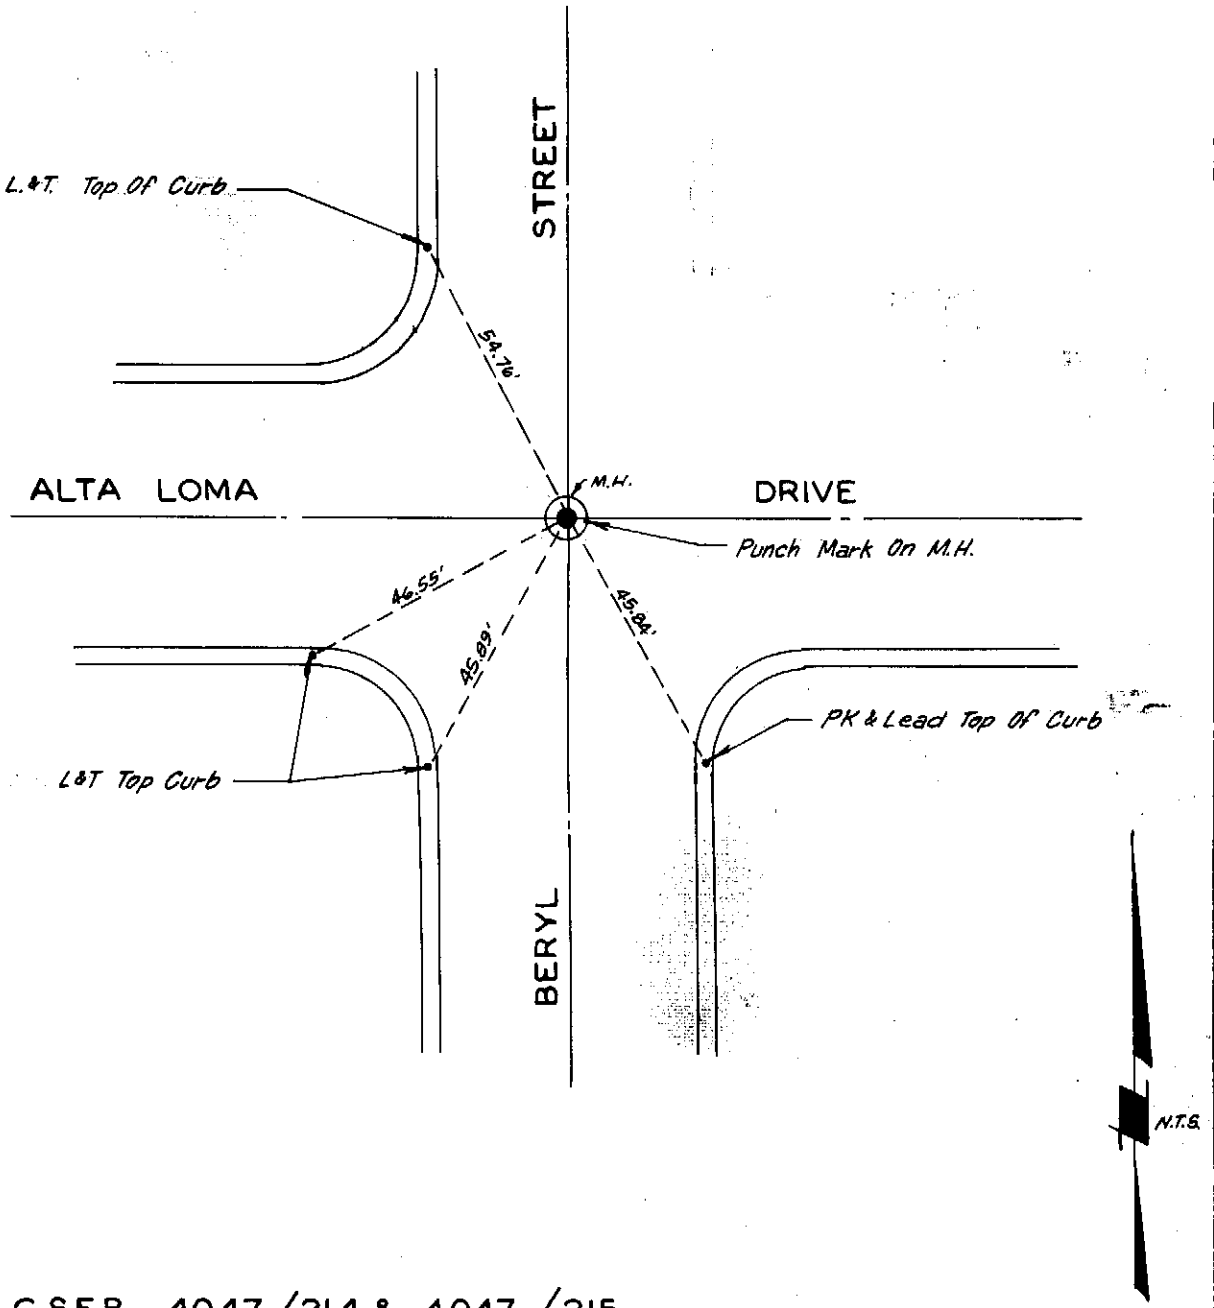

Ref. : C.S.F.B. 4047/214 & 4047/215

city of rancho cucamonga — STREET TIE	
COMPILED FROM SAN BERNARDINO COUNTY SURVEYOR'S RECORDS By: Linville-Sanderson-Horn & Assoc.	ALTA LOMA DRIVE & BERYL STREET
ENGR./L.S.	FIELD REVIEW DATE
R.C.E./L.S. No. DATE	TIE BOOK 5 PAGE 1

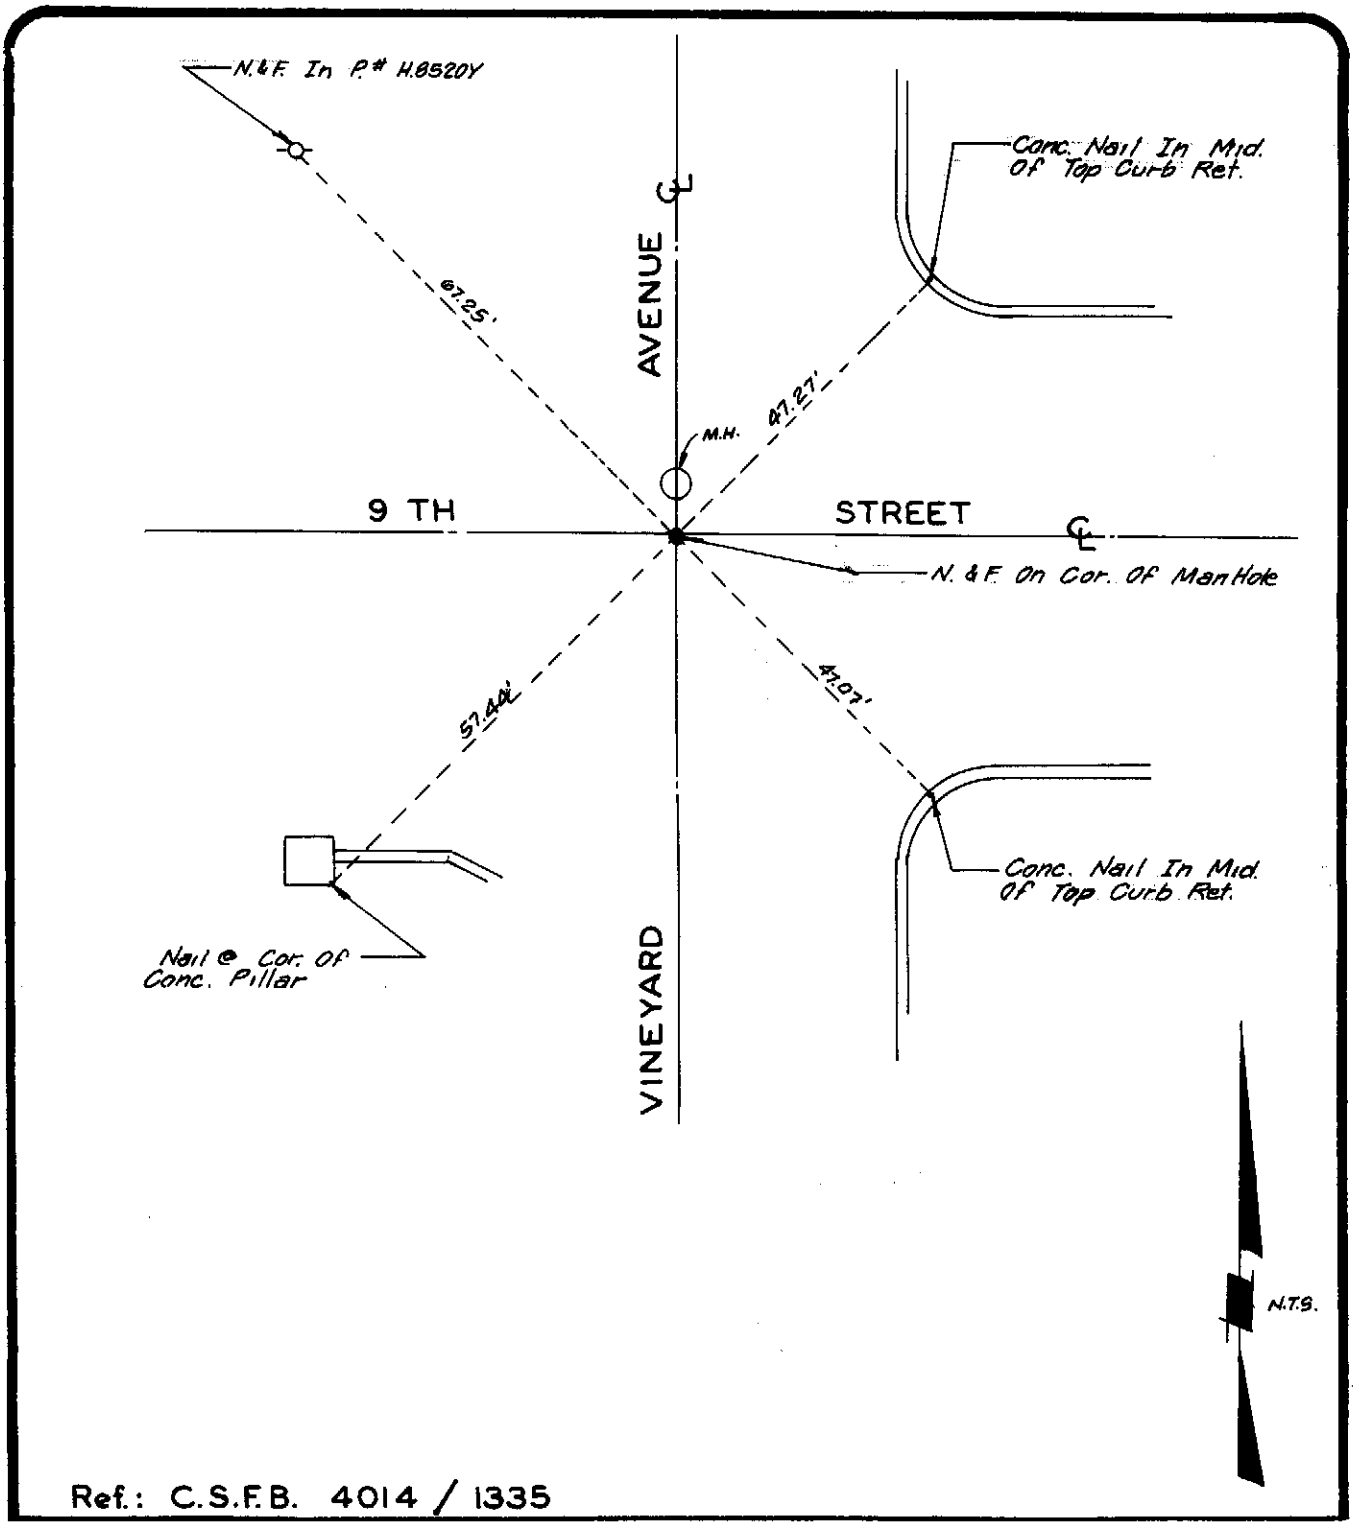

Ref.: C.S.F.B. 4014 / 1335

city of rancho cucamonga STREET TIE	
COMPILED FROM SAN BERNARDINO COUNTY SURVEYOR'S RECORDS By: Linville-Sanderson-Horn & Assoc.	9 TH STREET & VINEYARD AVENUE
ENGR. / L.S.	FIELD REVIEW DATE
R.C.E. / L.S. No. DATE	TIE BOOK 5 PAGE 2

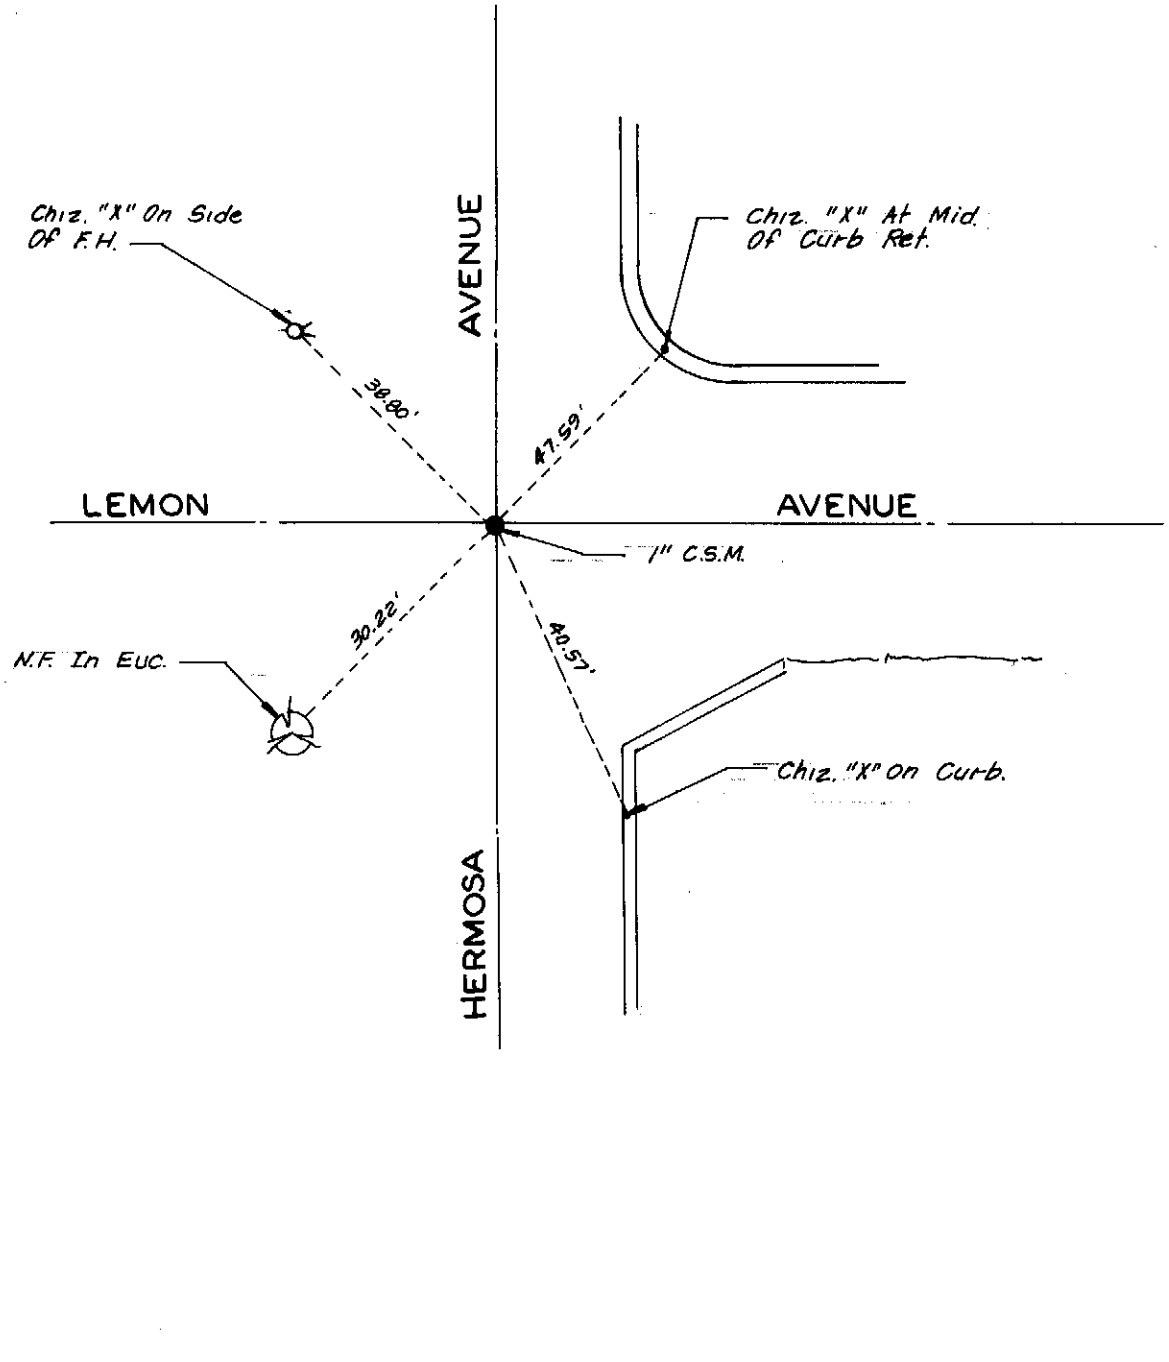

Ref.: C.S.F.B. 4047/189

city of rancho cucamonga — STREET TIE	
COMPILED FROM SAN BERNARDINO COUNTY SURVEYOR'S RECORDS **By: Linville-Sanderson-Horn & Assoc.**	LEMON AVENUE & HEMOSA AVENUE
ENGR. / L. S. _____	FIELD REVIEW _____ DATE _____
R.C.E. / L.S. No. _____ DATE _____	TIE BOOK 5 PAGE 3

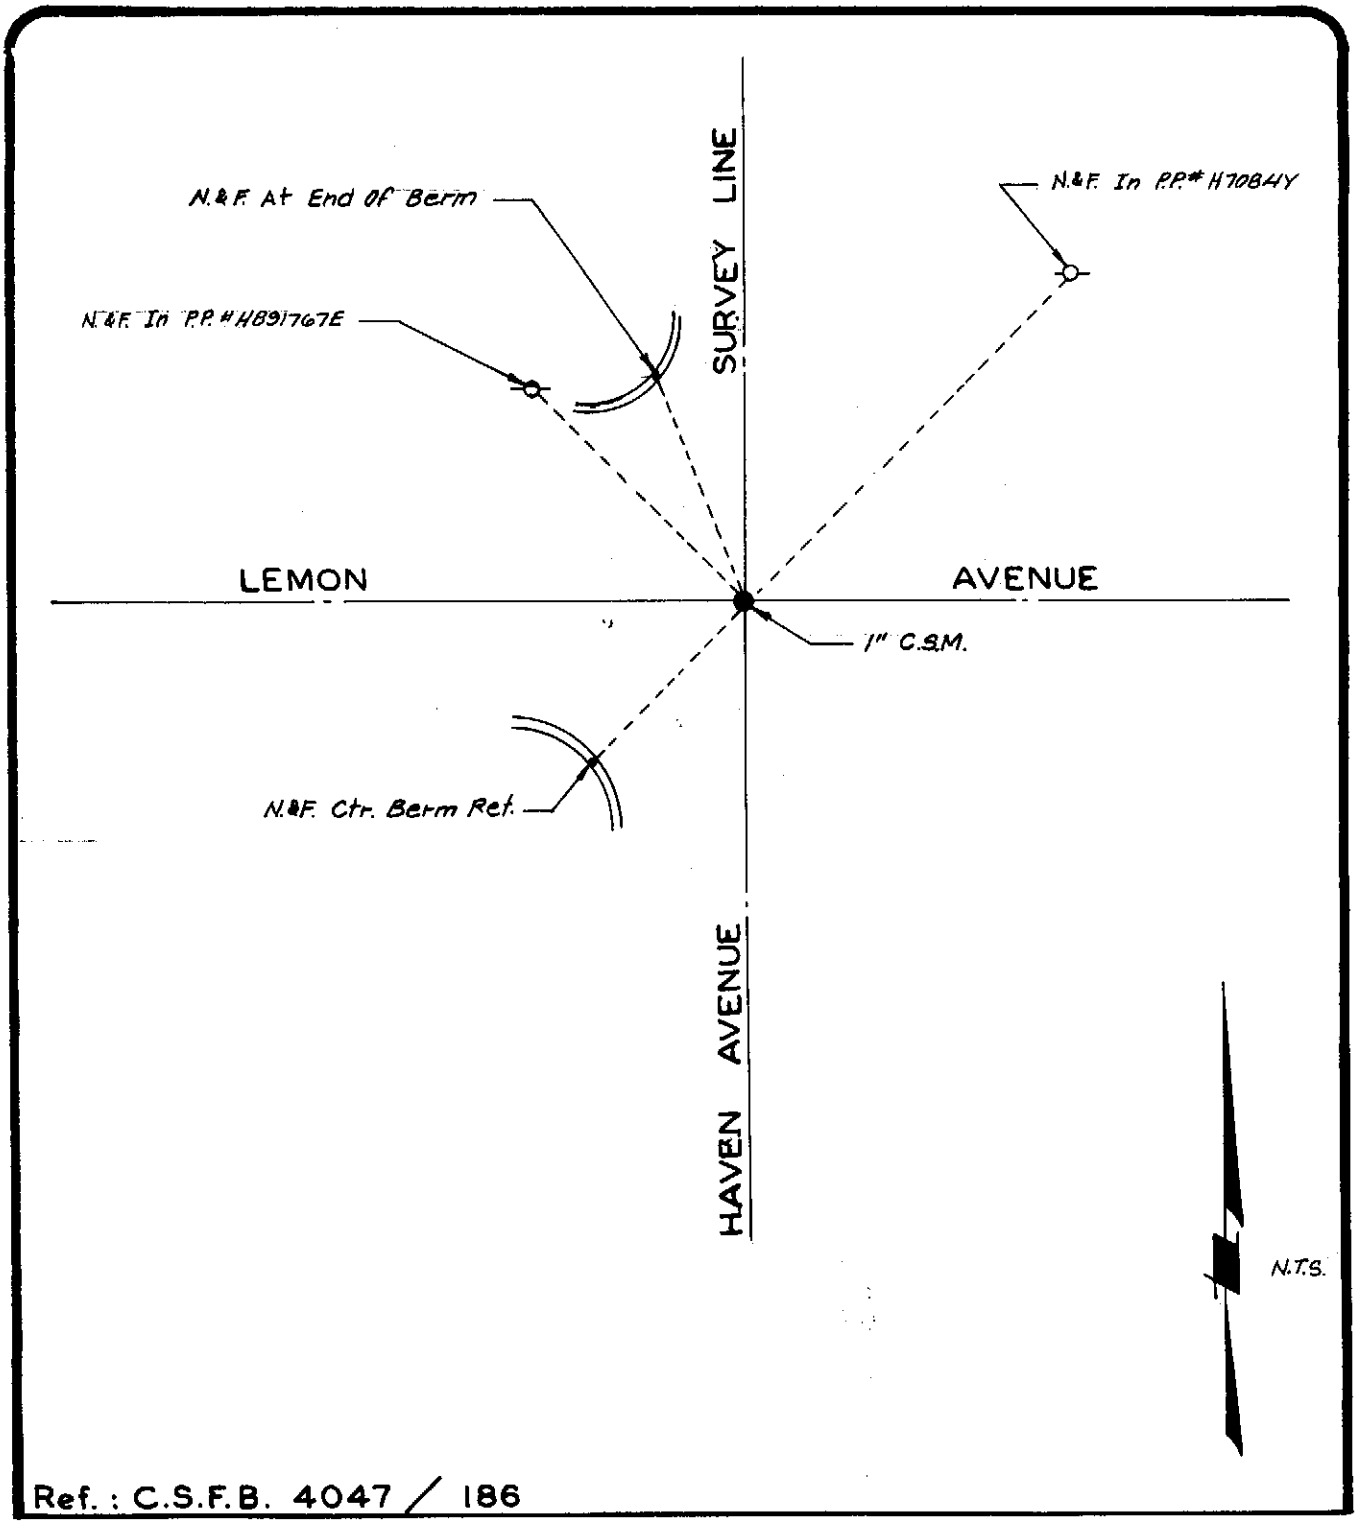

Ref. : C.S.F.B. 4047 / 186

city of rancho cucamonga — STREET TIE	
COMPILED FROM SAN BERNARDINO COUNTY SURVEYOR'S RECORDS By: Linville-Sanderson-Horn & Assoc.	LEMON AVENUE & HAVEN AVENUE
ENGR. / L. S. _____	FIELD REVIEW _____ DATE _____
R.C.E. / L.S. No. _____ DATE _____	TIE BOOK 5 PAGE 4

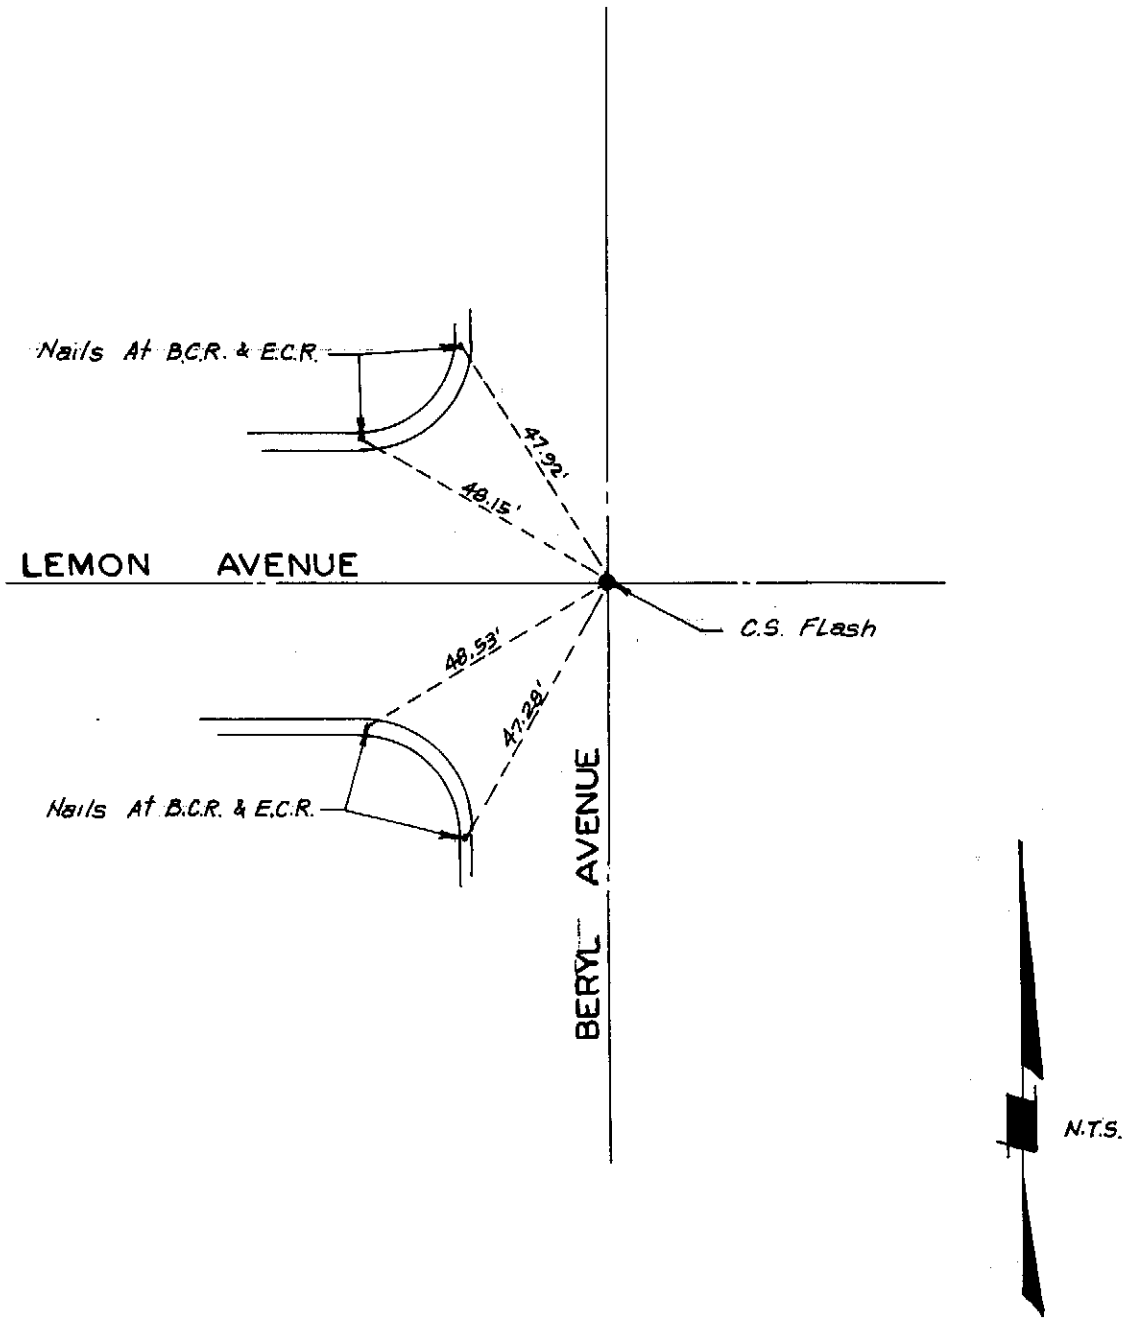

Ref.: C.S.F.B. 4047 / 216

city of rancho cucamonga — STREET TIE	
COMPILED FROM SAN BERNARDINO COUNTY SURVEYOR'S RECORDS By: Linville-Sanderson-Horn & Assoc.	LEMON AVENUE & BERYL AVENUE
ENGR. / L.S. _____	FIELD REVIEW _____ DATE _____
R.C.E. / L.S. No. _____ DATE _____	TIE BOOK 5 PAGE 5

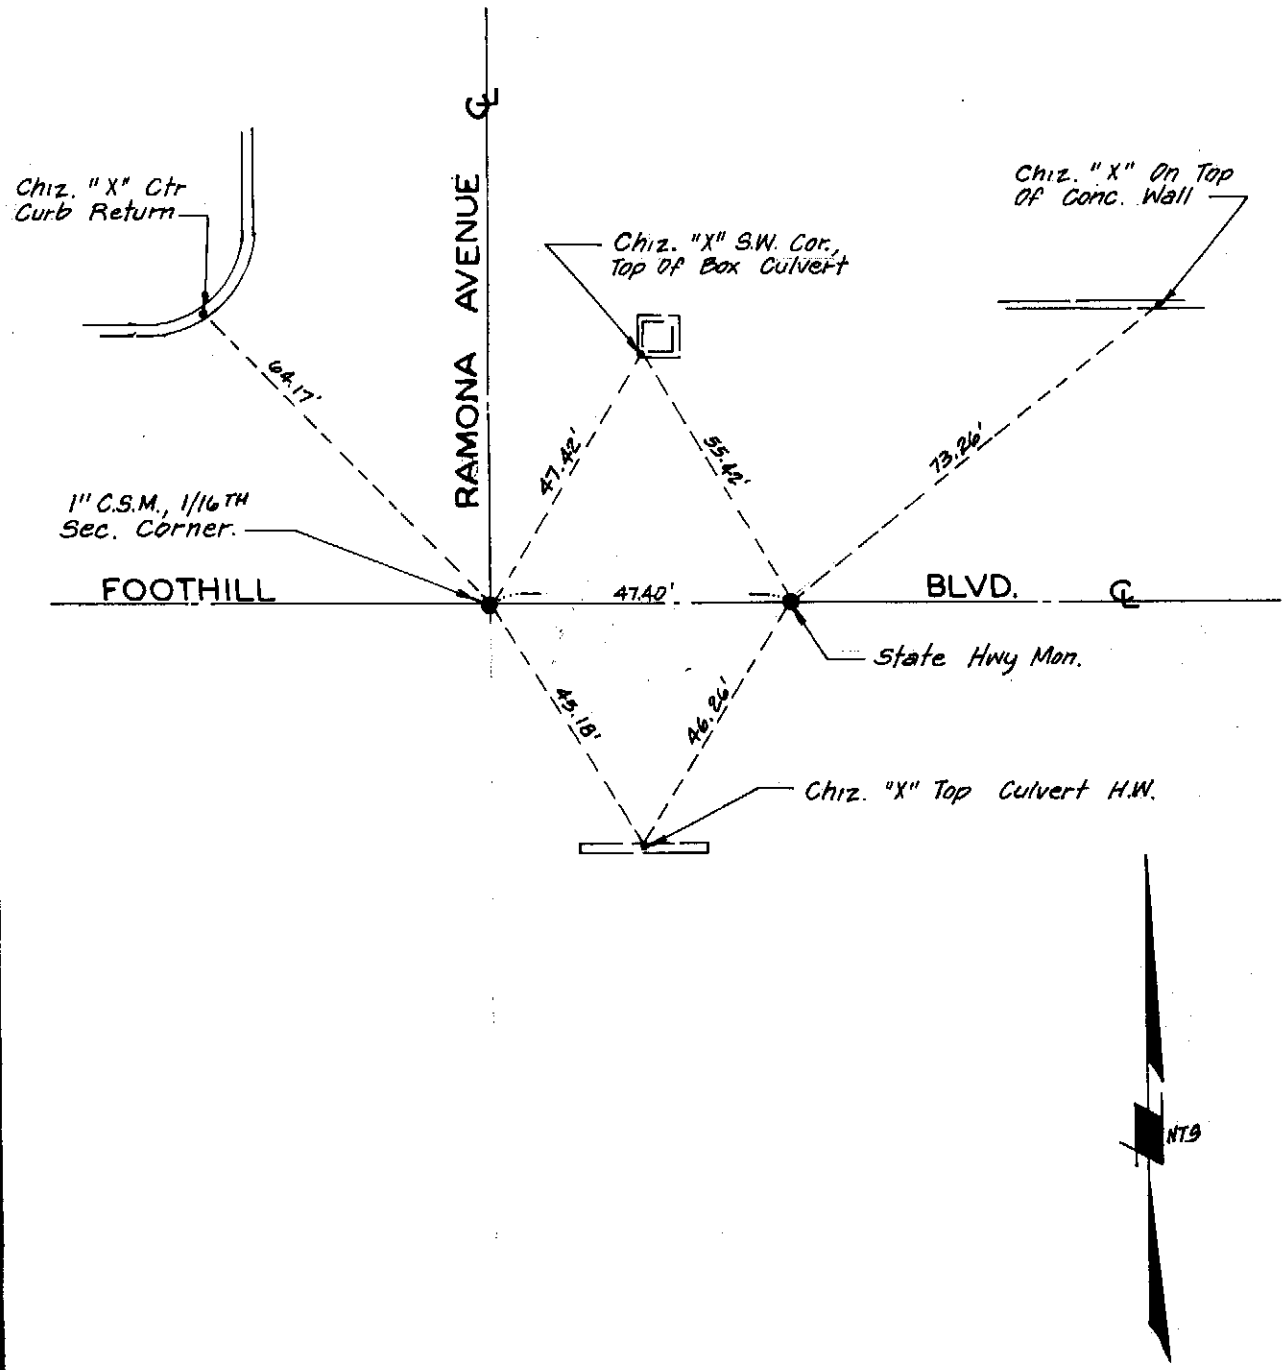

Ref.: C.S.F.B. 535 53

city of rancho cucamonga — STREET TIE	
COMPILED FROM SAN BERNARDINO COUNTY SURVEYOR'S RECORDS **By: Linville-Sanderson-Horn & Assoc.**	FOOTHILL BLVD. & RAMONA AVENUE
ENGR. / L. S. _____	FIELD REVIEW _____ DATE _____
R.C.E. / L.S. No. _____ DATE _____	TIE BOOK 5 PAGE 6

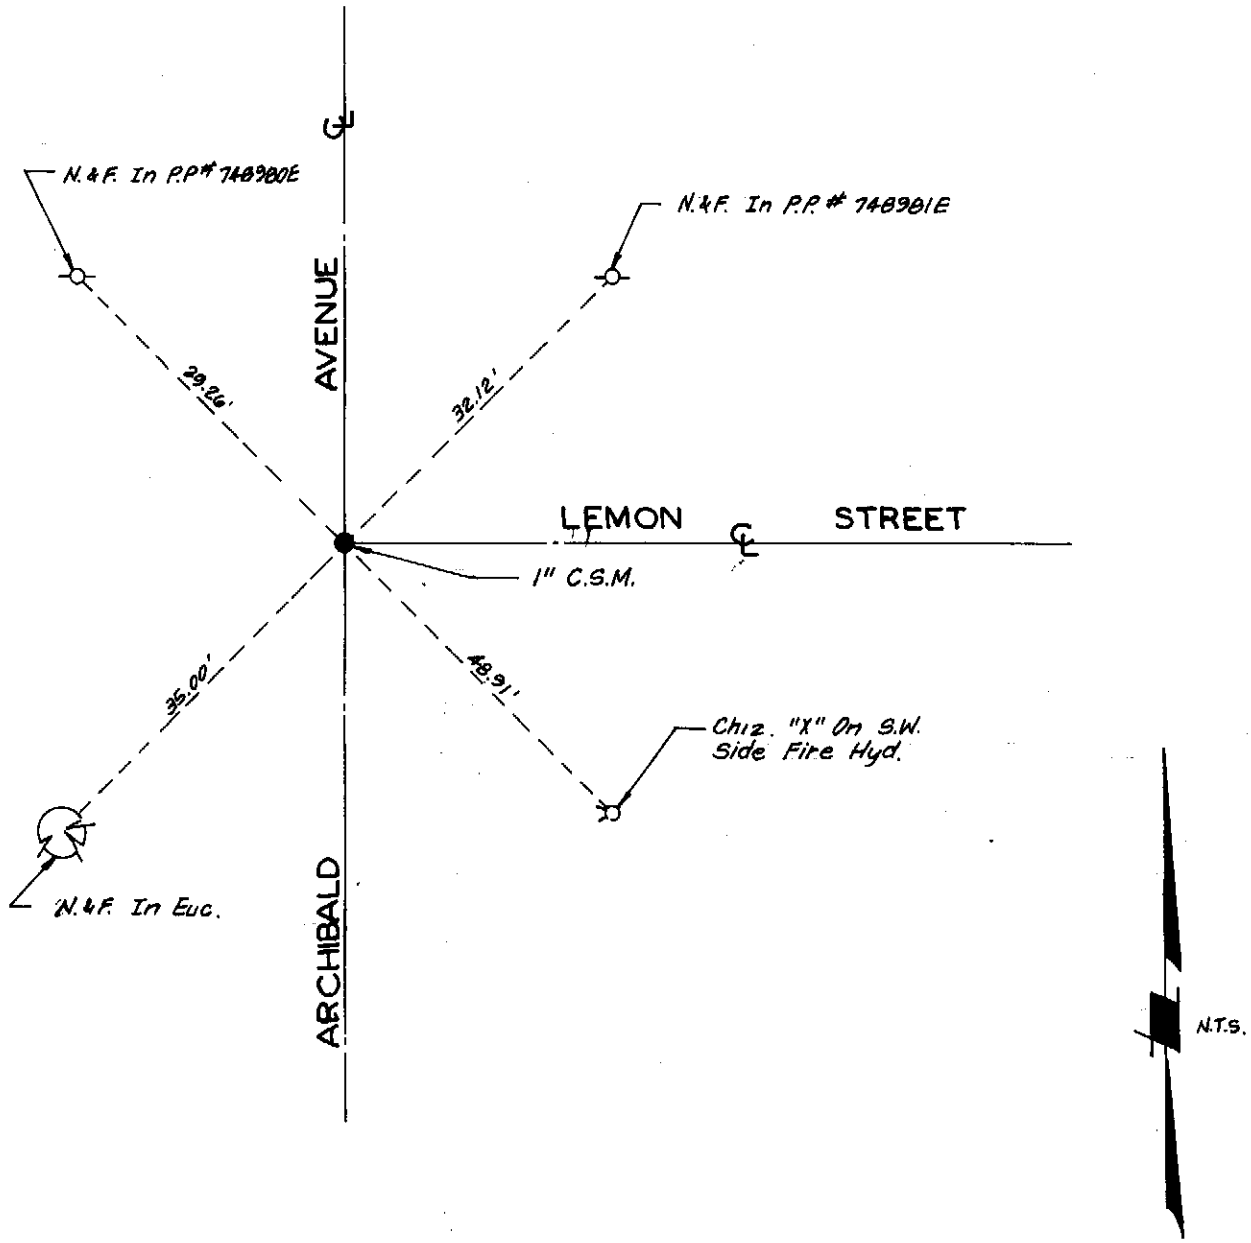

Ref.: F.B. 44 / 86

city of rancho cucamonga — STREET TIE	
COMPILED FROM SAN BERNARDINO COUNTY SURVEYOR'S RECORDS By: Linville-Sanderson-Horn & Assoc.	LEMON STREET & ARCHIBALD AVENUE
ENGR. / L.S. _____	FIELD REVIEW _____ DATE _____
R.C.E. / L.S. No. _____ DATE _____	TIE BOOK 5 PAGE 7

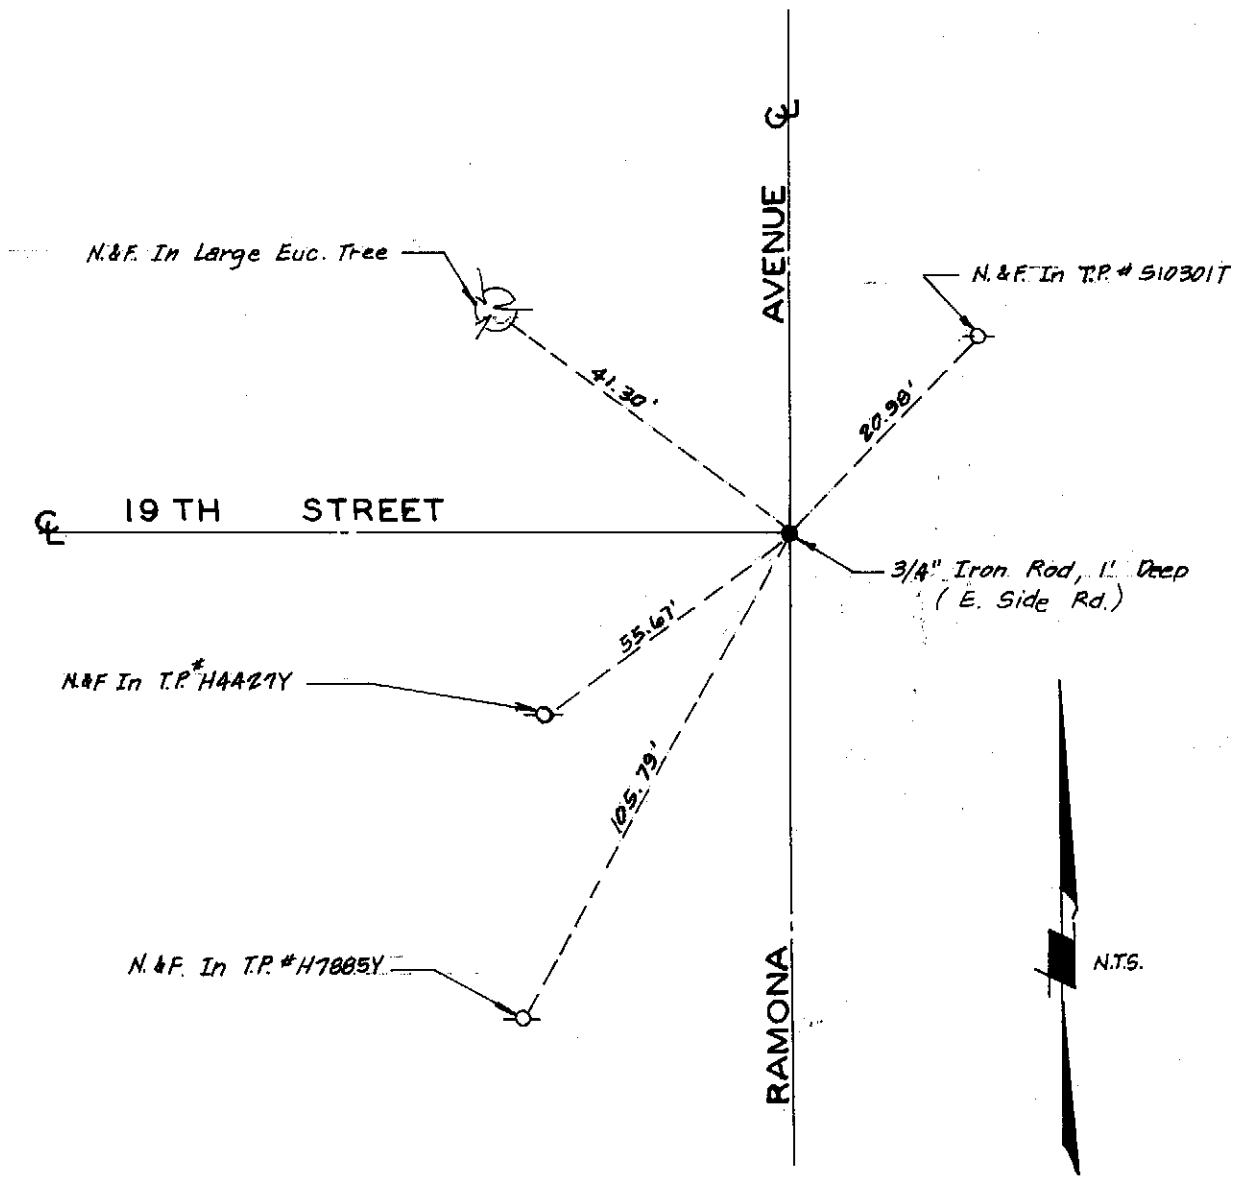

Ref.: R.D.F.B. 44 / 85

city of rancho cucamonga — STREET TIE	
COMPILED FROM SAN BERNARDINO COUNTY SURVEYOR'S RECORDS **By: Linville-Sanderson-Horn & Assoc.**	19TH STREET & ROMONA AVENUE
ENGR. / L.S.	FIELD REVIEW ____ DATE ____
R.C.E. / L.S. No. ____ DATE ____	TIE BOOK 5 PAGE 8

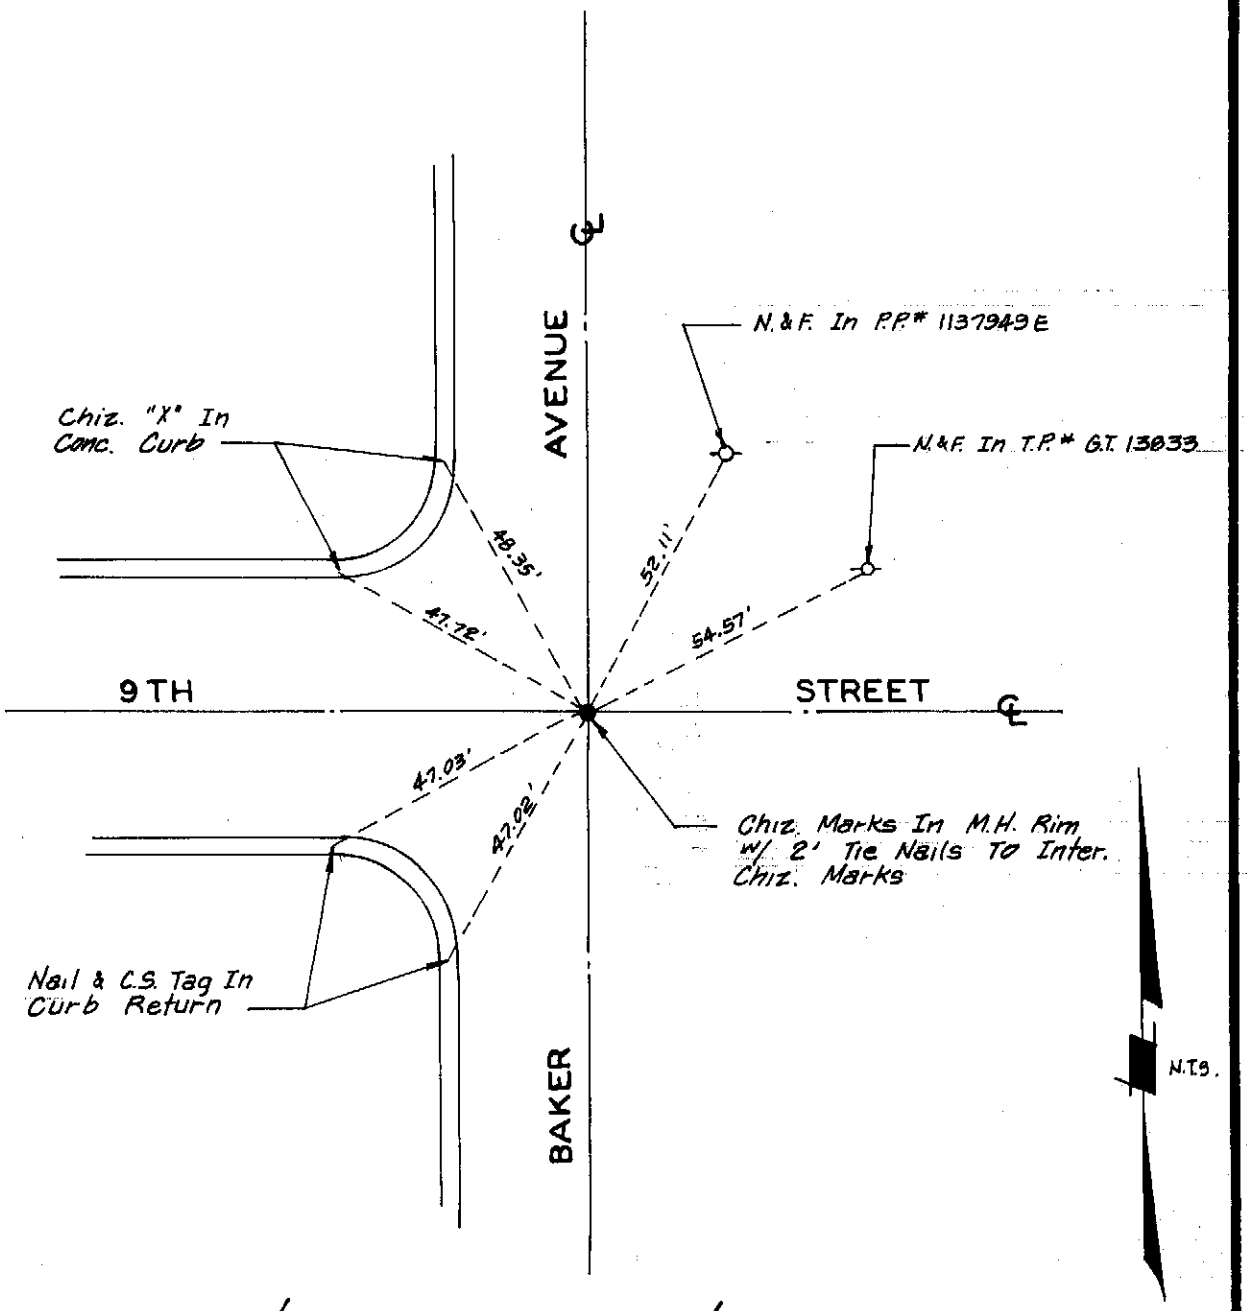

Ref. R.D.F.B. 11 / 306 & C.S.F.B. 4014 / 1614

city of rancho cucamonga STREET TIE	
COMPILED FROM SAN BERNARDINO COUNTY SURVEYOR'S RECORDS By: Linville-Sanderson-Horn & Assoc.	9TH STREET & BAKER AVENUE
ENGR. / L.S.	FIELD REVIEW DATE
R.C.E. / L.S. No. DATE	TIE BOOK 5 PAGE 9

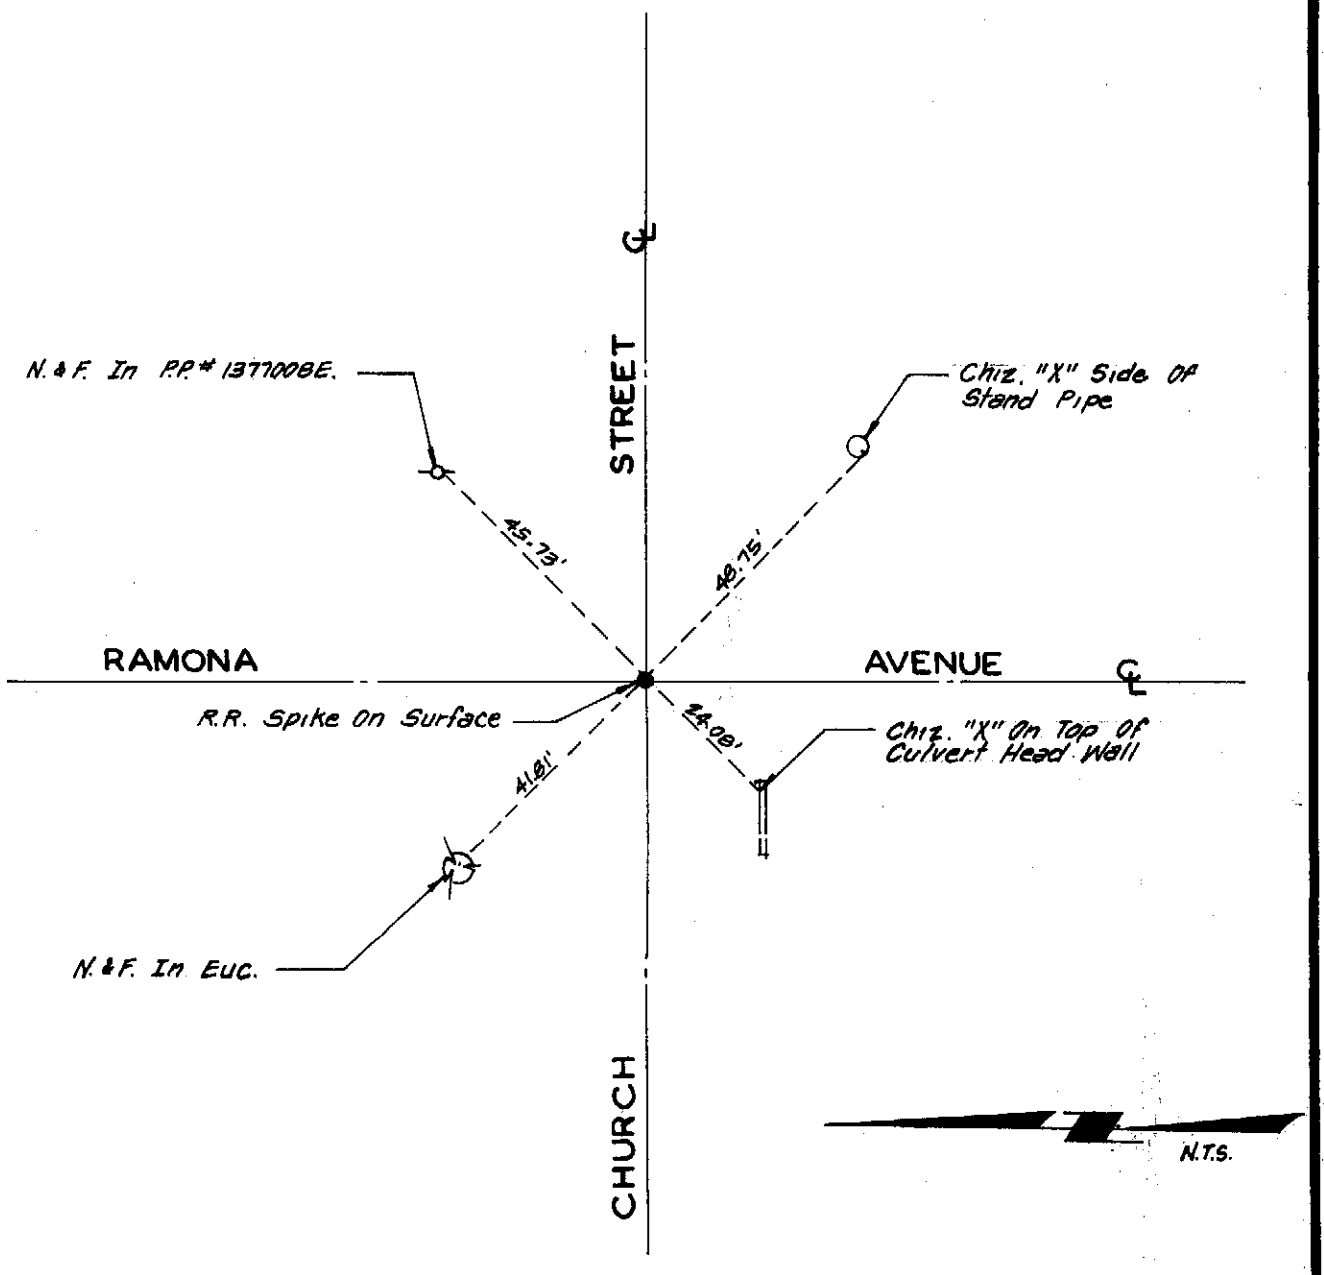

Ref.: C.S.F.B. 4014 /241

city of rancho cucamonga — STREET TIE	
COMPILED FROM SAN BERNARDINO COUNTY SURVEYOR'S RECORDS By: Linville-Sanderson-Horn & Assoc.	RAMONA AVENUE & CHURCH STREET
ENGR. / L. S. _____	FIELD REVIEW _____ DATE _____
R.C.E. / L.S. No. _____ DATE _____	TIE BOOK 5 PAGE 10

46

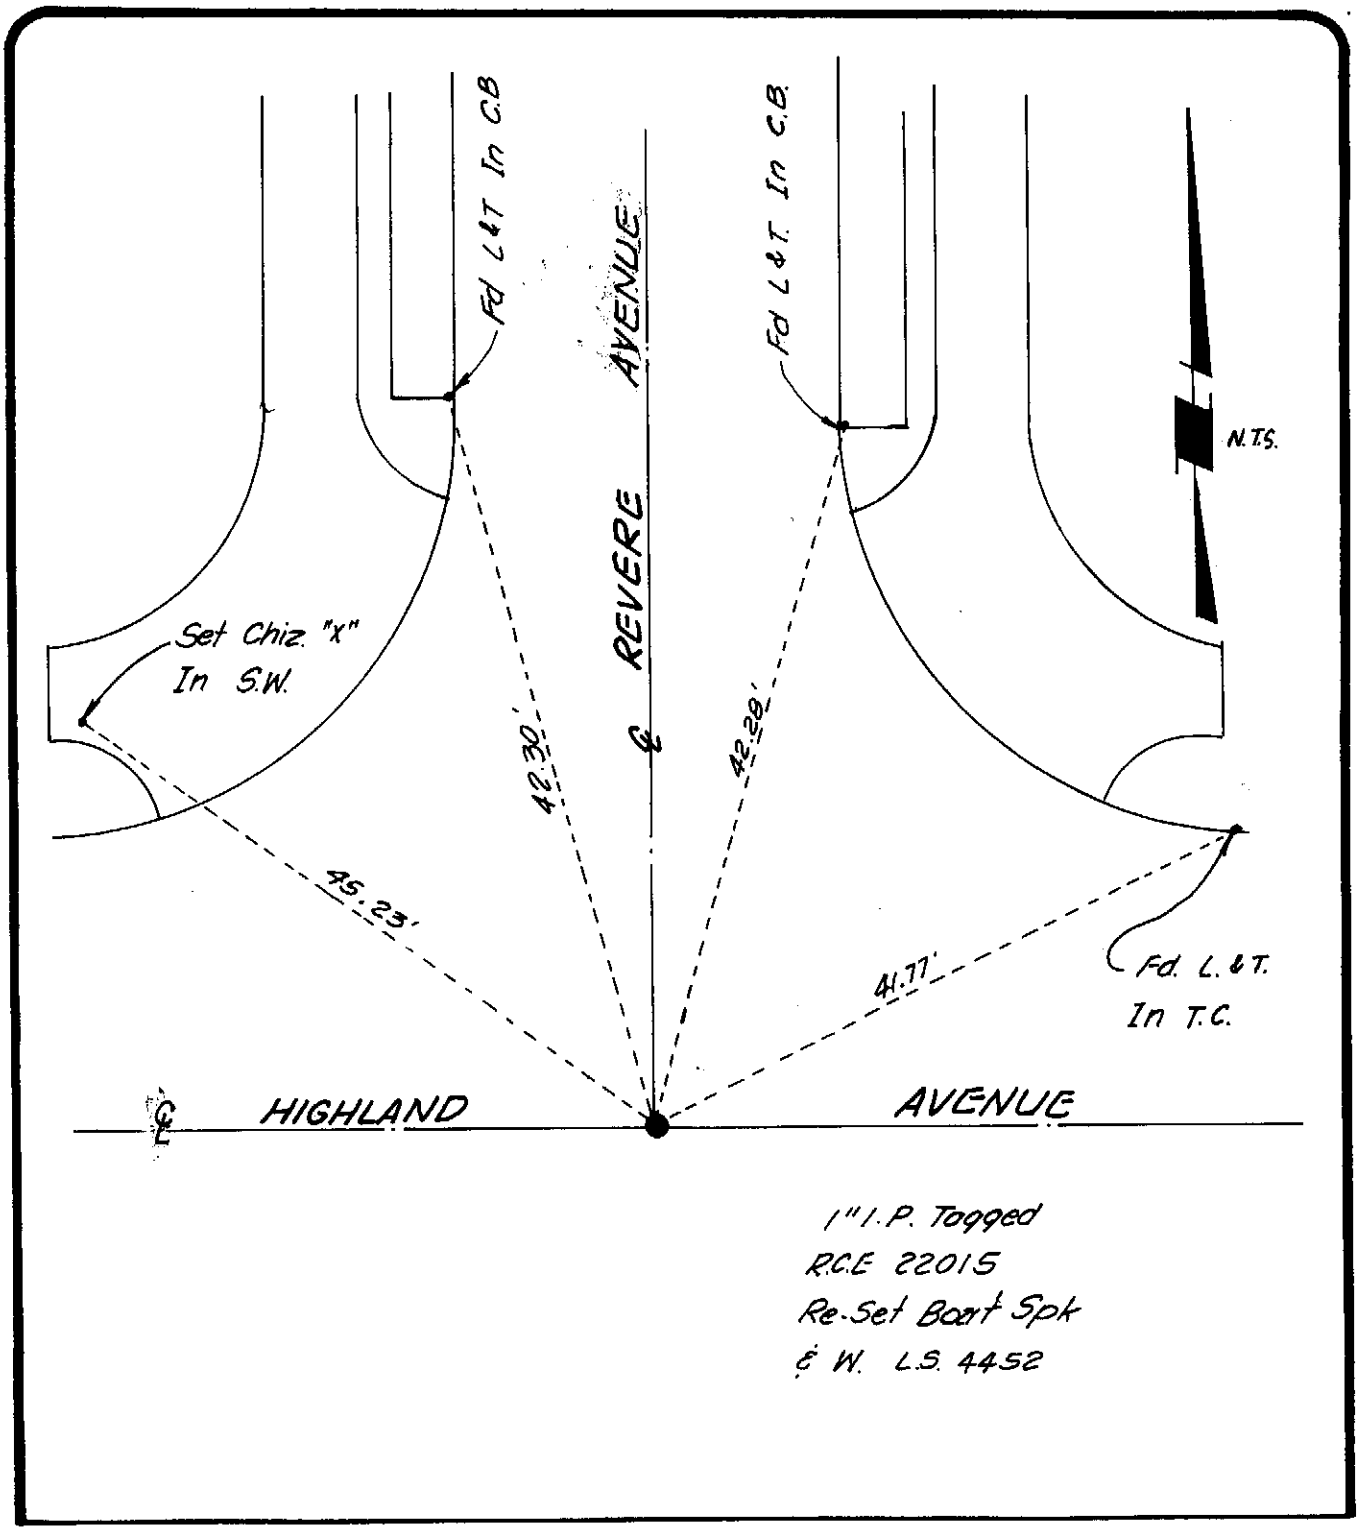

city of rancho cucamonga — STREET TIE	
LINVILLE-SANDERSON-HORN & ASSOC. 9587 ARROW ROUTE, SUITE "H" RANCHO CUCAMONGA, CA. 91730	REVERE AVENUE & HIGHLAND AVENUE
L.S. G. SANDERSON	FIELD REVIEW _____ DATE _____
L.S. No. 4452 DATE 3/81	TIE BOOK 5 PAGE 11

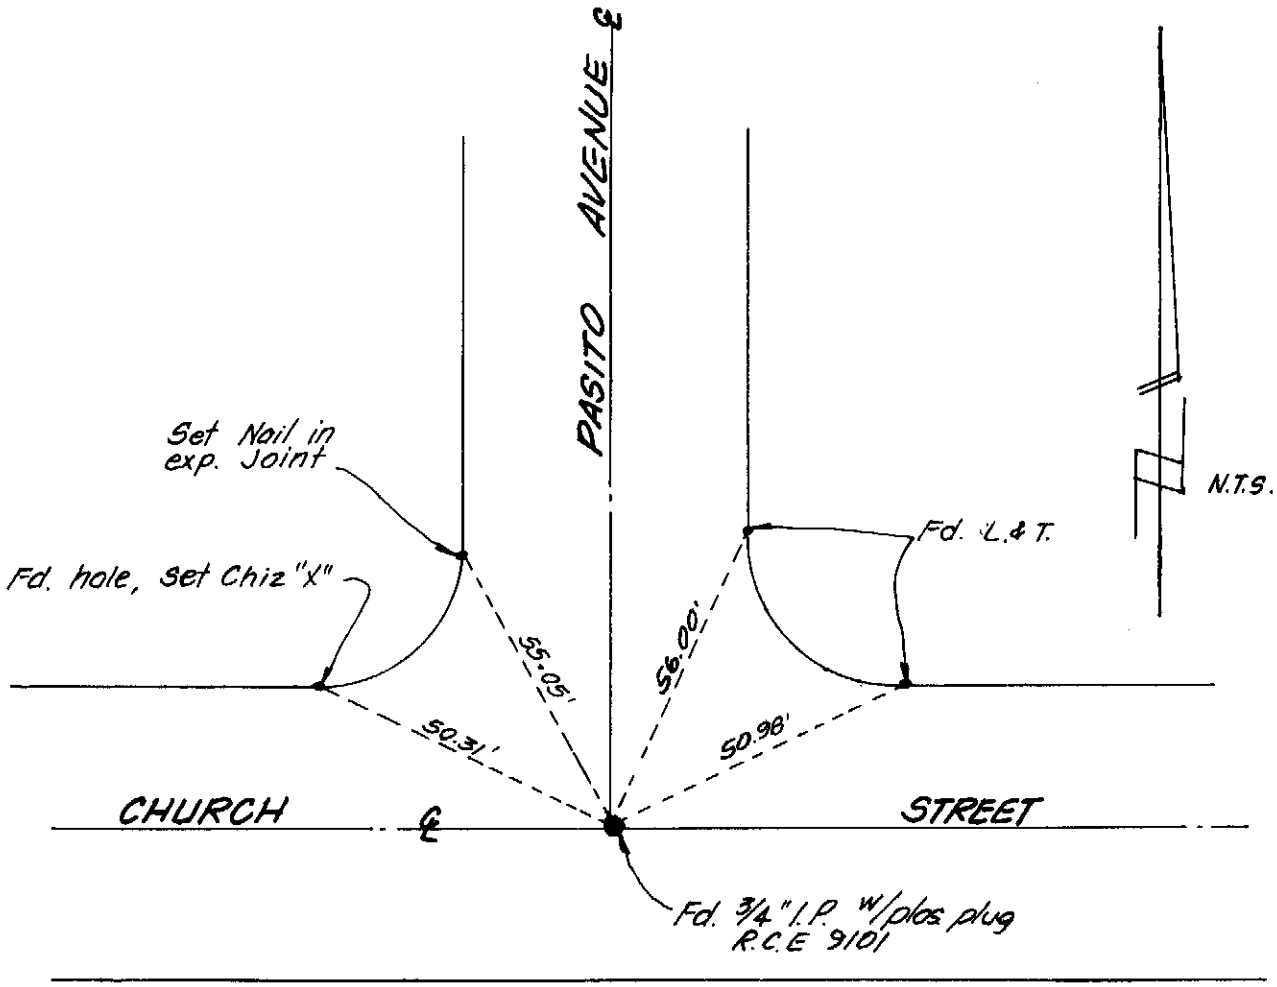

city of rancho cucamonga — STREET TIE	
LINVILLE-SANDERSON-HORN & ASSOC. 9587 ARROW ROUTE, SUITE "H" RANCHO, CUCAMONGA, CA. 91730	PASITO AVENUE & CHURCH STREET
L.S. G. SANDERSON	FIELD REVIEW _____ DATE _____
L.S. No. 4452 DATE 3/81	TIE BOOK 5 PAGE 12

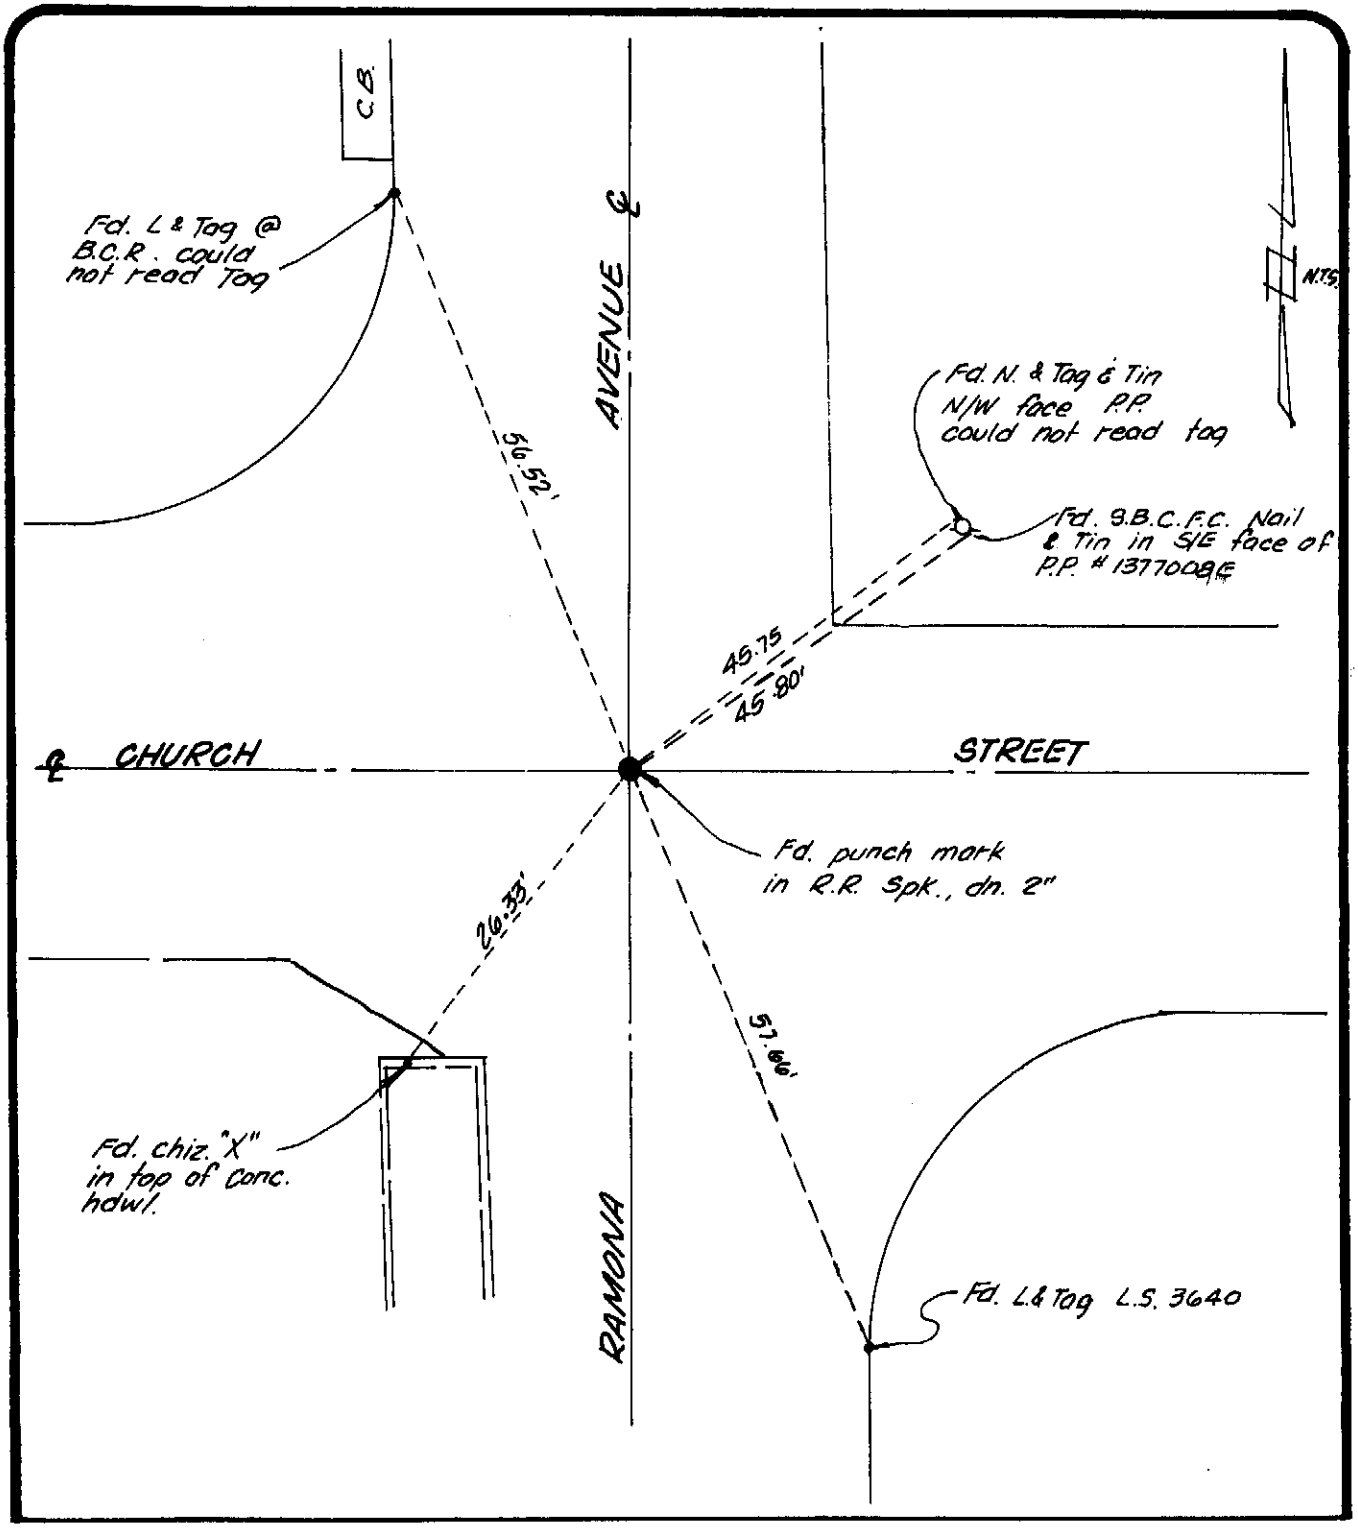

city of rancho cucamonga — STREET TIE	
LINVILLE-SANDERSON-HORN & ASSOC. 9587 ARROW ROUTE, SUITE "H" RANCHO CUCAMONGA, CA. 91730	CHURCH AVENUE AT RAMONA AVENUE
ENGR. / L.S. G. SANDERSON	FIELD REVIEW _____ DATE _____
R.C.E. / L.S. No. 4452 DATE 3/81	TIE BOOK 5 PAGE 13

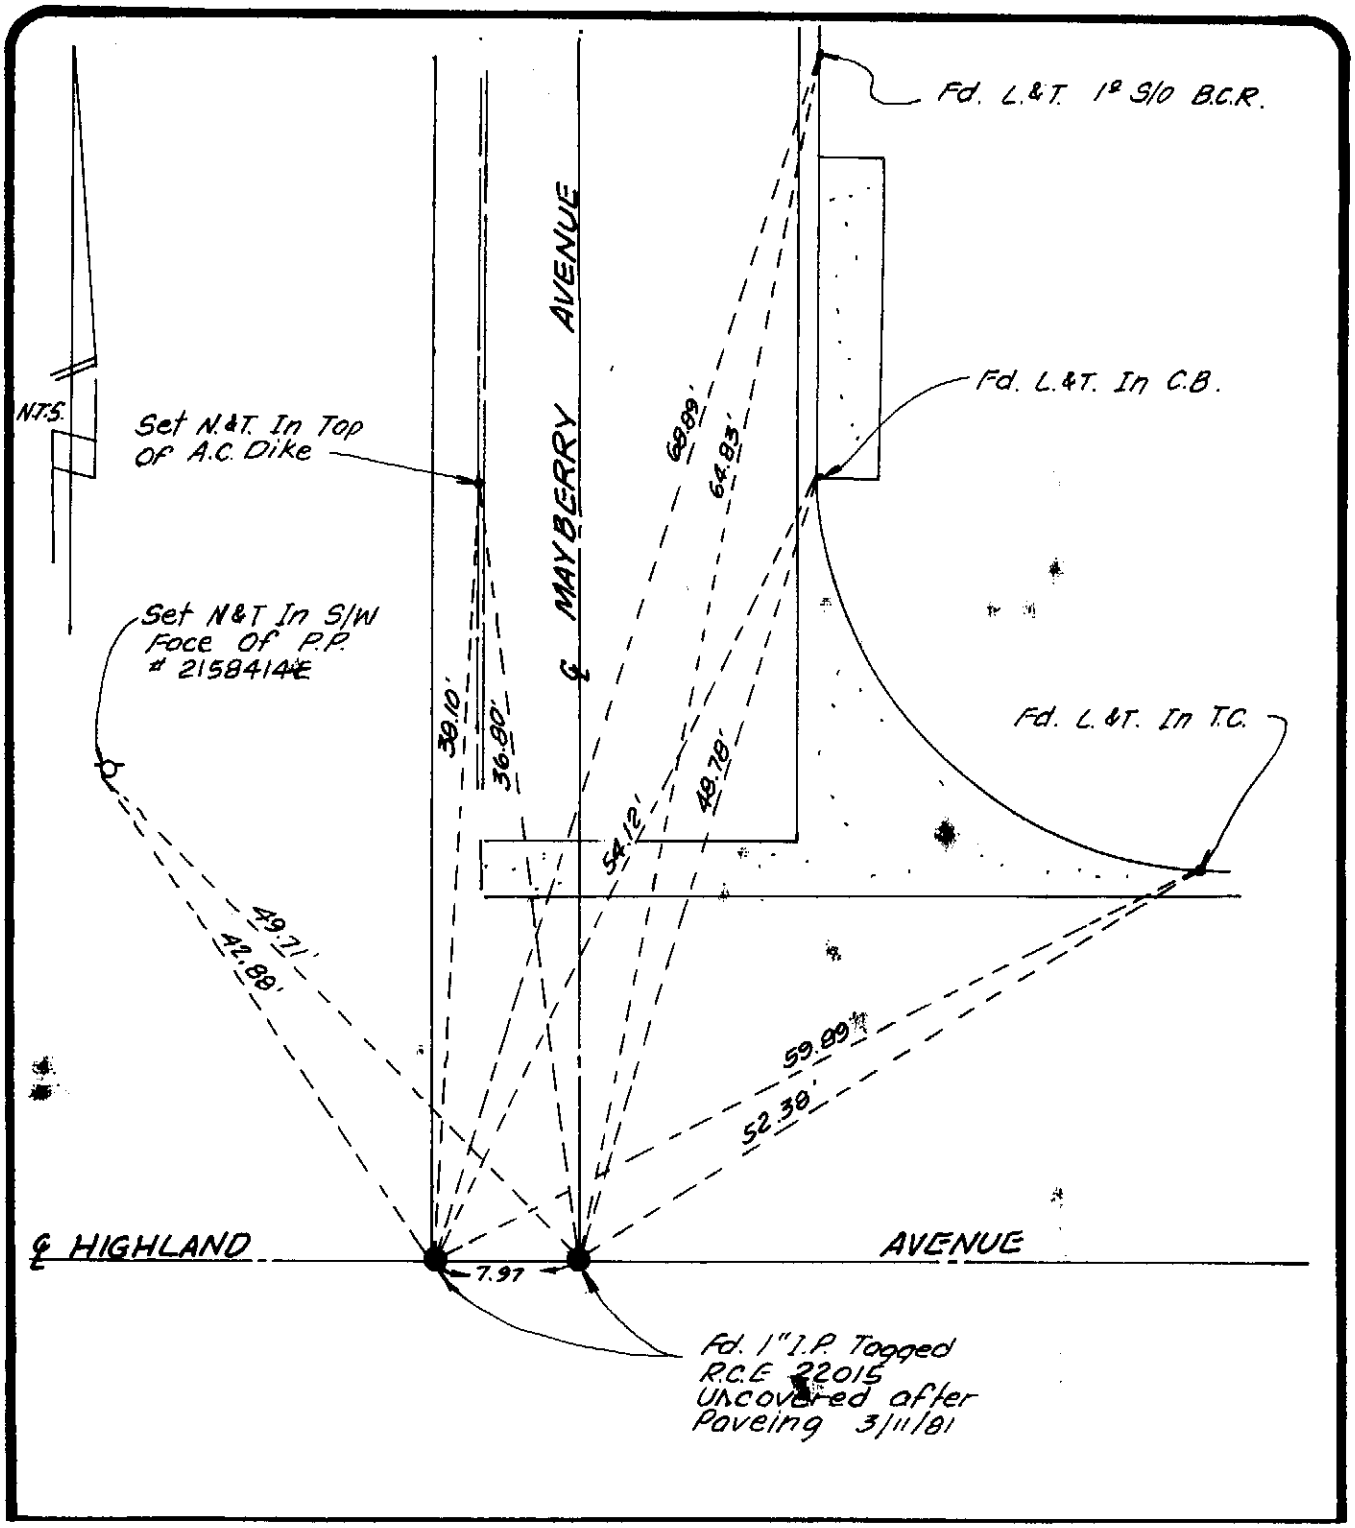

city of rancho cucamonga — STREET TIE	
LINVILLE-SANDERSON-HORN & ASSOC. 9587 ARROW ROUTE, SUITE "H" RANCHO CUCAMONGA, CA 91730	HIGHLAND AVENUE AT MAYBERRY AVENUE
L.S. G. SANDERSON	FIELD REVIEW _____ DATE _____
L.S. No. 4452 DATE 3/81	TIE BOOK 5 PAGE 14

Sheet 1 of 6
Date of Survey: Feb., 1981
Centerline Tie Notes for P.M. 5760
By: Joseph B. Hyde "RCE 12491"

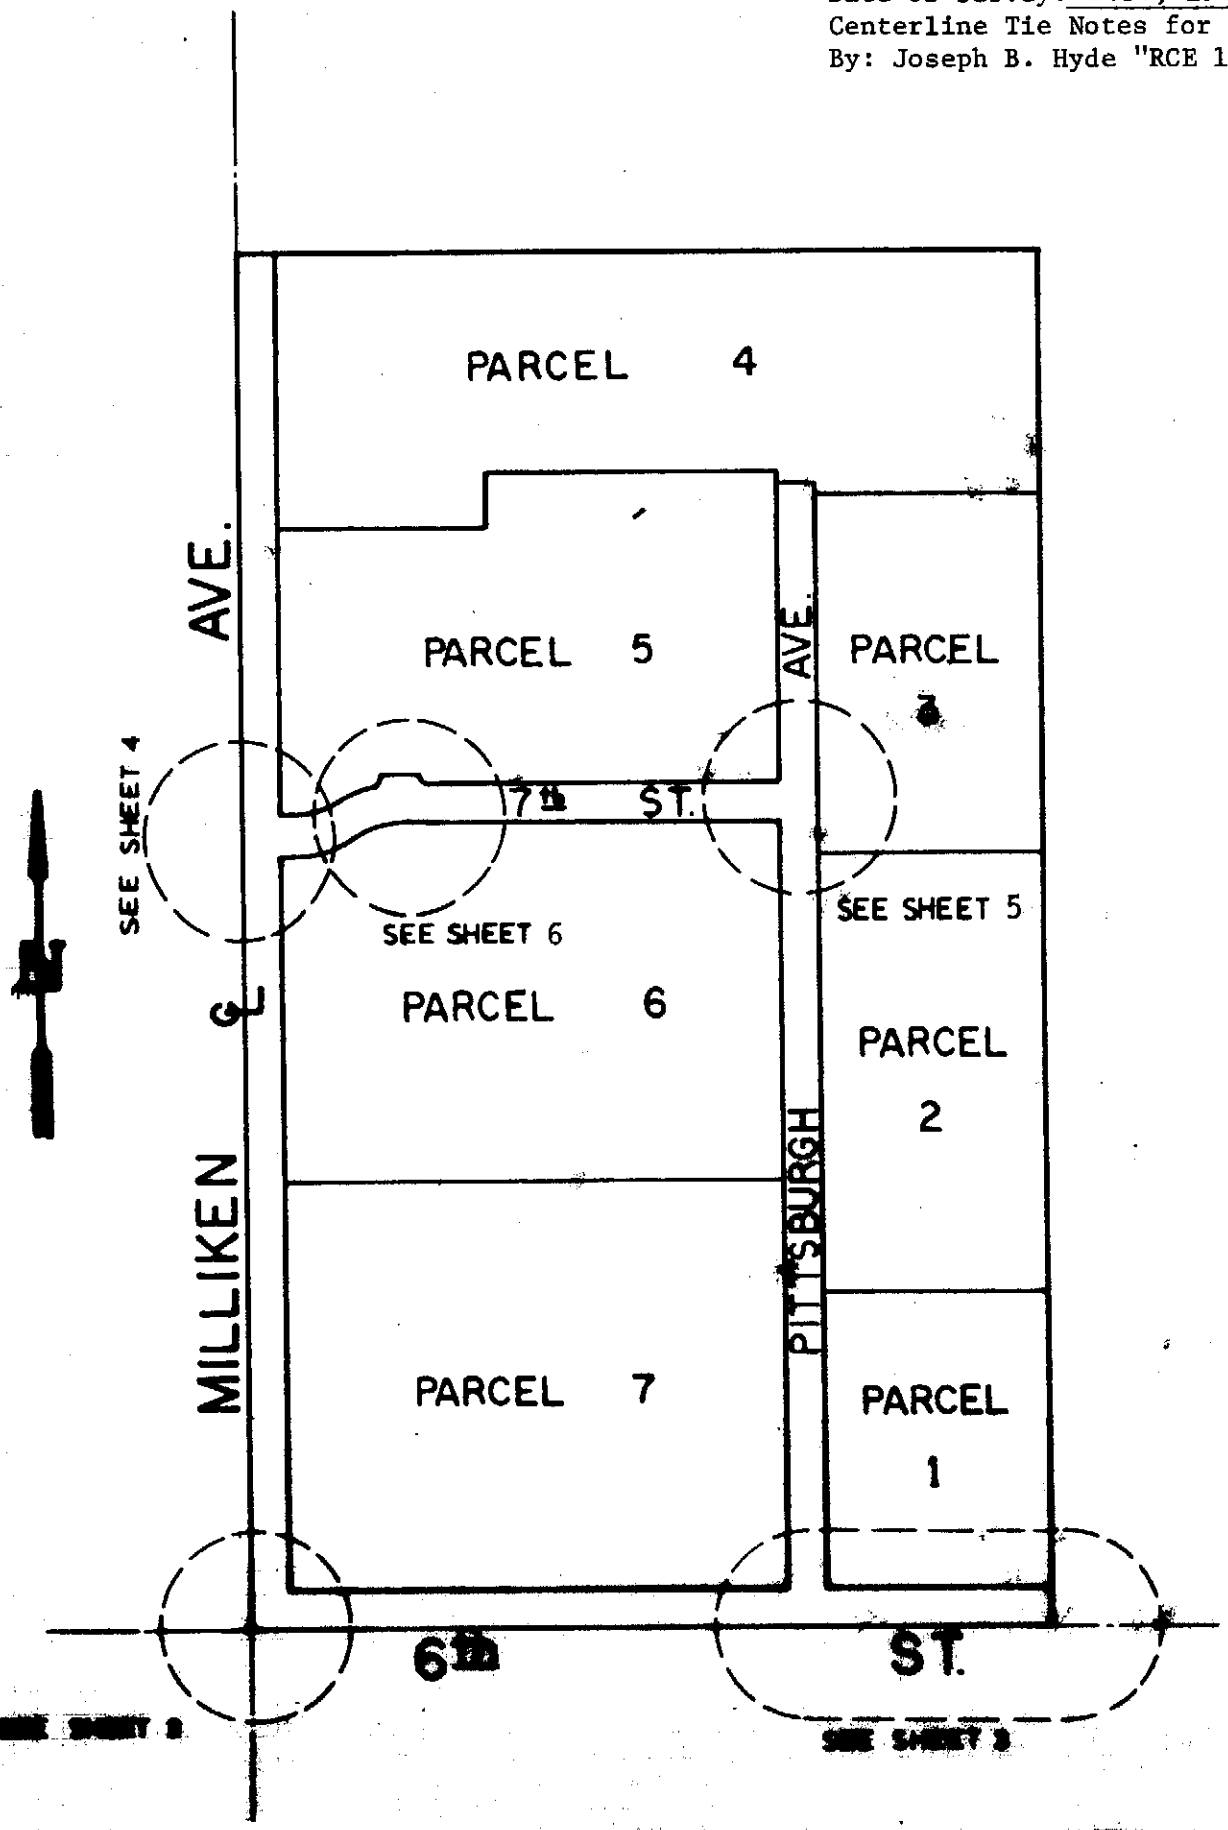

BK 5 PG 15

Sheet 2 of 6
Date of Survey: Feb., 1981
Centerline Tie Notes for P.M. 5760
By: Joseph B. Hyde "RCE 12491"

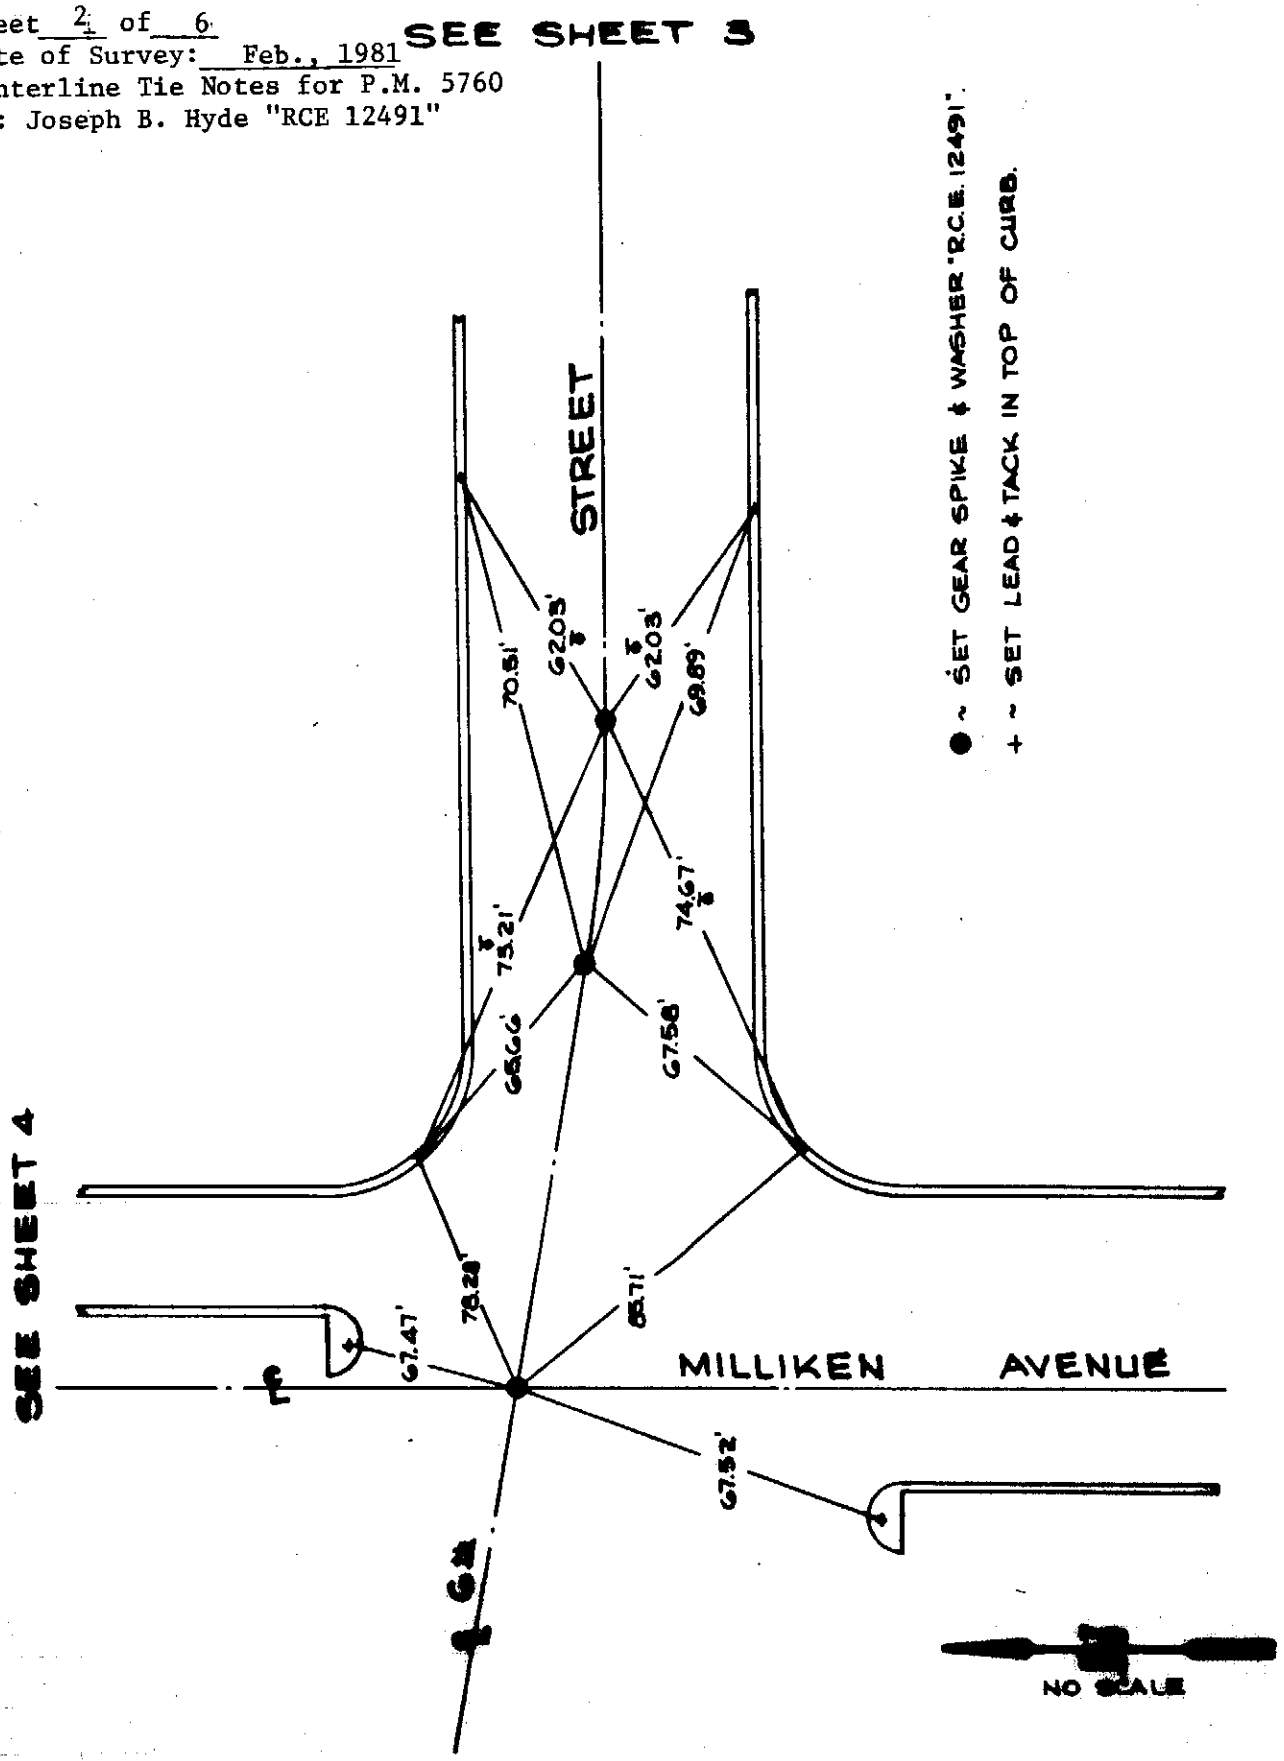

BK 5 PG 16

Sheet 3 of 6
Date of Survey: Feb., 1981
Centerline Tie Notes for P.M. 5760
By: Joseph B. Hyde "RCE 12491"

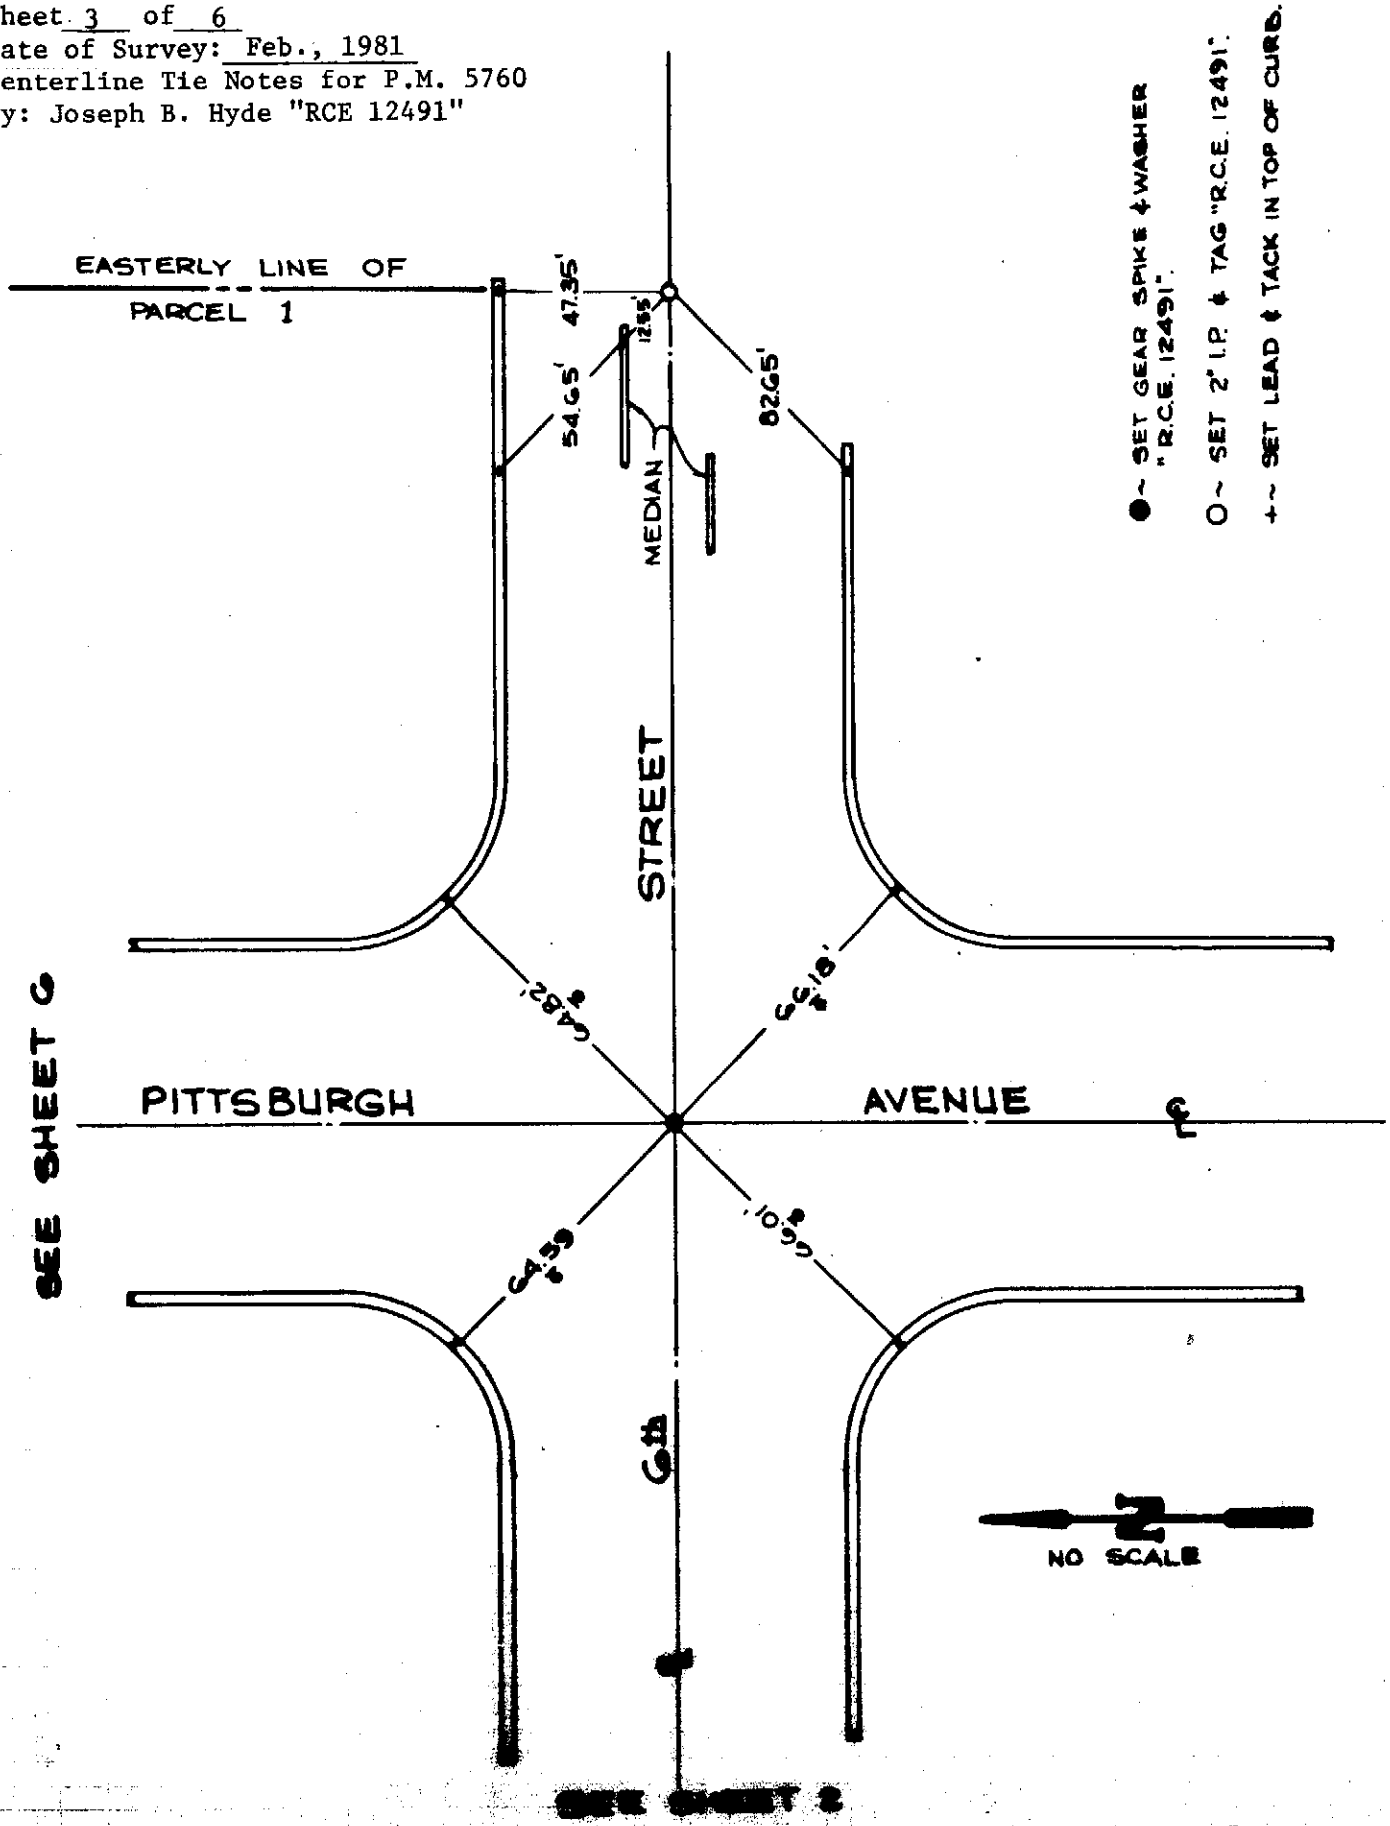

●~ SET GEAR SPIKE & WASHER "R.C.E. 12491".
O~ SET 2" I.P. & TAG "R.C.E. 12491".
+~ SET LEAD & TACK IN TOP OF CURB.

Date of Survey: Feb., 1981
Centerline Tie Notes for P.M. 5760
By: Joseph B. Hyde "RCE 12491"

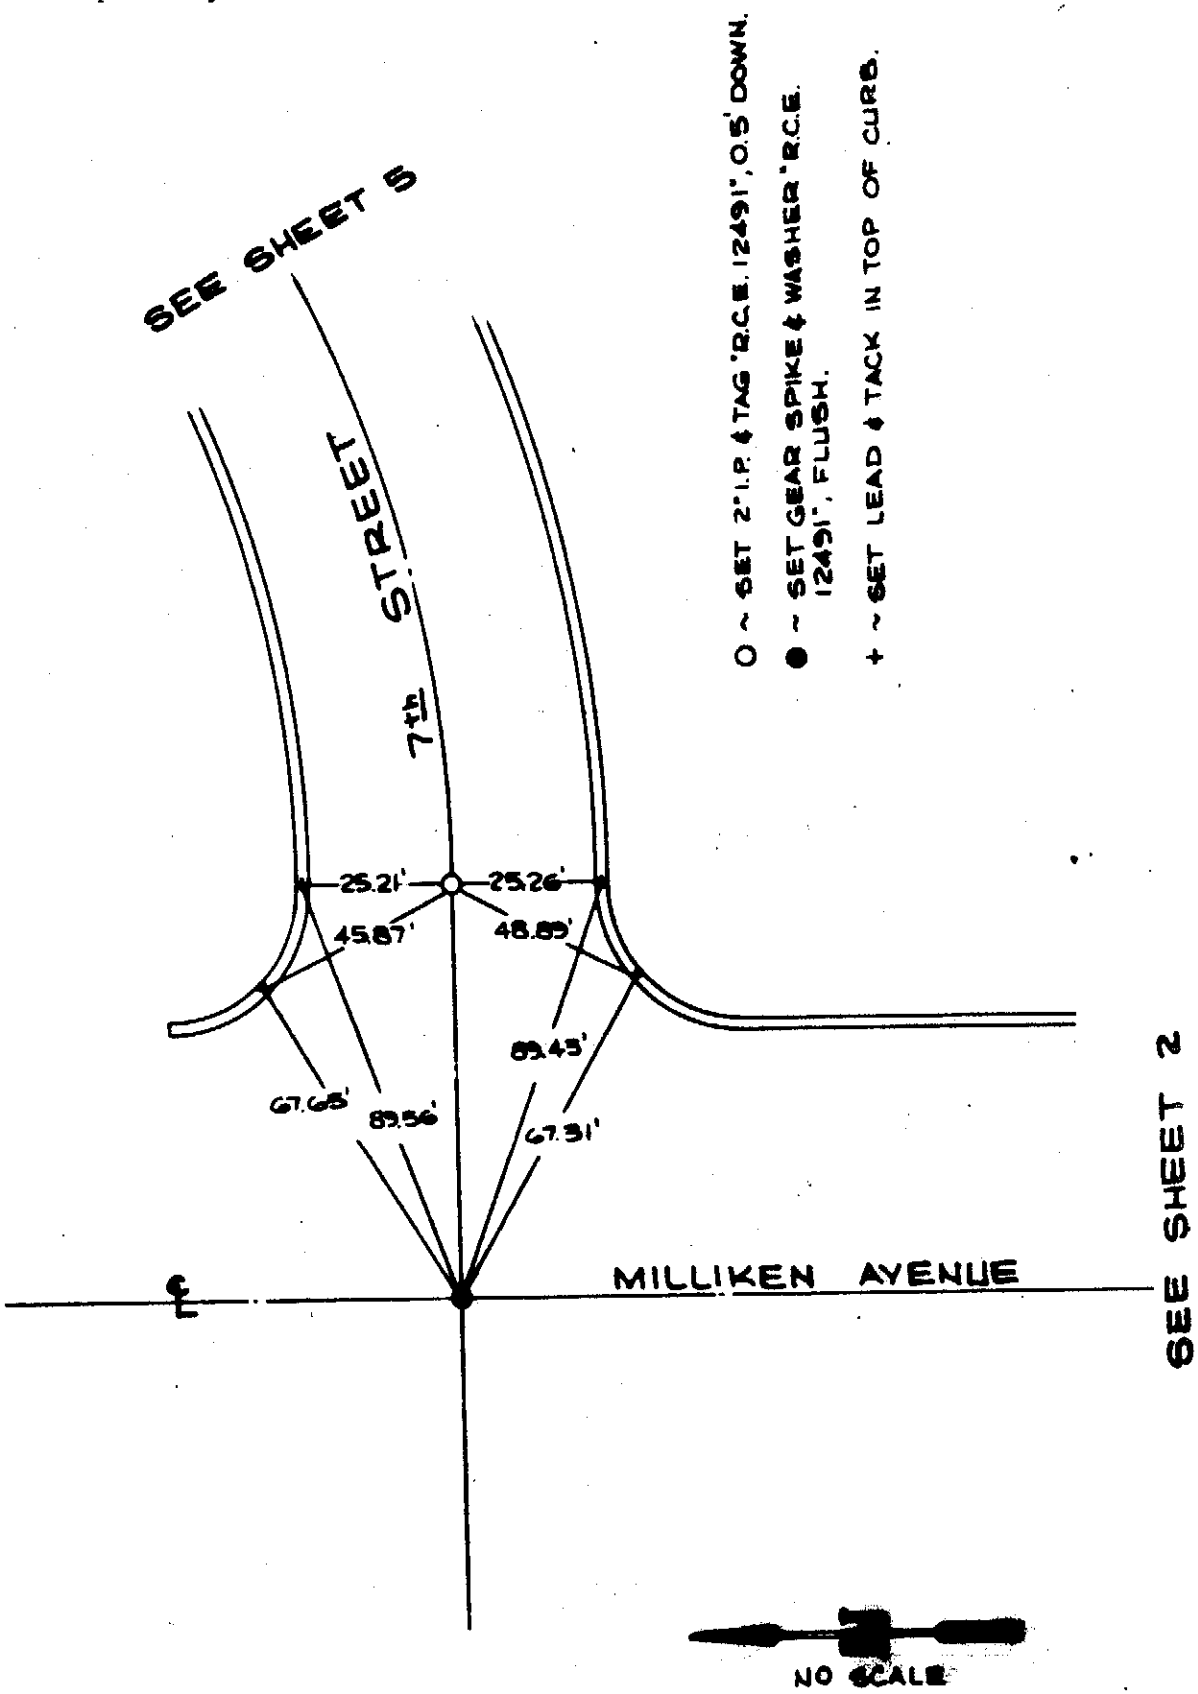

NO SCALE

BK 5 PG 18

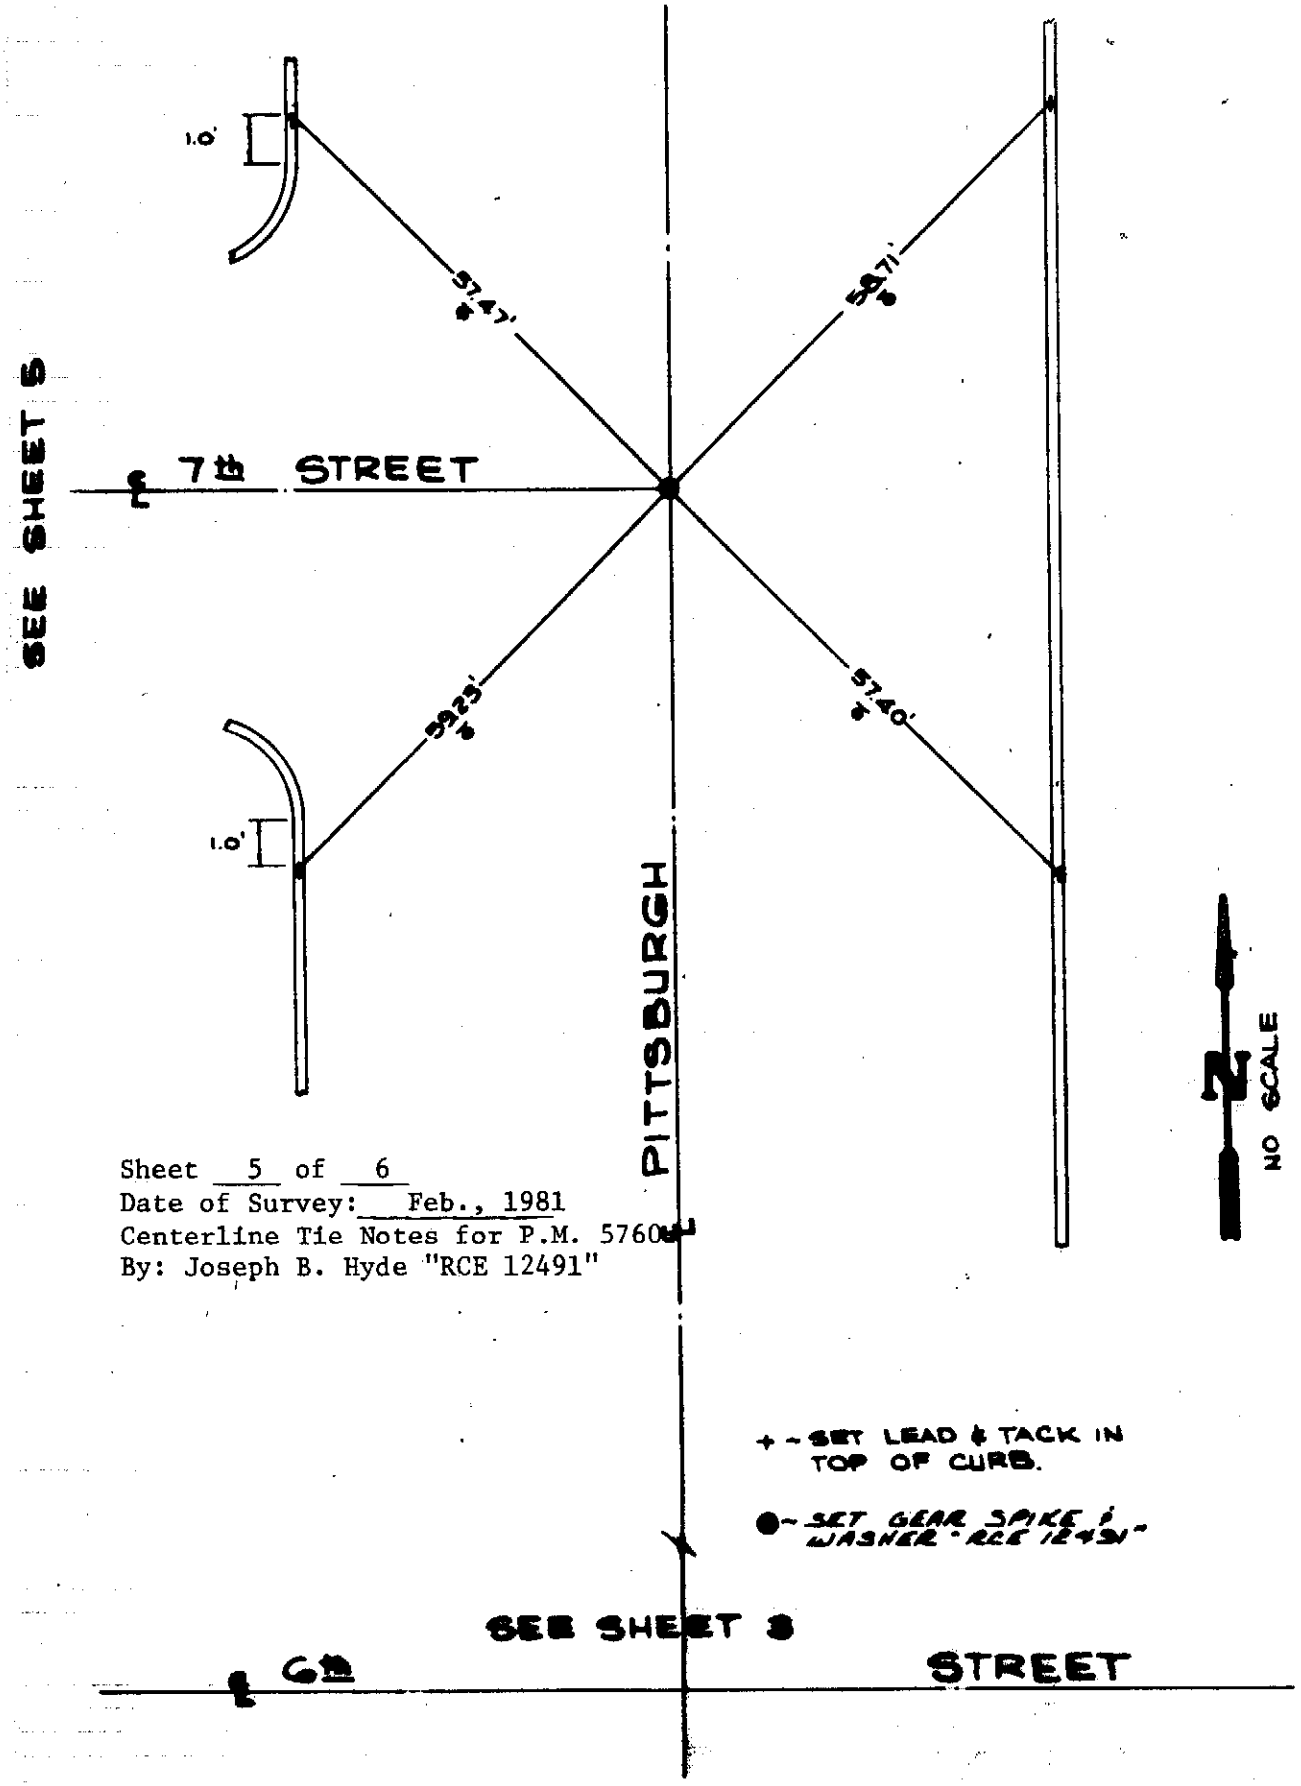

Sheet 5 of 6
Date of Survey: Feb., 1981
Centerline Tie Notes for P.M. 5760
By: Joseph B. Hyde "RCE 12491"

Sheet 6 of 6
Date of Survey: Feb., 1981
Centerline Tie Notes for P.M. 5760
By: Joseph B. Hyde "RCE 12491"

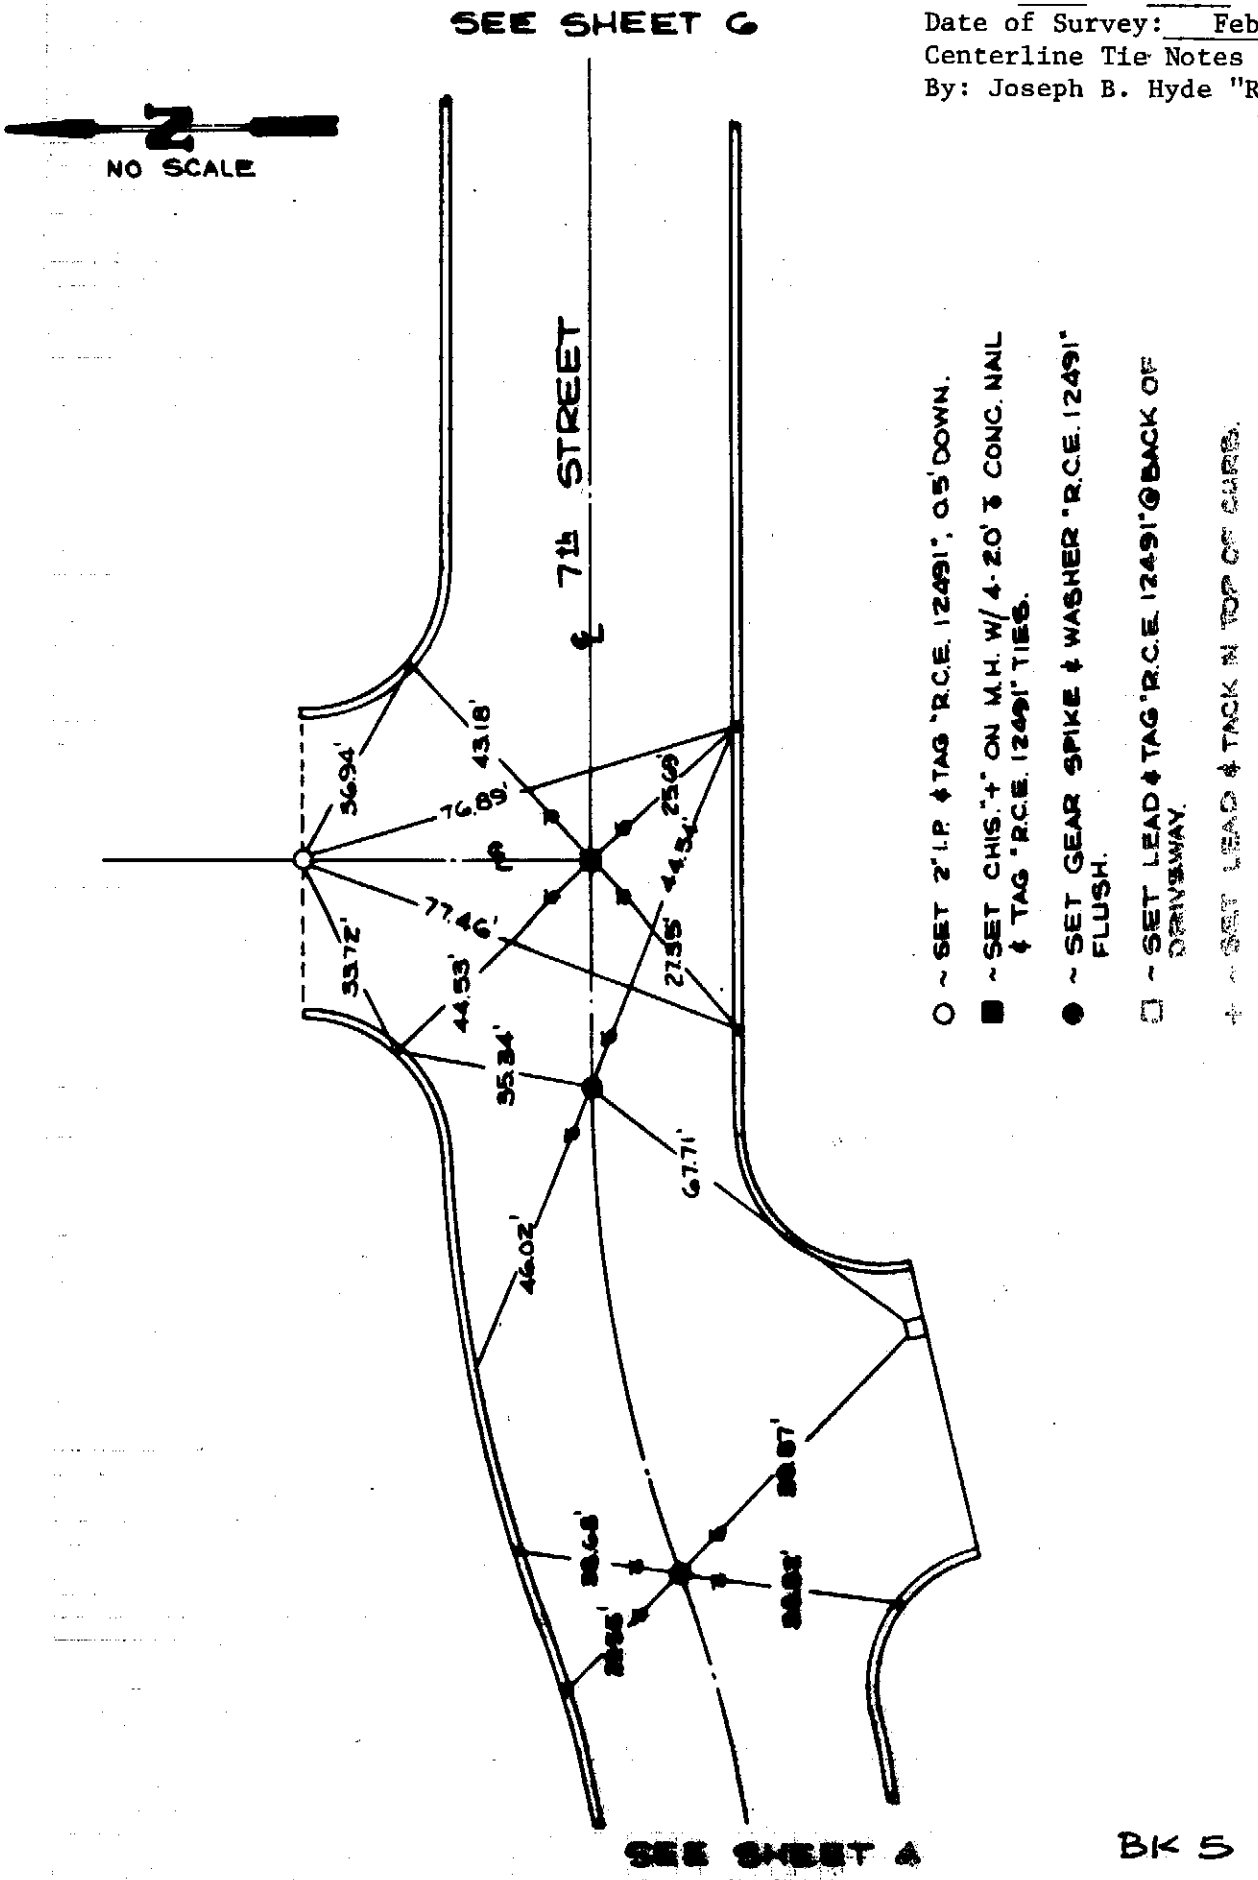

BK 5 PG 20

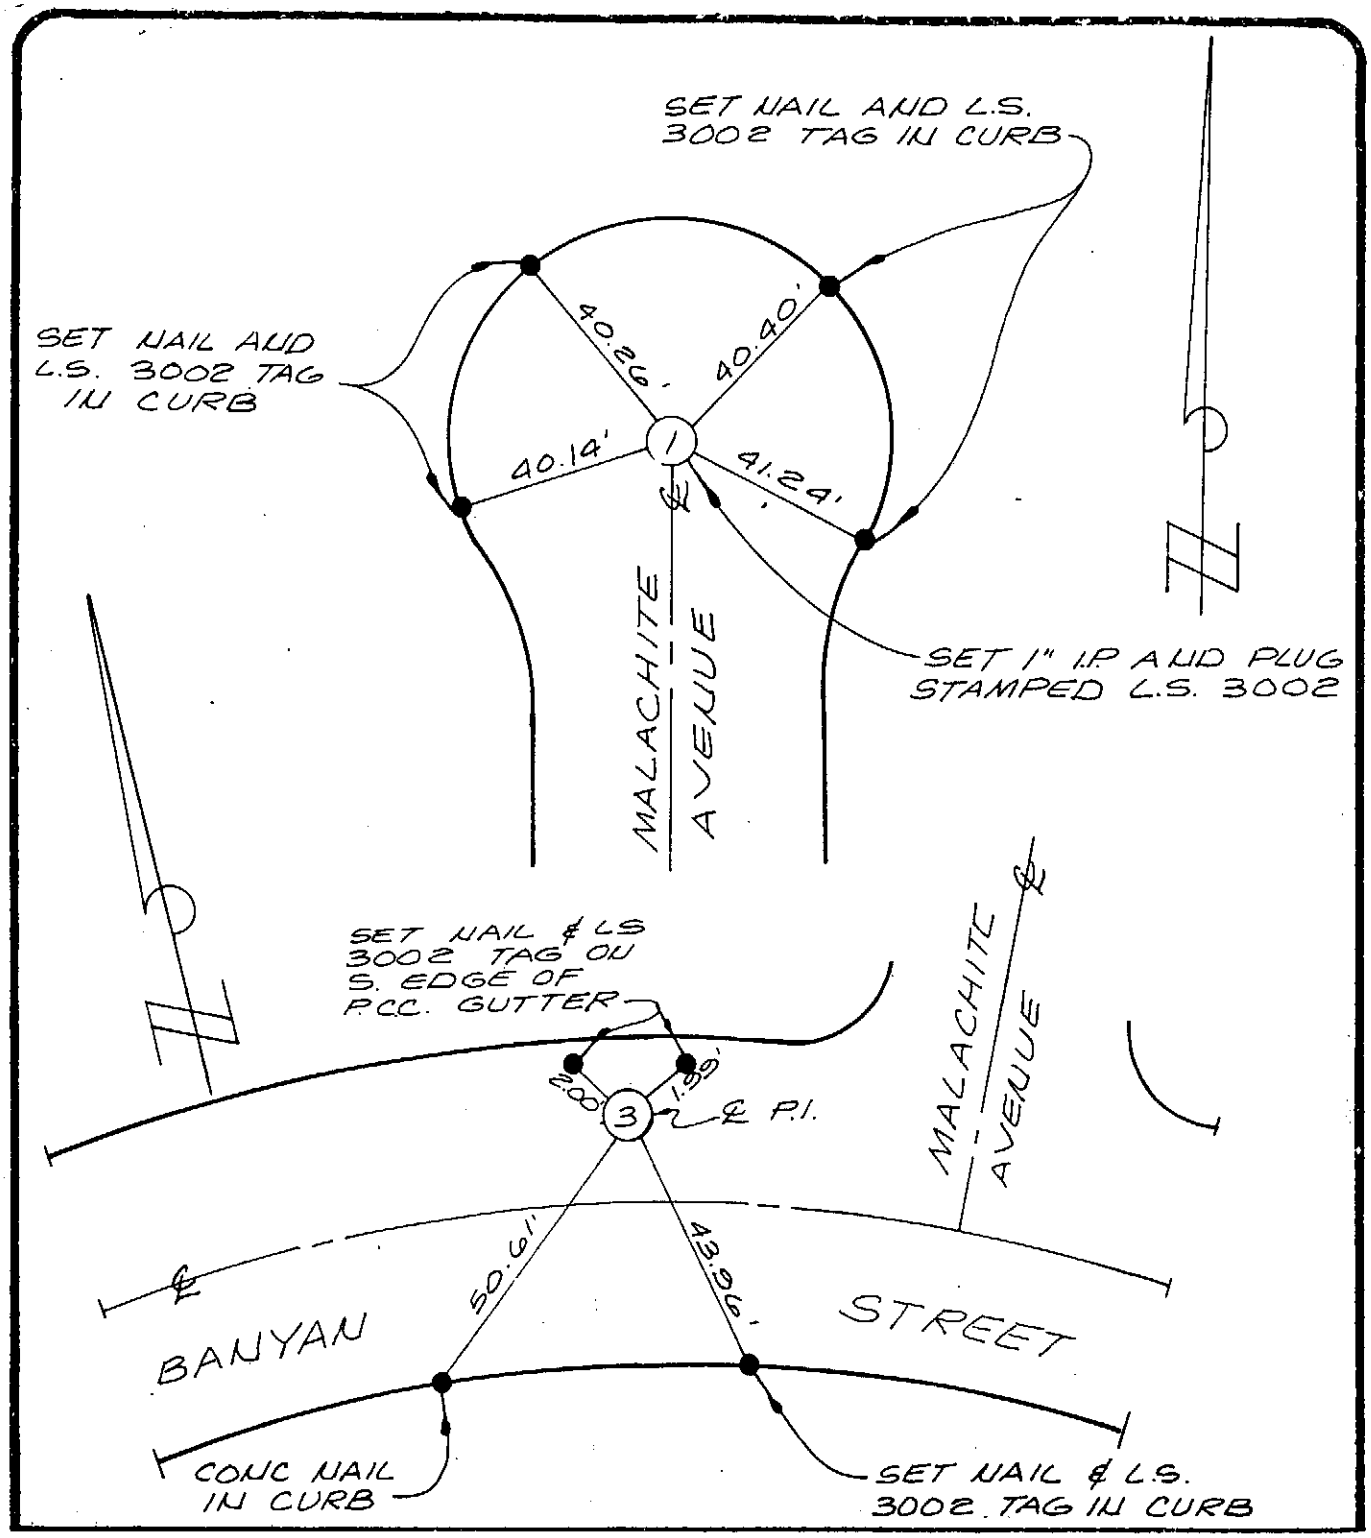

city of rancho cucamonga — STREET TIE	TRACT No. 9444
ASSOCIATED ENGINEERS 316 EAST E STREET ONTARIO, CA. 91764 (714) 986-5818	1 - ℄ RADIUS POINT OF MALACHITE CUL DE SAC. 3 - ℄ P.I. ON BANYON STREET 300' EAST OF AMETHYST ST.
L.S. L.H. NOREEN	FIELD REVIEW _____ DATE _____
L.S. No. 3002 DATE NOV. '80	TIE BOOK 5 PAGE 21

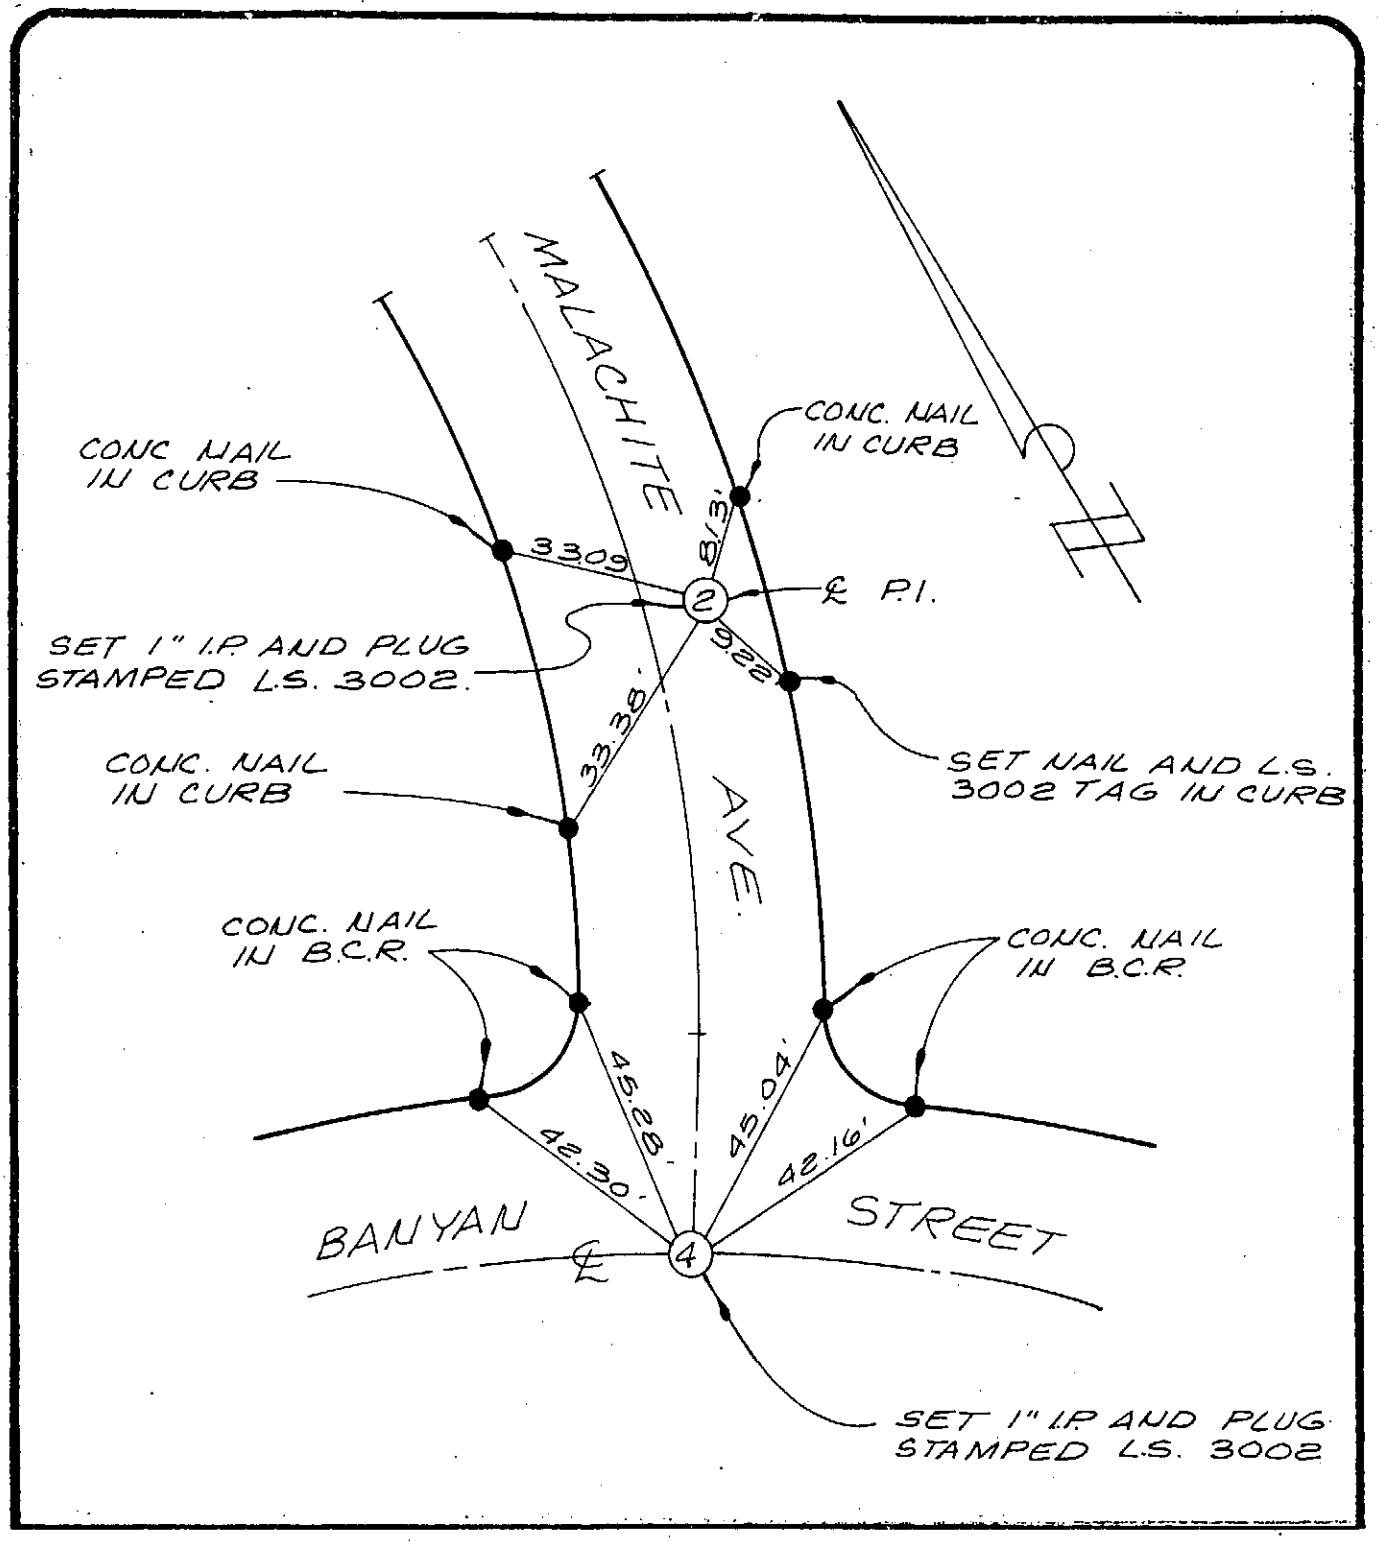

city of rancho cucamonga — STREET TIE	TRACT No. 9444
ASSOCIATED ENGINEERS 316 EAST E STREET ONTARIO, CA. 91764 (714) 986-5818	2 - ℄ P.I. ON MALACHITE AVE., 100' NORTH OF BANYON 4 - ℄ INT. OF BANYAN STREET AND MALACHITE CUL-DE-SAC
L.S. L.H. NOREEN	FIELD REVIEW _____ DATE _____
L.S. No. 3002 DATE NOV. '80	TIE BOOK 5 PAGE 22

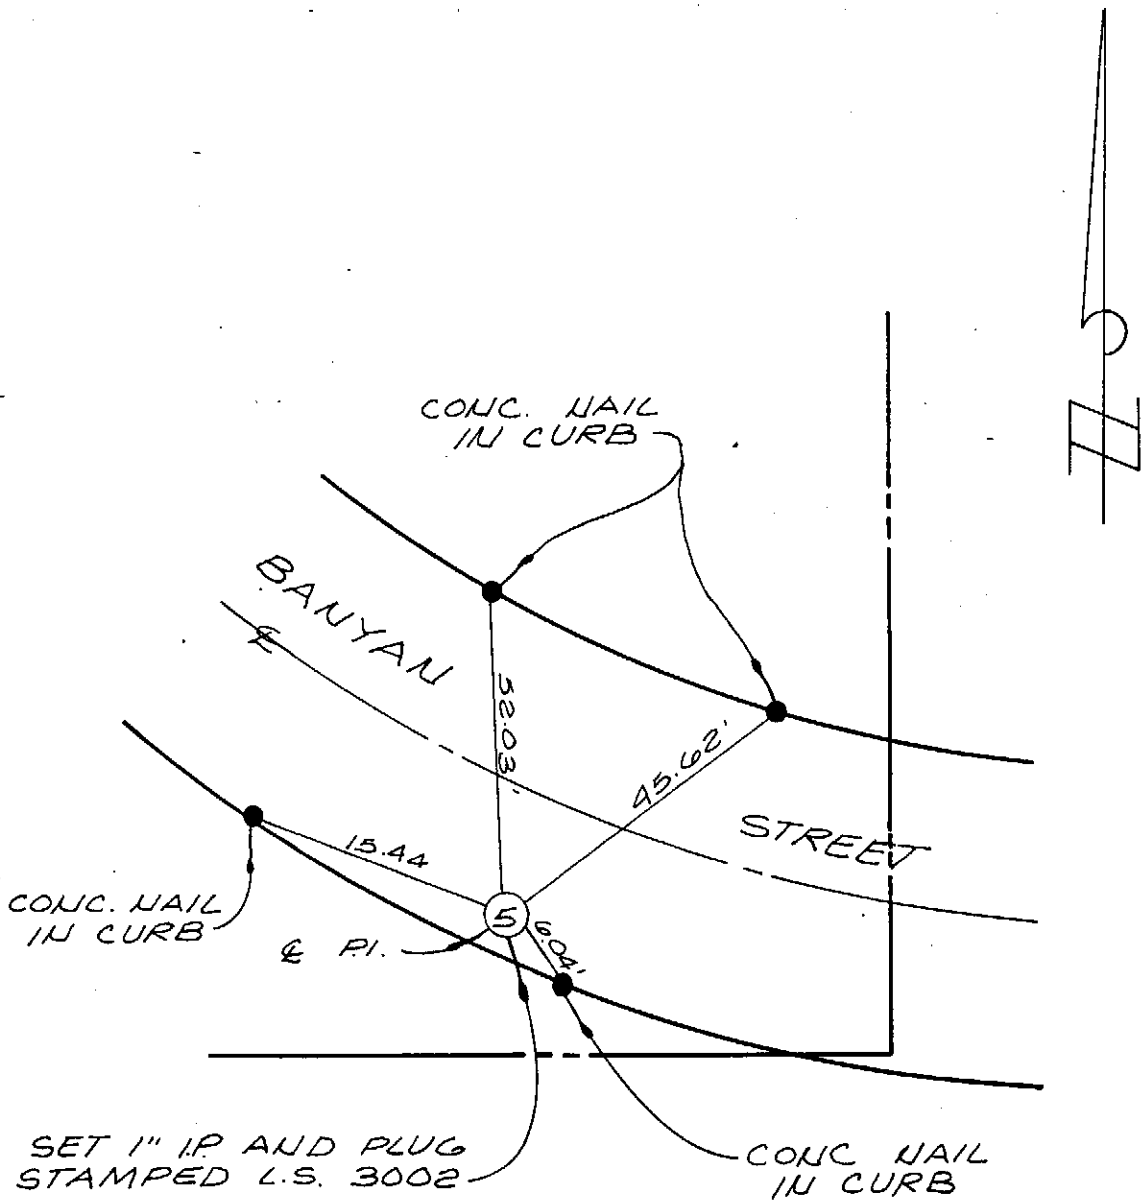

city of rancho cucamonga — STREET TIE	TRACT No. 9444
ASSOCIATED ENGINEERS 316 EAST E STREET ONTARIO, CA. 91764 (714) 986-5818	5 - ℄ P.I. BANYAN STREET, 600'± EAST OF AMETHYST STREET.
L.S. L.H. NOREEN	FIELD REVIEW _____ DATE _____
L.S. No. 3002 DATE NOV. '60	TIE BOOK 5 PAGE 23

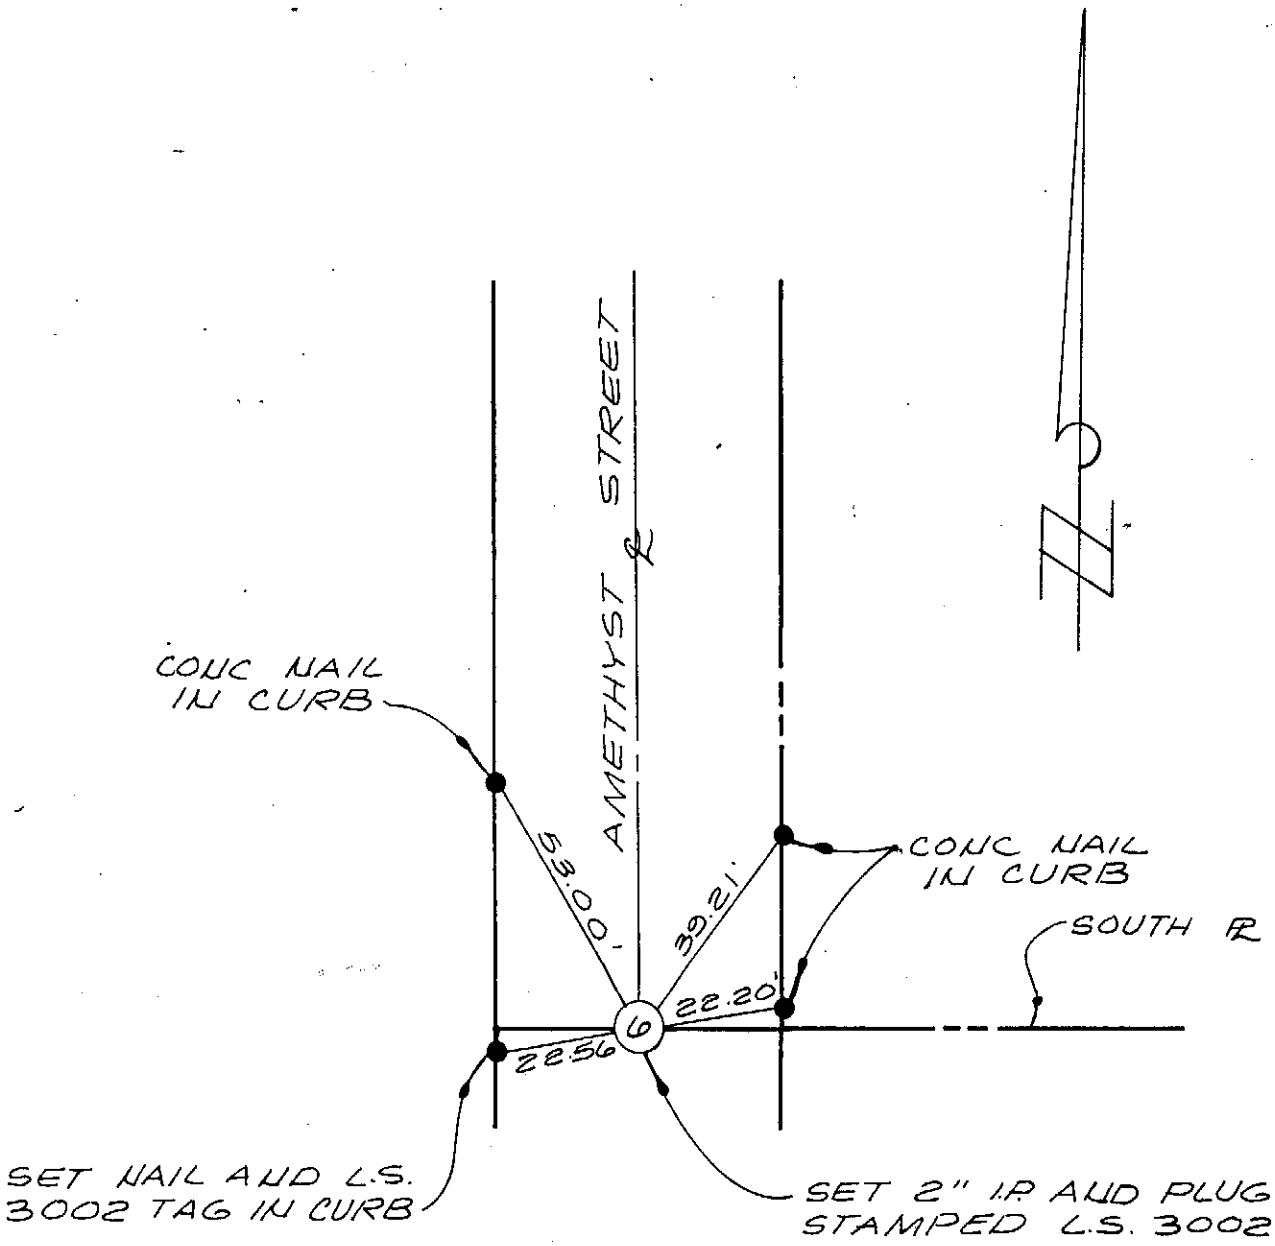

city of rancho cucamonga — STREET TIE	TRACT No. 9444
ASSOCIATED ENGINEERS 316 EAST E STREET ONTARIO, CA. 91764 (714) 986-5818	6 - INT OF SOUTH TR. BDRY. & ℄ OF AMETHYST STREET
L.S. L.H. NOREEN	FIELD REVIEW _____ DATE _____
L.S. No. 3002 DATE NOV '80	TIE BOOK 5 PAGE 24

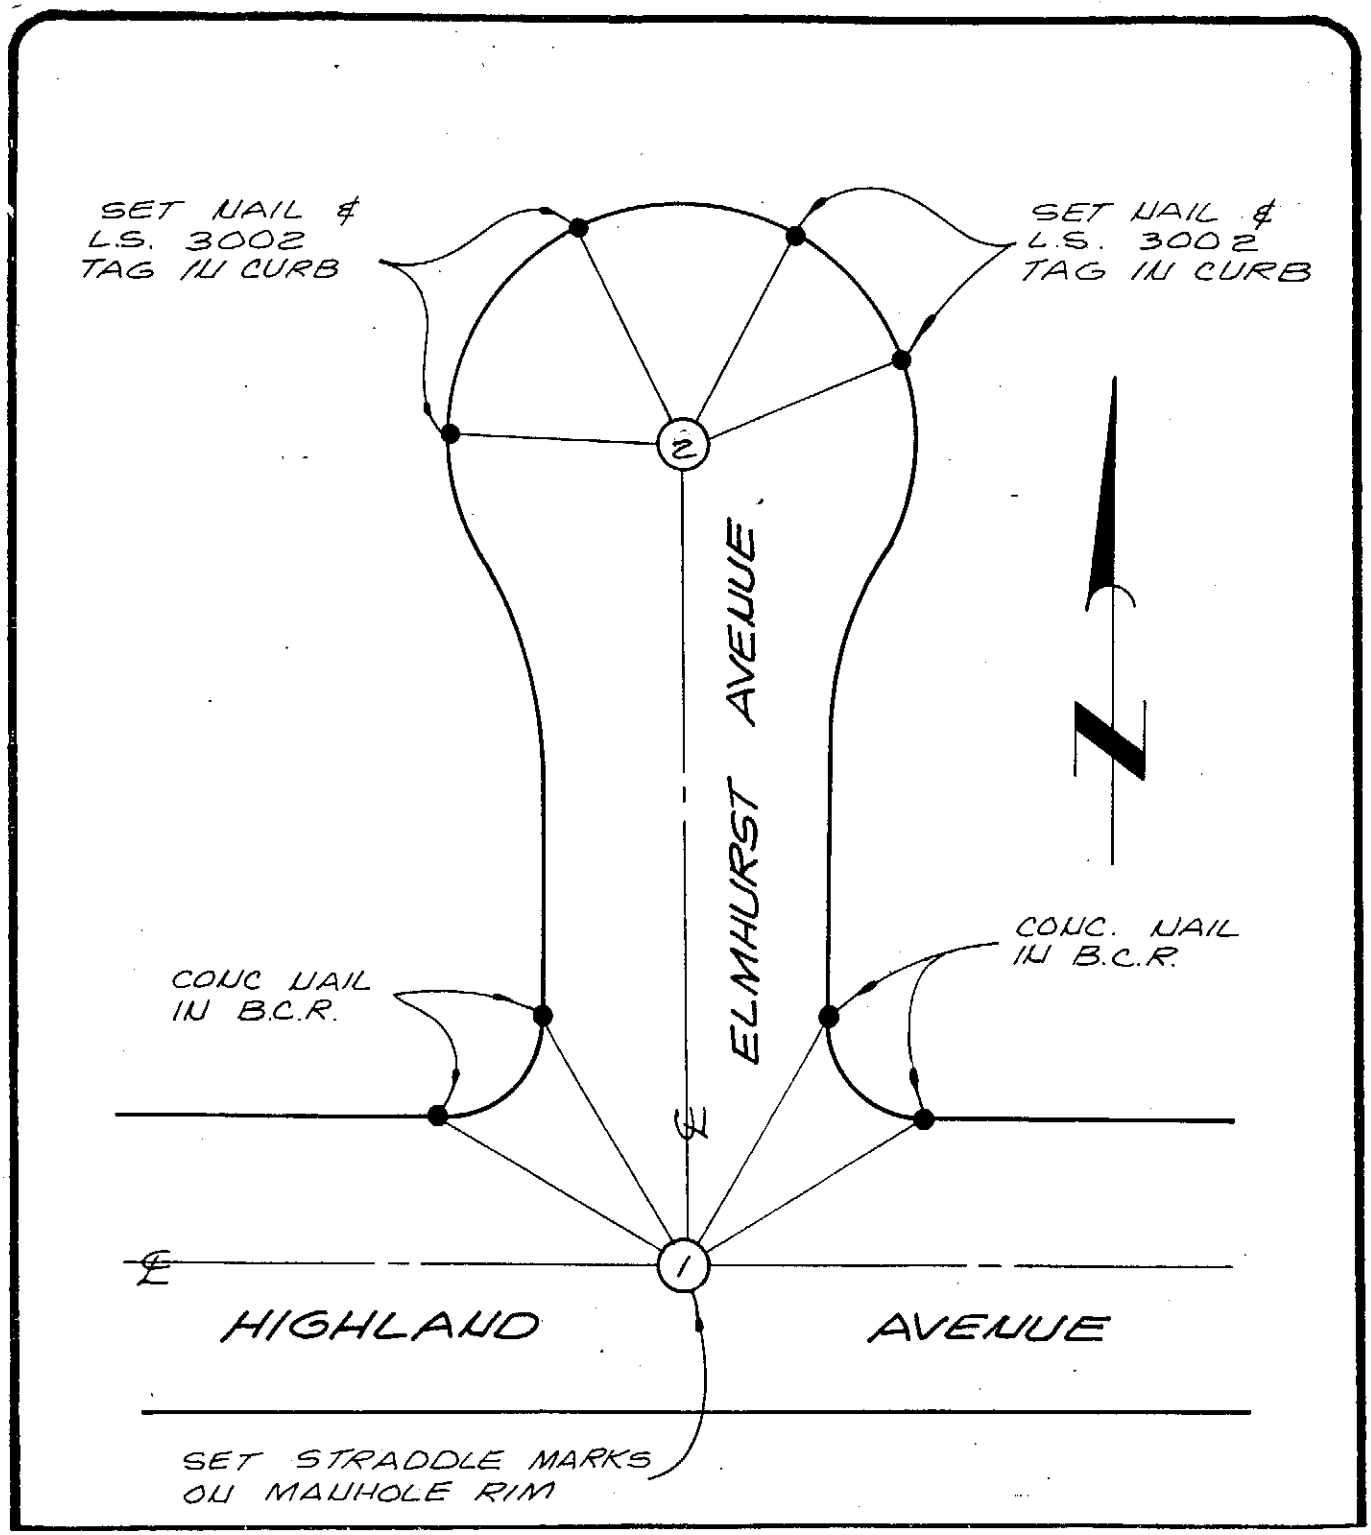

city of rancho cucamonga — STREET TIE	TRACT No. 9567
ASSOCIATED ENGINEERS 316 EAST E STREET ONTARIO, CA. 91764 (714) 986-5818	1 - ℄ INT OF HIGHLAND AVE. AND ELMHURST AVENUE CUL-DE-SAC. 2 - RADIUS POINT OF ELMHURST AVE CUL-DE-SAC
L.S. L.H. NOREEN	FIELD REVIEW _____ DATE _____
L.S. No. 3002 DATE 9/1/81	TIE BOOK 5 PAGE 25

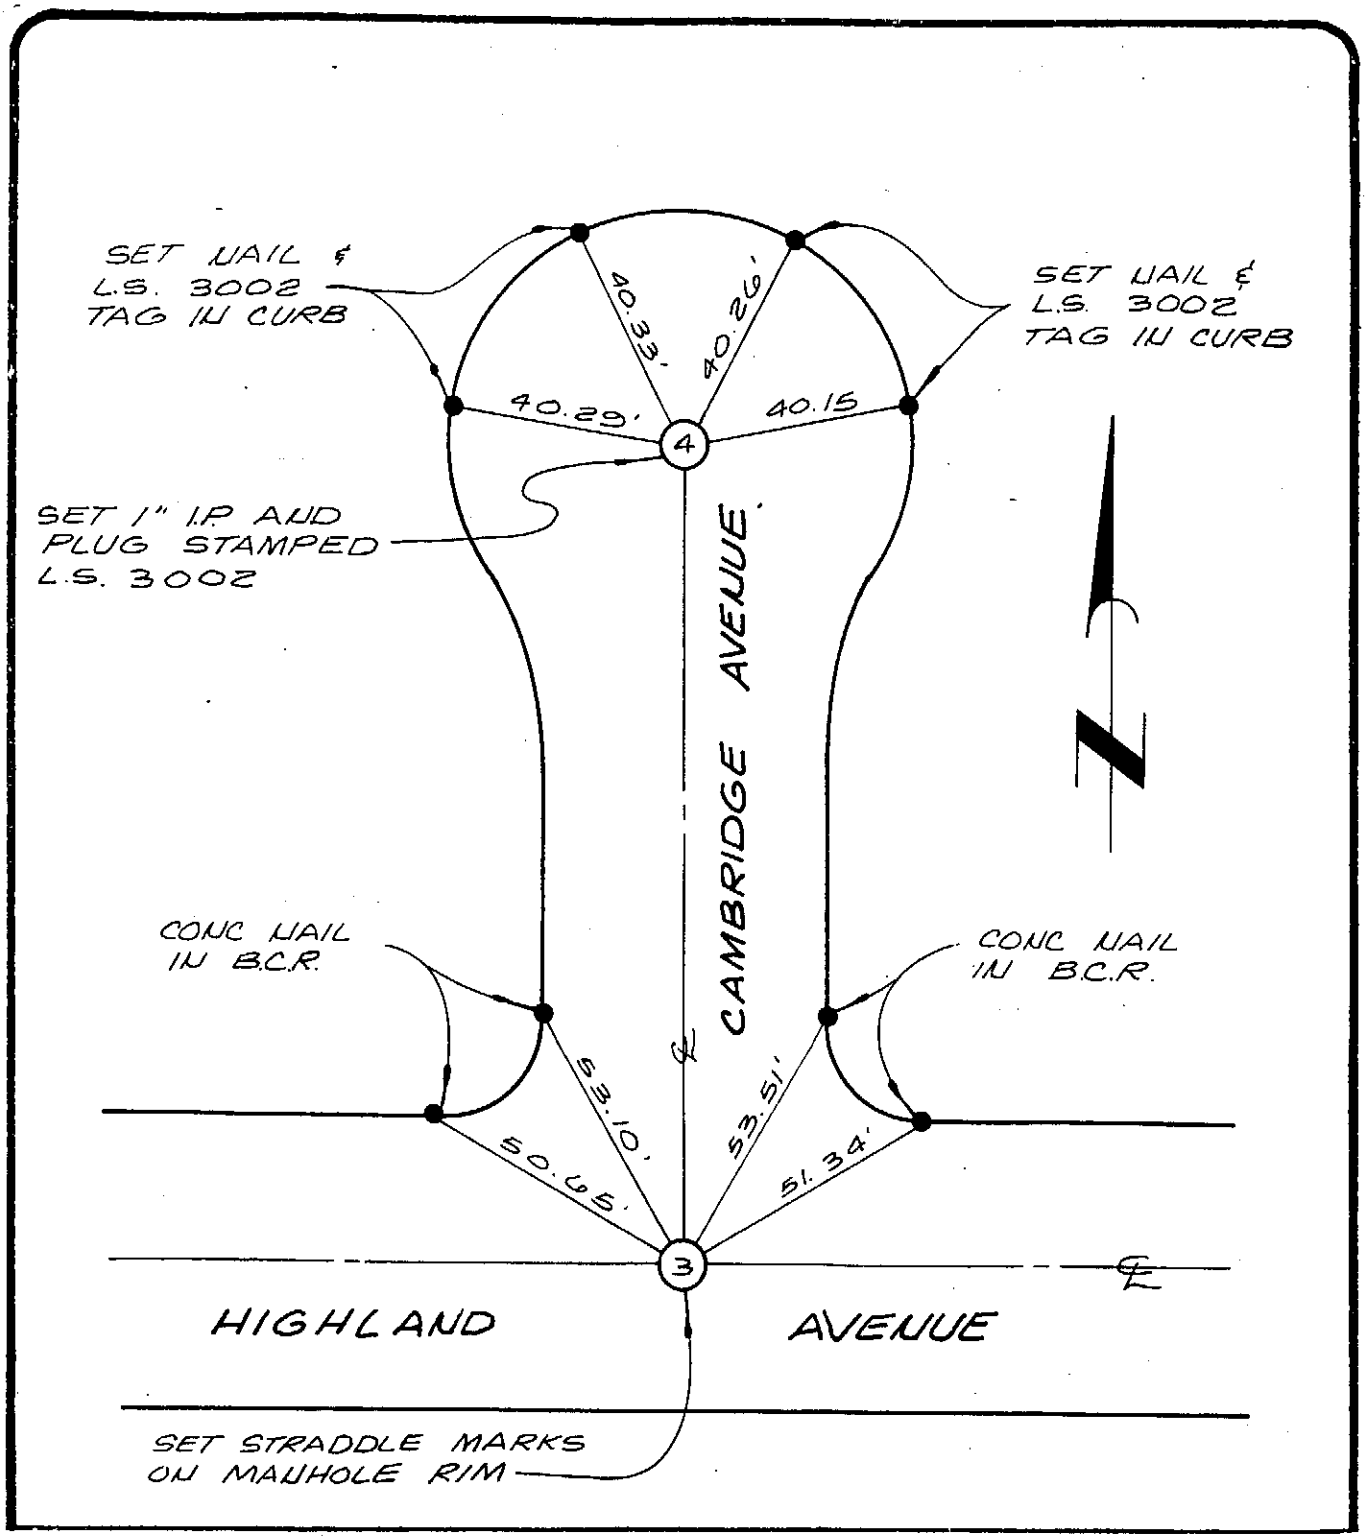

city of rancho cucamonga — STREET TIE	TRACT No. 9567
ASSOCIATED ENGINEERS 316 EAST E STREET ONTARIO, CA. 91764 (714) 986-5818	3 - ℄ INT. OF HIGHLAND AVE. AND CAMBRIDGE AVENUE CUL-DE-SAC 4 - RADIUS POINT OF CAMBRIDGE AVE CUL-DE-SAC.
L.S. L.H. NOREEN	FIELD REVIEW _____ DATE _____
L.S. No. 3002 DATE 9/1/81	TIE BOOK 5 PAGE 26

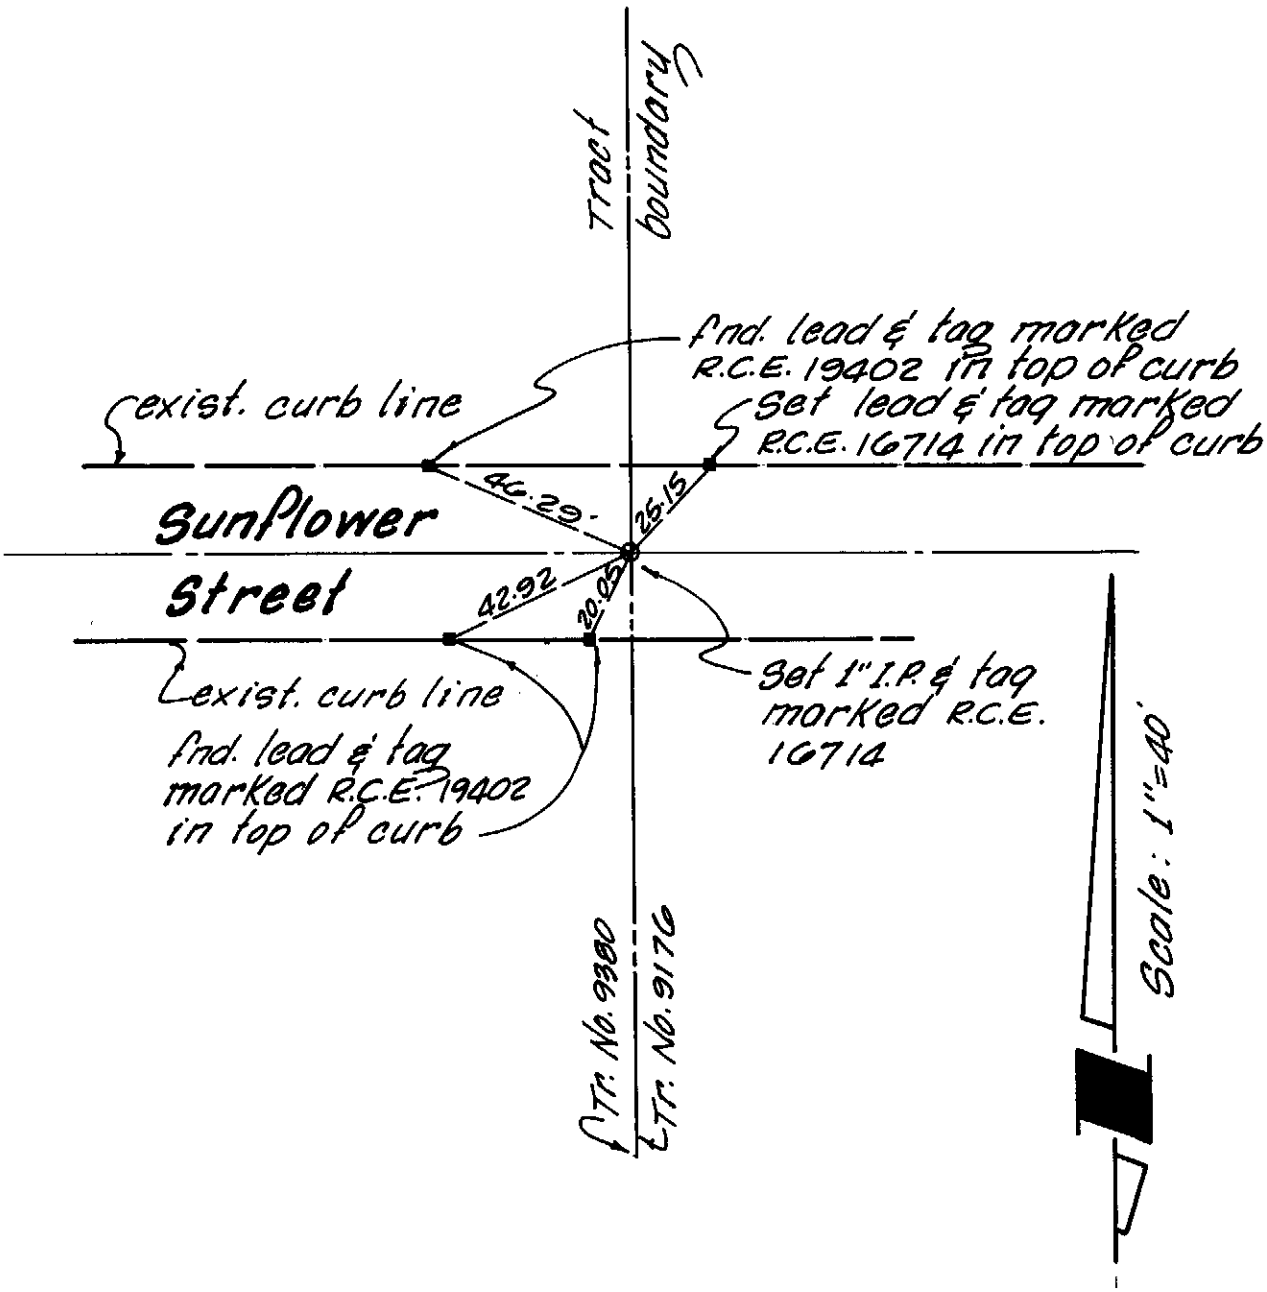

City of Rancho Cucamonga Street tie	Tract No. 9176
Nelson Engineering 2545 E. Chapman #115 Fullerton, Ca., 92631 (714) 870-1962	SunFlower Street at W. Tract Boundary
George D. Nelson	Field Review: _____ Date: _____
R.C.E. 16714 Date 5-22-81	Tie Book 5 Page: 27

Scale: 1" = 40'

■ Indicates set lead & tag marked R.C.E. 16714 in top of curb.
○ Indicates set 1" I.P. & tag marked R.C.E. 16714

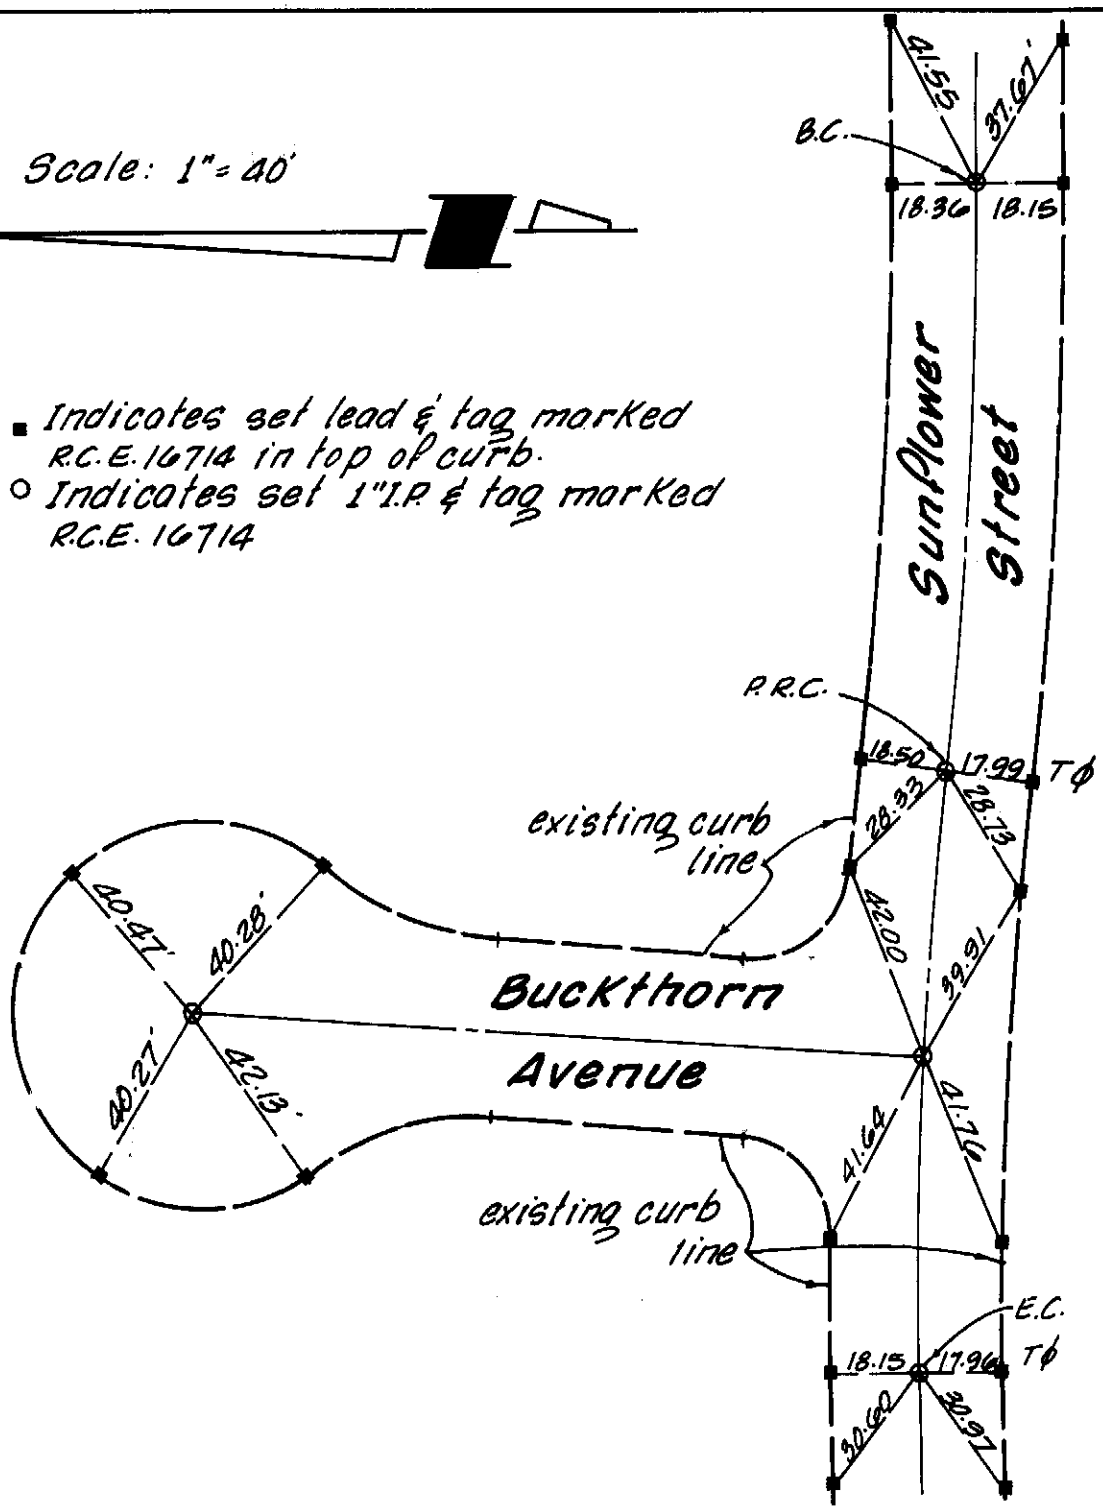

City of Rancho Cucamonga Street Tie	Tract No. 9176
Nelson Engineering 2545 E. Chapman #115 Fullerton, Ca., 92631 (714) 870-1962	SunFlower Street at Buckthorn Avenue & SunFlower Street
George L. Nelson	Field Review: _____ Date: _____
R.C.E. 16714 Date: 5-22-81	Tie Book: 5 Page: 28

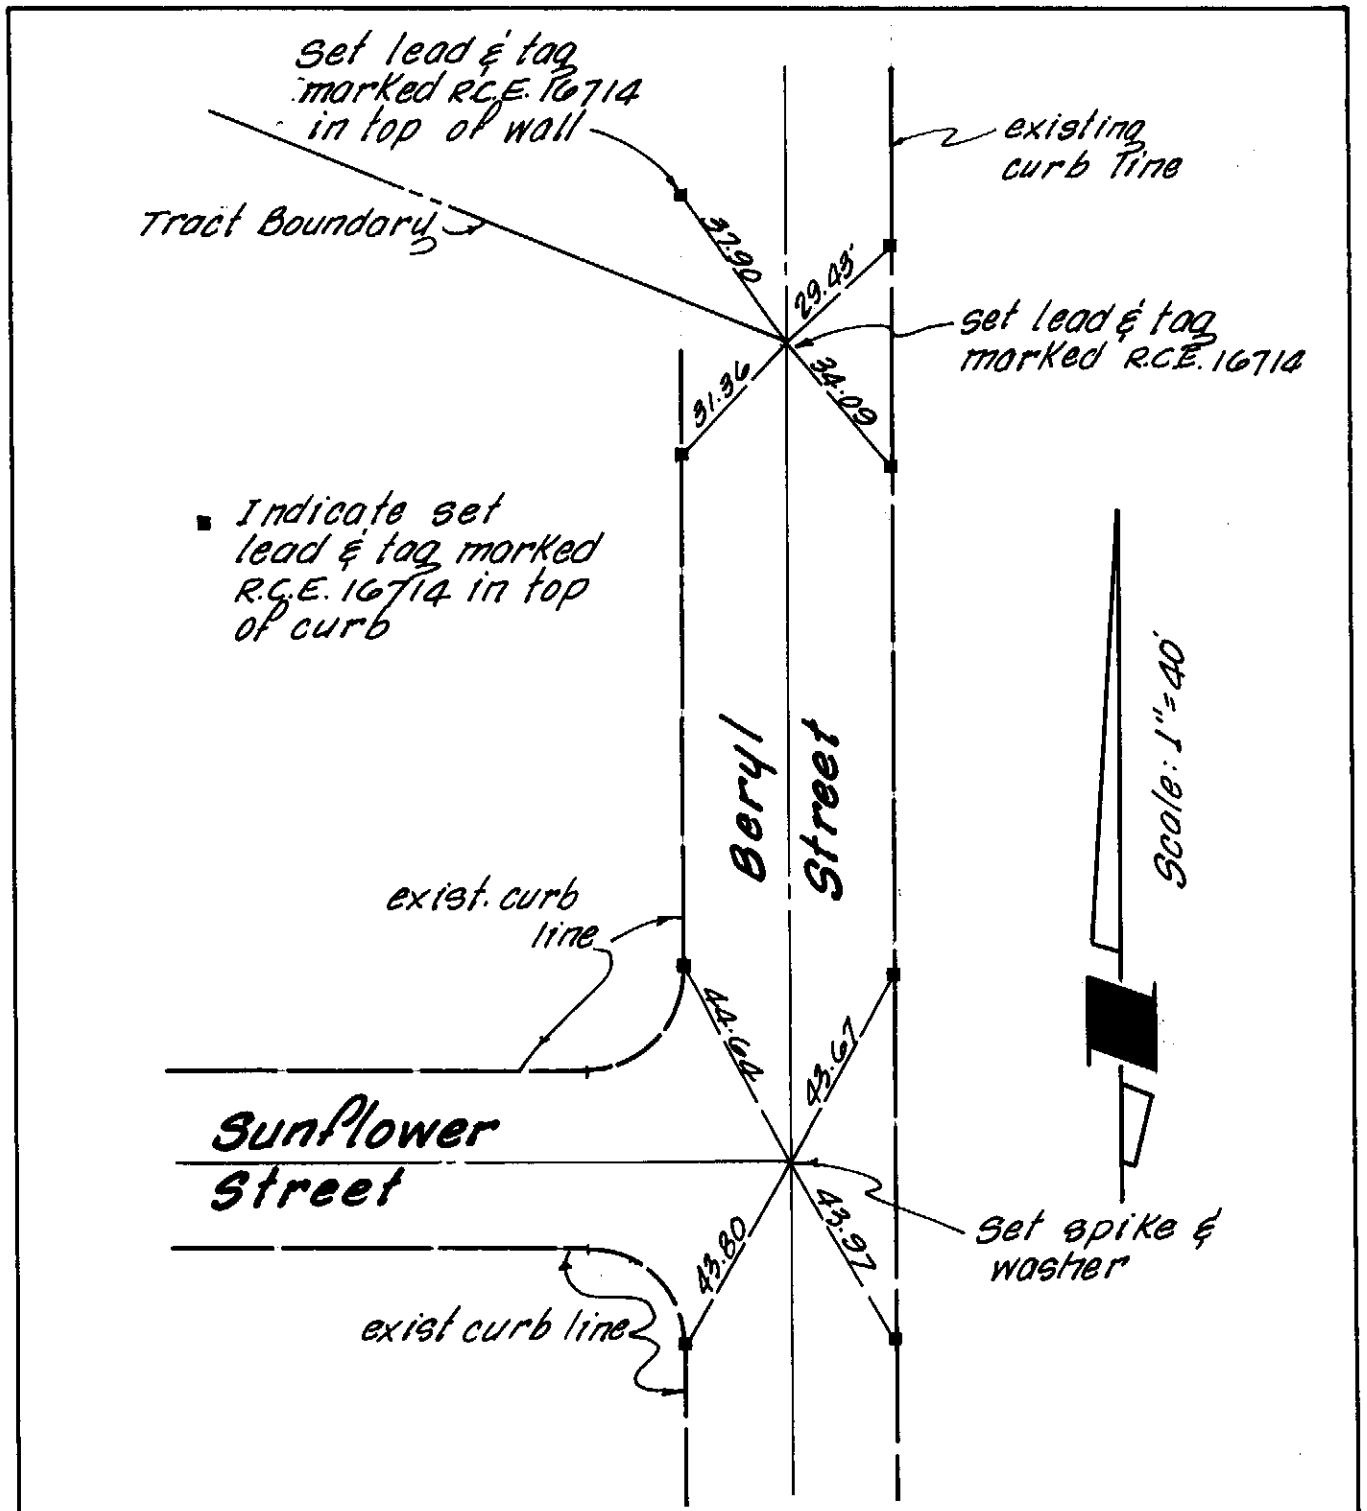

City of Rancho Cucamonga Street Tie	Tract No. 9176
Nelson Engineering 2545 E. Chapman #115 Fullerton, Ca., 92631 (714) 870-9962	Beryl Street at Sunflower Street & N. Tract Boundary
George S. Nelson	Field Review: _____ Date: _____
R.C.E. 16714 Date: 5-22-81	Tie Book: 5 Page 29

PARCEL MAP NO. 5157
CENTERLINE TIES
CITY OF RANCHO CUCAMONGA

122-3800
2/4/81
1 OF 6

- ● INDICATES LEAD, TACK AND L.S. 4279 TAG IN TOP OF CURB.
- ○ INDICATES SPIKE AND WASHER STAMPED L.S. 4279, UNLESS OTHERWISE NOTED.

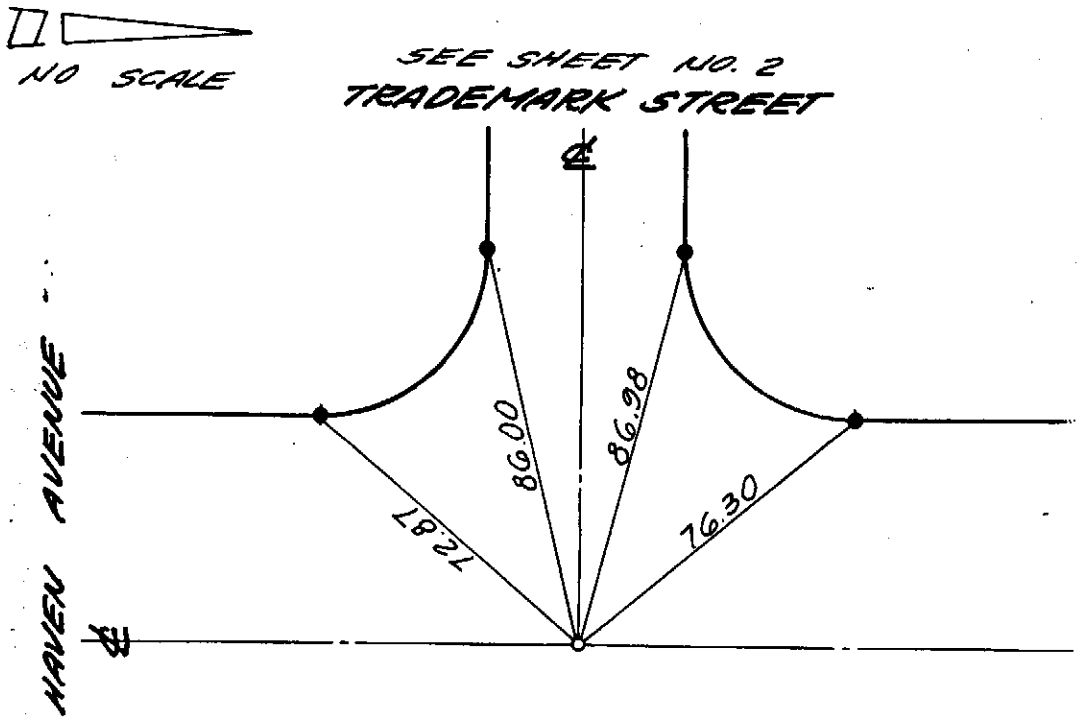

PARCEL MAP NO. 5157
CENTERLINE TIES
CITY OF RANCHO CUCAMONGA

122-3800
2/4/81
2 OF 6

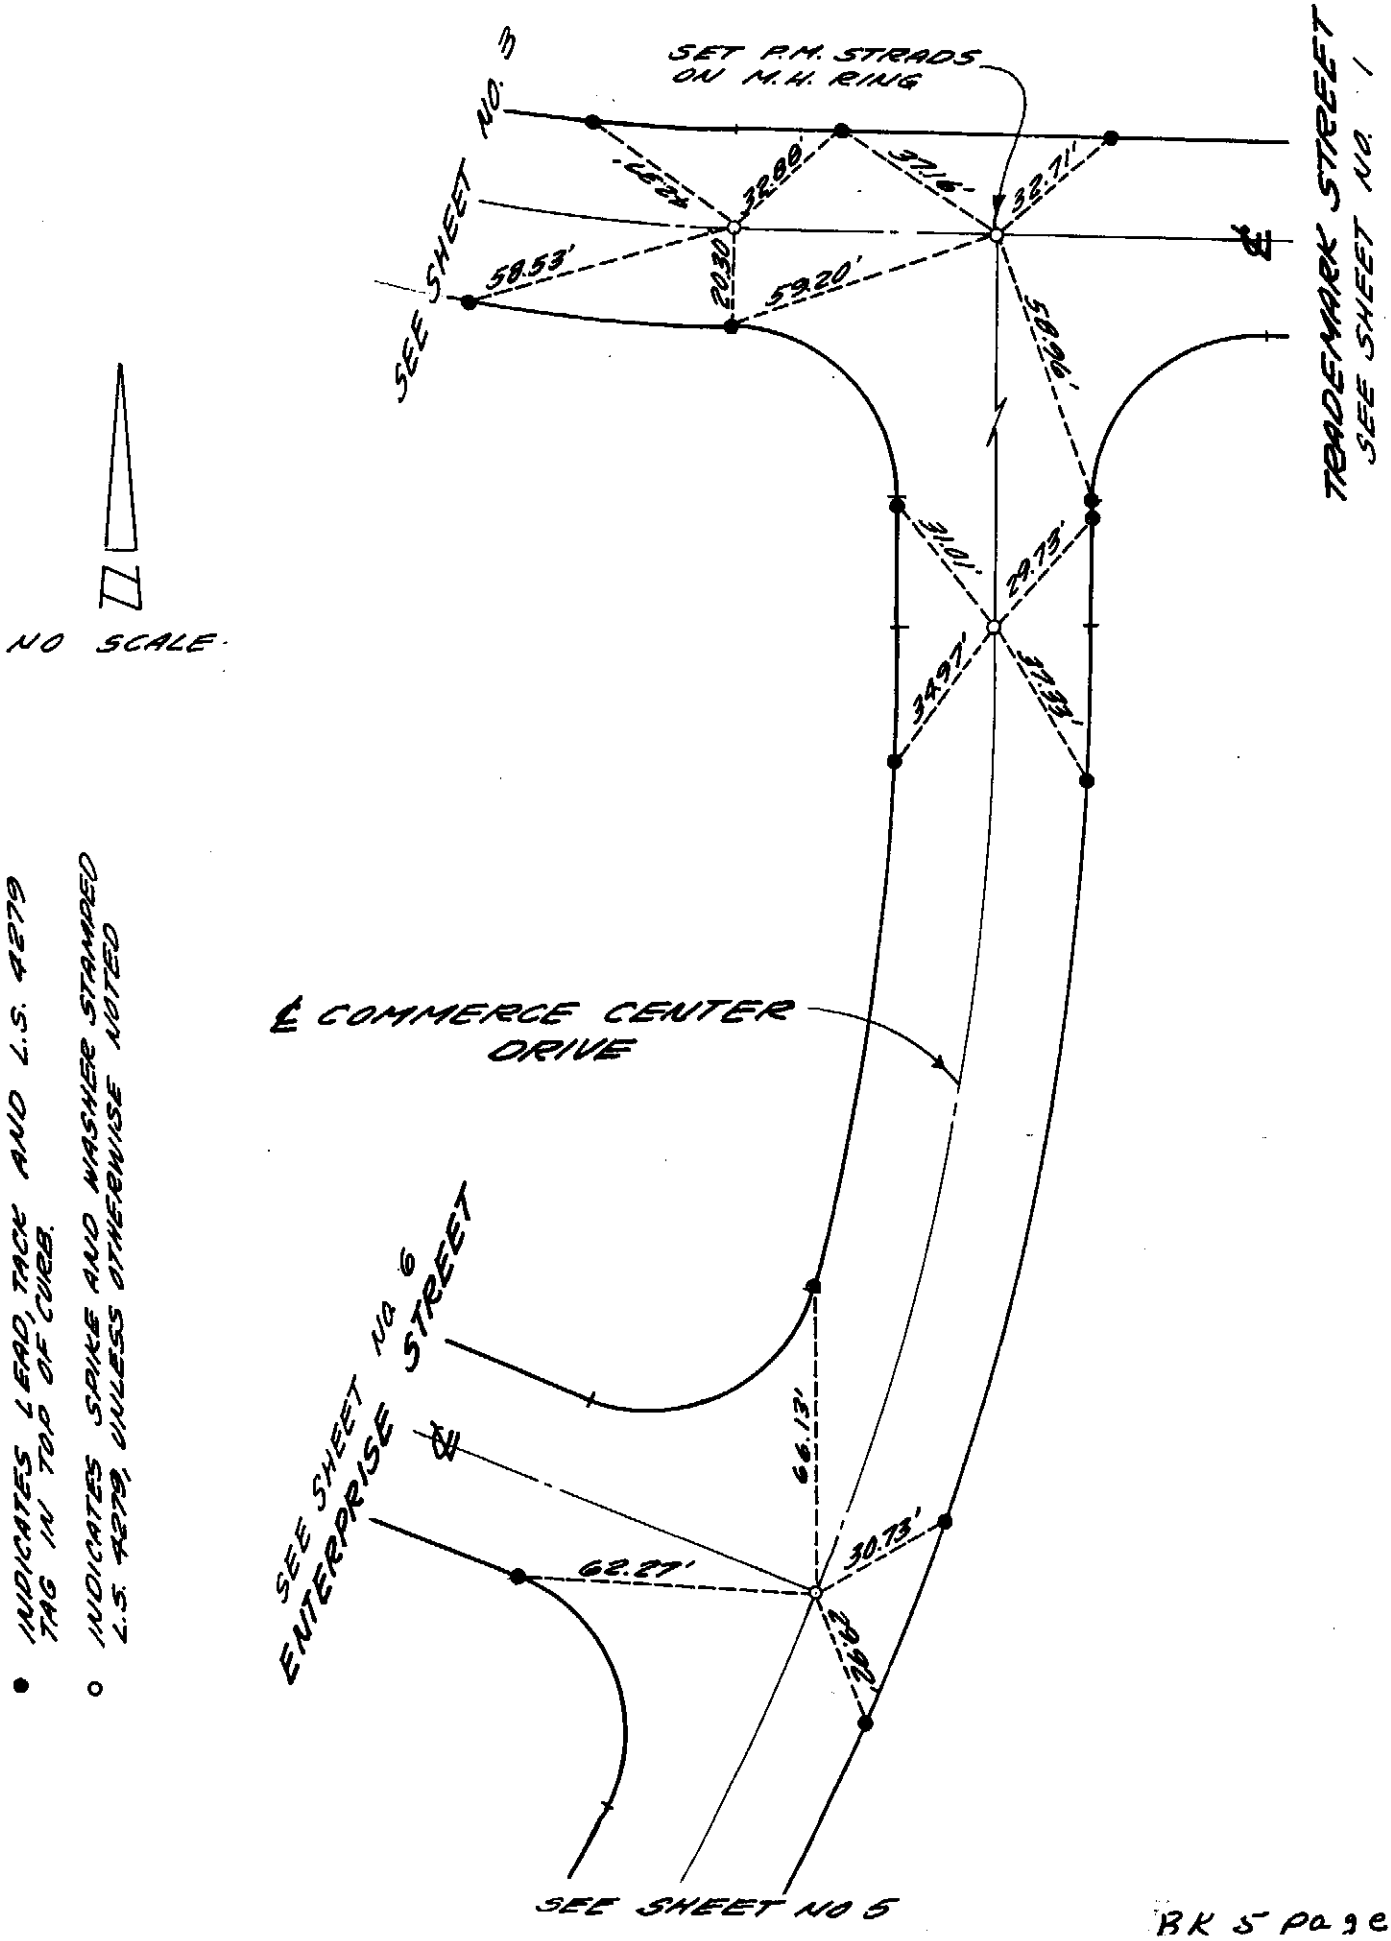

BK 5 page 31

PARCEL MAP NO 5157
CENTERLINE TIES
CITY OF RANCHO CUCAMONGA

122-3800
2/4/81
3 OF 6

- ● INDICATES LEAD, TACK AND L.S. 4279 TAG IN TOP OF CURB
- ○ INDICATES SPIKE AND WASHER STAMPED L.S. 4279, UNLESS OTHERWISE NOTED.

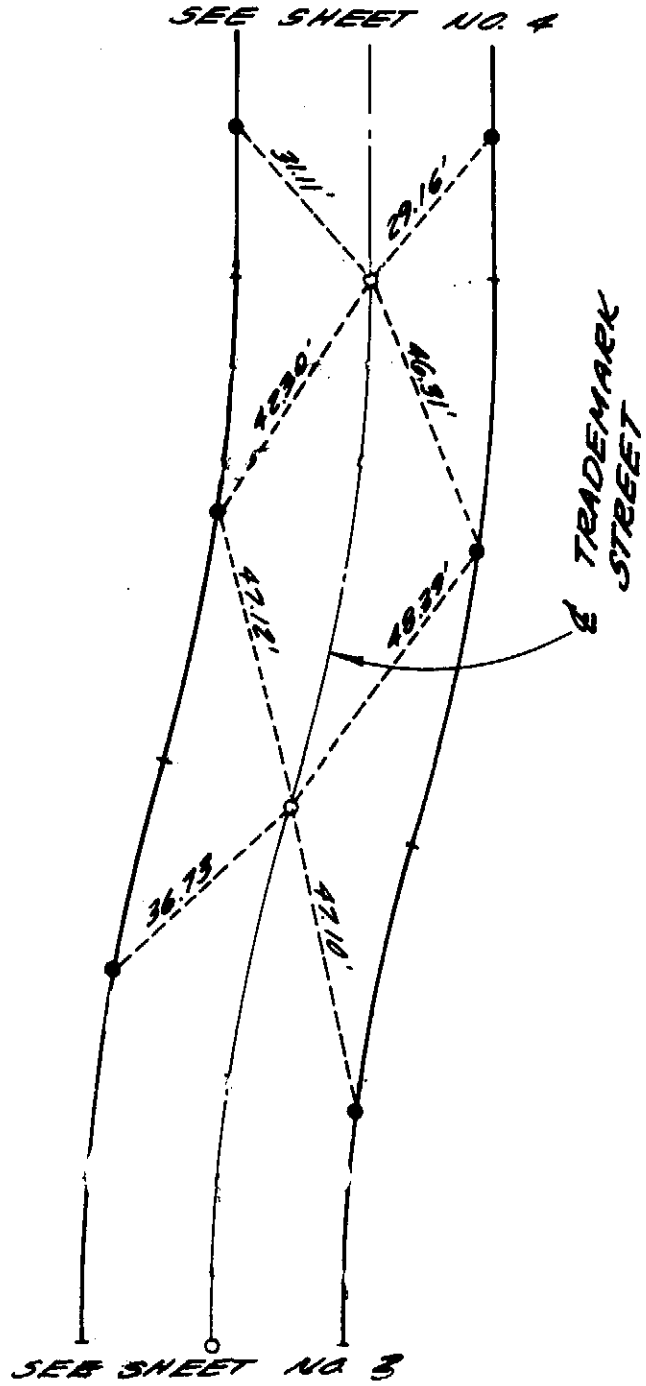

SCALE : 1" = 40'

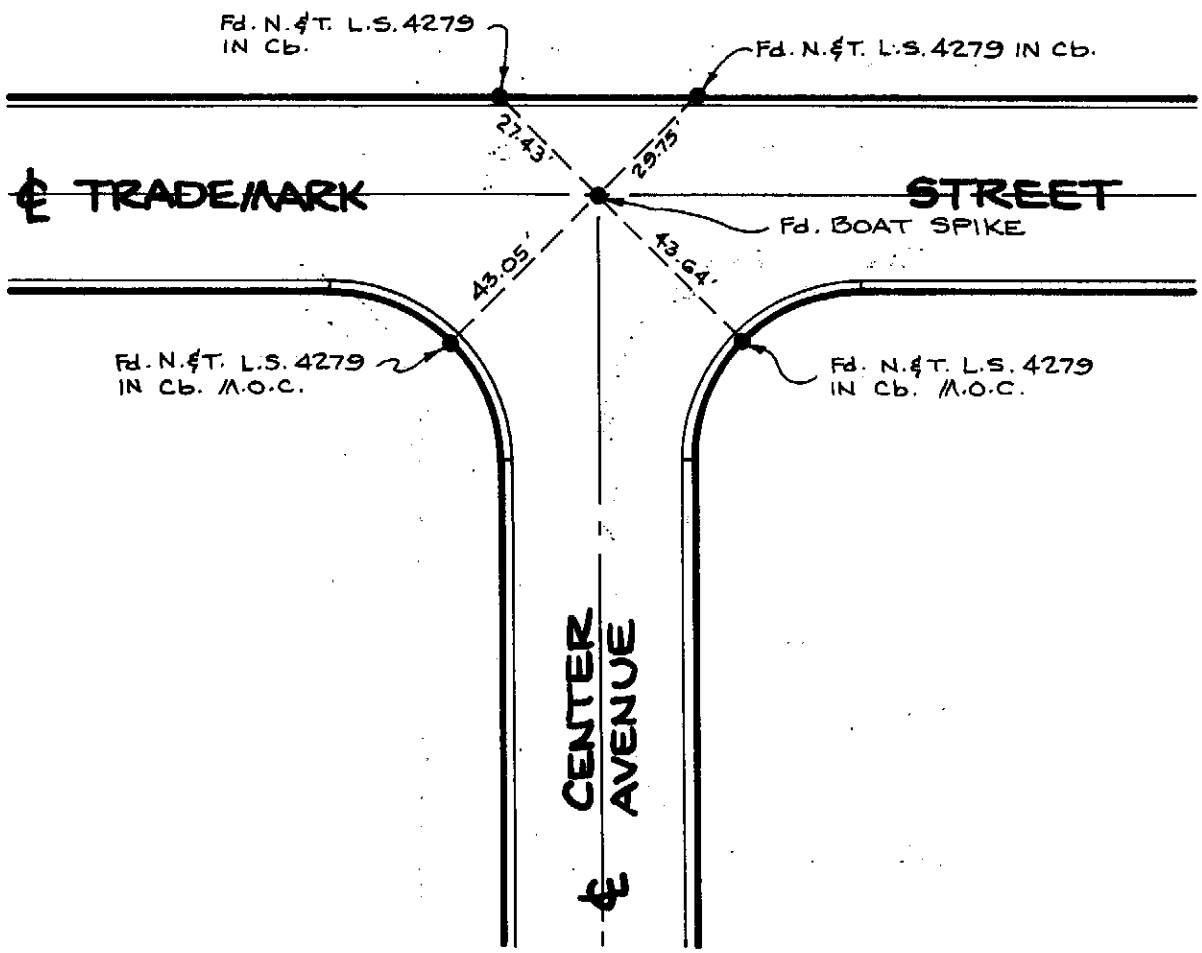

CITY OF RANCHO CUCAMONGA — STREET TIE	ASSESSMENT DISTRICT 82-1
LOCKWOOD ENGINEERING & SURVEYING COMPANY, INC. 380 W. FOOTHILL BLVD. RIALTO, CALIFORNIA	TRADEMARK STREET AT CENTER AVENUE
CARLETON W. LOCKWOOD	FIELD REVIEW _____ DATE _____
R.C.E. NO. 9101, DATE 3-15-82	TIE BOOK 5 PAGE 33

PARCEL MAP NO. 5154
CENTERLINE TIES
CITY OF [illegible] CUCAMONGA

[illegible]
[illegible]
4 OF 6

- INDICATES LEAD, TACK AND L.S. [illegible] TAG IN TOP OF CURB
- INDICATES SPIKE AND WASHER STAMPED L.S. [illegible] UNLESS OTHERWISE NOTED.

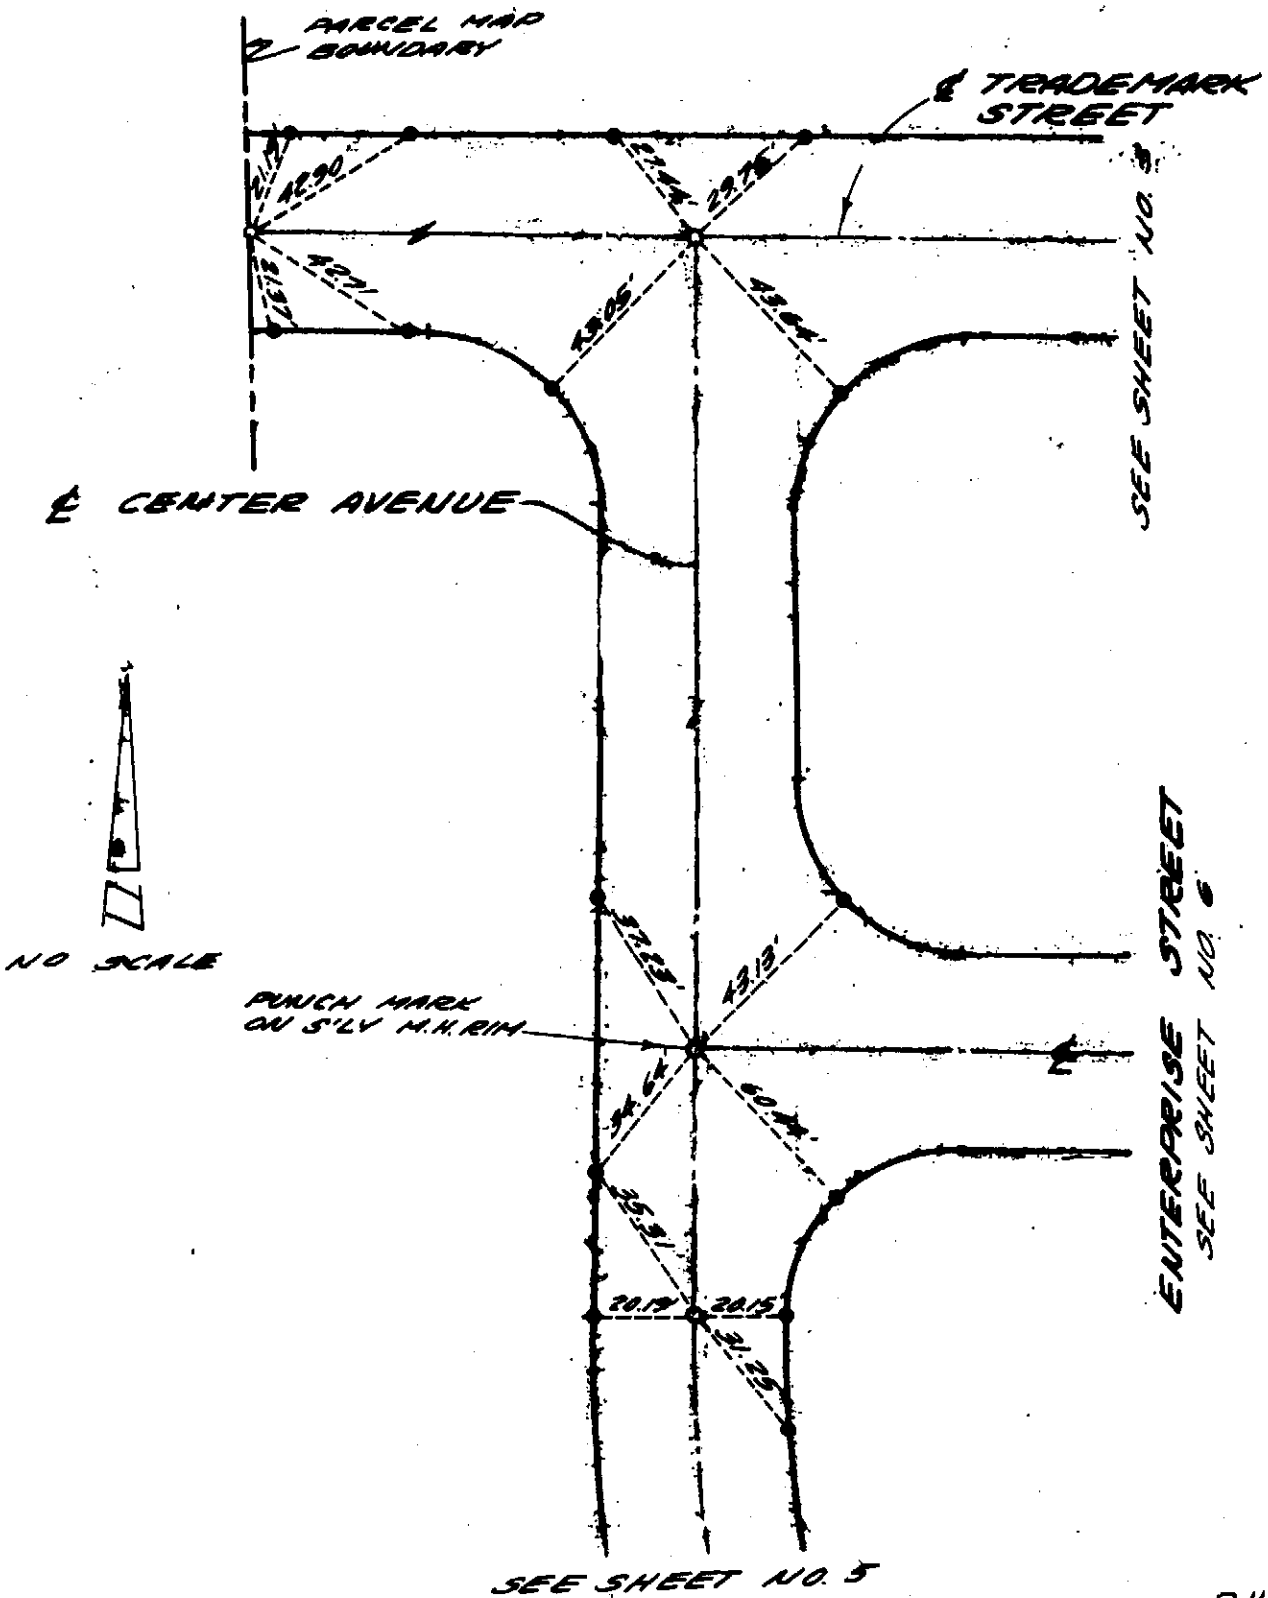

PARCEL MAP NO. 5187
CENTERLINE TIES
CITY OF RANCHO CUCAMONGA

SHEET
5 OF 6

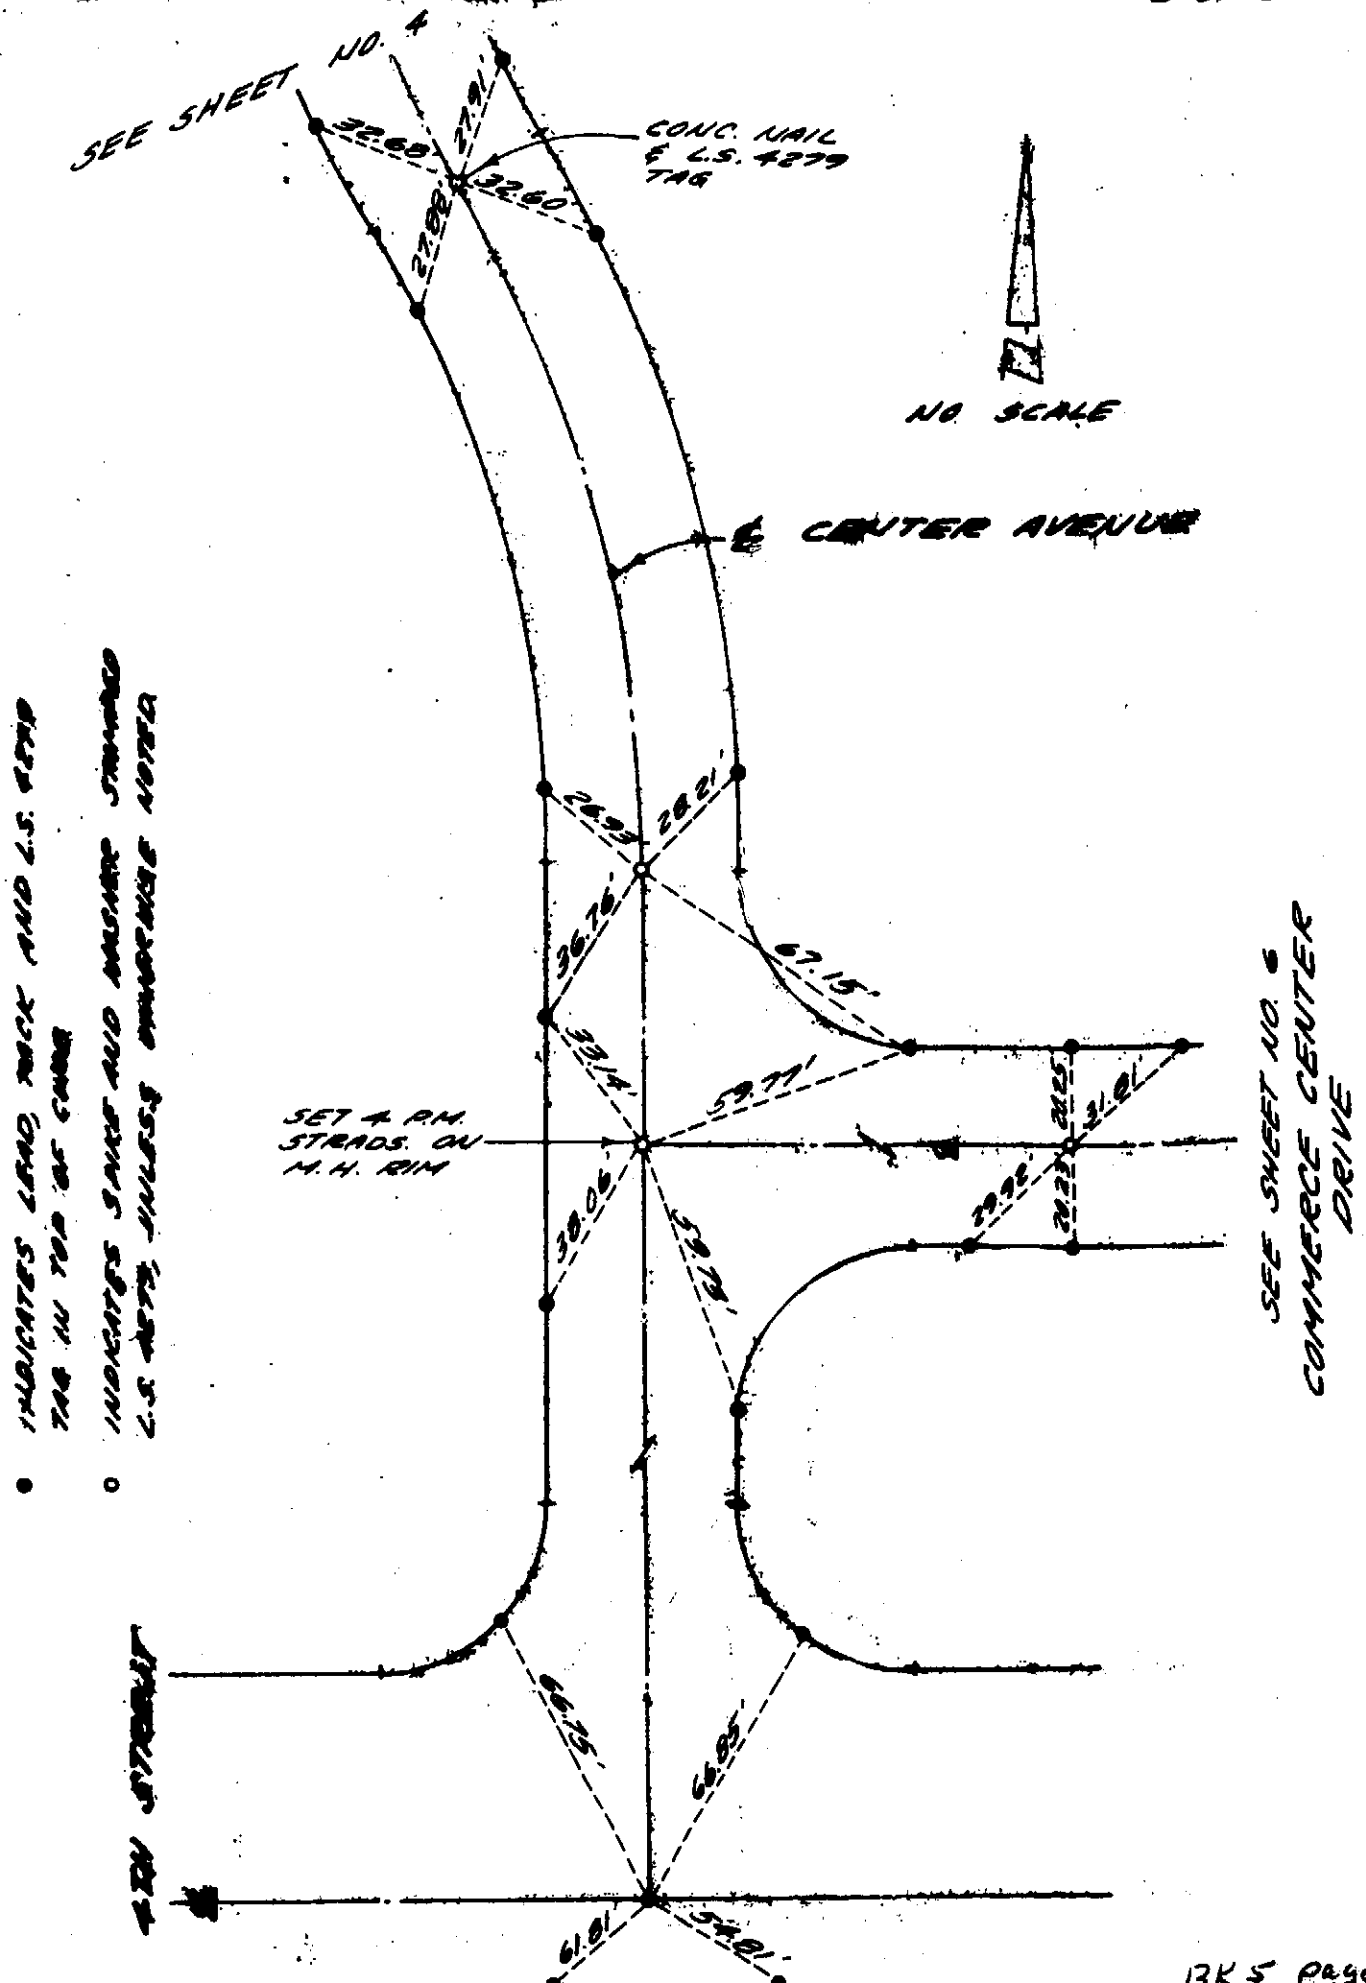

PARCEL MAP NO. 5157
CENTERLINE TIES
CITY OF RANCHO CUCAMONGA

122-3800
2/4/81
6 OF 6

- ● INDICATES LEAD, TACK AND L.S. 4279 TAG IN TOP OF CURB.
- ○ INDICATES SPIKE AND WASHER STAMPED L.S. 4279, UNLESS OTHERWISE NOTED.

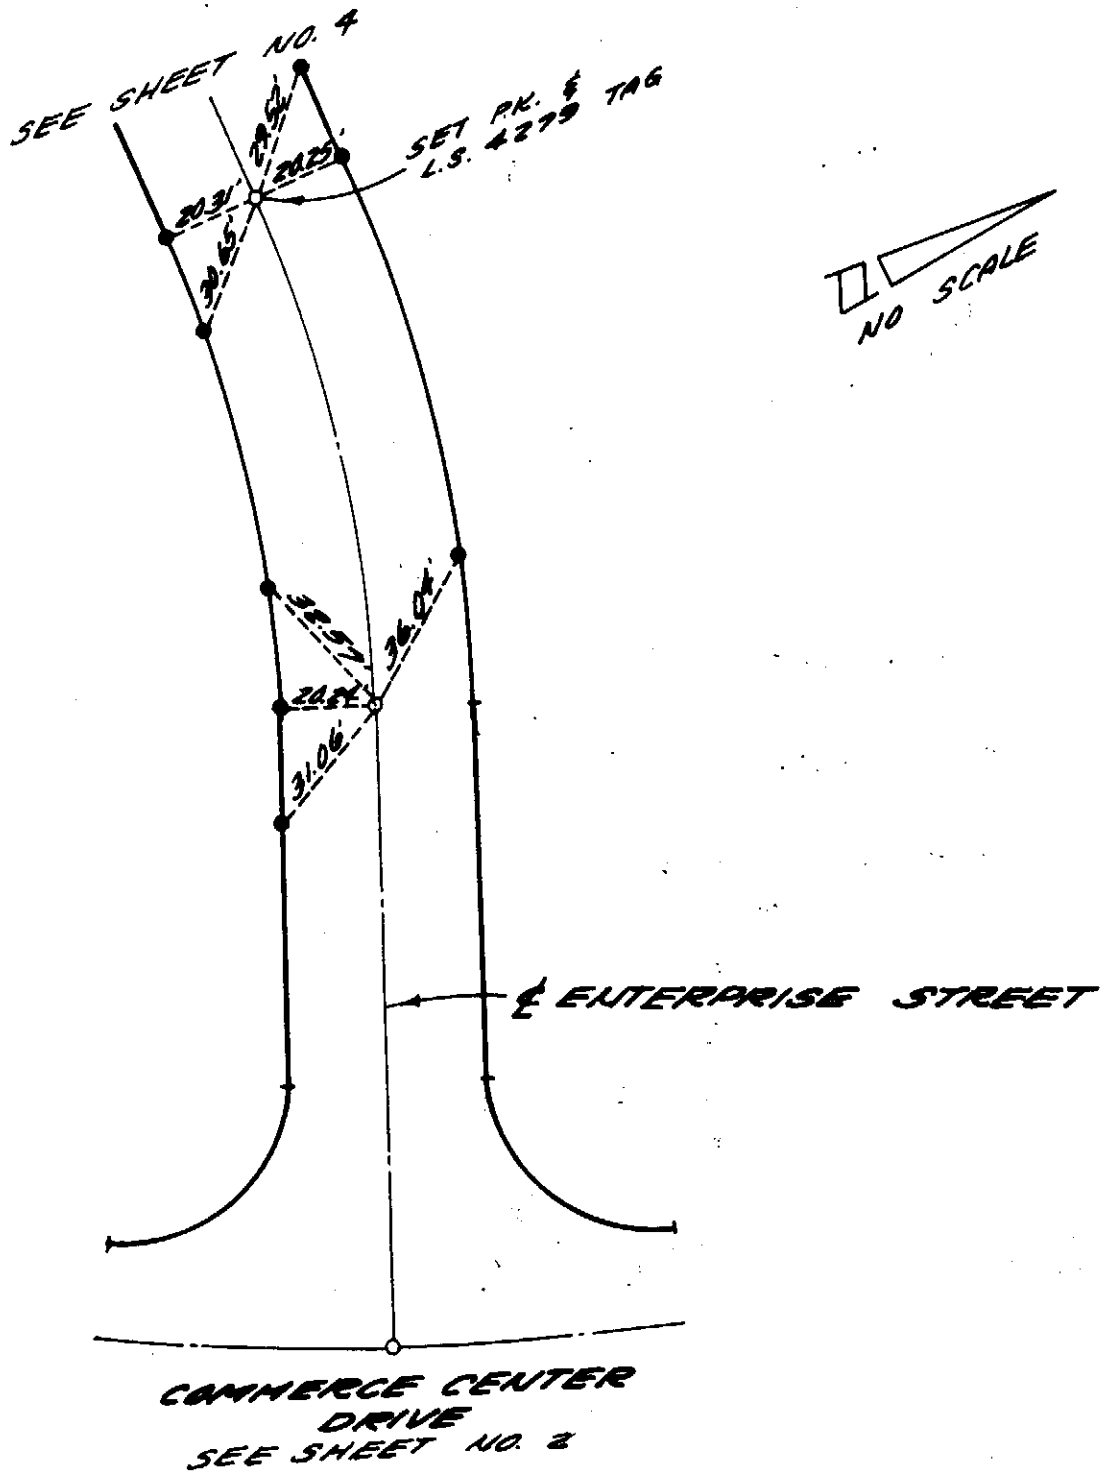

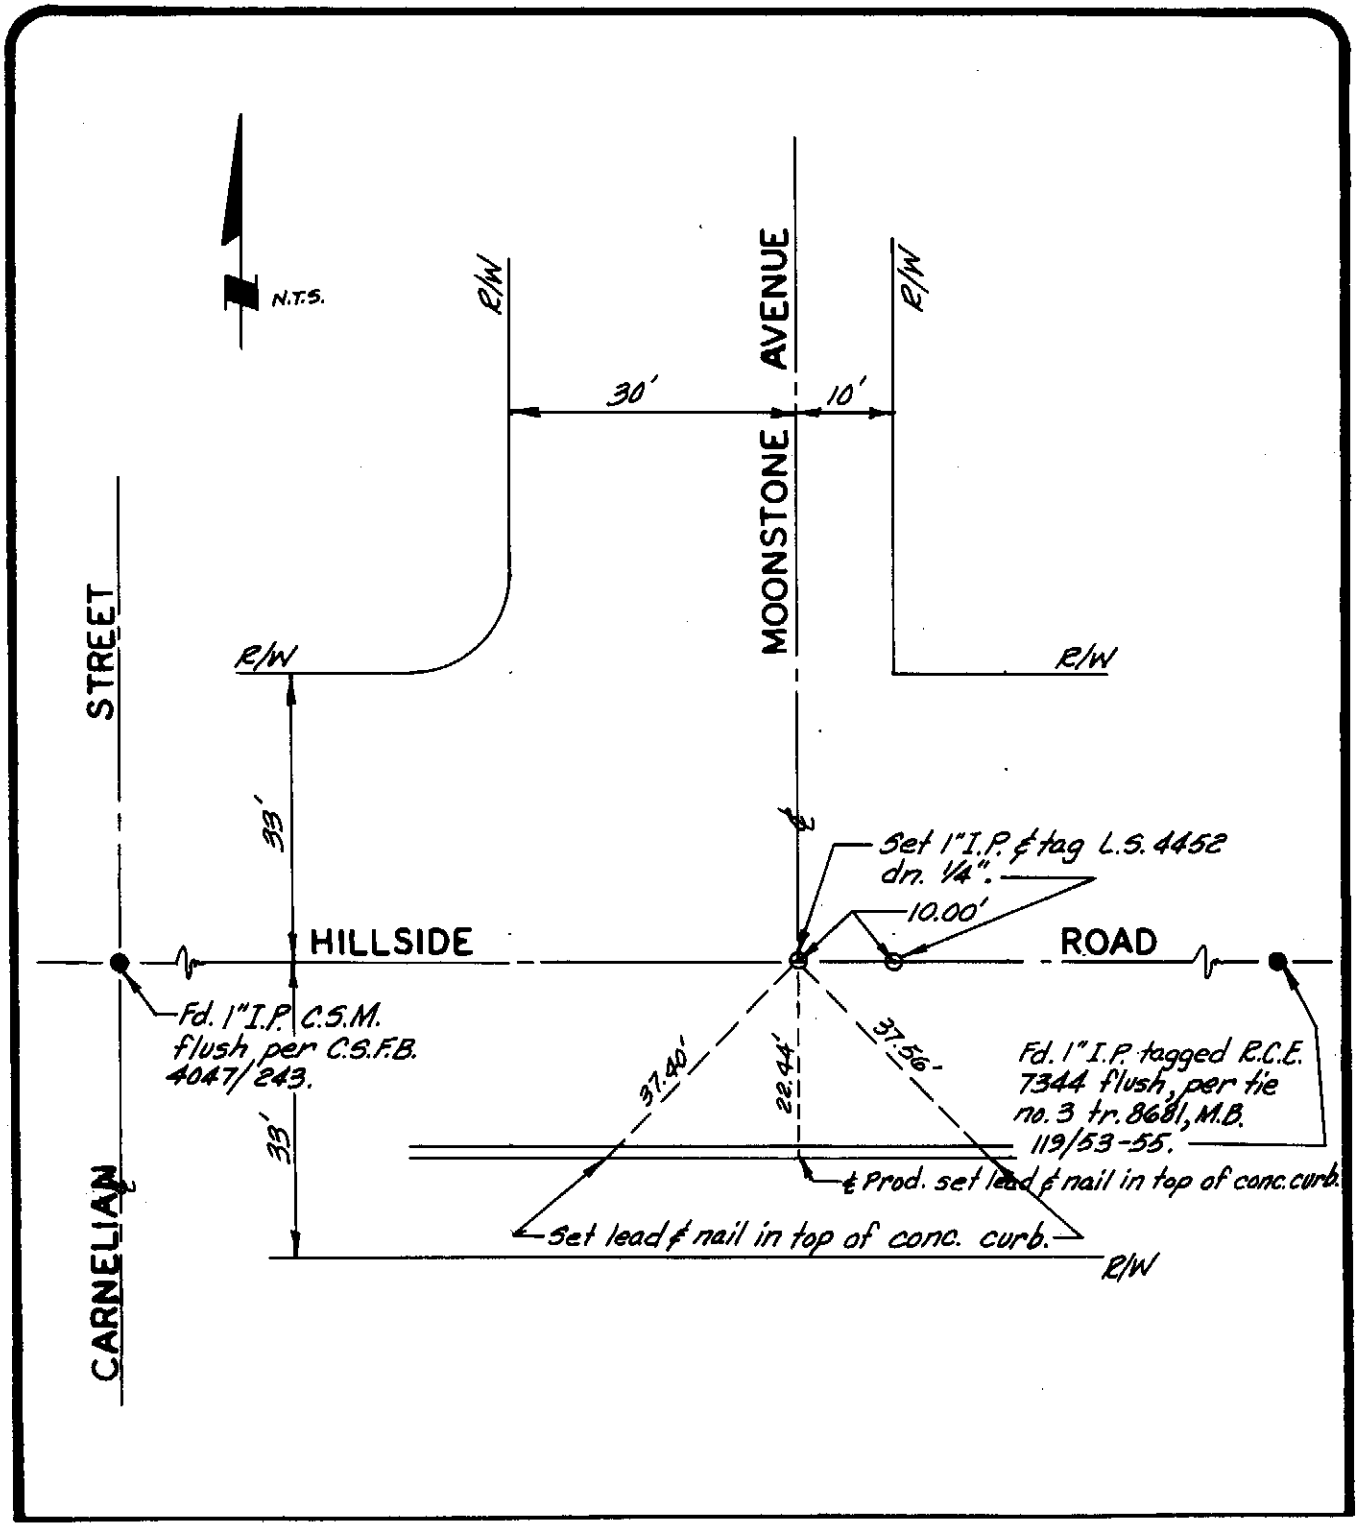

city of rancho cucamonga — STREET TIE	PARCEL MAP NO. 5269
LINVILLE-SANDERSON-HORN & ASSOC 9587 ARROW ROUTE, SUITE "H" RANCHO CUCAMONGA, CALIF. 91730 TELEPHONE: (714) 980-1211	INTERSECTION OF HILLSIDE ROAD & MOONSTONE AVENUE
ENGR./L.S. Gary T. Sanderson	FIELD REVIEW _____ DATE _____
R.C.E./L.S. No. 4452 DATE 10-9-81	TIE BOOK 5 PAGE 36

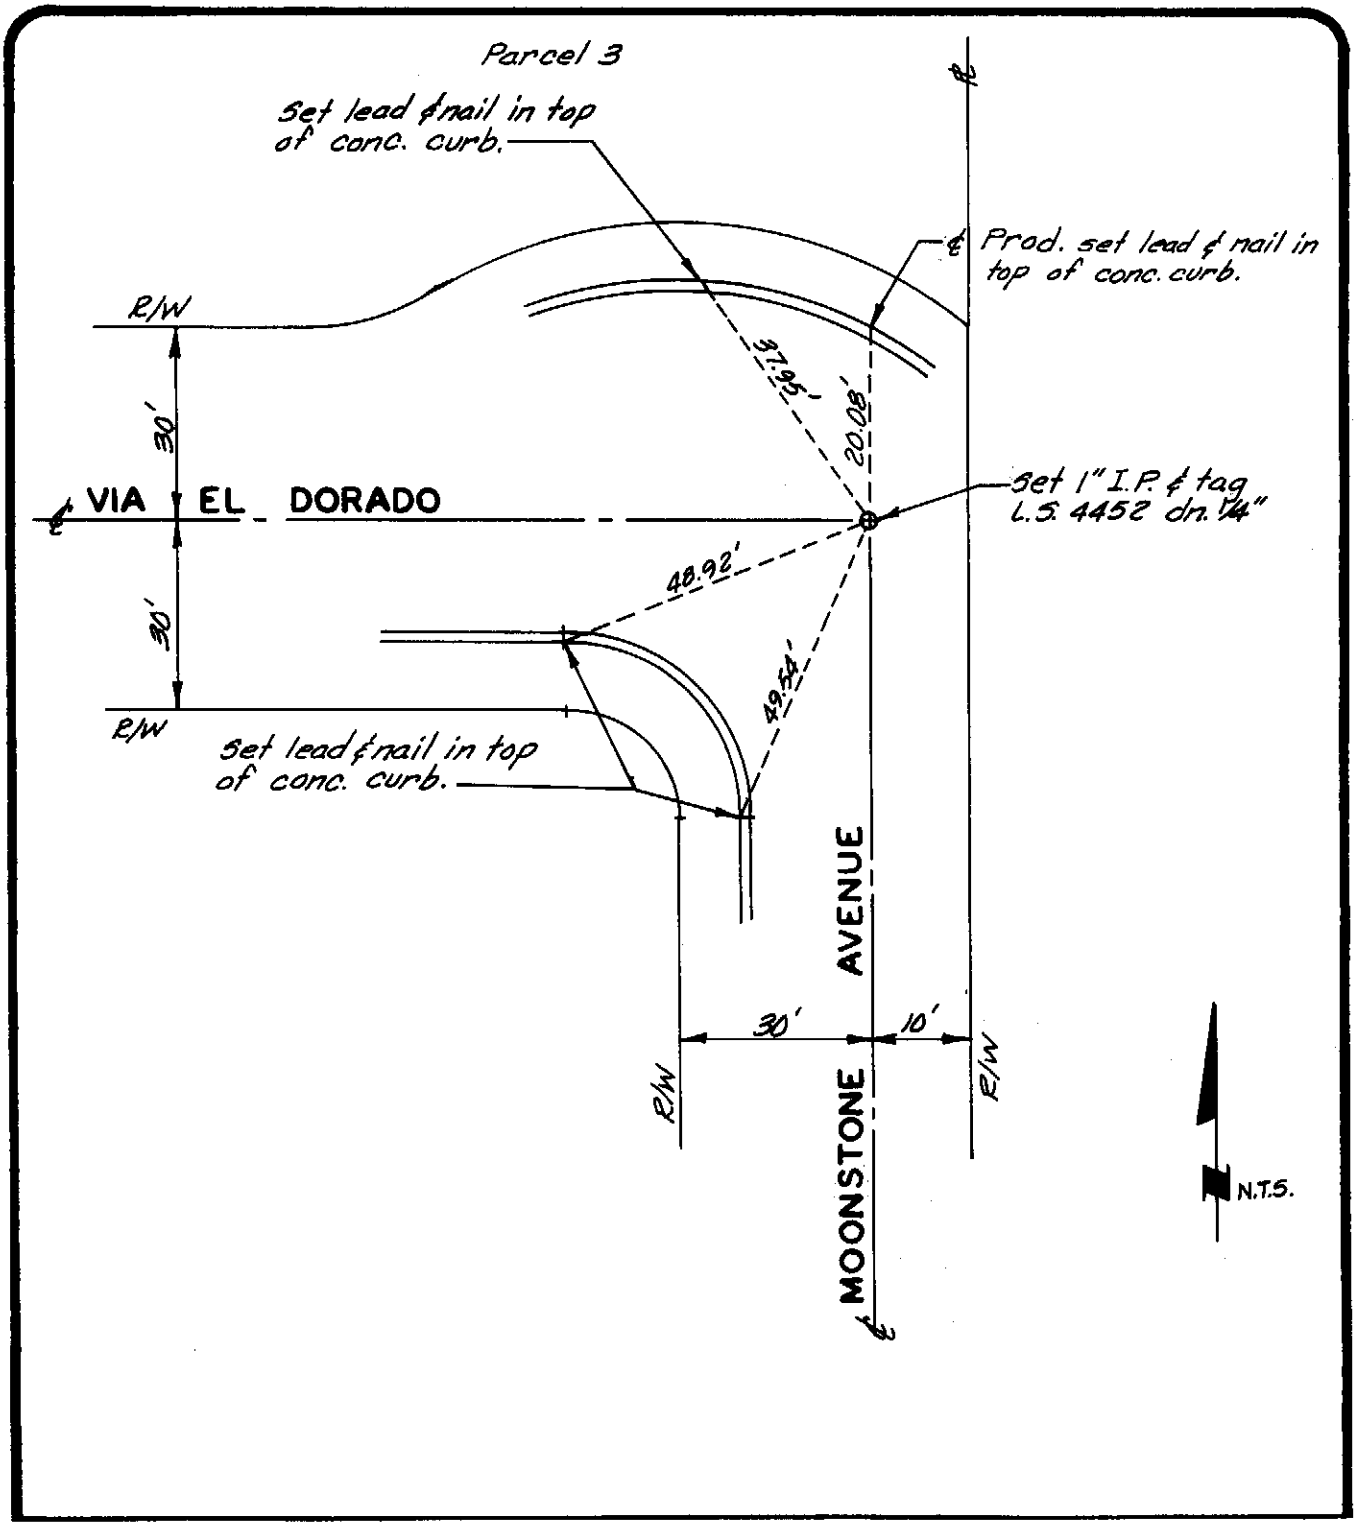

city of rancho cucamonga — STREET TIE	PARCEL MAP NO. 5269
LINVILLE-SANDERSON-HORN & ASSOC. 9587 ARROW ROUTE, SUITE "H" RANCHO CUCAMONGA, CALIF. 91730 TELEPHONE: (714) 980-1211	INTERSECTION OF MOONSTONE AVENUE & VIA EL DORADO
ENGR. / L.S. Gary T. Sanderson	FIELD REVIEW _____ DATE _____
R.C.E. / L.S. No. 4452 DATE 10-9-81	TIE BOOK 5 PAGE 37

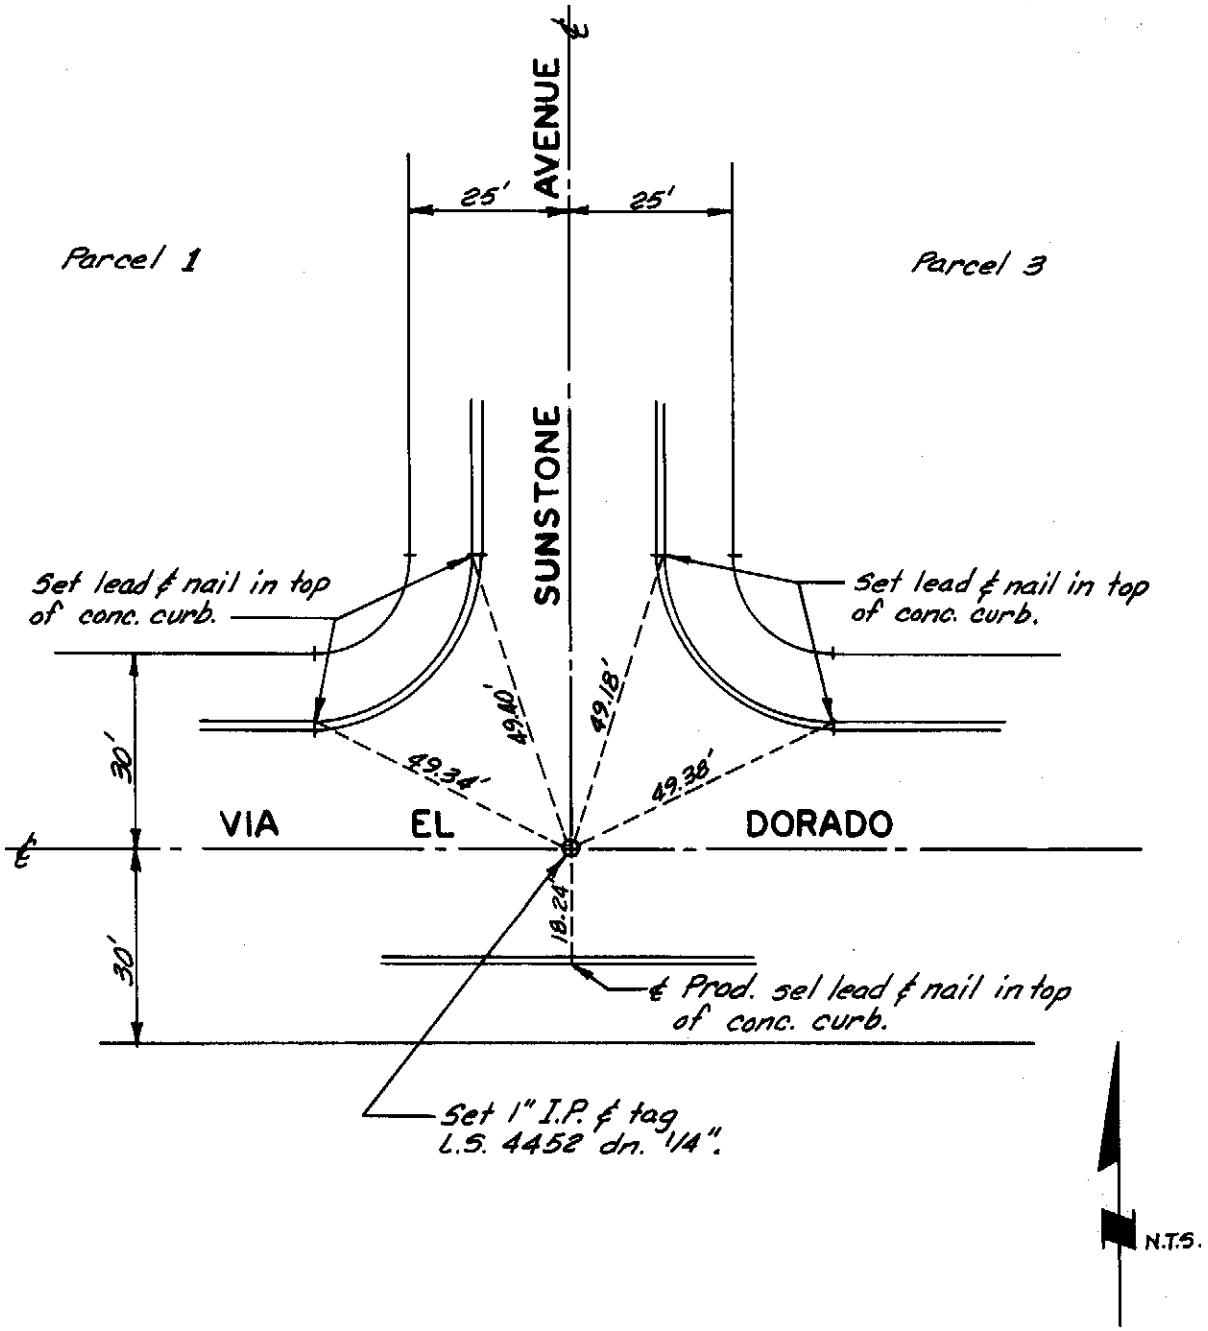

city of rancho cucamonga — STREET TIE	PARCEL MAP NO. 5269
LINVILLE-SANDERSON-HORN & ASSOC. 9587 ARROW ROUTE, SUITE "H" RANCHO CUCAMONGA, CALIF. 91730 TELEPHONE: (714) 980-1211	INTERSECTION OF VIA EL DORADO & SUNSTONE AVENUE
ENGR. / L.S. Gary T. Sanderson	FIELD REVIEW _____ DATE _____
R.C.E. / L.S. No. 4452 DATE 10-9-81	TIE BOOK 5 PAGE 38

5/5

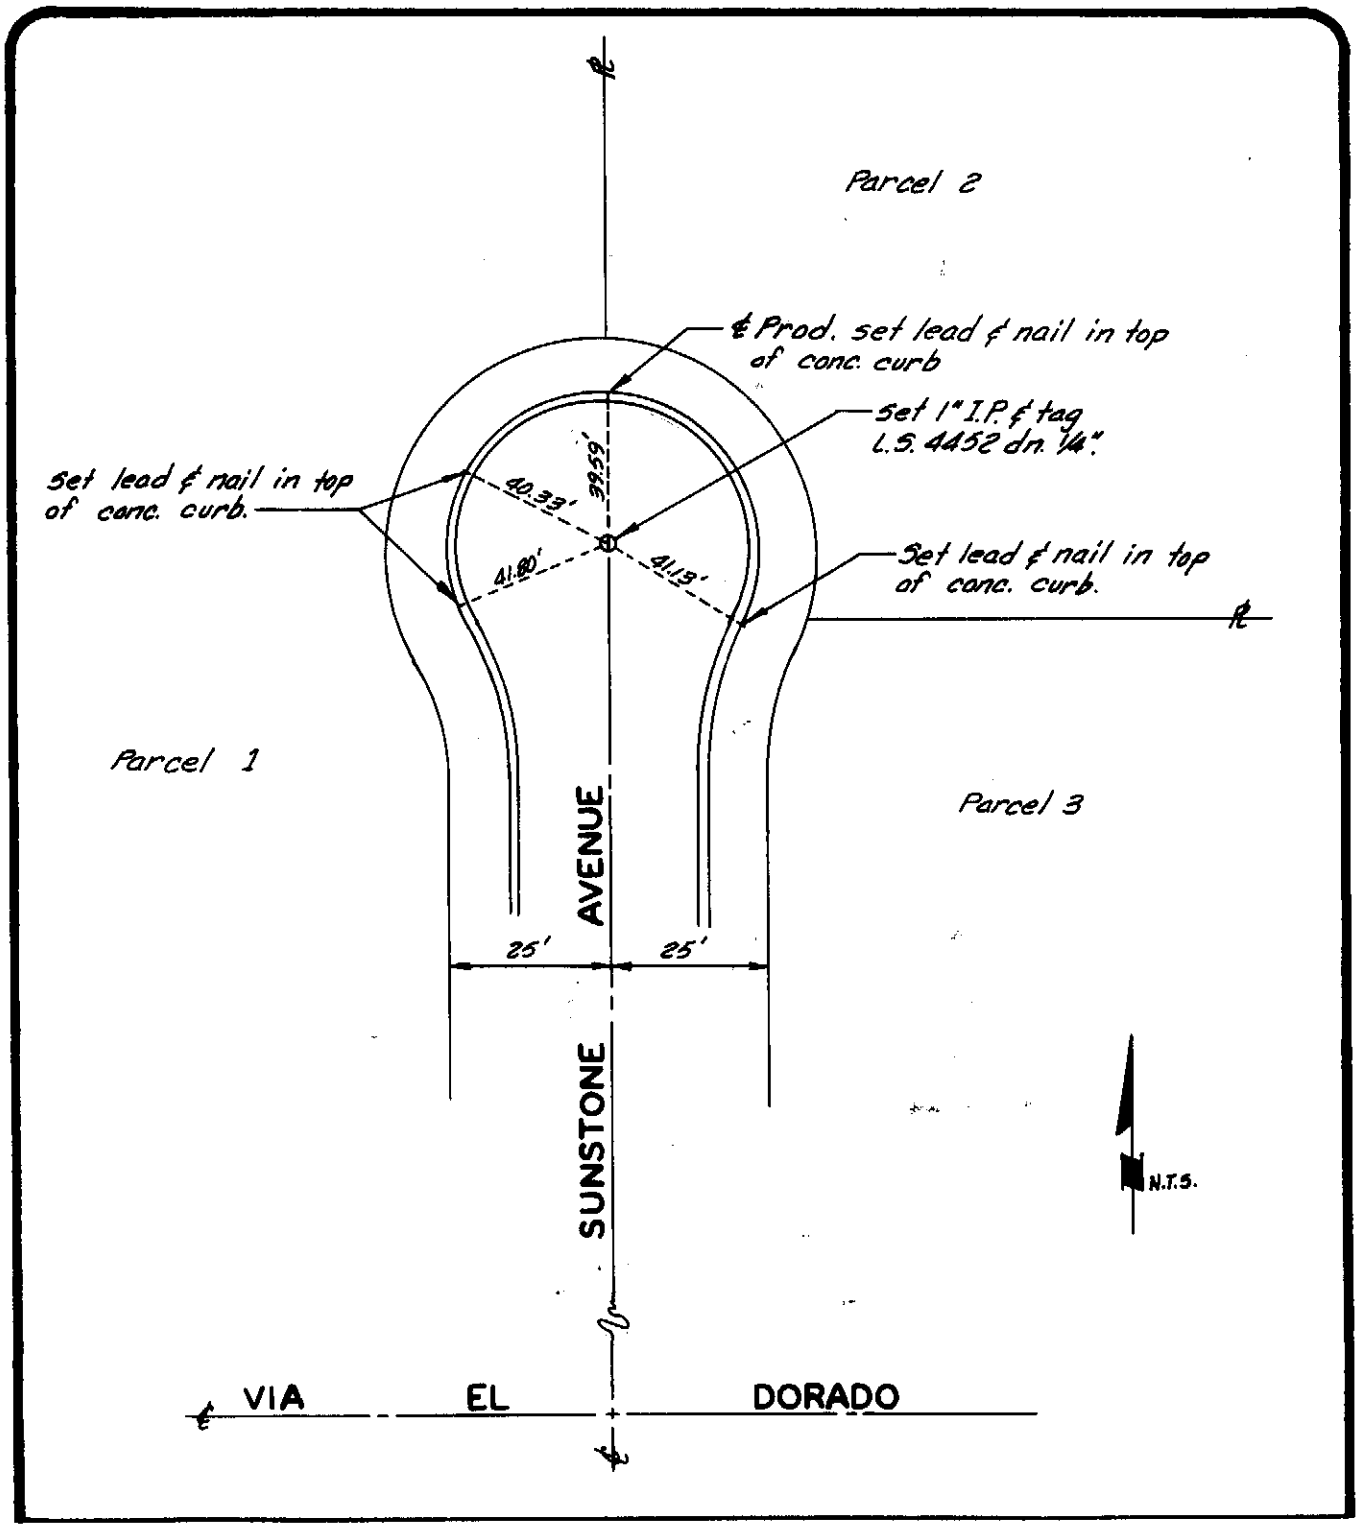

city of rancho cucamonga — STREET TIE	PARCEL MAP NO.5269
LINVILLE-SANDERSON-HORN & ASSOC. 9587 ARROW ROUTE, SUITE "H" RANCHO CUCAMONGA, CALIF. 91730 TELEPHONE: (714) 980-1211	CUL-DE-SAC AT SUNSTONE AVENUE NO. OF VIA EL DORADO
ENGR./L.S. Gary T. Sanderson	FIELD REVIEW _____ DATE _____
R.C.E./L.S. No. 4452 DATE 10-9-81	TIE BOOK 5 PAGE 39

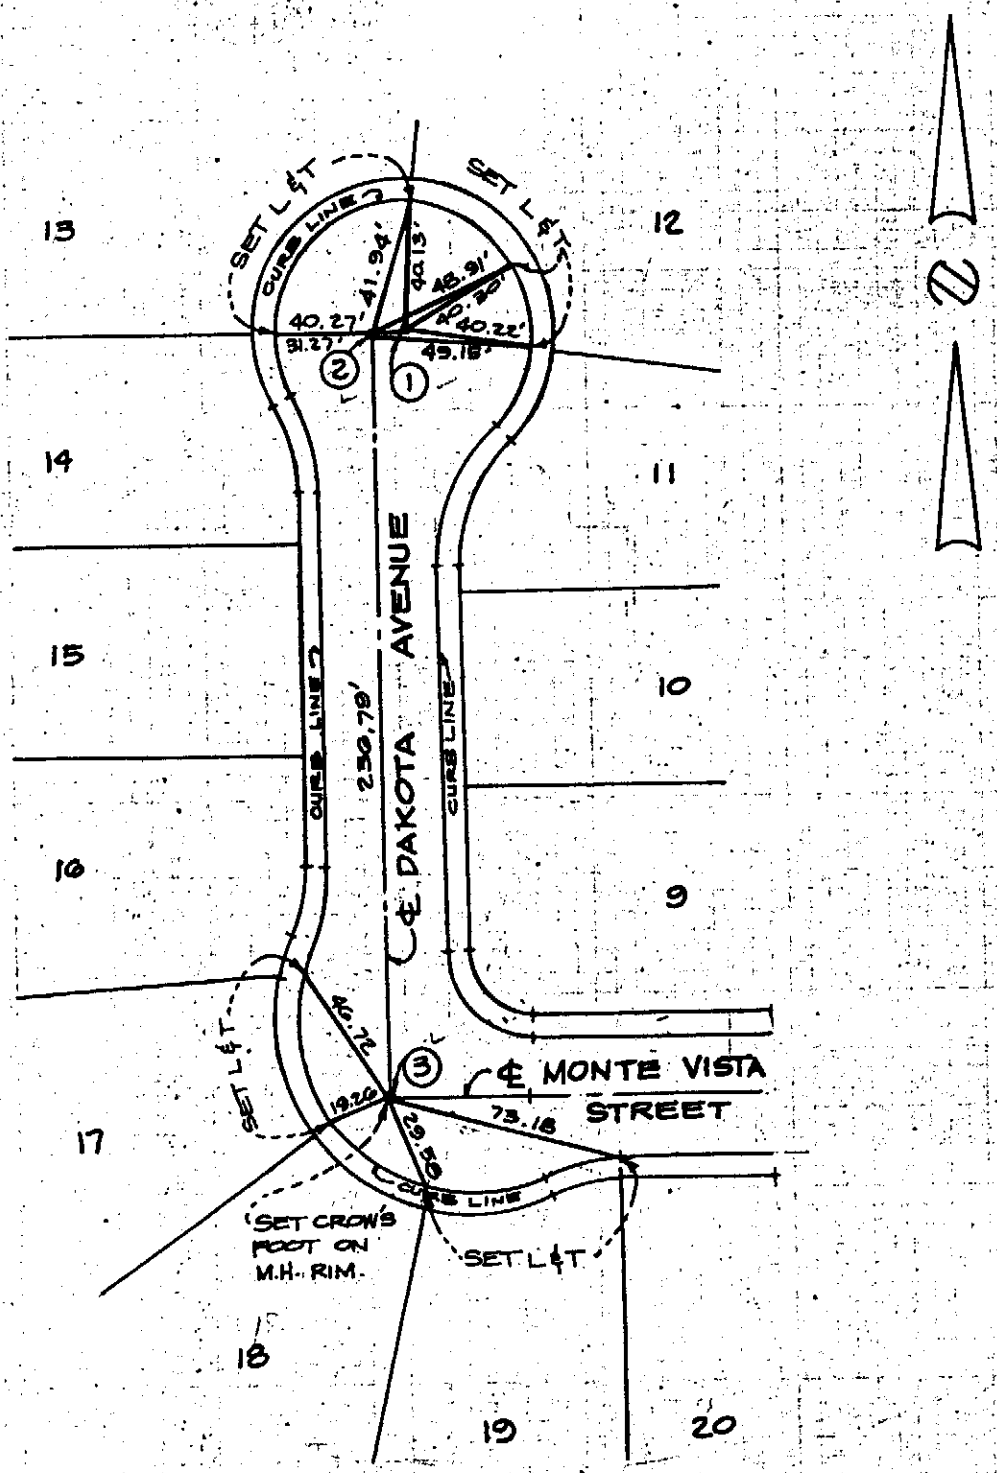

CITY of RANCHO CUCAMONGA — STREET TIE	TRACT No. 9436
Madole & Associates, Inc. Consulting Civil Engineering and Land Planning 1820 E. 16th Street, Santa Ana, CA 92701 (714) 835-2548	DAKOTA AVENUE & MONTE VISTA STREET MON. NO. 1, 2, 3
ENGINEER: J. M. Madole J. M. MADOLE R.C.E. 14814 DATE 11-12-81	FIELD REVIEW _____ DATE _____ TIE BOOK 5 PAGE 40

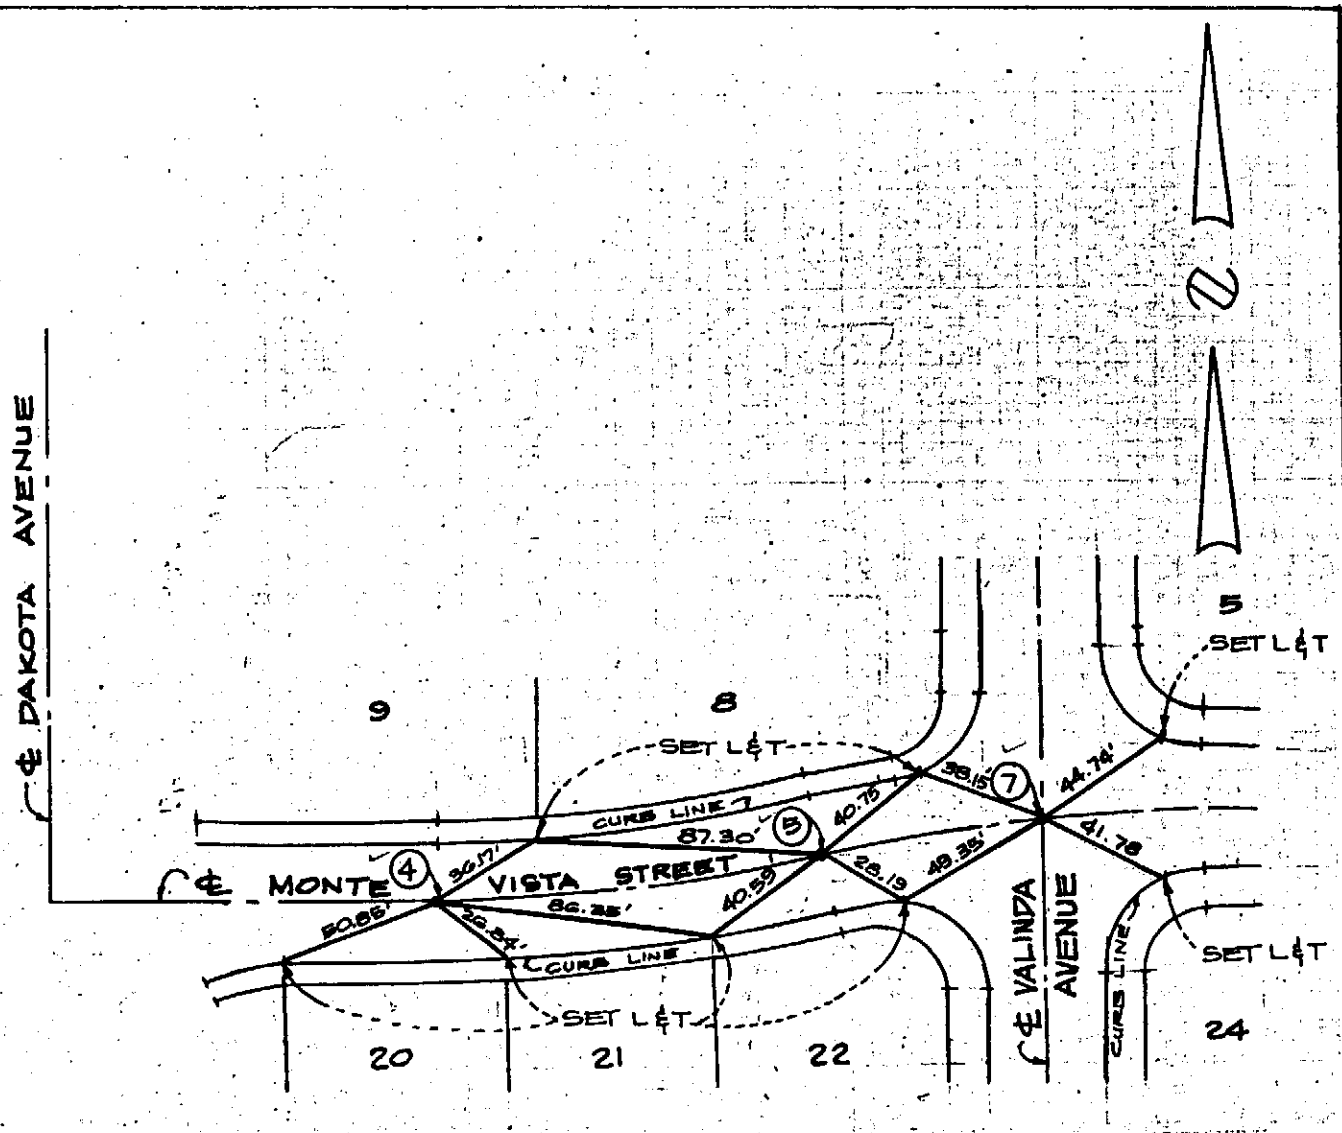

CITY of RANCHO CUCAMONGA — STREET TIE	TRACT No. 9436
Madole & Associates, Inc. Consulting Civil Engineering and Land Planning 1820 E. 16th Street, Santa Ana, CA 92701 (714) 835-2548	MONTE VISTA STREET MON. NO. 4, 5, & 7
ENGINEER: J. M. Madole J. M. MADOLE R.C.E. 14814 DATE 11-12-81	FIELD REVIEW _____ DATE _____ TIE BOOK 5 PAGE 41

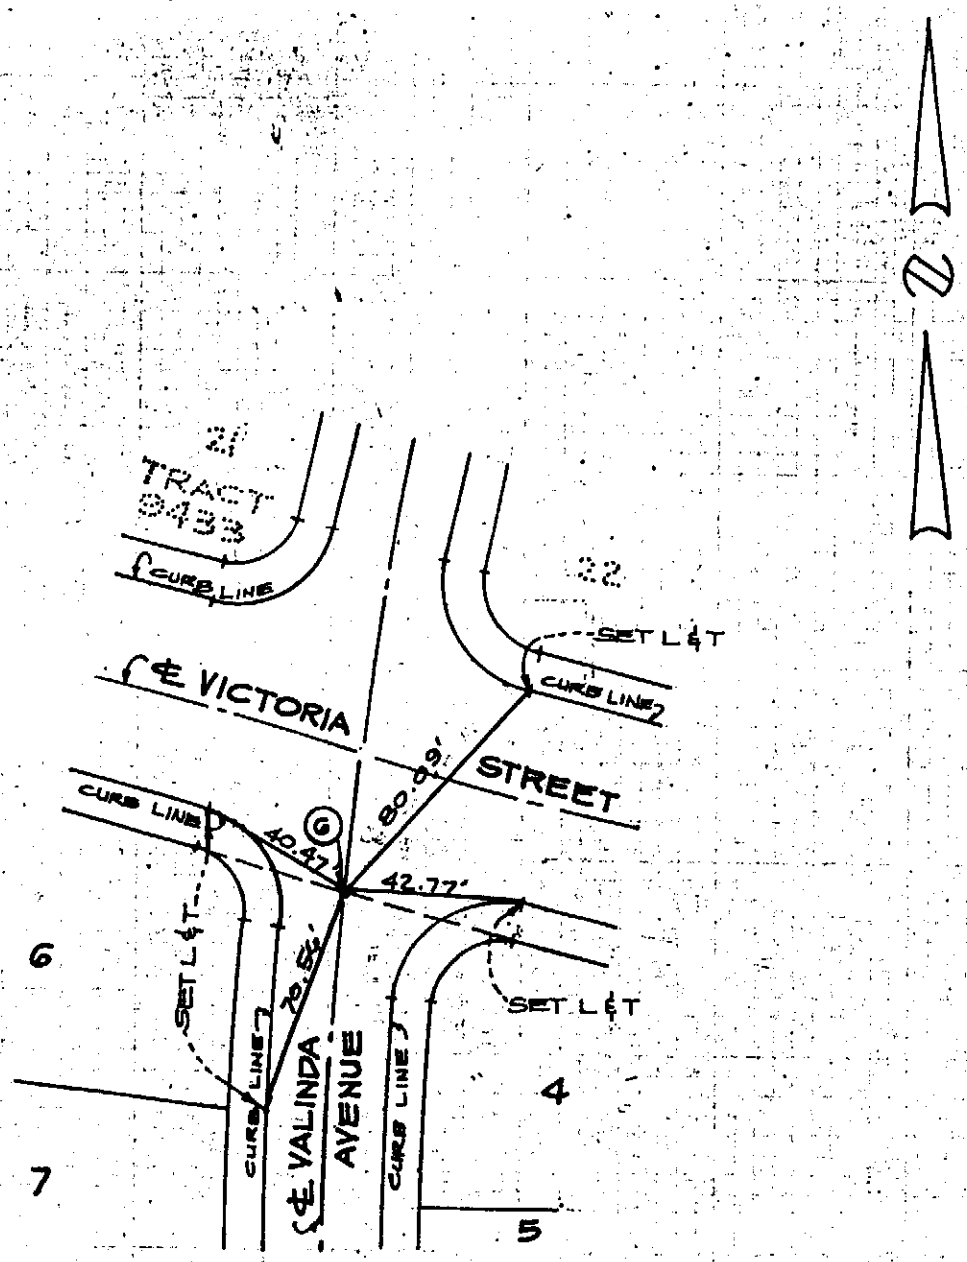

CITY of RANCHO CUCAMONGA — STREET TIE	TRACT No. 9436
Madole & Associates, Inc. Consulting Civil Engineering and Land Planning 1820 E. 16th Street, Santa Ana, CA 92701 (714) 835-2548	VALINDA AVENUE MON. NO. 6
ENGINEER: J. M. Madole J. M. MADOLE R.C.E. 14814 DATE 11-12-81	FIELD REVIEW _____ DATE _____ TIE BOOK 5 PAGE 42

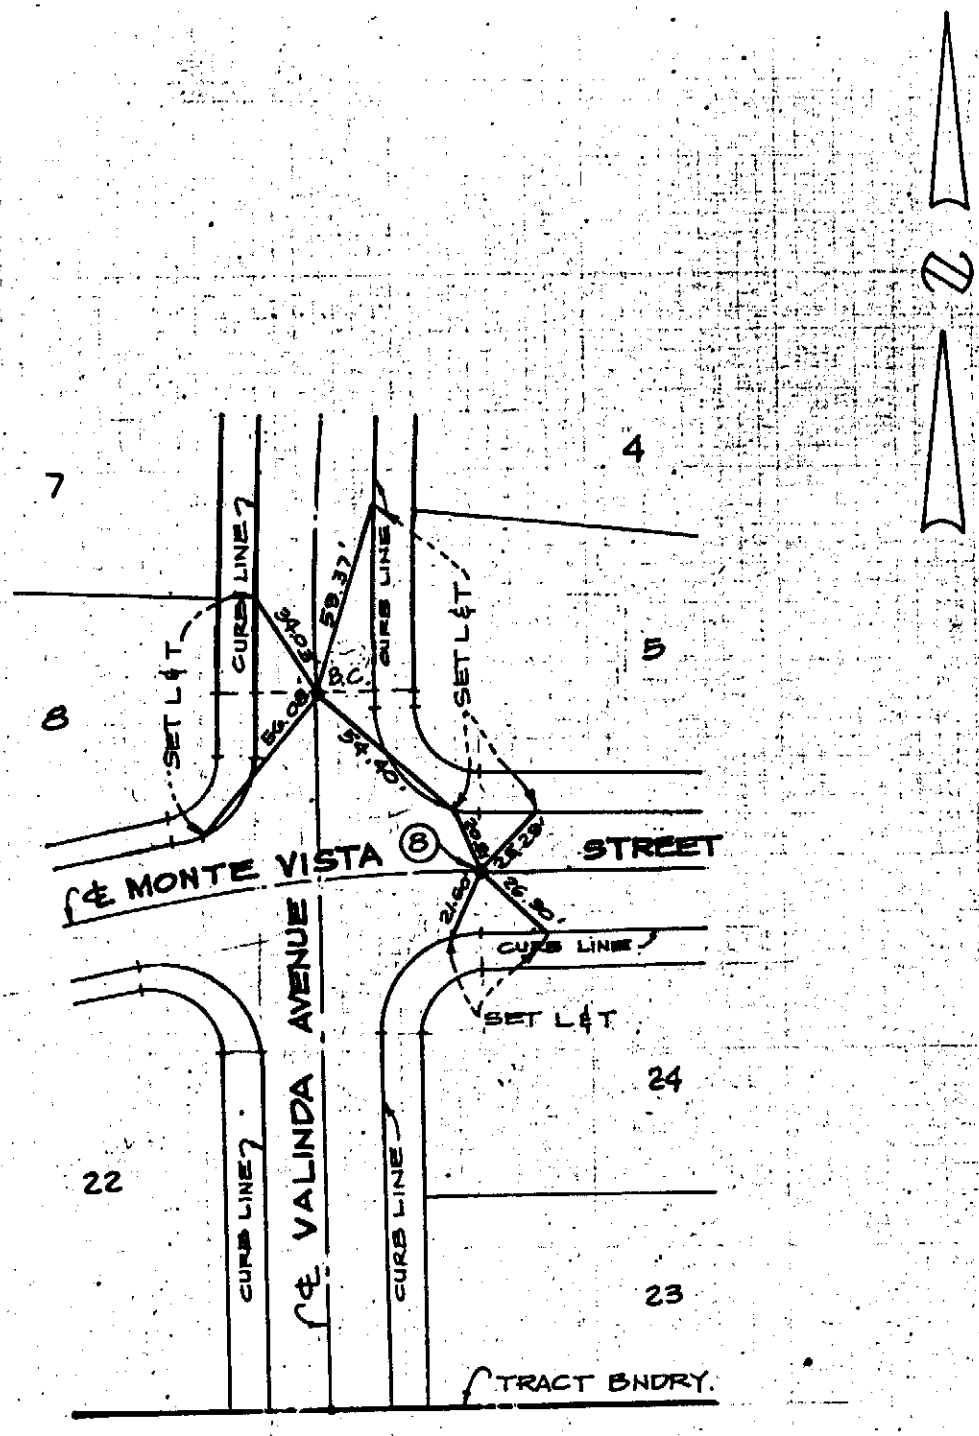

CITY of RANCHO CUCAMONGA — STREET TIE	TRACT No. 9436
Madole & Associates, Inc. Consulting Civil Engineering and Land Planning 1820 E. 16th Street, Santa Ana, CA 92701 (714) 835-2548	VALINDA AVENUE & MONTE VISTA STREET MON. NO. (8) & VALINDA AVE. B.C.
ENGINEER: J. M. Madole J. M. MADOLE R.C.E. 14814 DATE 11-12-81	FIELD REVIEW _____ DATE _____ TIE BOOK 5 PAGE 43

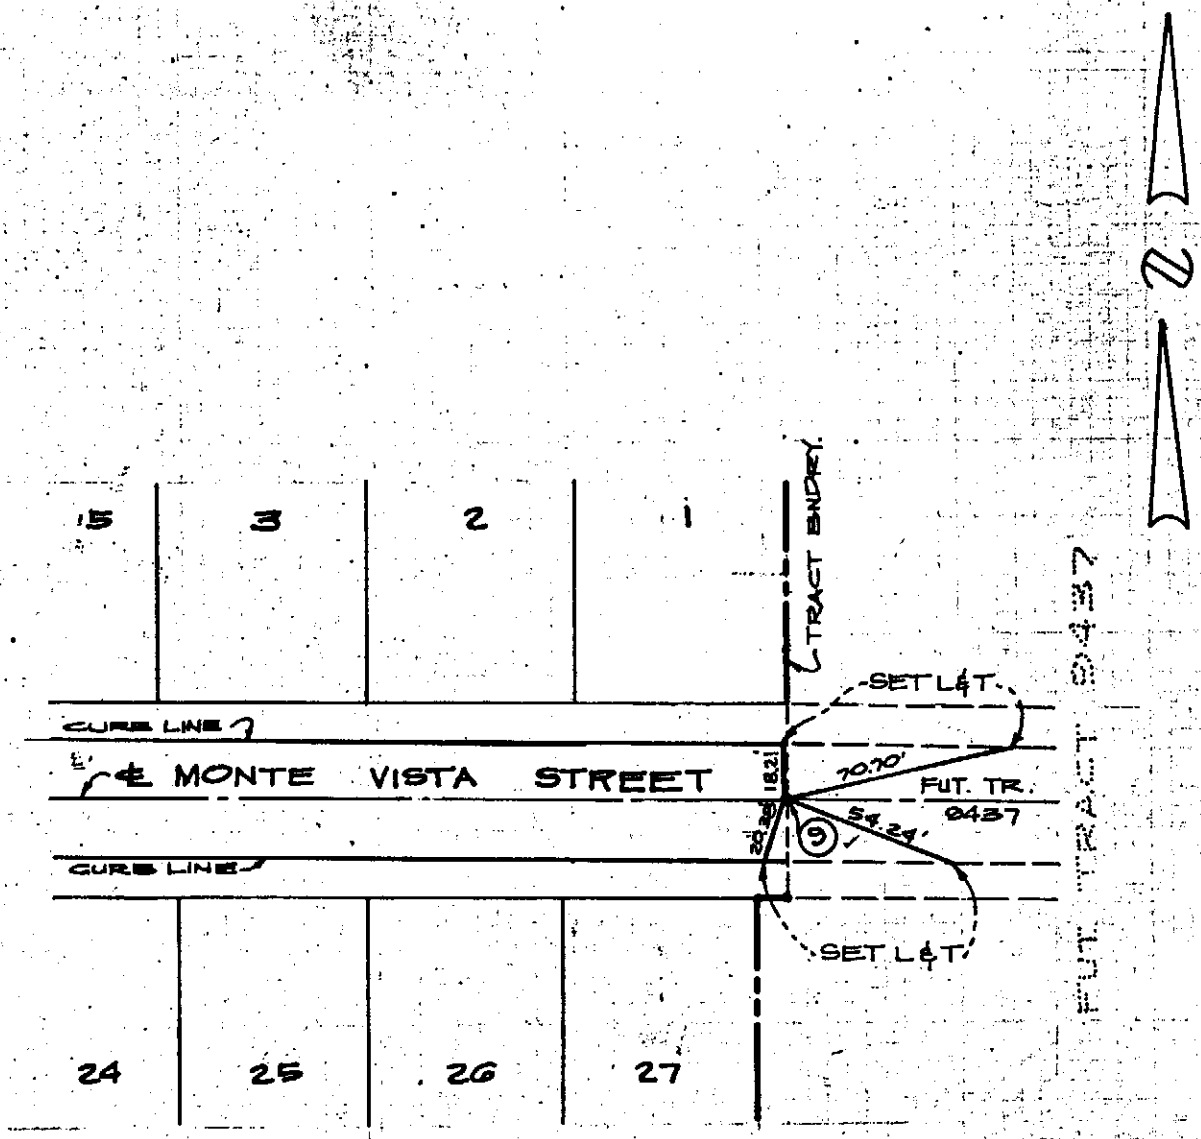

CITY of RANCHO CUCAMONGA — STREET TIE	TRACT No. 9436
Madole & Associates, Inc. Consulting Civil Engineering and Land Planning 1820 E. 16th Street, Santa Ana, CA 92701 (714) 835-2548	MONTE VISTA STREET MON. NO. 9
ENGINEER: J. M. Madole J. M. MADOLE R.C.E. 14814 DATE 11-12-81	FIELD REVIEW _____ DATE _____ TIE BOOK 5 PAGE 44

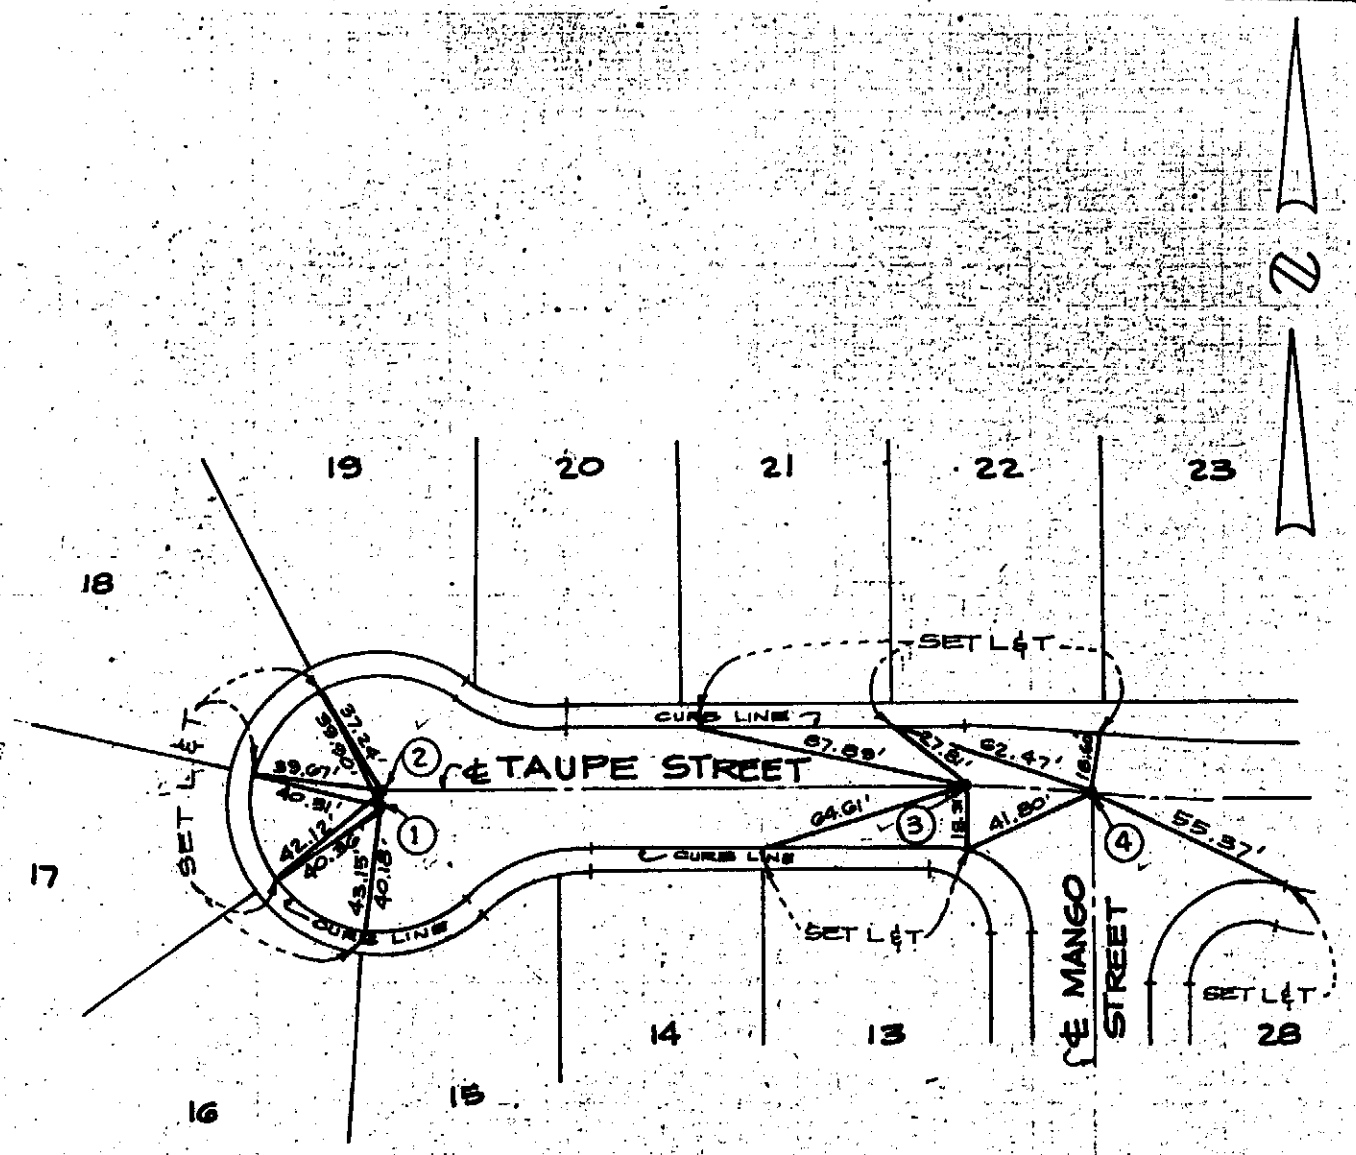

CITY of RANCHO CUCAMONGA — STREET TIE	TRACT No. 9437
Madole & Associates, Inc. Consulting Civil Engineering and Land Planning 1820 E. 16th Street, Santa Ana, CA 92701 (714) 835-2548	TAUPE STREET MON. NO. 1, 2, 3 & 4
ENGINEER: J. M. Madole J. M. MADOLE R.C.E. 14814 DATE 11-12-81	FIELD REVIEW _____ DATE _____ TIE BOOK 5 PAGE 45

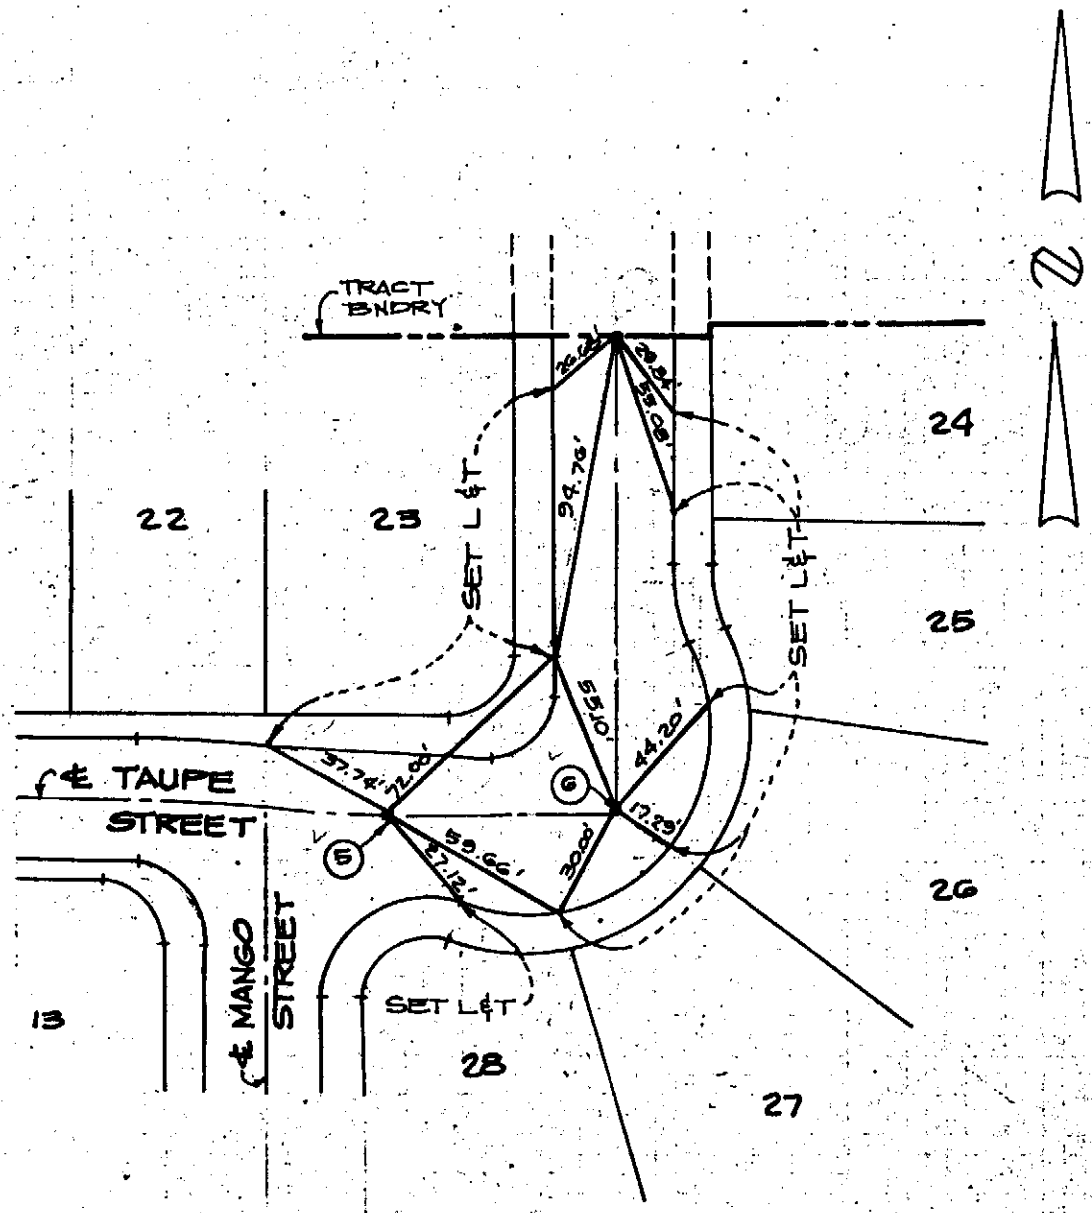

CITY of RANCHO CUCAMONGA — STREET TIE	TRACT No. 9437
Madole & Associates, Inc. Consulting Civil Engineering and Land Planning 1820 E. 16th Street, Santa Ana, CA 92701 (714) 835-2548	TAUPE STREET MON. NO. 5, 6
ENGINEER: J. M. Madole J. M. MADOLE R.C.E. 14814 DATE 11-12-81	FIELD REVIEW _____ DATE _____ TIE BOOK 5 PAGE 46

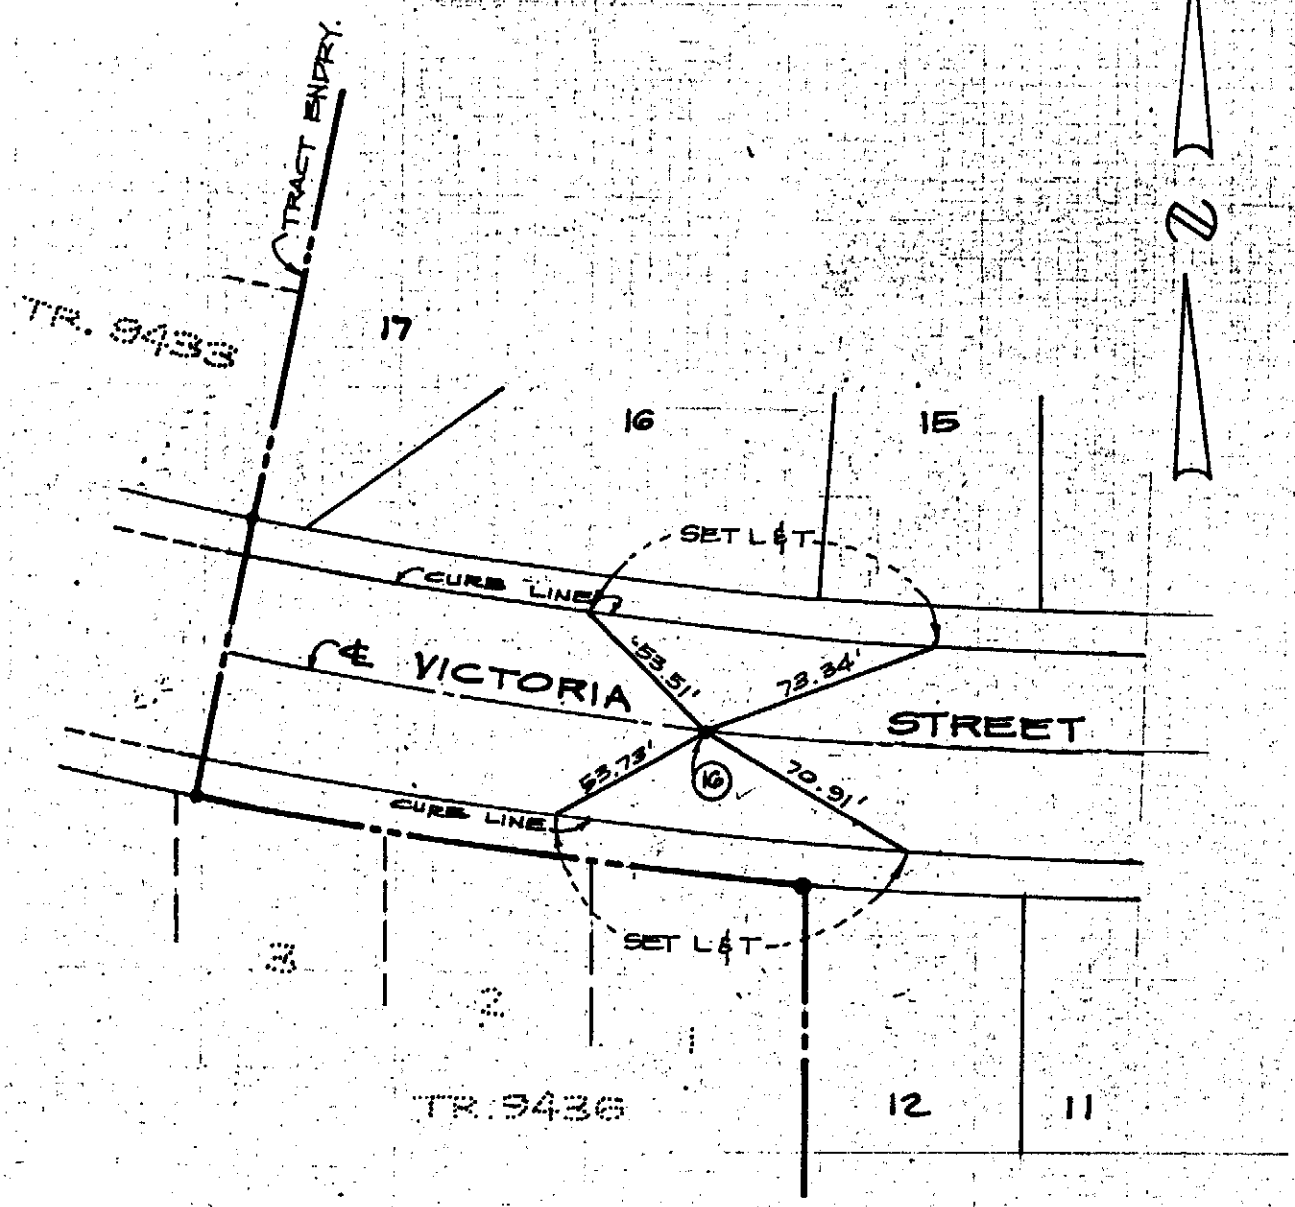

CITY of RANCHO CUCAMONGA — STREET TIE	TRACT No. 9437
Madole & Associates, Inc. Consulting Civil Engineering and Land Planning 1820 E. 16th Street, Santa Ana, CA 92701 (714) 835-2548	VICTORIA STREET MON. NO. 16
ENGINEER: J.M. Madole J. M. MADOLE R.C.E. 14814 DATE 11-12-81	FIELD REVIEW _____ DATE _____ TIE BOOK 5 PAGE 47

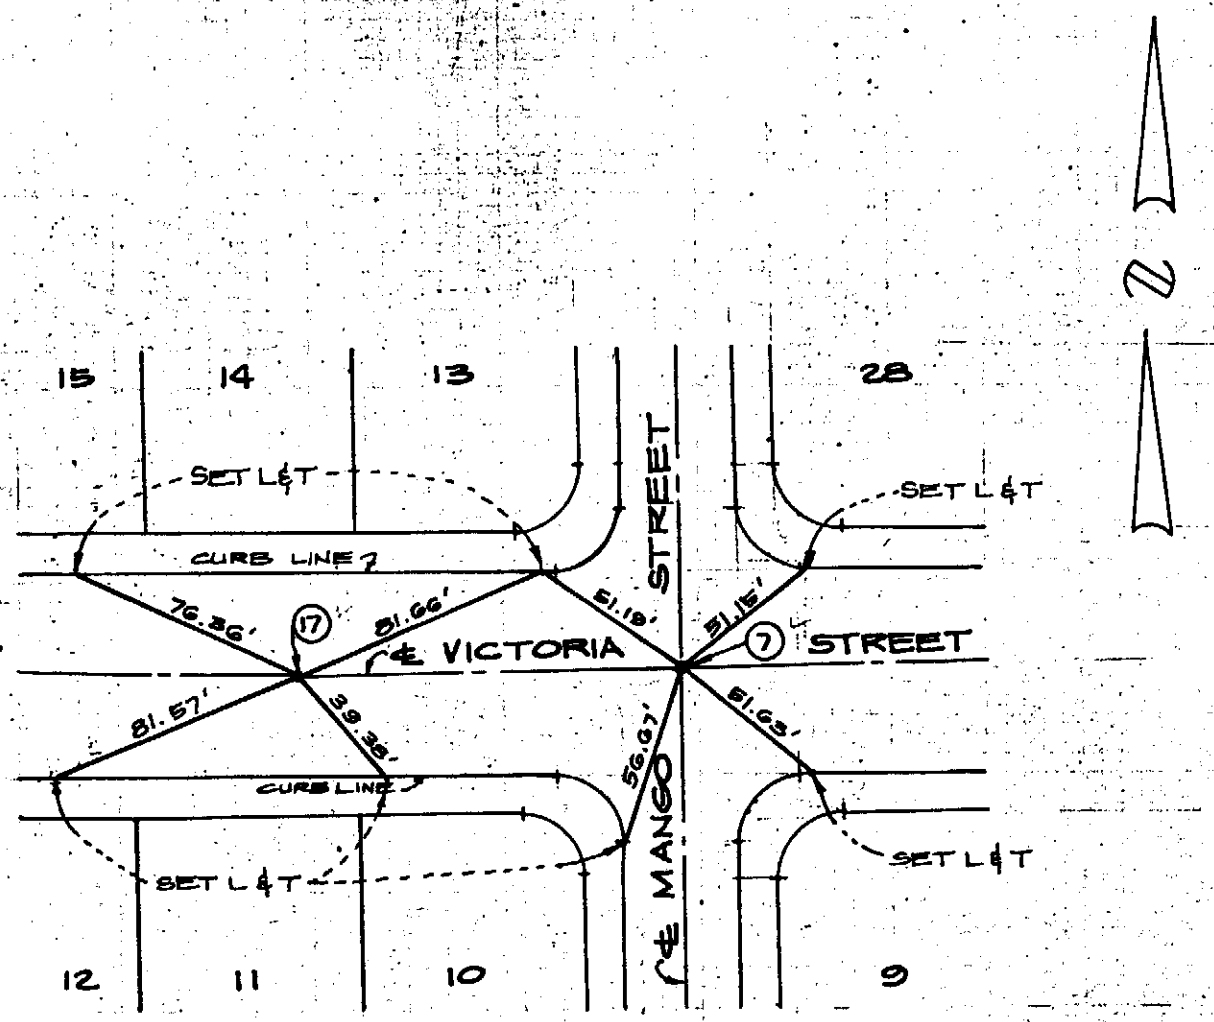

CITY of RANCHO CUCAMONGA — STREET TIE	TRACT No. 9437
Madole & Associates, Inc. Consulting Civil Engineering and Land Planning 1820 E. 16th Street, Santa Ana, CA 92701 (714) 835-2548	VICTORIA STREET & MANGO STREET MON. NO. 7 & 17
ENGINEER: J. M. Madole J. M. MADOLE R.C.E. 14814 DATE 11-12-81	FIELD REVIEW _____ DATE _____ TIE BOOK 5 PAGE 48

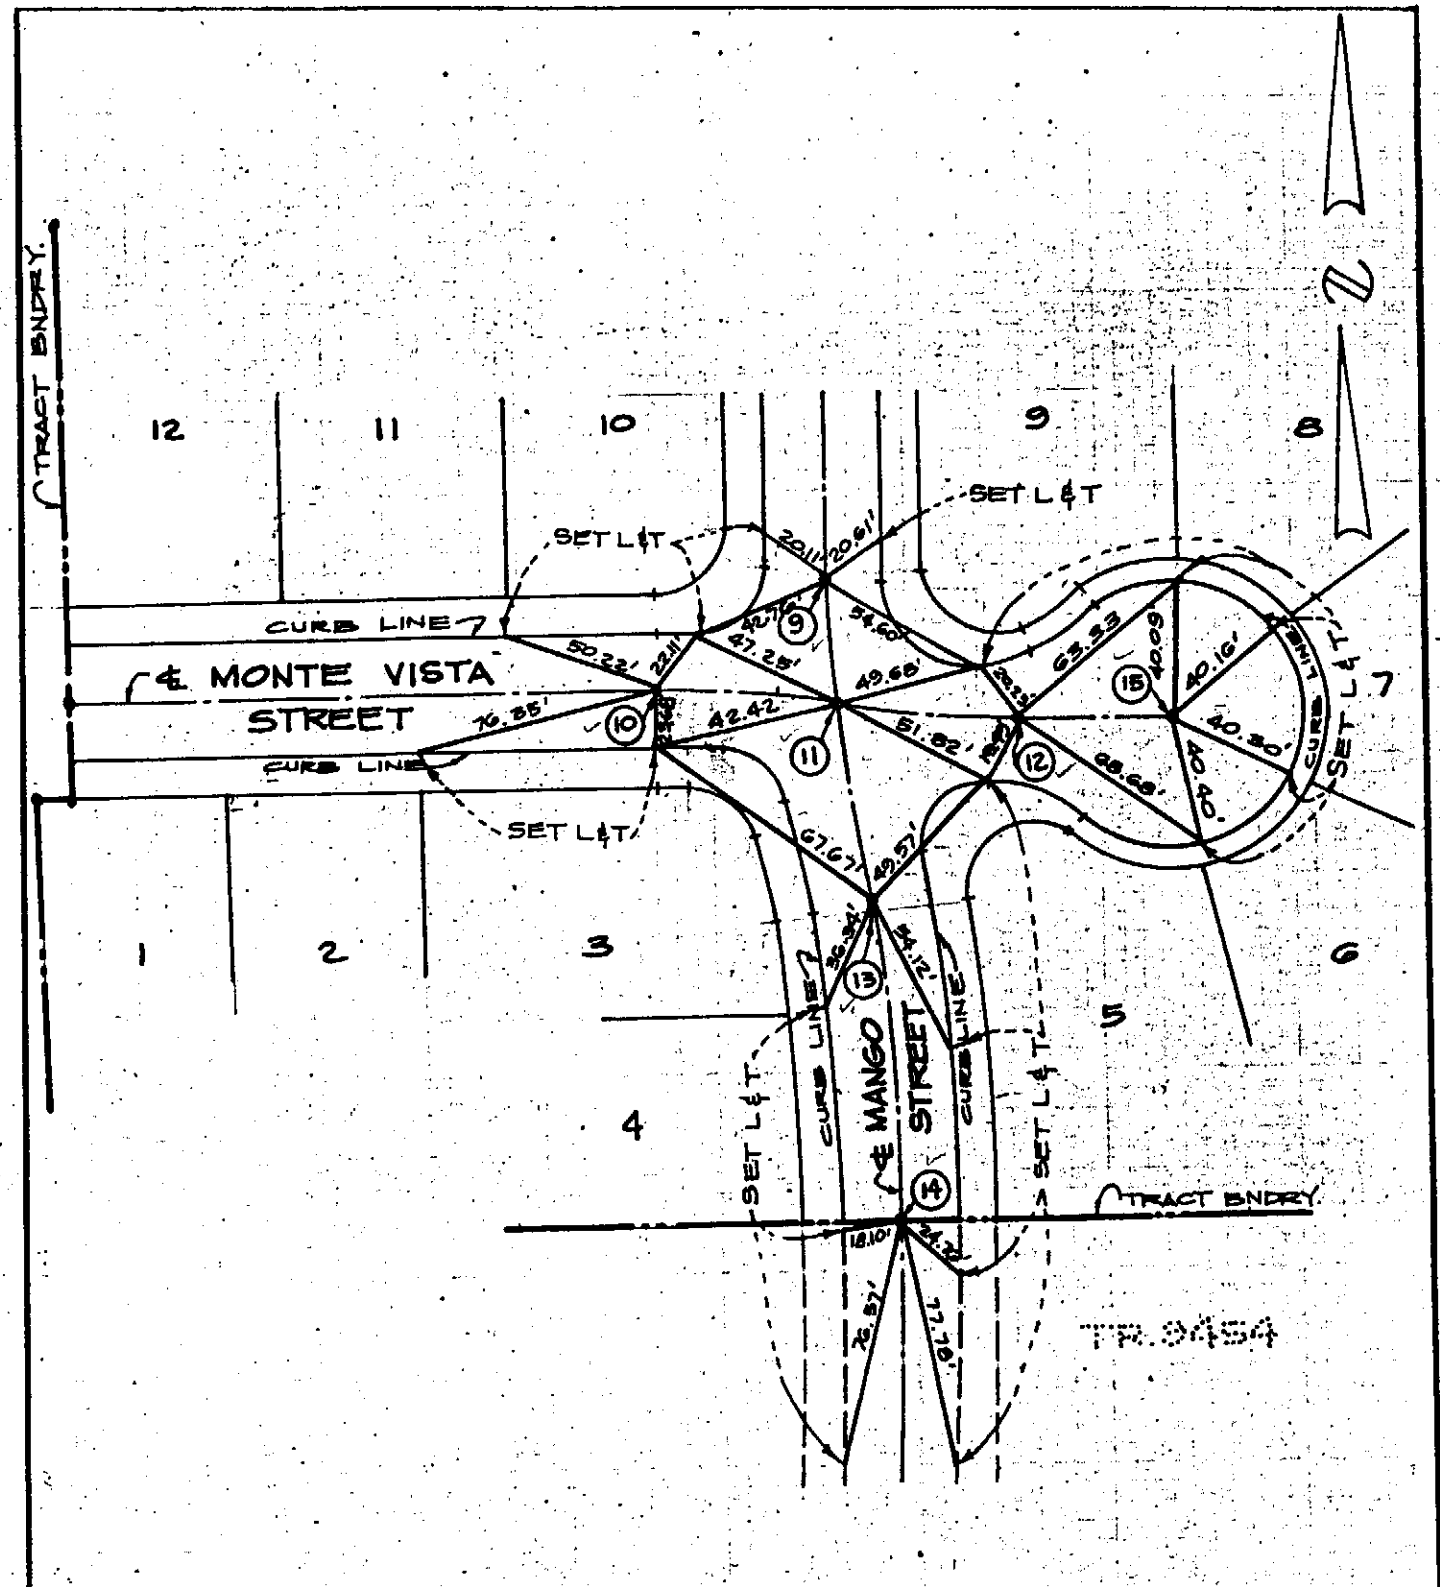

CITY of RANCHO CUCAMONGA — STREET TIE	TRACT No. 9437
Madole & Associates, Inc. Consulting Civil Engineering and Land Planning 1820 E. 16th Street, Santa Ana, CA 92701 (714) 835-2548	MONTE VISTA STREET ℄ MANGO STREET MON. NO. 9, 10, 11, 12, 13, 14, 15
ENGINEER: J. M. Madole J. M. MADOLE R.C.E. 14814 DATE 11-12-81	FIELD REVIEW _____ DATE _____ TIE BOOK 5 PAGE 49

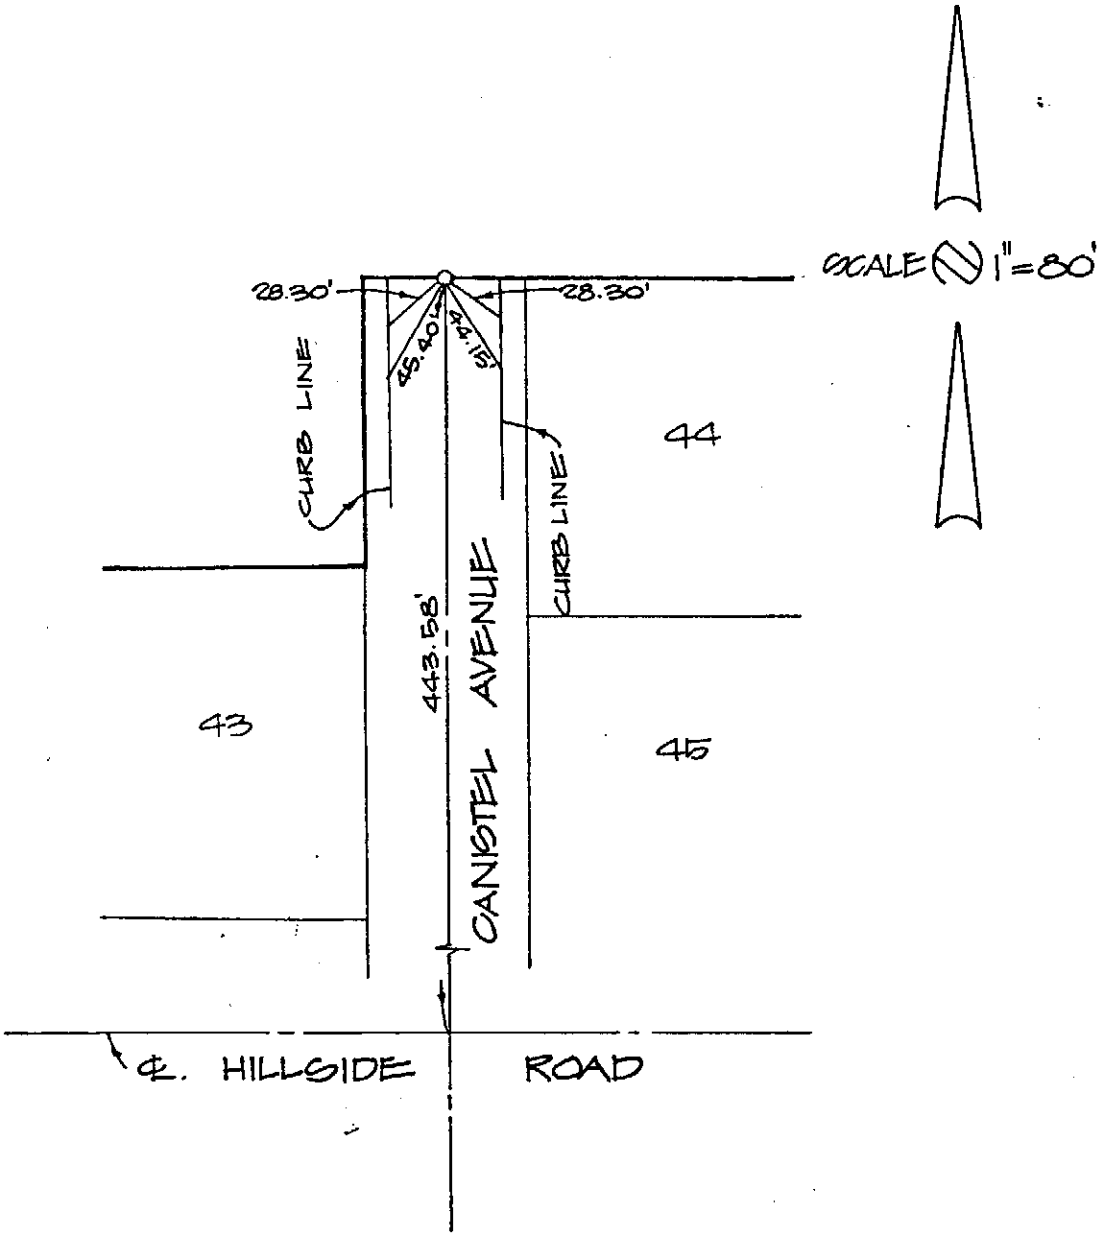

CITY OF RANCHO CUCAMONGA. STREET TIE	TRACT NO.9583
MADOLE AND ASSOCIATES, INC. 1820 E. 16th Street SANTA ANA, CALIFORNIA 92701 PHONE 714 • 835-2548	
ENGR. J.M. MADOLE	FIELD REVIEW _____ DATE _____
R.C.E. 14814 DATE 11-26-81	TIE BOOK 5 PAGE 50

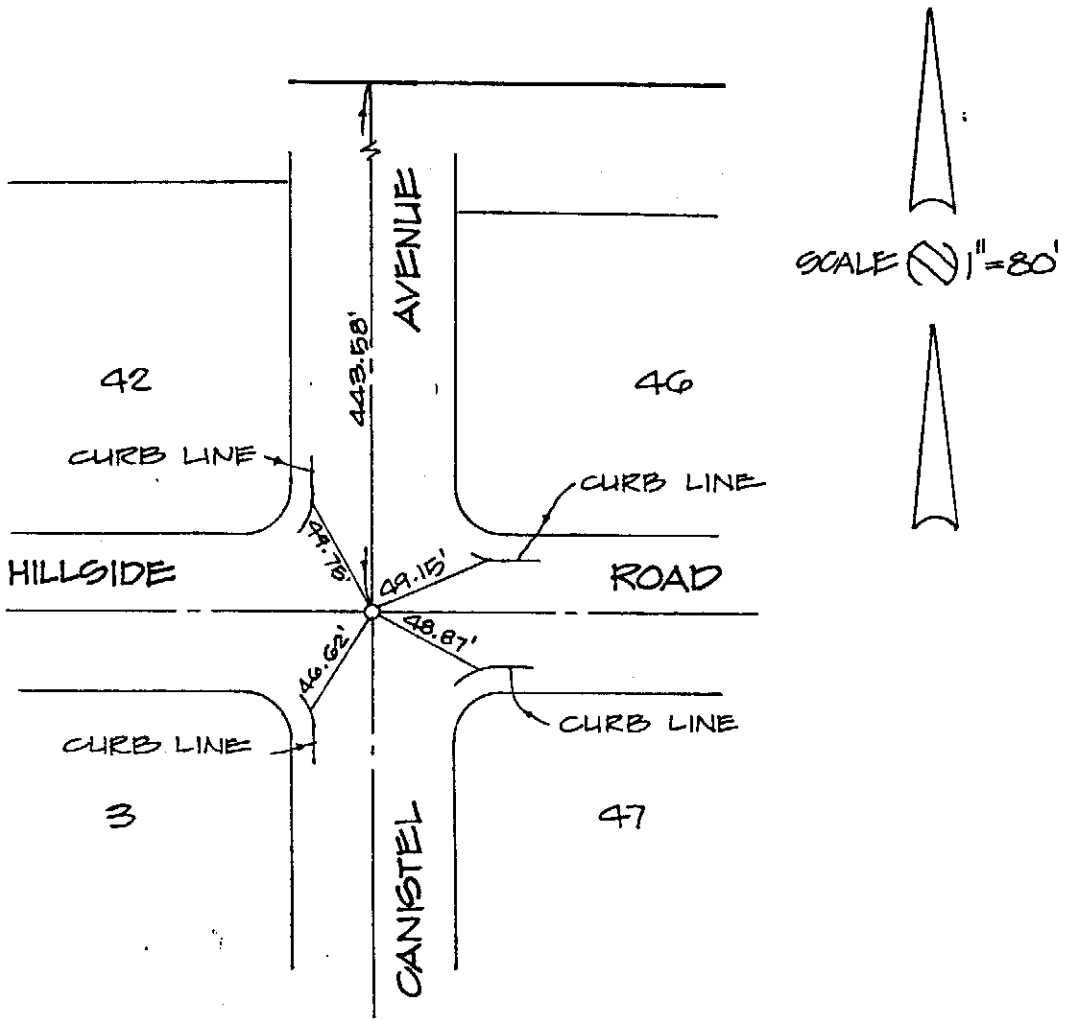

CITY OF RANCHO CUCAMONGA. STREET TIE	TRACT NO.9583
MADOLE AND ASSOCIATES, INC. 1820 E. 16th Street SANTA ANA, CALIFORNIA 92701 PHONE 714 • 835-2548	
ENGR. J.M. MADOLE	FIELD REVIEW _____ DATE _____
R.C.E. 14814 DATE 11-26-81	TIE BOOK 5 PAGE 51

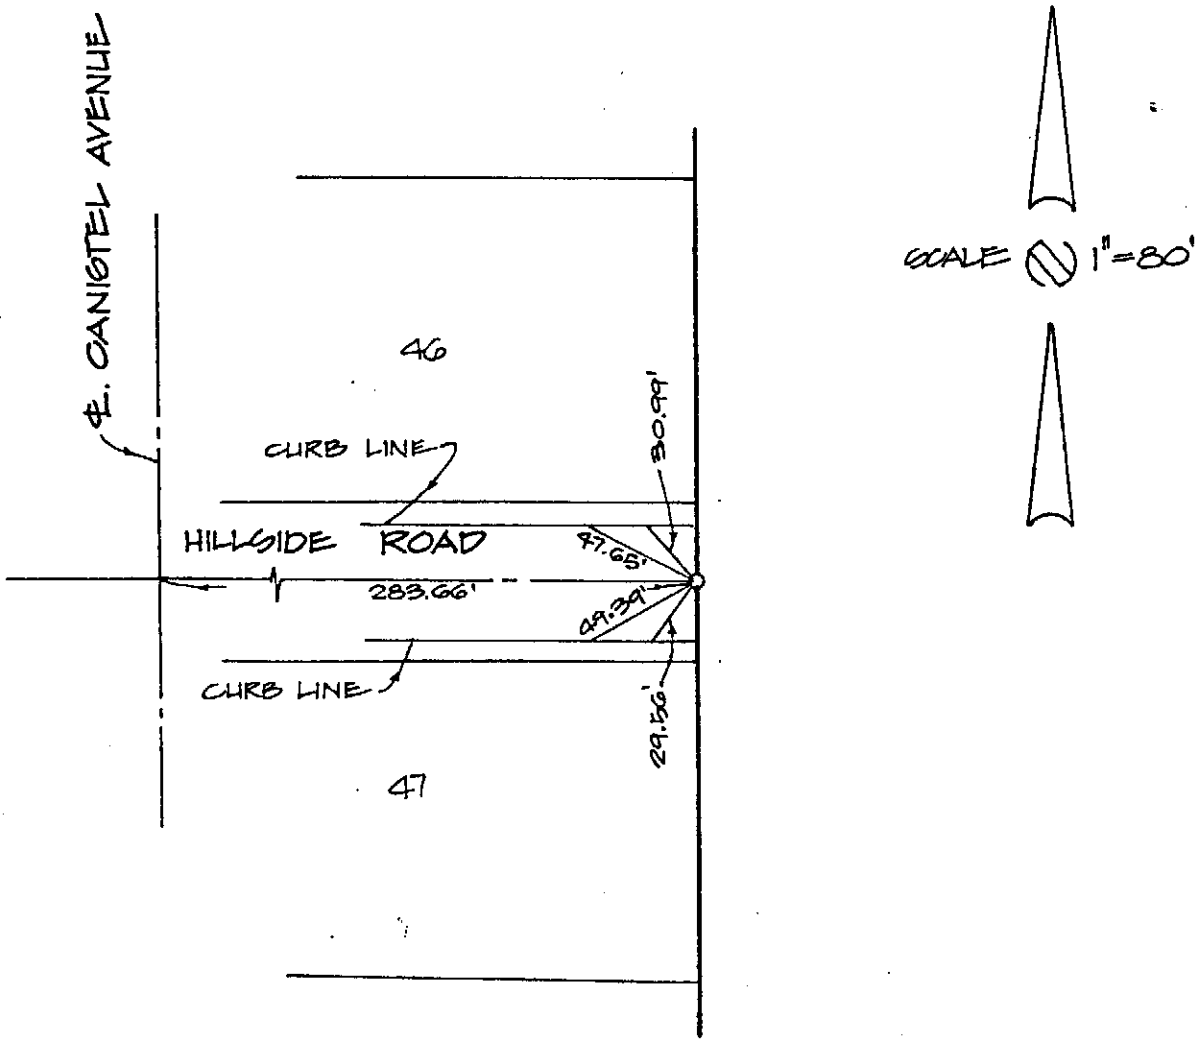

CITY OF RANCHO CUCAMONGA. STREET TIE	TRACT NO.9583
MADOLE AND ASSOCIATES, INC. 1820 E. 16th Street SANTA ANA, CALIFORNIA 92701 PHONE 714 • 835-2548	
ENGR. J.M. Madole J.M. MADOLE	FIELD REVIEW _____ DATE _____
R.C.E. 14814 DATE 11·26·81	TIE BOOK 5 PAGE 52

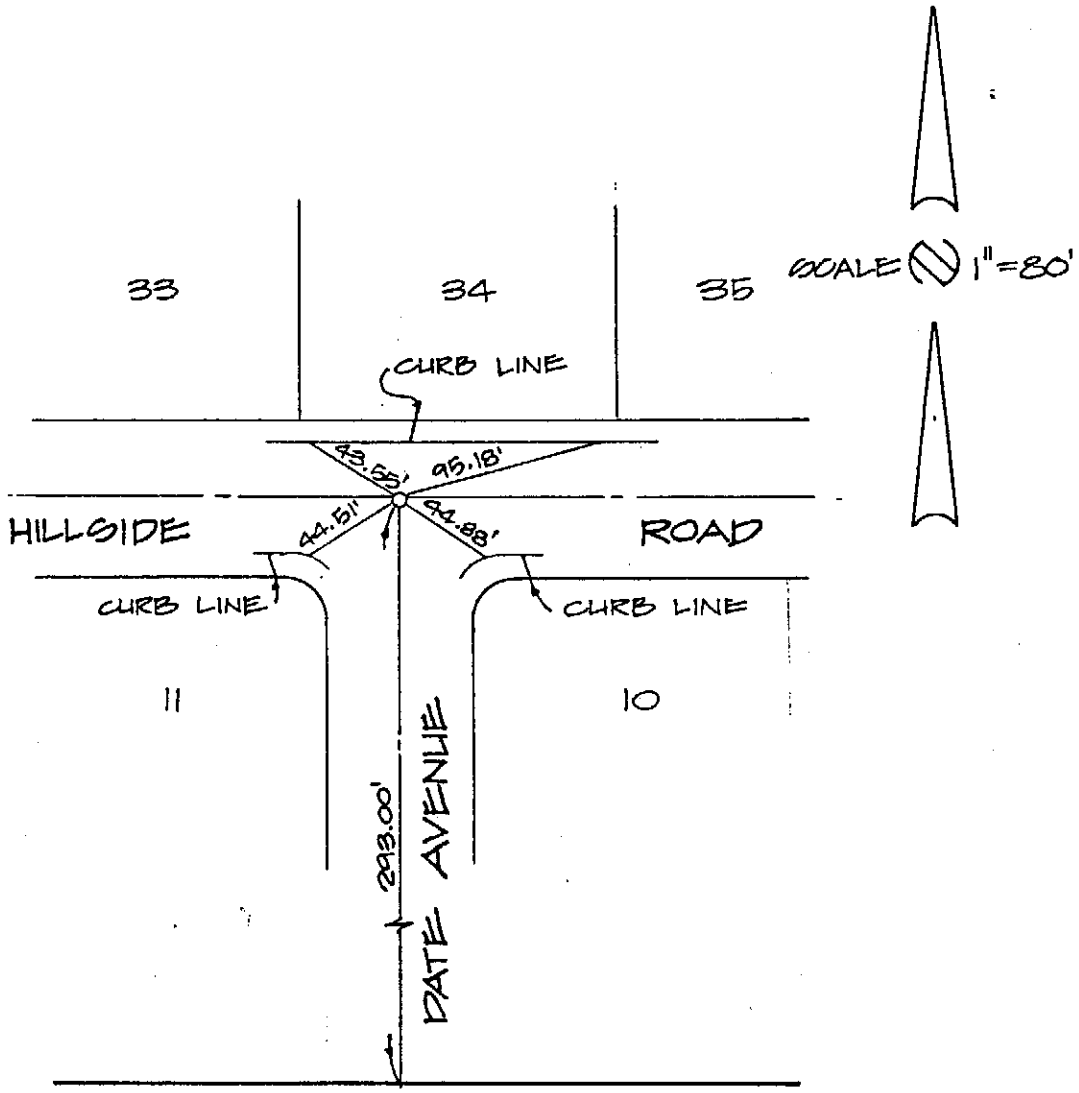

CITY OF RANCHO CUCAMONGA. STREET TIE	TRACT NO.9583
MADOLE AND ASSOCIATES, INC. 1820 E. 16th Street SANTA ANA, CALIFORNIA 92701 PHONE 714 • 835-2548	
ENGR. J.M. Madole J.M. MADOLE	FIELD REVIEW _____ DATE _____
R.C.E. 14814 DATE 11-26-81	TIE BOOK 5 PAGE 53

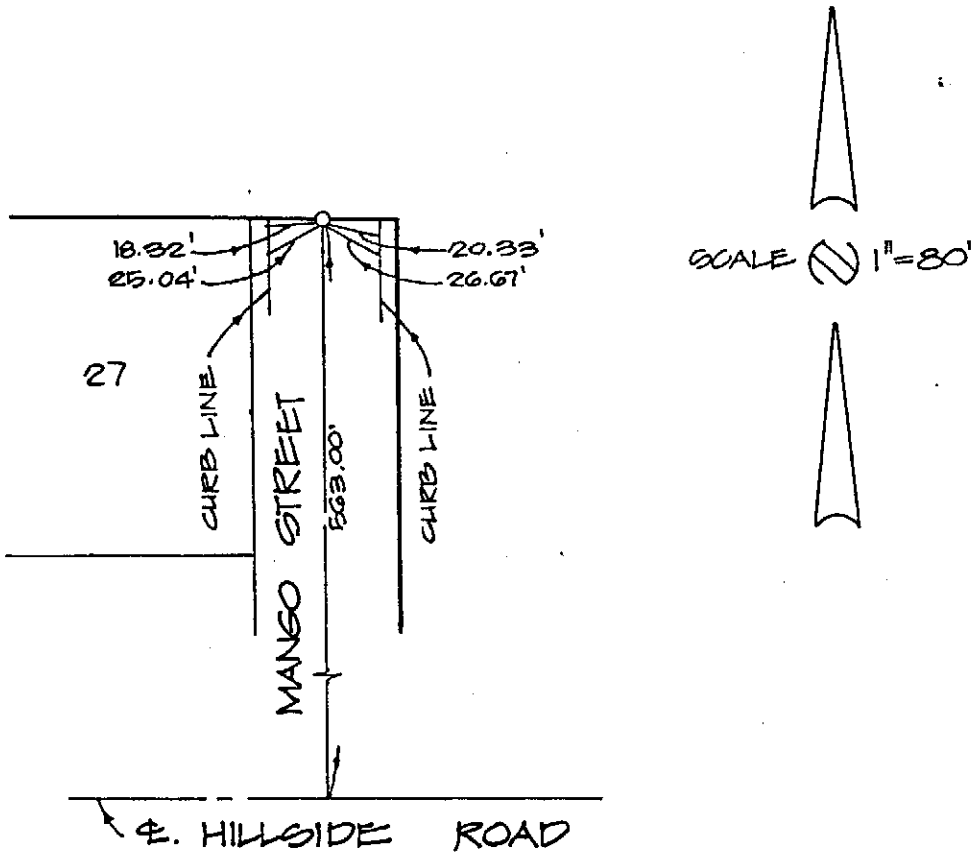

CITY OF RANCHO CUCAMONGA. STREET TIE	TRACT NO.9583
MADOLE AND ASSOCIATES, INC. 1820 E. 16th Street SANTA ANA, CALIFORNIA 92701 PHONE 714 • 835-2548	
ENGR. J.M. MADOLE	FIELD REVIEW _____ DATE _____
R.C.E. 14814 DATE 11-26-81	TIE BOOK 5 PAGE 54

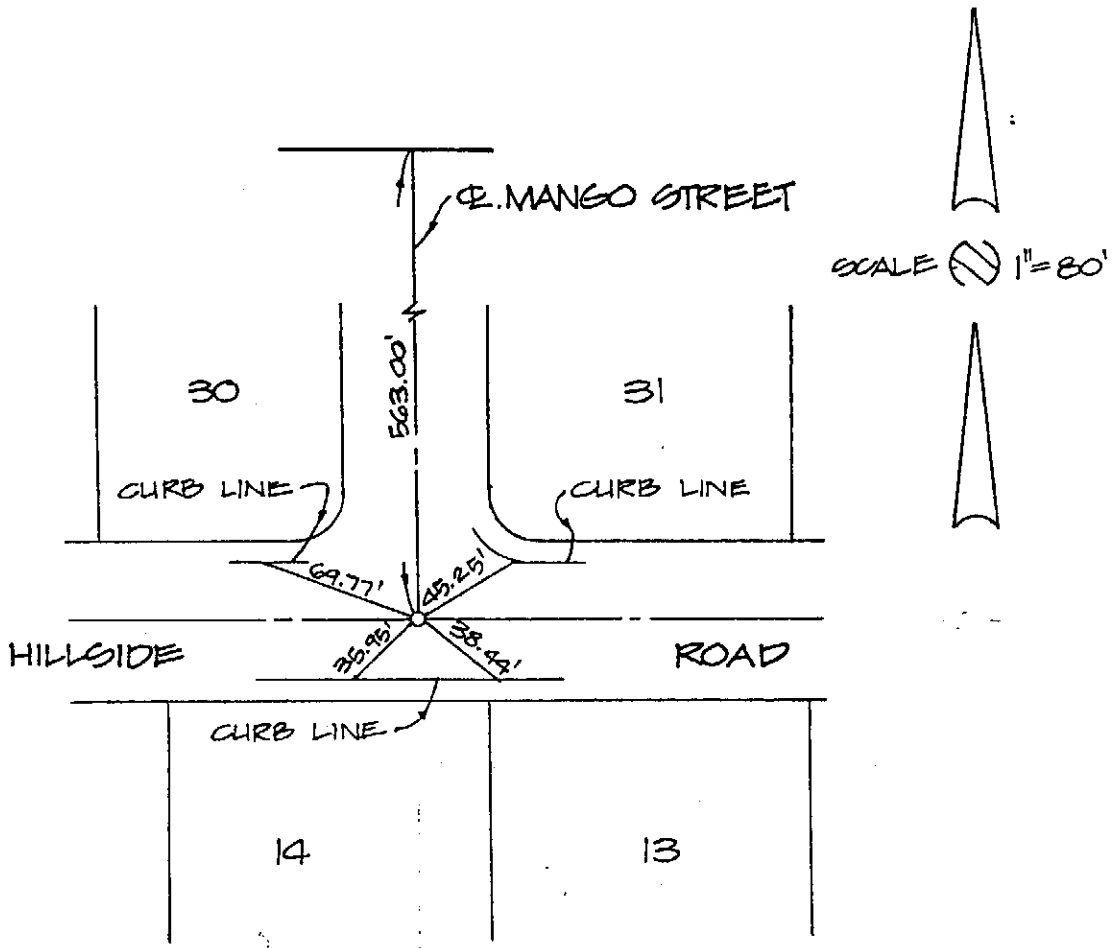

CITY OF RANCHO CUCAMONGA. STREET TIE	TRACT NO.9583
MADOLE AND ASSOCIATES, INC. 1820 E. 16th Street SANTA ANA, CALIFORNIA 92701 PHONE 714 • 835-2548	
ENGR. J.M. Madole J.M. MADOLE	FIELD REVIEW _____ DATE _____
R.C.E. 14814 DATE 11-26-81	TIE BOOK 5 PAGE 55

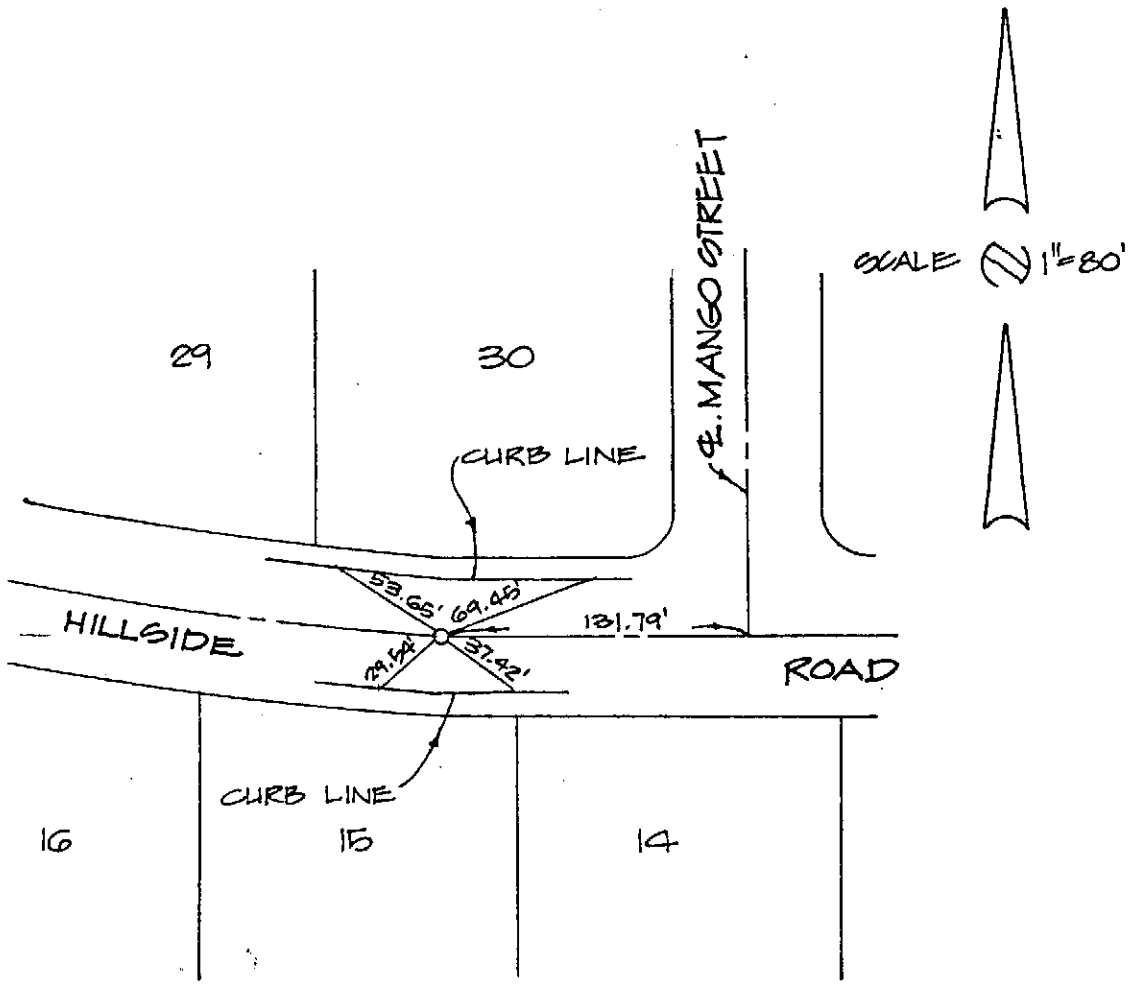

CITY OF RANCHO CUCAMONGA. STREET TIE	TRACT NO.9583
MADOLE AND ASSOCIATES, INC. 1820 E. 16th Street SANTA ANA, CALIFORNIA 92701 PHONE 714 • 835-2548	
ENGR. J.M. MADOLE	FIELD REVIEW _____ DATE _____
R.C.E. 14814 DATE 11·26·81	TIE BOOK 5 PAGE 56

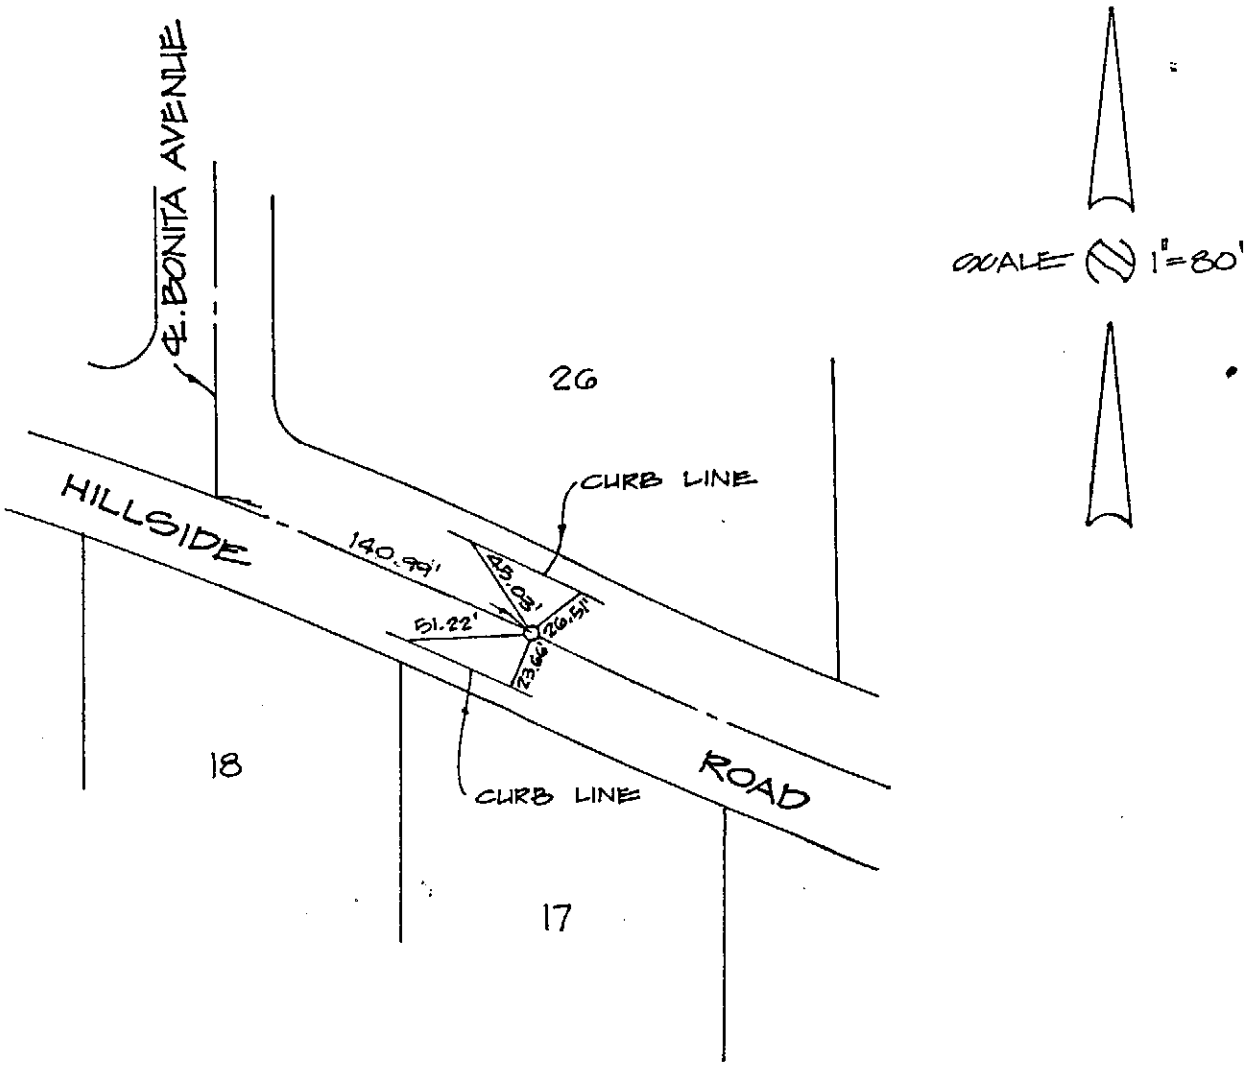

CITY OF RANCHO CUCAMONGA. STREET TIE	TRACT NO.9583
MADOLE AND ASSOCIATES, INC. 1820 E. 16th Street SANTA ANA, CALIFORNIA 92701 PHONE 714 • 835-2548	
ENGR. J.M. MADOLE	FIELD REVIEW _____ DATE _____
R.C.E. 14814 DATE 11·26·81	TIE BOOK 5 PAGE 57

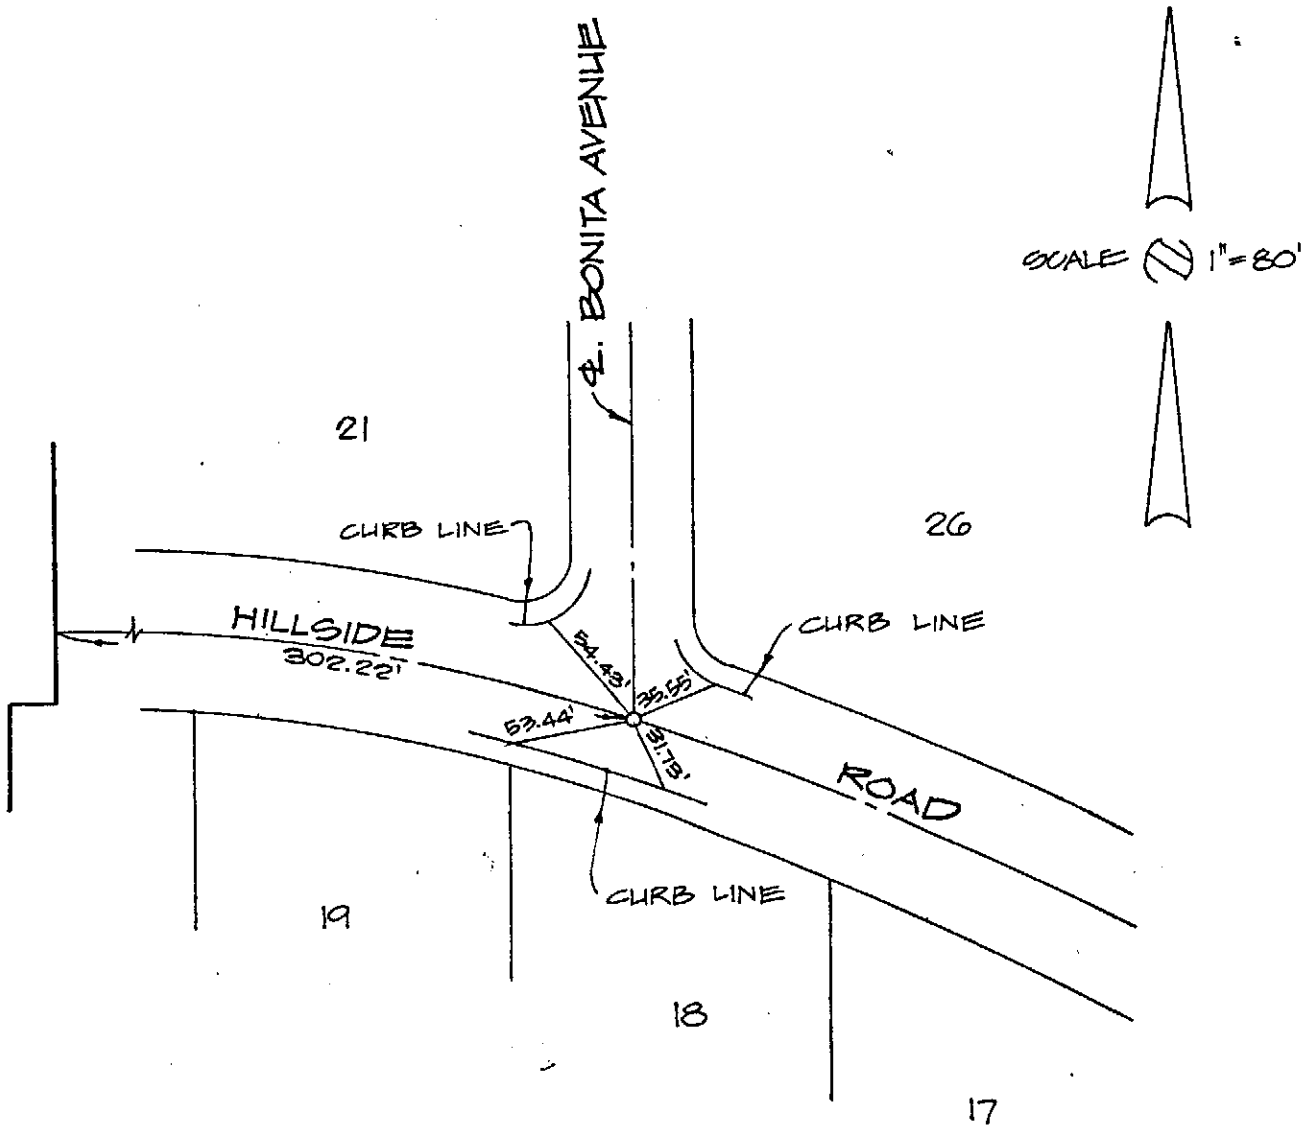

CITY OF RANCHO CUCAMONGA. STREET TIE	TRACT NO.9583
MADOLE AND ASSOCIATES, INC. 1820 E. 16th Street SANTA ANA, CALIFORNIA 92701 PHONE 714 • 835-2548	
ENGR. J.M. Madole J.M. MADOLE	FIELD REVIEW _____ DATE _____
R.C.E. 14814 DATE 11·26·81	TIE BOOK 5 PAGE 58

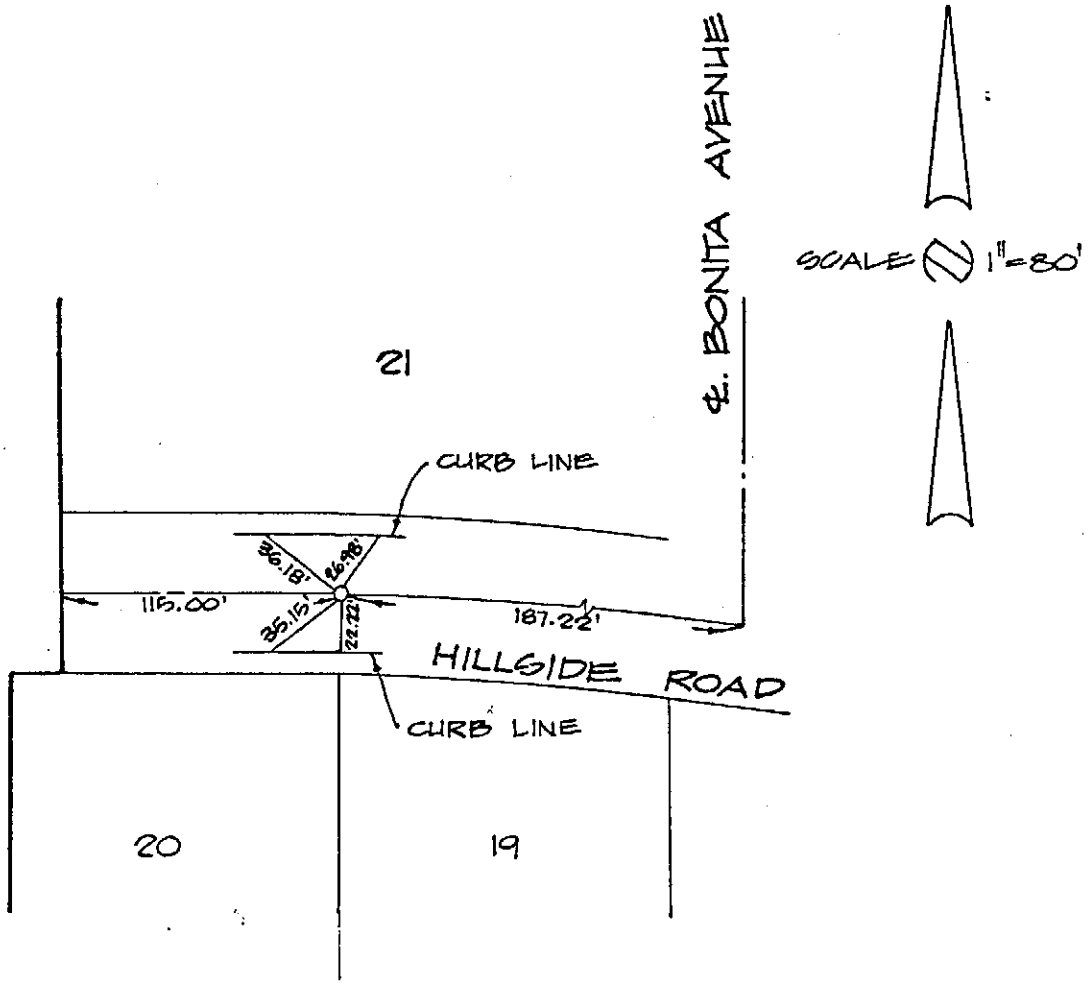

CITY OF RANCHO CUCAMONGA. STREET TIE	TRACT NO.9583
MADOLE AND ASSOCIATES, INC. 1820 E. 16th Street SANTA ANA, CALIFORNIA 92701 PHONE 714 • 835-2548	
ENGR. J.M. MADOLE	FIELD REVIEW _____ DATE _____
R.C.E. 14814 DATE 11.26.81	TIE BOOK 5 PAGE 59

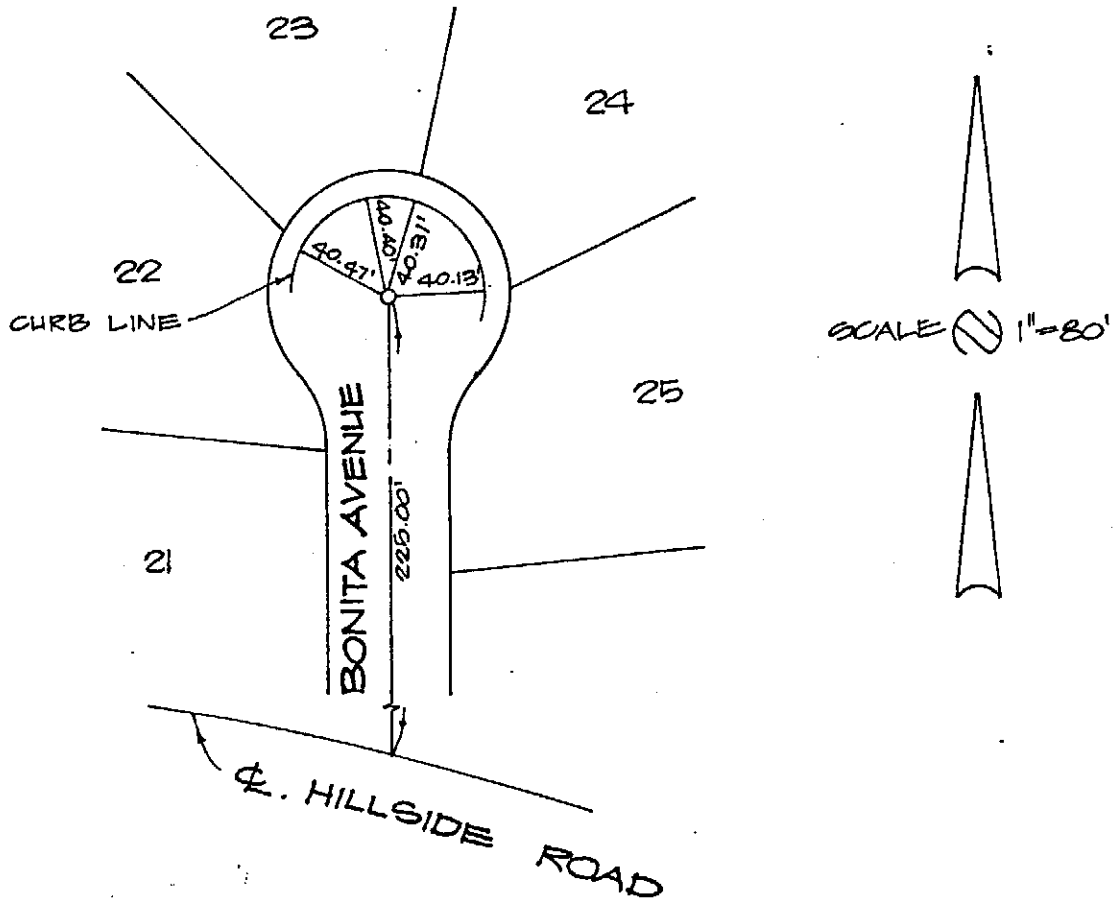

CITY OF RANCHO CUCAMONGA. STREET TIE	TRACT NO.9583
MADOLE AND ASSOCIATES, INC. 1820 E. 16th Street SANTA ANA, CALIFORNIA 92701 PHONE 714 • 835-2548	
ENGR. J.M. Madole J.M. MADOLE	FIELD REVIEW _____ DATE _____
R.C.E. 14814 DATE 11-26-81	TIE BOOK 5 PAGE 60

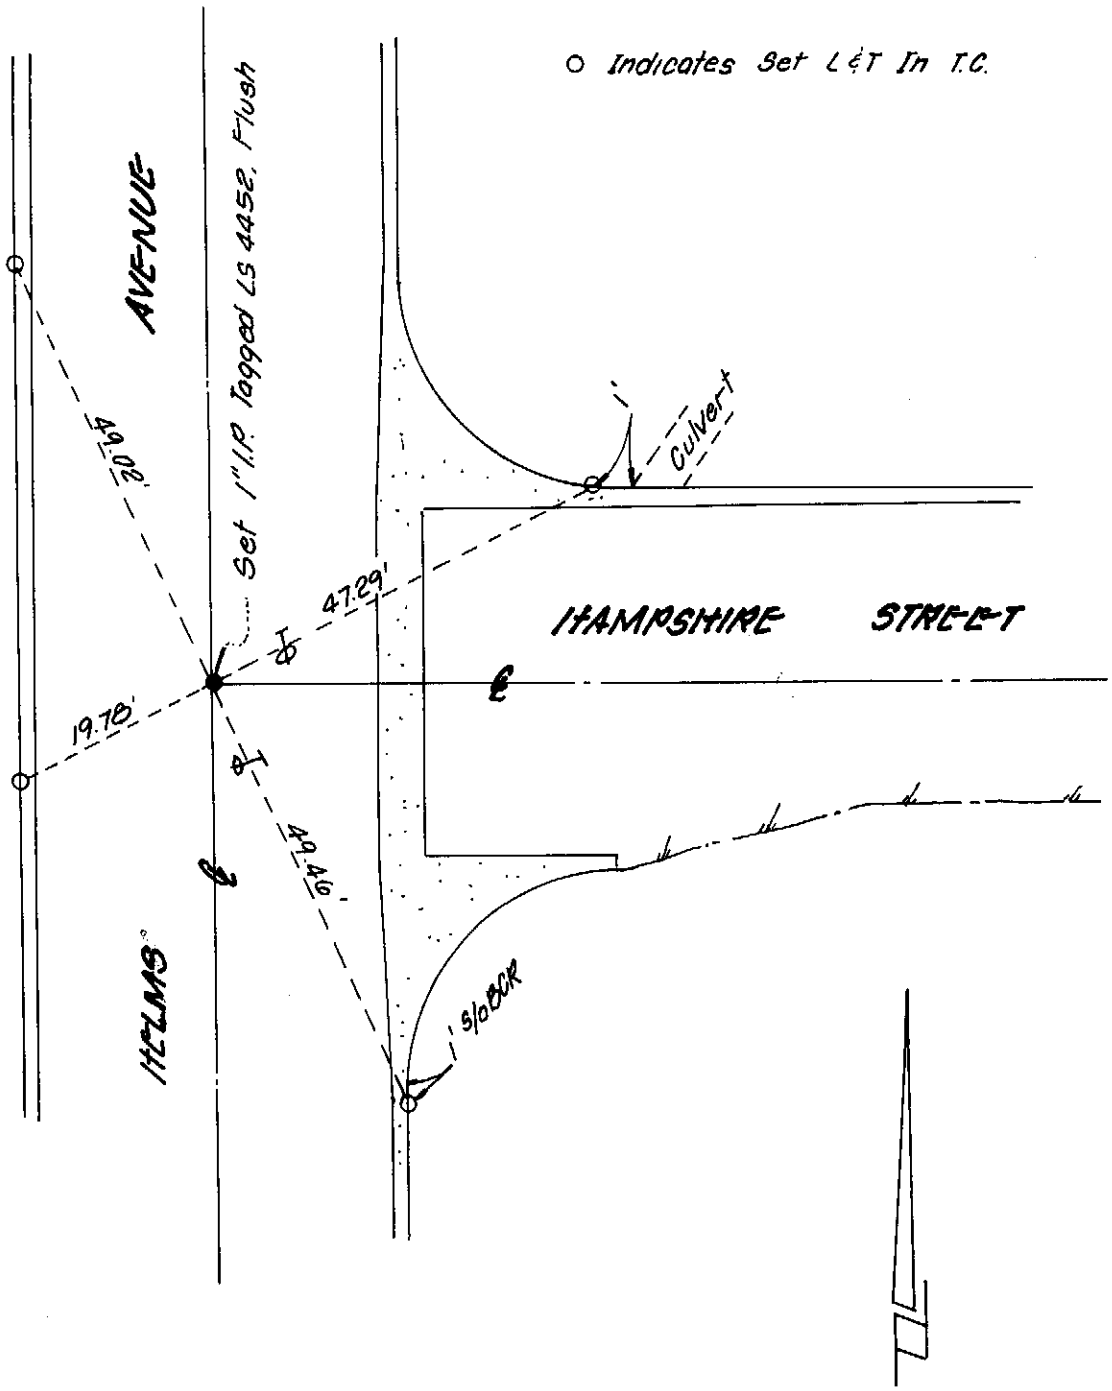

city of rancho cucamonga — STREET TIE	PARCEL MAP 6582
LINVILLE-SANDERSON-HORN & ASSOCIATES 9587 ARROW RTE. STE. "H" RANCHO CUCAMONGA, CA 9130	HELMS AVENUE AND HAMPSHIRE STREET
L.S. Gary L. Sanderson	FIELD REVIEW _____ DATE _____
L.S. No. 4452 DATE 1-15-82	TIE BOOK 5 PAGE 61

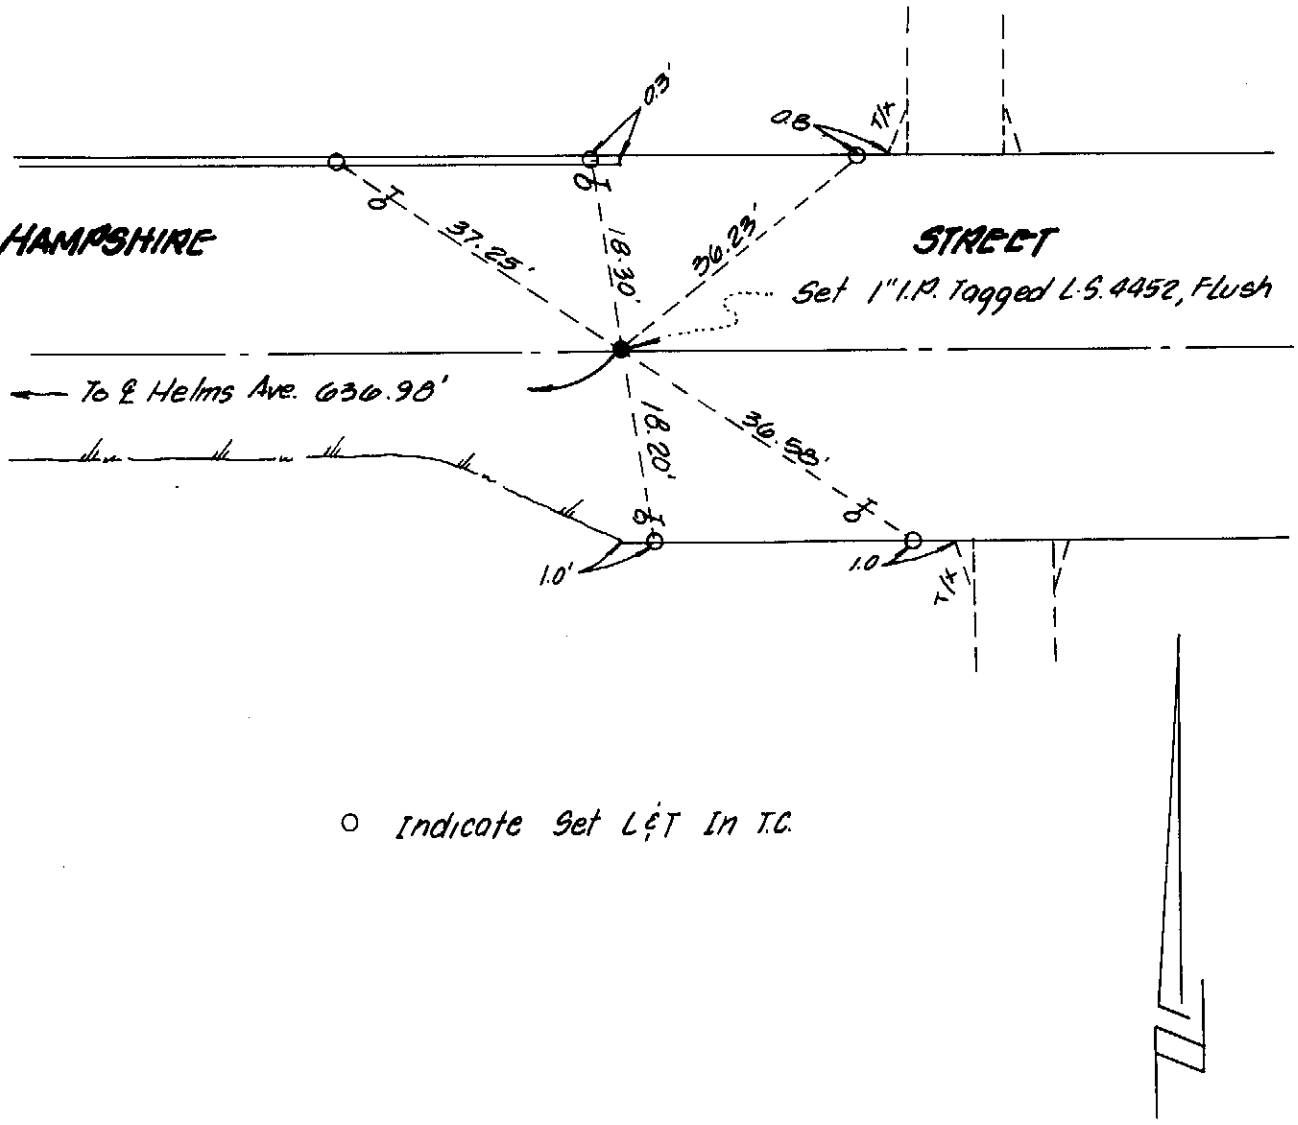

city of rancho cucamonga — STREET TIE	PARCEL MAP 6502
LINVILLE-SANDERSON-HORN & ASSOCIATES 9567 ARROW RTE. STE "H" RANCHO CUCAMONGA, CA 91730	HAMPSHIRE STREET East Of Helms Ave
L.S. Gary F. Sanderson	FIELD REVIEW _____ DATE _____
L.S. No. 4452 DATE 1-15-82	TIE BOOK 5 PAGE 62

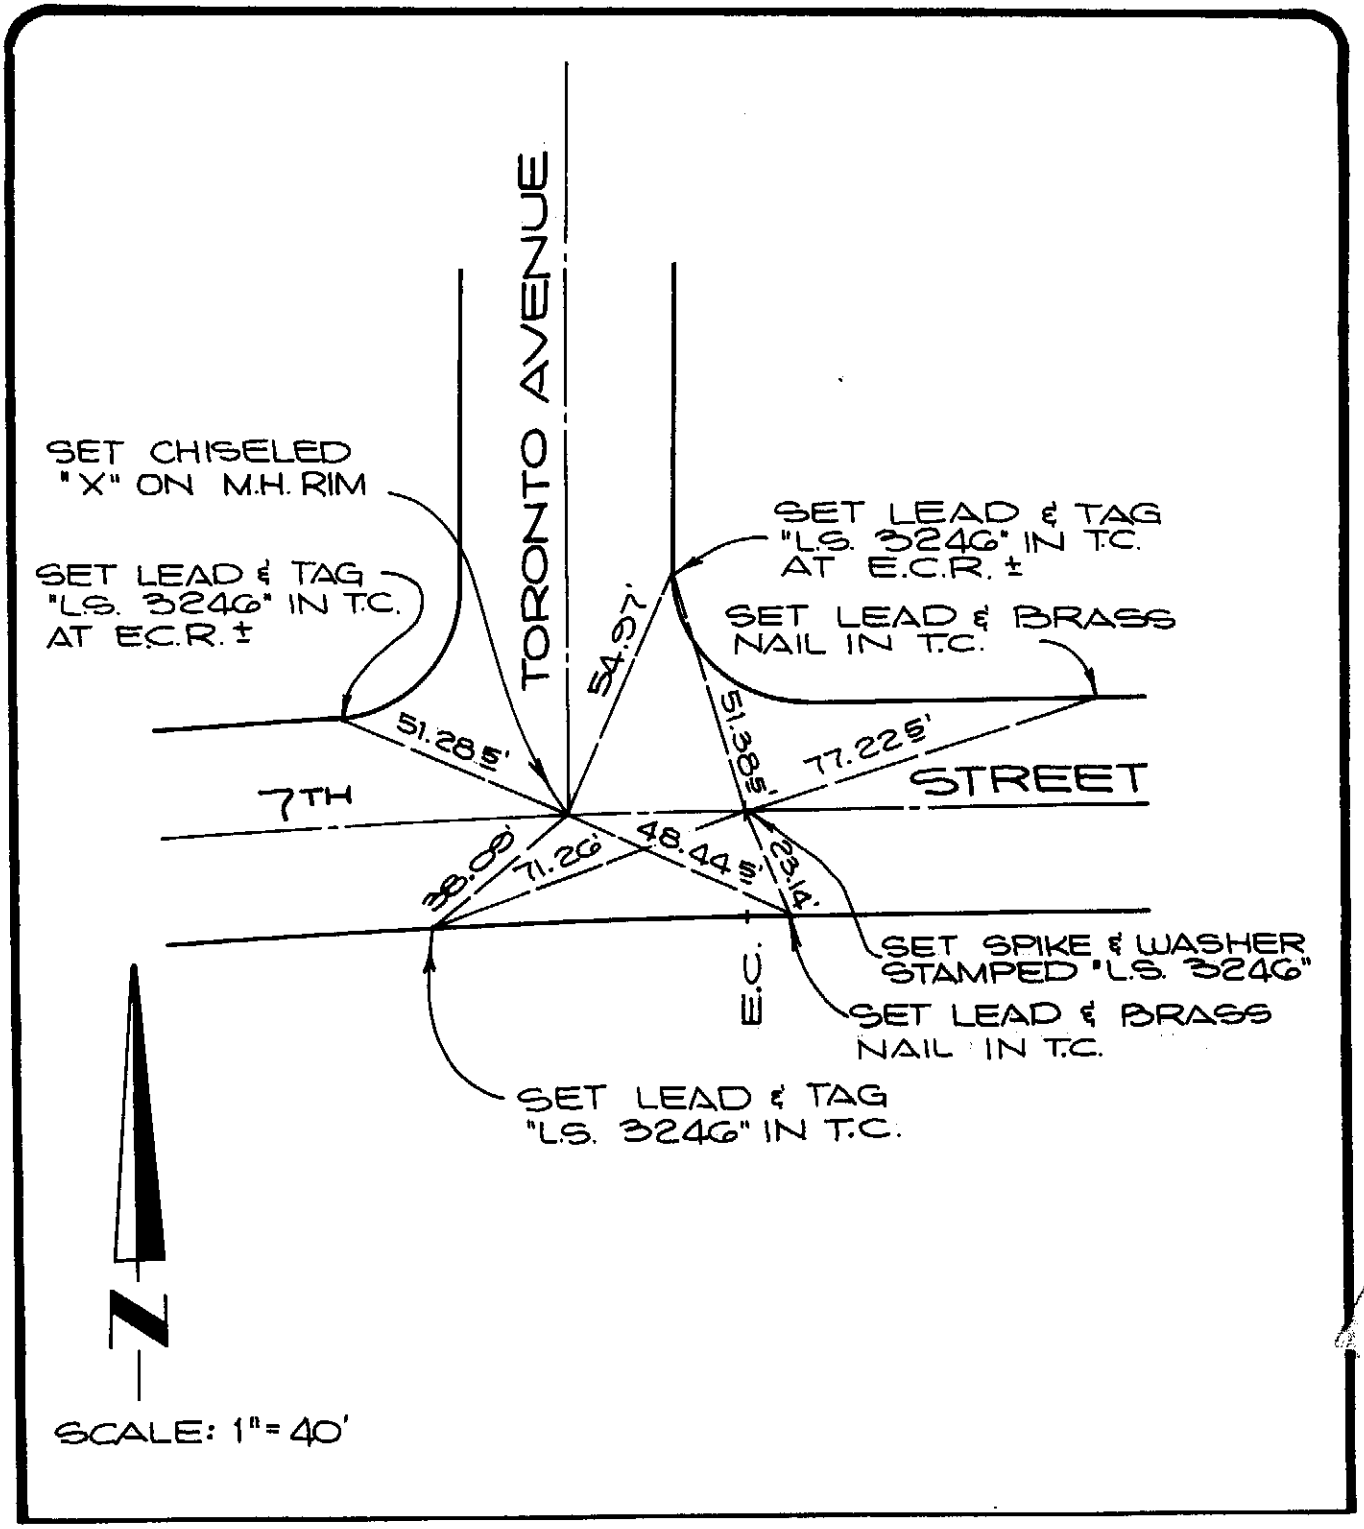

city of rancho cucamonga — STREET TIE	P.M. NO. 6194 P.M.B. 66/66-70
WILLIAMSON AND SCHMID CIVIL ENGINEERS 17782 SKY PARK BOULEVARD IRVINE, CALIFORNIA 92714 PHONE: (714) 549-2222	7TH STREET AND TORONTO AVENUE
~~ENGR.~~ / L.S. GERALD F. OLDENBURG	FIELD REVIEW _____ DATE _____
~~R.C.E.~~ / L.S. No. 3246 DATE 11-2-81	TIE BOOK 5 PAGE 68

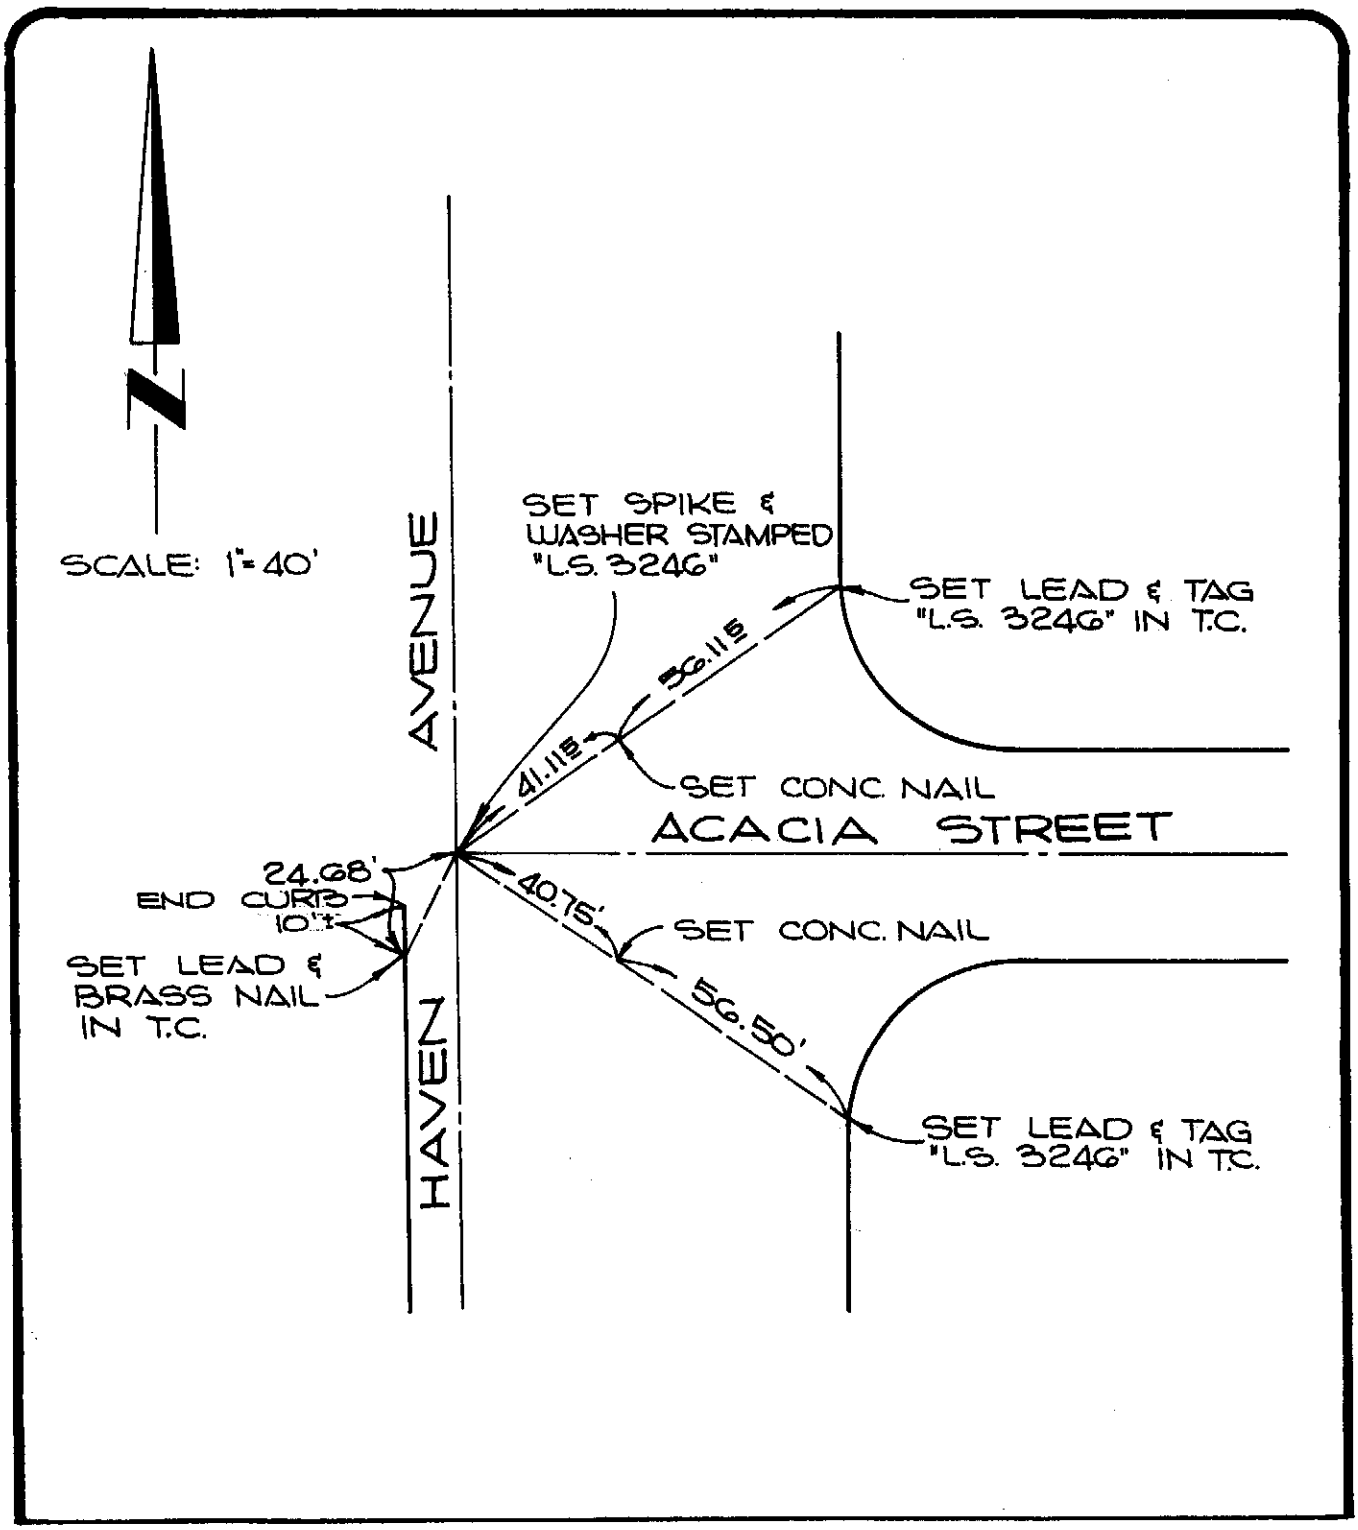

city of rancho cucamonga — STREET TIE	P.M. NO. 6194 P.M.B. 66/66-70
WILLIAMSON AND SCHMID CIVIL ENGINEERS 17782 SKY PARK BOULEVARD IRVINE, CALIFORNIA 92714 PHONE: (714) 549-2222	HAVEN AVENUE AND ACACIA STREET
~~ENGR.~~ / L.S. GERALD F. OLDENBURG	FIELD REVIEW _____ DATE _____
~~R.C.E.~~ / L.S. No. 3246 DATE 11-2-81	TIE BOOK 5 PAGE 64

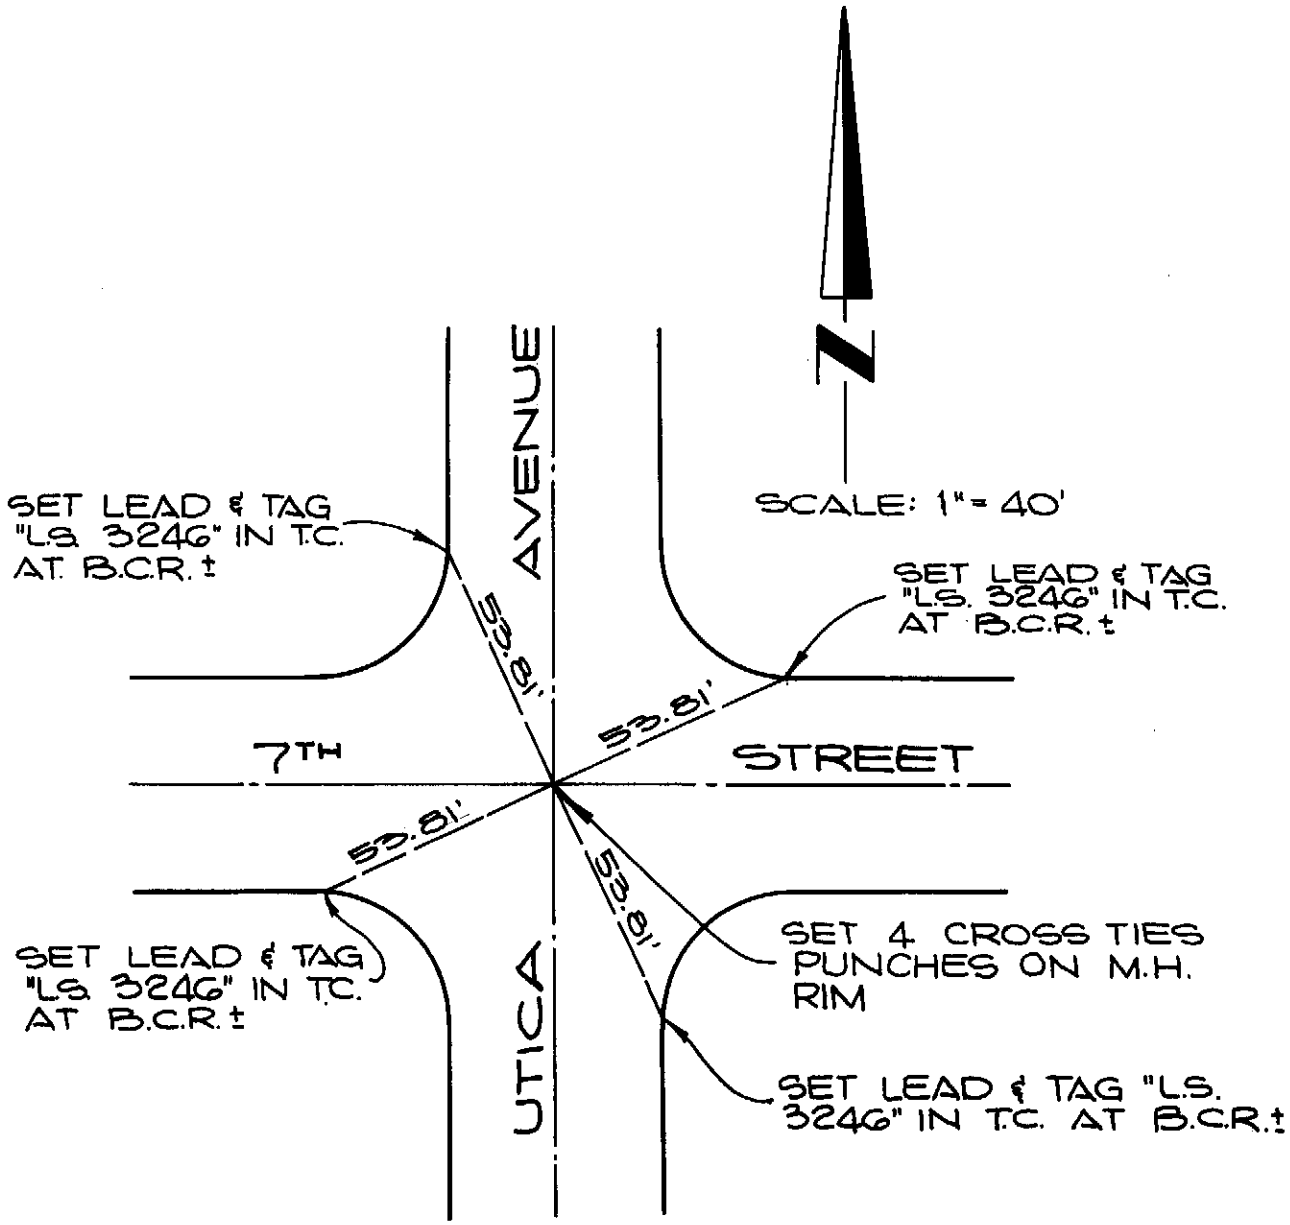

city of rancho cucamonga — STREET TIE	P.M. NO. 6194 P.M.B. 66/66-70
WILLIAMSON AND SCHMID CIVIL ENGINEERS 17782 SKY PARK BOULEVARD IRVINE, CALIFORNIA 92714 PHONE: (714) 549-2222	7TH STREET AND UTICA AVENUE
~~ENGR.~~ / L.S. GERALD F. OLDENBURG	FIELD REVIEW _____ DATE _____
~~R.C.E.~~ / L.S. No. 3246 DATE 11-2-81	TIE BOOK 5 PAGE 65

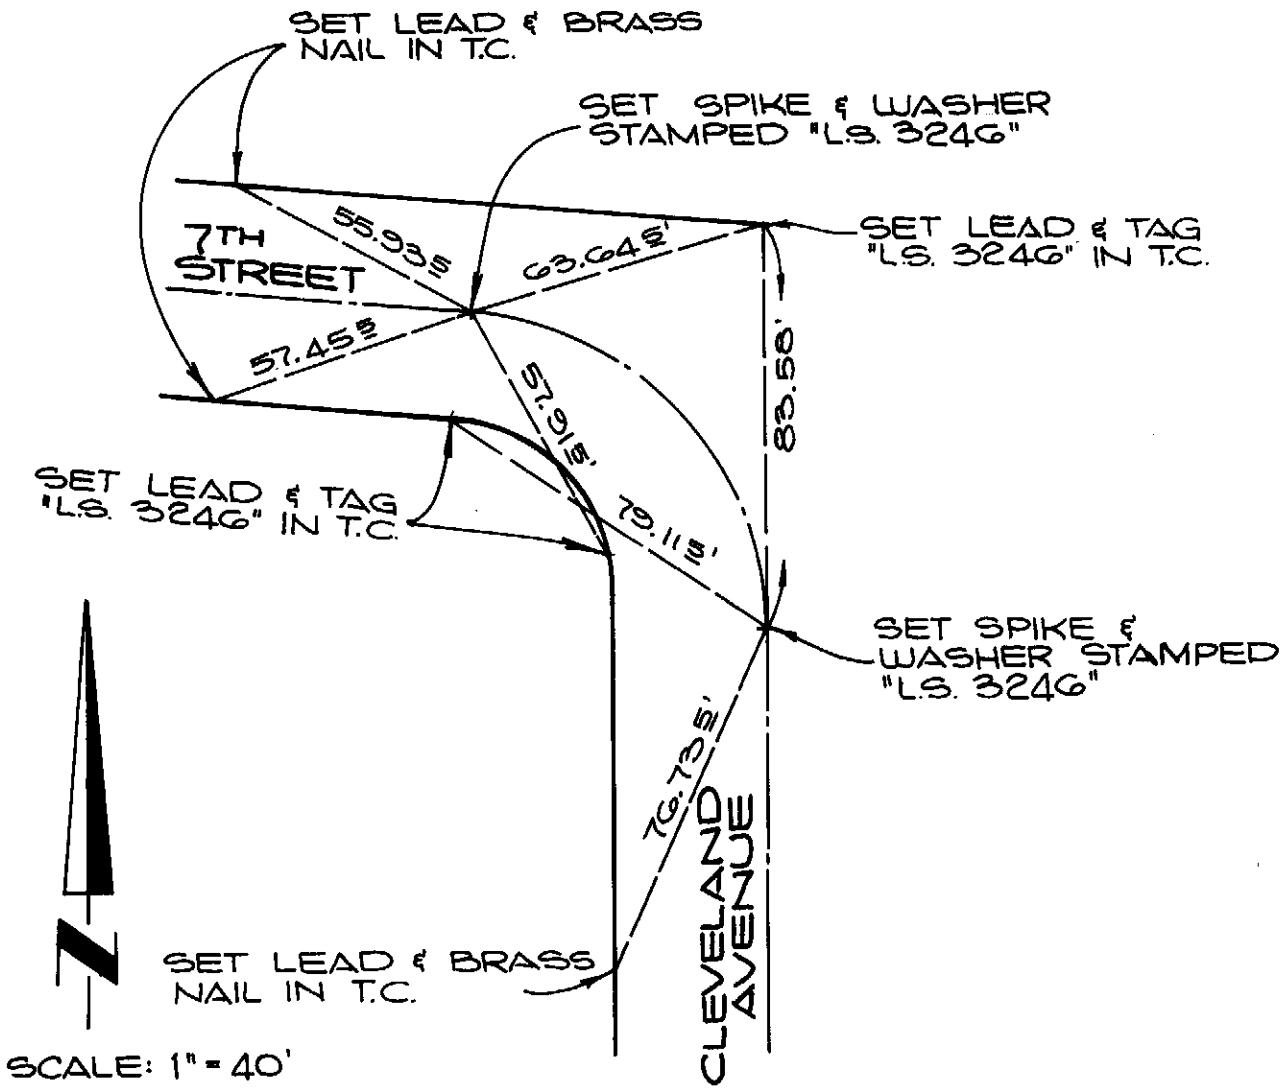

city of rancho cucamonga — STREET TIE	P.M. NO. 6194 P.M.B. 66/66-70
WILLIAMSON AND SCHMID CIVIL ENGINEERS 17782 SKY PARK BOULEVARD IRVINE, CALIFORNIA 92714 PHONE: (714) 549-2222	7TH STREET AND CLEVELAND AVENUE
~~ENGR.~~ / L.S. GERALD F. OLDENBURG	FIELD REVIEW _____ DATE _____
~~R.C.E.~~ / L.S. No. 3246 DATE 11-2-81	TIE BOOK 5 PAGE 66

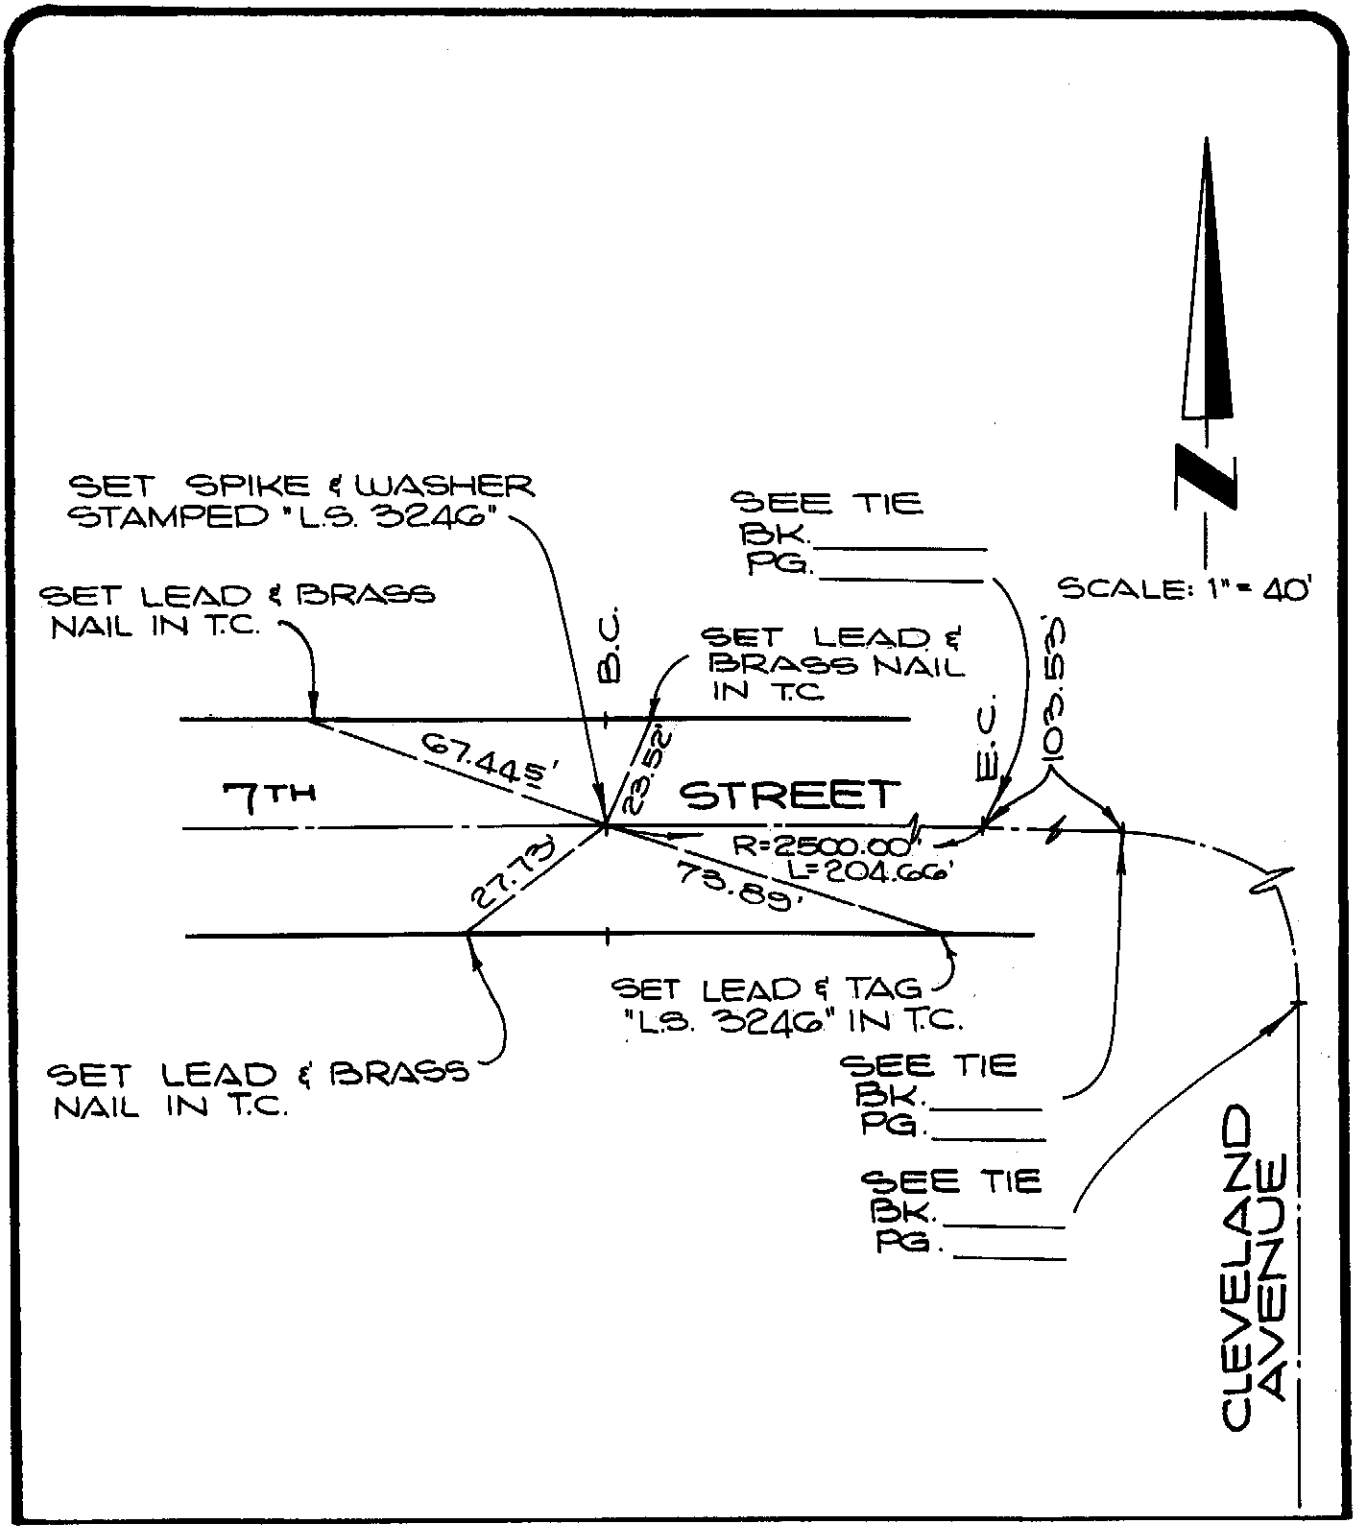

city of rancho cucamonga — STREET TIE	P.M. NO. 6194 P.M.B. 66/66-70
WILLIAMSON AND SCHMID CIVIL ENGINEERS 17782 SKY PARK BOULEVARD IRVINE, CALIFORNIA 92714 PHONE: (714) 549-2222	7TH STREET 308.19' W. OF CLEVELAND AVENUE
~~ENGR.~~ / L.S. GERALD F. OLDENBURG	FIELD REVIEW _____ DATE _____
~~R.C.E.~~ / L.S. No. 3246 DATE 11-2-81	TIE BOOK 5 PAGE 67

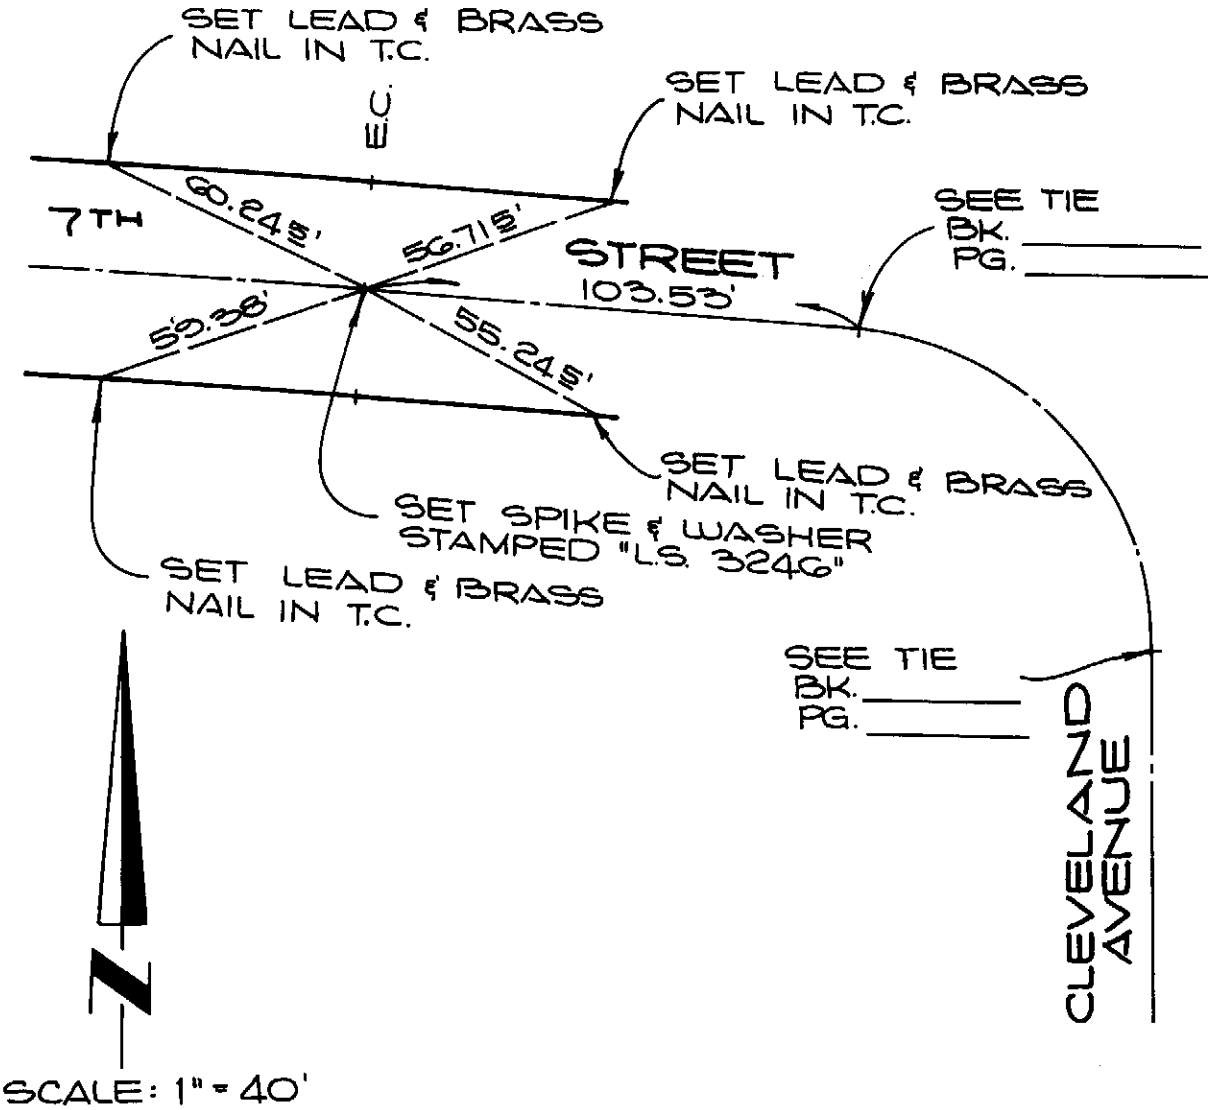

city of rancho cucamonga — STREET TIE	P.M. NO. 6194 P.M.B. 66/66-70
WILLIAMSON AND SCHMID CIVIL ENGINEERS 17782 SKY PARK BOULEVARD IRVINE, CALIFORNIA 92714 PHONE: (714) 549-2222	7TH STREET 103.53' W OF CLEVELAND AVENUE
~~ENGR.~~ / L.S. GERALD F. OLDENBURG	FIELD REVIEW _____ DATE _____
~~R.C.E.~~ / L.S. No. 3246 DATE 11-2-81	TIE BOOK 5 PAGE 68

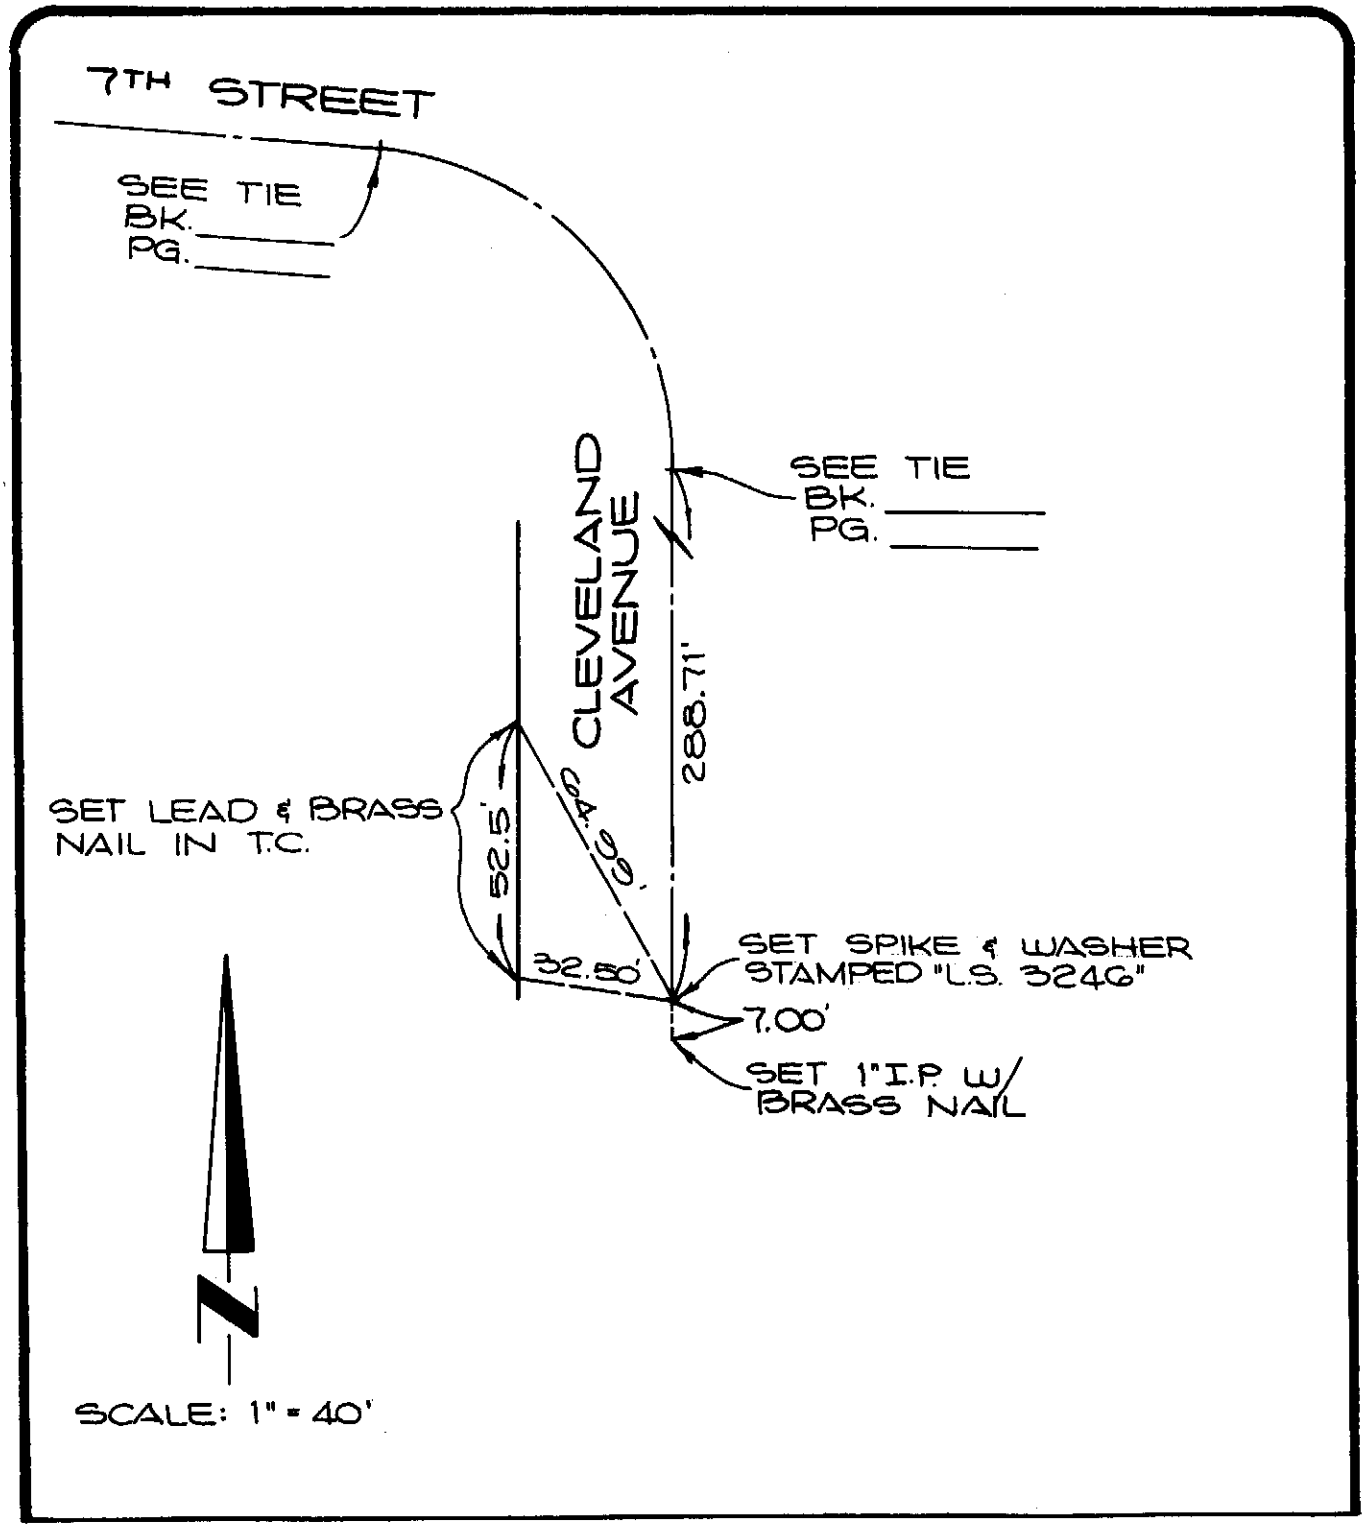

city of rancho cucamonga — STREET TIE	P.M. NO. 6194 P.M.B. 66/66-70
WILLIAMSON AND SCHMID CIVIL ENGINEERS 17782 SKY PARK BOULEVARD IRVINE, CALIFORNIA 92714 PHONE: (714) 549-2222	CLEVELAND AVENUE 288.71' S. OF 7TH STREET
~~ENGR.~~ / L.S. GERALD F. OLDENBURG	FIELD REVIEW _____ DATE _____
~~R.C.E.~~ / L.S. No. 3246 DATE 11-2-81	TIE BOOK 5 PAGE 69

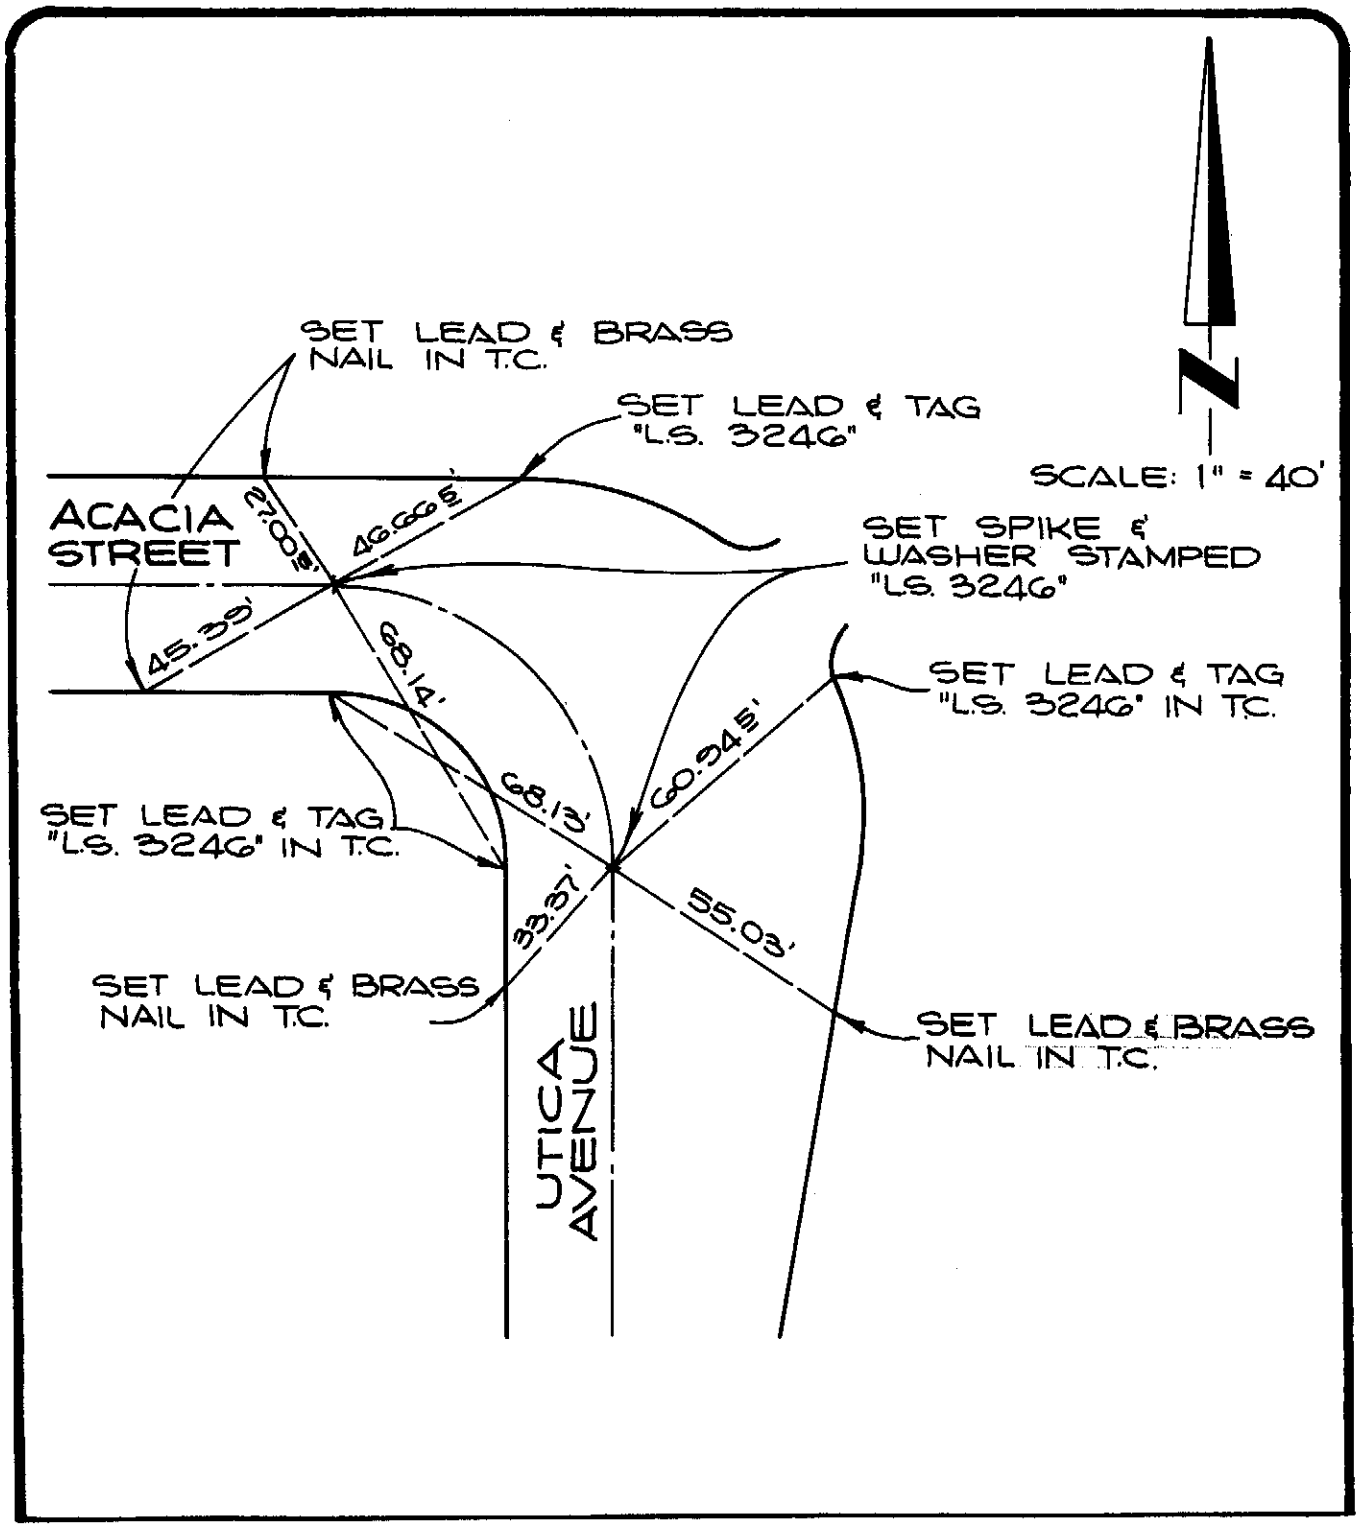

city of rancho cucamonga — STREET TIE	P.M. NO. 6194 P.M.B. 66/66-70
WILLIAMSON AND SCHMID CIVIL ENGINEERS 17782 SKY PARK BOULEVARD IRVINE, CALIFORNIA 92714 PHONE: (714) 549-2222	ACACIA STREET AND UTICA AVENUE
~~ENGR.~~ / L.S. GERALD F. OLDENBURG	FIELD REVIEW _____ DATE _____
~~R.C.E.~~ / L.S. No. 3246 DATE 11-2-81	TIE BOOK 5 PAGE 70

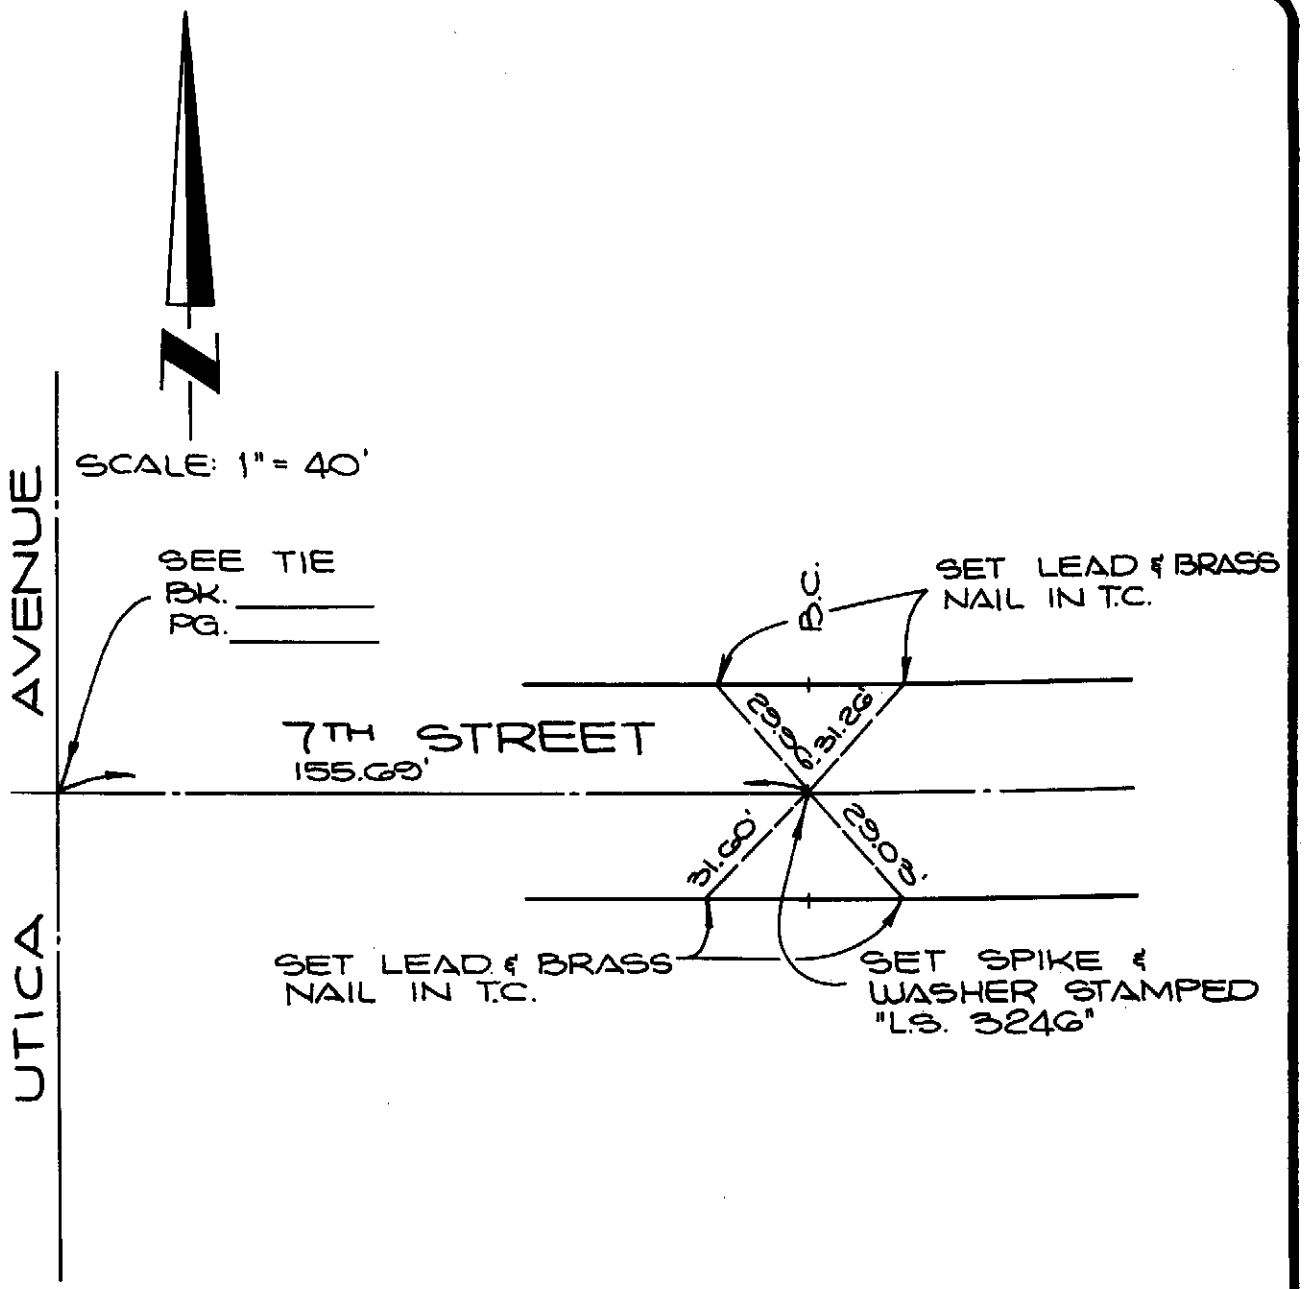

city of rancho cucamonga — STREET TIE	P.M. NO. 6194 P.M.B. 66/66-70
WILLIAMSON AND SCHMID CIVIL ENGINEERS 17782 SKY PARK BOULEVARD IRVINE, CALIFORNIA 92714 PHONE: (714) 549-2222	7TH STREET 155.69' E. OF UTICA AVE.
~~ENGR.~~/L.S. GERALD F. OLDENBURG	FIELD REVIEW _____ DATE _____
~~R.C.E.~~/L.S. No. 3246 DATE 11-2-81	TIE BOOK 5 PAGE 71

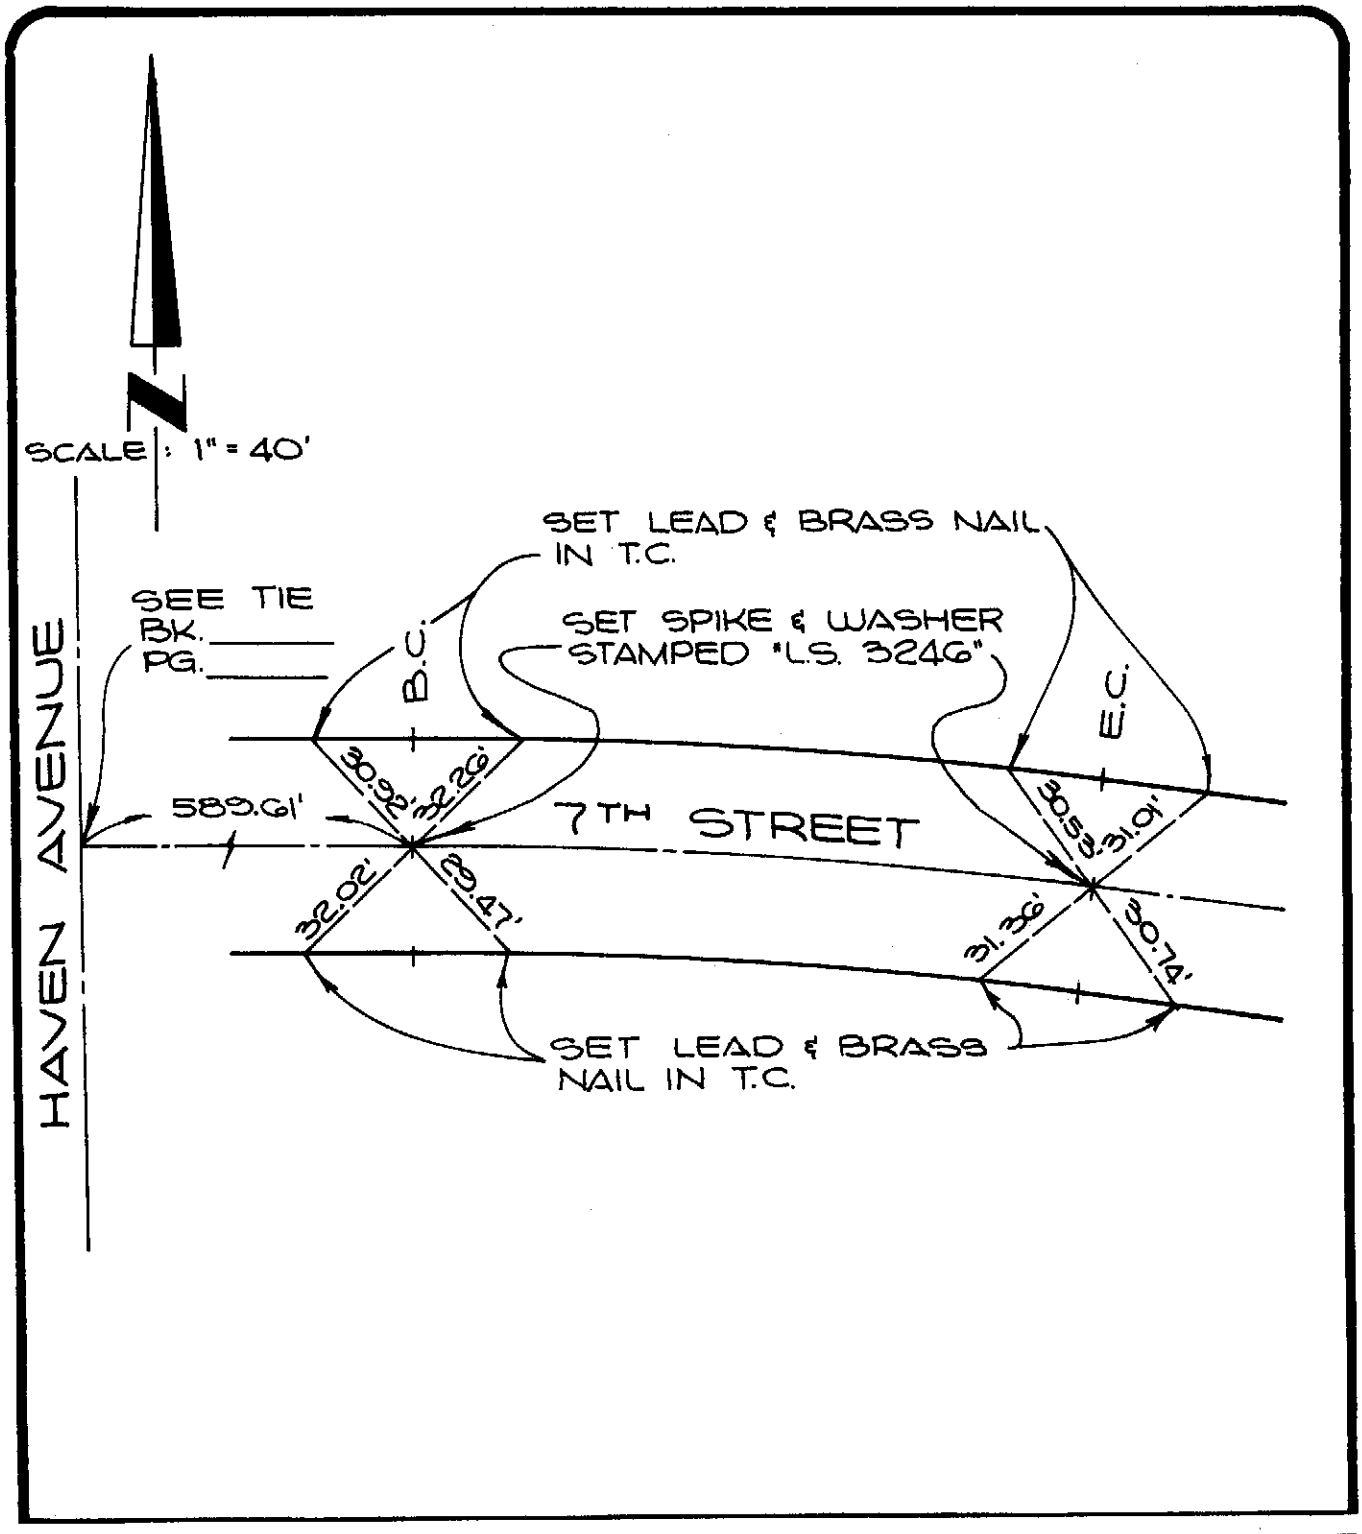

city of rancho cucamonga — STREET TIE	P.M. NO. 6194 P.M.B. 66/66-70
WILLIAMSON AND SCHMID CIVIL ENGINEERS 17782 SKY PARK BOULEVARD IRVINE, CALIFORNIA 92714 PHONE: (714) 549-2222	7TH STREET 589.61' E. OF HAVEN AVE.
~~ENGR.~~ / L.S. GERALD F. OLDENBURG	FIELD REVIEW _____ DATE _____
~~R.C.E.~~ / L.S. No. 3246 DATE 11-2-81	TIE BOOK 5 PAGE 72

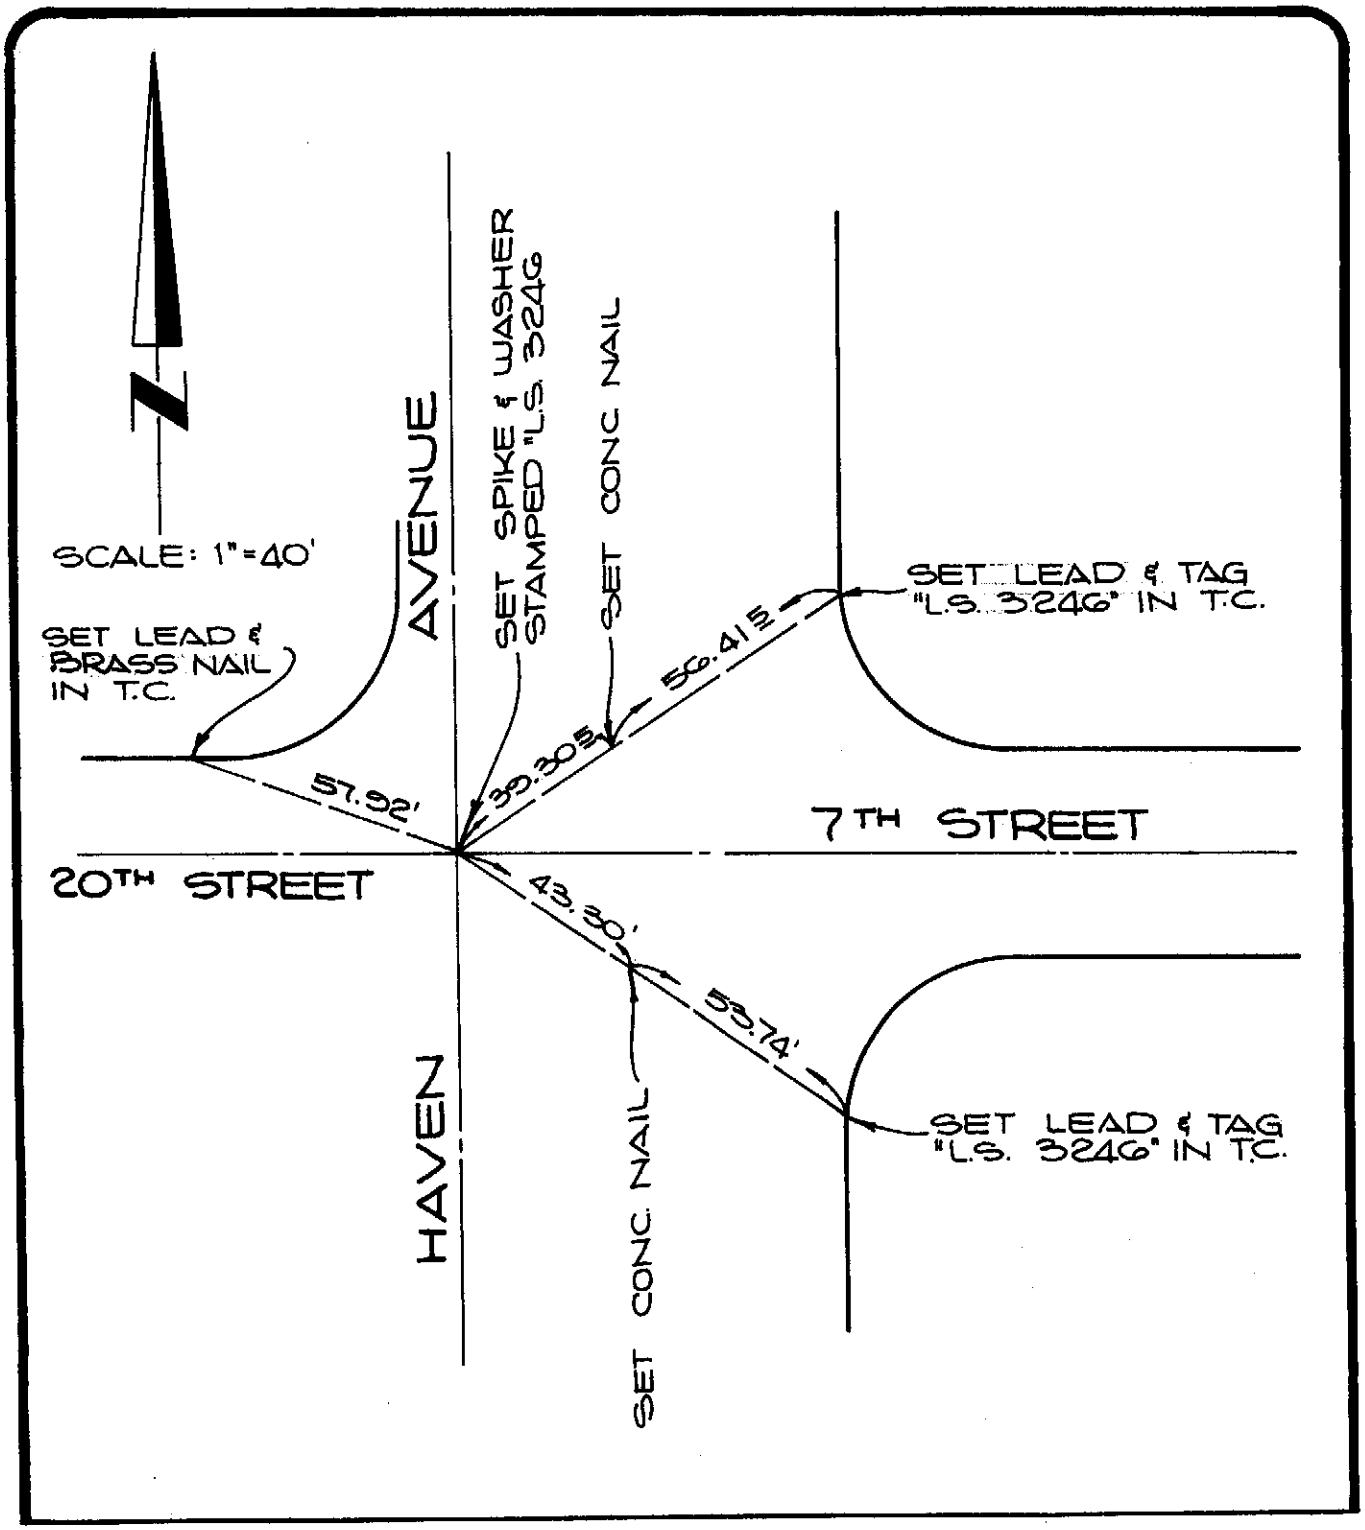

city of rancho cucamonga — STREET TIE	P.M. NO. 6194 P.M.B. 66/66-70
WILLIAMSON AND SCHMID CIVIL ENGINEERS 17782 SKY PARK BOULEVARD IRVINE, CALIFORNIA 92714 PHONE: (714) 549-2222	HAVEN AVENUE 7TH STREET AND 20TH STREET
~~ENGR.~~ / L.S. GERALD F. OLDENBURG	FIELD REVIEW _____ DATE _____
~~R.C.E.~~ / L.S. No. 3246 DATE 11-2-81	TIE BOOK 5 PAGE 73

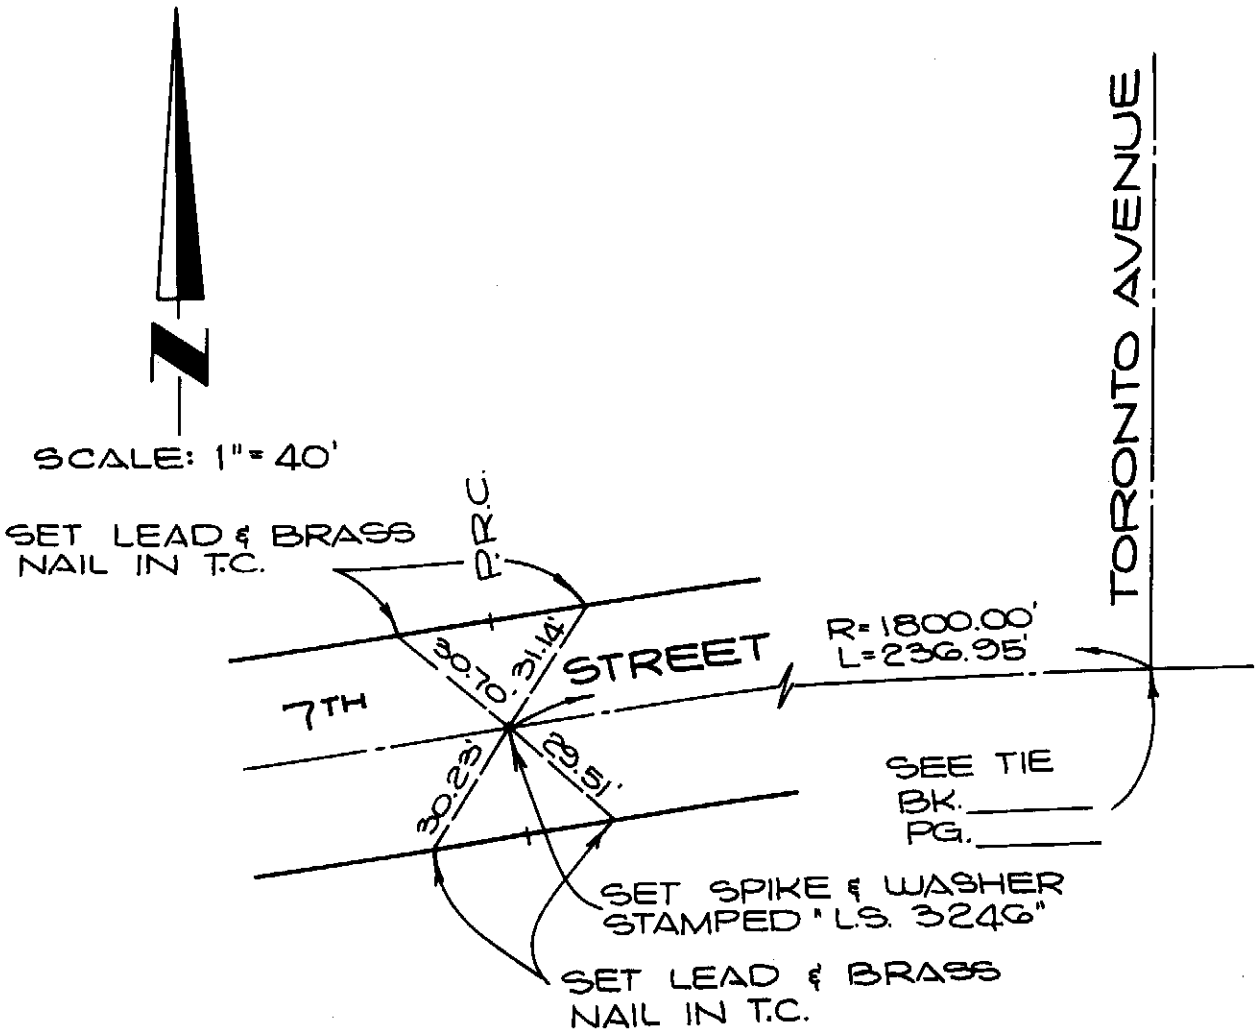

city of rancho cucamonga — STREET TIE	P.M. NO. 6194 P.M.B. 66/66-70
WILLIAMSON AND SCHMID CIVIL ENGINEERS 17782 SKY PARK BOULEVARD IRVINE, CALIFORNIA 92714 PHONE: (714) 549-2222	7TH STREET 236.95' W. OF TORONTO AVENUE
~~ENGR.~~ / L.S. GERALD F. OLDENBURG	FIELD REVIEW _____ DATE _____
~~R.C.E.~~ / L.S. No. 3246 DATE 11-2-81	TIE BOOK 5 PAGE 74

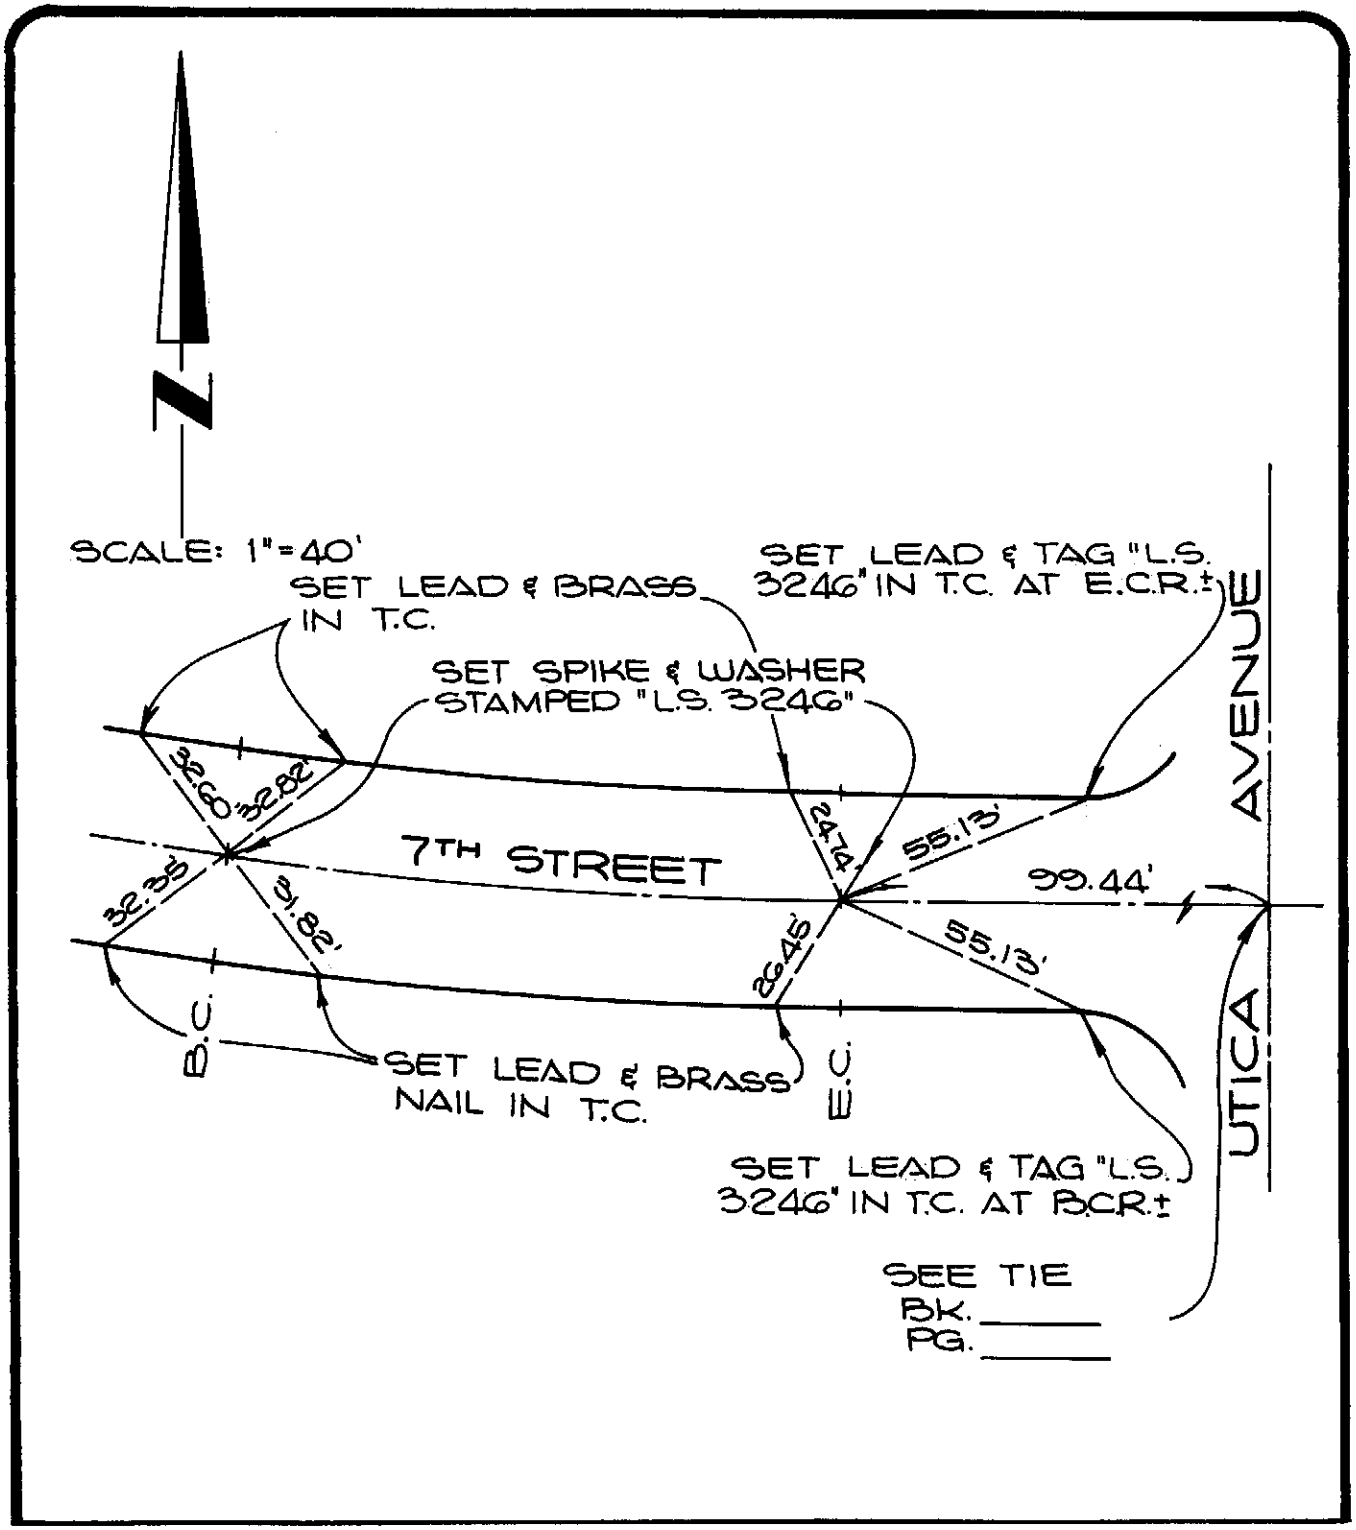

city of rancho cucamonga — STREET TIE	P.M. NO. 6194 P.M.B. 66/66-70
WILLIAMSON AND SCHMID CIVIL ENGINEERS 17782 SKY PARK BOULEVARD IRVINE, CALIFORNIA 92714 PHONE: (714) 549-2222	7TH STREET 99.44' W. OF UTICA AVE.
~~ENGR.~~ / L.S. GERALD F. OLDENBURG	FIELD REVIEW _____ DATE _____
~~R.C.E.~~ / L.S. No. 3246 DATE 11-2-81	TIE BOOK 5 PAGE 75

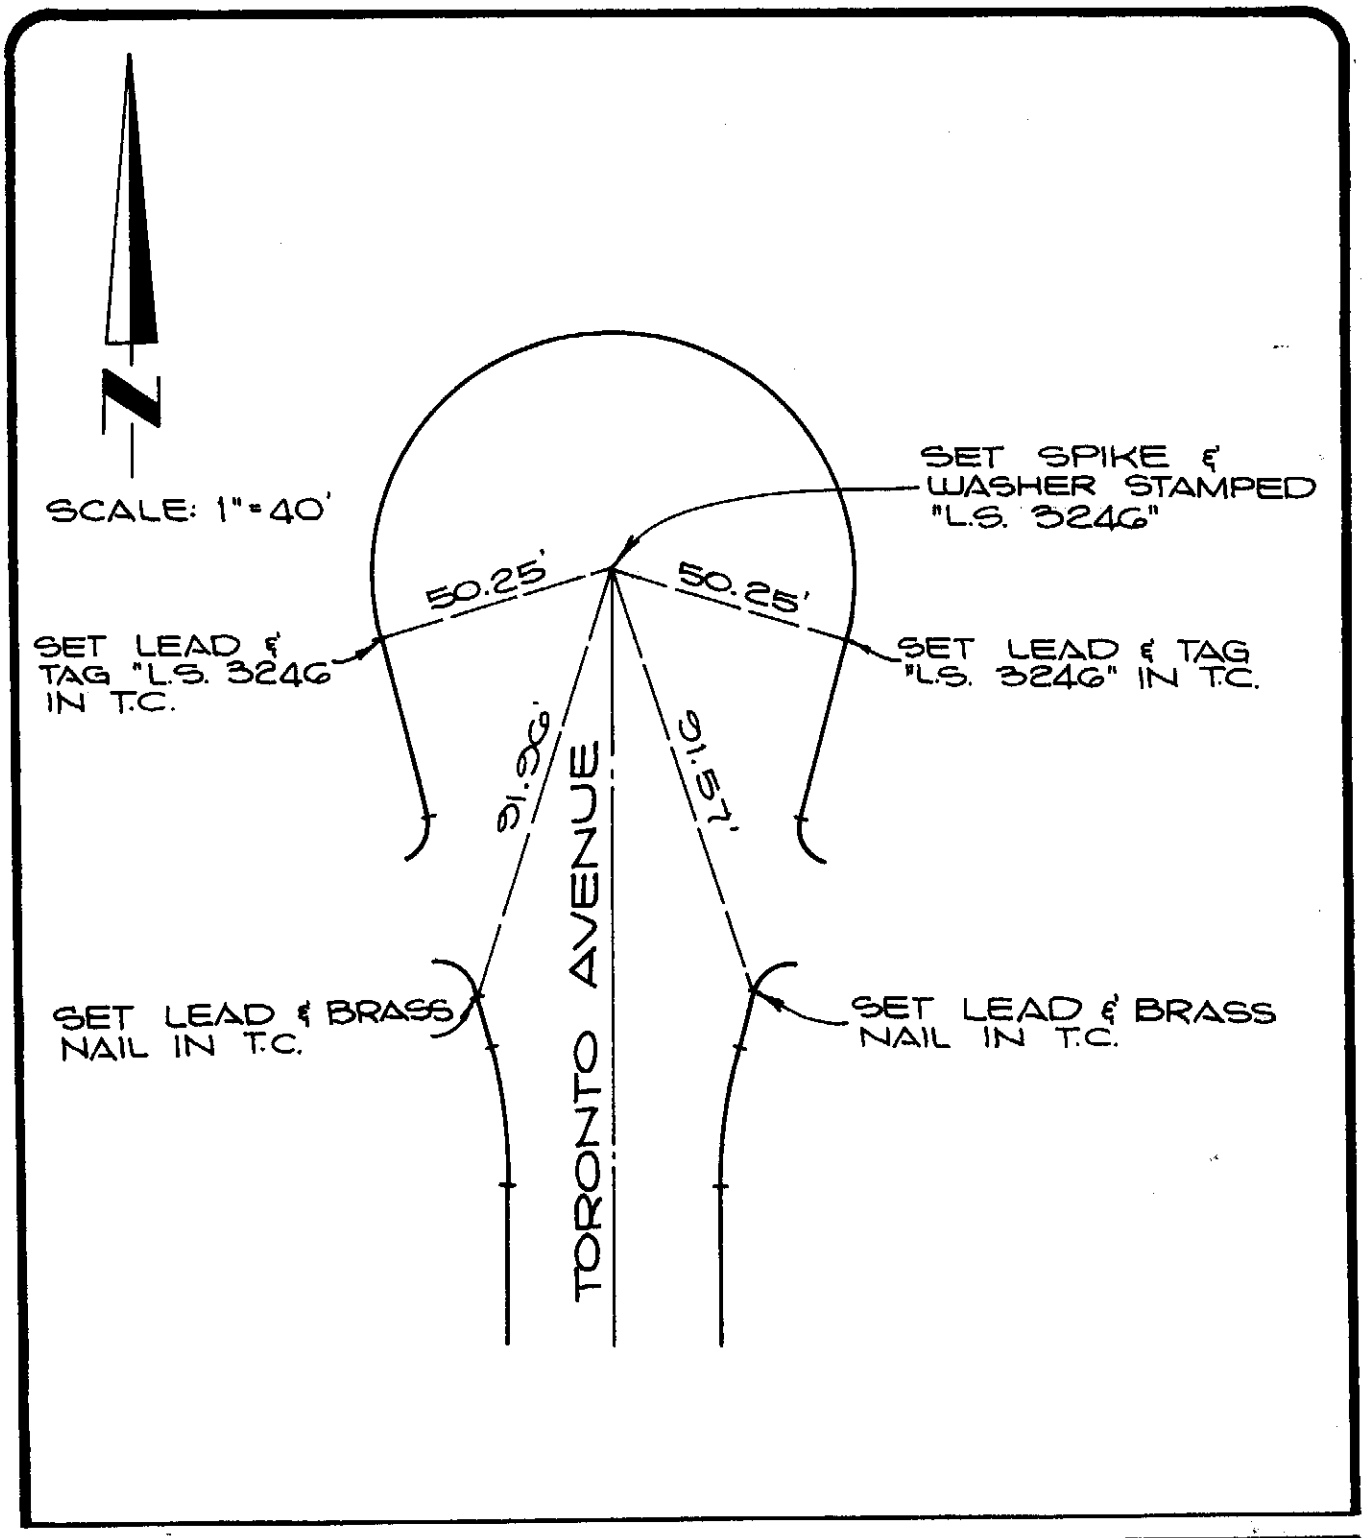

city of rancho cucamonga — STREET TIE	P.M. NO. 6194 P.M.B. 66/66-70
WILLIAMSON AND SCHMID CIVIL ENGINEERS 17782 SKY PARK BOULEVARD IRVINE, CALIFORNIA 92714 PHONE: (714) 549-2222	TORONTO AVENUE
~~ENGR.~~ / L.S. GERALD F. OLDENBURG	FIELD REVIEW _____ DATE _____
~~R.C.E.~~ / L.S. No. 3246 DATE 11-2-81	TIE BOOK 5 PAGE 76

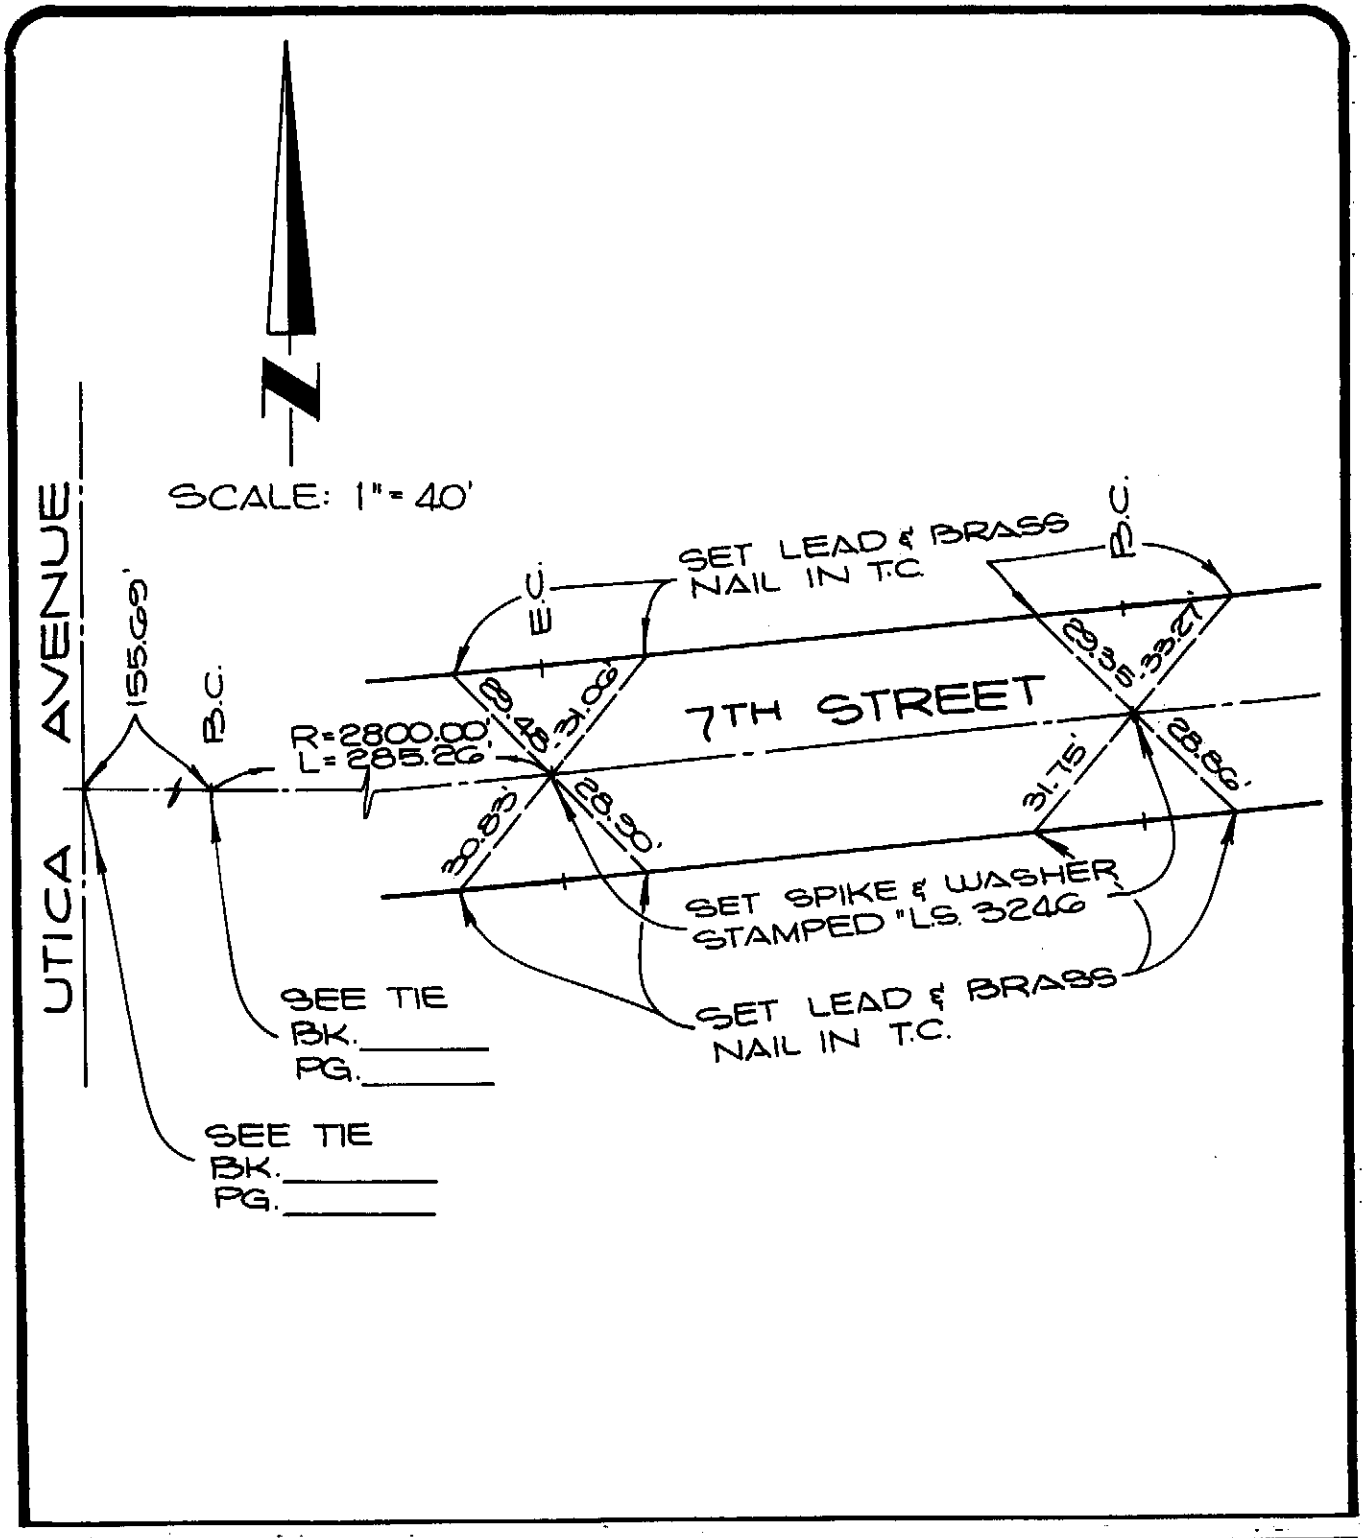

city of rancho cucamonga — STREET TIE	P.M. NO. 6194 P.M.B. 66/66-70
WILLIAMSON AND SCHMID CIVIL ENGINEERS 17782 SKY PARK BOULEVARD IRVINE, CALIFORNIA 92714 PHONE: (714) 549-2222	7TH STREET 440.95' E. OF UTICA AVE.
~~ENGR.~~ / L.S. GERALD F. OLDENBURG	FIELD REVIEW _____ DATE _____
~~R.C.E.~~ / L.S. No. 3246 DATE 11-2-81	TIE BOOK 5 PAGE 77

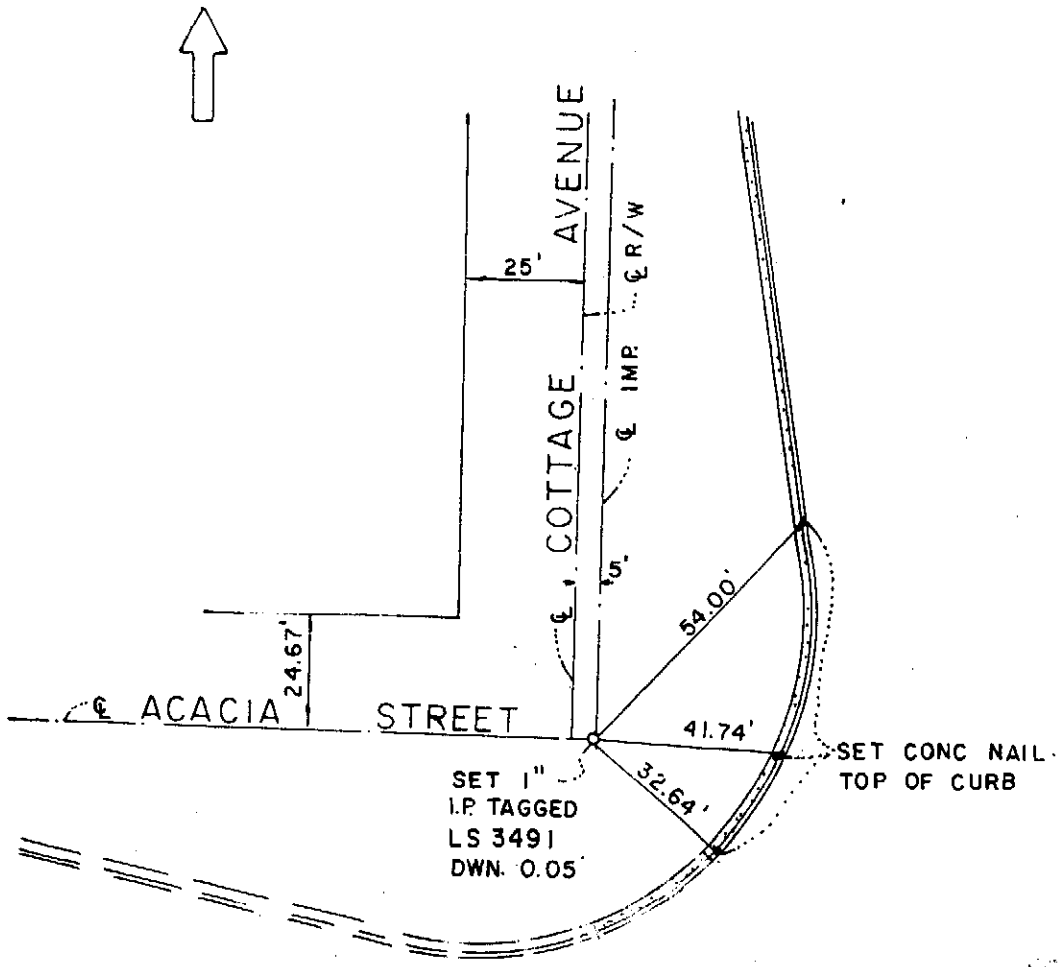

city of rancho cucamonga — STREET TIE	
ACACIA STREET COTTAGE AVE	
ENGR. / L.S.	FIELD REVIEW ____ DATE ____
R.C.E. / L.S. No. 3491 DATE 6/16/81	TIE BOOK 5 PAGE 70

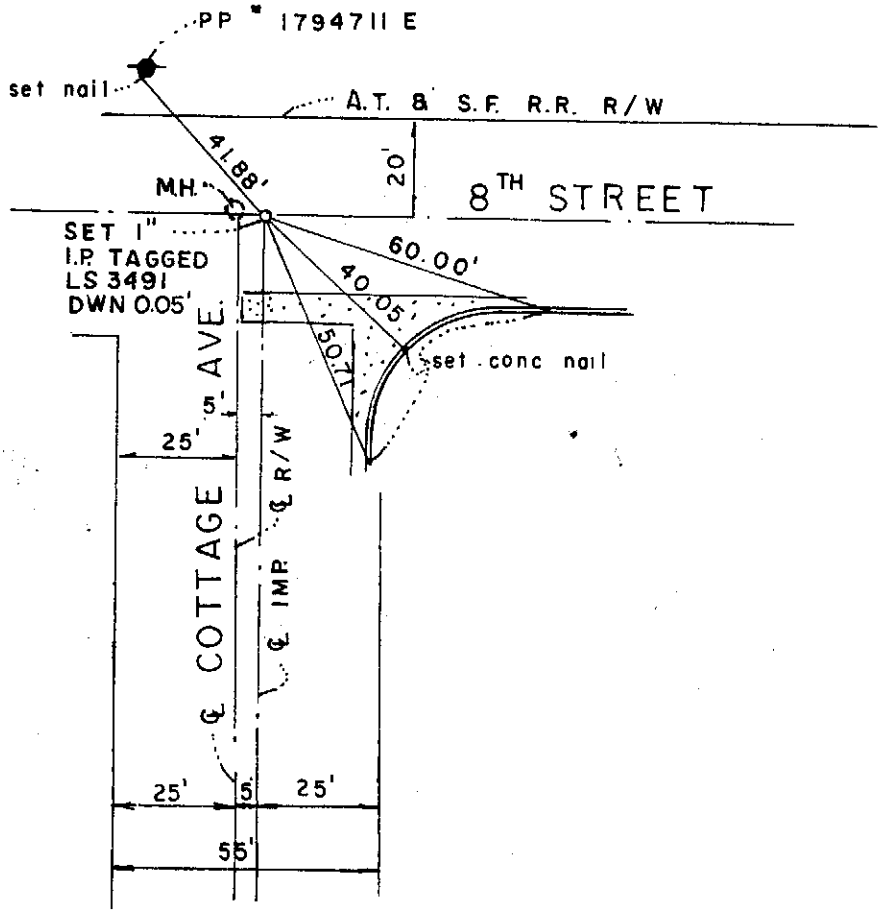

city of rancho cucamonga — STREET TIE	
8TH STREET COTTAGE AVE	
ENGR./L.S.	FIELD REVIEW ____ DATE ____
R.C.E./L.S. No. 3491 DATE 6/18/81	TIE BOOK 5 PAGE 79

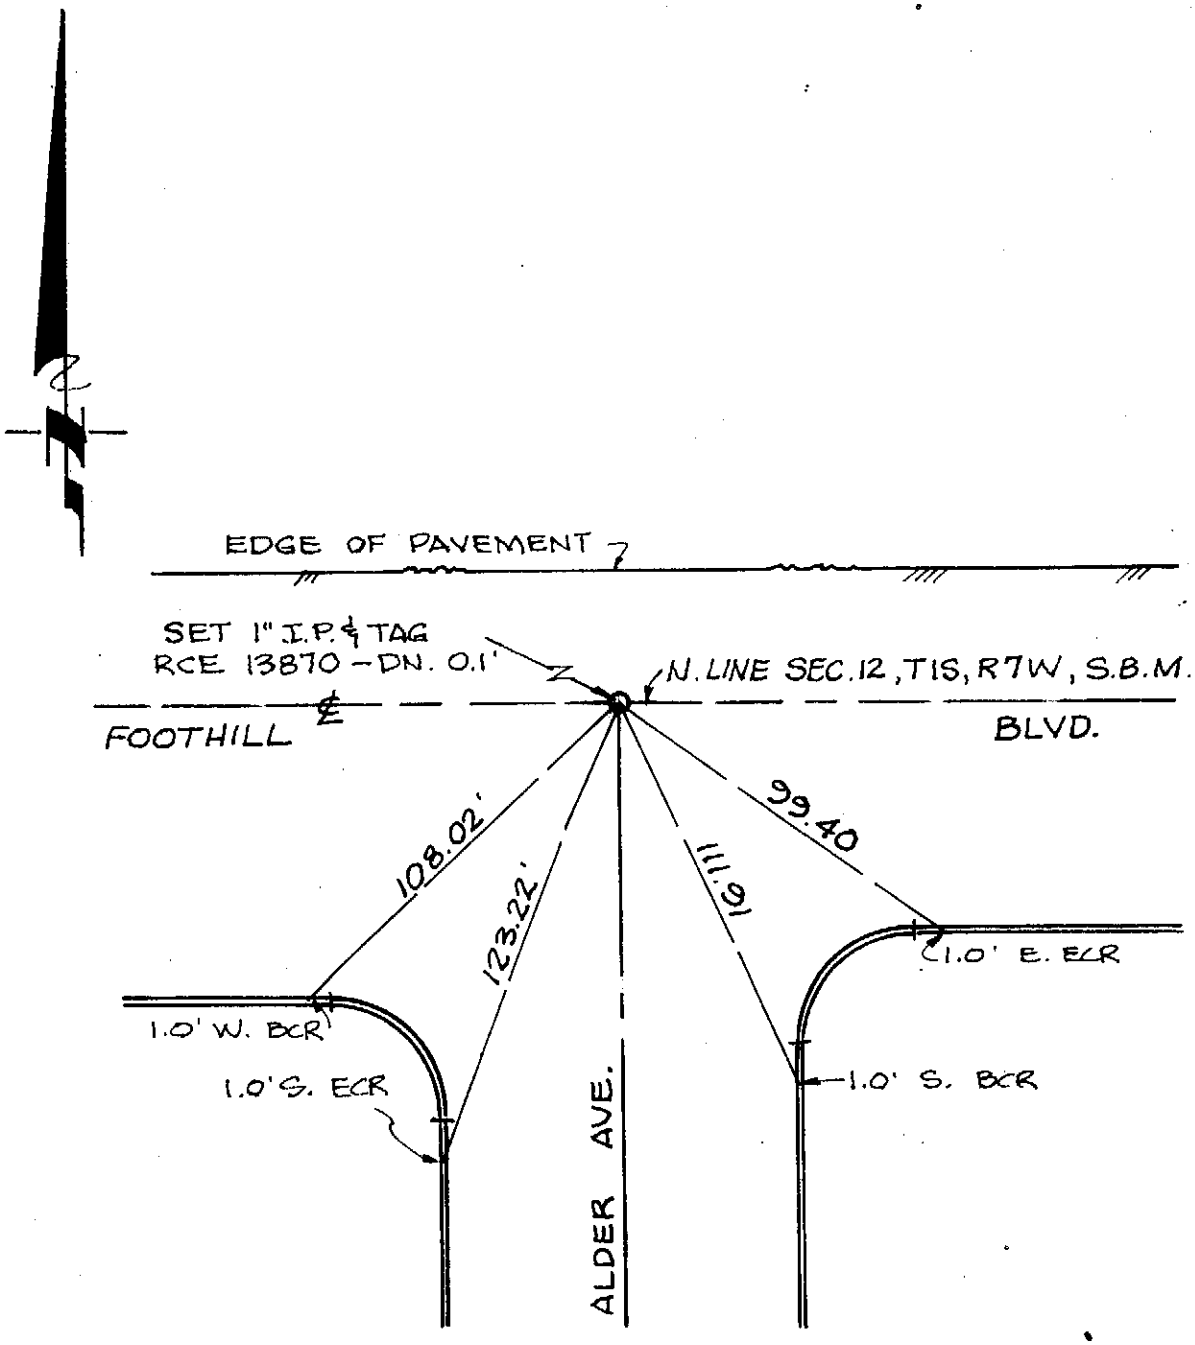

NOTE :
ALL TIE POINTS ARE RAMSET NAILS
ON TOP OF CURB ~ UNLESS OTHERWISE NOTED

CITY OF RANCHO CUCAMONGA — STREET TIES	PARCEL MAP NO. 6725
LDKING L.D. KING, INC. 517 N. EUCLID AVENUE ONTARIO, CALIF. (714) 988-5492	ASPEN ~~ALDER~~ AVE. ℄ FOOTHILL BLVD.
ENGR. [signature]	FIELD REVIEW _____ DATE _____
R.C.E. NO. 13870 DATE 4-22-82	TIE BOOK 5 PAGE 80

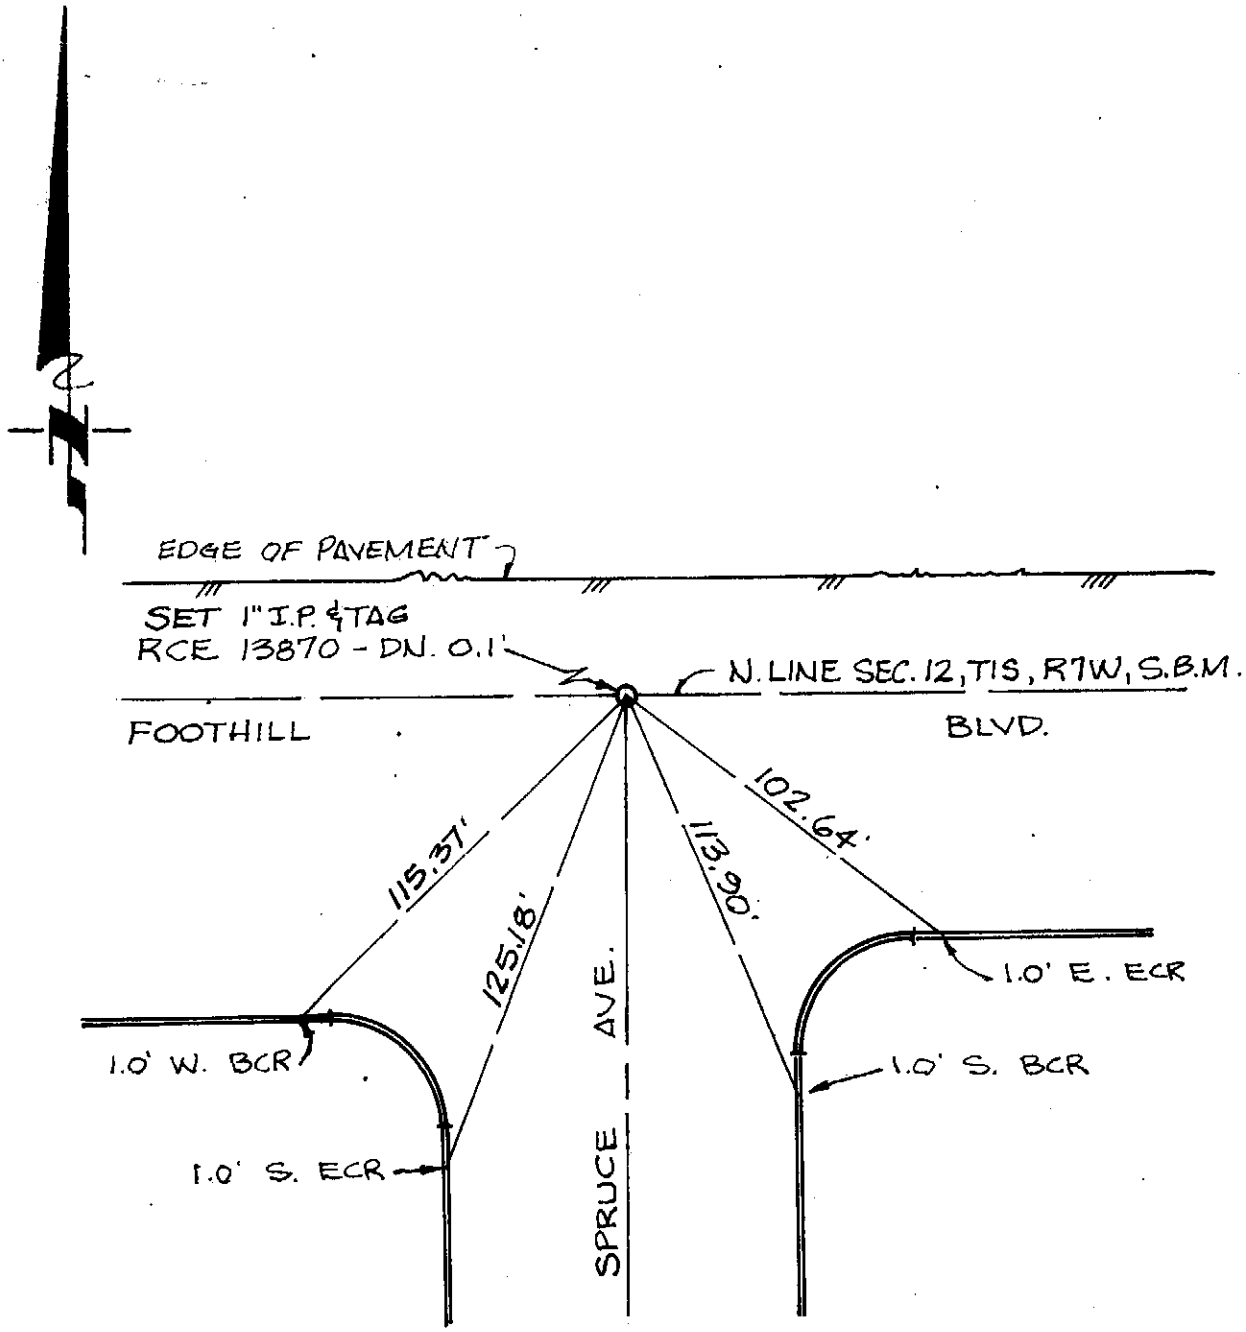

NOTE :
ALL TIE POINTS ARE RAMSET NAILS
ON TOP OF CURB ~ UNLESS OTHERWISE NOTED

CITY OF RANCHO CUCAMONGA — STREET TIES	PARCEL MAP NO. 6725
LDKING L.D. KING, INC. 517 N. EUCLID AVENUE ONTARIO, CALIF. (714) 988-5492	SPRUCE AVE. & FOOTHILL BLVD.
ENGR. [signature]	FIELD REVIEW _____ DATE _____
R.C.E. NO. 13870 DATE 4-22-82	TIE BOOK 5 PAGE 81

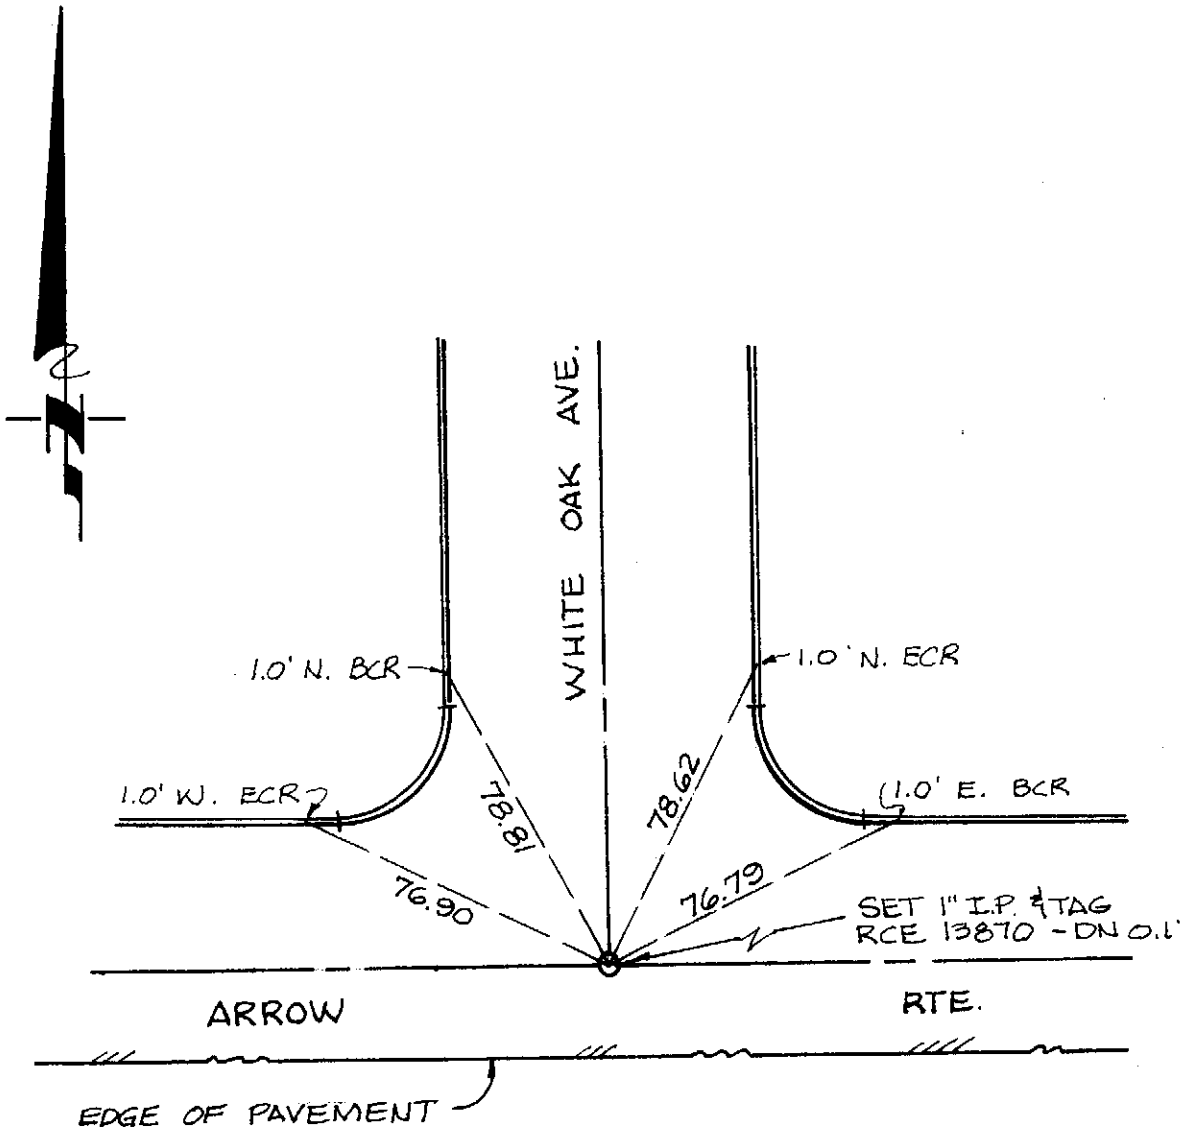

NOTE :
ALL TIE POINTS ARE RAMSET NAILS
ON TOP OF CURB ~ UNLESS OTHERWISE NOTED

CITY OF RANCHO CUCAMONGA — STREET TIES	PARCEL MAP NO. 6725
LDKING L.D. KING, INC. 517 N. EUCLID AVENUE ONTARIO, CALIF. (714) 988-5492	WHITE OAK AVE. & ARROW RTE.
ENGR. [signature]	FIELD REVIEW _____ DATE _____
R.C.E. NO. 13870 DATE 4-22-82	TIE BOOK 5 PAGE 82

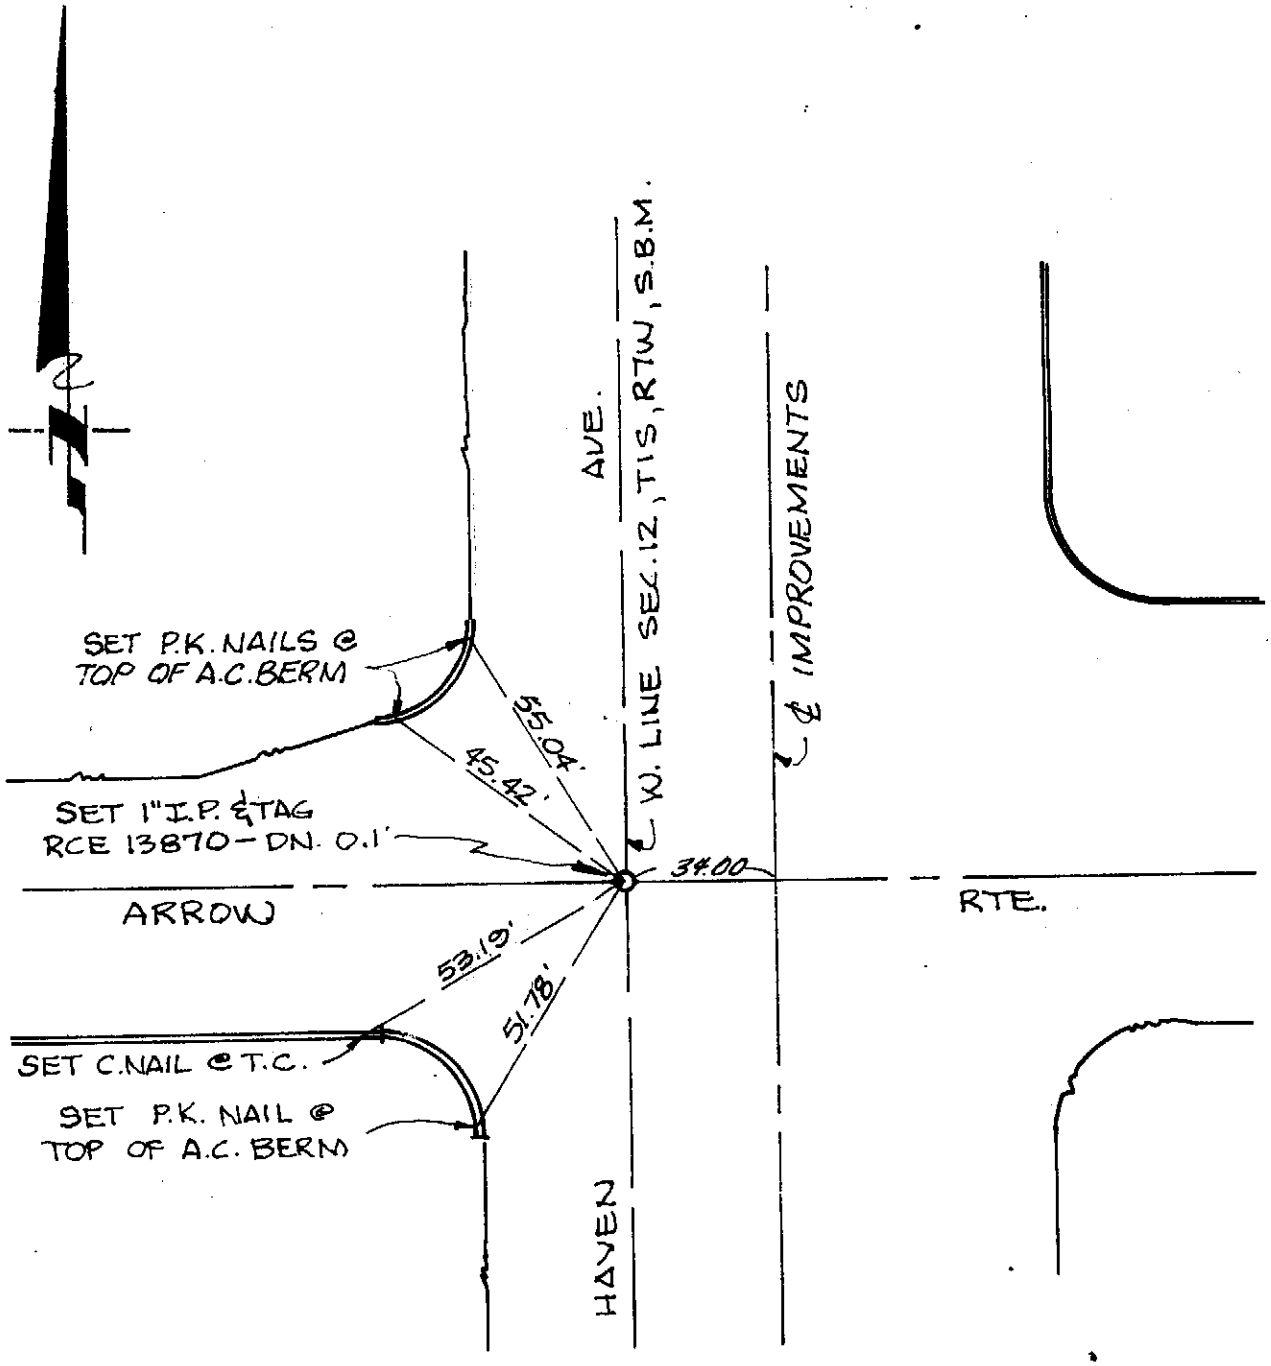

NOTE :

- ALL TIE POINTS ARE RAMSET NAILS ON TOP OF CURB ~ UNLESS OTHERWISE NOTED

CITY OF RANCHO CUCAMONGA — STREET TIES	PARCEL MAP NO. 6725
LDKING L.D. KING, INC. 517 N. EUCLID AVENUE ONTARIO, CALIF. (714) 988-5492	HAVEN AVE. & ARROW RTE.
ENGR.	FIELD REVIEW _____ DATE _____
R.C.E. NO. 13870 DATE 4-22-82	TIE BOOK 5 PAGE 83

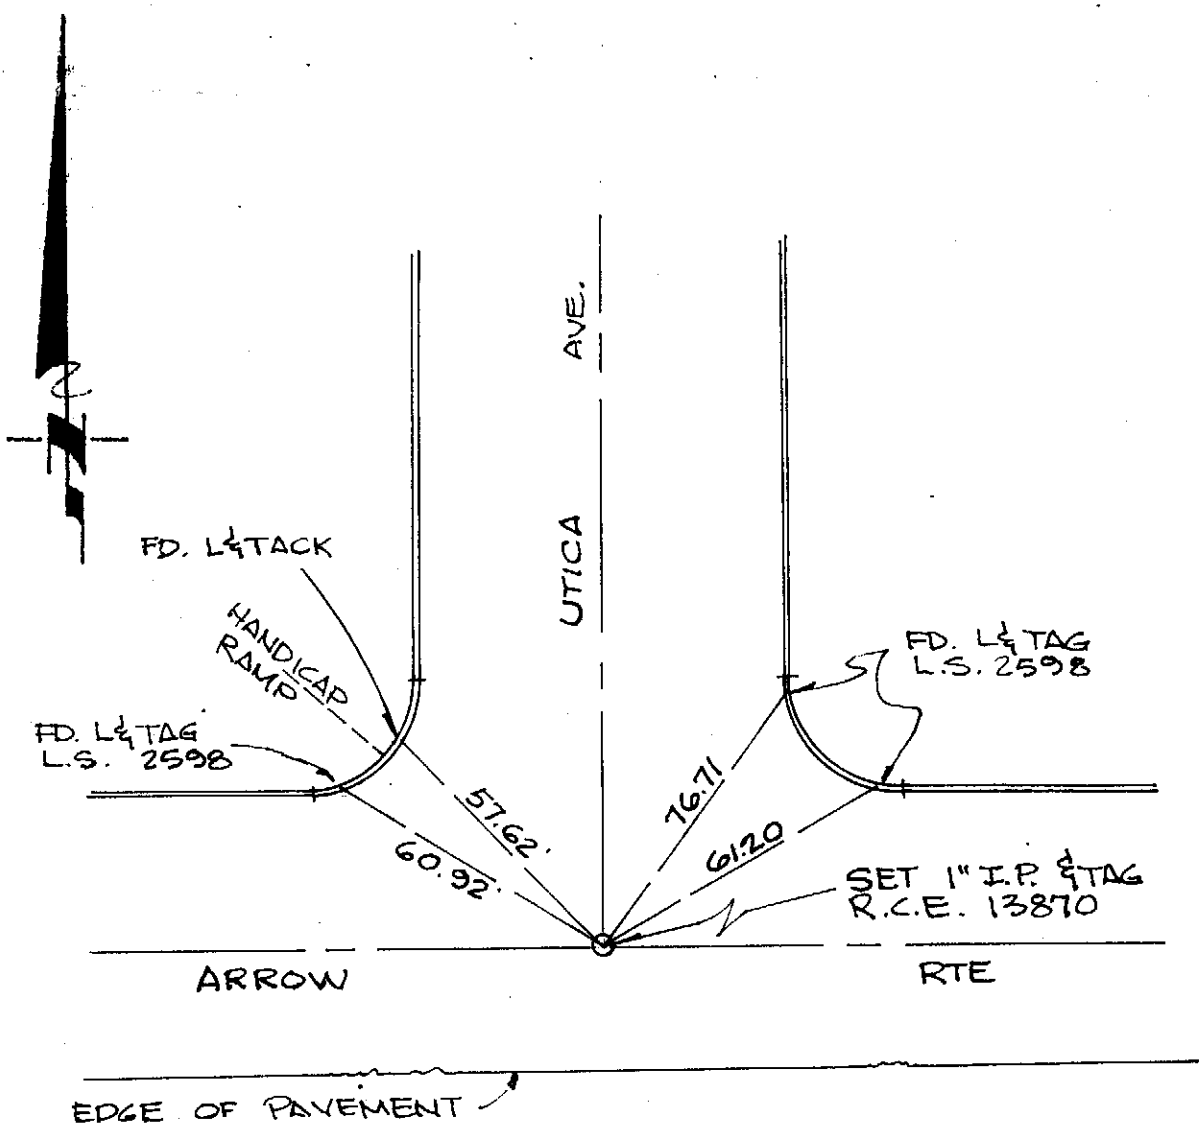

NOTE :
ALL TIE POINTS ARE RAMSET NAILS
ON TOP OF CURB ~ UNLESS OTHERWISE NOTED

CITY OF RANCHO CUCAMONGA — STREET TIES	PARCEL MAP NO. 6725
LDKING L.D. KING, INC. 517 N. EUCLID AVENUE ONTARIO, CALIF. (714) 988-5492	UTICA AVE. & ARROW RTE.
ENGR	FIELD REVIEW _____ DATE _____
R.C.E. NO. 13870 DATE 4-22-82	TIE BOOK 5 PAGE 84

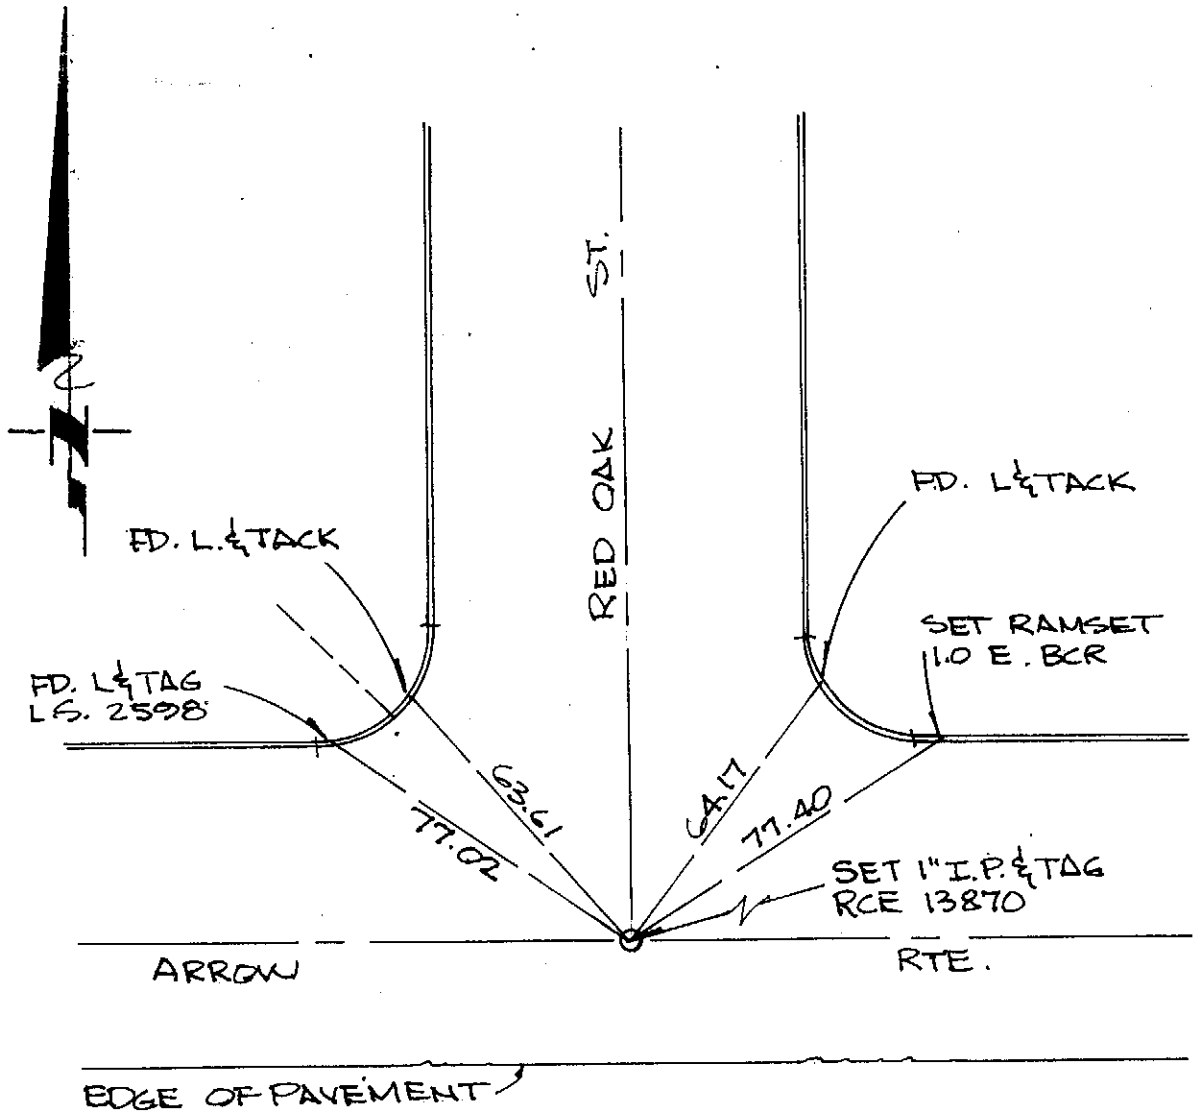

NOTE :
ALL TIE POINTS ARE RAMSET NAILS
ON TOP OF CURB ~ UNLESS OTHERWISE NOTED

CITY OF RANCHO CUCAMONGA — STREET TIES	PARCEL MAP NO. 6725
LDKING L.D. KING, INC. 517 N. EUCLID AVENUE ONTARIO, CALIF. (714) 988-5492	RED OAK ST. & ARROW RTE.
ENGR. [signature]	FIELD REVIEW _____ DATE _____
R.C.E. NO. 13870 DATE 4-22-82	TIE BOOK 5 PAGE 85

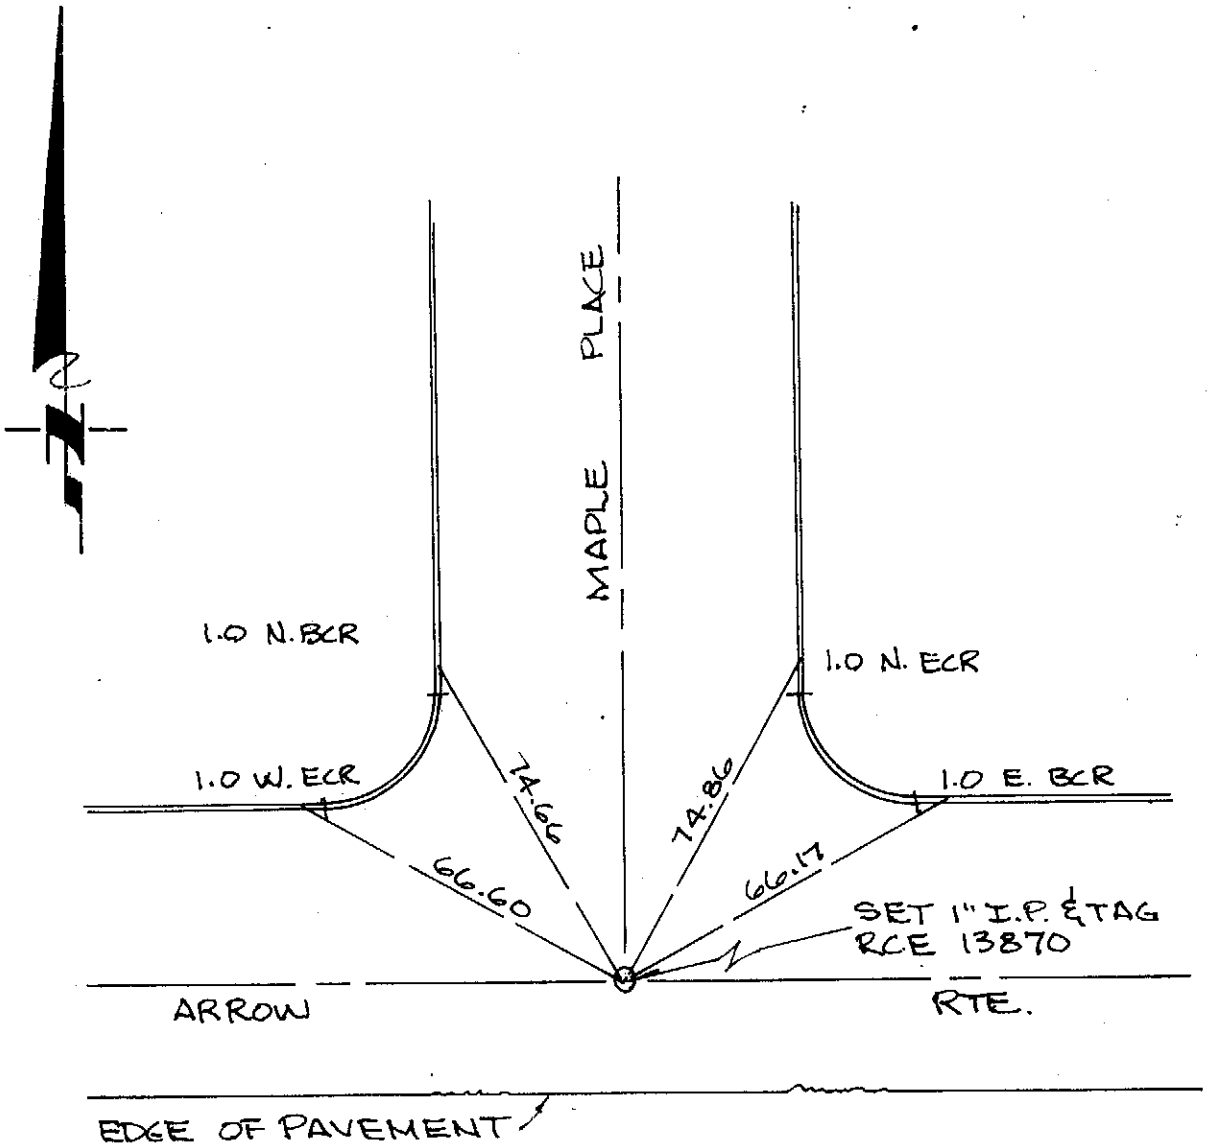

NOTE :

- ALL TIE POINTS ARE RAMSET NAILS ON TOP OF CURB ~ UNLESS OTHERWISE NOTED

CITY OF RANCHO CUCAMONGA — STREET TIES	PARCEL MAP NO. 6725
LDKING L.D. KING, INC. 517 N. EUCLID AVENUE ONTARIO, CALIF. (714) 988-5492	MAPLE PLACE & ARROW RTE.
ENGR. [signature]	FIELD REVIEW _____ DATE _____
R.C.E. NO. 13870 DATE 4-22-82	TIE BOOK 5 PAGE 86

TRACT NO. 9589

STREET CENTERLINE TIES

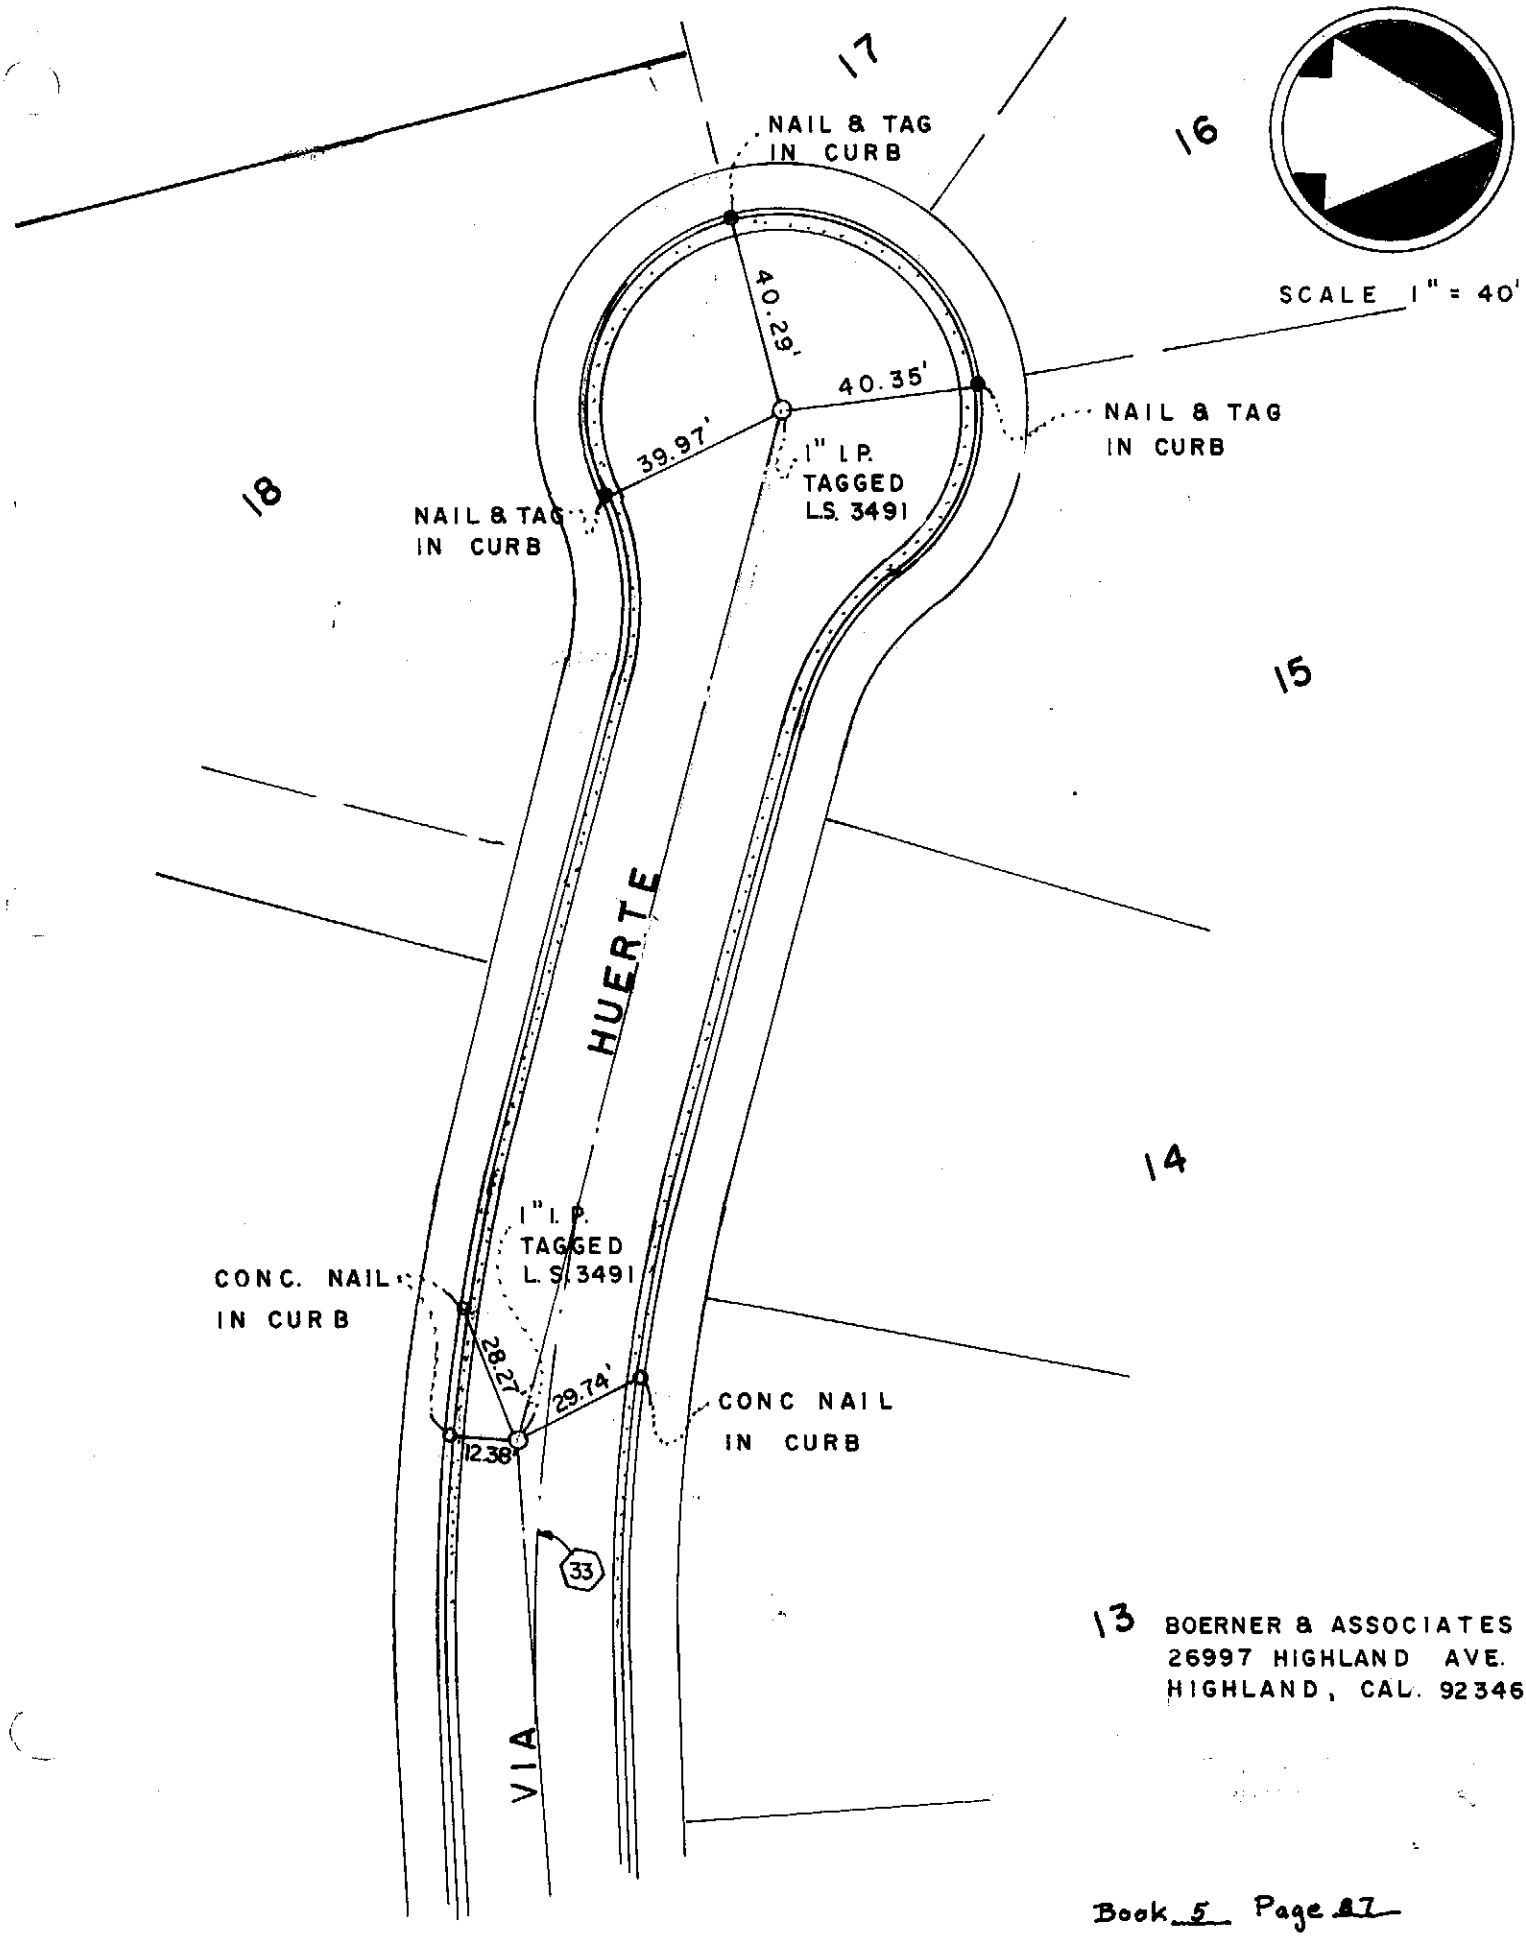

BOERNER & ASSOCIATES
26997 HIGHLAND AVE.
HIGHLAND, CAL. 92346

TRACT NO. 9589

STREET CENTERLINE TIES

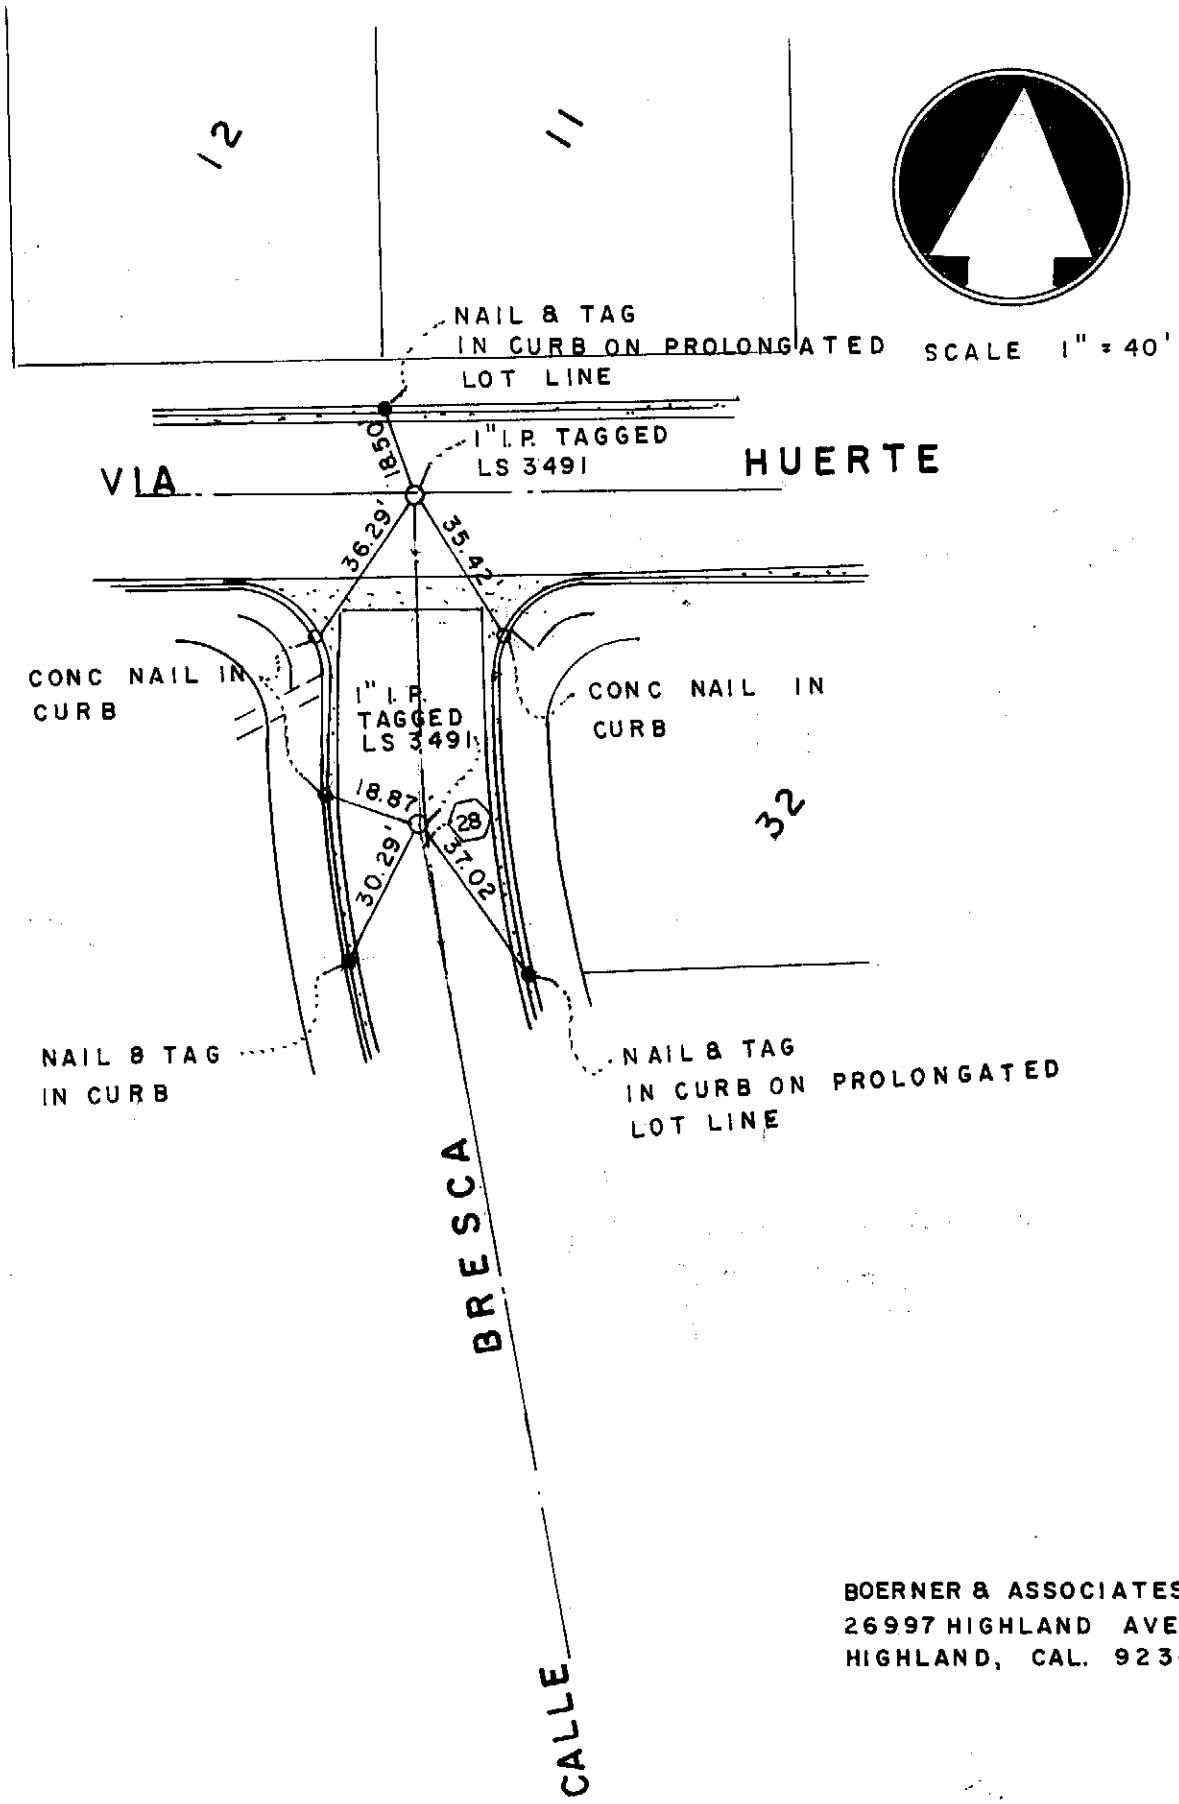

BOERNER & ASSOCIATES
26997 HIGHLAND AVE.
HIGHLAND, CAL. 92346

TRACT NO. 9589

STREET CENTERLINE TIES

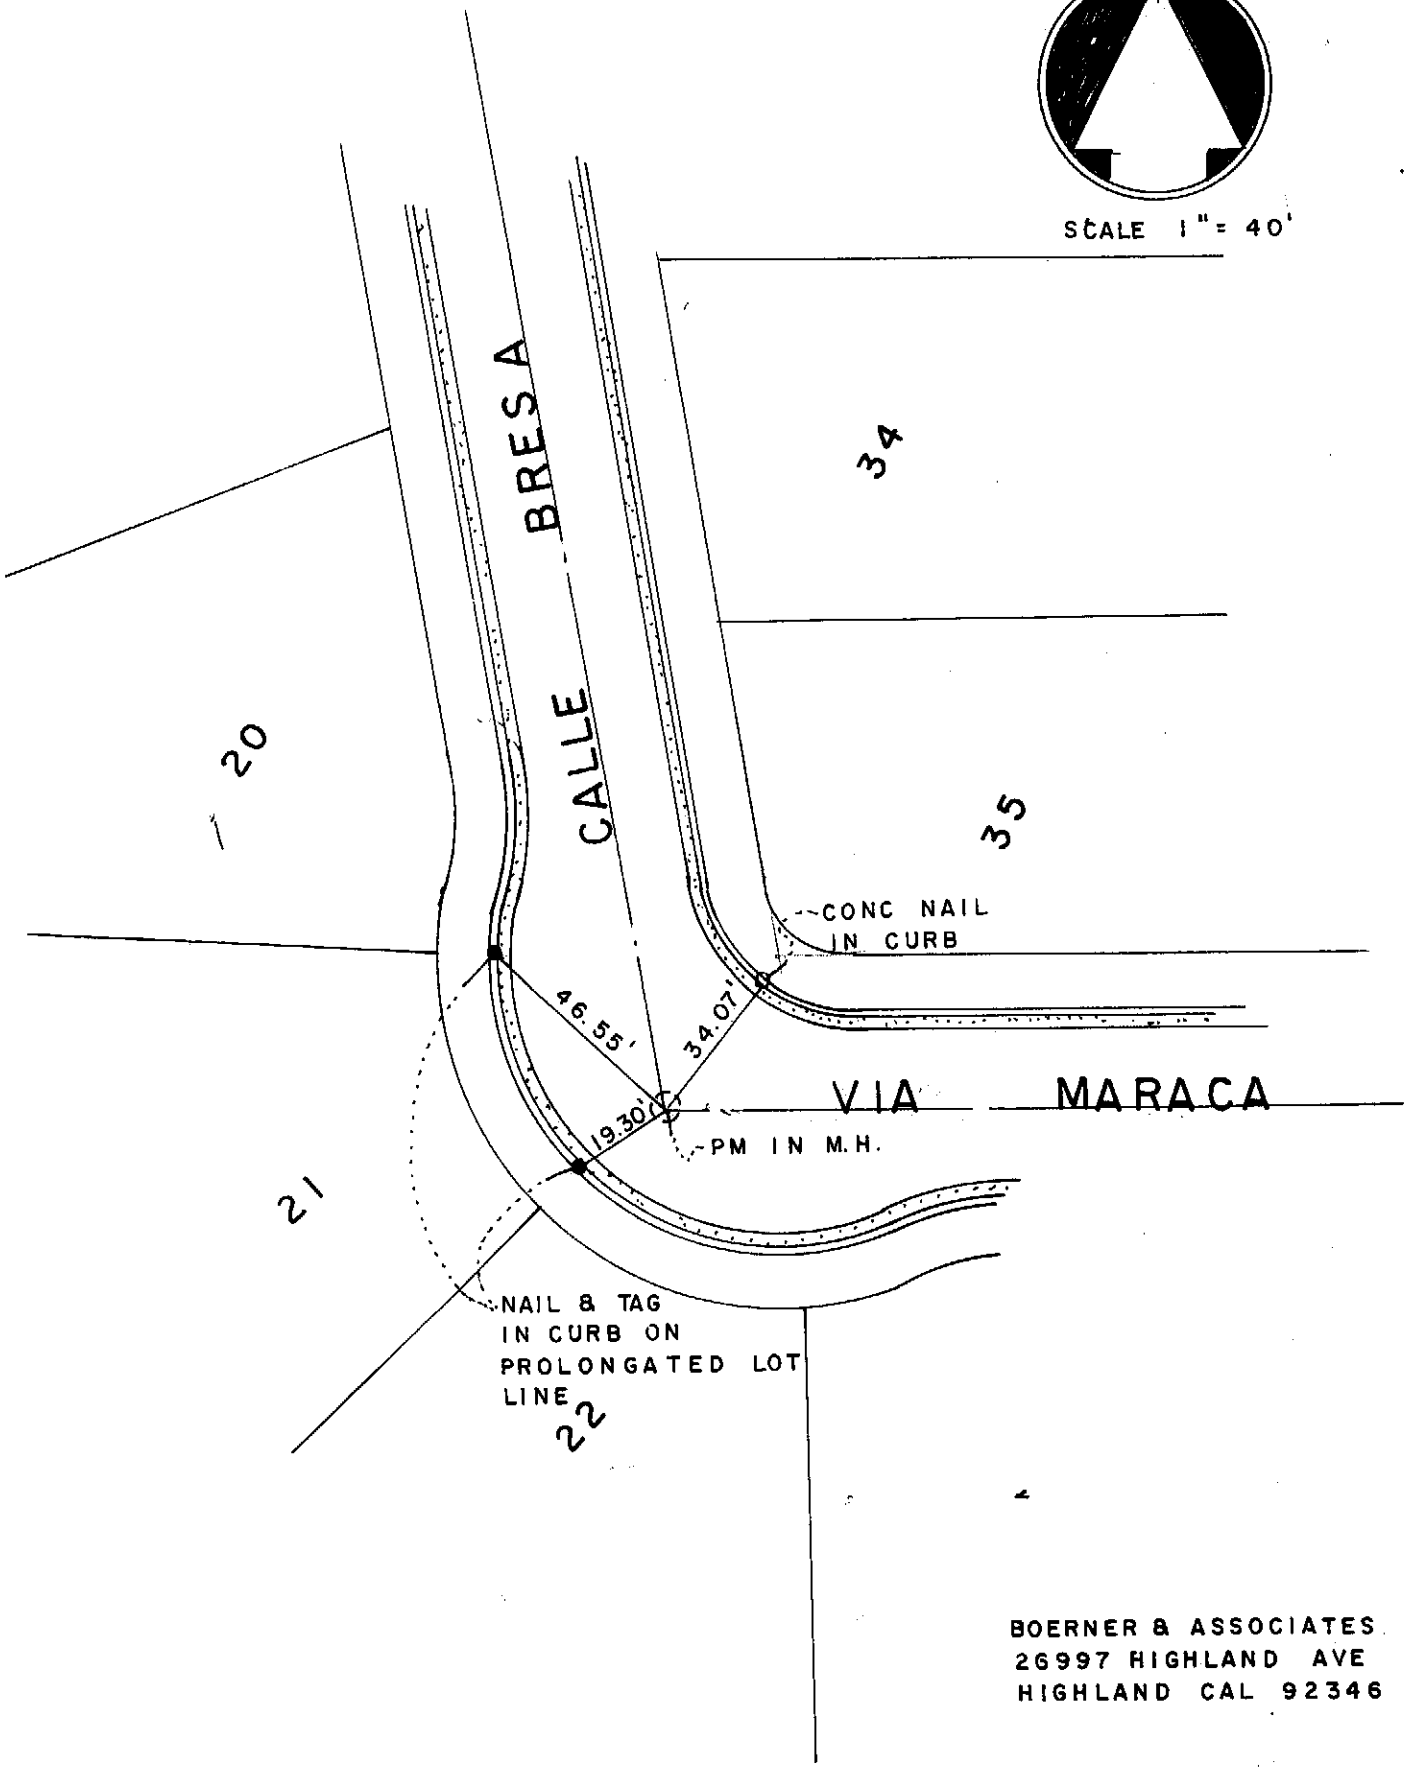

BOERNER & ASSOCIATES
26997 HIGHLAND AVE
HIGHLAND CAL 92346

TRACT NO. 9589
STREET CENTERLINE TIES

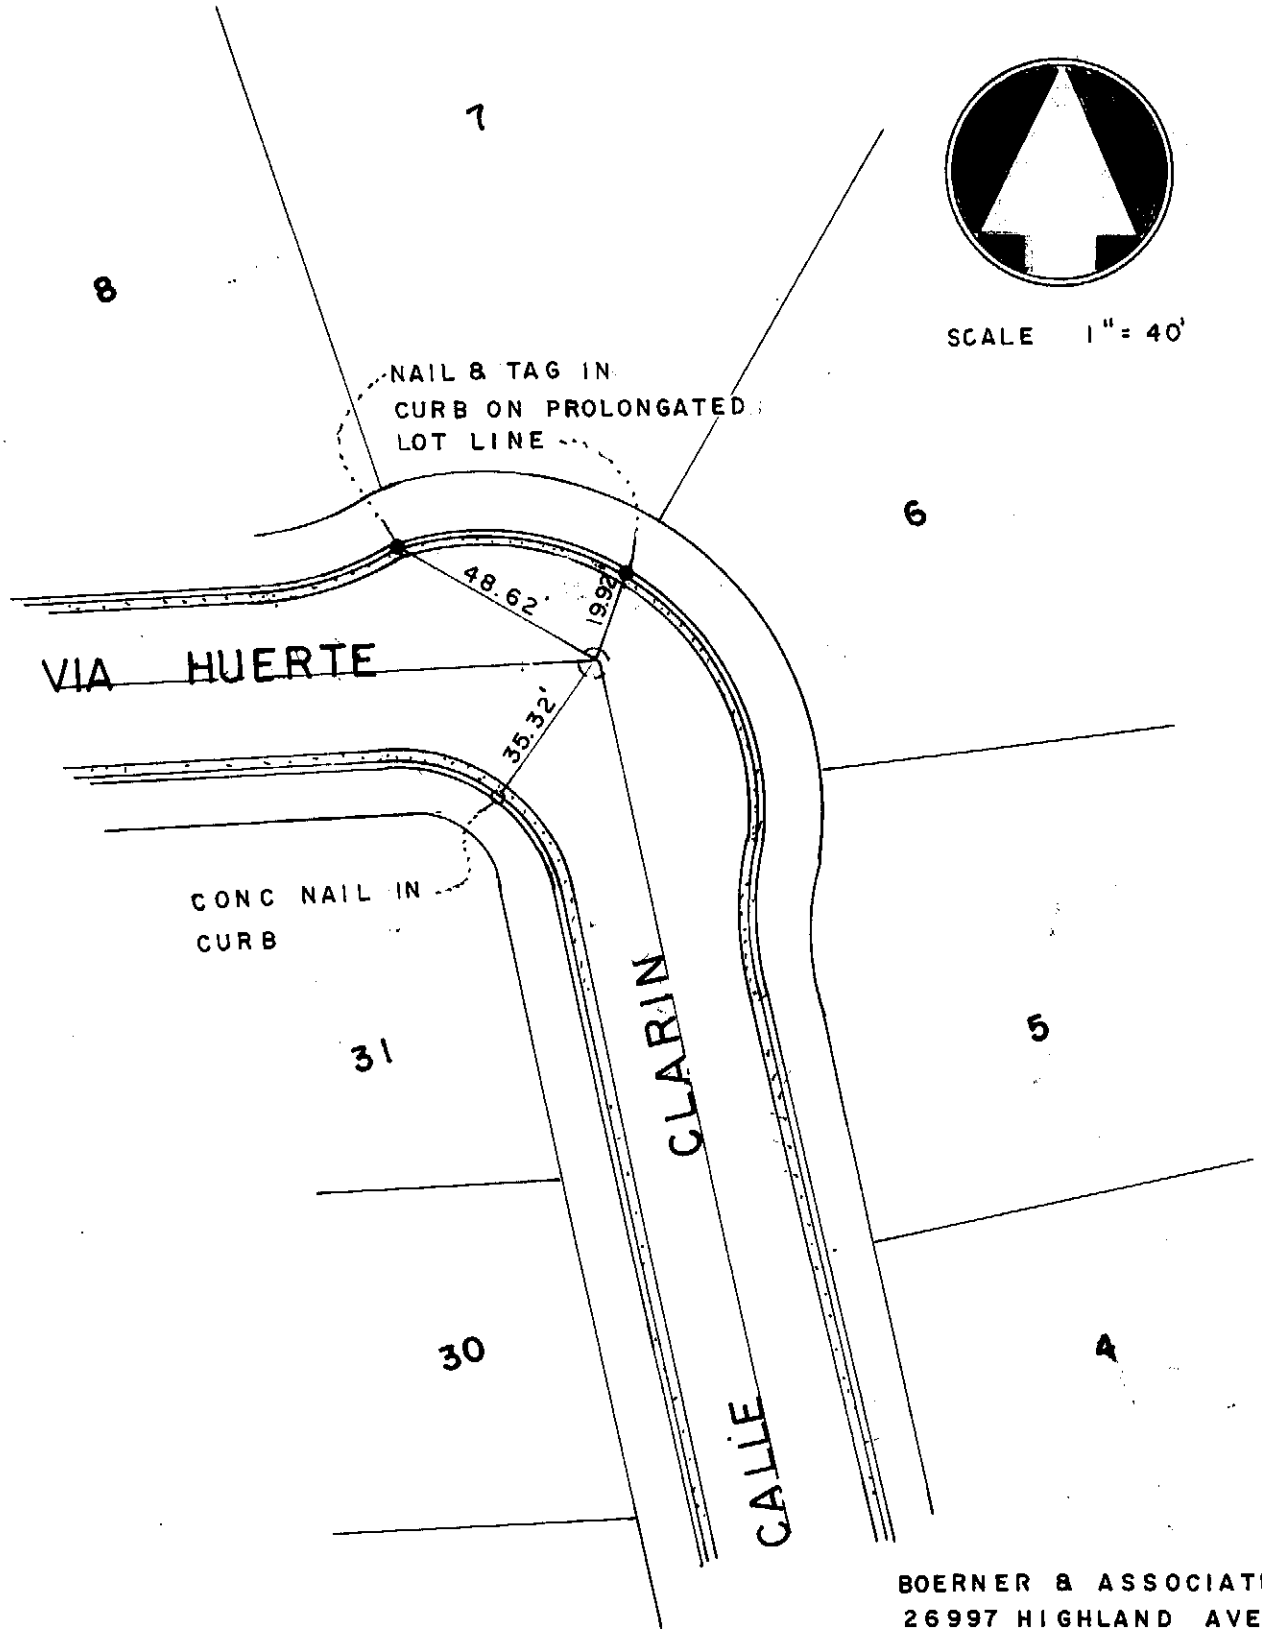

BOERNER & ASSOCIATES
26997 HIGHLAND AVE.
HIGHLAND, CAL. 92346

TRACT NO. 9589
STREET CENTERLINE TIES

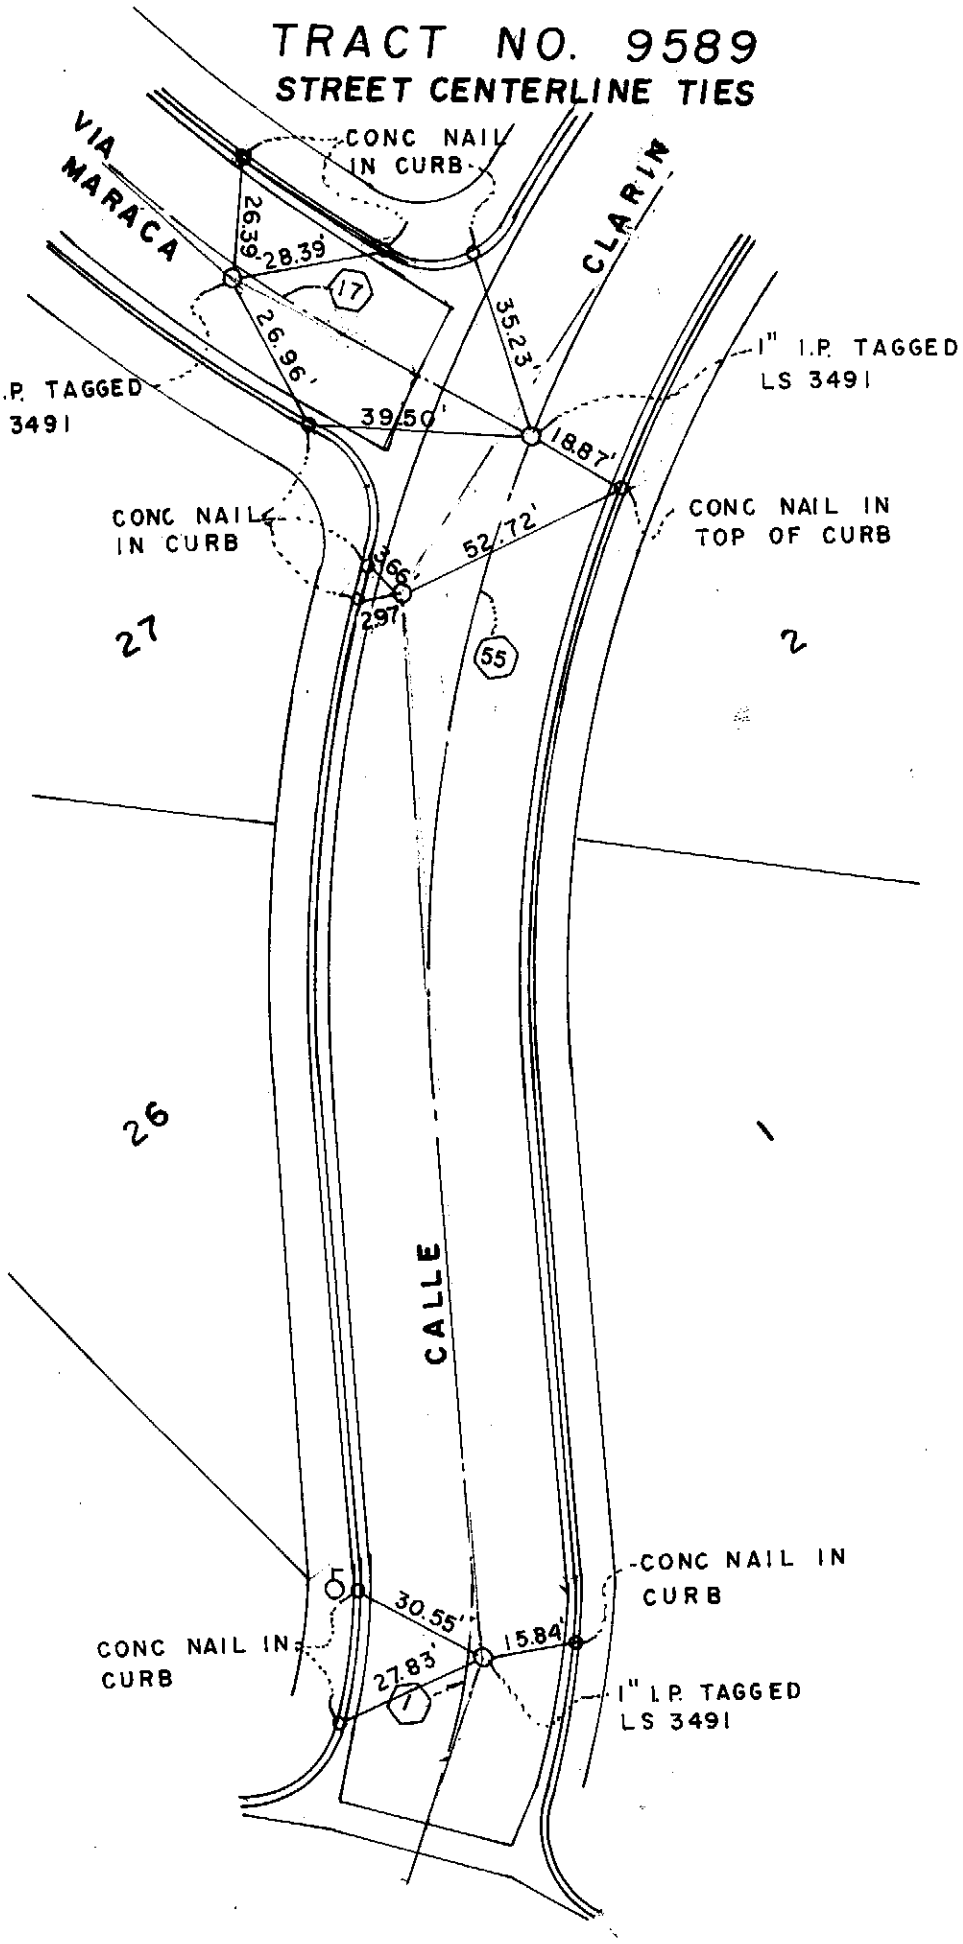

SCALE 1" = 40'

BOERNER & ASSOCIATES
26997 HIGHLAND AVE
HIGHLAND, CAL. 92346

Book 5 Page 91

TRACT NO. 9589
STREET CENTERLINE TIES

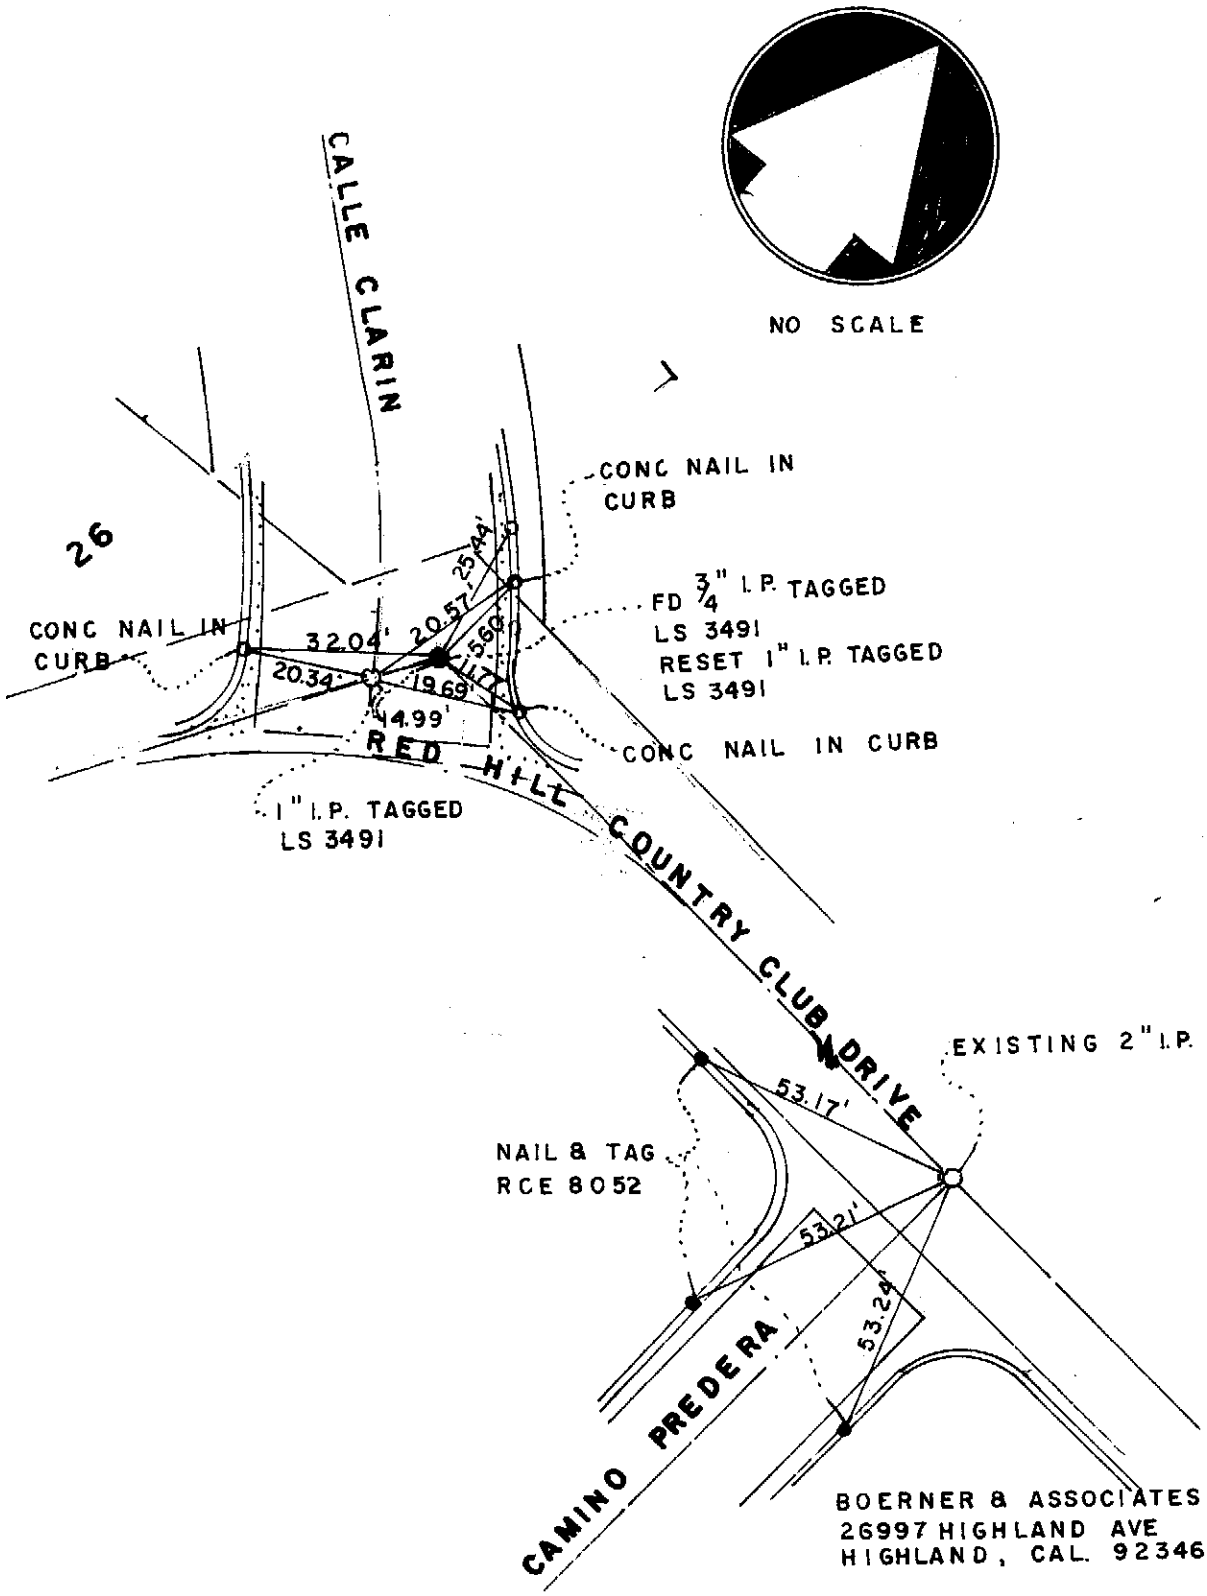

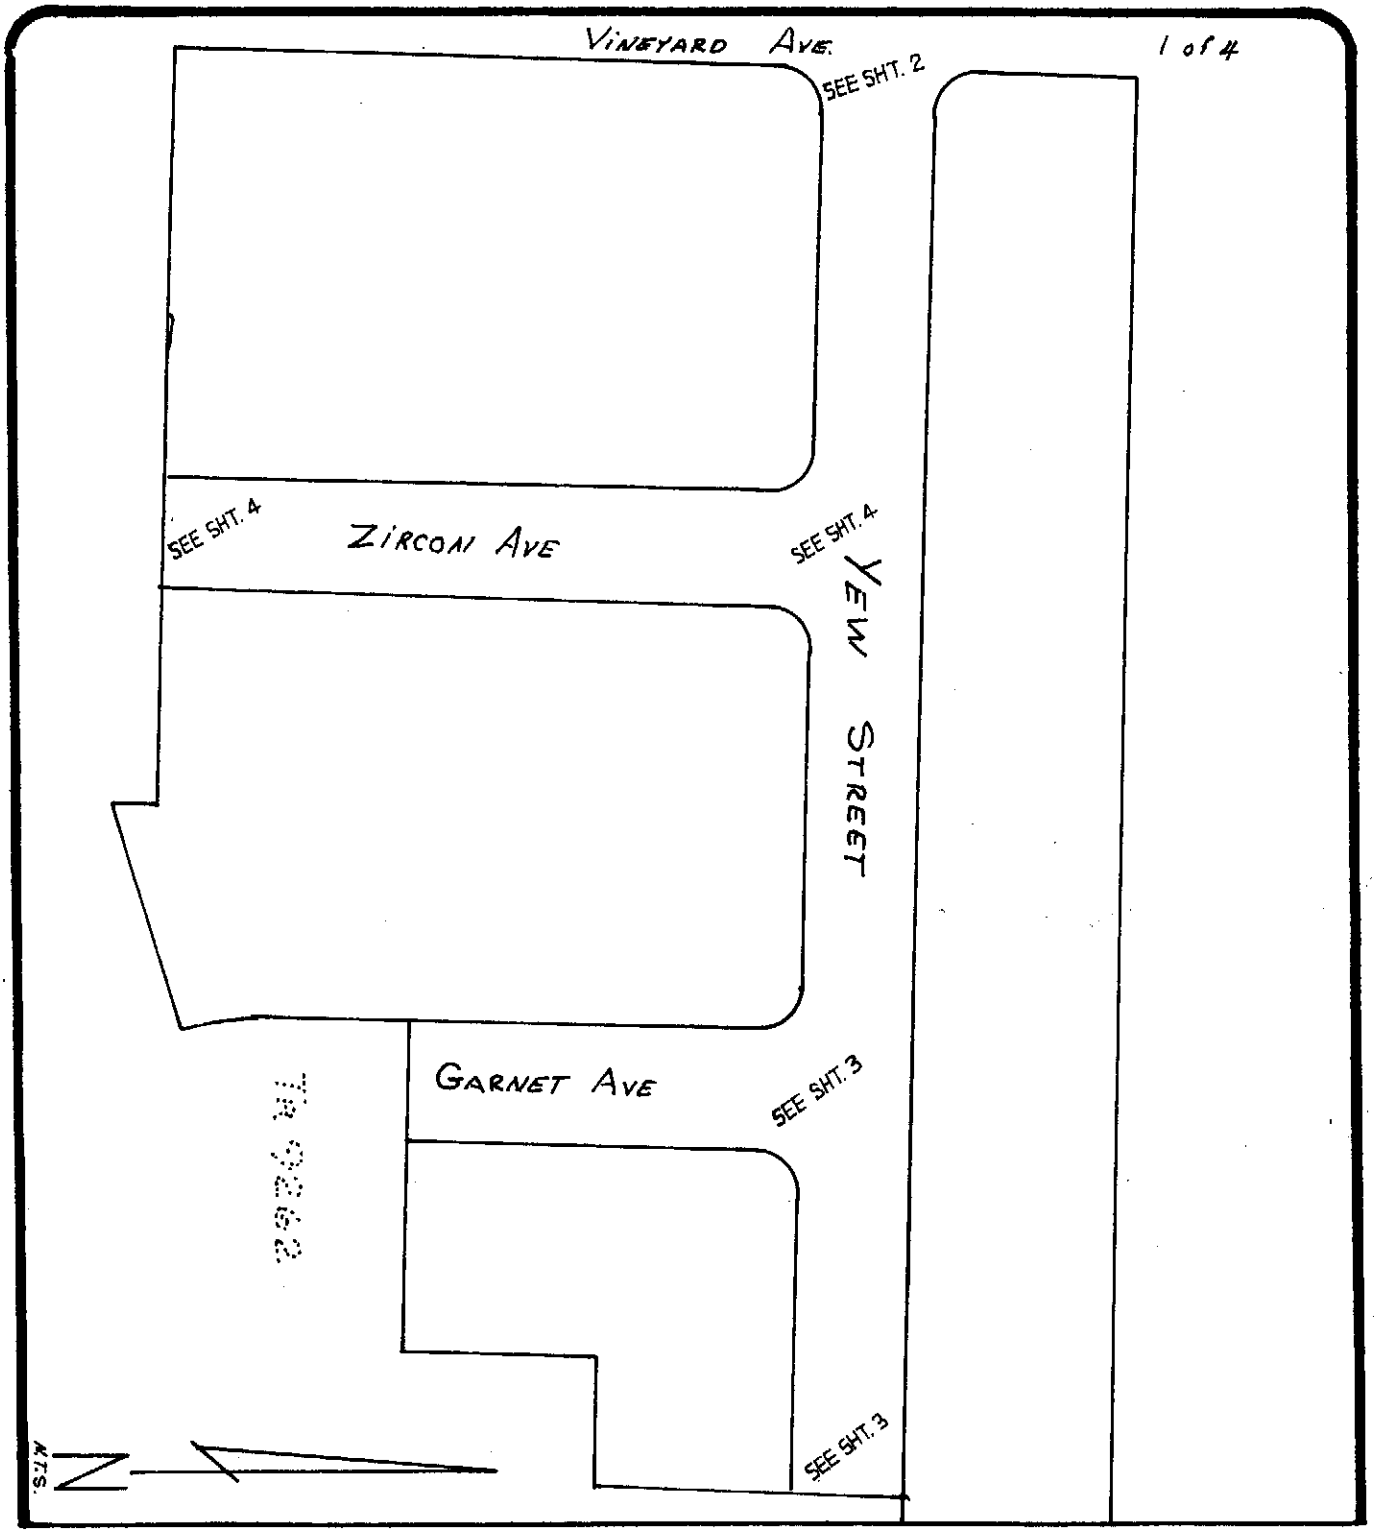

city of rancho cucamonga — STREET TIE	TRACT 9193
Hall & Foreman Inc 3186-L Airway Ave Costa Mesa, Calif. 92626 714-641-8777	VICINITY & LOCATION MAP
ENGR. / L.S. George H. Crawford	FIELD REVIEW _____ DATE _____
~~R.C.E.~~ / L.S. No. 3419 DATE 5-25-82	TIE BOOK 5 PAGE 23

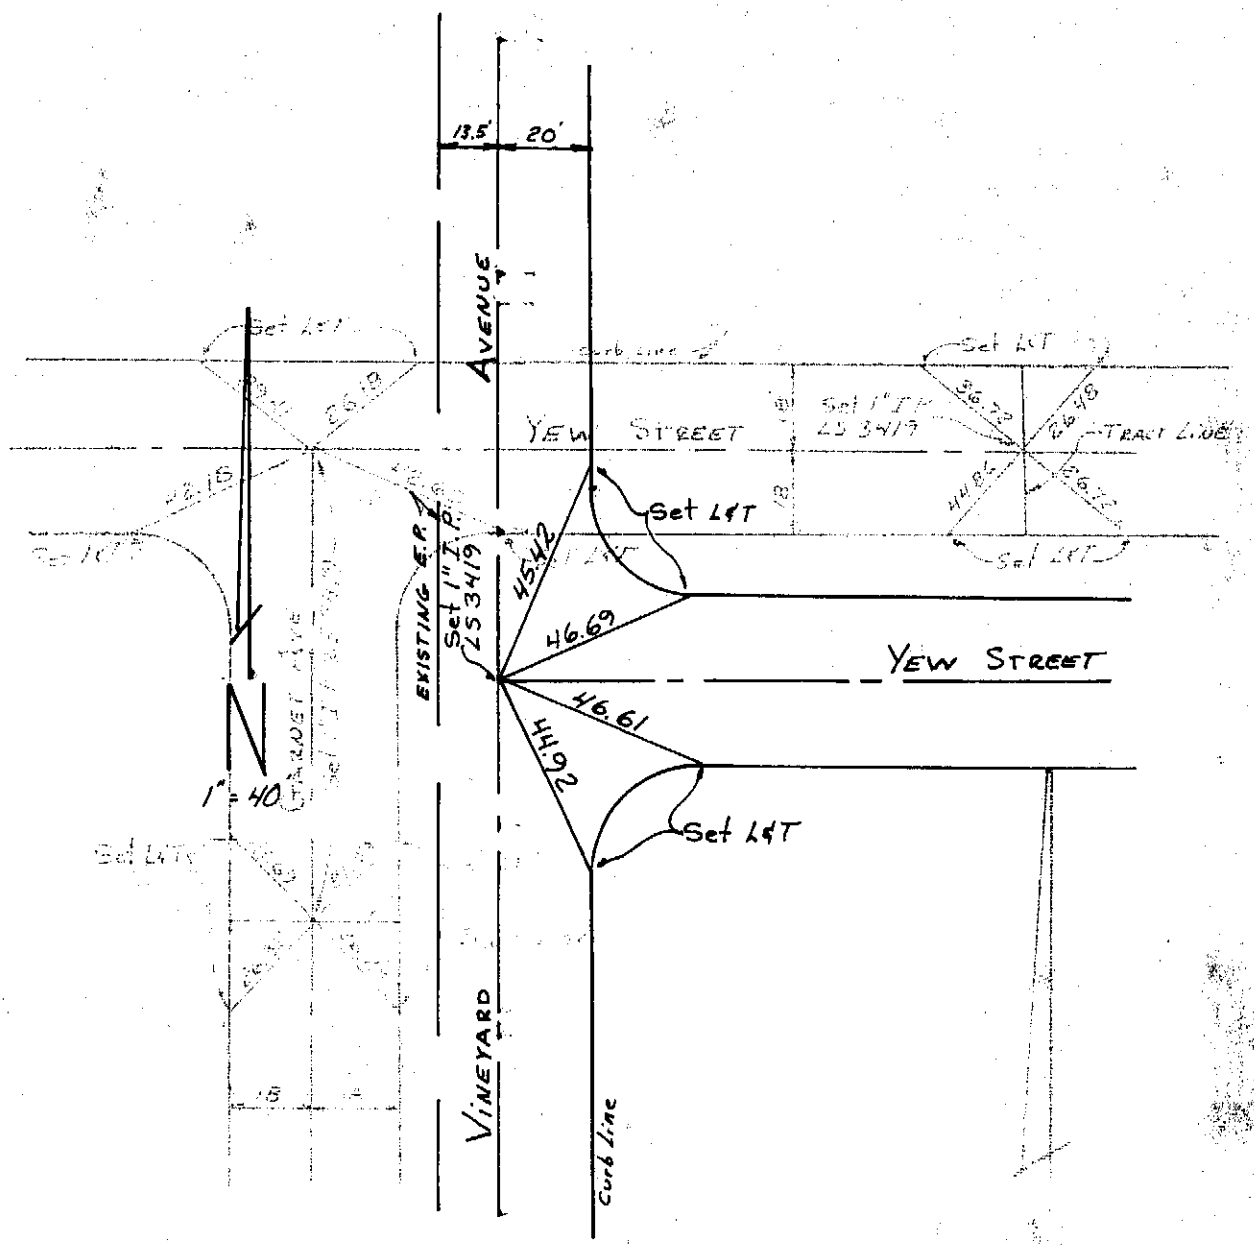

city of rancho cucamonga STREET TIE	TRACT 9193
Mall & Foreman Inc. 3186-L Airway Ave Costa Mesa, Calif 92626 714-641-8777	℄ INT TIES FOR VINEYARD AVE & YEW ST.
ENGR./L.S. George W. Stewart	FIELD REVIEW _____ DATE _____
R.C.E./L.S. No. 3419 DATE 5-25-82	TIE BOOK 5 PAGE _____

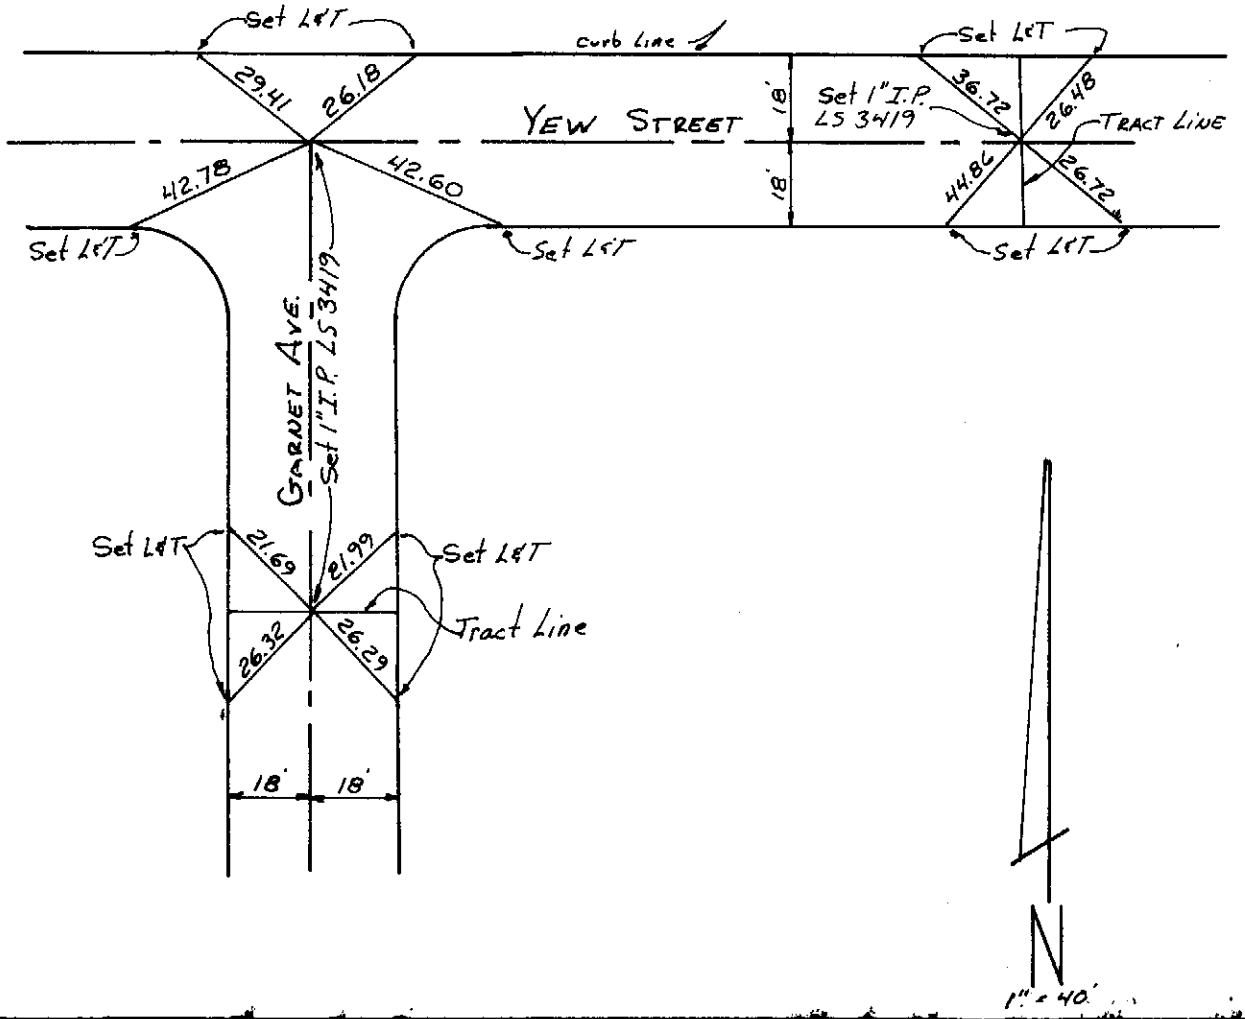

city of rancho cucamonga STREET TIE	TRACT 9193
Hall & Foreman Inc. 3186-L Airway Ave Costa Mesa, Calif. 92626 714-641-8777	℄ INT. TIES FOR YEW ST. & GARNET AVE.
ENGR. / L.S. George H. Shamfeld	FIELD REVIEW _____ DATE _____
R.C.E. / L.S. No. 3419 DATE 5-25-82	TIE BOOK 5 PAGE 95

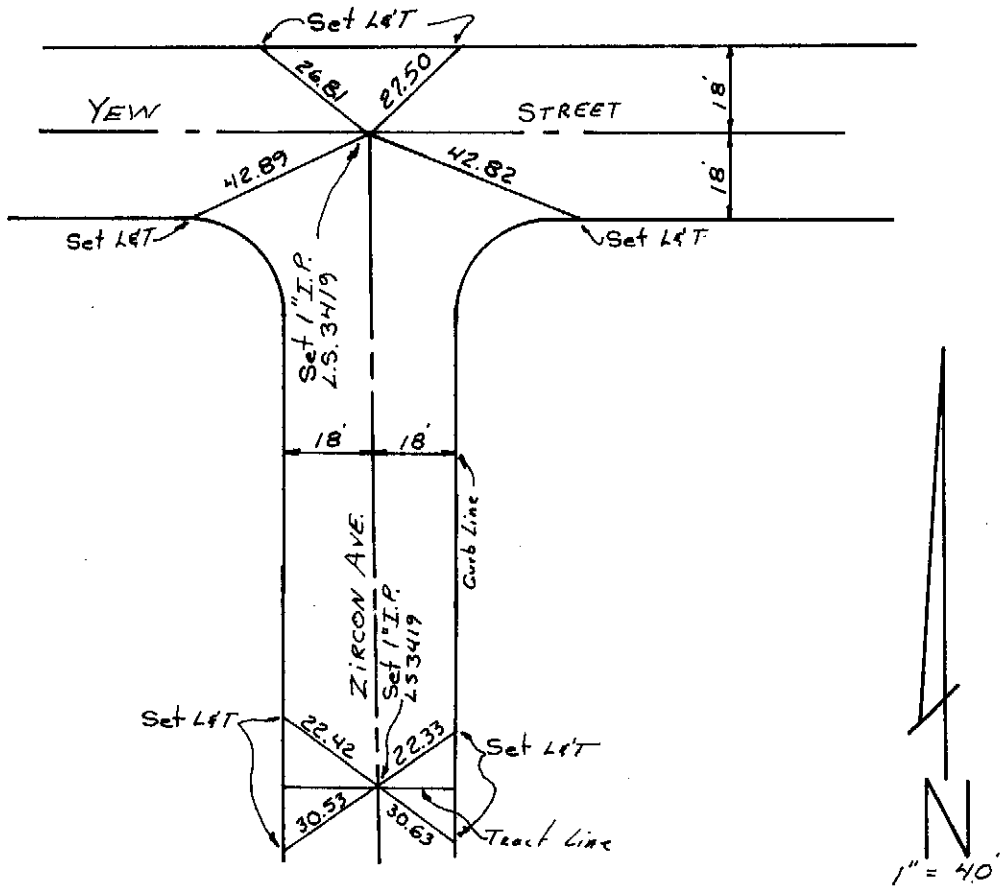

city of rancho cucamonga — STREET TIE	TRACT 9193
Hall & Foreman Inc. 3186-L Airway Ave. Costa Mesa, Calif. 92626 714-641-8777	℄ INT. TIES FOR YEW ST. & ZIRCON AVE.
ENGR. / L.S. George H. Thomas	FIELD REVIEW _____ DATE _____
R.C.E. / L.S. No. 3419 DATE 5-25-82	TIE BOOK 5 PAGE 96

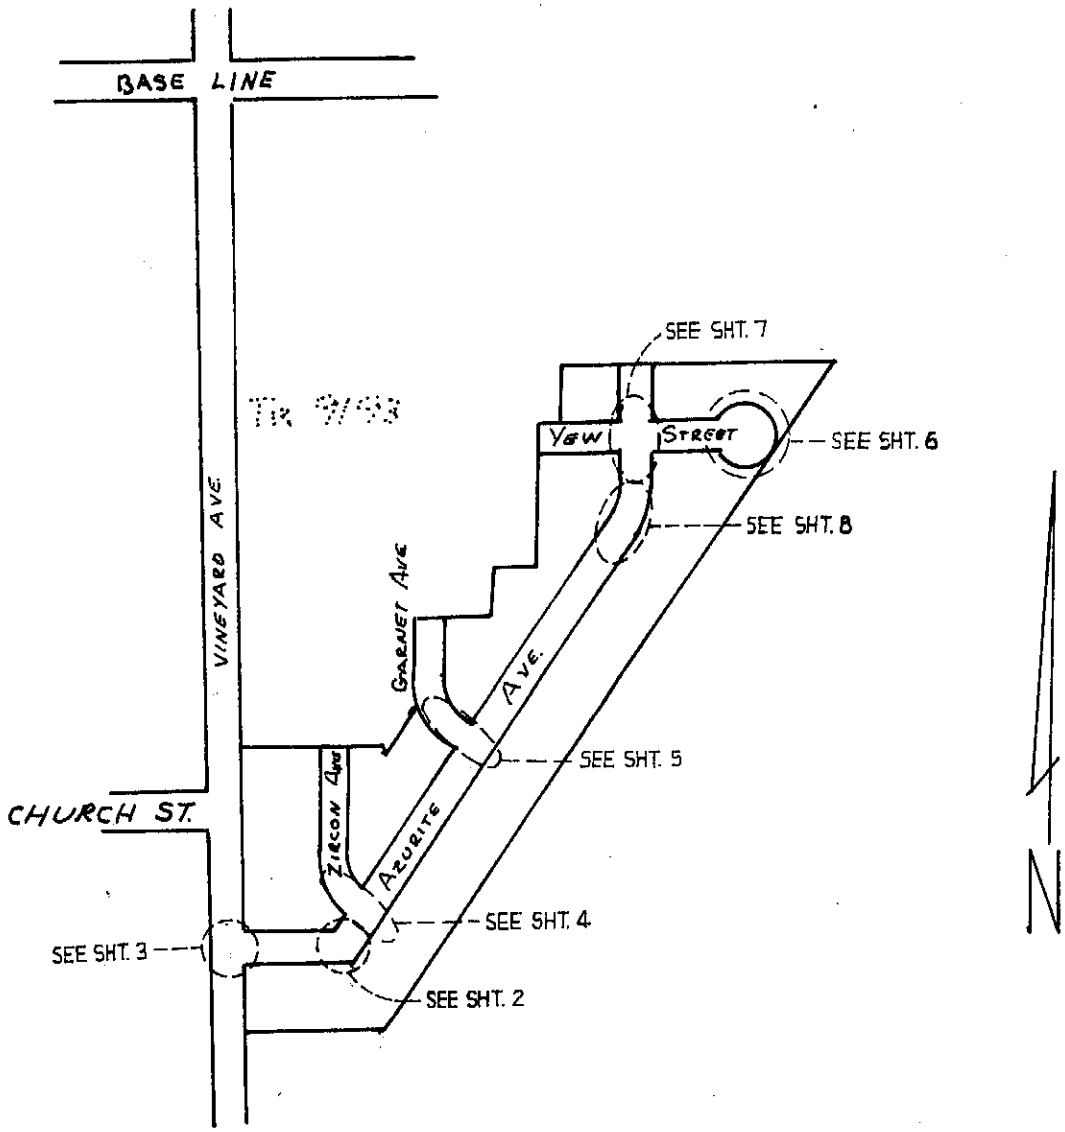

city of rancho cucamonga — STREET TIE	TRACT 9262
Hall & Foreman Inc. 3186-L Airway Ave Costa Mesa, Calif. 92626 714-641-8777	VICINITY & LOCATION MAP
ENGR./L.S. [signature]	FIELD REVIEW _____ DATE _____
~~R.C.E.~~ /L.S. No. 3419 DATE 5-25-82	TIE BOOK 5 PAGE 97

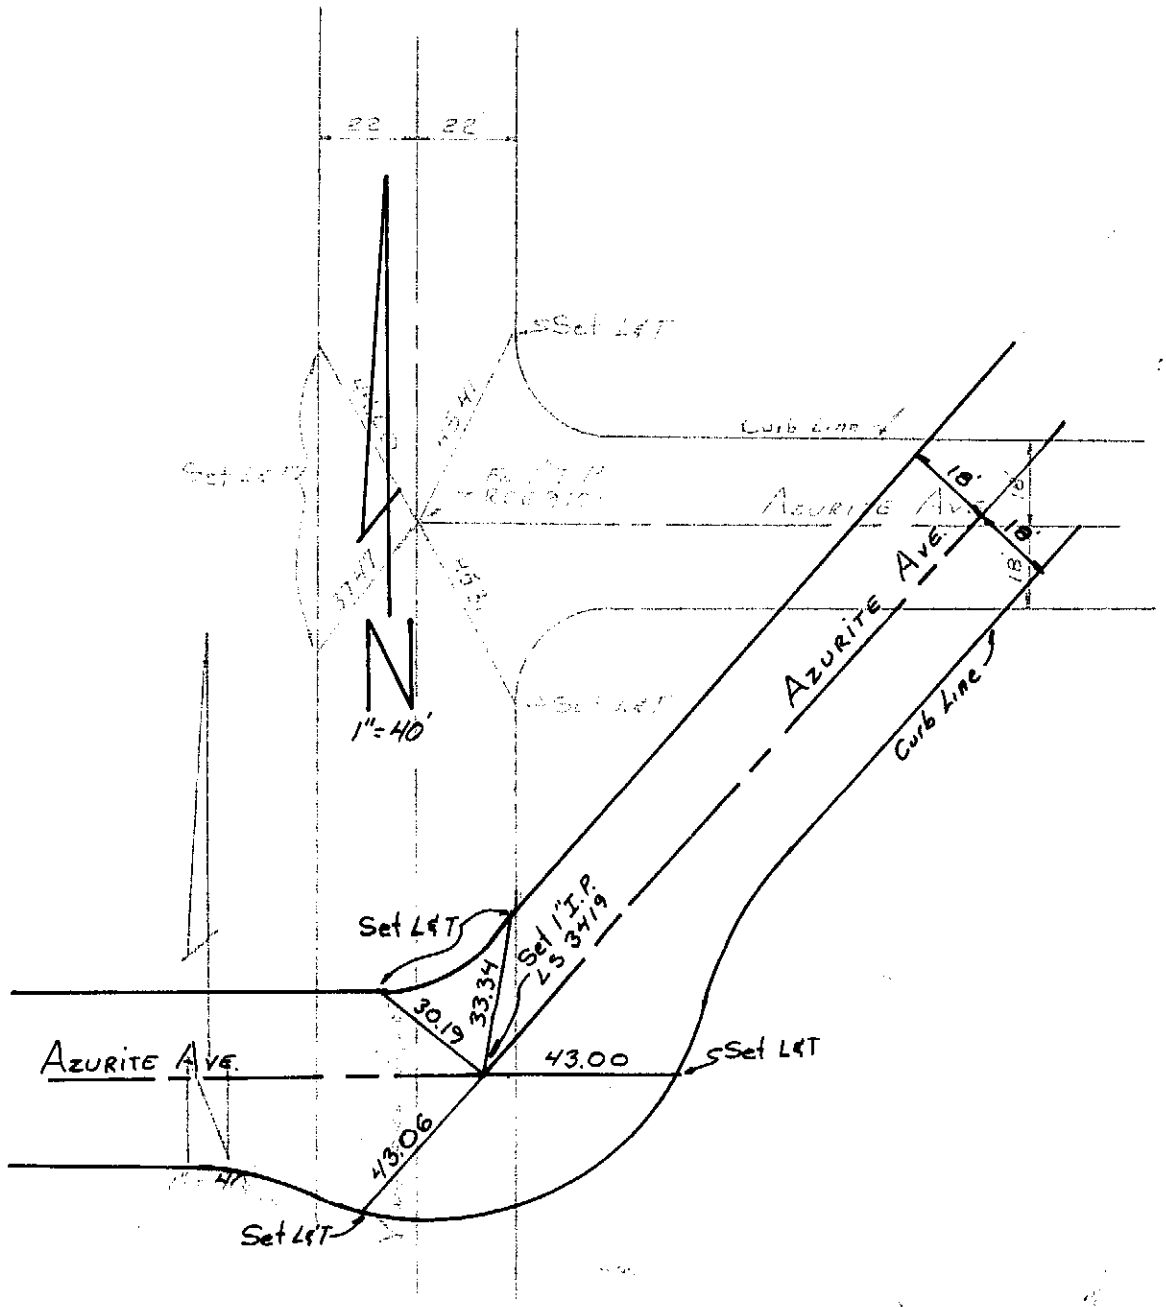

City of Rancho Cucamonga	STREET TIE
Hall & Foreman Inc. 3186 L Airway Ave Costa Mesa, Calif 92626 714-641-8777	TRACT 9262 & FIGS FOR AZURITE AVE. VINEYARD AVE. & AZURITE AVE.
ENGR / L.S.	FIELD REVIEW DATE
R.C.E. / L.S. No. 3419 DATE 5-25-82	TIE BOOK 5 PAGE

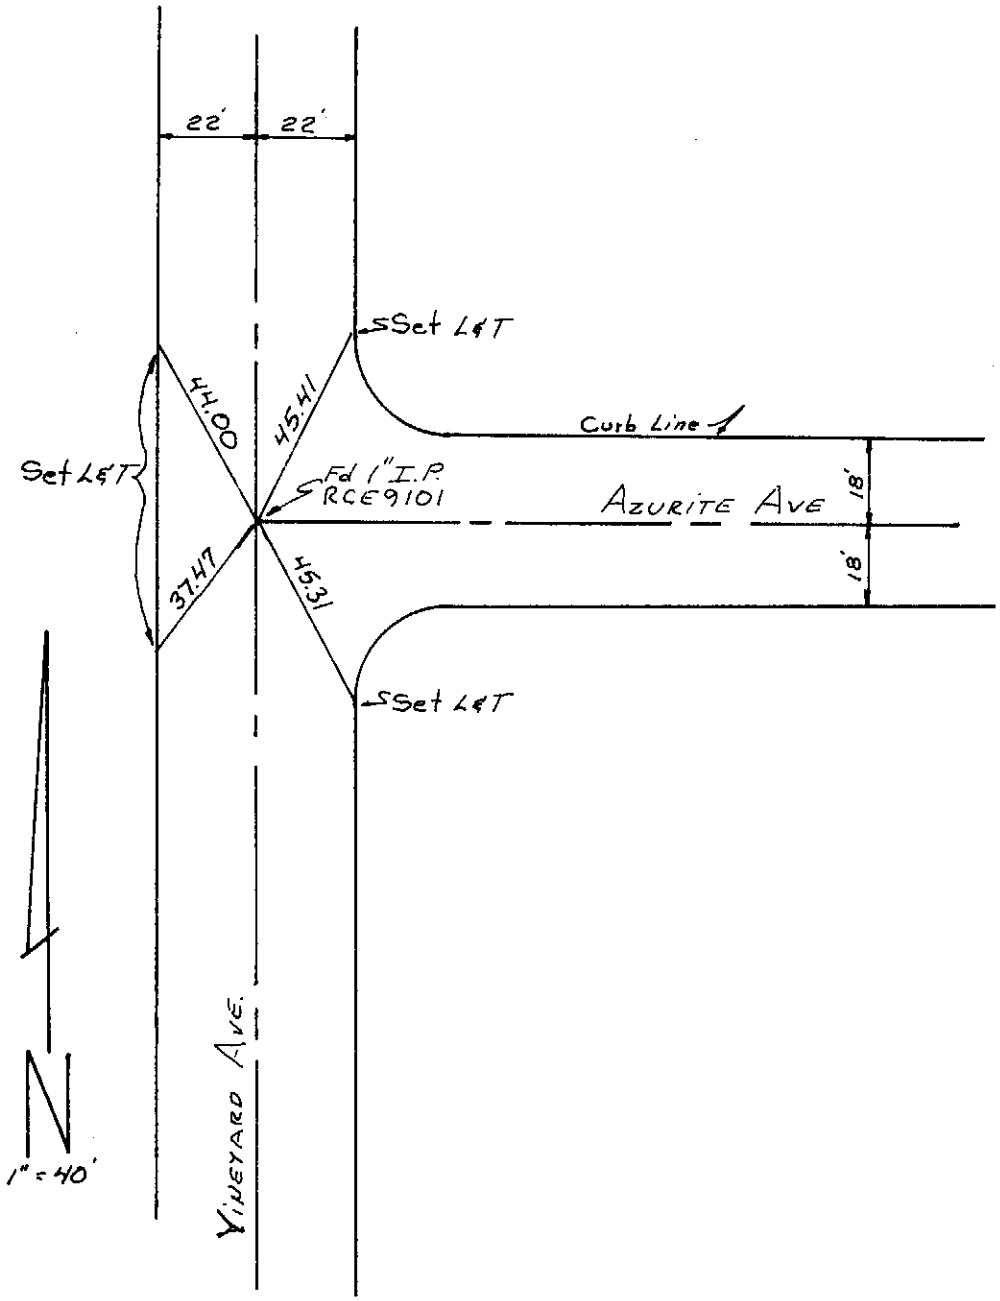

city of rancho cucamonga — STREET TIE	TRACT 9262.
Hall & Foreman Inc. 3186-L Airway Ave. Costa Mesa, Calif. 92626 714-641-8777	℄ Int. Ties For Vineyard Ave. & Azurite Ave.
ENGR. / L.S. [signature]	FIELD REVIEW _____ DATE _____
R.C.E. / L.S. No. 3419 DATE 5-25-82	TIE BOOK 5 PAGE 99

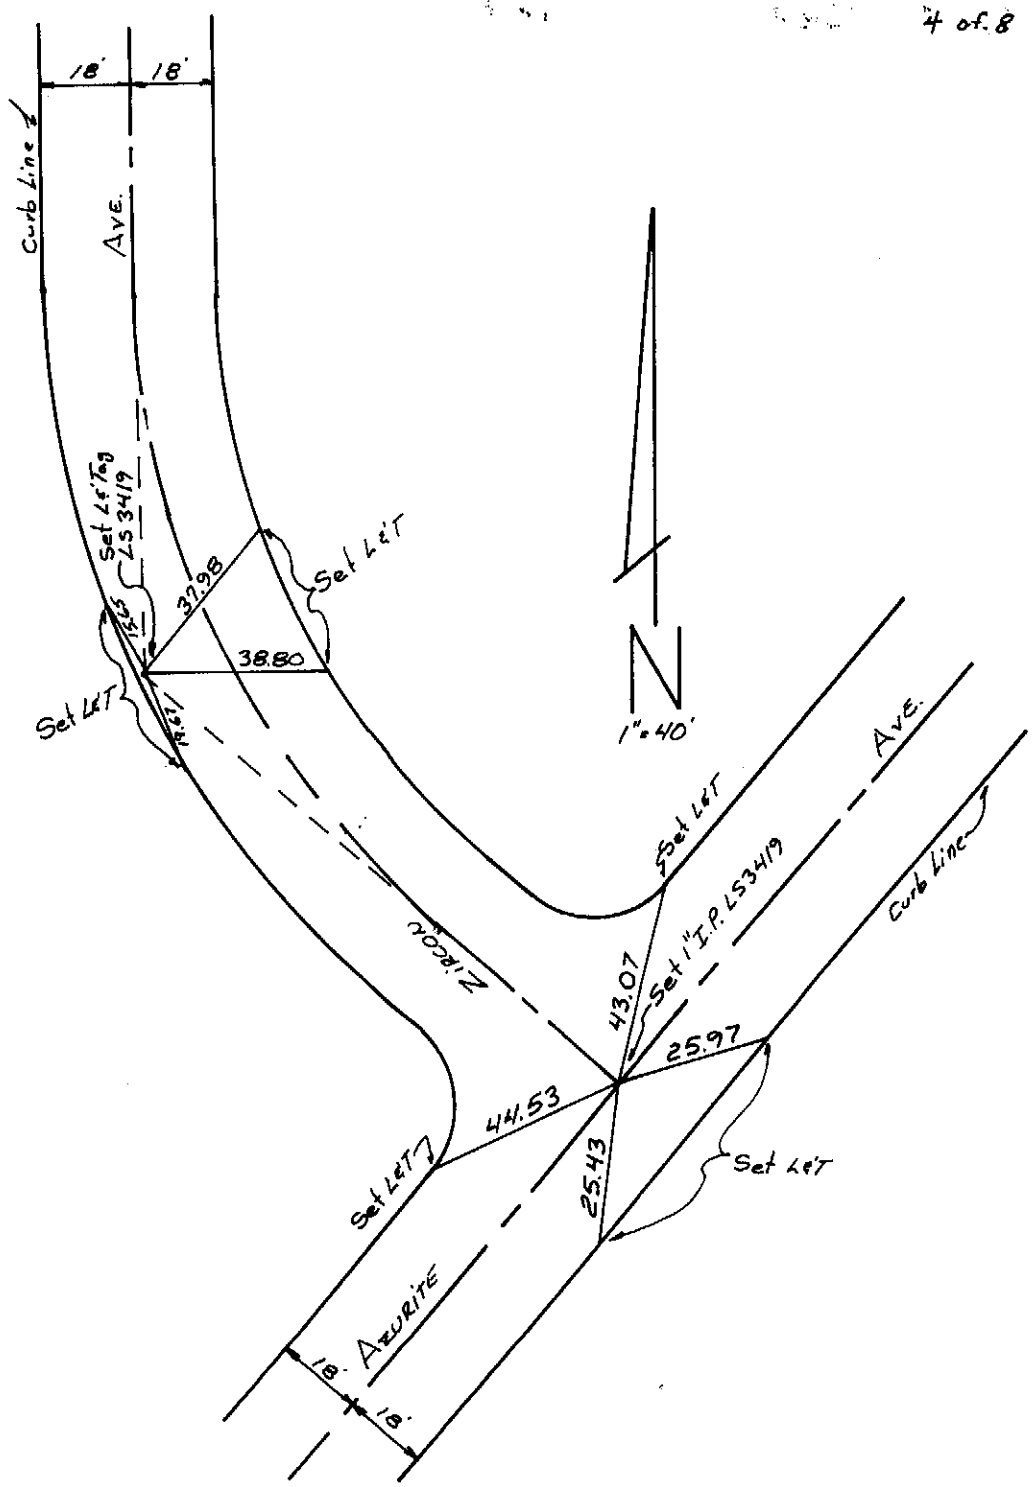

city of rancho cucamonga — STREET TIE	TRACT 9262
Hall & Foreman Inc. Costa Mesa, Calif. 92626 3186-L Airway Ave. 714-641-8777	℄ TIES FOR AZURITE AVE & ZIRCON AVE.
ENGR. / L.S. [signature]	FIELD REVIEW _____ DATE _____
~~R.C.E.~~ / L.S. No. 3419 DATE 5-25-82	TIE BOOK 5 PAGE 100

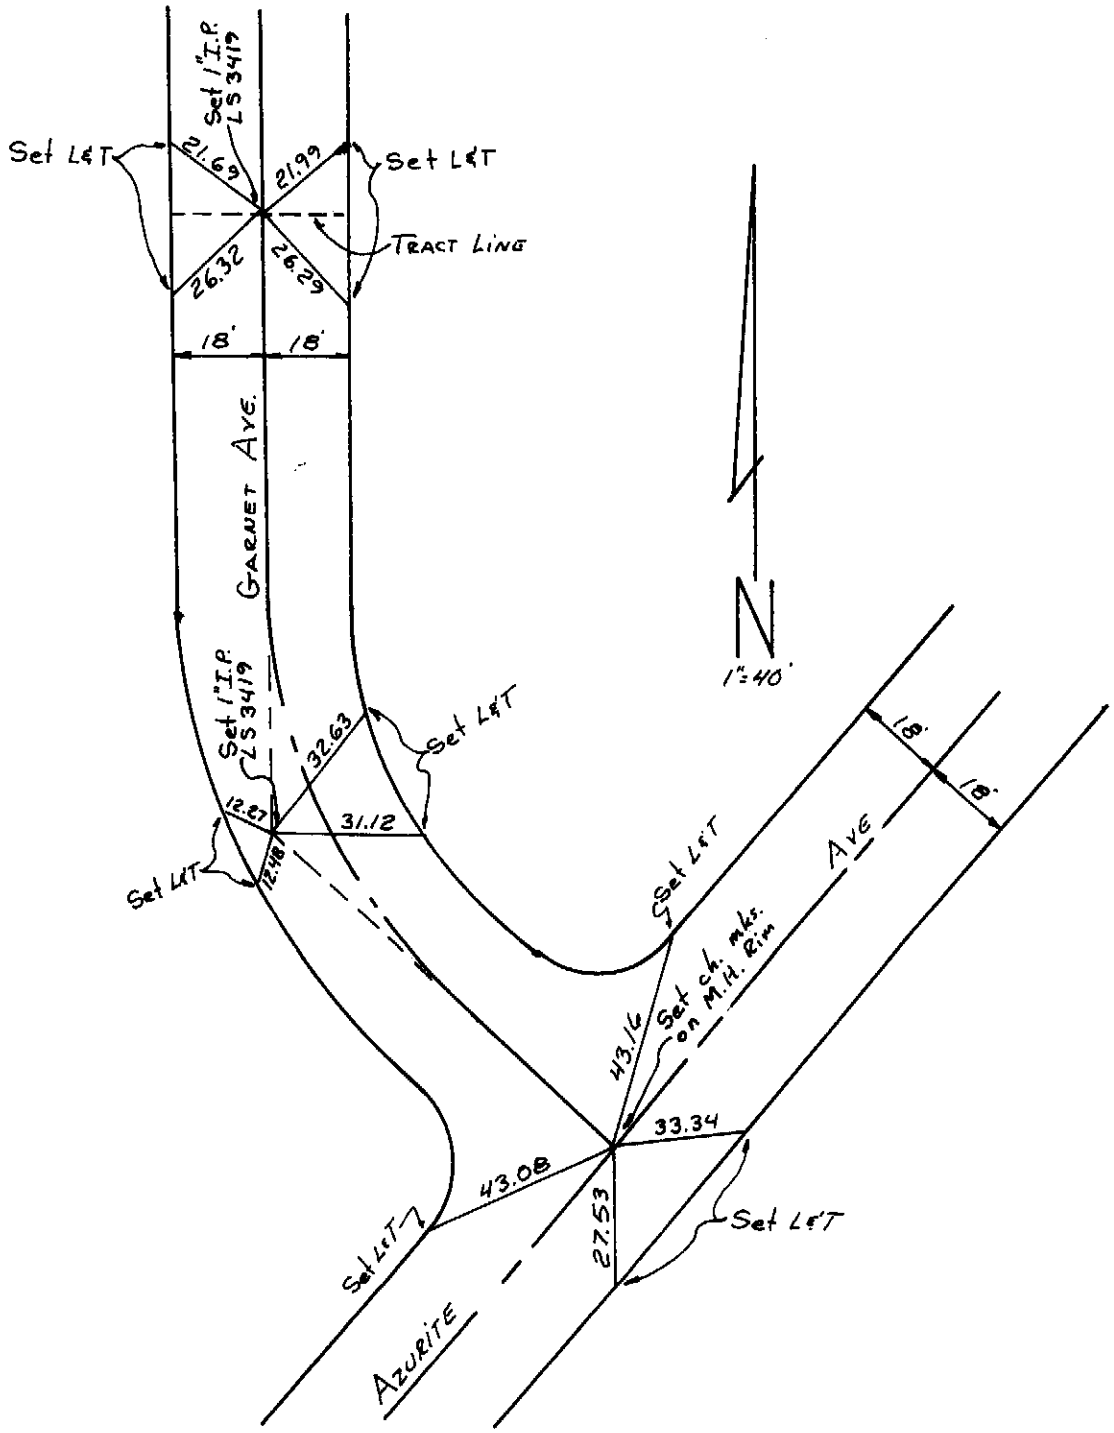

city of rancho cucamonga — STREET TIE	TRACT 9262
Hall & Foreman Inc. 3186-L Airway Ave. Costa Mesa, Calif. 92626 714-641-8777	& INT. TIES FOR AZURITE AVE. & GARNET AVE.
ENGR. / L.S. [signature]	FIELD REVIEW _____ DATE _____
~~R.C.E.~~ / L.S. No. 3419 DATE 5-25-82	TIE BOOK 5 PAGE 101

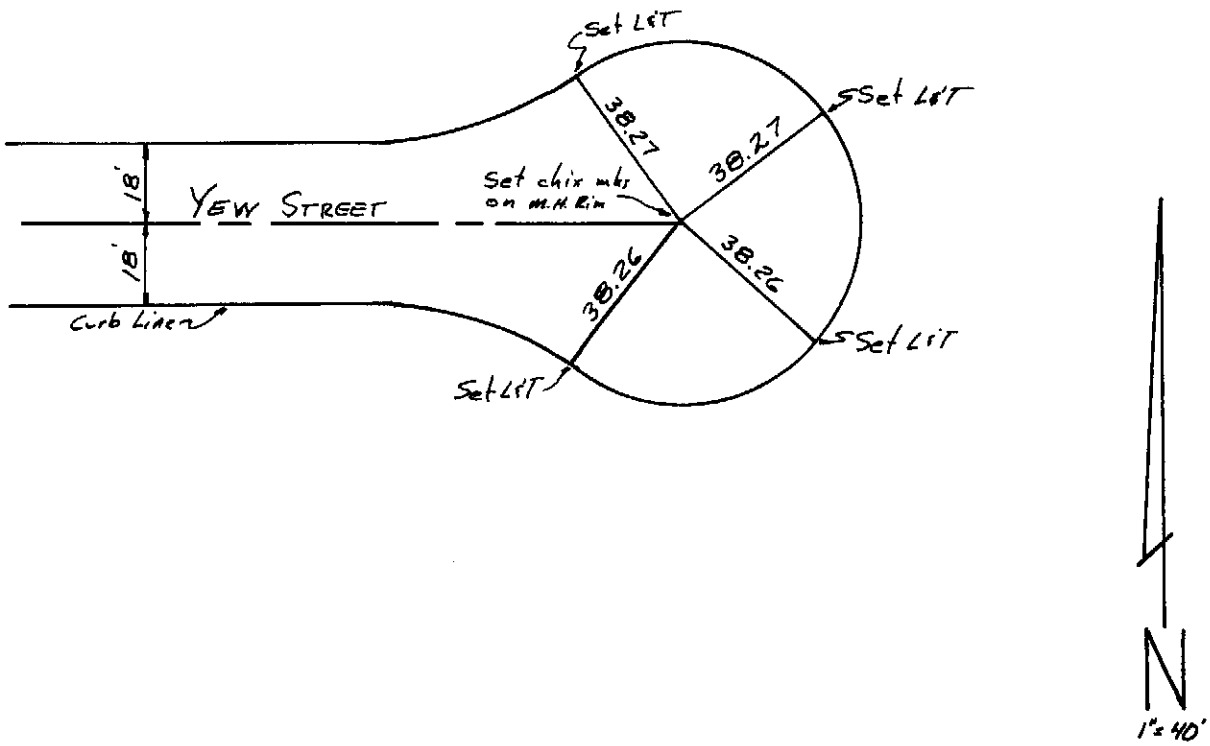

city of rancho cucamonga — STREET TIE	TRACT 9262
Hall & Foreman Inc. 3186-L Airway Ave. Costa Mesa Calif. 92626 714-641-8777	& TIE on Cul-de-Sac YEW STREET
ENGR. / L.S. [signature]	FIELD REVIEW _____ DATE _____
~~R.C.E.~~ / L.S. No. 3419 DATE 5-25-82	TIE BOOK 5 PAGE 102

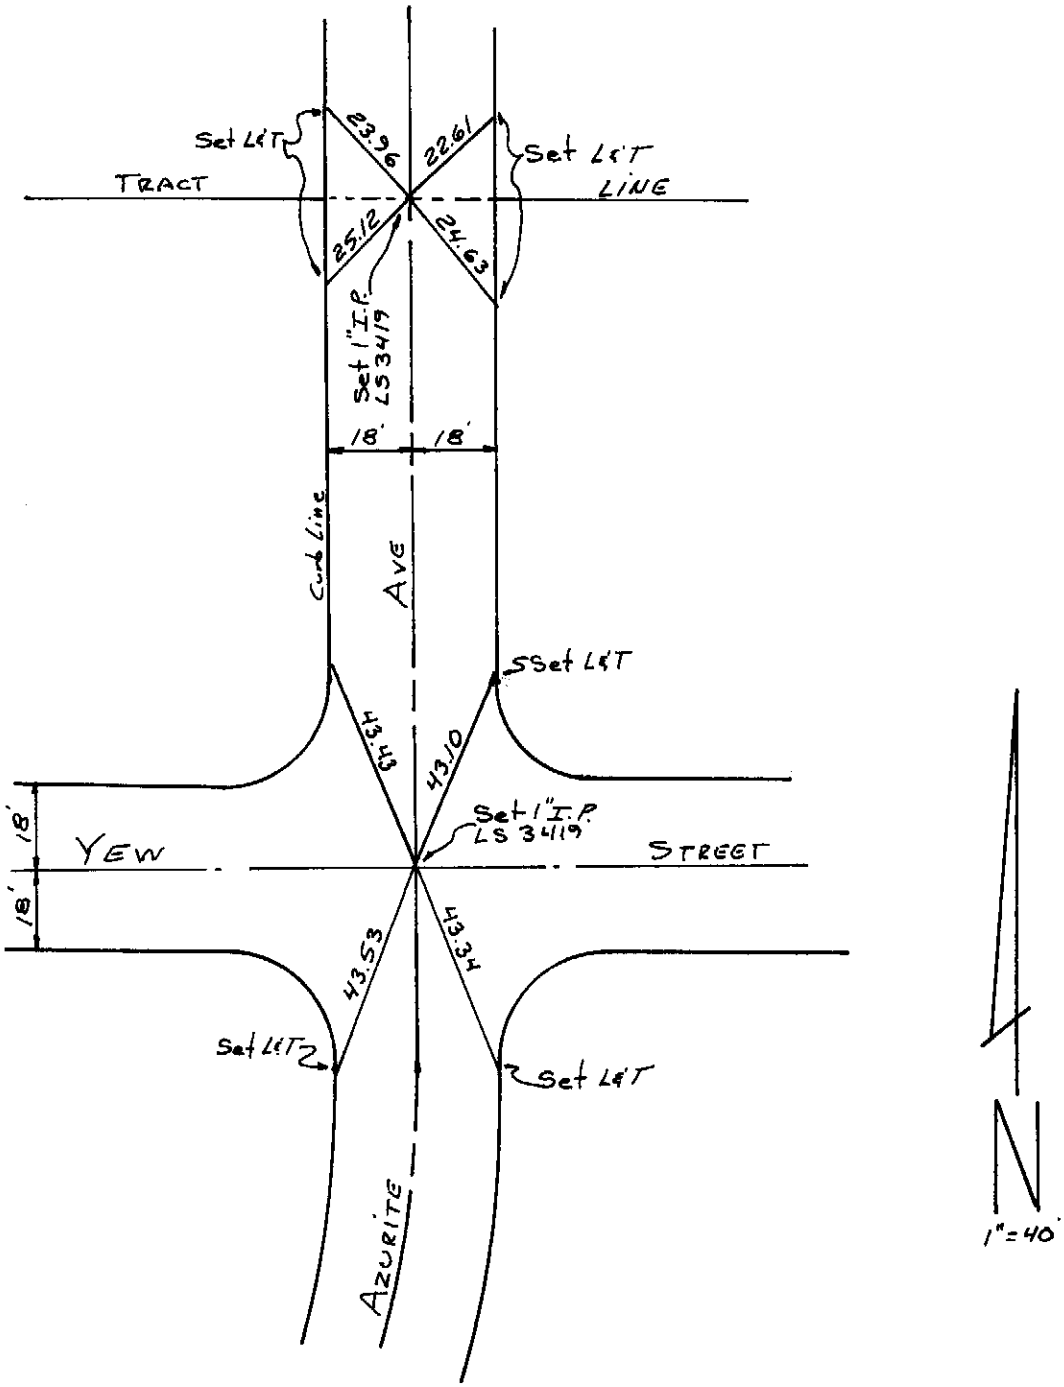

city of rancho cucamonga — STREET TIE	TRACT 9262
Hall & Foreman Inc. 3186-L Airway Ave. Costa Mesa, Calif. 92626 714-641-8777	℄ INT. TIES FOR YEW ST & AZURITE AVE.
ENGR. / L.S. [signature]	FIELD REVIEW _____ DATE _____
~~R.C.E.~~ / L.S. No. 3419 DATE 5-25-82	TIE BOOK 5 PAGE 103

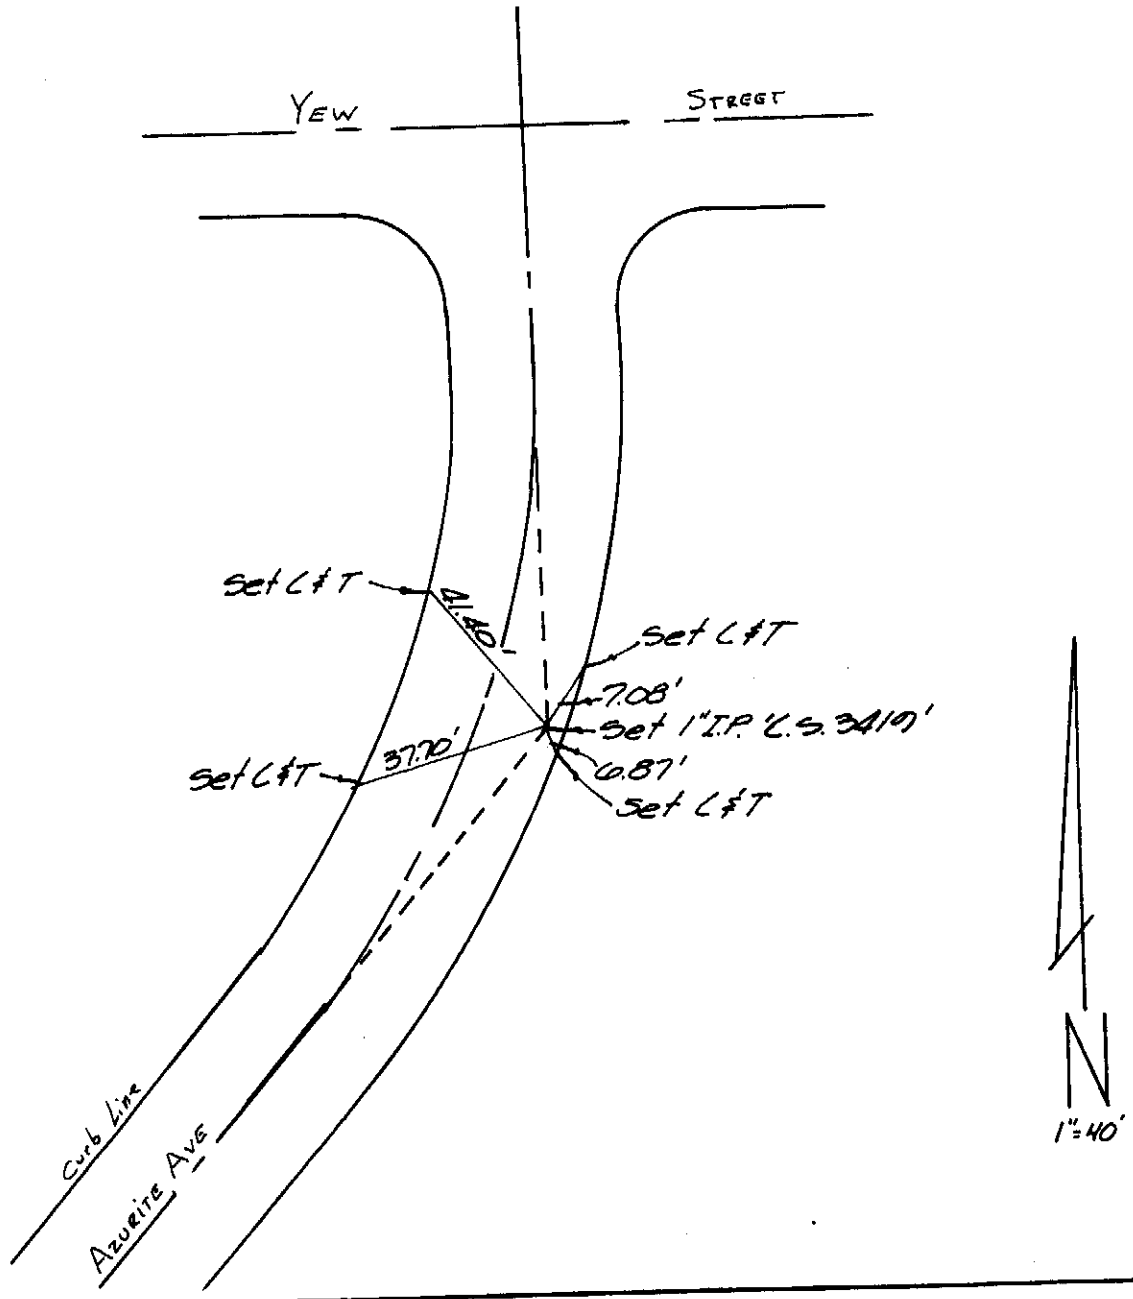

city of rancho cucamonga — STREET TIE	TRACT 9262
Hall & Foreman Inc. 3186-L Airway Ave. Costa Mesa, Calif. 92626 714-641-8777	℄ TIE FOR P.I. OF AZURITE AVE.
ENGR. / L.S. [signature]	FIELD REVIEW _____ DATE _____
~~R.C.E.~~ / L.S. No. 3419 DATE 5-25-82	TIE BOOK 5 PAGE 104