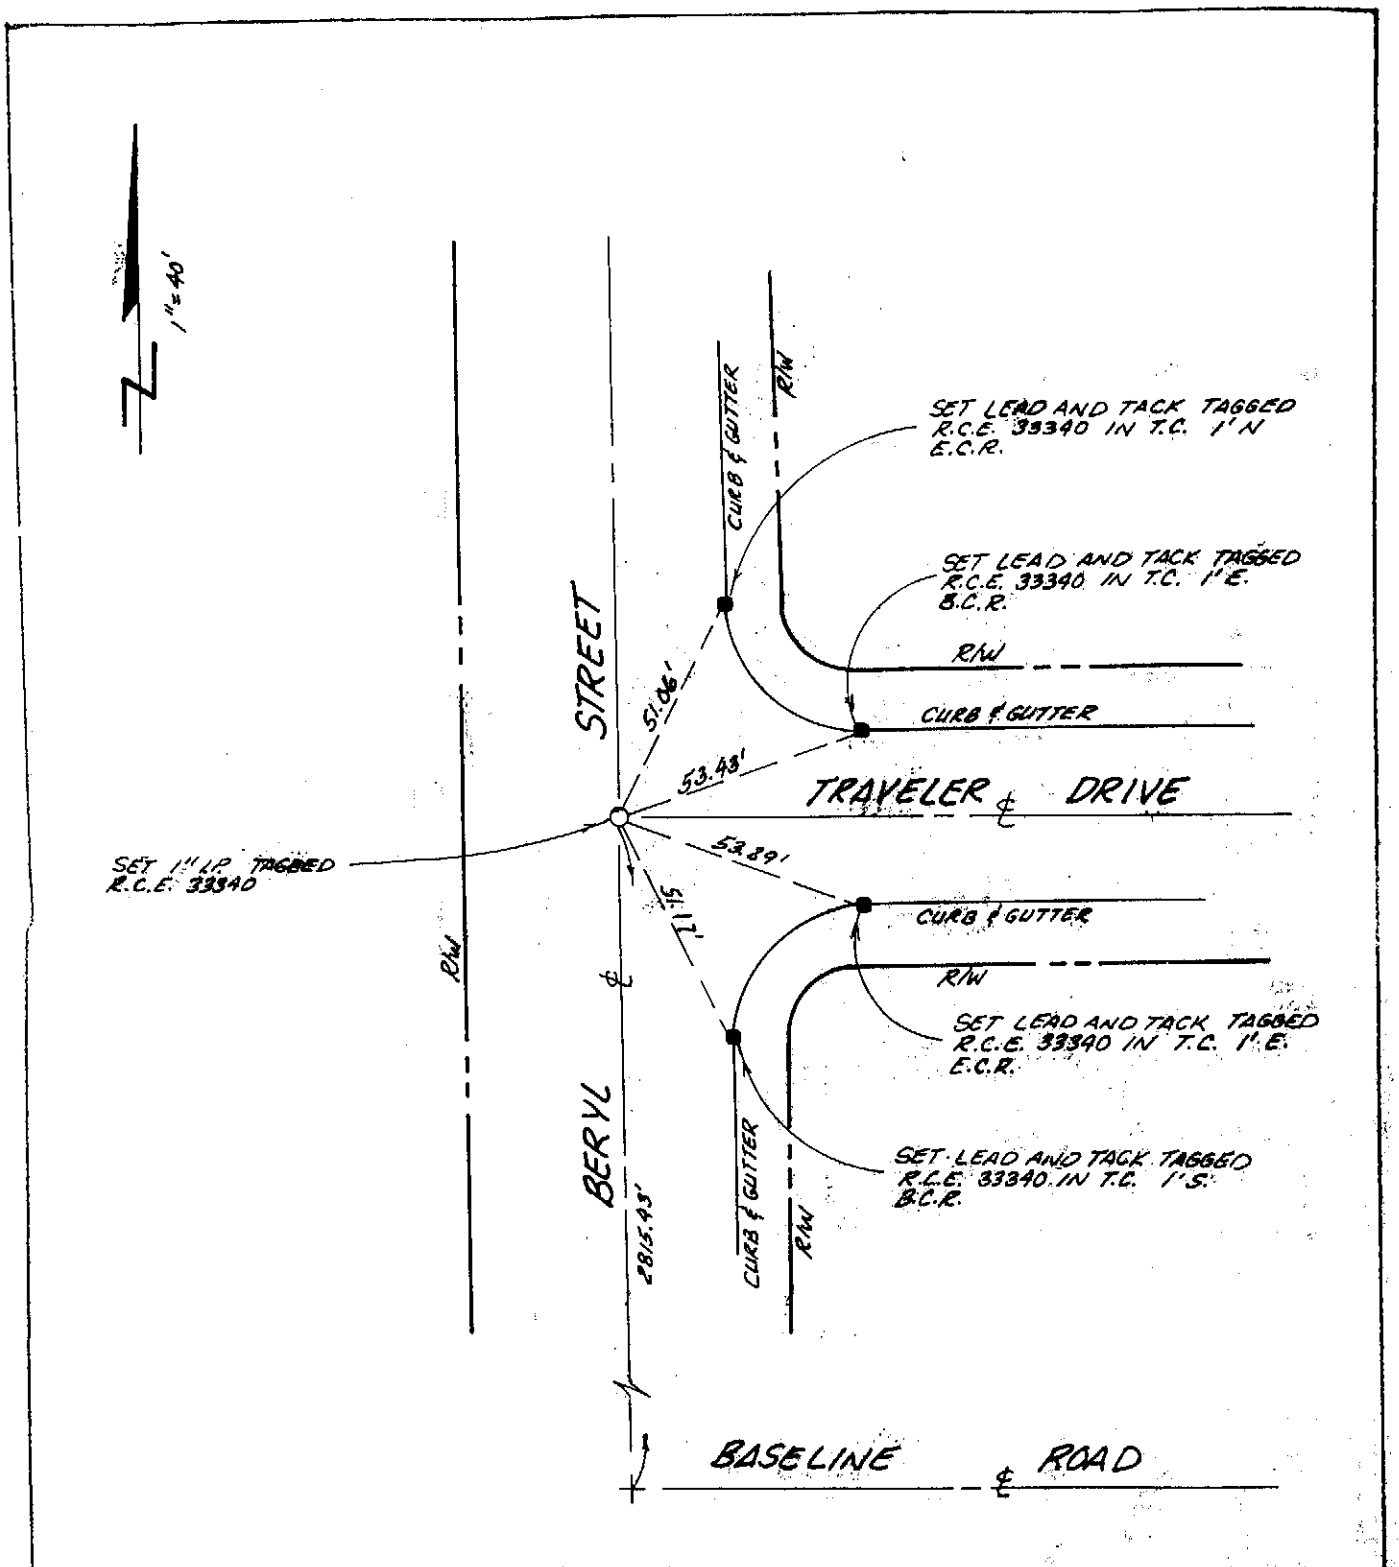

CITY OF RANCHO CUCAMONGA — STREET TIE	TRACT NO. 13642
MIM MACK ENGINEERING 214 SOUTH EUCLID AVE. ONTARIO, CALIF. 91761 (714) 983-0439	INTERSECTION BERYL AVE & TRAVELER DR.
ENGR Jim Mim Mack	FIELD REVIEW _____ DATE _____
RCE # 33340 DATE 1-12-90	TIE BOOK 15 PAGE 1

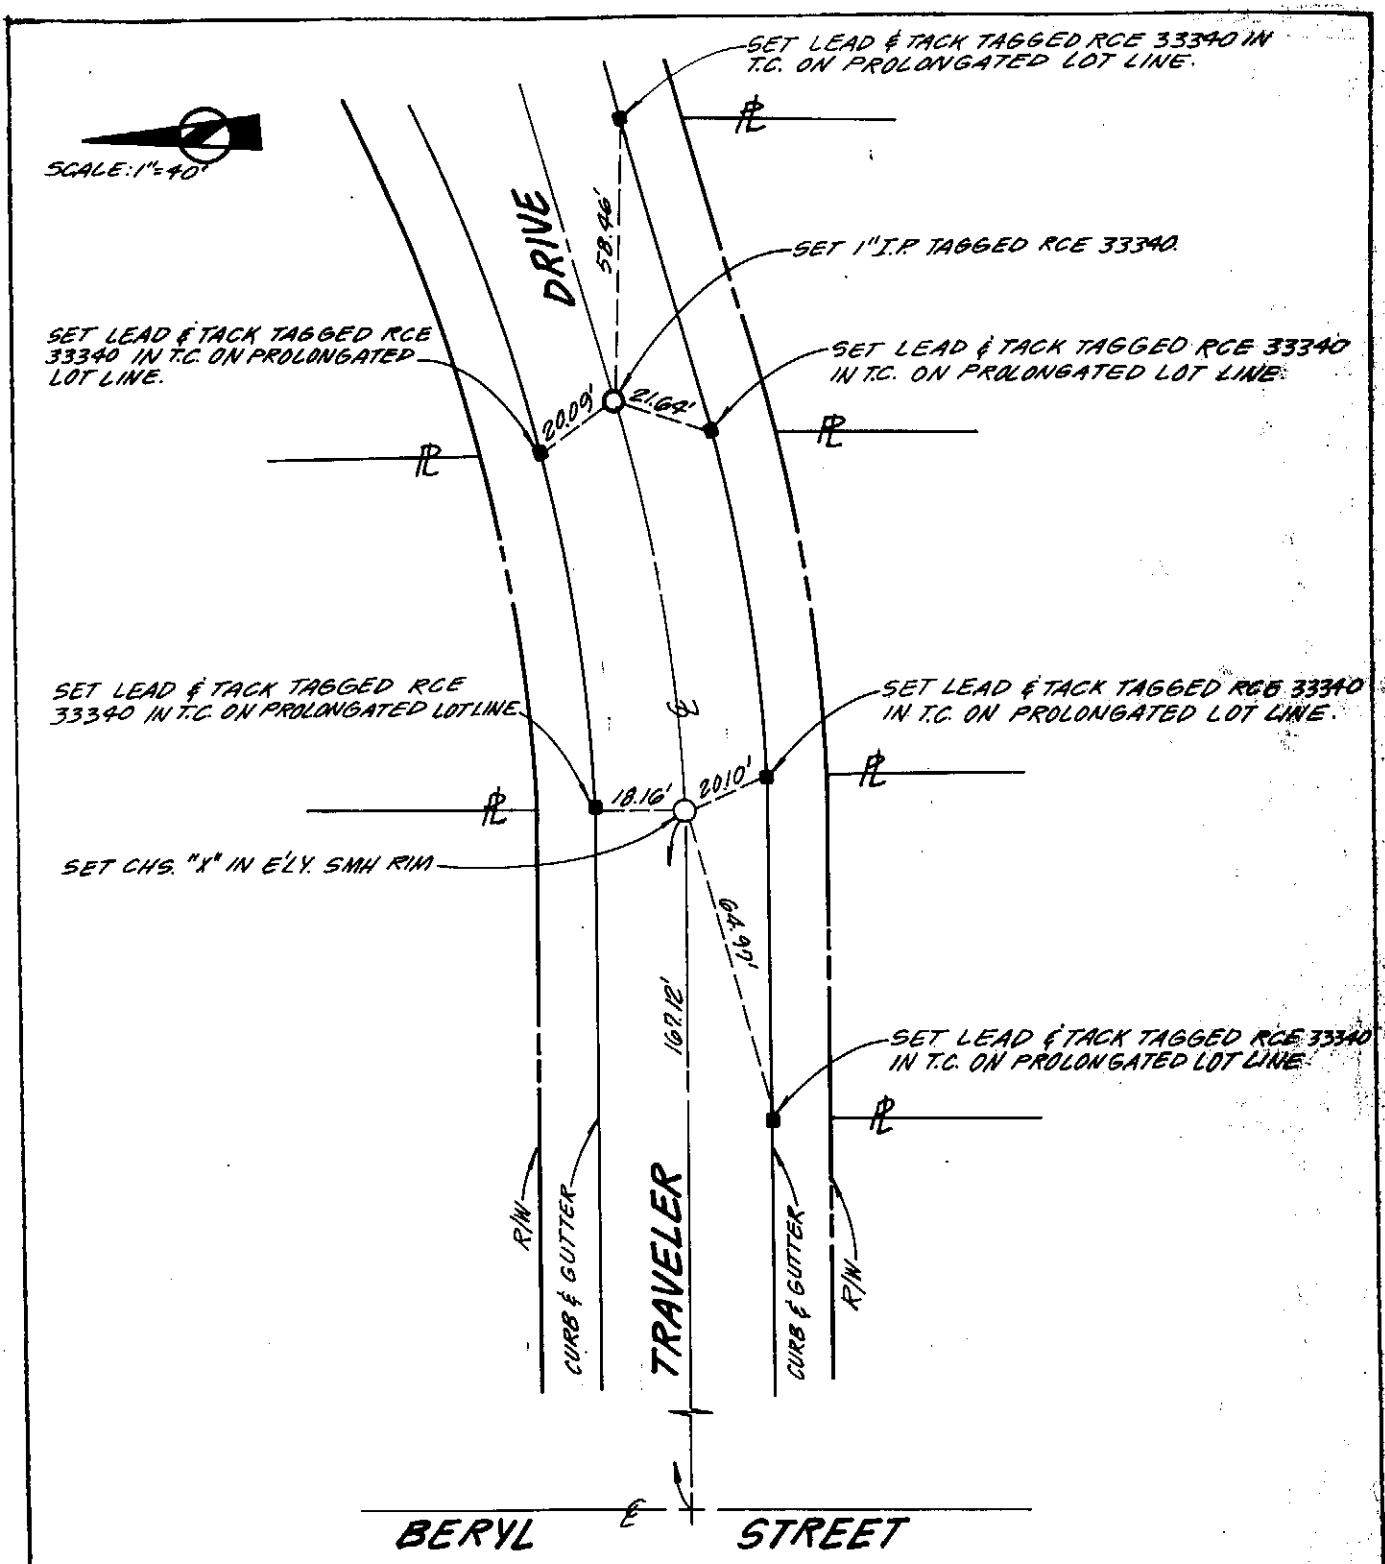

CITY OF RANCHO CUCAMONGA — STREET TIE	TRACT MAP NO. 13642
MIM MACK ENGINEERING 214 SOUTH EUCLID. AVE. ONTARIO, CALIF. 91761 (714) 983-0439	TRAVELER DRIVE
ENGR Jim Mim Mack	FIELD REVIEW _____ DATE _____
RCE # 33340 DATE 1-12-90	TIE BOOK 15 PAGE 2

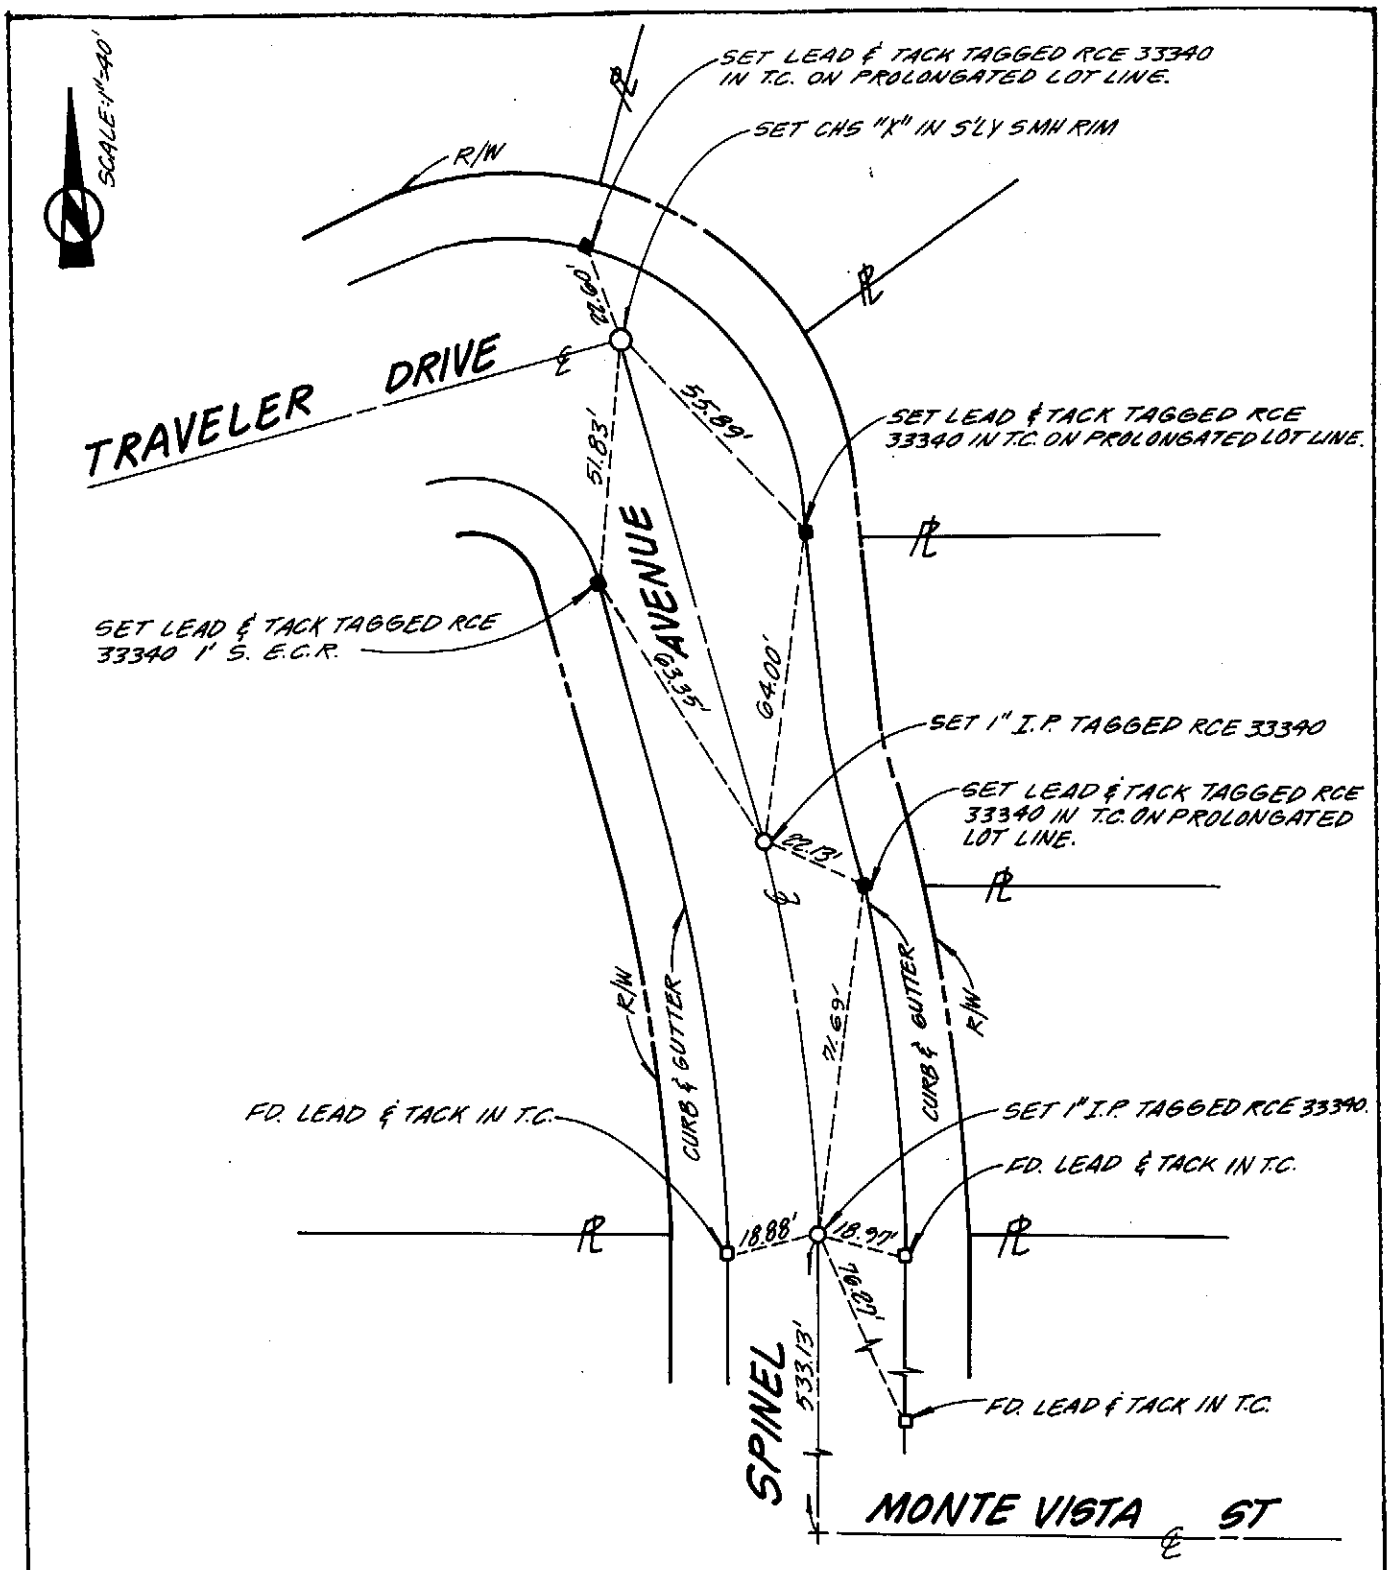

CITY OF RANCHO CUCAMONGA — STREET TIE	TRACT MAP NO. 13642
MIM MACK ENGINEERING 214 SOUTH EUCLID. AVE. ONTARIO, CALIF. 91761 (714) 983-0439	SPINEL AVENUE
ENGR Jim Mac Mack	FIELD REVIEW _____ DATE _____
RCE # 33340 DATE 1-12-90	TIE BOOK 15 PAGE 3

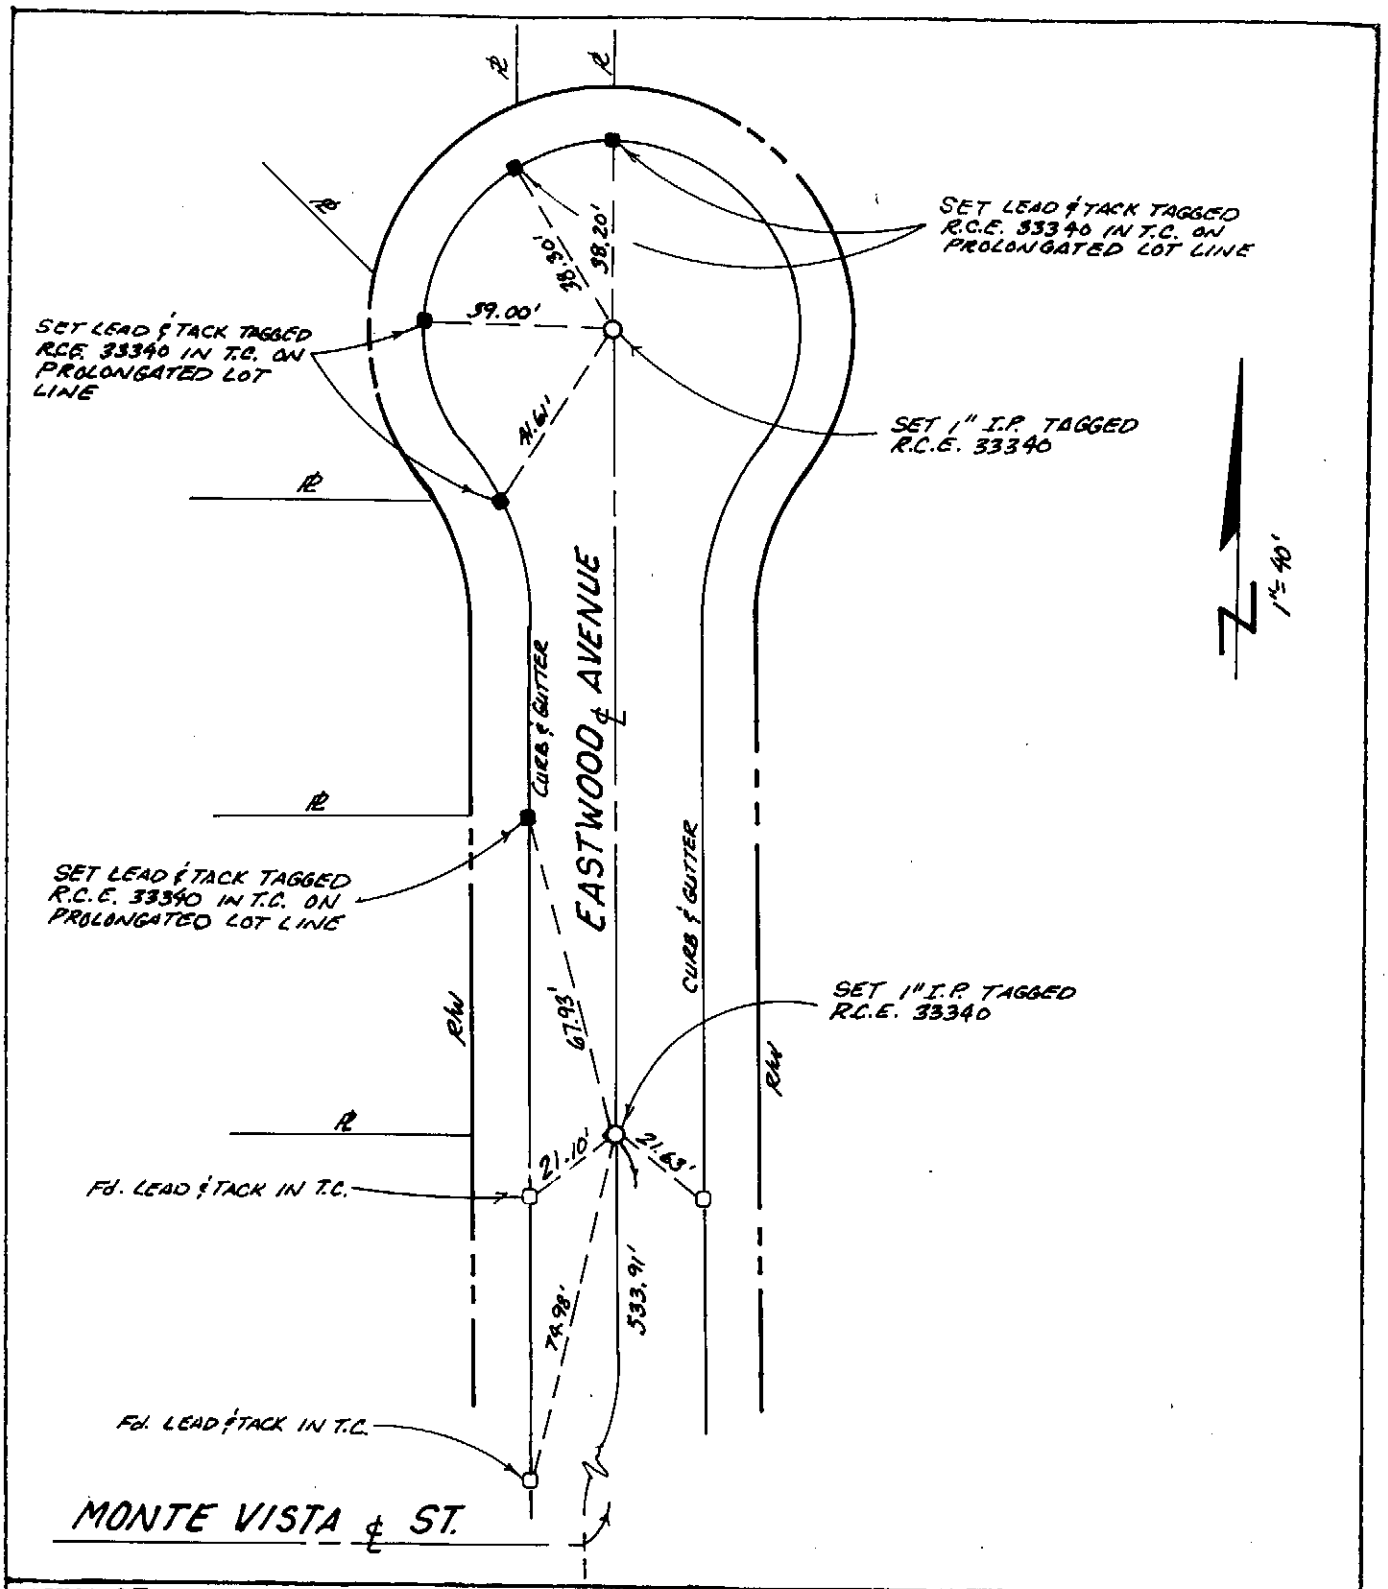

CITY OF RANCHO CUCAMONGA — STREET TIE	TRACT NO. 13642
MIM MACK ENGINEERING 214 SOUTH EUCLID. AVE. ONTARIO, CALIF. 91761 (714) 983-0439	EASTWOOD AVENUE
ENGR Jim Mim Mack	FIELD REVIEW _____ DATE _____
RCE # 33340 DATE 1-12-90	TIE BOOK 15 PAGE 4

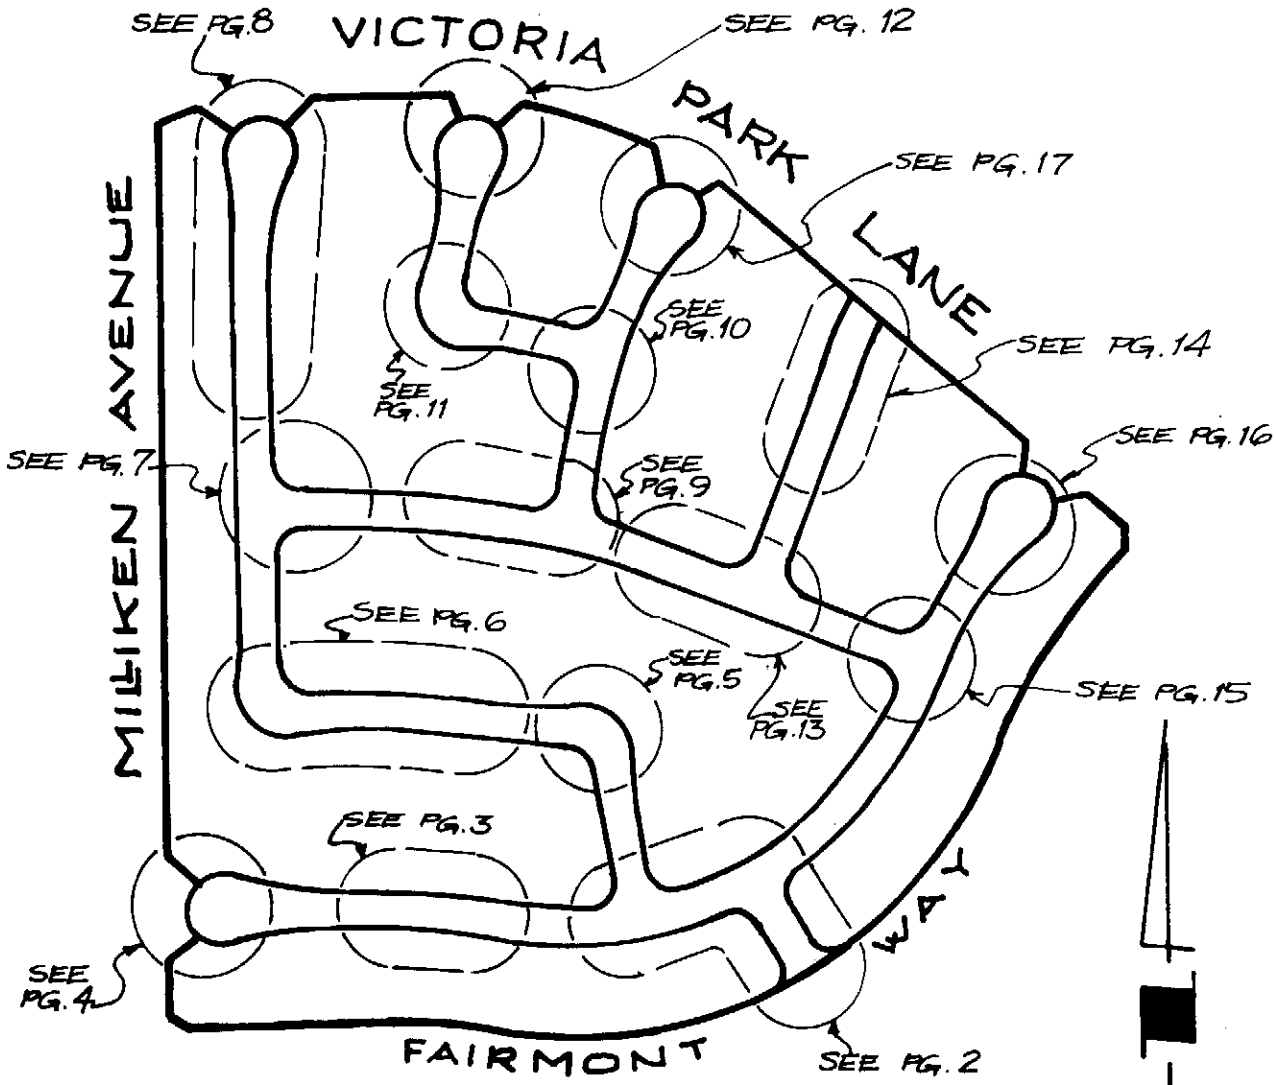

INDEX MAP

CITY OF RANCHO CUCAMONGA — STREET TIES	TRACT OR P.M. NO. 13443
HUNSAKER & ASSOCIATES 732 E.CARNEGIE DR. SAN BERNARDINO, CA 92408 (714) 889-2222	INDEX MAP
ENGR: TOM R.McGANNON	FIELD REVIEW — DATE 11/8/89
R.C.E. No. 23956 EXP.DATE: 12/31/89	TIE BOOK 15 — PAGE 0

RANCHO CUCAMONGA TIE NOTE BASE SHT. - 241[0.11]PF: ONTRIO 1 01-Dec-87 03:45 PM / 146-0-600

NOTE:

ALL TIE POINTS ARE L&T SET IN TOP OF CURB AND TANGENT OVER UNLESS OTHERWISE NOTED.

LEGEND:

○ —— SET SPIKE & WASHER STAMPED RCE 23956

● —— SET PUNCH MARKS ON M.H. RIM

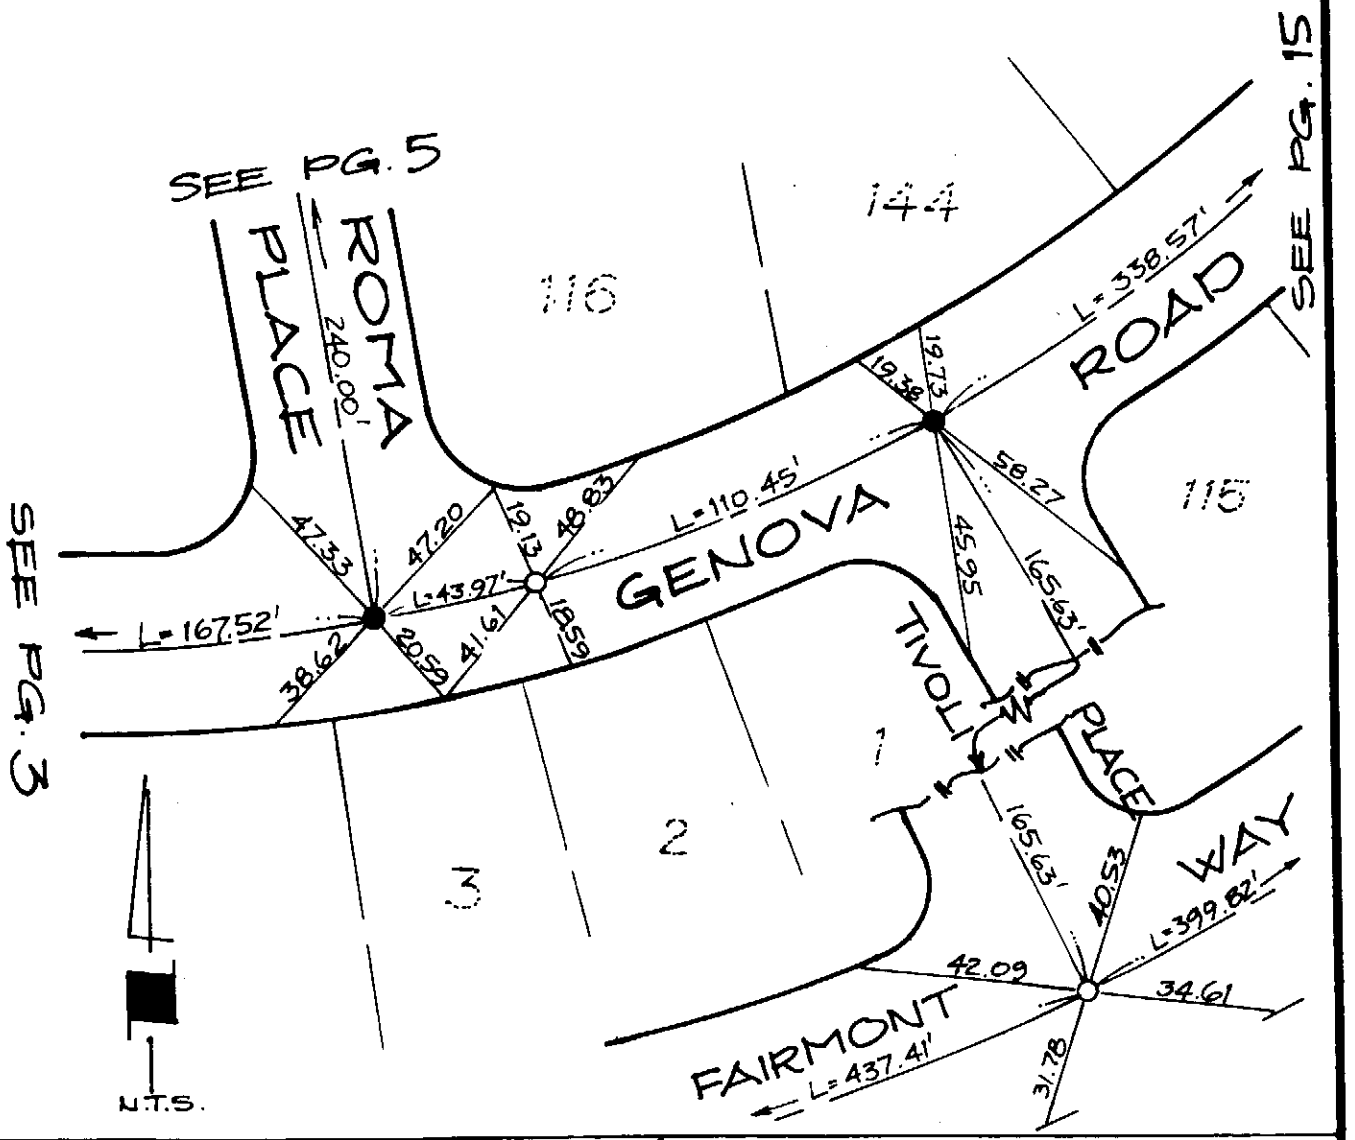

CITY OF RANCHO CUCAMONGA — STREET TIES	TRACT OR P.M. NO. 13443
HUNSAKER & ASSOCIATES 732 E. CARNEGIE DR. SAN BERNARDINO, CA 92408 (714) 889-2222	GENOVA Rd. AT ROMA PL.
ENGR: TOM R. McGANNON	FIELD REVIEW — DATE 11/8/89
R.C.E. No. 23956 EXP. DATE: 12/31/89	TIE BOOK 15 — PAGE 5

RANCHO CUCAMONGA TIE NOTE BASE SHT. - 241[0.11]PF: ONTRIO 1 01-Dec-87 03:45 PM / 146-0-600

NOTE:

ALL TIE POINTS ARE L&T SET IN TOP OF CURB AND TANGENT OVER UNLESS OTHERWISE NOTED.

LEGEND:

O —— SET SPIKE & WASHER STAMPED R.C.E. 23956

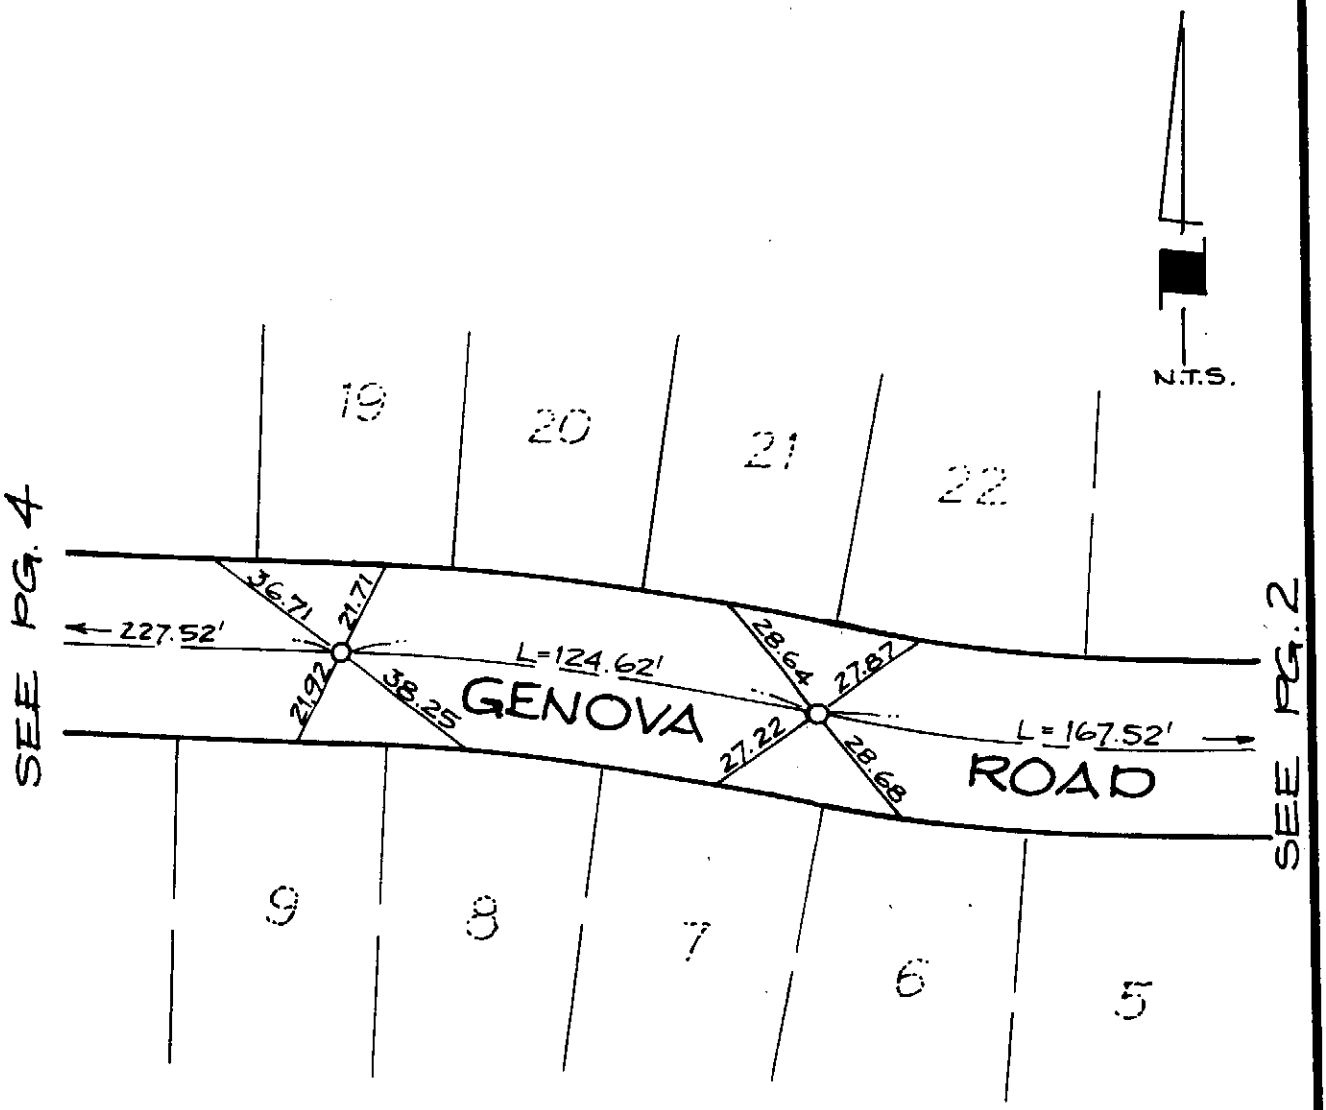

CITY OF RANCHO CUCAMONGA — STREET TIES	TRACT OR P.M. NO. 13443
HUNSAKER & ASSOCIATES 732 E. CARNEGIE DR. SAN BERNARDINO, CA 92408 (714) 889-2222	GENOVA Rd. W/O ROMA PL.
ENGR: TOM R. McGANNON	FIELD REVIEW — DATE 11/8/89
R.C.E. No. 23956 EXP. DATE: 12/31/89	TIE BOOK 5 — PAGE 6

RANCHO CUCAMONGA TIE NOTE BASE SHT. - 241[0.11]PF: ONTRIO 1 01-Dec-87 03:45 PM / 146-0-600

(3 OF 17)

NOTE:

ALL TIE POINTS ARE L&T SET IN TOP OF CURB AND TANGENT OVER UNLESS OTHERWISE NOTED.

LEGEND:

O —— SET SPIKE & WASHER STAMPED R.C.E. 23956

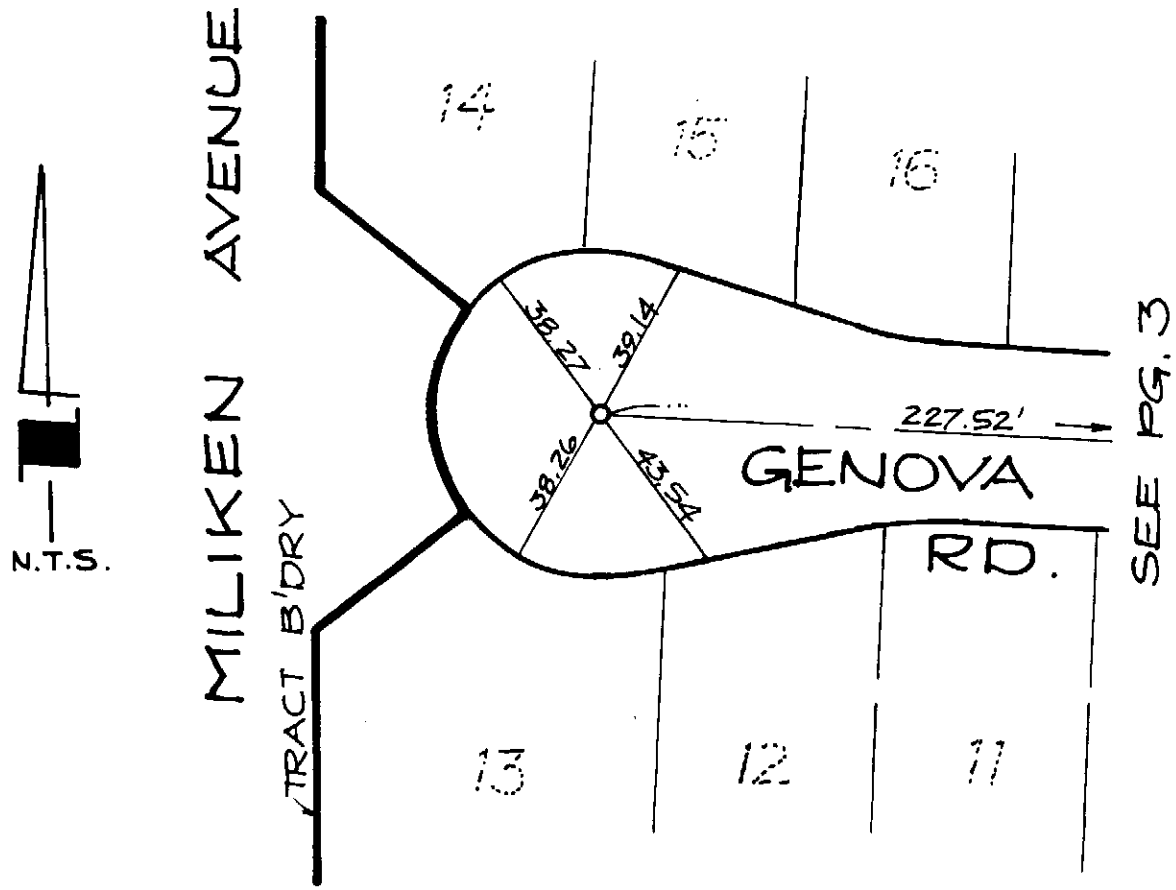

CITY OF RANCHO CUCAMONGA — STREET TIES	TRACT OR P.M. NO. 13443
HUNSAKER & ASSOCIATES 732 E. CARNEGIE DR. SAN BERNARDINO, CA 92408 (714) 889-2222	GENOVA ROAd WESTERLY CUL-DE-SAC
ENGR: TOM R. McGANNON	FIELD REVIEW — DATE 11/8/89
R.C.E. No. 23956 — EXP. DATE: 12/31/89	TIE BOOK 15 — PAGE 7

RANCHO CUCAMONGA TIE NOTE BASE SHT. - 241[0.11]PF: ONTRIO 1 01-Dec-87 03:45 PM / 146-0-600

NOTE:

ALL TIE POINTS ARE L&T SET IN TOP OF CURB AND TANGENT OVER UNLESS OTHERWISE NOTED.

LEGEND:

O —— SET SPIKE & WASHER STAMPED R.C.E. 23956

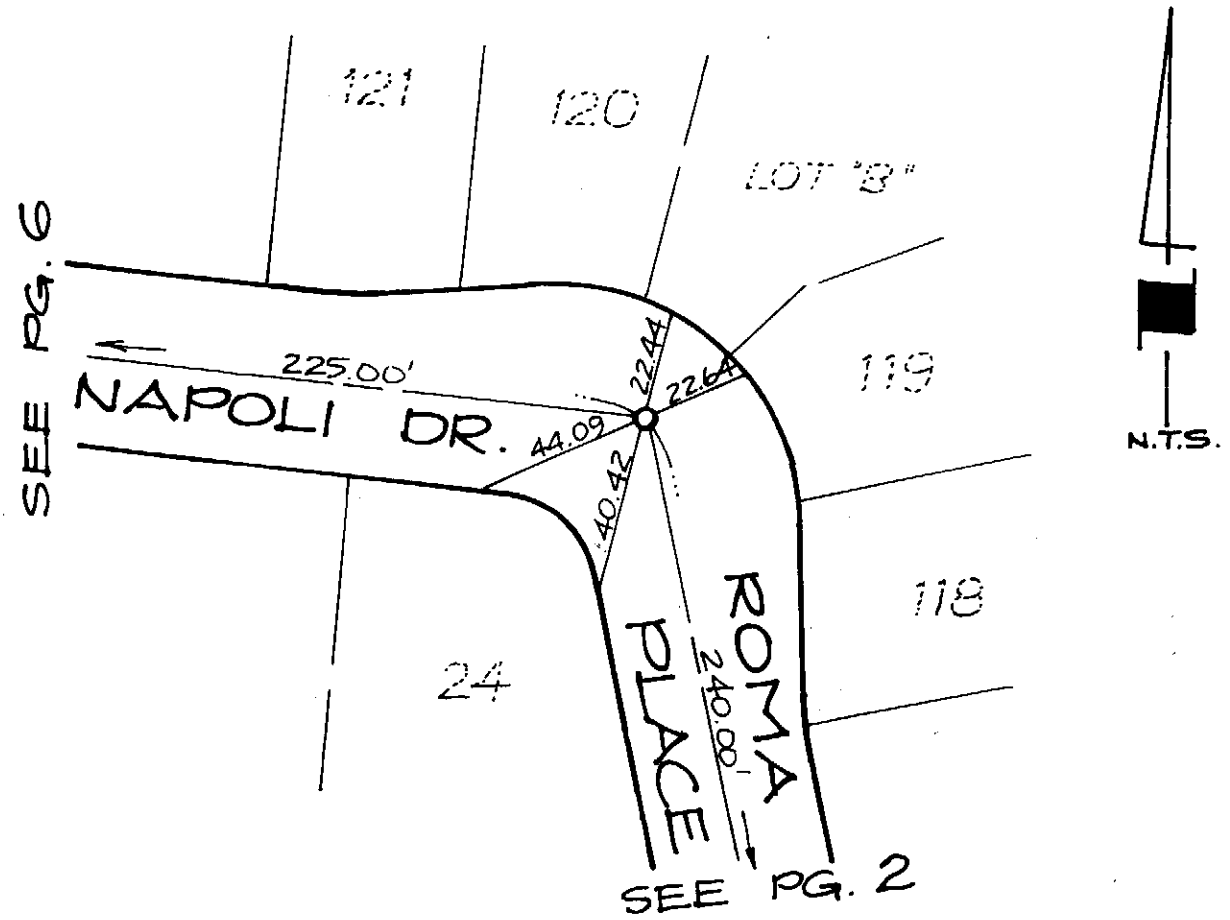

CITY OF RANCHO CUCAMONGA — STREET TIES	TRACT OR P.M. NO. 13443
HUNSAKER & ASSOCIATES 732 E. CARNEGIE DR. SAN BERNARDINO, CA 92408 (714) 889-2222	NAPOLI DRIVE AT ROMA PLACE
ENGR: TOM R. McGANNON	FIELD REVIEW — DATE 11/8/89
R.C.E. No. 23956 EXP. DATE: 12/31/89	TIE BOOK 15 — PAGE 8

RANCHO CUCAMONGA TIE NOTE BASE SHT. - 241[0.11]PF: ONTRIO 1 01-Dec-87 03:45 PM / 146-0-600

NOTE:

ALL TIE POINTS ARE L&T SET IN TOP OF CURB AND TANGENT OVER UNLESS OTHERWISE NOTED.

LEGEND:

○ —— SET SPIKE & WASHER STAMPED RCE. 23956

● —— SET PUNCH MARKS ON M.H. RIM

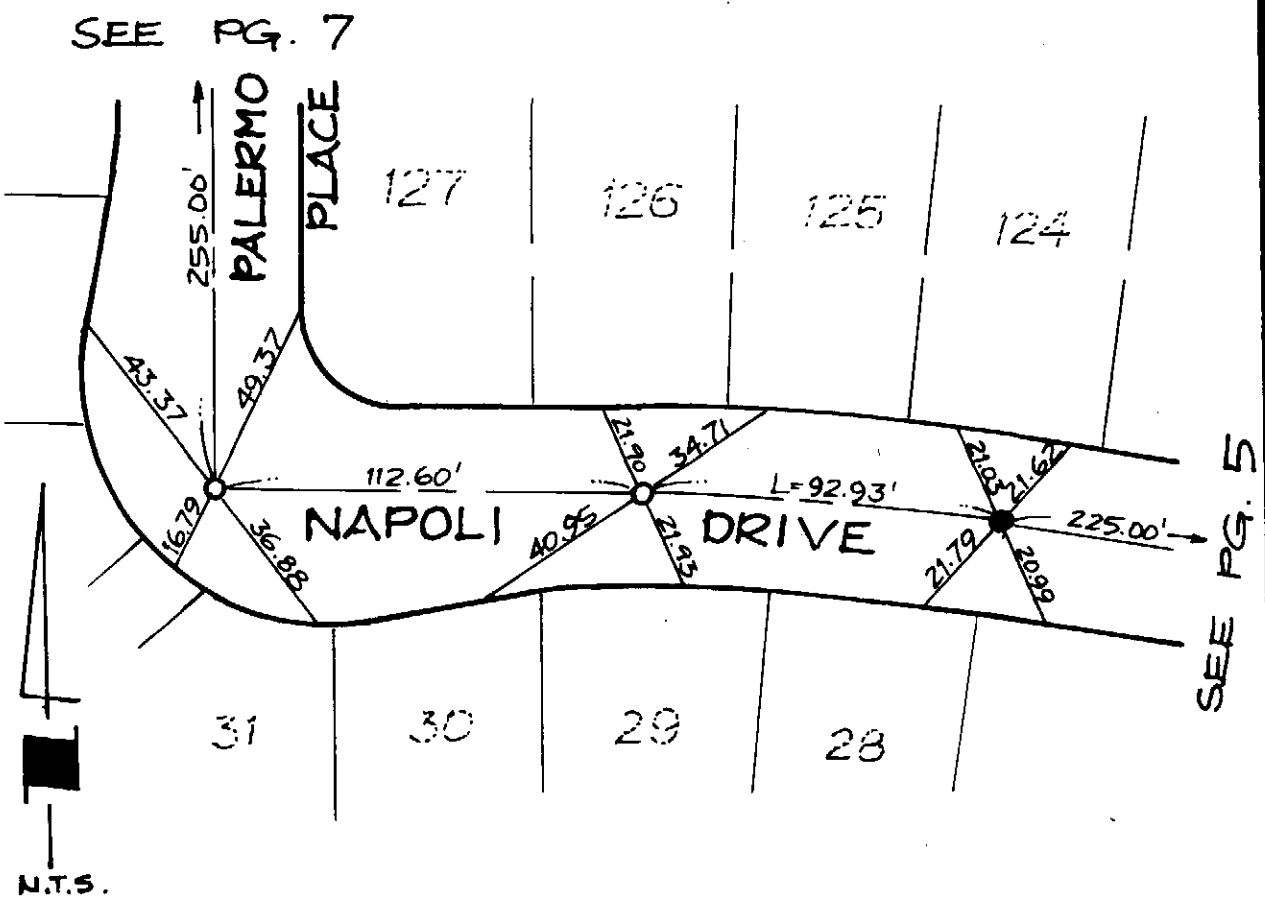

CITY OF RANCHO CUCAMONGA — STREET TIES	TRACT OR P.M. NO. 13443
HUNSAKER & ASSOCIATES 732 E. CARNEGIE DR. SAN BERNARDINO, CA 92408 (714) 889-2222	NAPOLI DRIVE AT PALERMO PLACE
ENGR: TOM R. McGANNON	FIELD REVIEW — DATE 11/8/89
R.C.E. No. 23956 EXP. DATE: 12/31/89	TIE BOOK 15 — PAGE 9

RANCHO CUCAMONGA TIE NOTE BASE SHT. - 241[0.11]PF: ONTRIO 1 01-Dec-87 03:45 PM / 146-0-600

NOTE:

ALL TIE POINTS ARE L&T SET IN TOP OF CURB AND TANGENT OVER UNLESS OTHERWISE NOTED.

LEGEND:

O —— SET SPIKE & WASHER STAMPED R.C.E. 23956

● —— SET PUNCH MARKS ON M.H. RIM

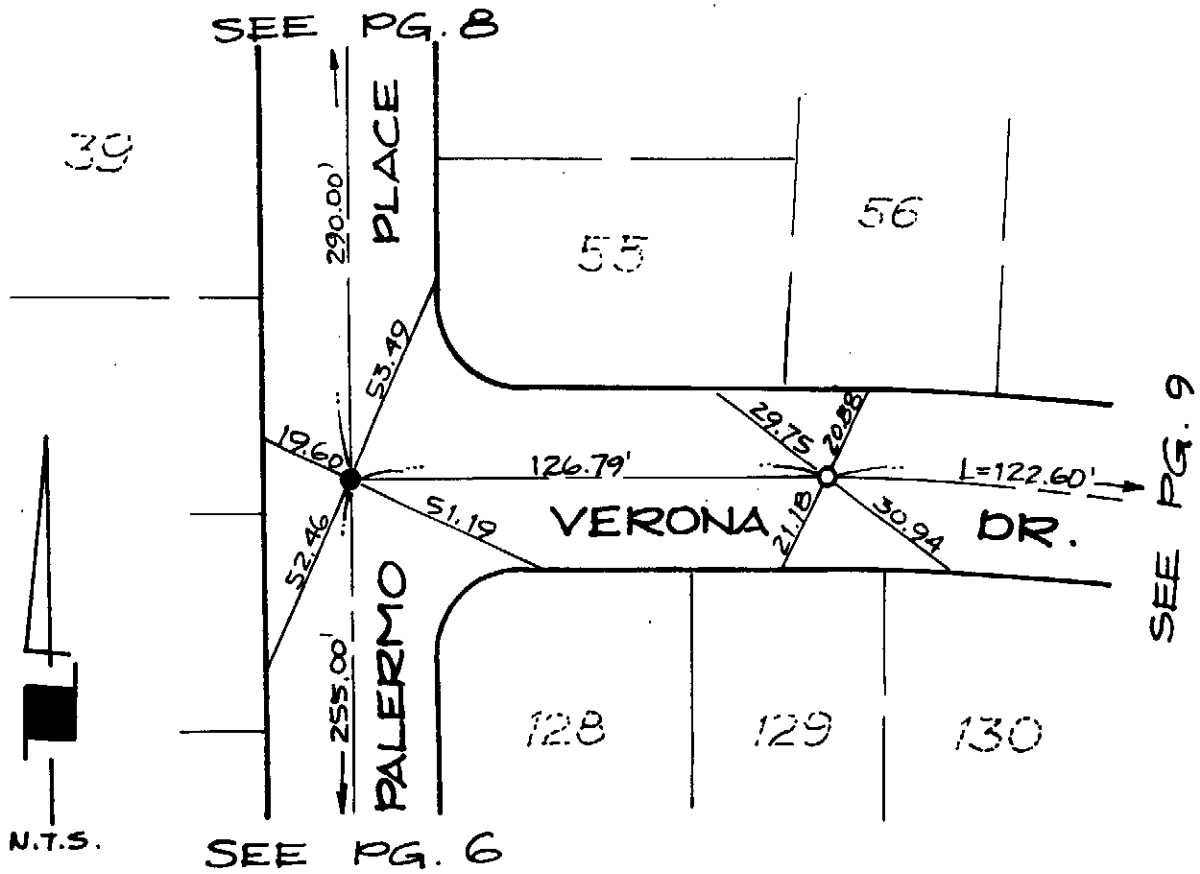

CITY OF RANCHO CUCAMONGA — STREET TIES	TRACT OR P.M. NO. 13443
HUNSAKER & ASSOCIATES 732 E. CARNEGIE DR. SAN BERNARDINO, CA 92408 (714) 889-2222	PALERMO PLACE AT VERONA DRIVE
ENGR: TOM R. McGANNON	FIELD REVIEW — DATE 11/8/89
R.C.E. No. 23956 EXP. DATE: 12/31/89	TIE BOOK 15 — PAGE 10

RANCHO CUCAMONGA TIE NOTE BASE SHT. - 241[0.11]PF: ONTRIO 1 01-Dec-87 03:45 PM / 146-0-600

(7 OF 17)

NOTE:

ALL TIE POINTS ARE L&T SET IN TOP OF CURB AND TANGENT OVER UNLESS OTHERWISE NOTED.

LEGEND:

O —— SET SPIKE & WASHER STAMPED

● —— SET PUNCH MARKS ON M.H. RIM

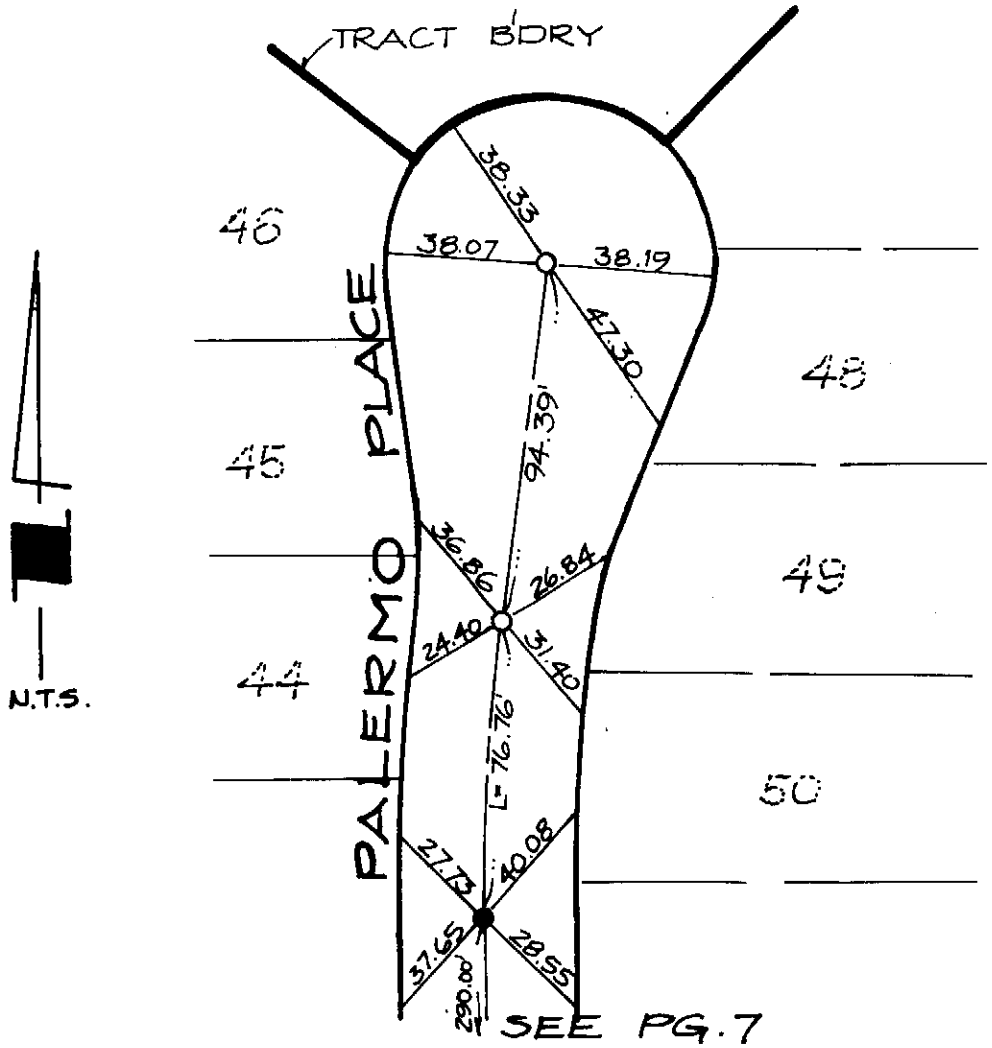

CITY OF RANCHO CUCAMONGA — STREET TIES	TRACT OR P.M. NO. 13443
HUNSAKER & ASSOCIATES 732 E. CARNEGIE DR. SAN BERNARDINO, CA 92408 (714) 889-2222	PALERMO PLACE CUI-de-SAC
ENGR: TOM R. McGANNON	FIELD REVIEW — DATE 11/8/89
R.C.E. No. 23956 EXP. DATE: 12/31/89	TIE BOOK 15 — PAGE 7

RANCHO CUCAMONGA TIE NOTE BASE SHT. - 241[0.11]PF: ONTRIO 1 01-Dec-87 03:45 PM / 146-0-600

NOTE:

ALL TIE POINTS ARE L&T SET IN TOP OF CURB AND TANGENT OVER UNLESS OTHERWISE NOTED.

LEGEND:

O —— SET SPIKE & WASHER STAMPED RCE. 239

● —— SET PUNCH MARKS ON M.H. RIM

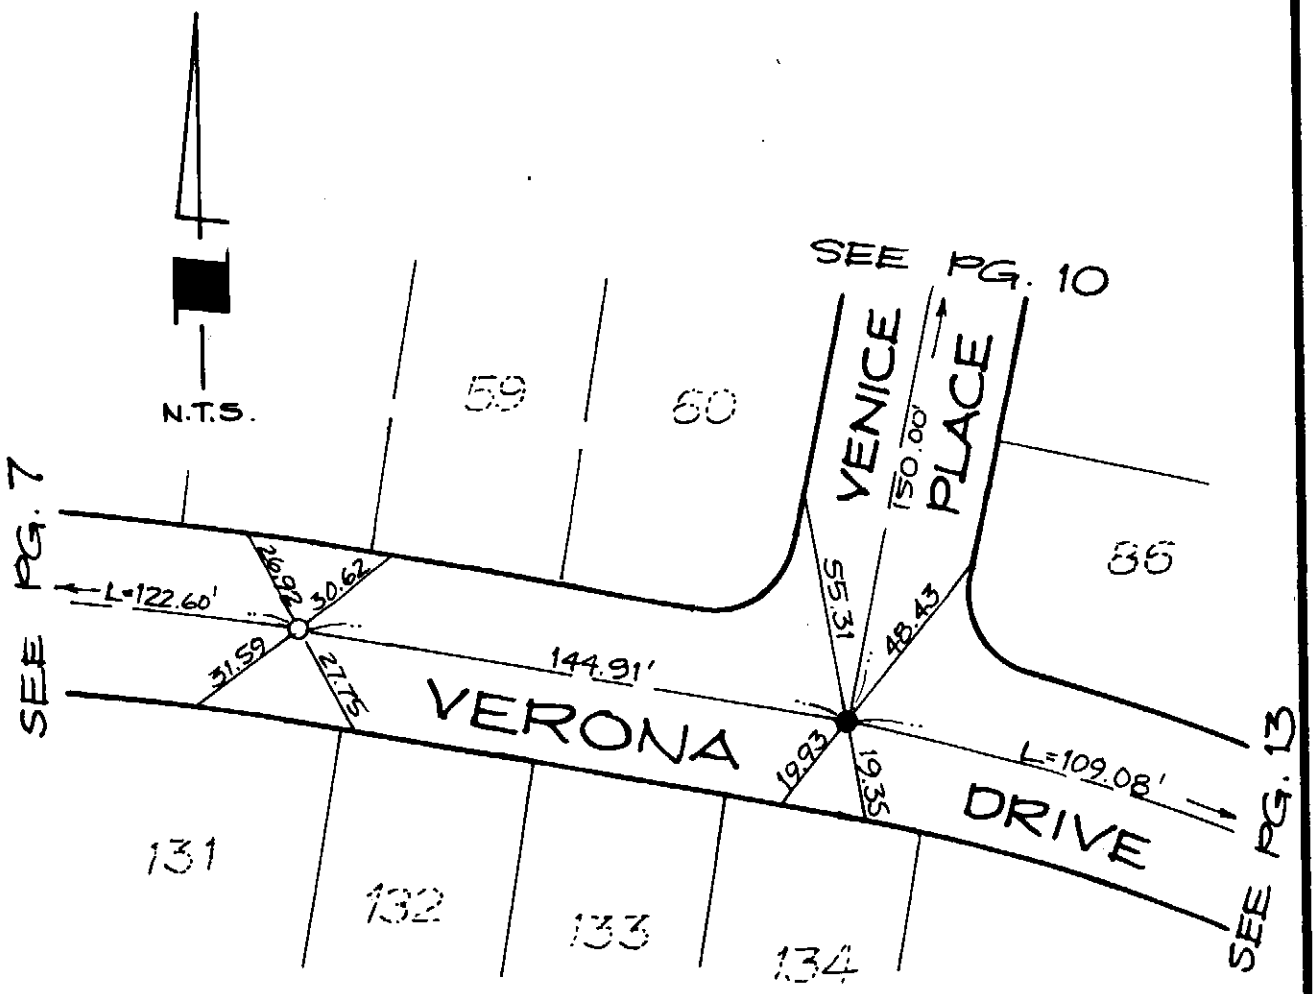

CITY OF RANCHO CUCAMONGA — STREET TIES	TRACT OR P.M. NO. 13443
HUNSAKER & ASSOCIATES 732 E. CARNEGIE DR. SAN BERNARDINO, CA 92408 (714) 889-2222	VERONA DRIVE AT VENICE PLACE
ENGR: TOM R. McGANNON	FIELD REVIEW — DATE 11/8/89
R.C.E. No. 23956 EXP. DATE: 12/31/89	TIE BOOK 15 — PAGE 12

NOTE:

ALL TIE POINTS ARE L&T SET IN TOP OF CURB AND TANGENT OVER UNLESS OTHERWISE NOTED.

LEGEND:

○ —— SET SPIKE & WASHER STAMPED R.C.E. 23956

● —— SET PUNCH MARKS ON M.H. RIM

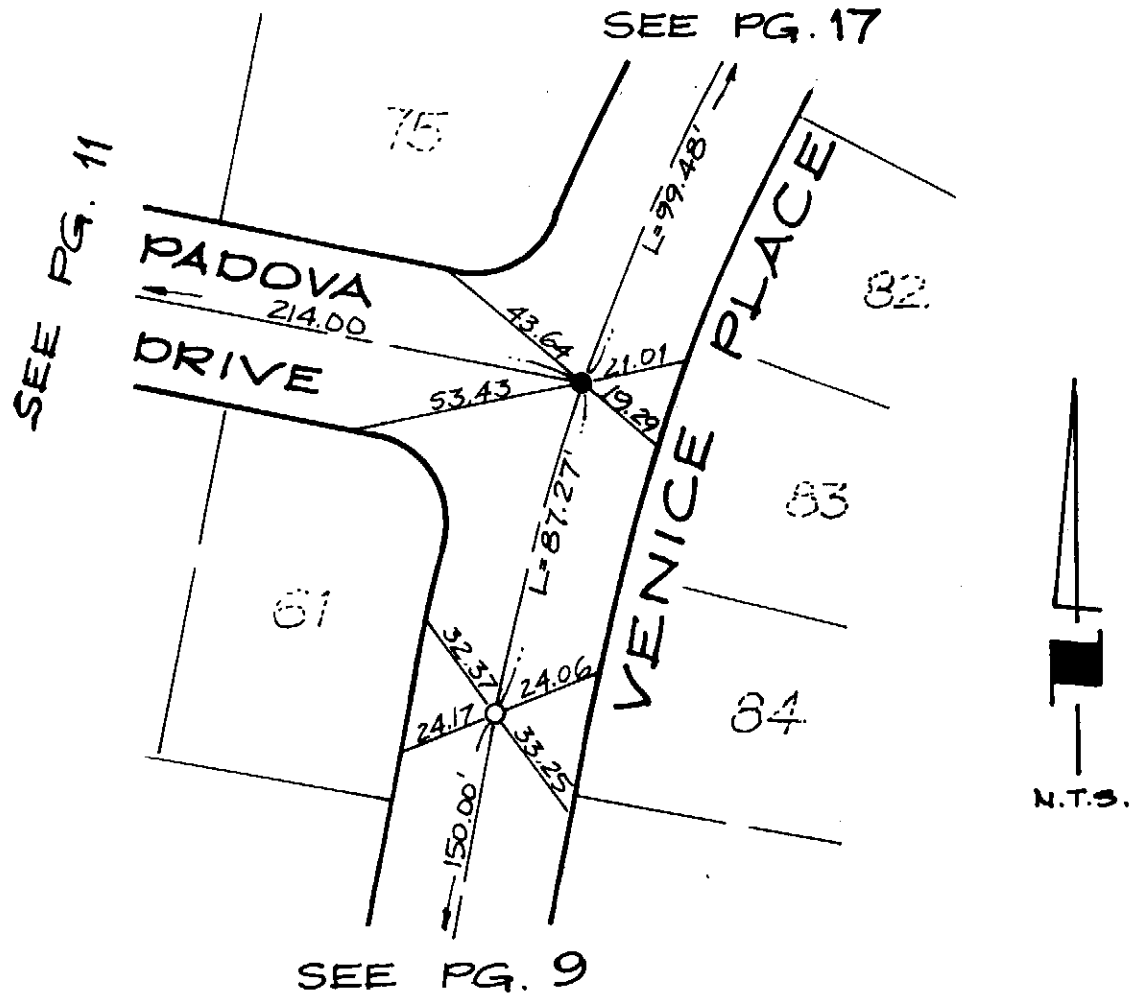

CITY OF RANCHO CUCAMONGA — STREET TIES	TRACT OR P.M. NO. 13443
HUNSAKER & ASSOCIATES 732 E. CARNEGIE DR. SAN BERNARDINO, CA 92408 (714) 889-2222	PADOVA DRIVE AT VENICE PLACE
ENGR: TOM R. McGANNON	FIELD REVIEW — DATE 11/8/89
R.C.E. No. 23956 EXP. DATE: 12/31/89	TIE BOOK 15 — PAGE 13

RANCHO CUCAMONGA TIE NOTE BASE SHT. - 241[0.,1]PF: ONTRIO 1 01-Dec-87 03:45 PM / 146-0-600

(10 OF 17)

NOTE:

ALL TIE POINTS ARE L&T SET IN TOP OF CURB AND TANGENT OVER UNLESS OTHERWISE NOTED.

LEGEND:

O —— SET SPIKE & WASHER STAMPED R.C.E. 23956

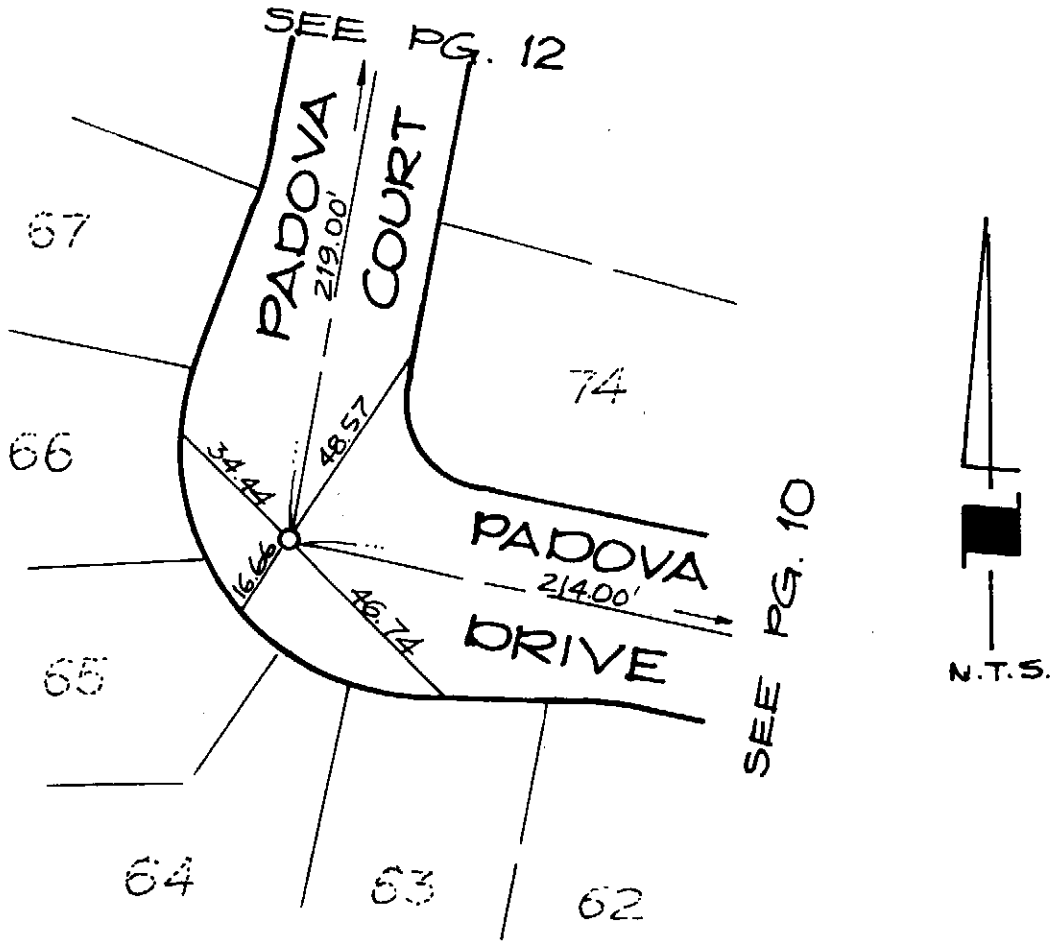

CITY OF RANCHO CUCAMONGA — STREET TIES	TRACT OR P.M. NO. 13443
HUNSAKER & ASSOCIATES 732 E. CARNEGIE DR. SAN BERNARDINO, CA 92408 (714) 889-2222	PADOVA DRIVE AT PADOVA COURT
ENGR: TOM R. McGANNON	FIELD REVIEW — DATE 11/8/89
R.C.E. No. 23956 EXP. DATE: 12/31/89	TIE BOOK 15 — PAGE 14

RANCHO CUCAMONGA TIE NOTE BASE SHT. - 241[0.11]PF: ONTRIO 1 01-Dec-87 03:45 PM / 146-0-600

NOTE:

ALL TIE POINTS ARE L&T SET IN TOP OF CURB AND TANGENT OVER UNLESS OTHERWISE NOTED.

LEGEND:

O —— SET SPIKE & WASHER STAMPED R.C.E. 23956

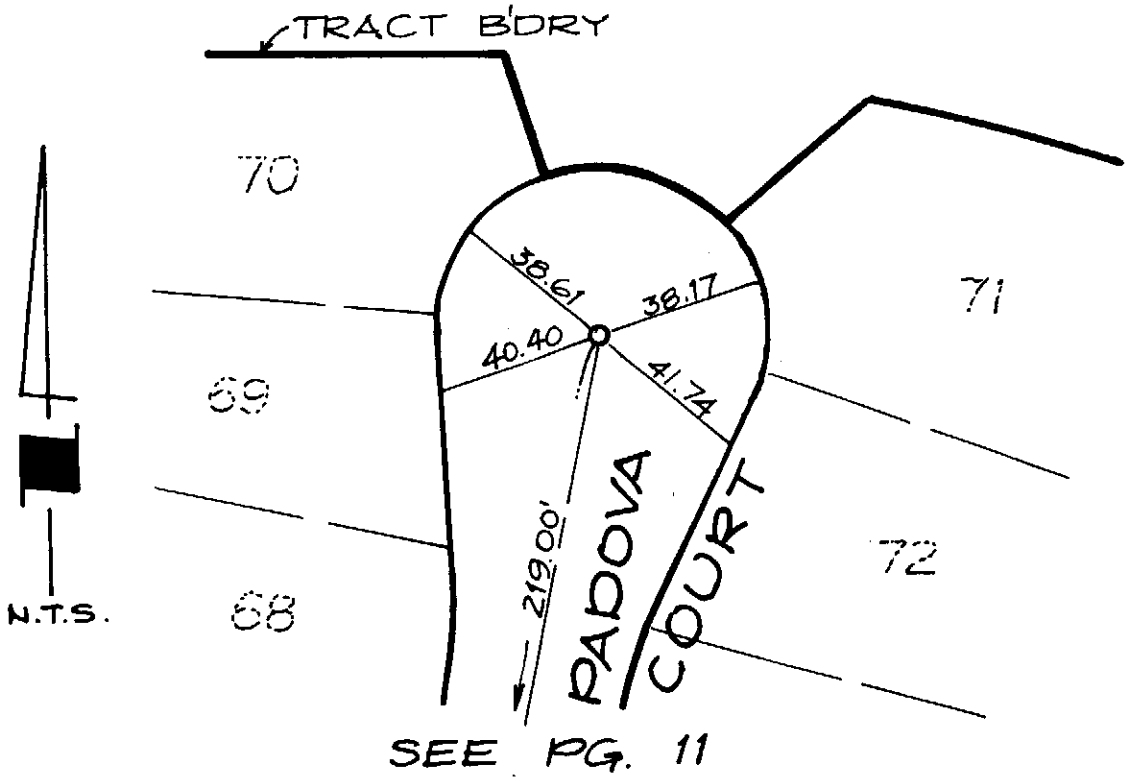

SEE PG. 11

CITY OF RANCHO CUCAMONGA — STREET TIES	TRACT OR P.M. NO. 13443
HUNSAKER & ASSOCIATES 732 E. CARNEGIE DR. SAN BERNARDINO, CA 92408 (714) 889-2222	PADOVA COURT CUL-DE-SAC
ENGR: TOM R. McGANNON	FIELD REVIEW — DATE 11/8/89
R.C.E. No. 23956 EXP. DATE: 12/31/89	TIE BOOK 15 — PAGE 15

NOTE:

ALL TIE POINTS ARE L&T SET IN TOP OF CURB AND TANGENT OVER UNLESS OTHERWISE NOTED.

LEGEND:

O —— SET SPIKE & WASHER STAMPED R.C.E. 23956

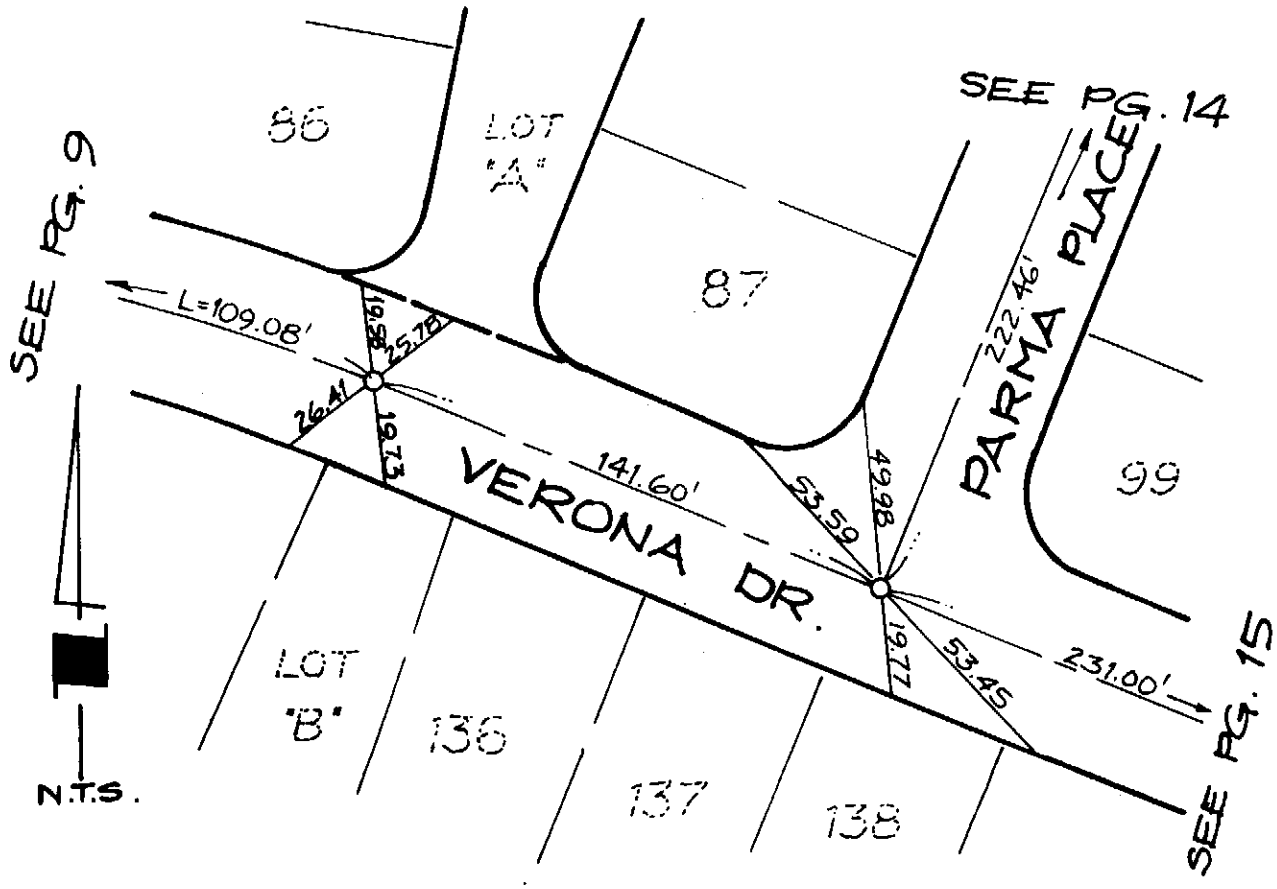

CITY OF RANCHO CUCAMONGA — STREET TIES	TRACT OR P.M. NO. 13443
HUNSAKER & ASSOCIATES 732 E.CARNEGIE DR. SAN BERNARDINO, CA 92408 (714) 889-2222	VERONA DRIVE AT PARMA PL.
ENGR: TOM R. McGANNON	FIELD REVIEW — DATE 11/8/89
R.C.E. No. 23956 EXP.DATE: 12/31/89	TIE BOOK 15 — PAGE 16

RANCHO CUCAMONGA TIE NOTE BASE SHT. - 241[0.113PF: ONTRIO 1 01-Dec-87 03:45 PM / 146-0-600

(13 OF 17)

NOTE:

ALL TIE POINTS ARE L&T SET IN TOP OF CURB AND TANGENT OVER UNLESS OTHERWISE NOTED.

LEGEND:

O —— SET SPIKE & WASHER STAMPED R.C.E. 23956

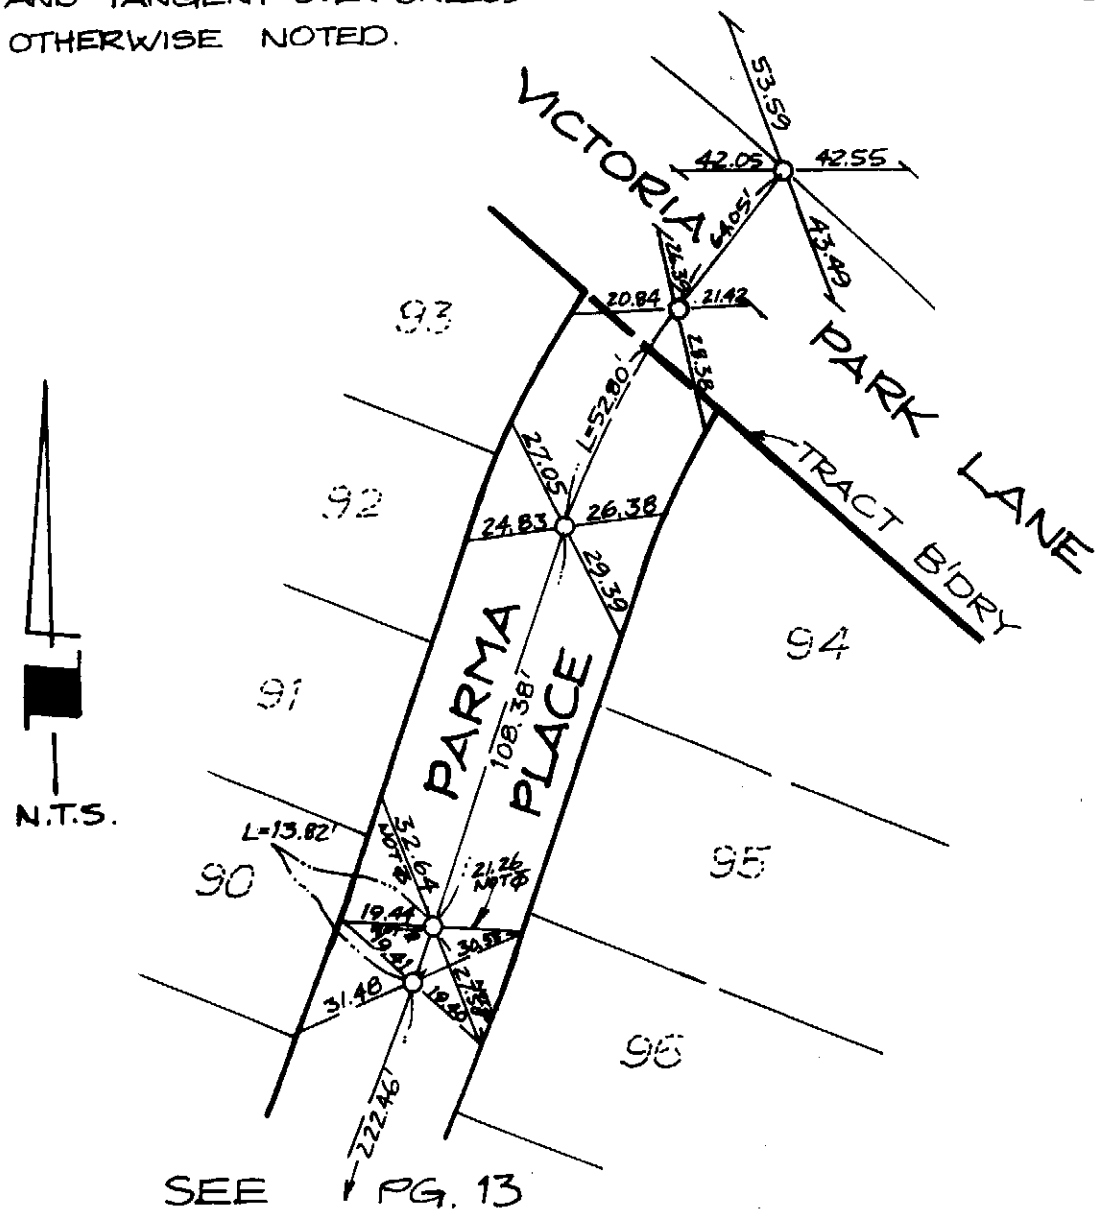

SEE PG. 13

CITY OF RANCHO CUCAMONGA — STREET TIES	TRACT OR P.M. NO. 13443
HUNSAKER & ASSOCIATES 732 E. CARNEGIE DR. SAN BERNARDINO, CA 92408 (714) 889-2222	PARMA PLACE AT VICTORIA PARK LANE
ENGR. TOM R. McGANNON	FIELD REVIEW — DATE 11/8/89
R.C.E. No. 23956 EXP. DATE: 12/31/89	TIE BOOK 15 — PAGE 17

RANCHO CUCAMONGA TIE NOTE BASE SHT. - 241[0.1]PF: ONTRIO 1 01-Dec-87 03:45 PM / 146-0-600

(14 OF 17)

NOTE:

ALL TIE POINTS ARE L&T SET IN TOP OF CURB AND TANGENT OVER UNLESS OTHERWISE NOTED.

LEGEND:

O —— SET SPIKE & WASHER STAMPED R.C.E. 23956

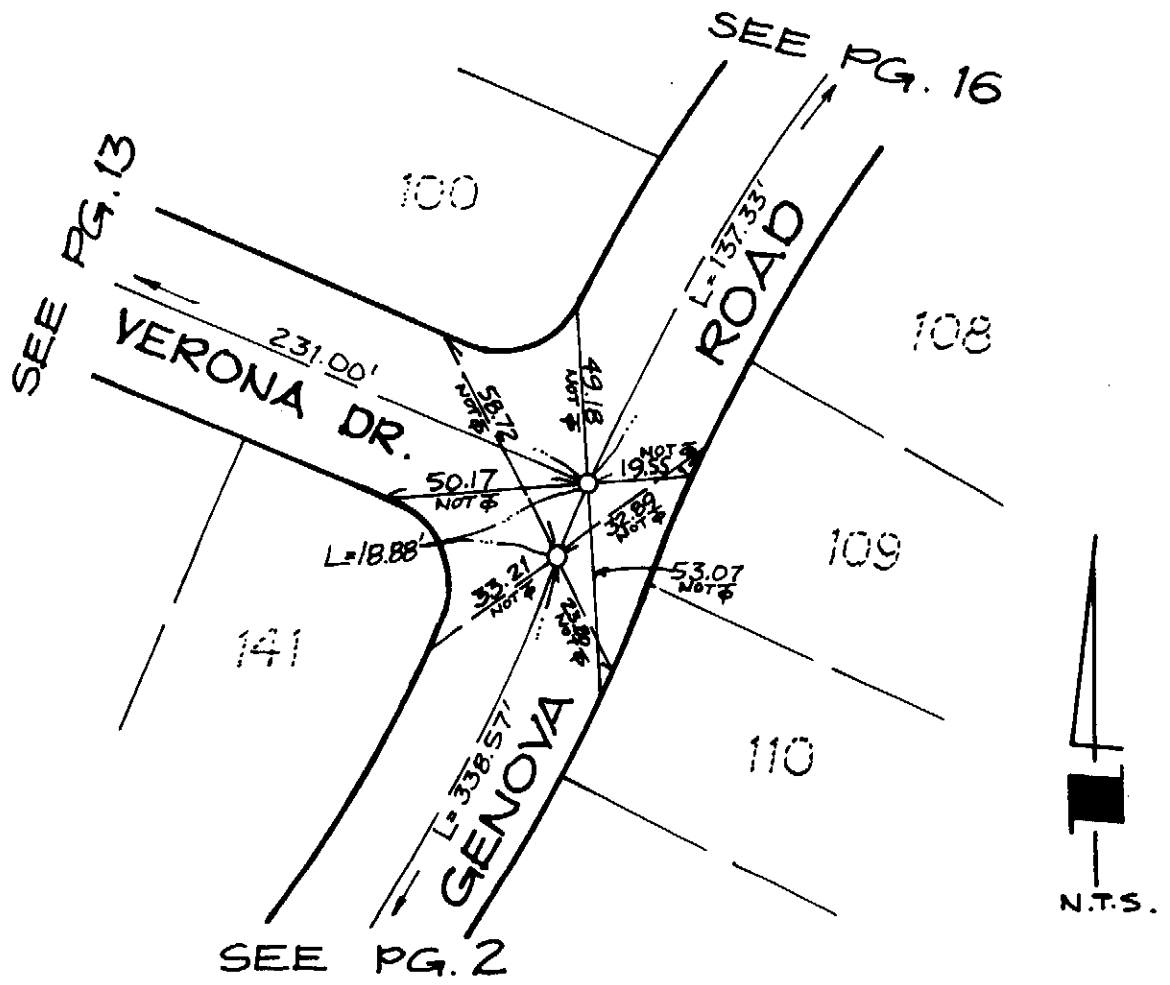

CITY OF RANCHO CUCAMONGA — STREET TIES	TRACT OR P.M. NO. 13443
HUNSAKER & ASSOCIATES 732 E. CARNEGIE DR. SAN BERNARDINO, CA 92408 (714) 889-2222	GENOVA ROAD AT VERONA DRIVE
ENGR: TOM R. McGANNON	FIELD REVIEW — DATE 11/8/89
R.C.E. No. 23956 EXP. DATE: 12/31/89	TIE BOOK 15 — PAGE 18

RANCHO CUCAMONGA TIE NOTE BASE SHT. - 241[0.1]PF: ONTRIO 1 01-Dec-87 03:45 PM / 146-0-600

NOTE:

ALL TIE POINTS ARE L&T SET IN TOP OF CURB AND TANGENT OVER UNLESS OTHERWISE NOTED.

LEGEND:

O —— SET SPIKE & WASHER STAMPED R.C.E. 23956

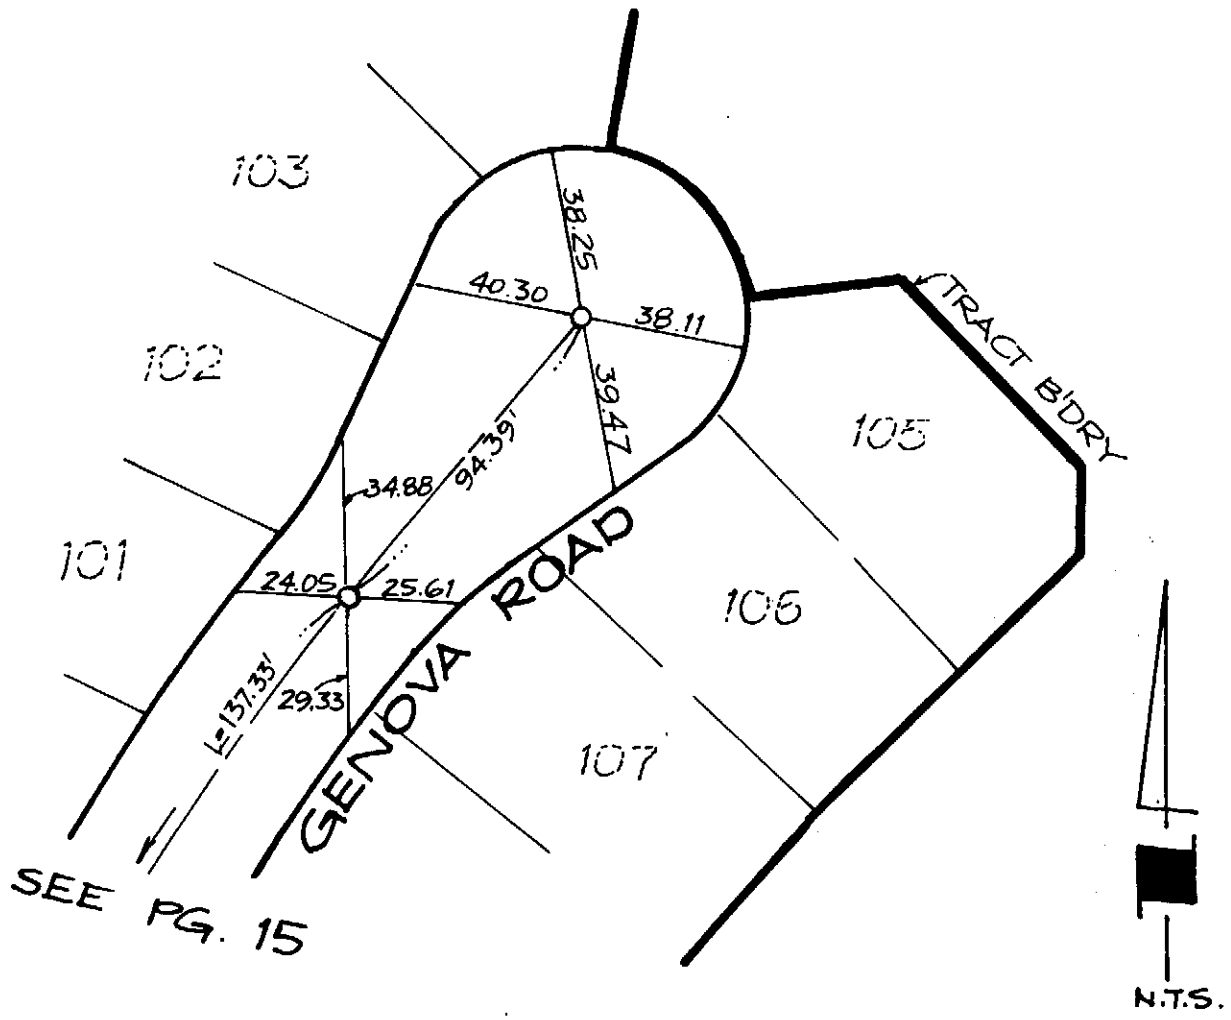

CITY OF RANCHO CUCAMONGA — STREET TIES	TRACT OR P.M. NO. 13443
HUNSAKER & ASSOCIATES 732 E. CARNEGIE DR. SAN BERNARDINO, CA 92408 (714) 889-2222	GENOVA ROAD EASTERLY CUL-DE-SAC
ENGR: TOM R. McGANNON	FIELD REVIEW — DATE 11/8/89
R.C.E. No. 23956 EXP. DATE: 12/31/89	TIE BOOK 15 — PAGE 19

RANCHO CUCAMONGA TIE NOTE BASE SHT. - 241[0.11]PF: ONTRIO 1 01-Dec-67 03:45 PM / 146-0-600

(16 OF 17)

NOTE:

ALL TIE POINTS ARE L&T SET IN TOP OF CURB AND TANGENT OVER UNLESS OTHERWISE NOTED.

LEGEND:

O —— SET SPIKE & WASHER STAMPED R.C.E. 23956

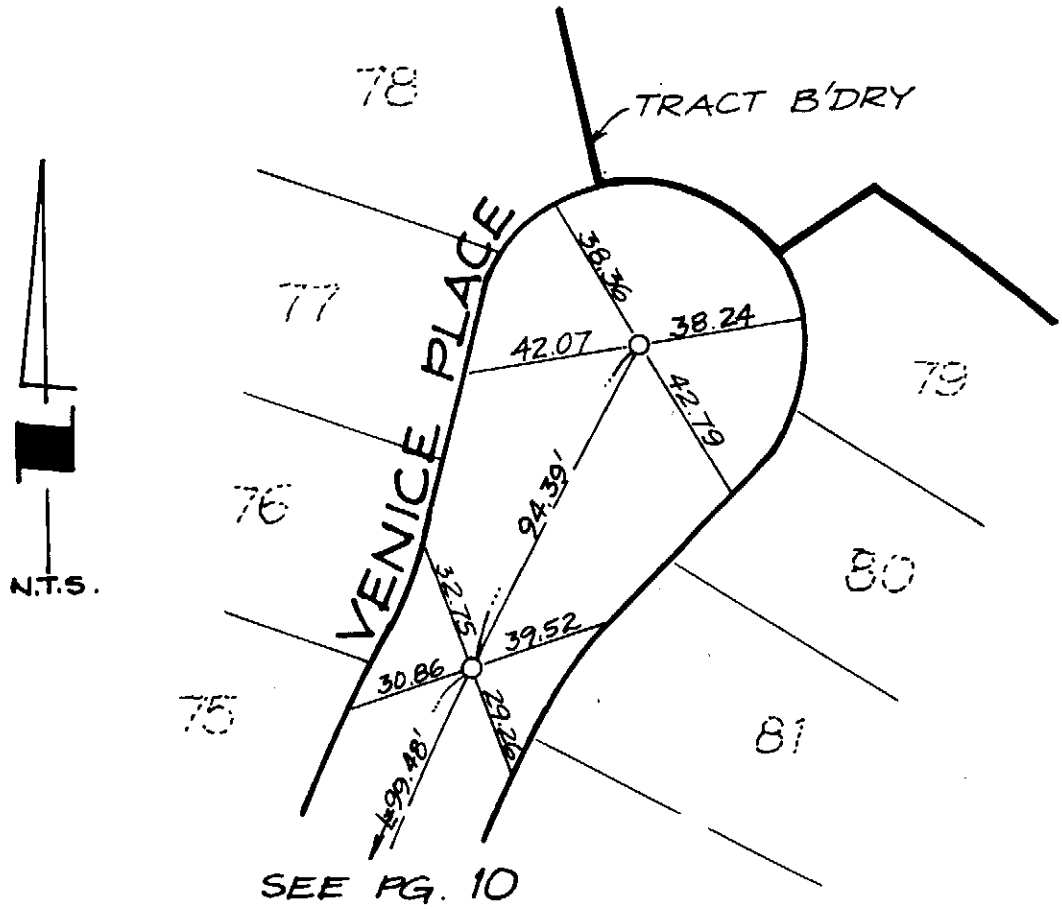

CITY OF RANCHO CUCAMONGA — STREET TIES	TRACT OR P.M. NO. 13443
HUNSAKER & ASSOCIATES 732 E. CARNEGIE DR. SAN BERNARDINO, CA 92408 (714) 889-2222	VENICE PLACE CUL-DE-SAC
ENGR: TOM R. McGANNON	FIELD REVIEW — DATE 11/8/89
R.C.E. No. 23956 EXP. DATE: 12/31/89	TIE BOOK 15 — PAGE 20

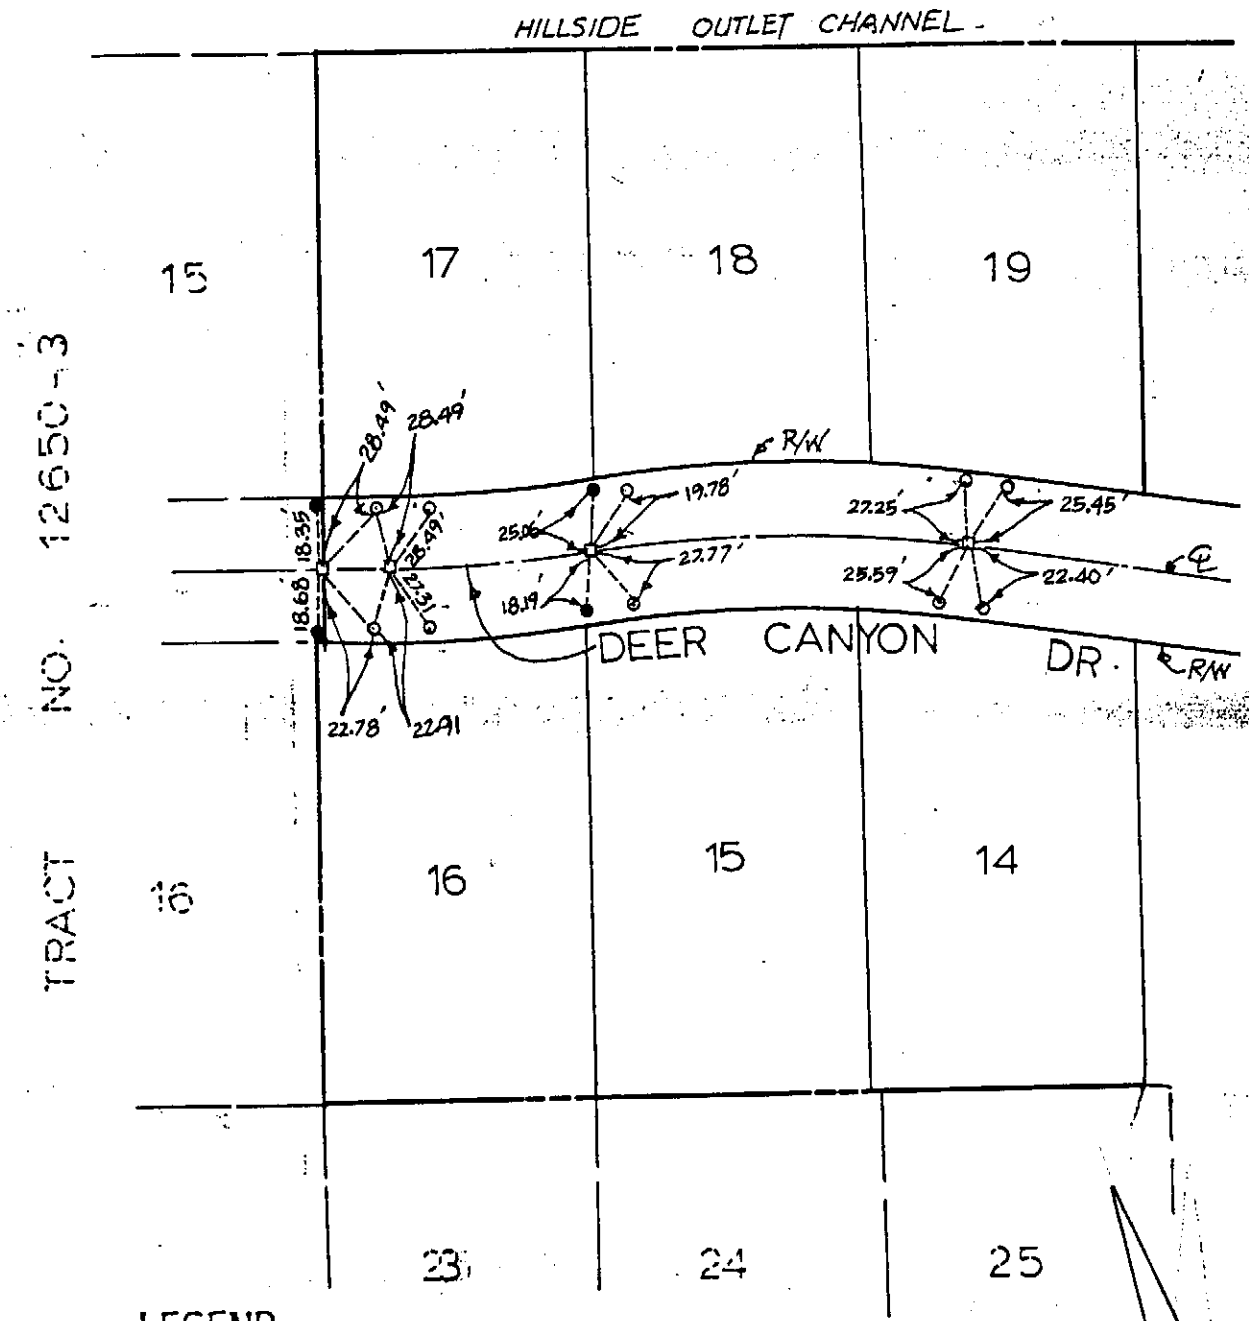

LEGEND

□ = 1" IRON PIPE TAGGED R.C.E.14814.

○ = SET LEAD AND TAG IN TOP OF CURB TAGGED R.C.E. 14814.

● SET LEAD AND TACK

SCALE 1"=80'

CITY OF RANCHO CUCAMONGA STREET TIE	TRACT NO. 12650
MADOLE AND ASSOCIATES, INC. 1820 E. 16th Street SANTA ANA, CALIFORNIA 92701 PHONE 714 • 835-2548	DEER CANYON DRIVE E/O COBBLESTONE
ENGR. J.M. MADOLE	FIELD REVIEW _____ DATE _____
R.C.E. NO. 14814 DATE _____	TIE BOOK 15 PAGE 21

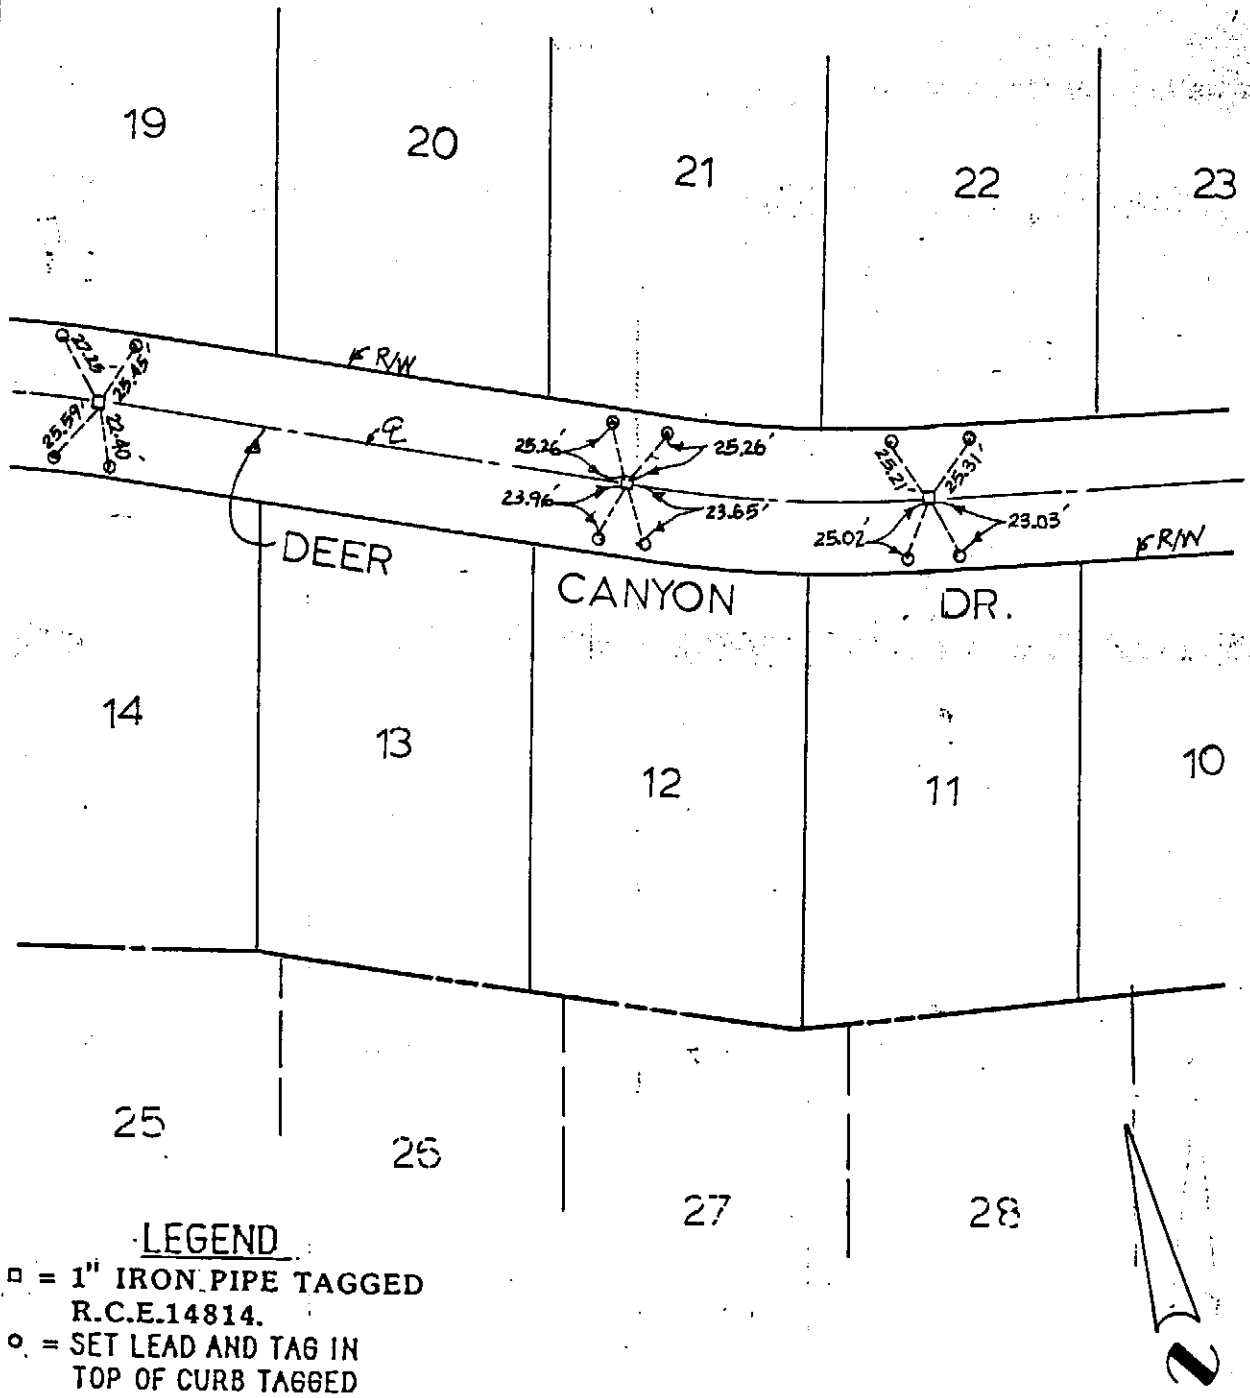

LEGEND

□ = 1" IRON PIPE TAGGED R.C.E.14814.

○ = SET LEAD AND TAG IN TOP OF CURB TAGGED R.C.E. 14814.

SCALE 1" 80'

CITY OF RANCHO CUCAMONGA STREET TIE	TRACT NO. 12650
MADOLE AND ASSOCIATES, INC. 1820 E. 16th Street SANTA ANA, CALIFORNIA 92701 PHONE 714 • 835-2548	DEER CANYON DRIVE EID COBBLESTONE
ENGR. J.M. MADOLE	FIELD REVIEW _____ DATE _____
R.C.E. NO. 14814 DATE _____	TIE BOOK 15 PAGE 22

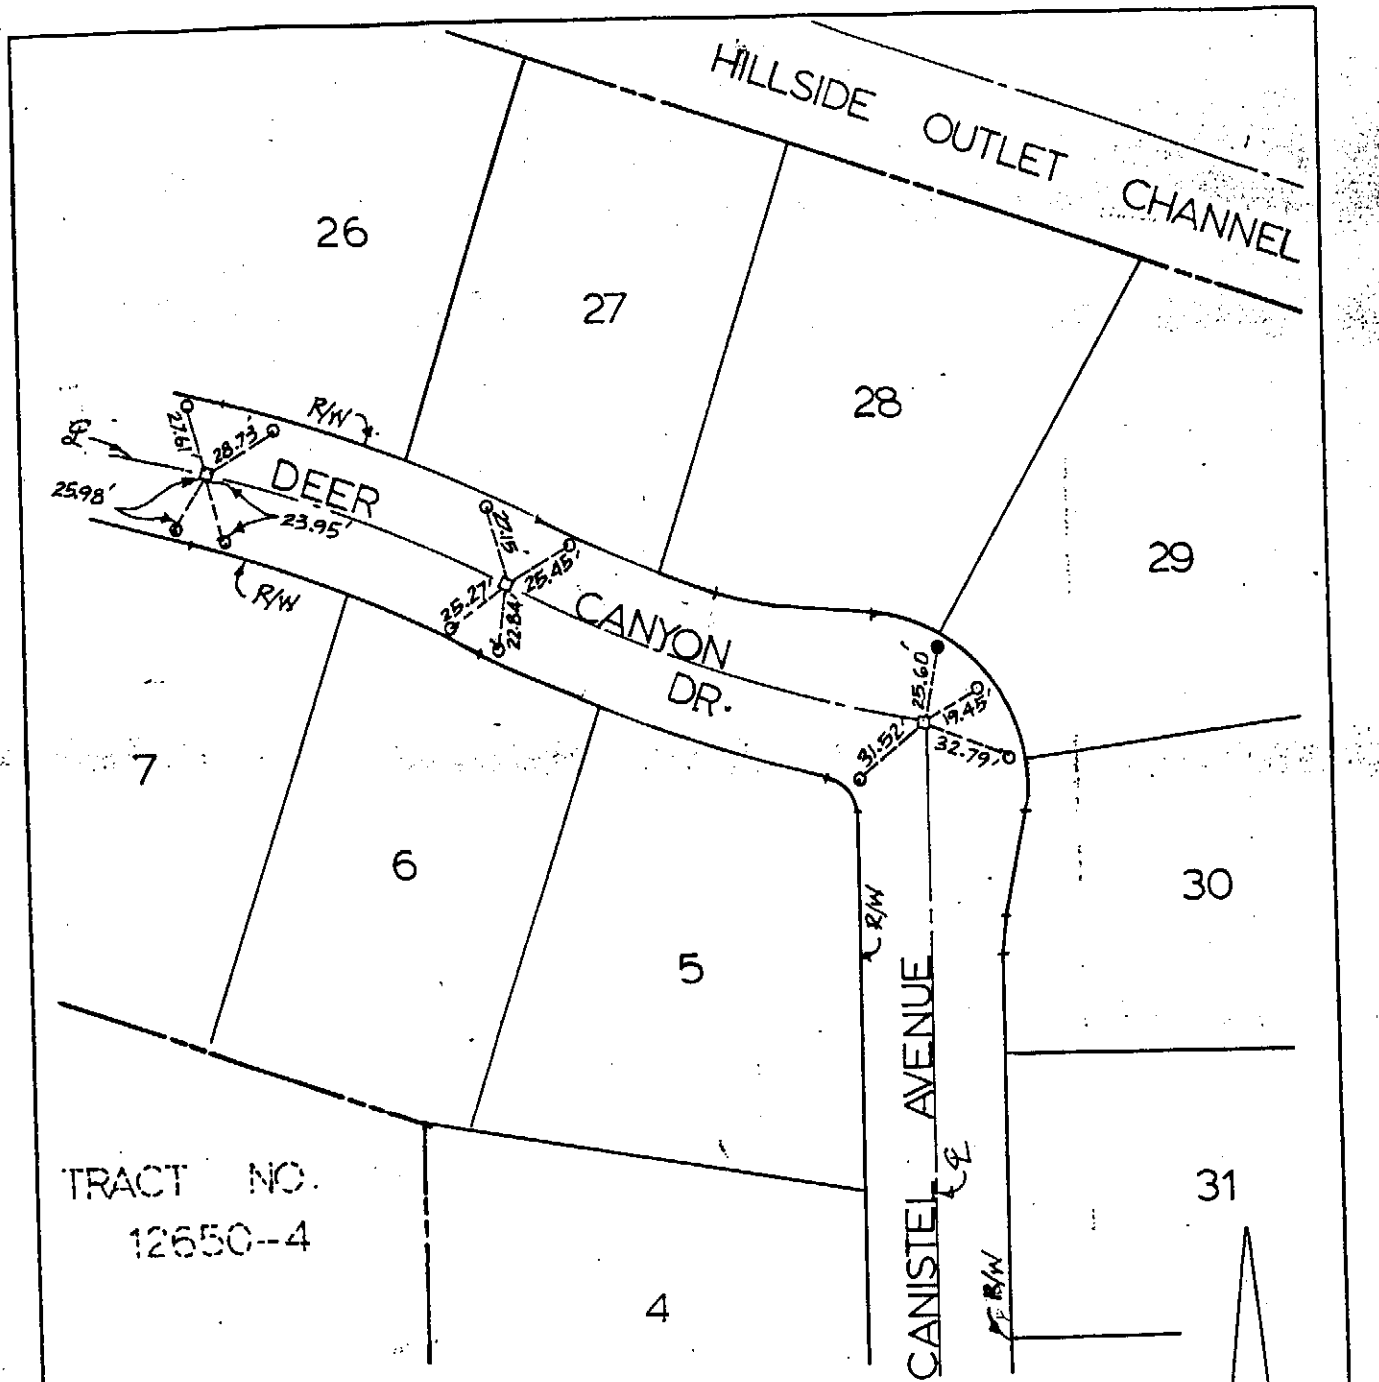

LEGEND

□ = 1" IRON PIPE TAGGED R.C.E.14814.

○ = SET LEAD AND TAG IN TOP OF CURB TAGGED R.C.E. 14814.

● = SET LEAD AND TACK

CITY OF RANCHO CUCAMONGA — STREET TIE	TRACT NO. 12650
MADOLE AND ASSOCIATES, INC. 1820 E. 16th Street SANTA ANA, CALIFORNIA 92701 PHONE 714 • 835-2548	DEER CANYON DR. W/O CANISTEL AVE.
ENGR. J.M. MADOLE	FIELD REVIEW _____ DATE _____
R.C.E. NO. 14814 DATE _____	TIE BOOK 15 PAGE 23

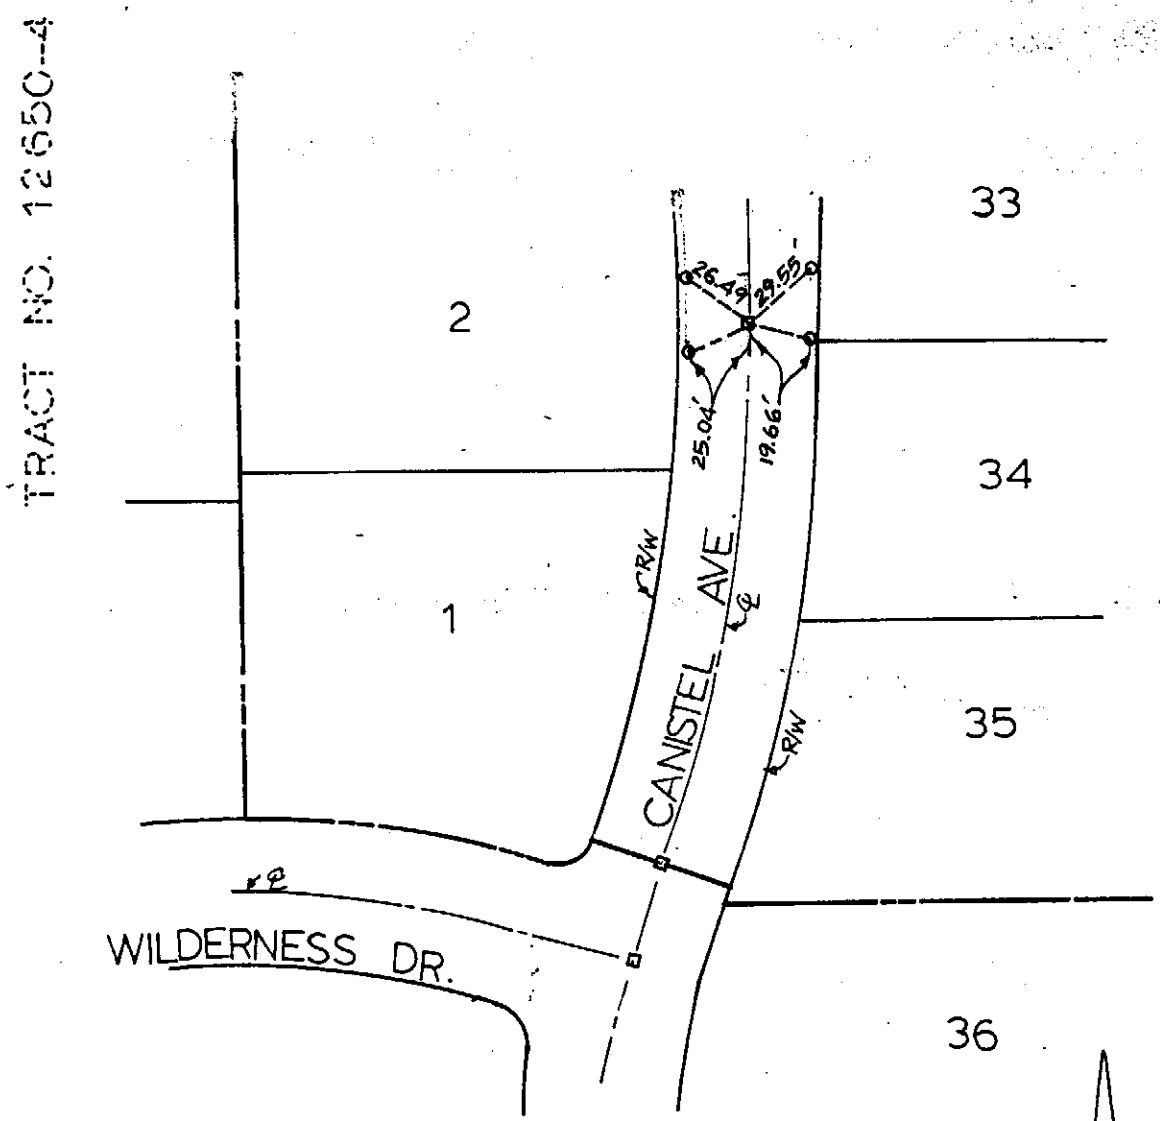

LEGEND

□ = 1" IRON PIPE TAGGED R.C.E.14814.

○ = SET LEAD AND TAG IN TOP OF CURB TAGGED R.C.E. 14814.

● = SET LEAD AND TACK

N

SCALE: 1"=80'

CITY OF RANCHO CUCAMONGA — STREET TIE	TRACT NO. 12650
MADOLE AND ASSOCIATES, INC. 1820 E. 16th Street SANTA ANA, CALIFORNIA 92701 PHONE 714 • 835-2548	CANISTEL AVENUE N/O WILDERNESS DR.
ENGR. J.M. MADOLE	FIELD REVIEW _____ DATE _____
R.C.E. NO. 14814 DATE _____	TIE BOOK 15 PAGE 24

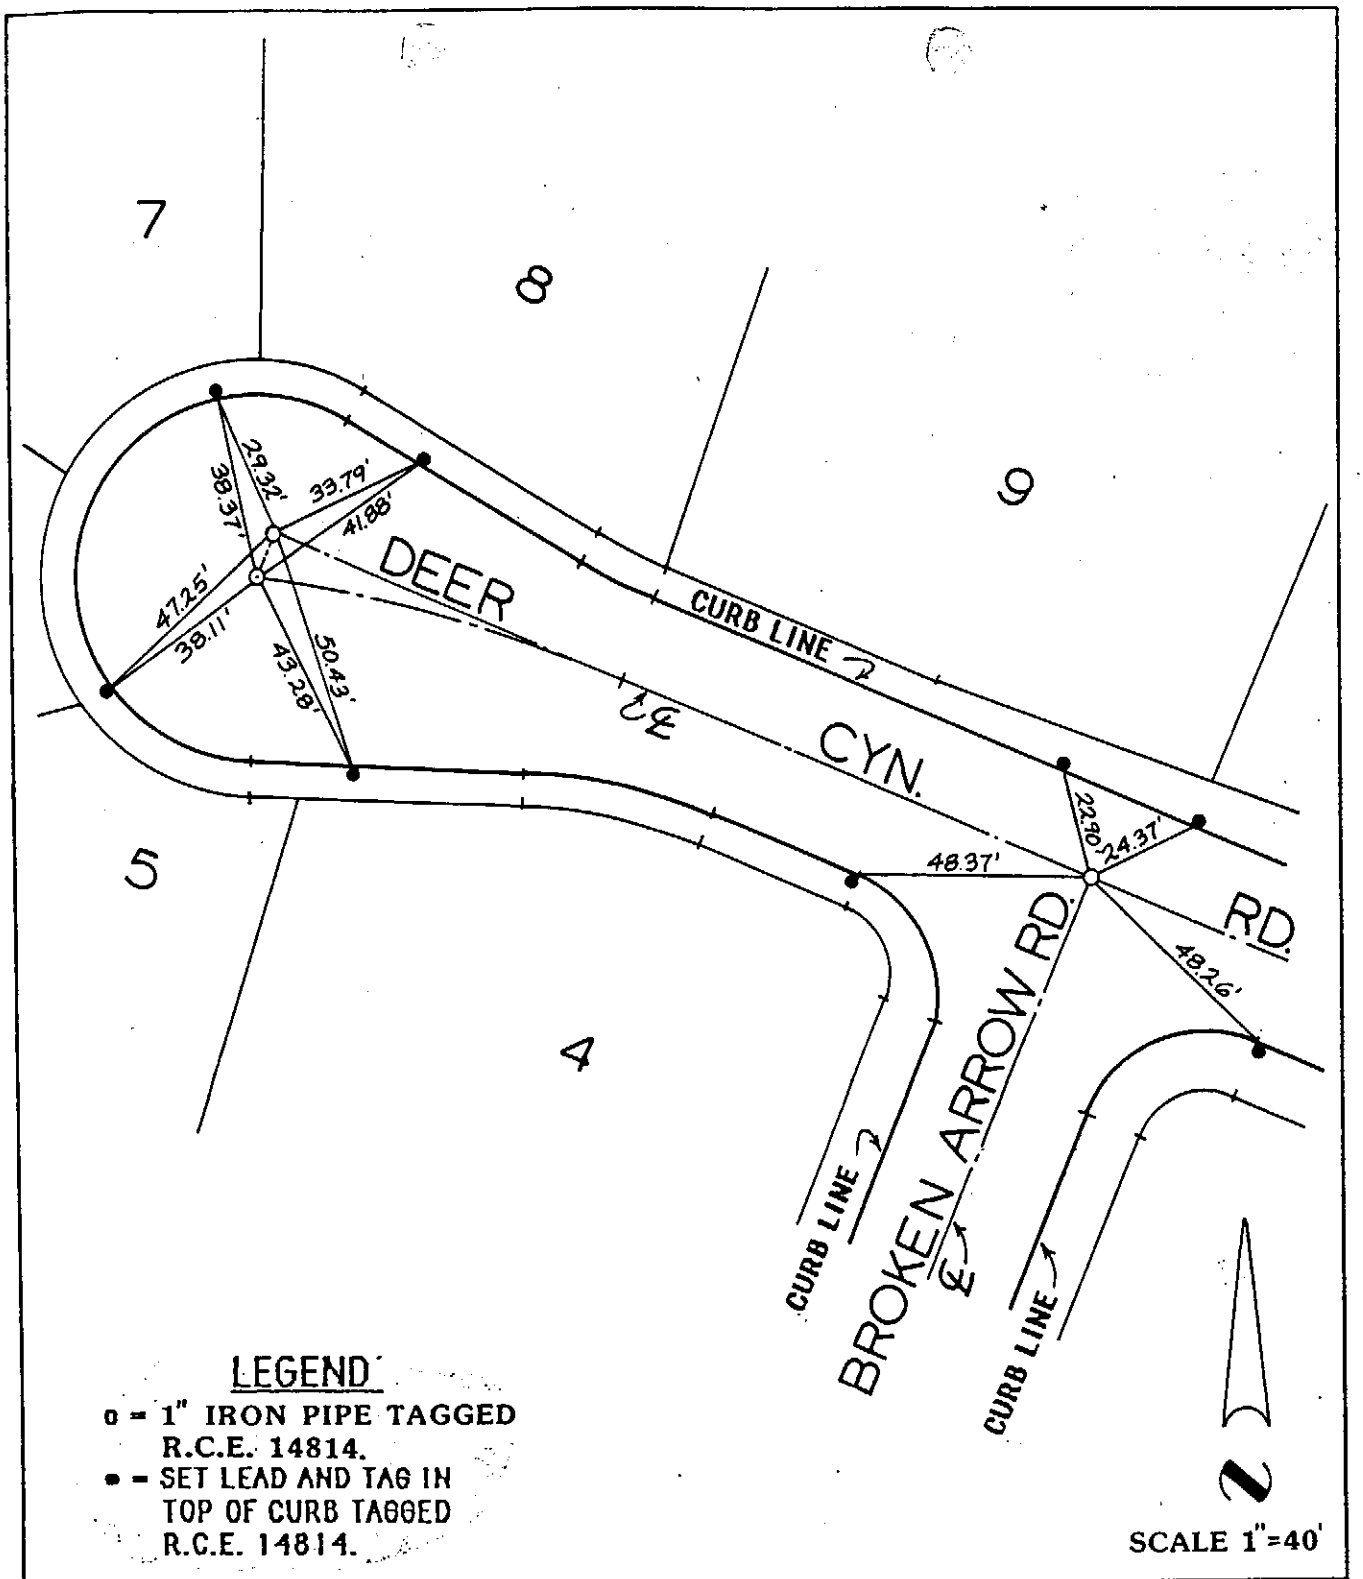

CITY OF RANCHO CUCAMONGA — STREET TIE	TRACT NO. 12650-1
MADOLE AND ASSOCIATES, INC. 1820 E. 16th Street SANTA ANA, CALIFORNIA 92701 PHONE 714 • 835-2548	**DEER CANYON RD.** WEST CUL-DE-SAC
ENGR. J.M. MADOLE	FIELD REVIEW _____ DATE _____
R.C.E. NO. 14814 DATE _____	TIE BOOK 15 PAGE 25

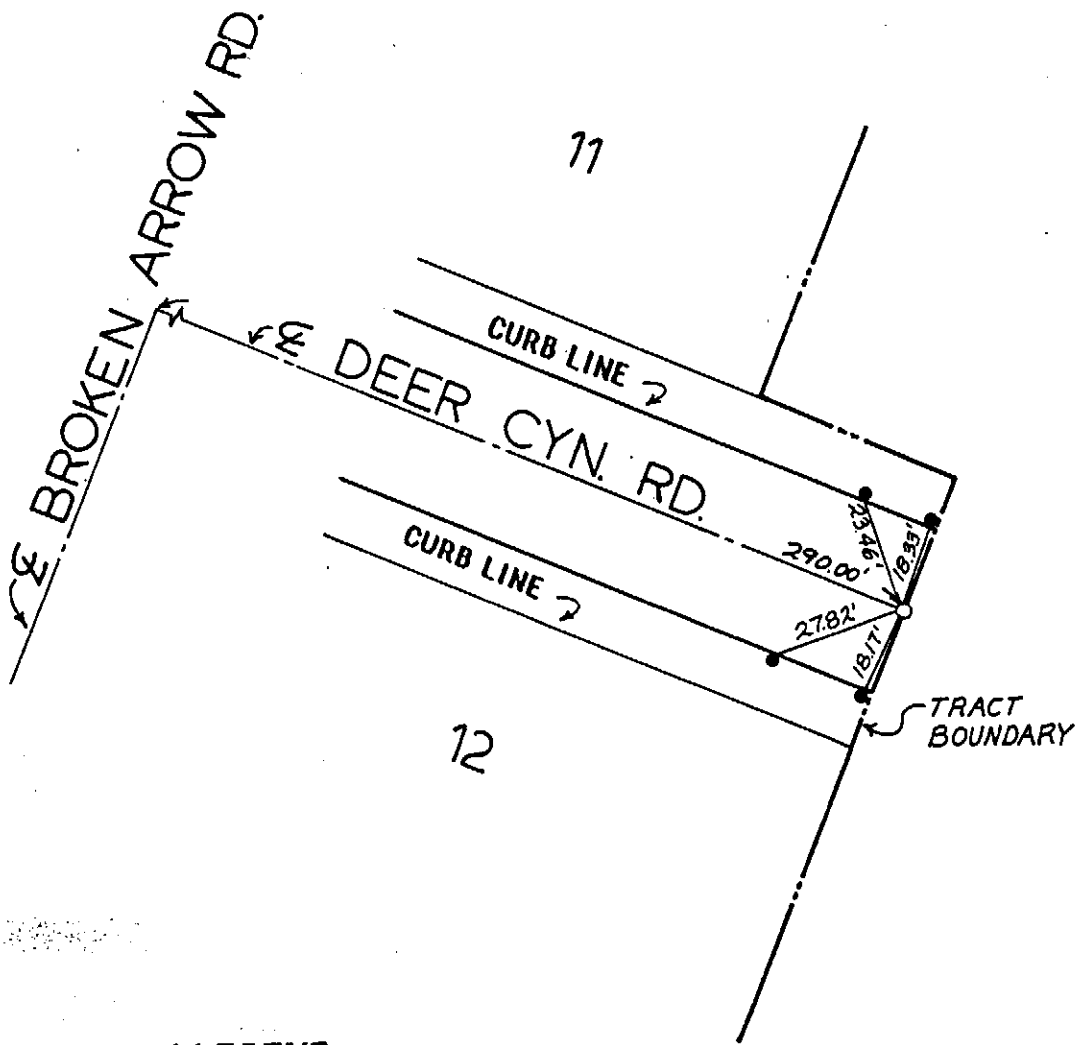

LEGEND

o = 1" IRON PIPE TAGGED R.C.E. 14814.

• = SET LEAD AND TAG IN TOP OF CURB TAGGED R.C.E. 14814.

N

SCALE 1"=40'

CITY OF RANCHO CUCAMONGA — STREET TIE	TRACT NO. 12650-1
MADOLE AND ASSOCIATES, INC. 1820 E. 16th Street SANTA ANA, CALIFORNIA 92701 PHONE 714 • 835-2548	DEER CANYON RD. E/O BROKEN ARROW
ENGR. J.M. MADOLE	FIELD REVIEW _____ DATE _____
R.C.E. NO. 14814 DATE _____	TIE BOOK 15 PAGE 26

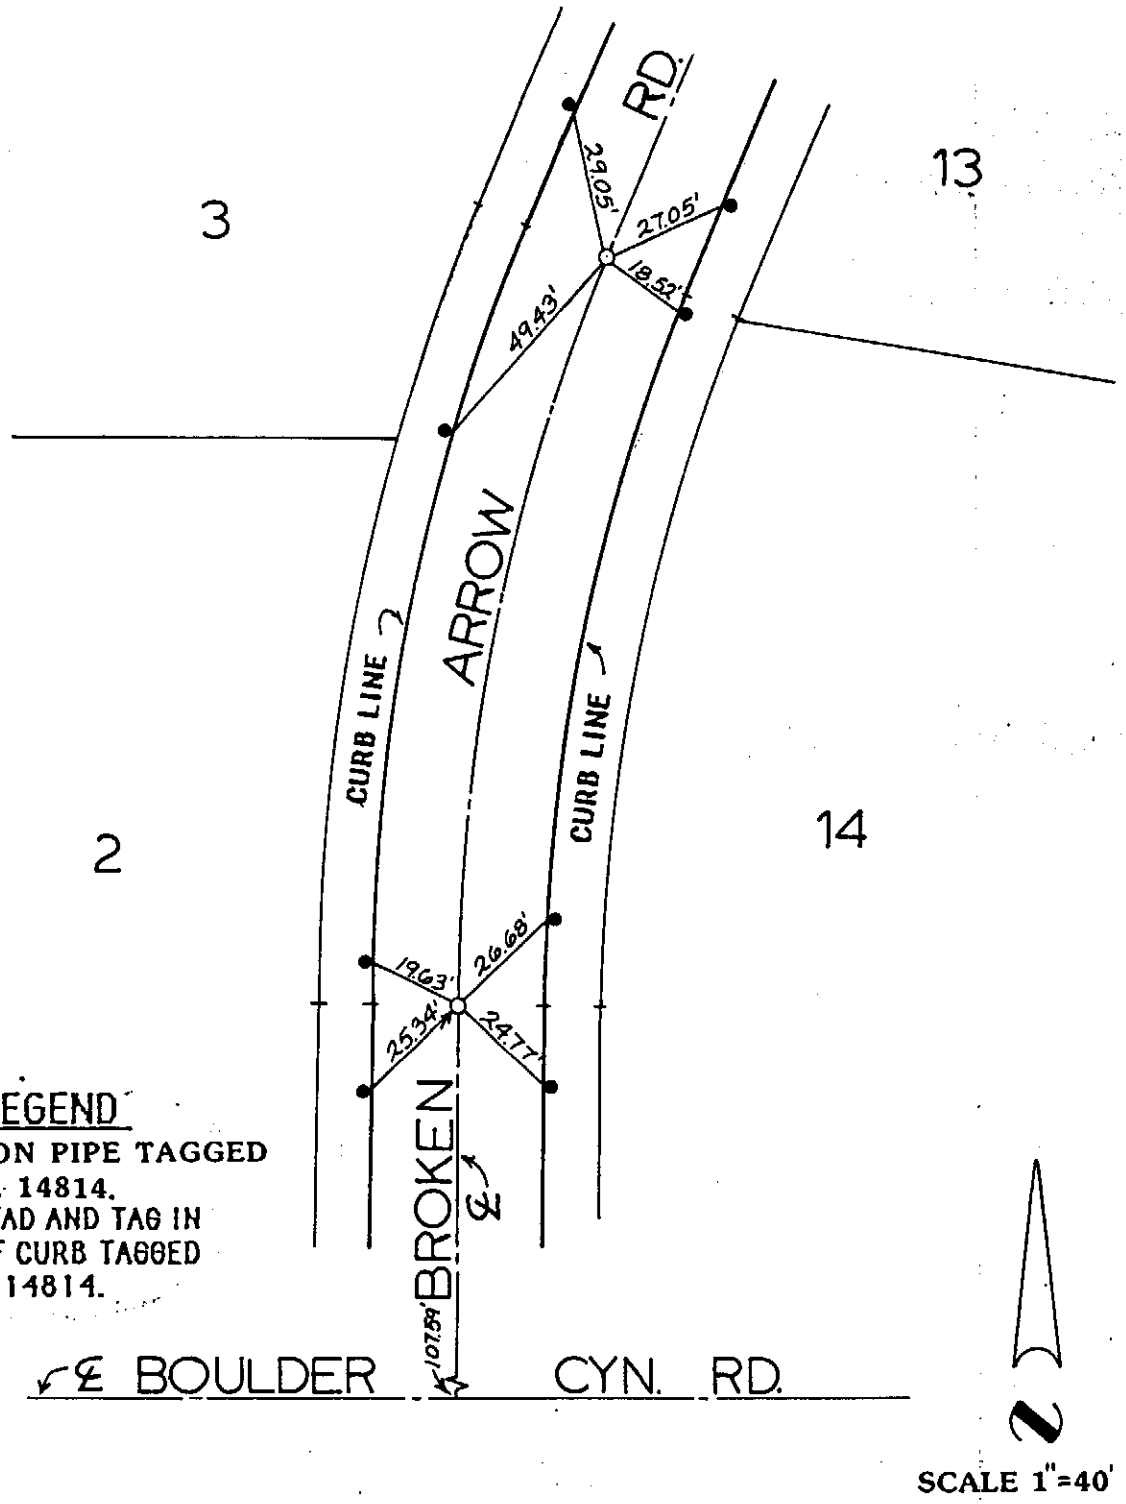

CITY OF RANCHO CUCAMONGA — STREET TIE	TRACT NO. 12650-1
MADOLE AND ASSOCIATES, INC. 1820 E. 16th Street SANTA ANA, CALIFORNIA 92701 PHONE 714 • 835-2548	**BROKEN ARROW RD.**
ENGR. J.M. MADOLE	FIELD REVIEW _____ DATE _____
R.C.E. NO. 14814 DATE _____	TIE BOOK 15 PAGE 27

LEGEND

o = 1" IRON PIPE TAGGED R.C.E. 14814.

• = SET LEAD AND TAG IN TOP OF CURB TAGGED R.C.E. 14814.

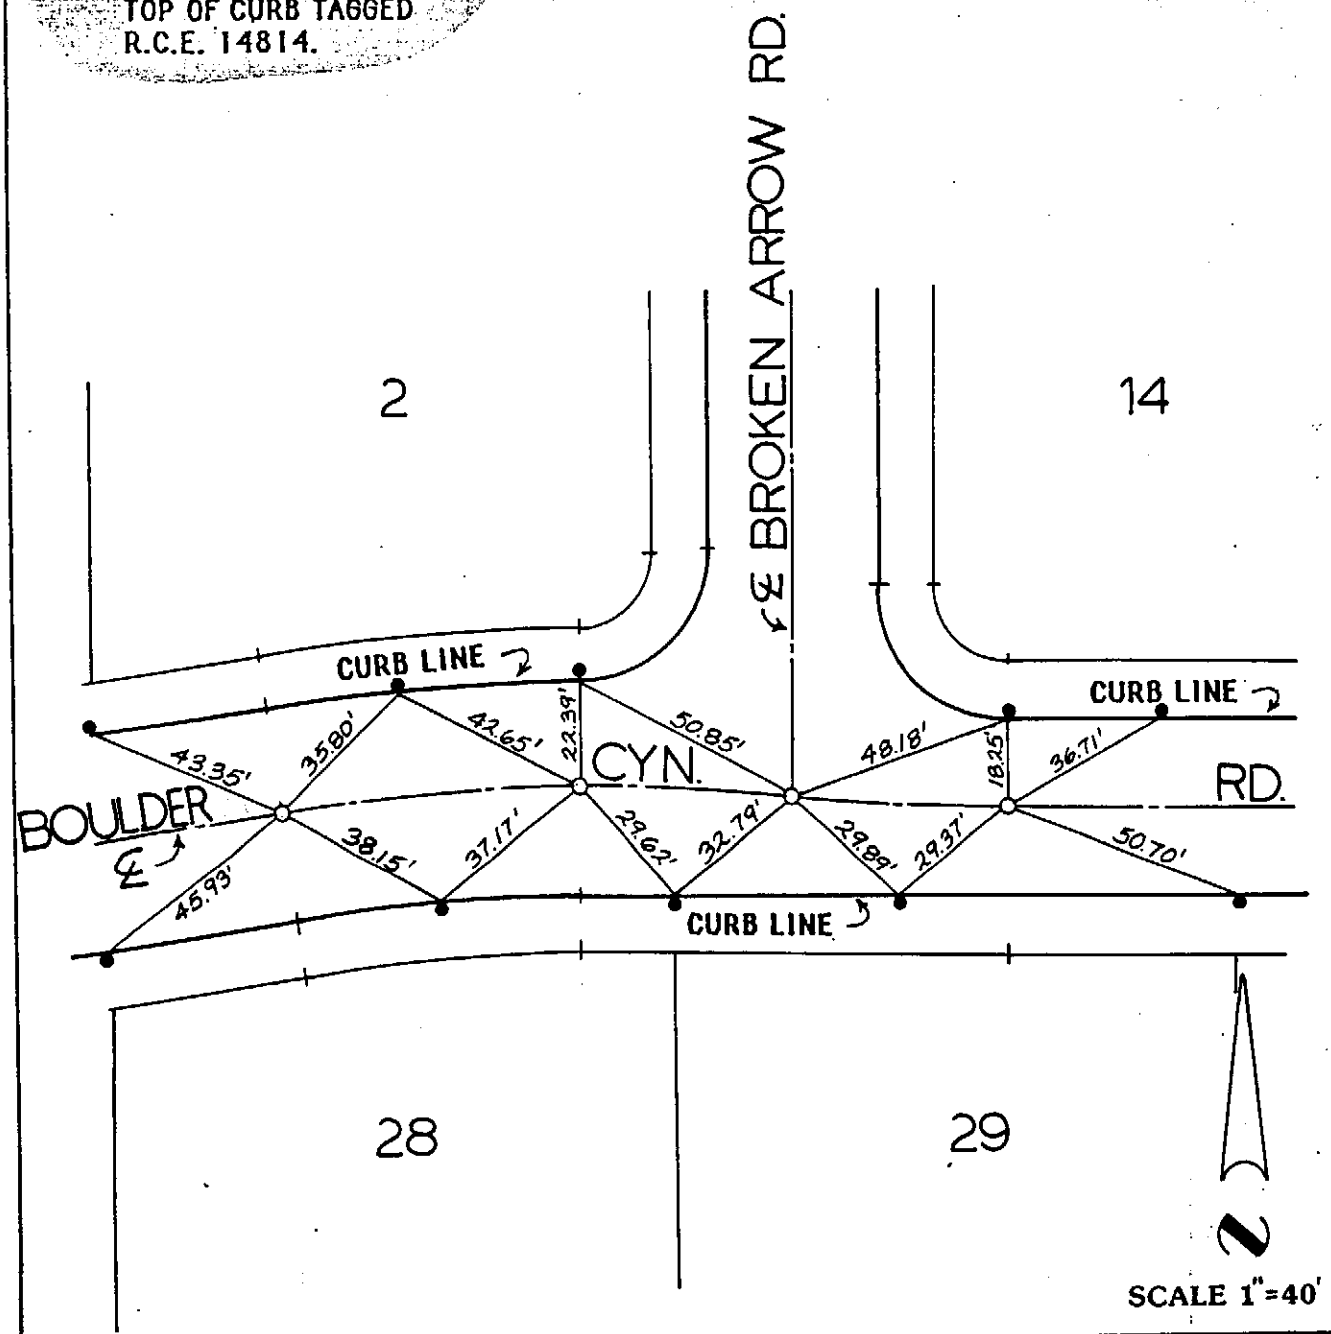

CITY OF RANCHO CUCAMONGA — STREET TIE	TRACT NO. 12650-1
MADOLE AND ASSOCIATES, INC. 1820 E. 16th Street SANTA ANA, CALIFORNIA 92701 PHONE 714 • 835-2548	**BOULDER CANYON RD.** AT BROKEN ARROW
ENGR. J.M. MADOLE	FIELD REVIEW _____ DATE _____
R.C.E. NO. 14814 DATE _____	TIE BOOK 15 PAGE 28

LEGEND

o = 1" IRON PIPE TAGGED R.C.E.14814.

• = SET LEAD AND TAG IN TOP OF CURB TAGGED R.C.E. 14814.

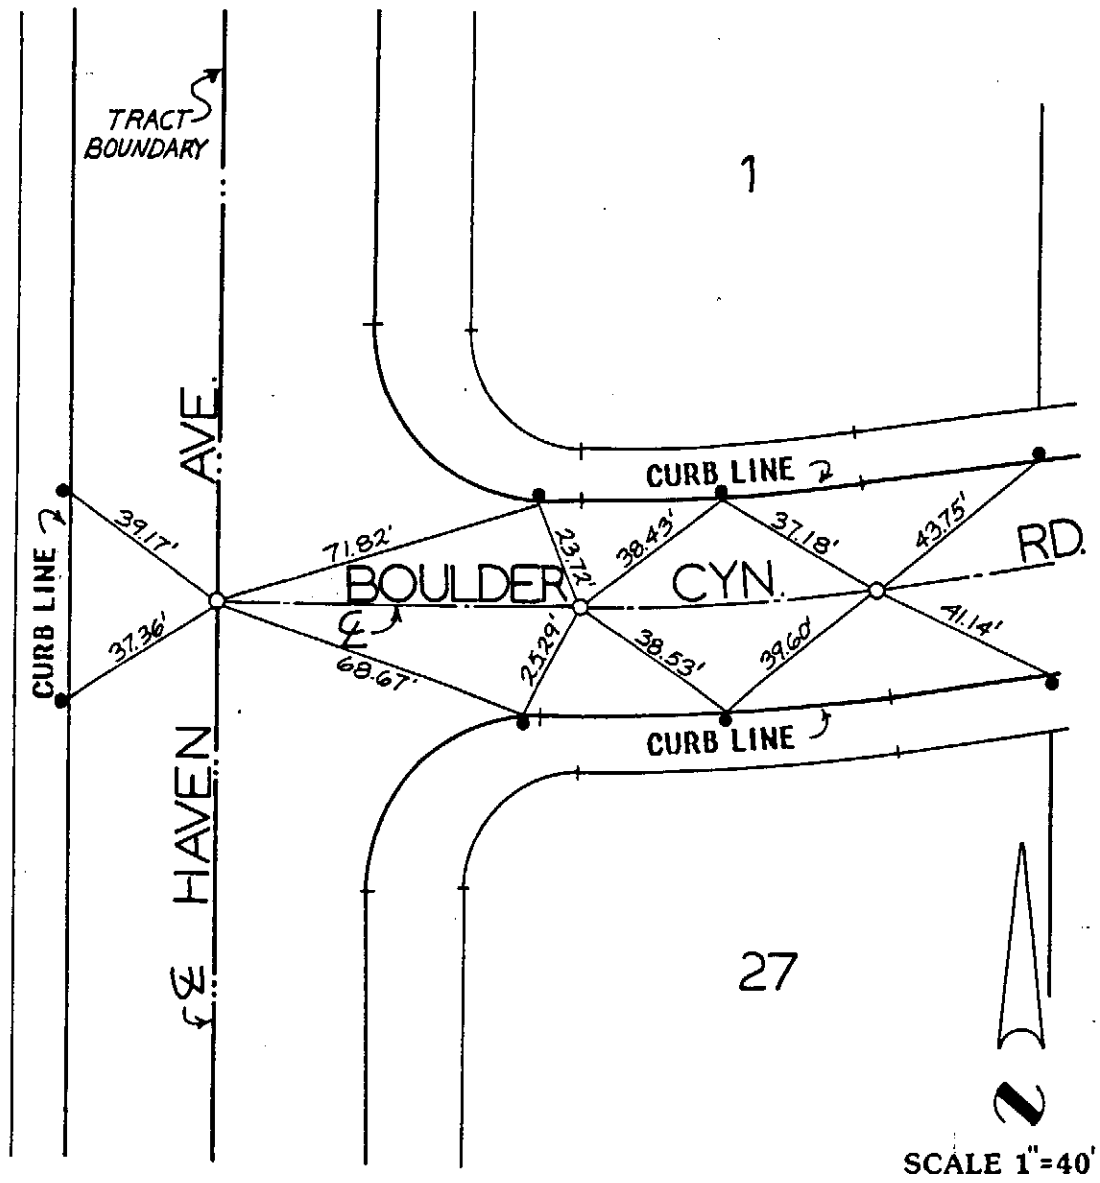

CITY OF RANCHO CUCAMONGA — STREET TIE	TRACT NO. 12650-1
MADOLE AND ASSOCIATES, INC. 1820 E. 16th Street SANTA ANA, CALIFORNIA 92701 PHONE 714 • 835-2548	**BOULDER CANYON RD.** AT HAVEN AVENUE
ENGR. J.M. MADOLE	FIELD REVIEW _____ DATE _____
R.C.E. NO. 14814 DATE _____	TIE BOOK 15 PAGE 29

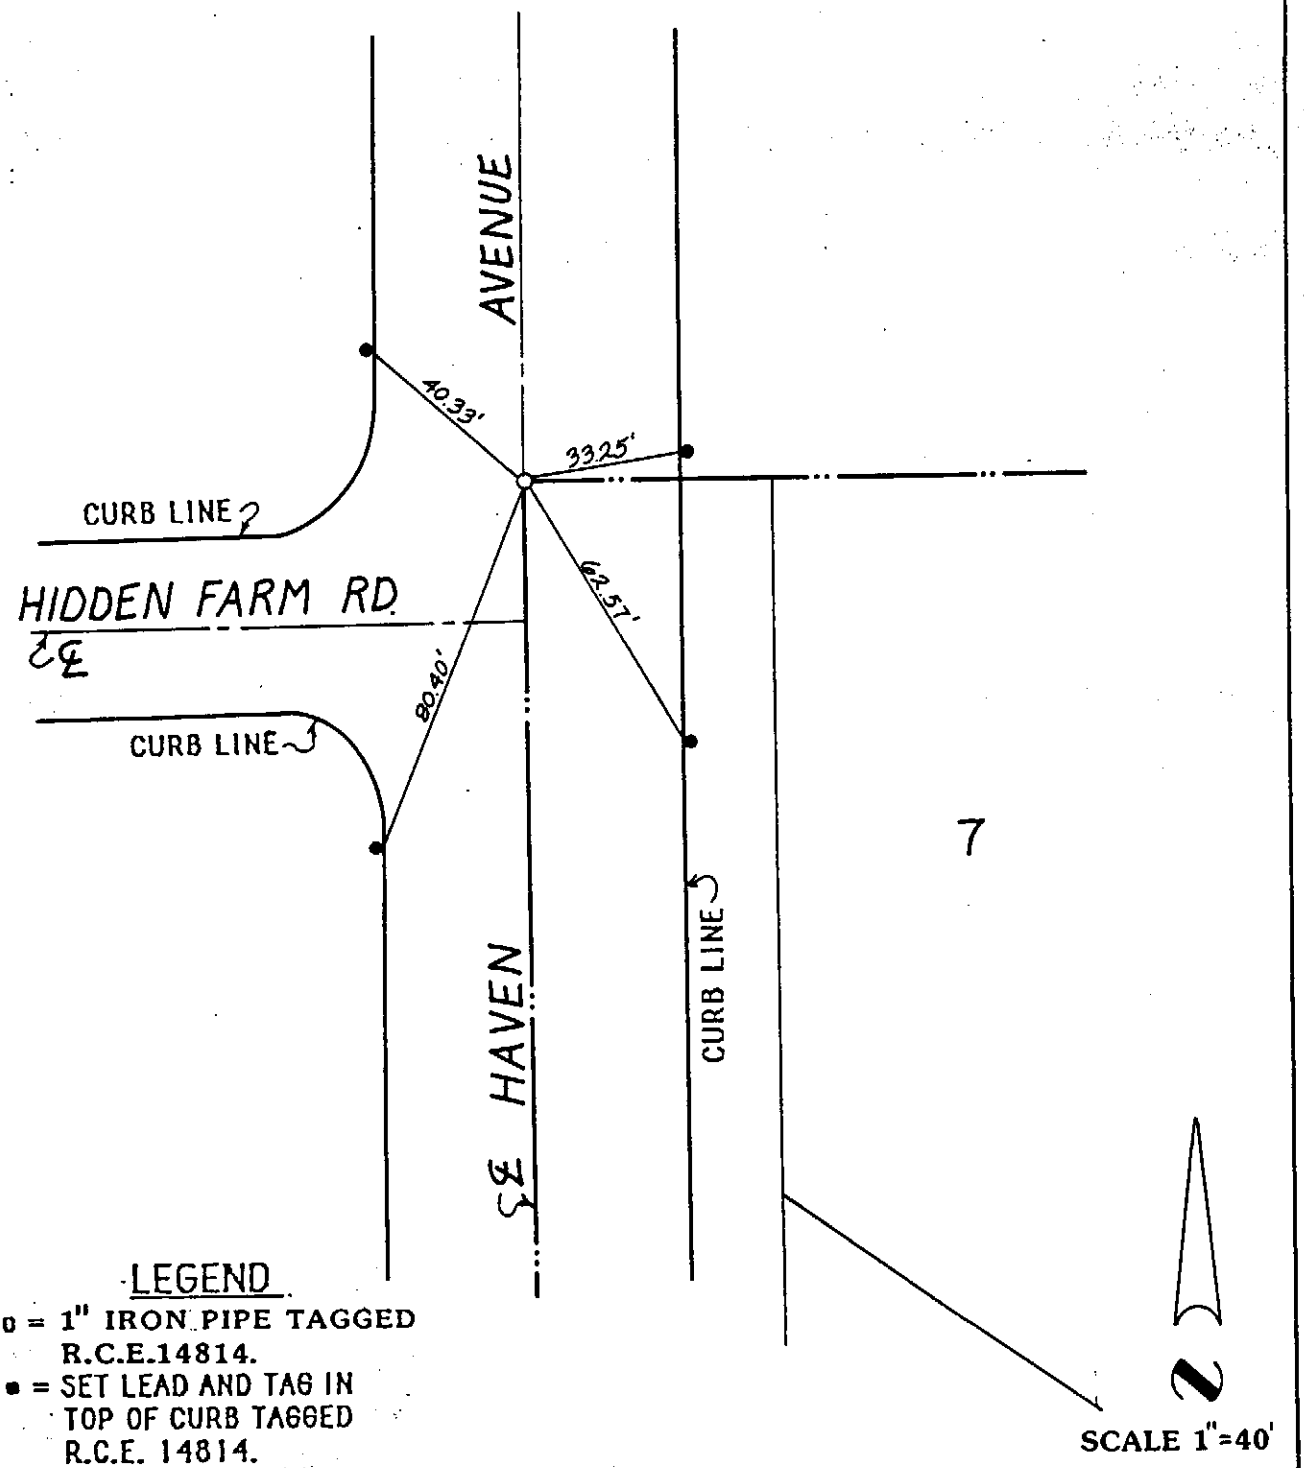

LEGEND

o = 1" IRON PIPE TAGGED R.C.E.14814.

• = SET LEAD AND TAG IN TOP OF CURB TAGGED R.C.E. 14814.

CITY OF RANCHO CUCAMONGA — STREET TIE	TRACT NO. 12650-1
MADOLE AND ASSOCIATES, INC. 1820 E. 16th Street SANTA ANA, CALIFORNIA 92701 PHONE 714 • 835-2548	HAVEN AVENUE AT HIDDEN FARM RD.
ENGR. J.M. MADOLE	FIELD REVIEW _____ DATE _____
R.C.E. NO. 14814 DATE _____	TIE BOOK 15 PAGE 30

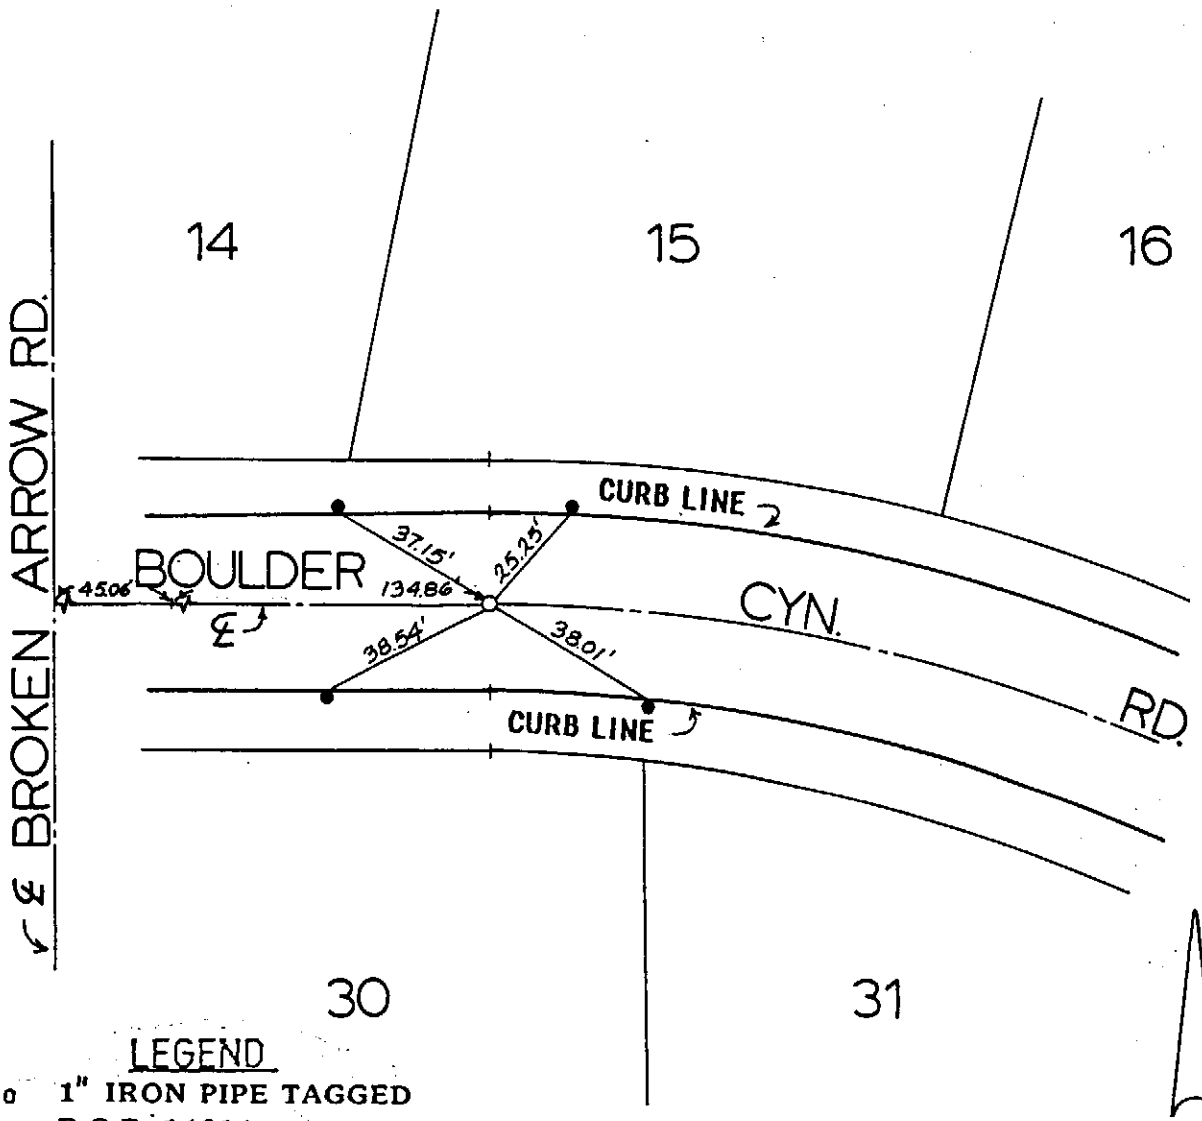

LEGEND

o 1" IRON PIPE TAGGED R.C.E. 14814.

• = SET LEAD AND TAG IN TOP OF CURB TAGGED R.C.E. 14814.

SCALE 1"=40'

CITY OF RANCHO CUCAMONGA — STREET TIE	TRACT NO. 12650-1
MADOLE AND ASSOCIATES, INC. 1820 E. 16th Street SANTA ANA, CALIFORNIA 92701 PHONE 714 • 835-2548	BOULDER CANYON RD. E/O BROKEN ARROW RD.
ENGR. J.M. MADOLE	FIELD REVIEW _____ DATE _____
R.C.E. NO. 14814 DATE _____	TIE BOOK 15 PAGE 31

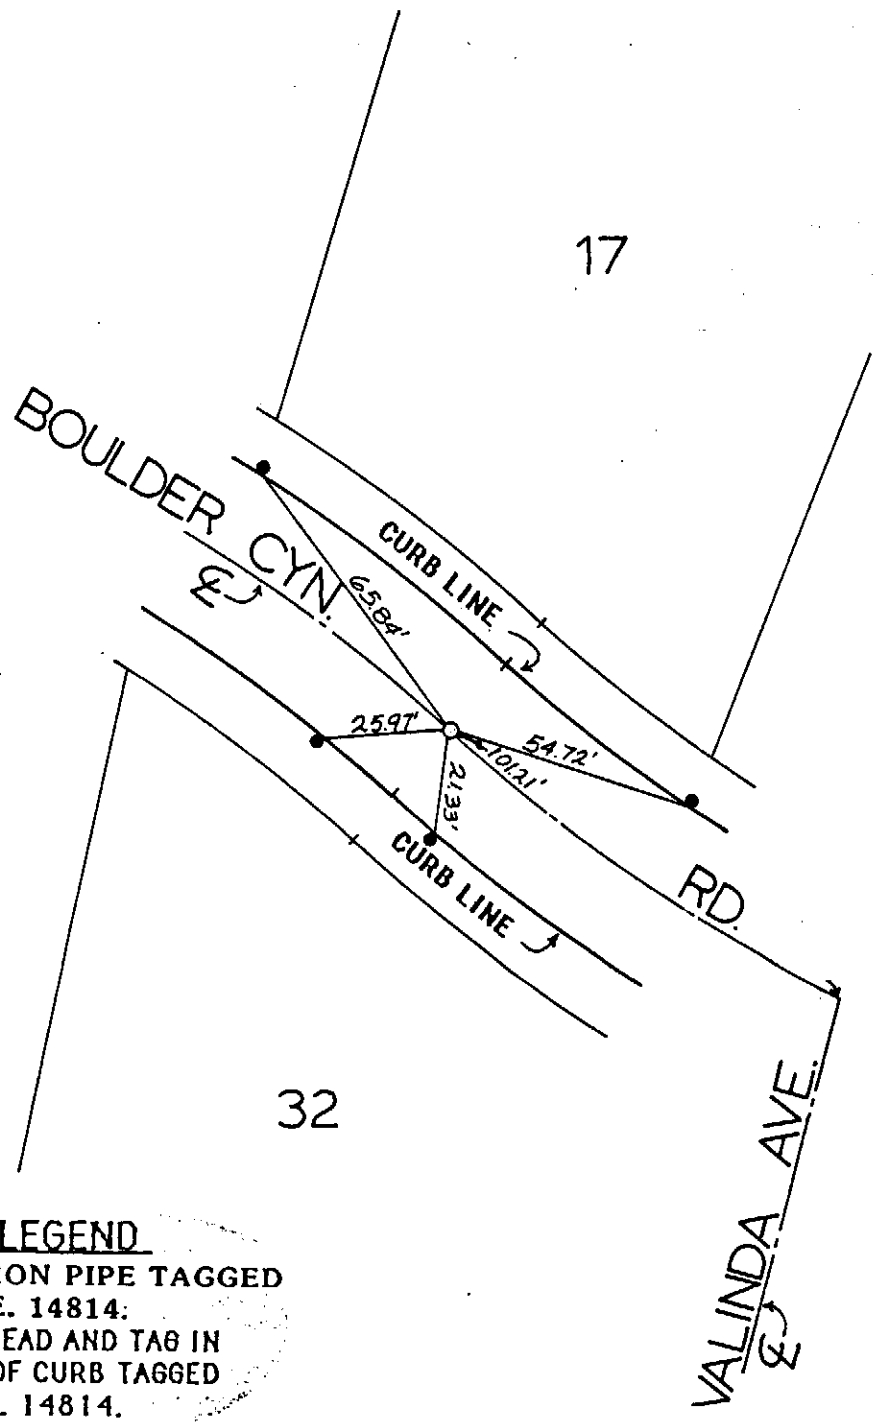

LEGEND

o = 1" IRON PIPE TAGGED R.C.E. 14814.

• = SET LEAD AND TAG IN TOP OF CURB TAGGED R.C.E. 14814.

SCALE 1"=40'

CITY OF RANCHO CUCAMONGA — STREET TIE	TRACT NO. 12650-1
MADOLE AND ASSOCIATES, INC. 1820 E. 16th Street SANTA ANA, CALIFORNIA 92701 PHONE 714 • 835-2548	**BOULDER CANYON RD.** W/O VALINDA AVE.
ENGR. J.M. MADOLE	FIELD REVIEW _____ DATE _____
R.C.E. NO. 14814 DATE _____	TIE BOOK 15 PAGE 32

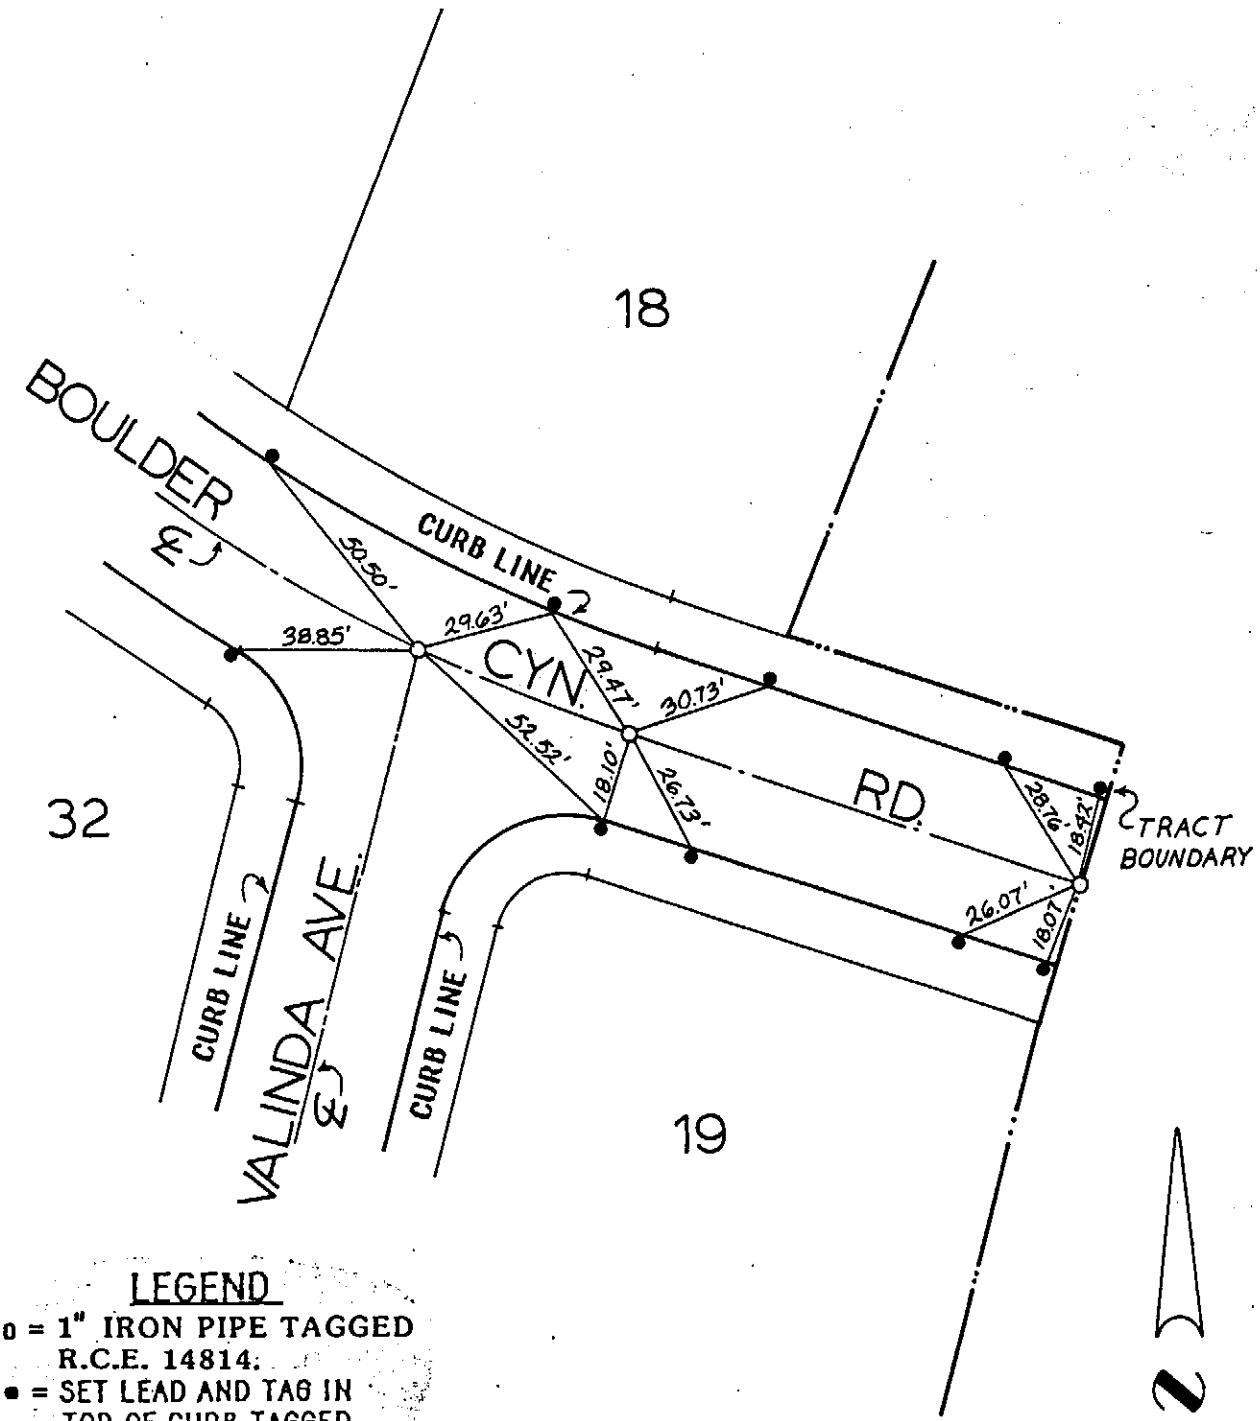

LEGEND

o = 1" IRON PIPE TAGGED R.C.E. 14814.

• = SET LEAD AND TAG IN TOP OF CURB TAGGED R.C.E. 14814.

SCALE 1"=40'

CITY OF RANCHO CUCAMONGA — STREET TIE	TRACT NO. 12650-1
MADOLE AND ASSOCIATES, INC. 1820 E. 16th Street SANTA ANA, CALIFORNIA 92701 PHONE 714 • 835-2548	**BOULDER CANYON RD.** AT VALINDA AVE.
ENGR. J.M. MADOLE	FIELD REVIEW _____ DATE _____
R.C.E. NO. 14814 DATE _____	TIE BOOK 15 PAGE 33

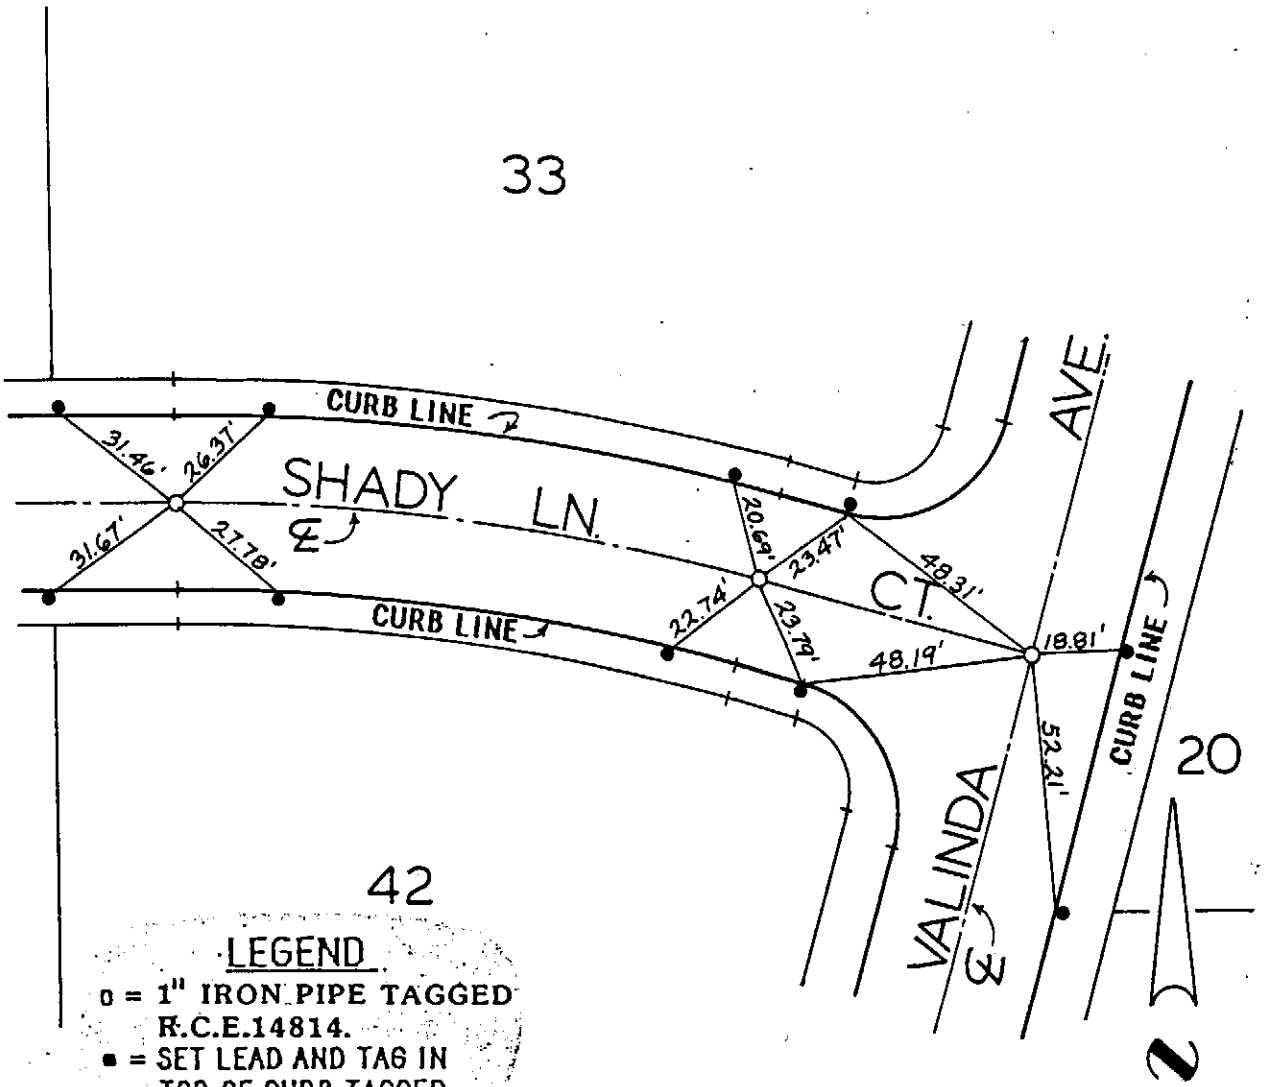

LEGEND

o = 1" IRON PIPE TAGGED R.C.E.14814.

■ = SET LEAD AND TAG IN TOP OF CURB TAGGED R.C.E. 14814.

SCALE 1"=40'

CITY OF RANCHO CUCAMONGA — STREET TIE	TRACT NO. 12650-1
MADOLE AND ASSOCIATES, INC. 1820 E. 16th Street SANTA ANA, CALIFORNIA 92701 PHONE 714 • 835-2548	SHADY LANE CT. AT VALINDA AVE.
ENGR. J.M. MADOLE	FIELD REVIEW _____ DATE _____
R.C.E. NO. 14814 DATE _____	TIE BOOK 15 PAGE 34

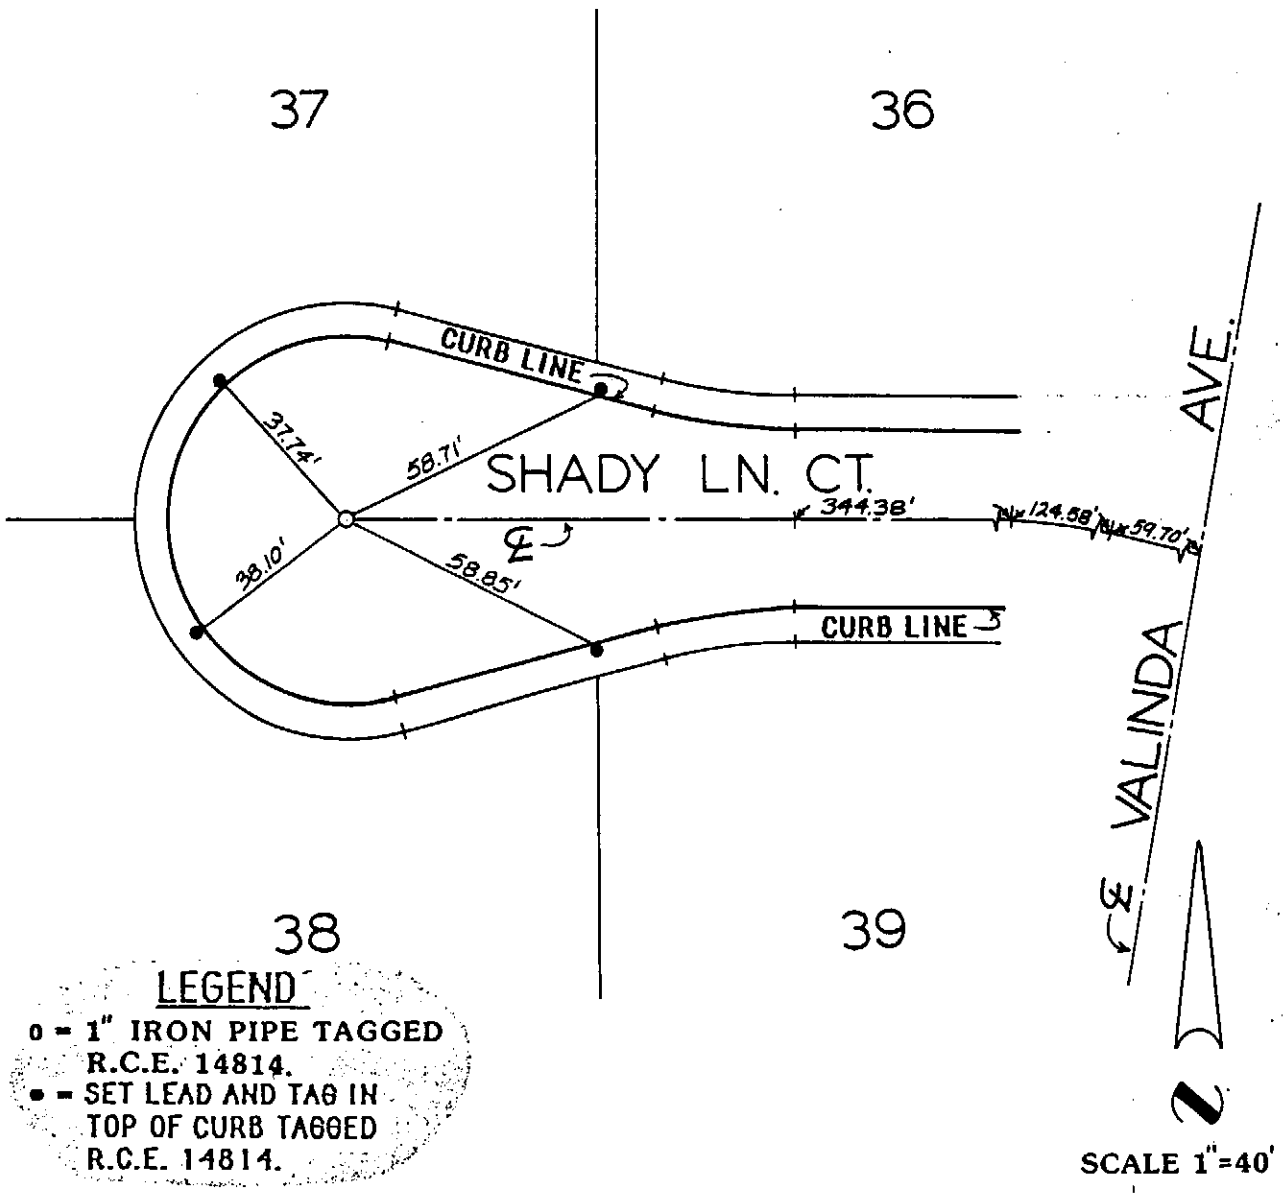

LEGEND

o = 1" IRON PIPE TAGGED R.C.E. 14814.

• = SET LEAD AND TAG IN TOP OF CURB TAGGED R.C.E. 14814.

SCALE 1"=40'

CITY OF RANCHO CUCAMONGA — STREET TIE	TRACT NO. 12650-1
MADOLE AND ASSOCIATES, INC. 1820 E. 16th Street SANTA ANA, CALIFORNIA 92701 PHONE 714 • 835-2548	**SHADY LANE CT.** CUL-DE-SAC
ENGR. J.M. MADOLE	FIELD REVIEW _____ DATE _____
R.C.E. NO. 14814 DATE _____	TIE BOOK 15 PAGE 35

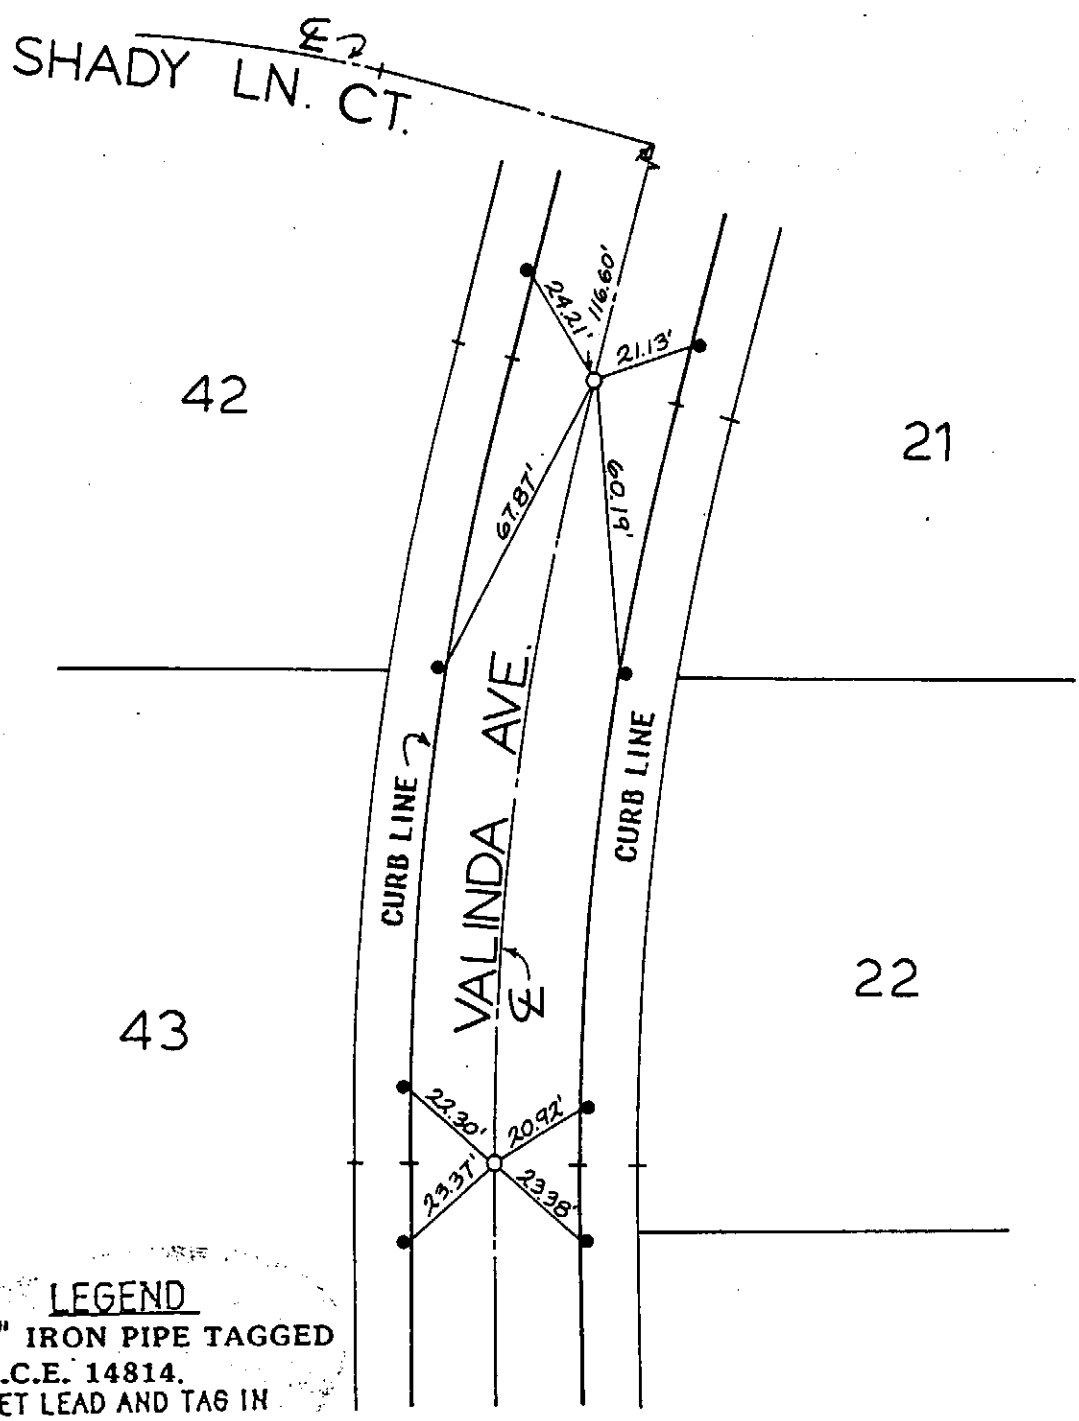

LEGEND

o 1" IRON PIPE TAGGED R.C.E. 14814.

• = SET LEAD AND TAG IN TOP OF CURB TAGGED R.C.E. 14814.

SCALE 1"=40'

CITY OF RANCHO CUCAMONGA — STREET TIE	TRACT NO. 12650-1
MADOLE AND ASSOCIATES, INC. 1820 E. 16th Street SANTA ANA, CALIFORNIA 92701 PHONE 714 • 835-2548	**VALINDA AVE.** S/O SHADY LANE CT.
ENGR. J.M. MADOLE	FIELD REVIEW _____ DATE _____
R.C.E. NO. 14814 DATE _____	TIE BOOK 15 PAGE 36

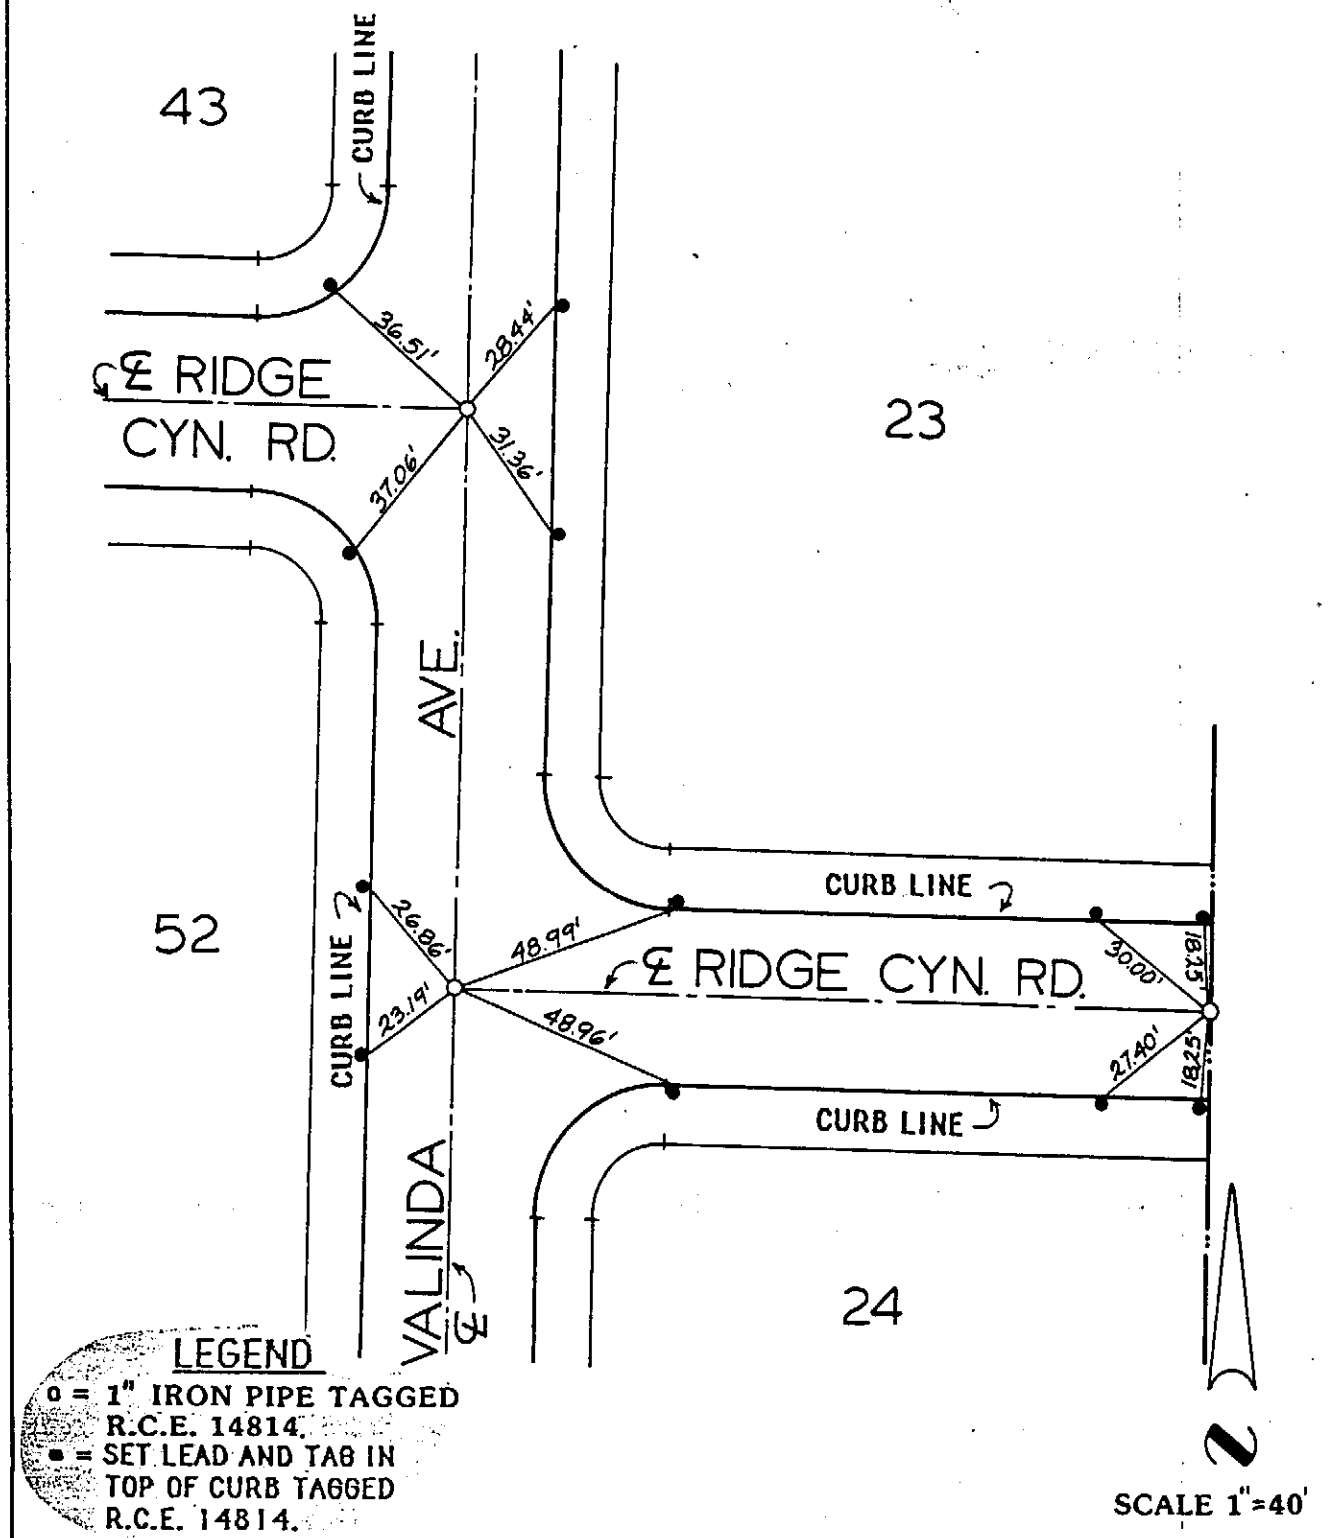

CITY OF RANCHO CUCAMONGA — STREET TIE	TRACT NO. 12650-1
MADOLE AND ASSOCIATES, INC. 1820 E. 16th Street SANTA ANA, CALIFORNIA 92701 PHONE 714 • 835-2548	**RIDGE CANYON RD.** AT VALINDA AVE.
ENGR. J.M. MADOLE	FIELD REVIEW _____ DATE _____
R.C.E. NO. 14814 DATE _____	TIE BOOK 15 PAGE 37

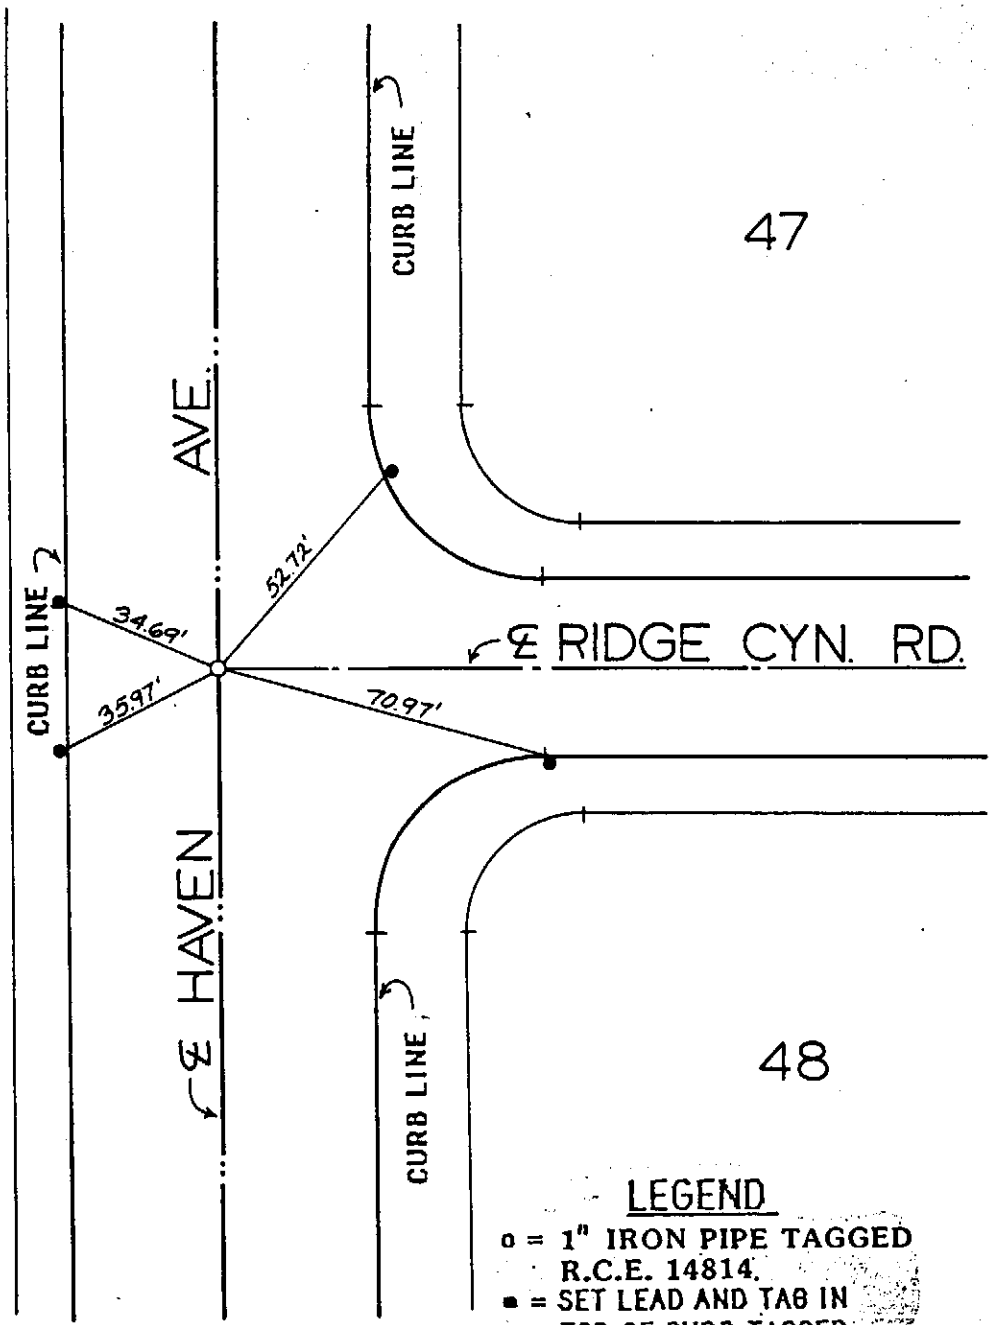

LEGEND

o = 1" IRON PIPE TAGGED R.C.E. 14814.

• = SET LEAD AND TAG IN TOP OF CURB TAGGED R.C.E. 14814.

SCALE 1"=40'

CITY OF RANCHO CUCAMONGA — STREET TIE	TRACT NO. 12650-1
MADOLE AND ASSOCIATES, INC. 1820 E. 16th Street SANTA ANA, CALIFORNIA 92701 PHONE 714 • 835-2548	**RIDGE CANYON RD.** AT HAVEN AVE.
ENGR. J.M. MADOLE	FIELD REVIEW _____ DATE _____
R.C.E. NO. 14814 DATE _____	TIE BOOK 15 PAGE 38

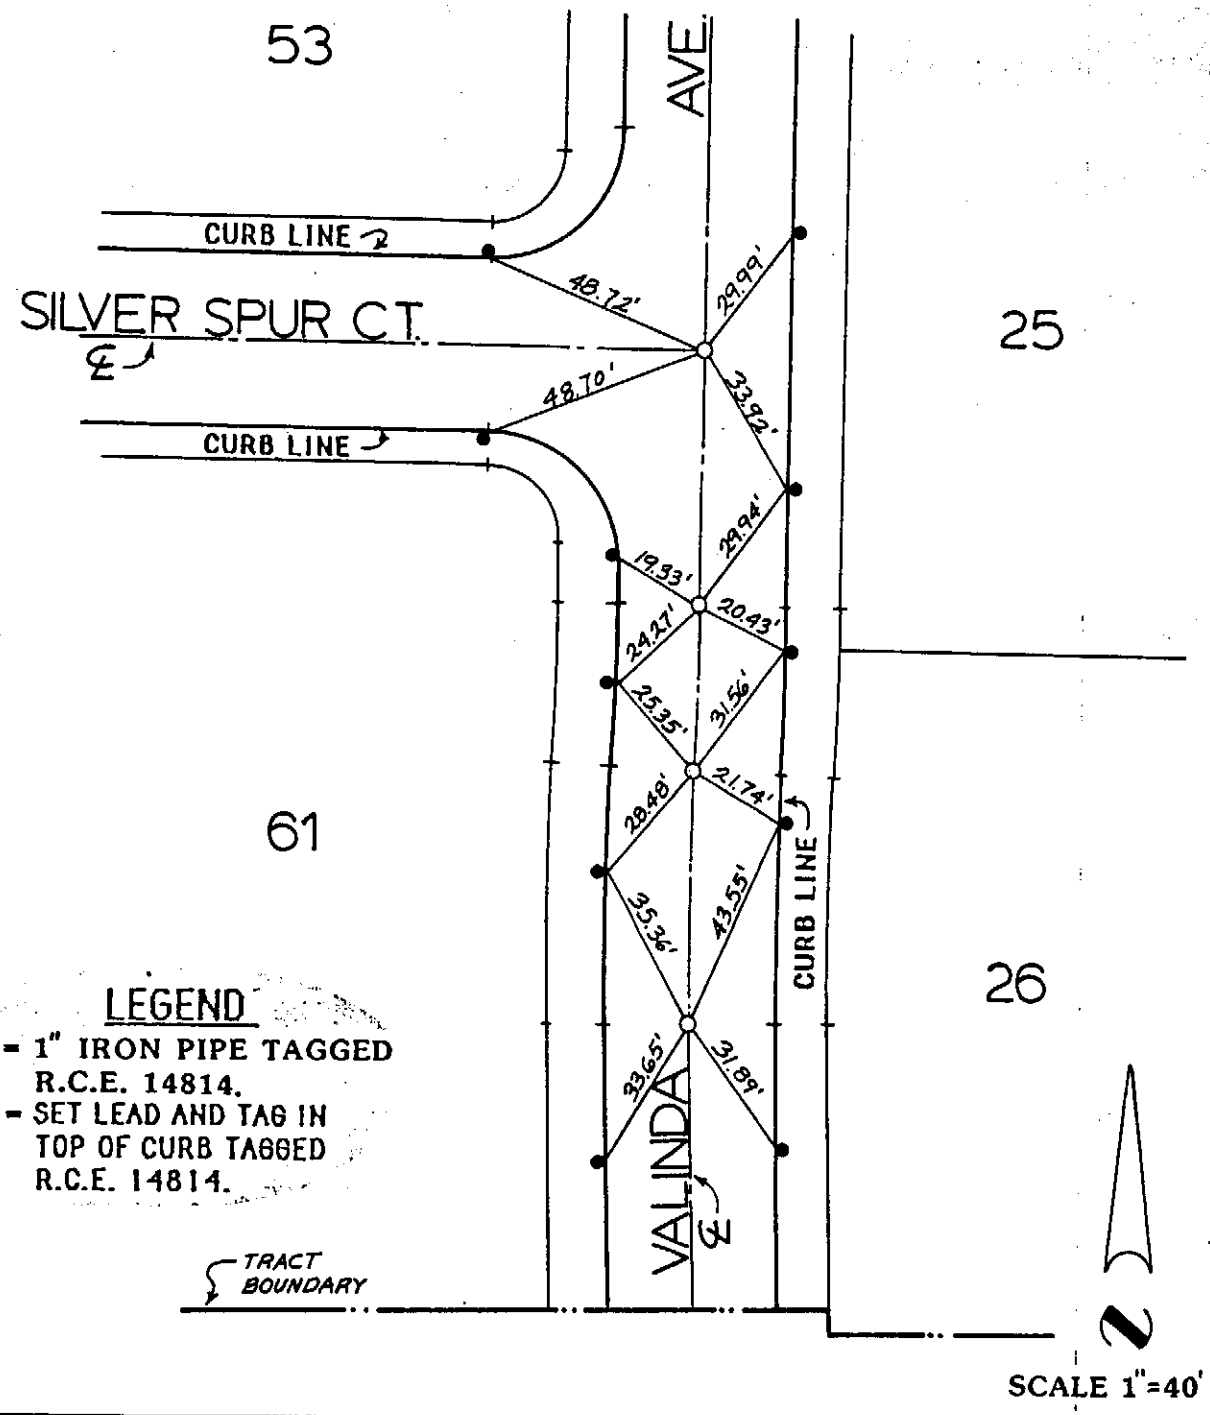

LEGEND

o = 1" IRON PIPE TAGGED R.C.E. 14814.

• = SET LEAD AND TAG IN TOP OF CURB TAGGED R.C.E. 14814.

CITY OF RANCHO CUCAMONGA — STREET TIE	TRACT NO. 12650-1
MADOLE AND ASSOCIATES, INC. 1820 E. 16th Street SANTA ANA, CALIFORNIA 92701 PHONE 714 • 835-2548	**VALINDA AVE.** AT SILVER SPUR CT.
ENGR. J.M. MADOLE	FIELD REVIEW _____ DATE _____
R.C.E. NO. 14814 DATE _____	TIE BOOK 15 PAGE 139

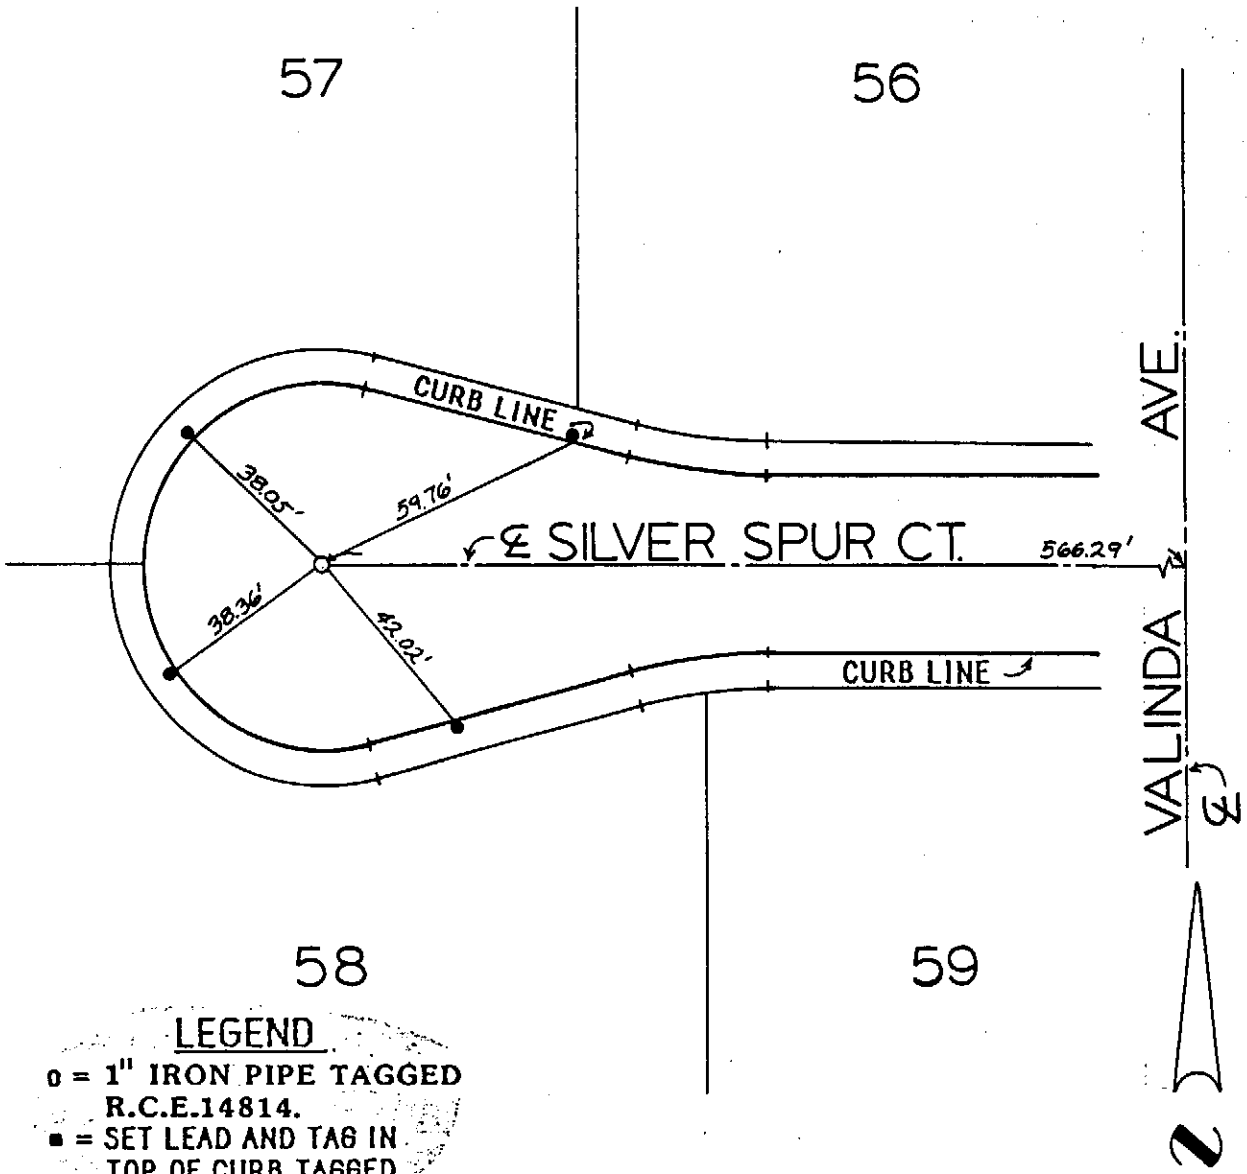

LEGEND

o = 1" IRON PIPE TAGGED R.C.E.14814.

■ = SET LEAD AND TAG IN TOP OF CURB TAGGED R.C.E. 14814.

SCALE 1"=40'

CITY OF RANCHO CUCAMONGA — STREET TIE	TRACT NO. 12650-1
MADOLE AND ASSOCIATES, INC. 1820 E. 16th Street SANTA ANA, CALIFORNIA 92701 PHONE 714 • 835-2548	**SILVER SPUR CT.** CUL-DE-SAC
ENGR. J.M. MADOLE	FIELD REVIEW _____ DATE _____
R.C.E. NO. 14814 DATE _____	TIE BOOK 15 PAGE 40

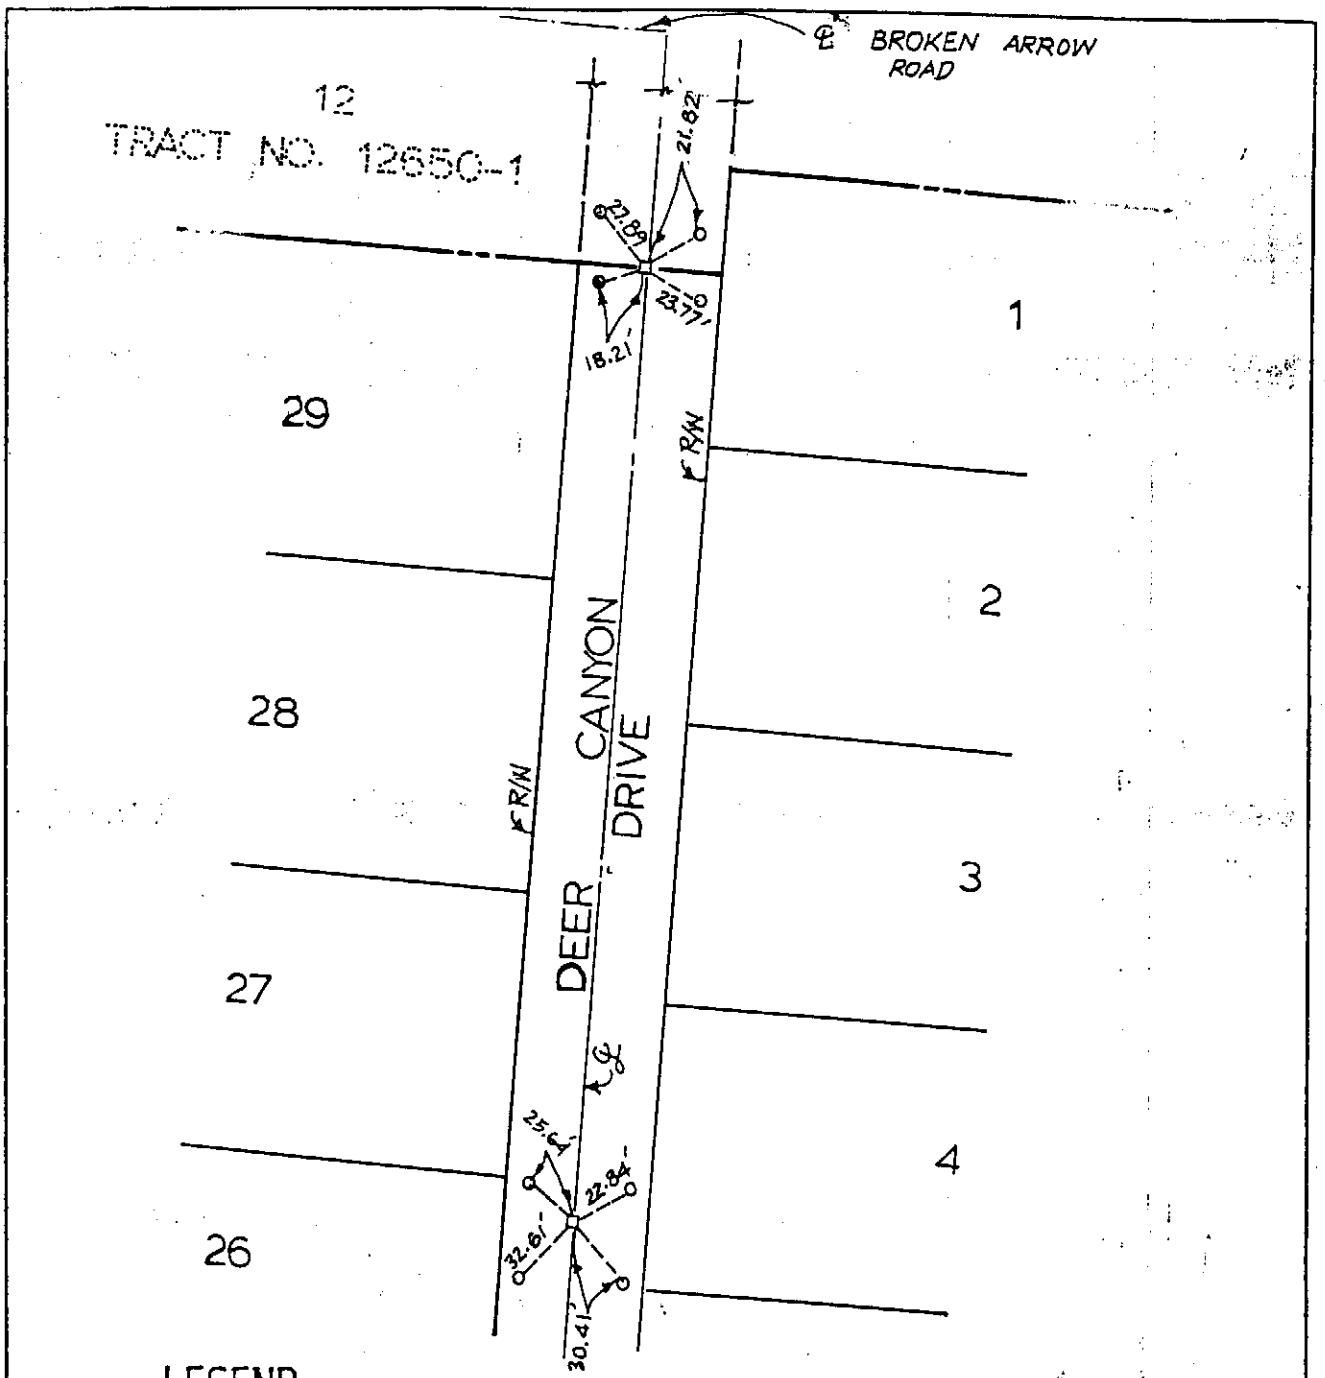

LEGEND

□ = 1" IRON PIPE TAGGED R.C.E.14814.

○ = SET LEAD AND TAG IN TOP OF CURB TAGGED R.C.E. 14814.

● = SET LEAD AND TACK

SCALE 1"=80'

CITY OF RANCHO CUCAMONGA STREET TIE	TRACT NO. 12650-3
MADOLE AND ASSOCIATES, INC. 1820 E. 16th Street SANTA ANA, CALIFORNIA 92701 PHONE 714 • 835-2548	DEER CANYON DRIVE E/O BROKEN ARROW RD.
ENGR. J.M. MADOLE	FIELD REVIEW _____ DATE _____
R.C.E. NO. 14814 DATE _____	TIE BOOK 15 PAGE 41

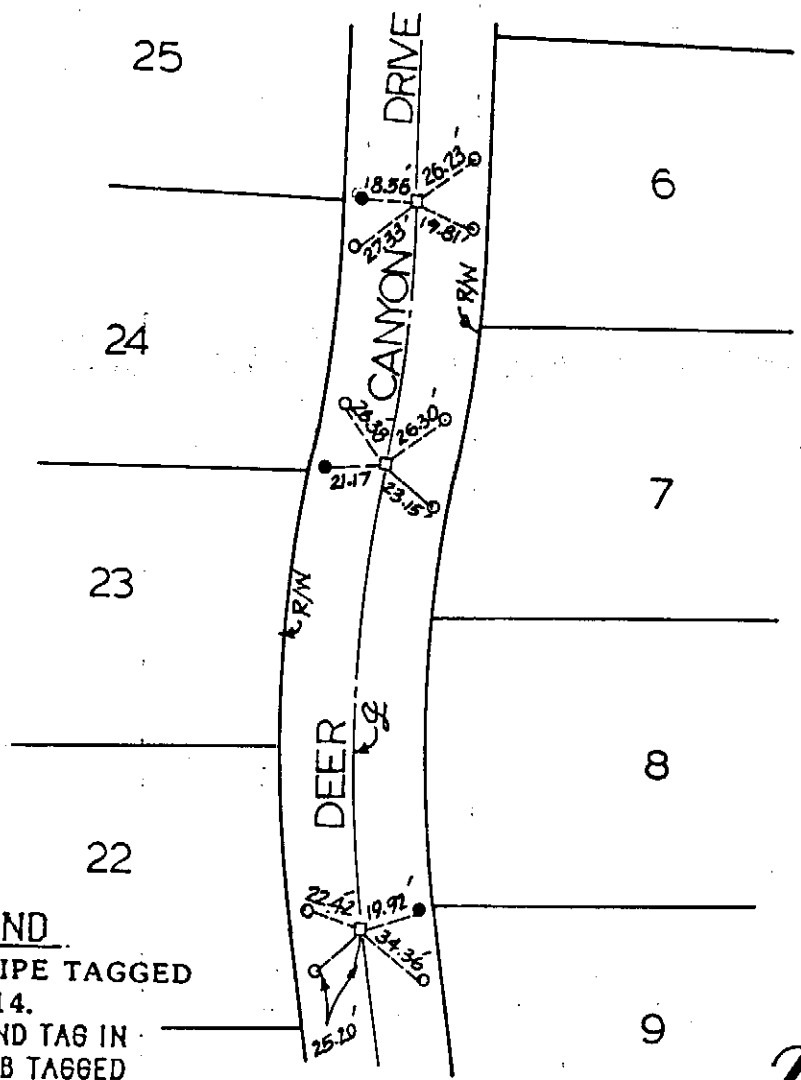

LEGEND

□ = 1" IRON PIPE TAGGED R.C.E.14814.

○ = SET LEAD AND TAG IN TOP OF CURB TAGGED R.C.E. 14814.

● = SET LEAD AND TACK

SCALE 1"=80'

CITY OF RANCHO CUCAMONGA — STREET TIE	TRACT NO. 12650-3
MADOLE AND ASSOCIATES, INC. 1820 E. 16th Street SANTA ANA, CALIFORNIA 92701 PHONE 714 • 835-2548	DEER CANYON DRIVE E/O BROKEN ARROW RD.
ENGR. J.M. MADOLE	FIELD REVIEW _____ DATE _____
R.C.E. NO. 14814 DATE _____	TIE BOOK 15 PAGE 42

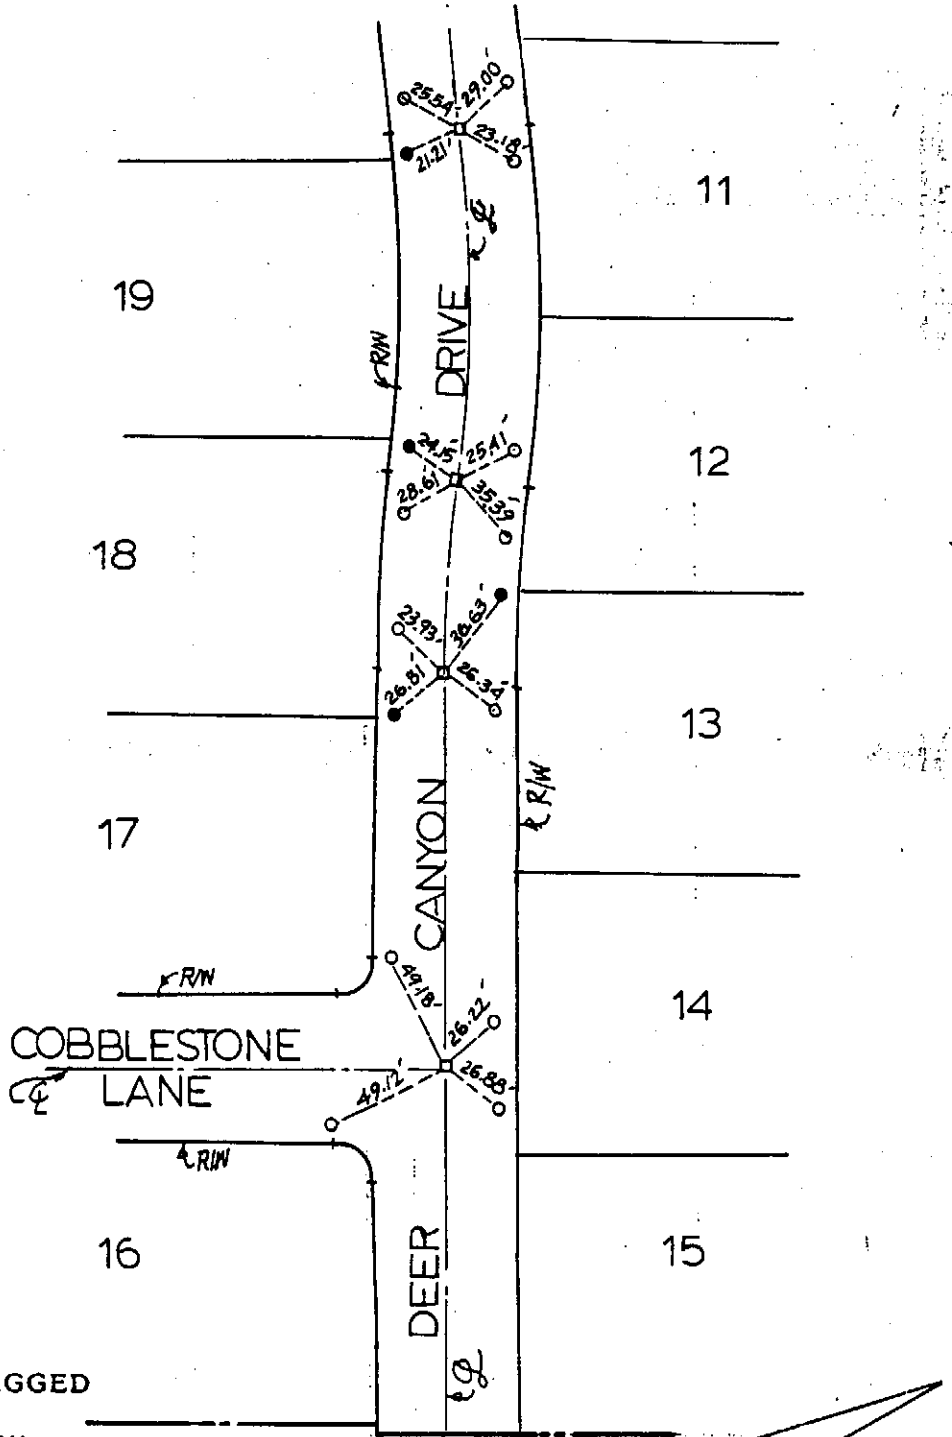

LEGEND

□ = 1" IRON PIPE TAGGED R.C.E.14814.

○ = SET LEAD AND TAG IN TOP OF CURB TAGGED R.C.E. 14814.

● = SET LEAD AND TACK

TRACT NO. 12650-1

SCALE 1"=80'

CITY OF RANCHO CUCAMONGA STREET TIE	TRACT NO. 12650-3
MADOLE AND ASSOCIATES, INC. 1820 E. 16th Street SANTA ANA, CALIFORNIA 92701 PHONE 714 • 835-2548	DEER CANYON DRIVE AT COBBLESTONE LN.
ENGR. J.M. MADOLE	FIELD REVIEW _____ DATE _____
R.C.E. NO. 14814 DATE _____	TIE BOOK 15 PAGE 43

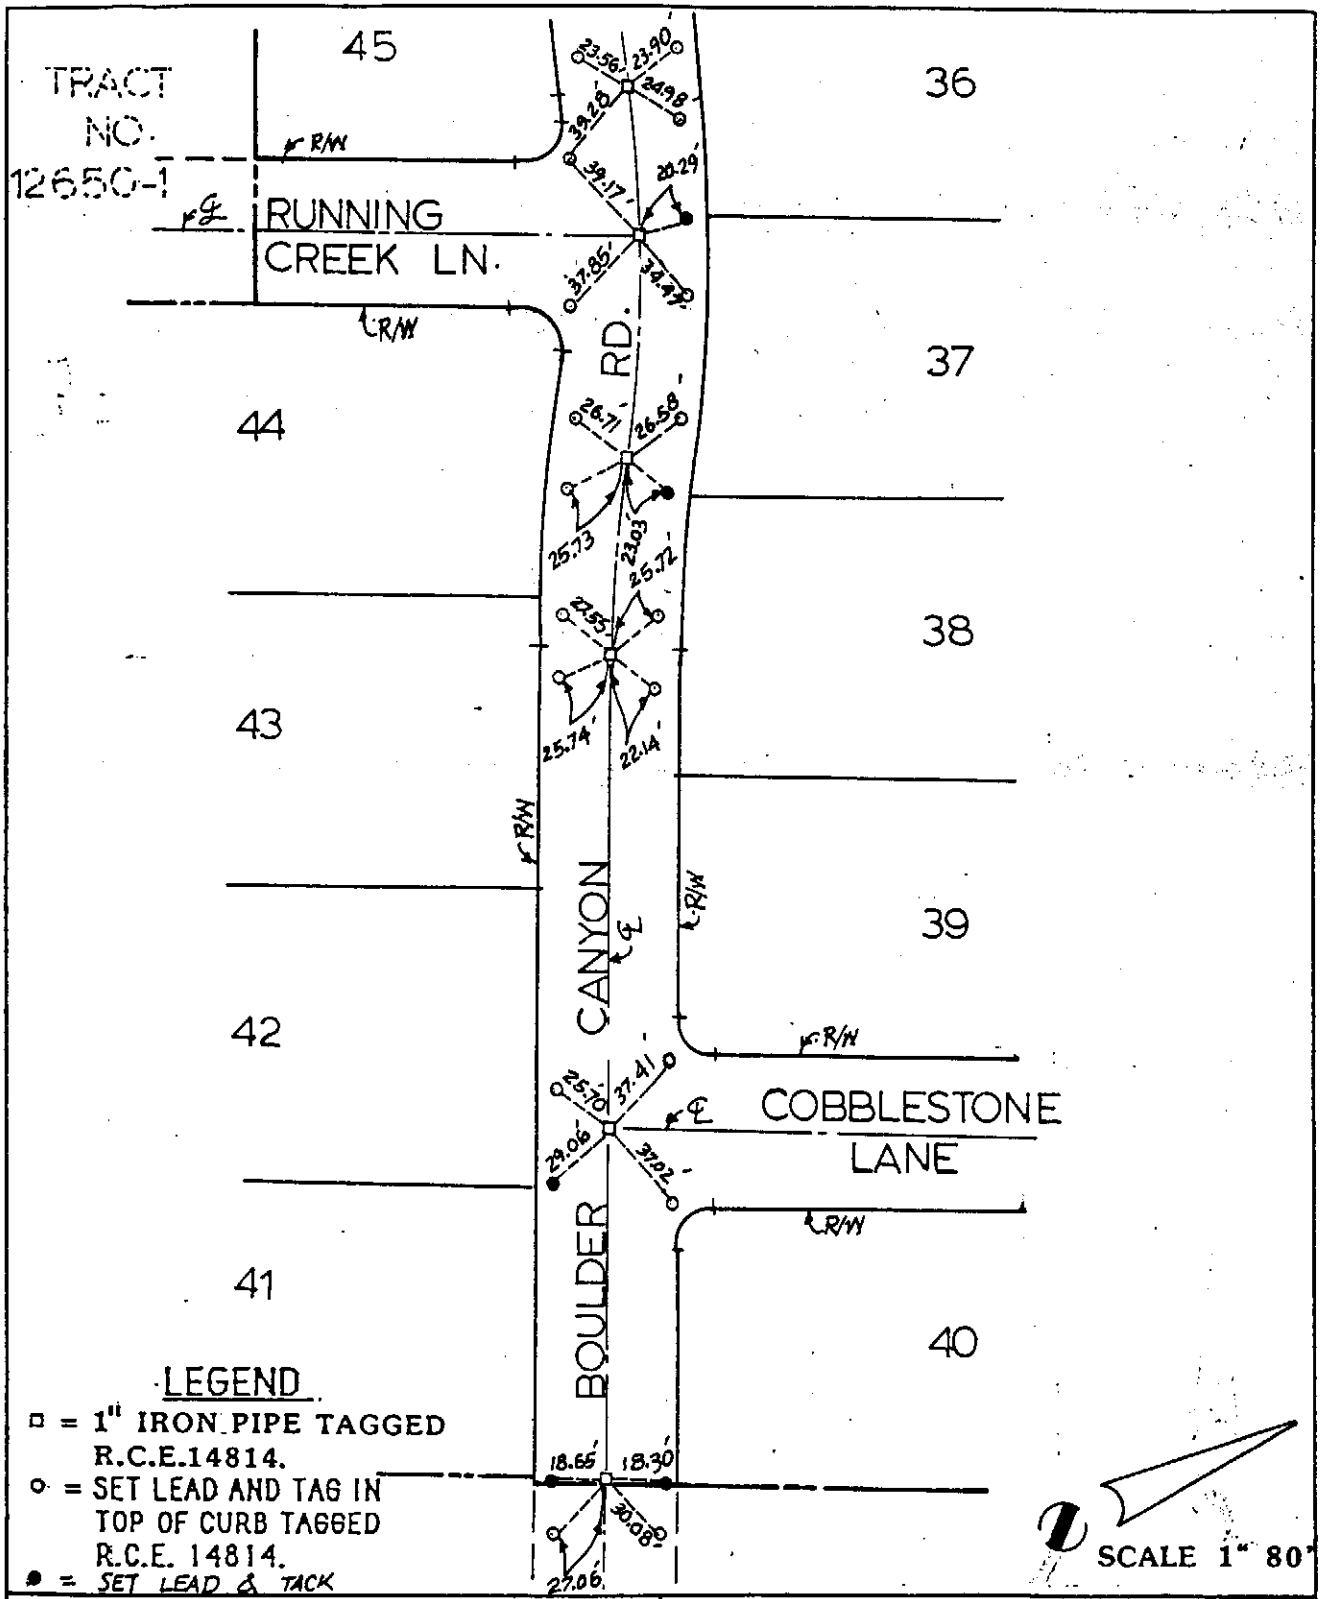

CITY OF RANCHO CUCAMONGA — STREET TIE	TRACT NO. 12650-3
MADOLE AND ASSOCIATES, INC. 1820 E. 16th Street SANTA ANA, CALIFORNIA 92701 PHONE 714 • 835-2548	BOULDER CANYON Rd. AT RUNNING CREEK LN.
ENGR. J.M. MADOLE	FIELD REVIEW _____ DATE _____
R.C.E. NO. 14814 DATE _____	TIE BOOK 15 PAGE 44

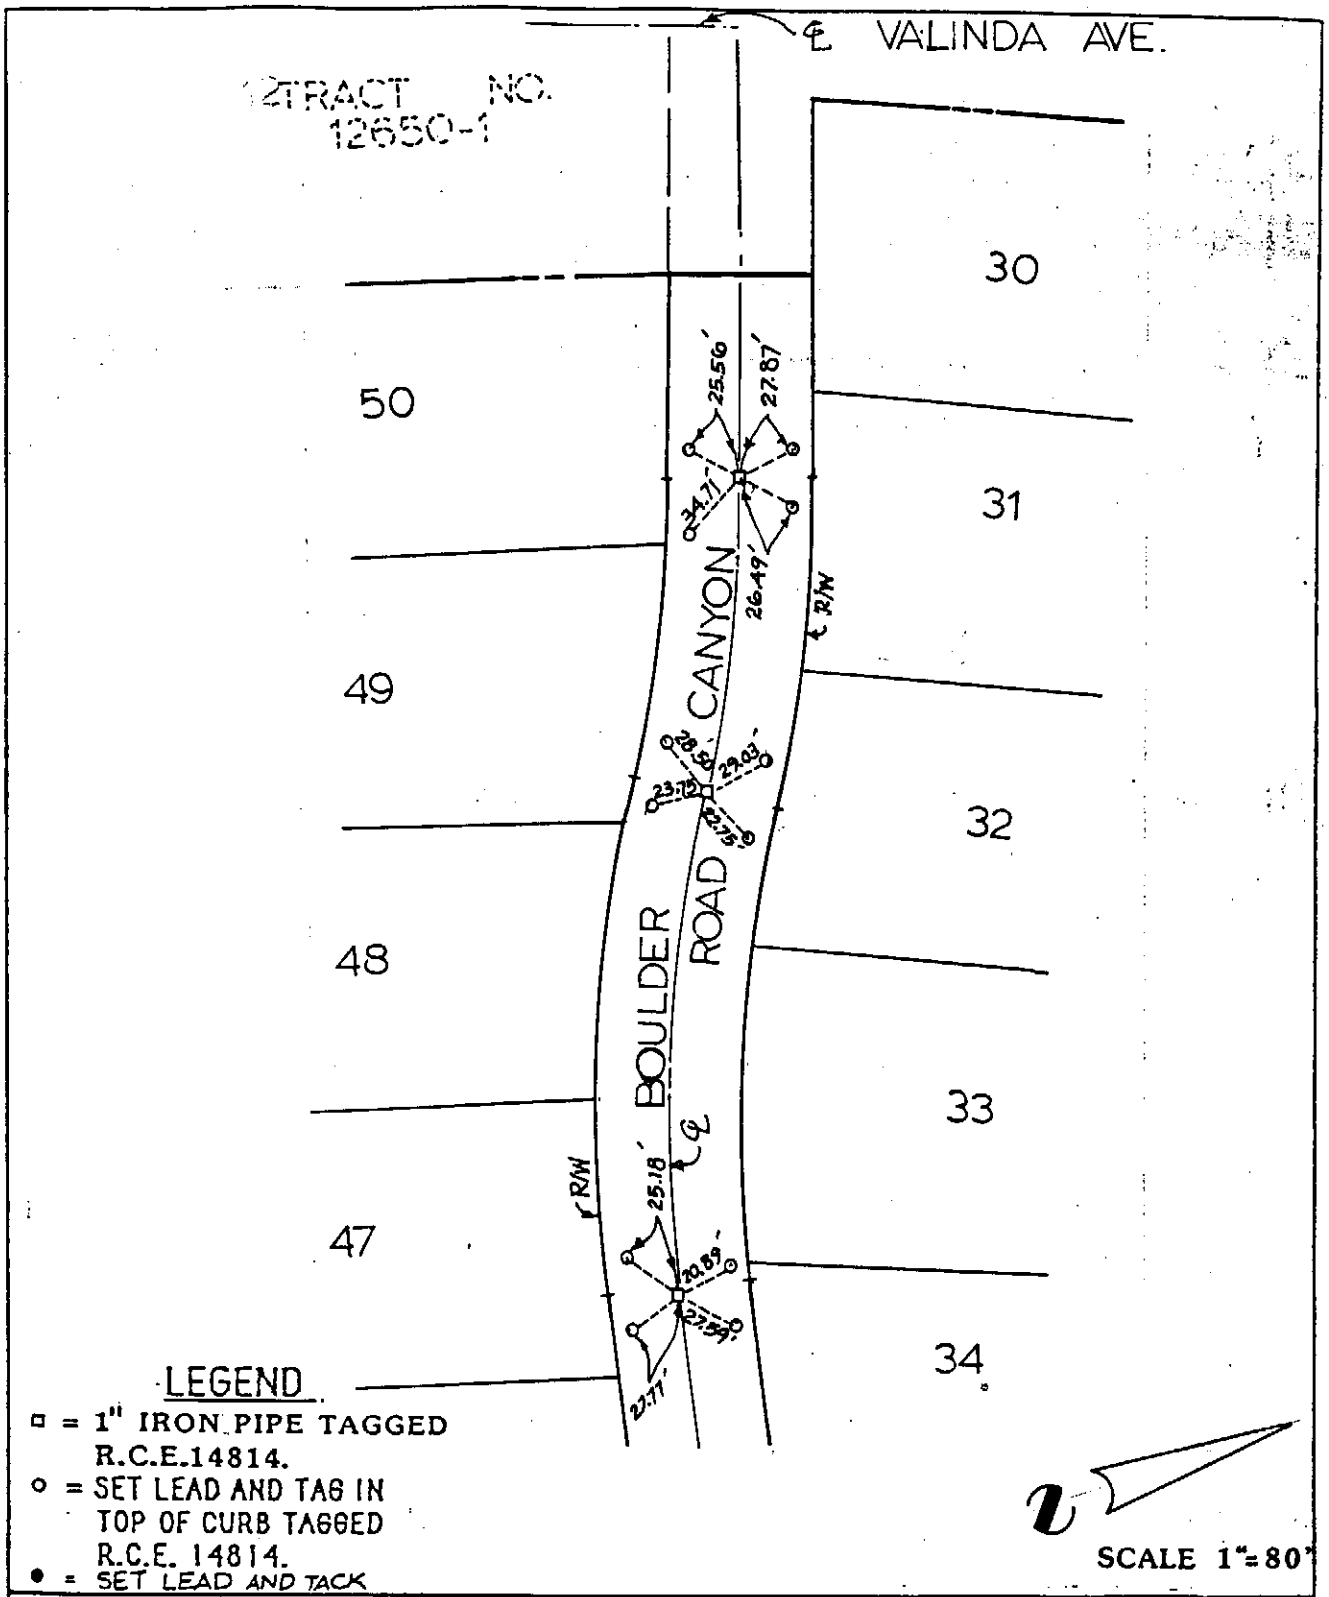

CITY OF RANCHO CUCAMONGA — STREET TIE	TRACT NO. 12650-3
MADOLE AND ASSOCIATES, INC. 1820 E. 16th Street SANTA ANA, CALIFORNIA 92701 PHONE 714 • 835-2548	BOULDER CANYON RD. W/O VALINDA AVE.
ENGR. J.M. MADOLE	FIELD REVIEW _____ DATE _____
R.C.E. NO. 14814 DATE _____	TIE BOOK 15 PAGE 45

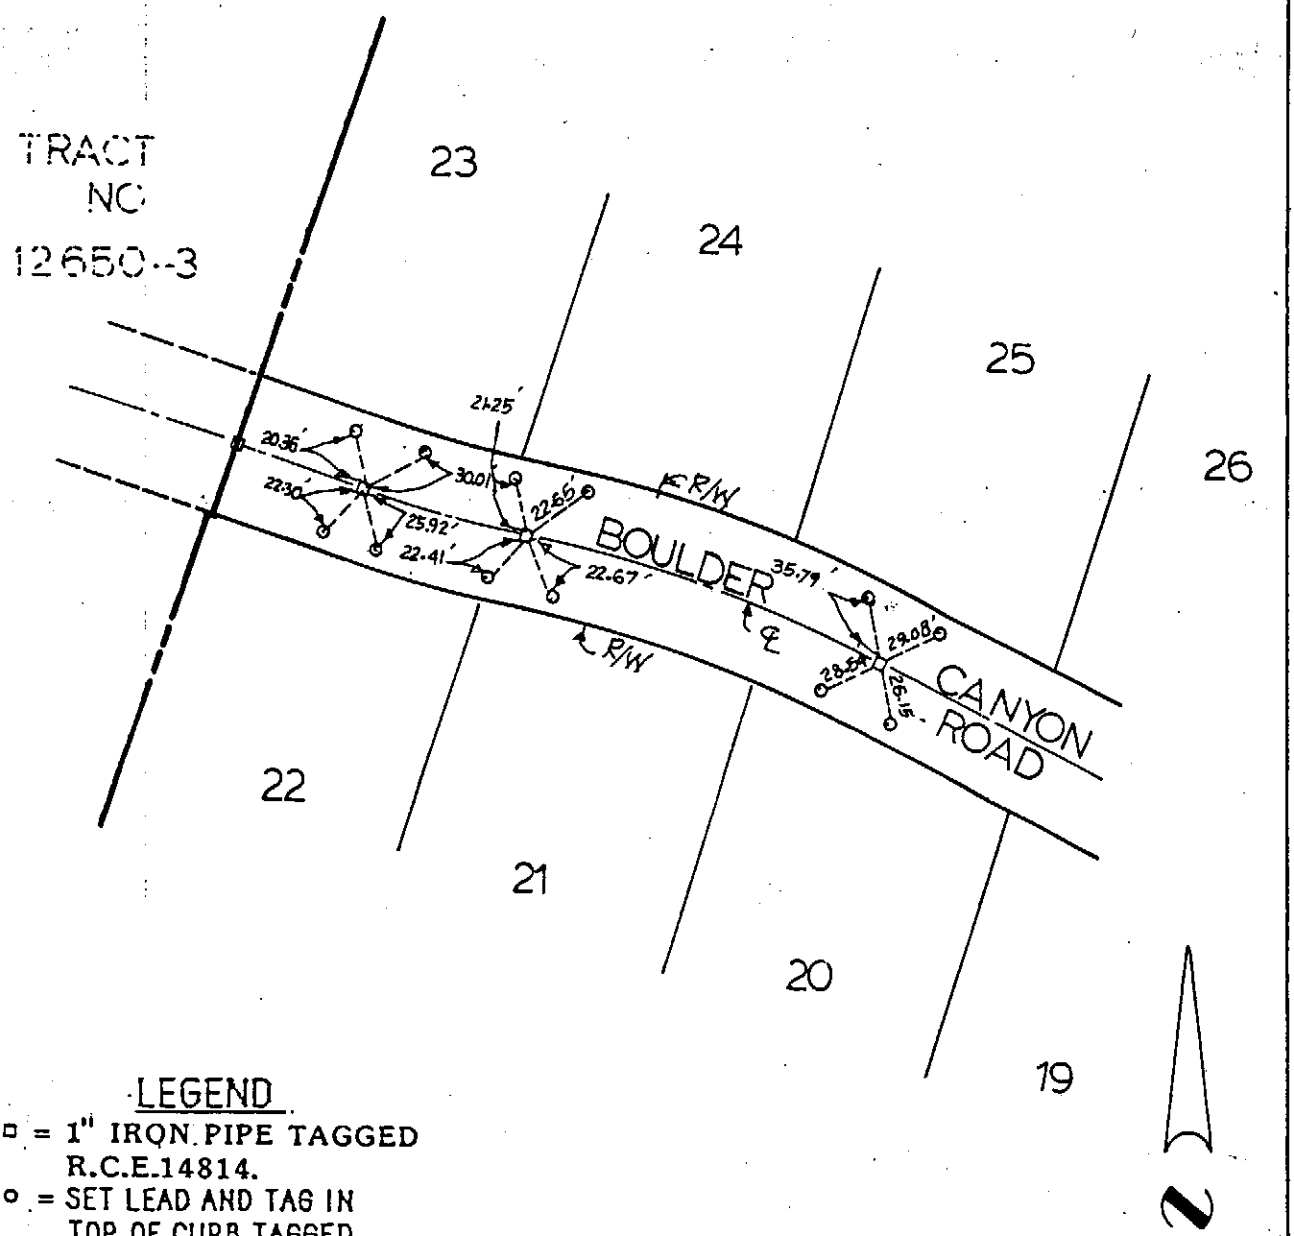

LEGEND

□ = 1" IRON PIPE TAGGED R.C.E.14814.

○ = SET LEAD AND TAG IN TOP OF CURB TAGGED R.C.E. 14814.

● = SET LEAD AND TACK

SCALE 1"=80'

CITY OF RANCHO CUCAMONGA — STREET TIE	TRACT NO. 12650-4
MADOLE AND ASSOCIATES, INC. 1820 E. 16th Street SANTA ANA, CALIFORNIA 92701 PHONE 714 • 835-2548	BOULDER CANYON RD. E/O COBBLESTONE LN.
ENGR. J.M. MADOLE	FIELD REVIEW _____ DATE _____
R.C.E. NO. 14814 DATE _____	TIE BOOK 15 PAGE 46

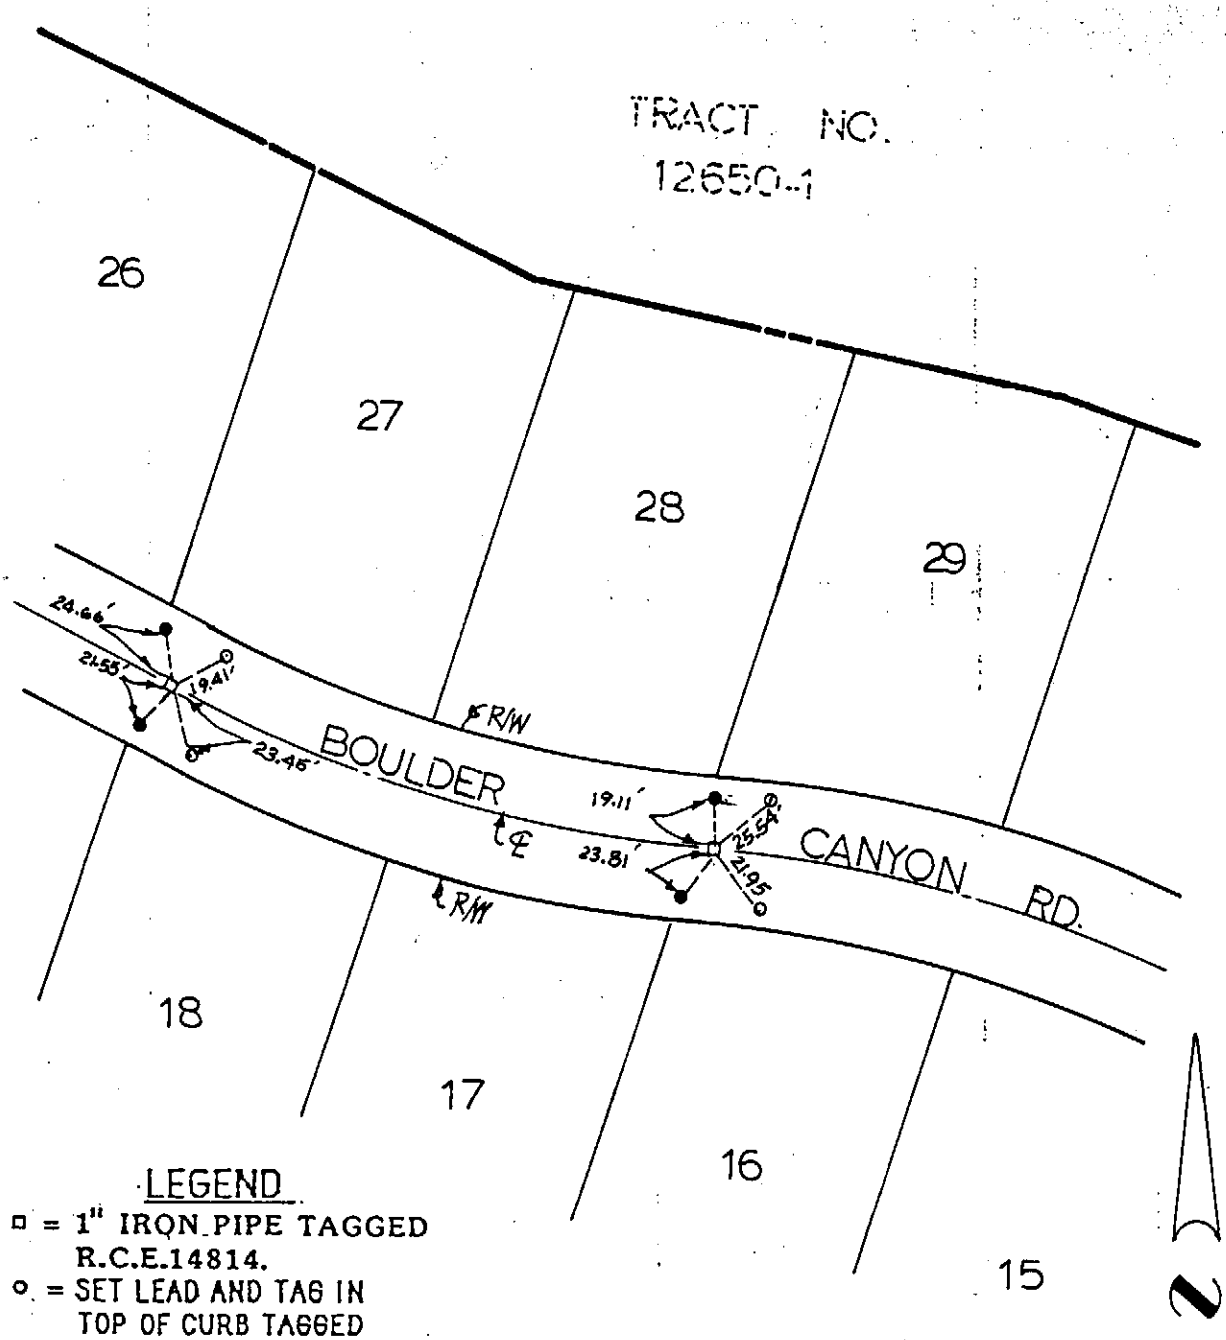

LEGEND

□ = 1" IRON PIPE TAGGED R.C.E.14814.

○ = SET LEAD AND TAG IN TOP OF CURB TAGGED R.C.E. 14814.

● = SET LEAD AND TACK

SCALE 1"=80'

CITY OF RANCHO CUCAMONGA — STREET TIE	TRACT NO. 12650-4
MADOLE AND ASSOCIATES, INC. 1820 E. 16th Street SANTA ANA, CALIFORNIA 92701 PHONE 714 • 835-2548	BOULDER CANYON RD. E/O COBBLESTONE LN.
ENGR. J.M. MADOLE	FIELD REVIEW _____ DATE _____
R.C.E. NO. 14814 DATE _____	TIE BOOK 15 PAGE 47

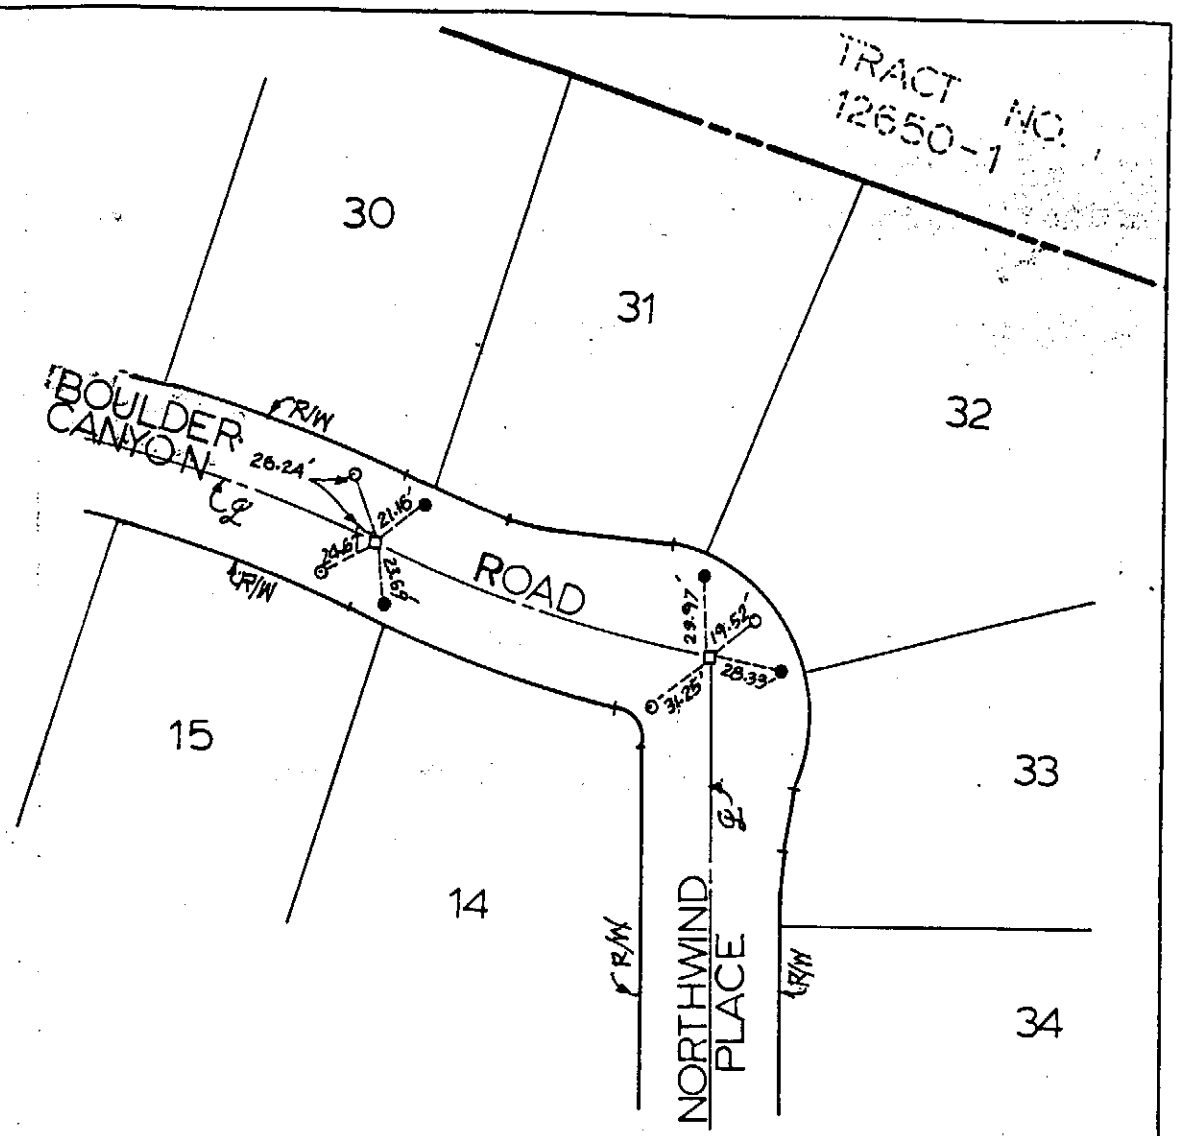

LEGEND

□ = 1" IRON PIPE TAGGED R.C.E.14814.

○ = SET LEAD AND TAG IN TOP OF CURB TAGGED R.C.E. 14814.

● = SET LEAD AND TACK

SCALE 1"=80'

CITY OF RANCHO CUCAMONGA STREET TIE	TRACT NO. 12650-4
MADOLE AND ASSOCIATES, INC. 1820 E. 16th Street SANTA ANA, CALIFORNIA 92701 PHONE 714 • 835-2548	BOULDER CANYON RD. AT NORTHWIND PL.
ENGR. J.M. MADOLE	FIELD REVIEW _____ DATE _____
R.C.E. NO. 14814 DATE _____	TIE BOOK 15 PAGE 48

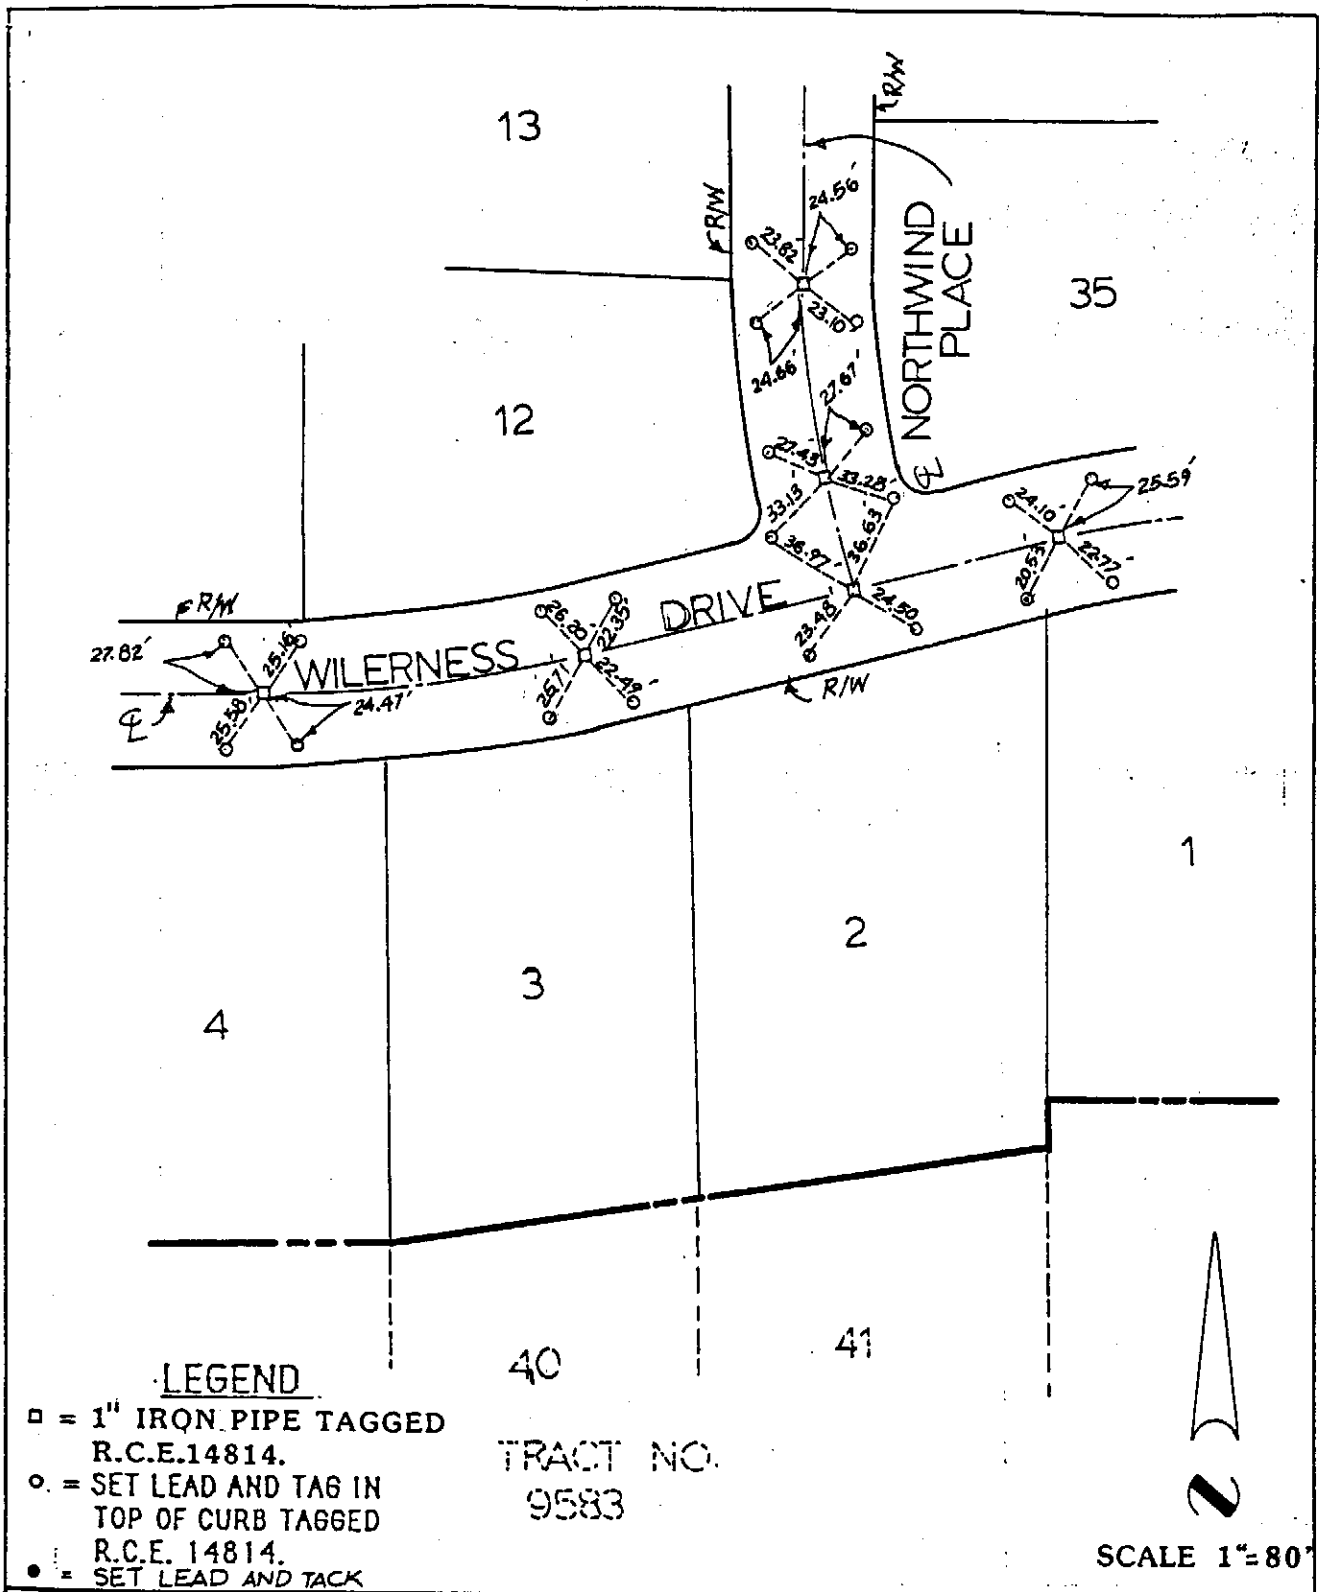

LEGEND

□ = 1" IRON PIPE TAGGED R.C.E.14814.

○ = SET LEAD AND TAG IN TOP OF CURB TAGGED R.C.E. 14814.

● = SET LEAD AND TACK

CITY OF RANCHO CUCAMONGA — STREET TIE	TRACT NO. 12650-4
MADOLE AND ASSOCIATES, INC. 1820 E. 16th Street SANTA ANA, CALIFORNIA 92701 PHONE 714 • 835-2548	WILDERNESS DRIVE AT NORTHWIND PL.
ENGR. J.M. MADOLE	FIELD REVIEW _____ DATE _____
R.C.E. NO. 14814 DATE _____	TIE BOOK 15 PAGE 49

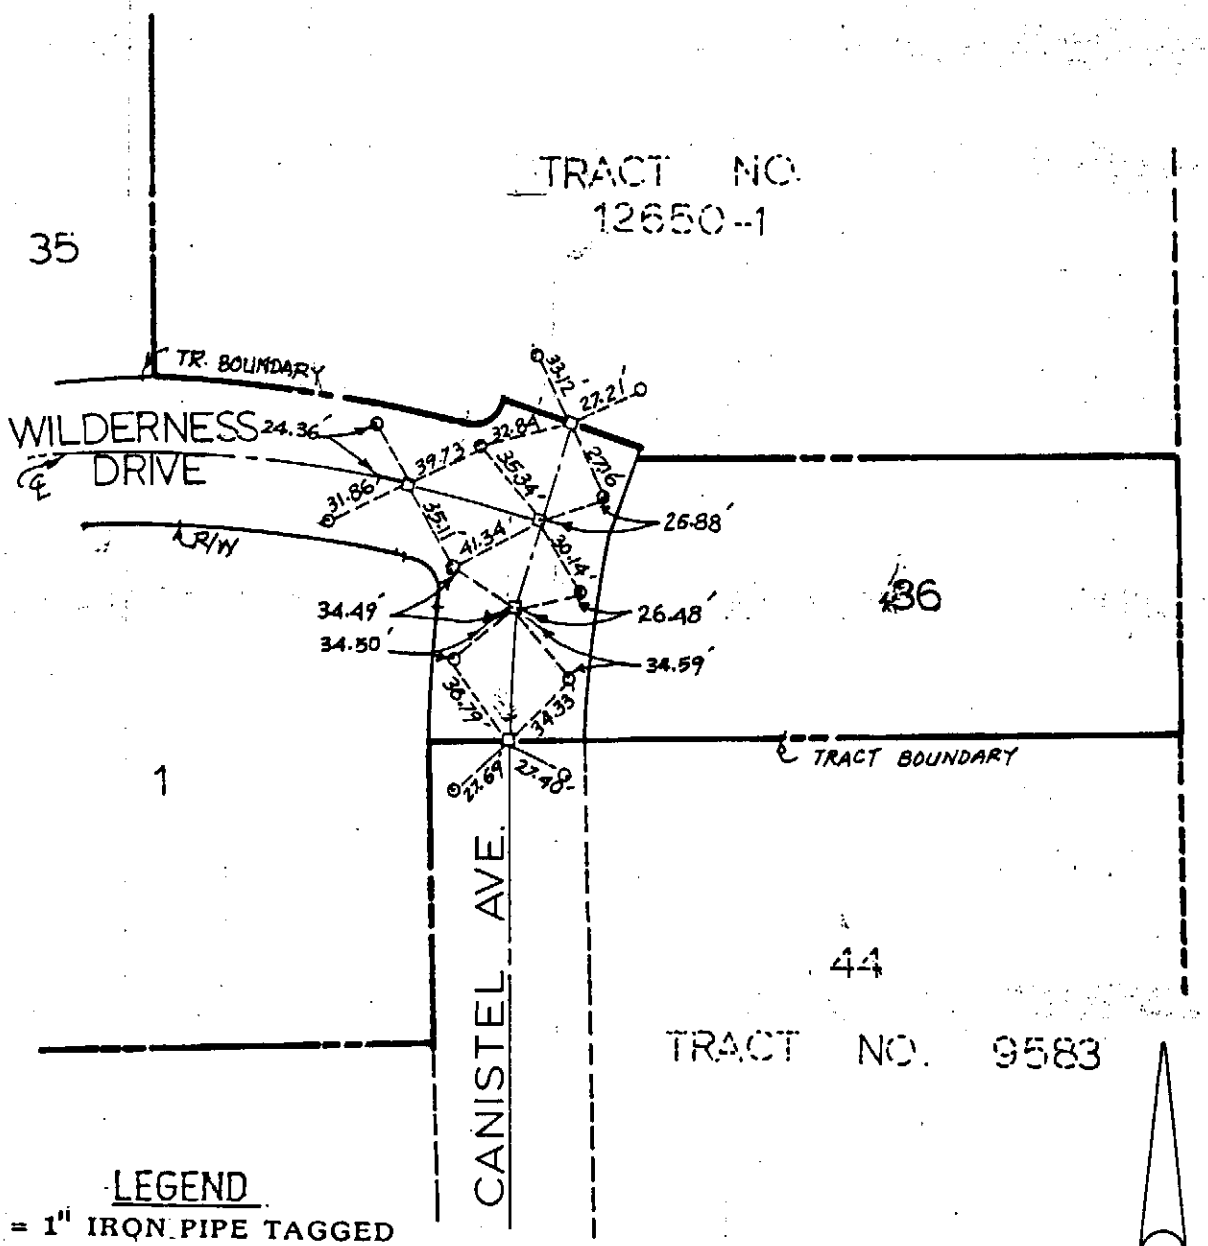

LEGEND

□ = 1" IRON PIPE TAGGED R.C.E.14814.

○ = SET LEAD AND TAG IN TOP OF CURB TAGGED R.C.E. 14814.

● = SET LEAD AND TACK

SCALE 1"=80'

CITY OF RANCHO CUCAMONGA — STREET TIE	TRACT NO. 12650-4
MADOLE AND ASSOCIATES, INC. 1820 E. 16th Street SANTA ANA, CALIFORNIA 92701 PHONE 714 • 835-2548	WILDERNESS DRIVE AT CANISTEL AVE.
ENGR. J.M. MADOLE	FIELD REVIEW _____ DATE _____
R.C.E. NO. 14814 DATE _____	TIE BOOK 15 PAGE 50

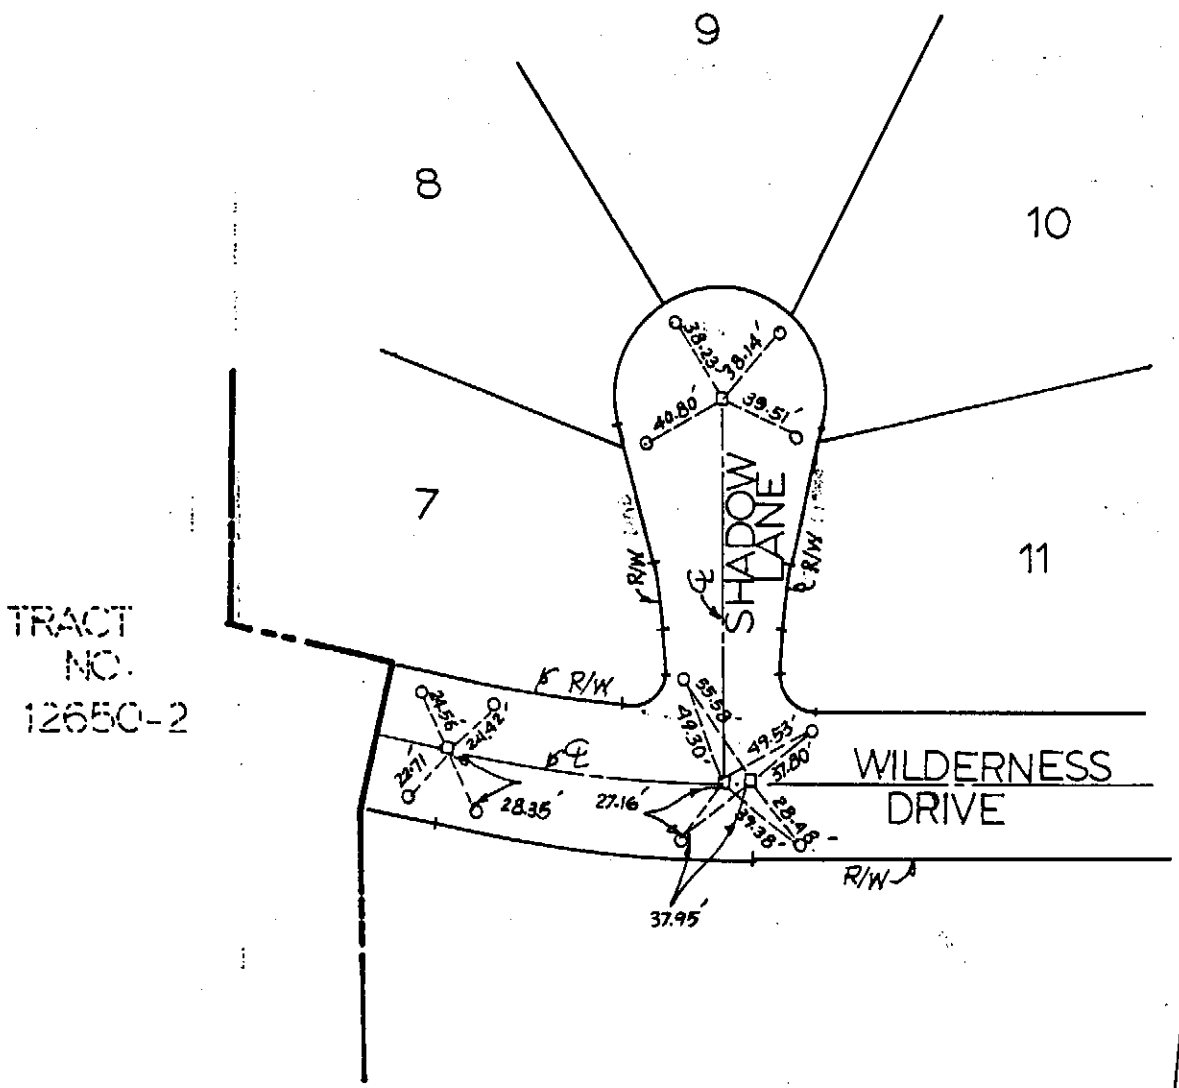

LEGEND

□ = 1" IRON PIPE TAGGED R.C.E.14814.

○ = SET LEAD AND TAG IN TOP OF CURB TAGGED R.C.E. 14814.

● = SET LEAD AND TACK

SCALE 1"=80'

CITY OF RANCHO CUCAMONGA — STREET TIE	TRACT NO. 12650-4
MADOLE AND ASSOCIATES, INC. 1820 E. 16th Street SANTA ANA, CALIFORNIA 92701 PHONE 714 • 835-2548	SHADOW LANE CUL-DE-SAC
ENGR. J.M. MADOLE	FIELD REVIEW _____ DATE _____
R.C.E. NO. 14814 DATE _____	TIE BOOK 15 PAGE 51

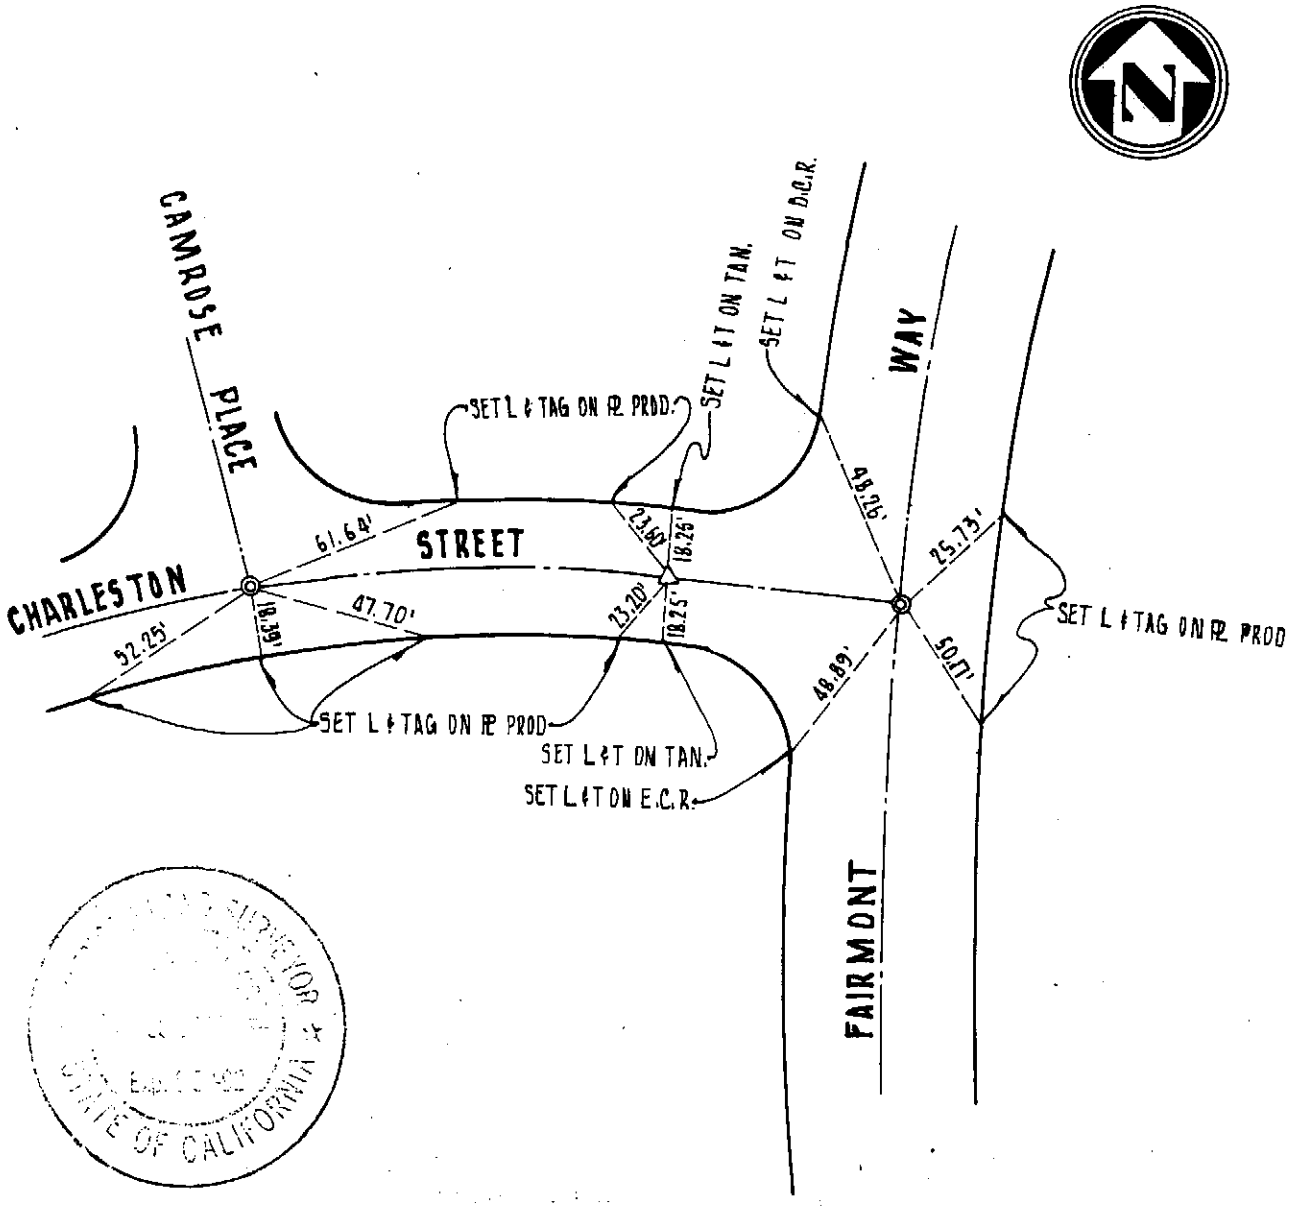

△ INDICATES 8" SPIKE & WASHER L.S. 5390 FLUSH.

◎ INDICATES SET 4 PUNCH MARKS IN M.U. RIM

city of rancho cucamonga — STREET TIE	**TRACT NO. 13058**
ADKAN ENGINEERS 6830 AIRPORT DRIVE RIVERSIDE, CA. 92504 (714)688-0241 CIVIL ENGINEERING, PLANNING, LAND SURVEYING	CAMROSE PLACE & CHARLESTON STREET & FAIRMONT WAY
~~ENGR.~~/L.S.	FIELD REVIEW _____ DATE _____
R.C.E./L.S. NO. 5390 DATE 2/5/90	TIE BOOK 15 PAGE 52

3228

◉ SET PUNCH MARKS ON SEWER M.H.
△ INDICATES 8" SPIKE AND WASHER L.S. 5390, FLUSH

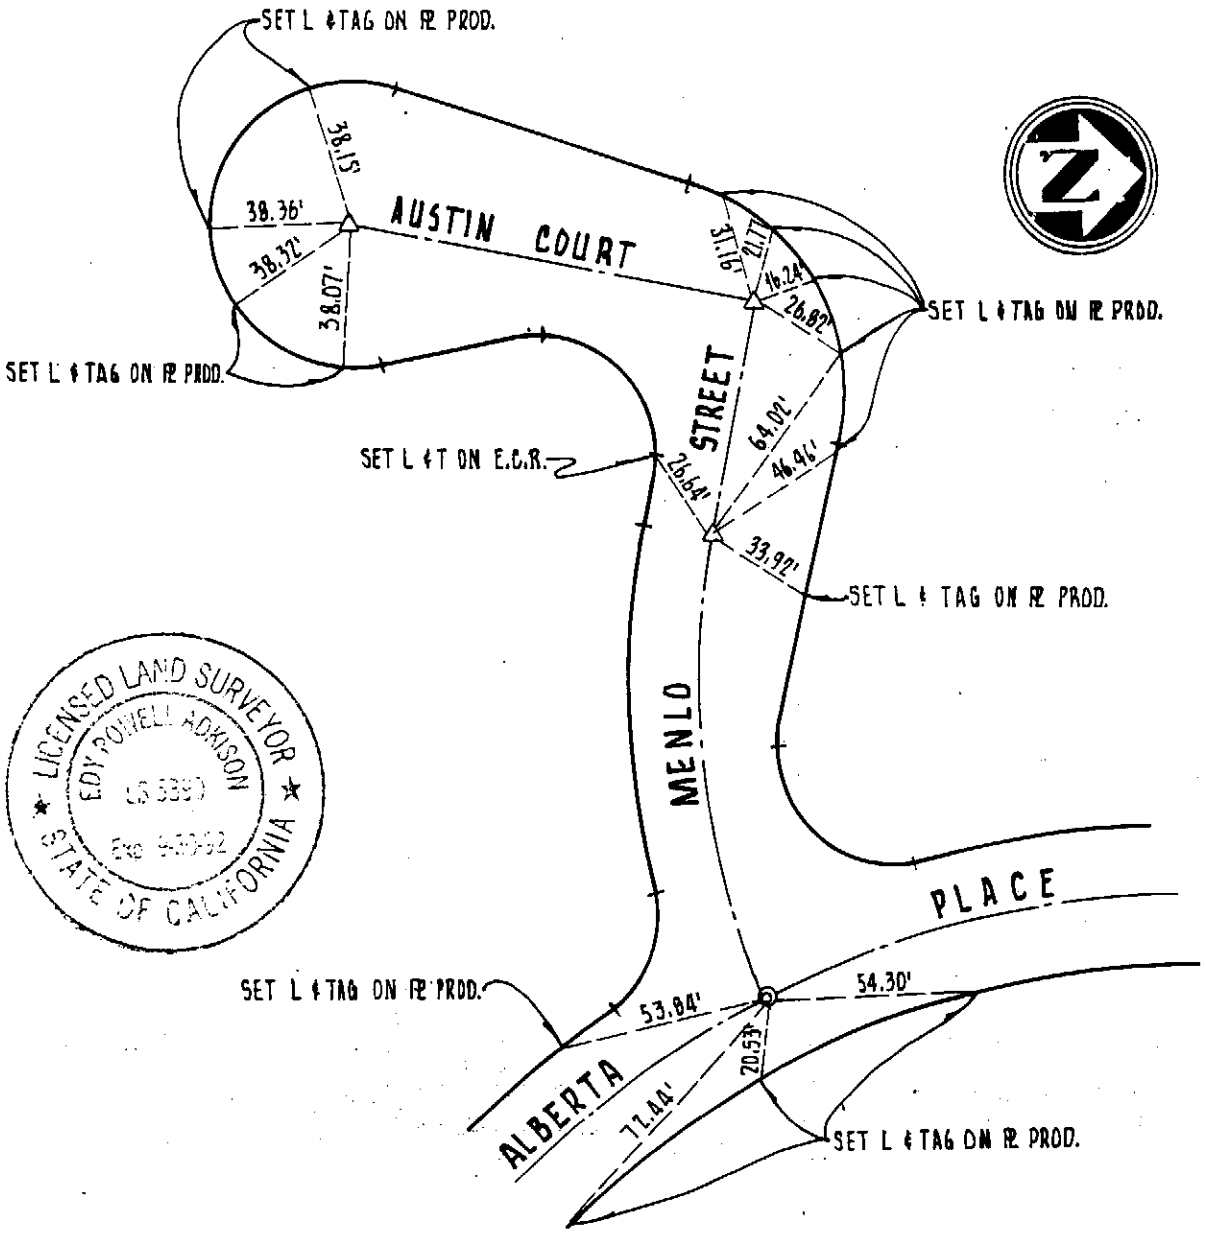

city of rancho cucamonga — STREET TIE	**TRACT NO. 13058**
ADKAN ENGINEERS 6830 AIRPORT DRIVE RIVERSIDE, CA. 92504 (714)688-0241 CIVIL ENGINEERING, PLANNING, LAND SURVEYING	AUSTIN COURT & MENLO STREET ALBERTA PLACE
~~ENGR~~./L.S. Edy Adkison	FIELD REVIEW _____ DATE _____
~~R.C.E.~~/L.S. NO. 5390 DATE 2/5/90	TIE BOOK 15 PAGE 53

3228

◉ SET PUNCH MARKS ON SEWER M.H.
△ INDICATES 8" SPIKE AND WASHER L.S. 5390, FLUSH

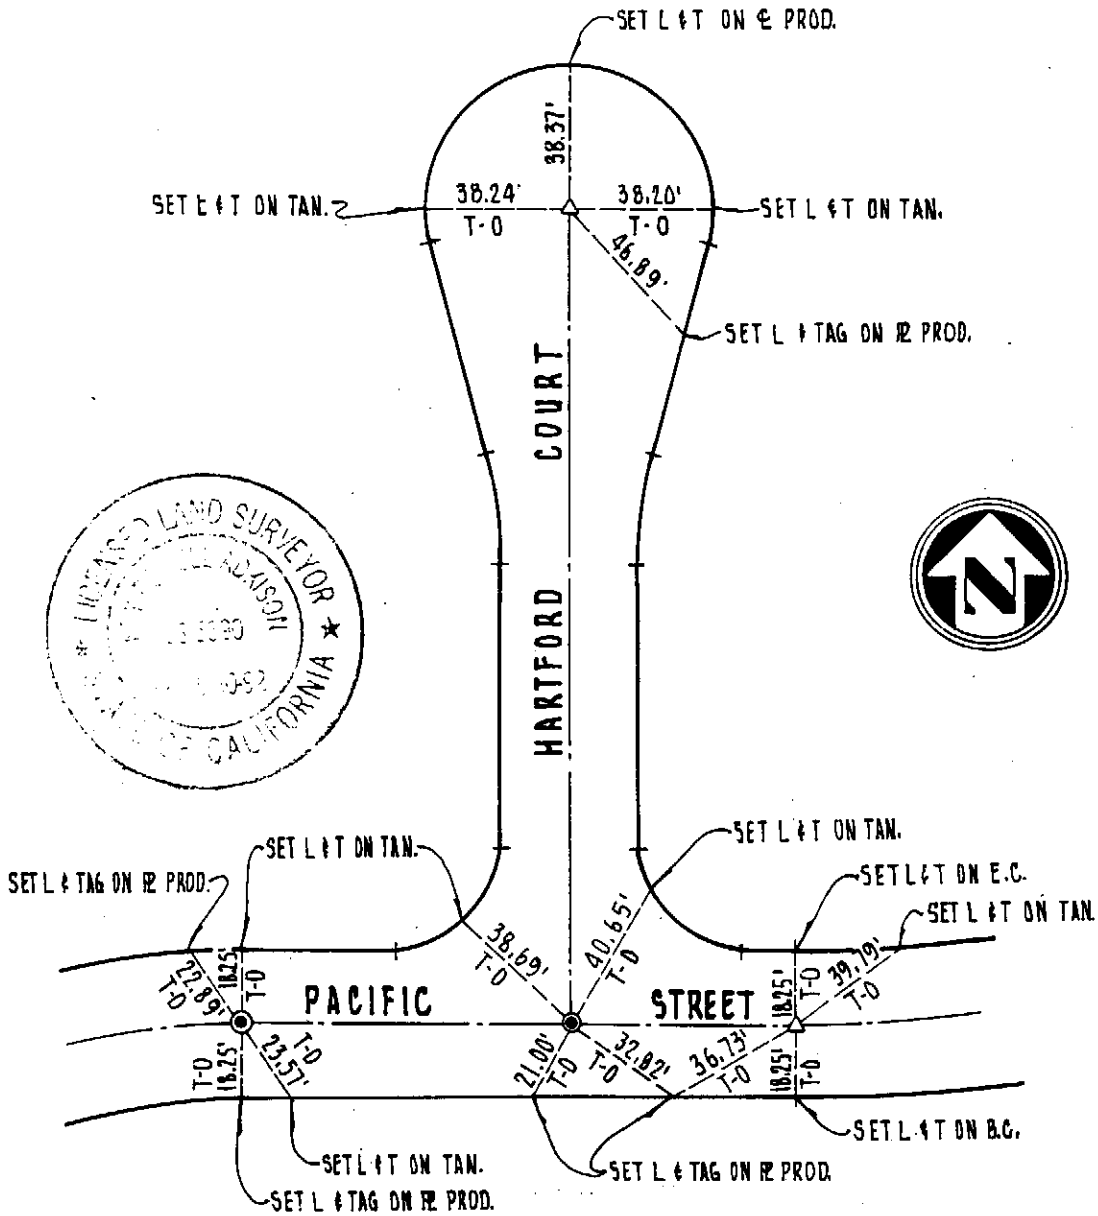

city of rancho cucamonga — STREET TIE	**TRACT NO. 13058**
ADKAN ENGINEERS 6830 AIRPORT DRIVE RIVERSIDE, CA. 92504 (714)688-0241 CIVIL ENGINEERING, PLANNING, LAND SURVEYING	PACIFIC STREET & HARTFORD COURT
~~ENGR.~~/L.S.	FIELD REVIEW _____ DATE _____
~~R.C.E.~~/L.S. NO. 5390 DATE 2/5/90	TIE BOOK 15 PAGE 54

3228

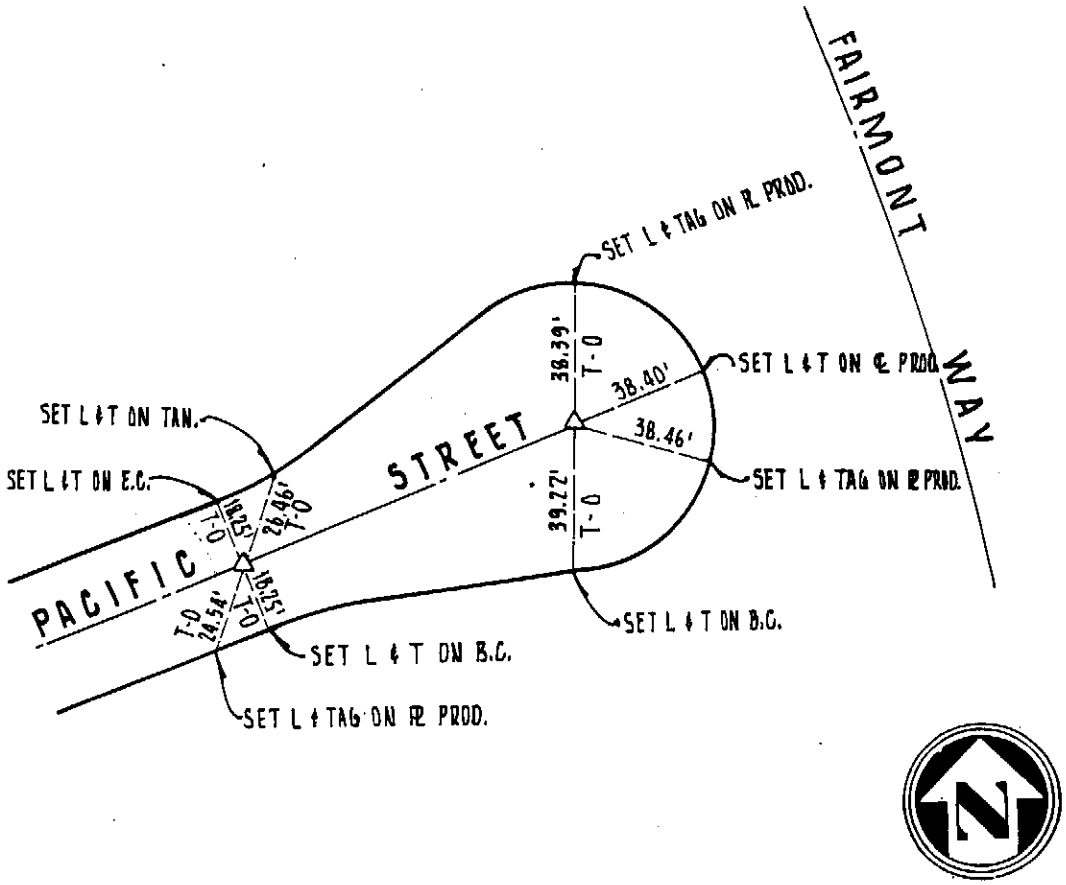

△ INDICATES 8" SPIKE & WASHER TAGGED L.S. 5390, FLUSH

LICENSED LAND SURVEYOR
EDY POWELL ADKISON
LS 5390
Exp. 9-30-92
STATE OF CALIFORNIA

city of rancho cucamonga — STREET TIE	**TRACT NO. 13058**
ADKAN ENGINEERS 6830 AIRPORT DRIVE RIVERSIDE, CA. 92504 (714)688-0241 CIVIL ENGINEERING, PLANNING, LAND SURVEYING	PACIFIC STREET
~~ENGR.~~/L.S. [signature]	FIELD REVIEW _____ DATE _____
~~R.C.E.~~/L.S. NO. 5390 DATE 2/5/90	TIE BOOK 15 PAGE 55

3228

△ INDICATES 8" SPIKE & WASHER L.S. 5390 , FLUSH

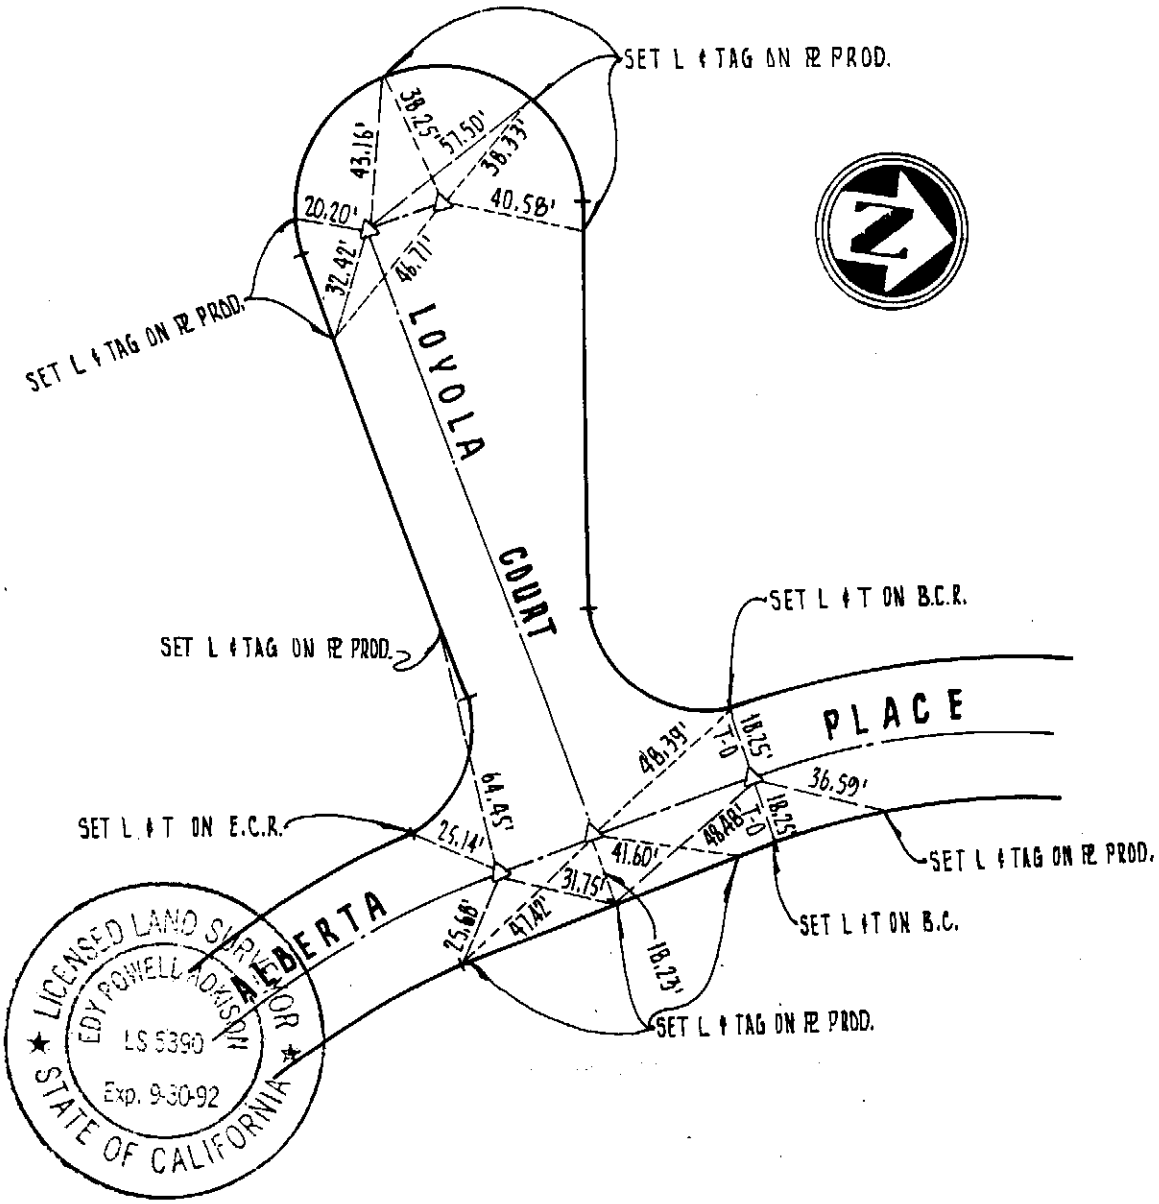

city of rancho cucamonga — STREET TIE	TRACT NO. 13058
ADKAN ENGINEERS 8830 AIRPORT DRIVE RIVERSIDE, CA. 92504 (714)688-0241 CIVIL ENGINEERING, PLANNING, LAND SURVEYING	ALBERTA PLACE & LOYOLA COURT
~~ENGR~~./L.S.	FIELD REVIEW _____ DATE _____
~~R.C.E.~~/L.S. NO. 5390 DATE 2/5/90	TIE BOOK 15 PAGE 56

3228

△ INDICATES 8" SPIKE & WASHER L.S. 5390, FLUSH.
◉ INDICATES SET 4 PUNCH MARKS IN M.H. RIM

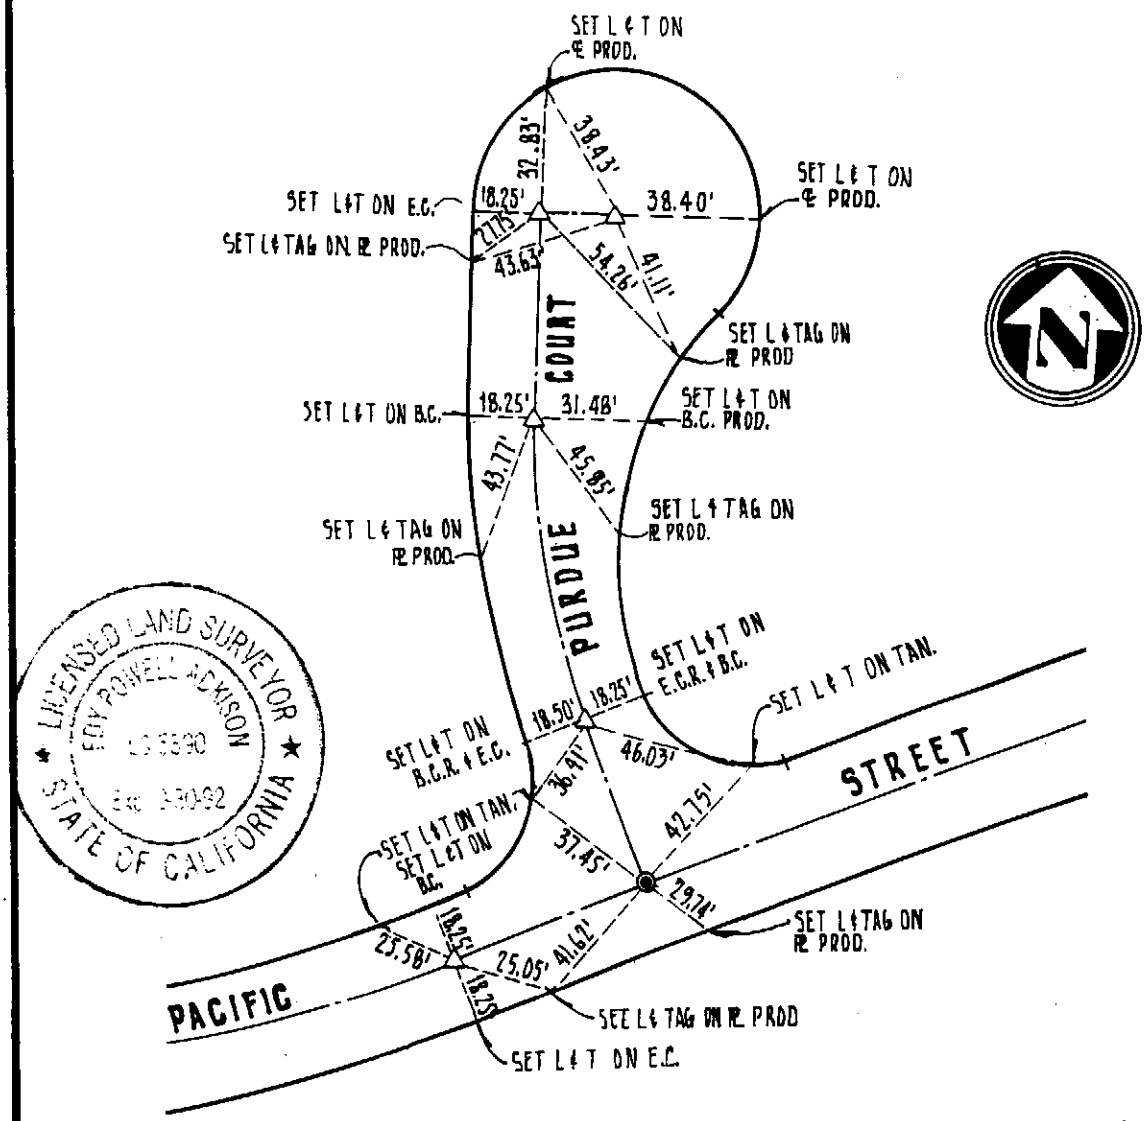

city of rancho cucamonga — STREET TIE	TRACT NO. 13058
ADKAN ENGINEERS 6830 AIRPORT DRIVE RIVERSIDE, CA. 92504 (714)688-0241 CIVIL ENGINEERING, PLANNING, LAND SURVEYING	PACIFIC STREET AND PURDUE COURT
~~ENGR.~~/L.S. [signature]	FIELD REVIEW _____ DATE _____
~~R.C.E.~~/L.S. NO. 5390 DATE 2/5/90	TIE BOOK 15 PAGE 57

3228

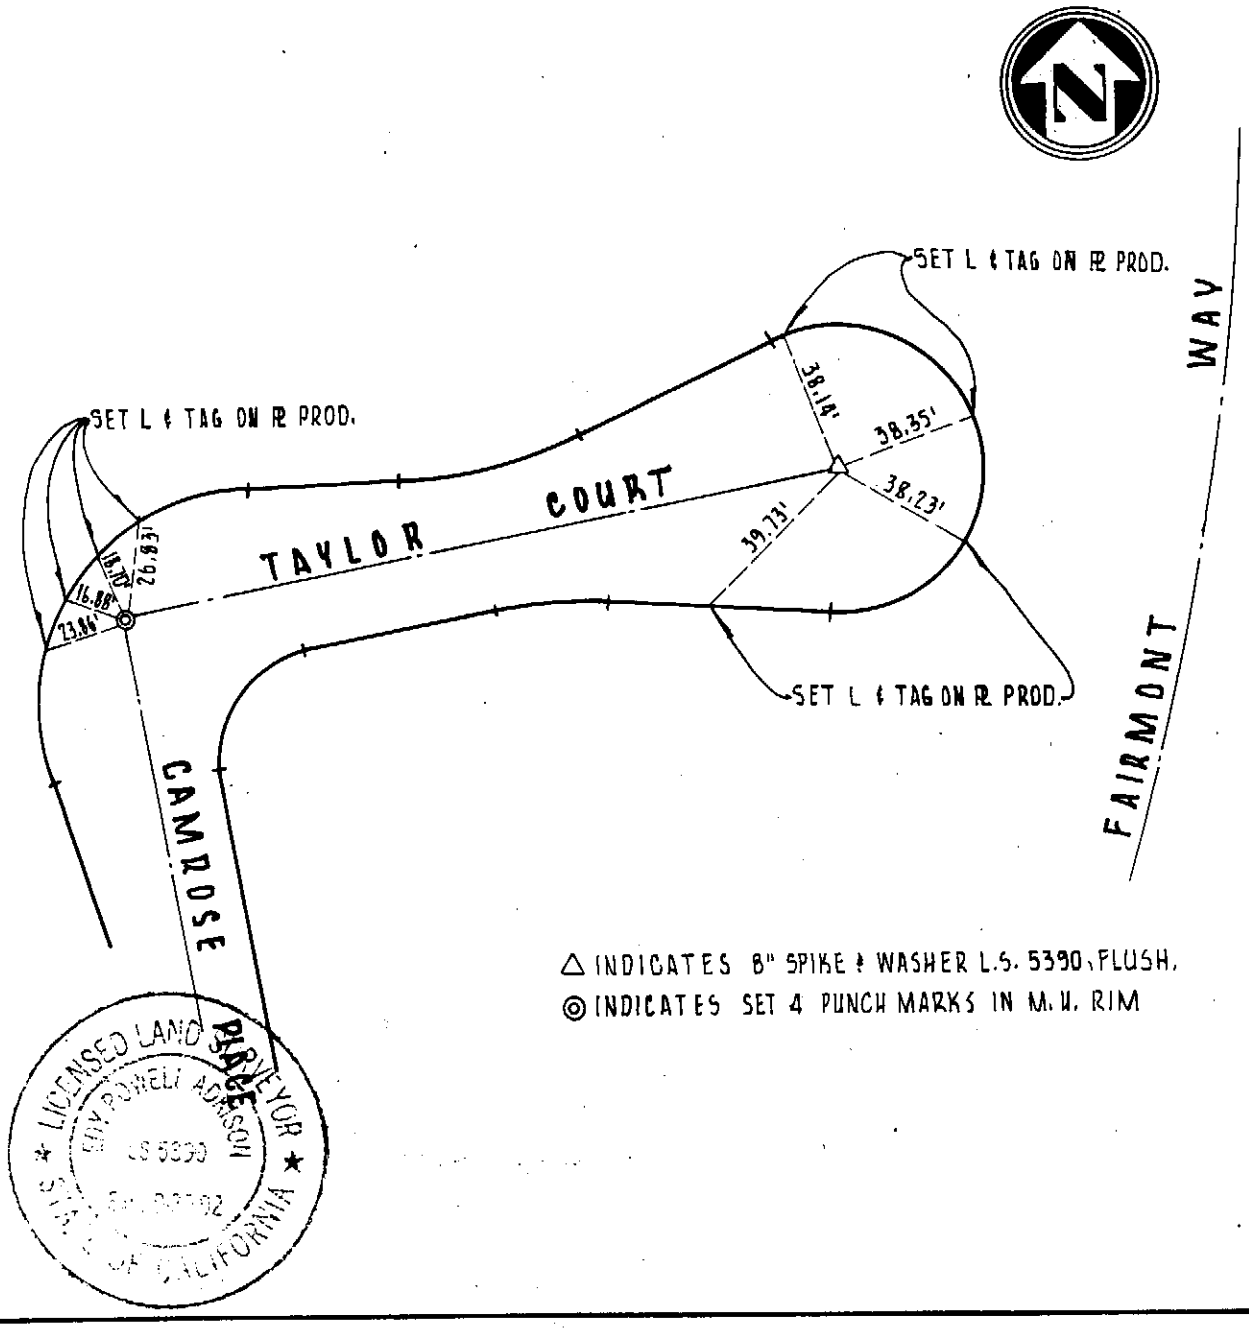

city of rancho cucamonga — STREET TIE	**TRACT NO. 13058**
ADKAN ENGINEERS 6830 AIRPORT DRIVE RIVERSIDE, CA. 92504 (714)688-0241 CIVIL ENGINEERING, PLANNING, LAND SURVEYING	TAYLOR COURT & CAMROSE PLACE
~~ENGR.~~/L.S.	FIELD REVIEW _____ DATE _____
~~R.C.E.~~/L.S. NO. 5390 DATE 2/5/90	TIE BOOK 15 PAGE 58

3228

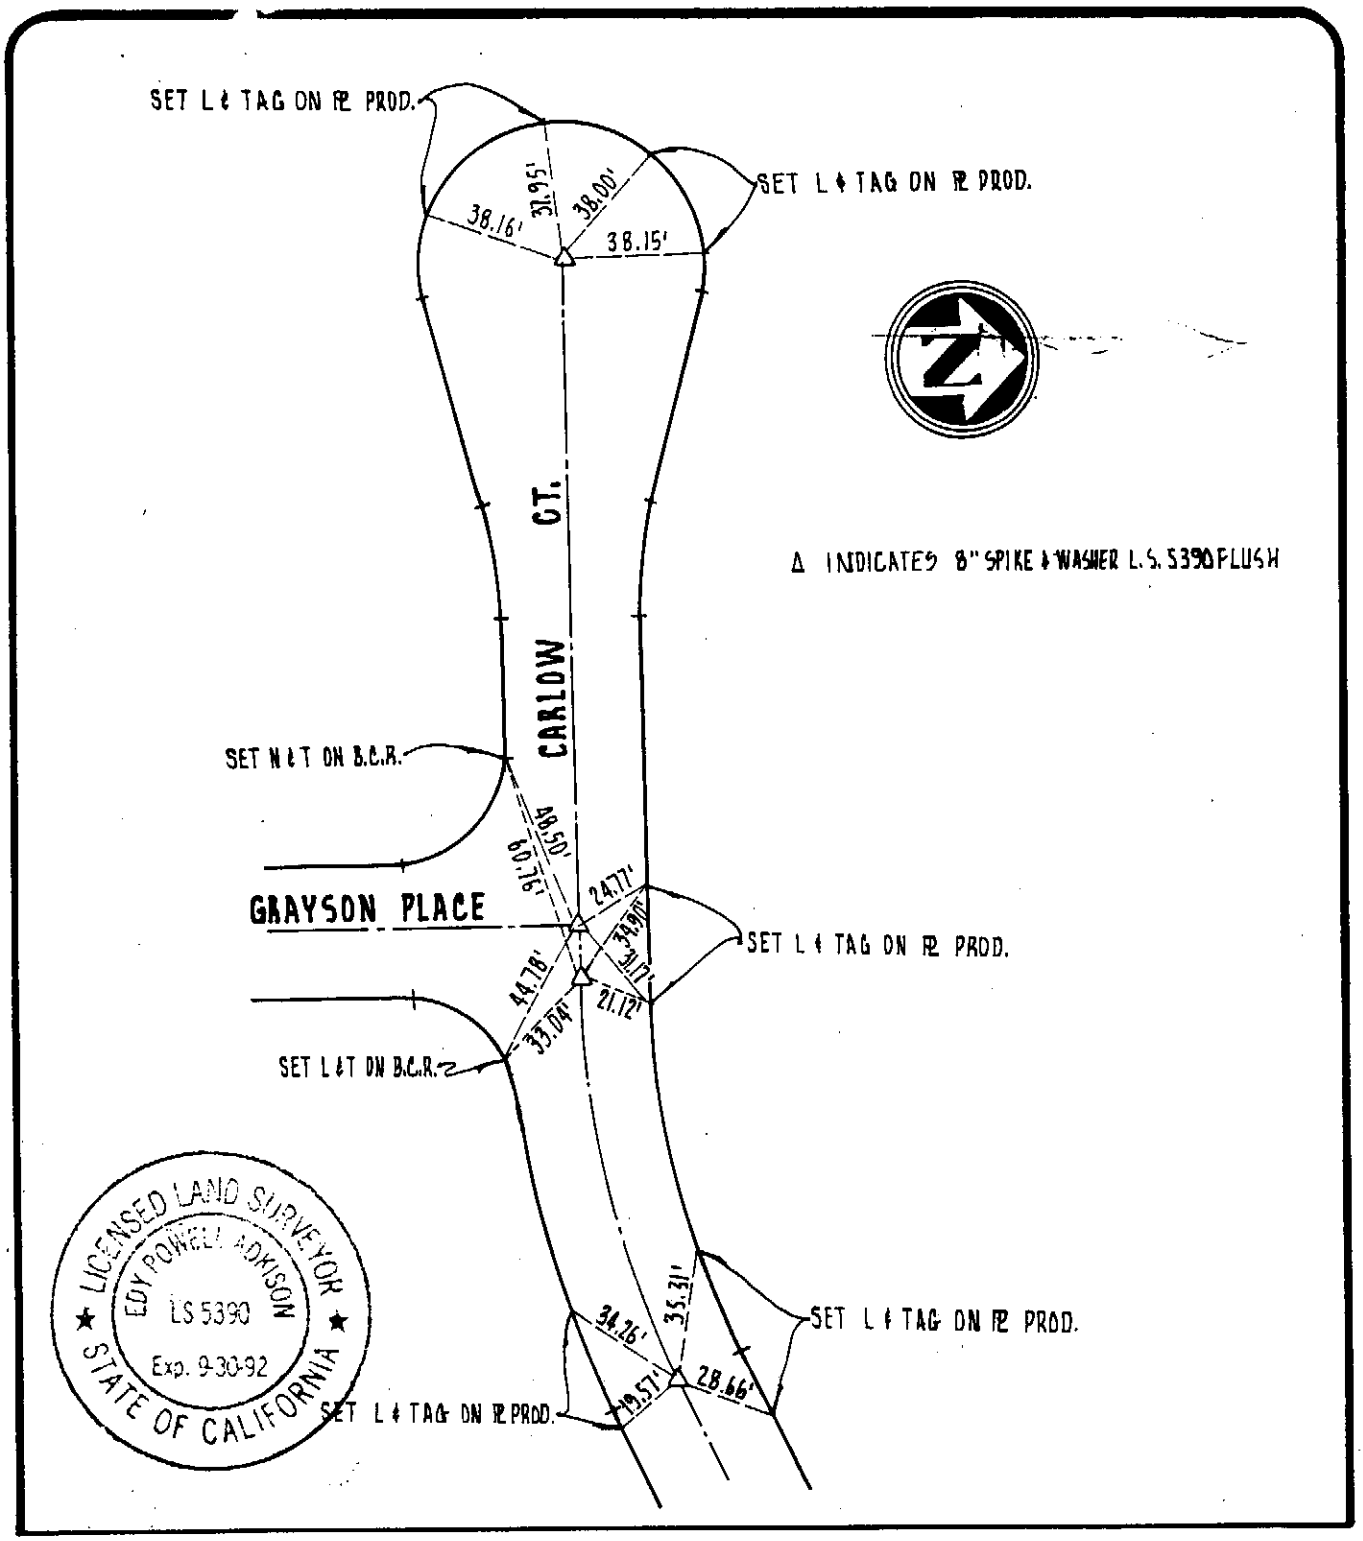

city of rancho cucamonga — STREET TIE	**TRACT NO. 13058**
ADKAN ENGINEERS 6830 AIRPORT DRIVE RIVERSIDE, CA. 92504 (714)688-0241 CIVIL ENGINEERING, PLANNING, LAND SURVEYING	GRAYSON PLACE & CARLOW COURT
ENGR./L.S. [signature]	FIELD REVIEW _____ DATE _____
R.O.E./L.S. NO. 5390 DATE 2/5/90	TIE BOOK 15 PAGE 59

3228

△ INDICATES 8" SPIKE & WASHER L.S. 5390, FLUSH.
◎ INDICATES SET 4 PUNCH MARKS IN M.H. RIM

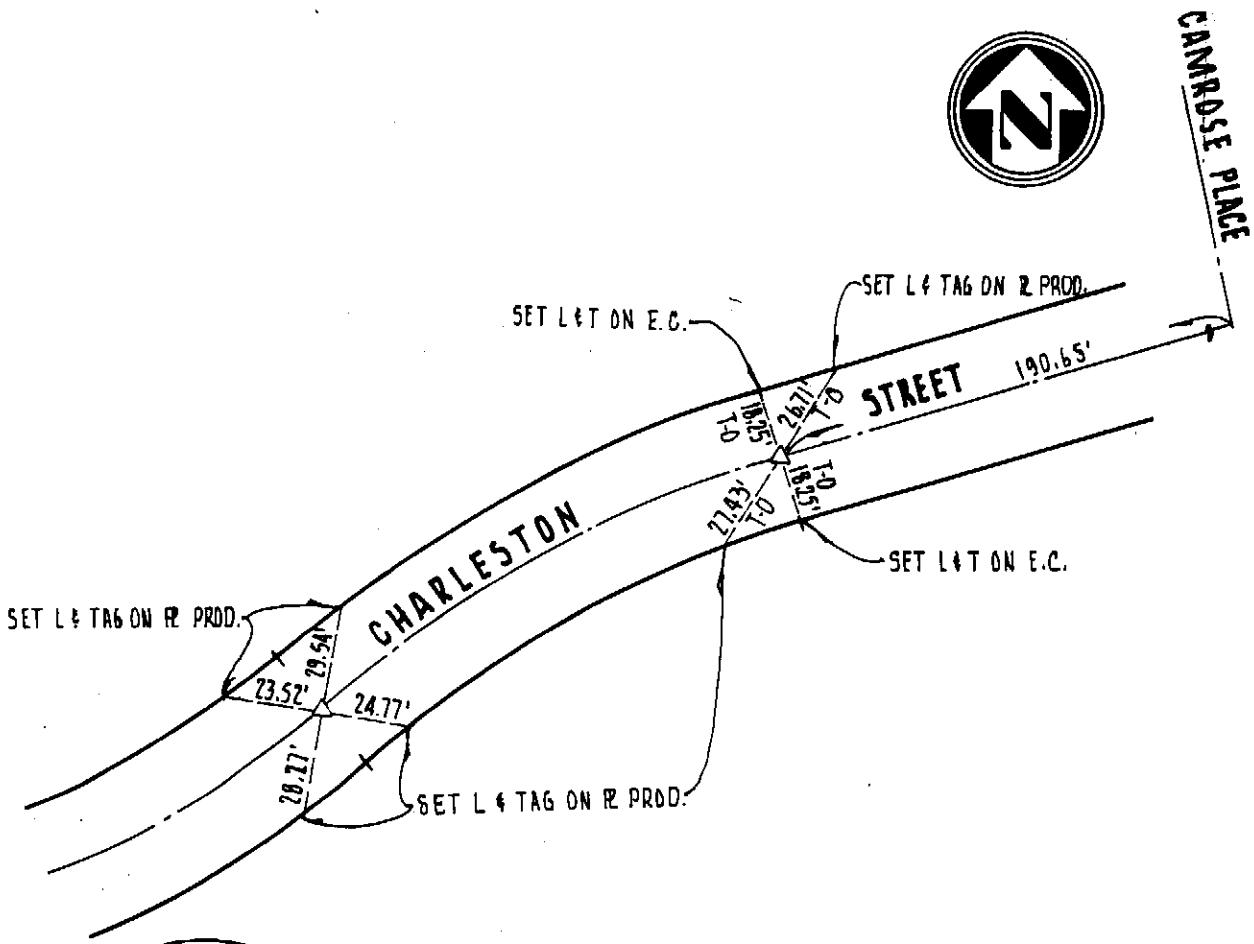

LICENSED LAND SURVEYOR
LS 5390
Exp. 9-30-92
STATE OF CALIFORNIA

city of rancho cucamonga — STREET TIE	**TRACT NO. 13058**
ADKAN ENGINEERS 6830 AIRPORT DRIVE RIVERSIDE, CA. 92504 (714)688-0241 CIVIL ENGINEERING, PLANNING, LAND SURVEYING	CHARLESTON STREET
~~ENGR.~~/L.S. [signature]	FIELD REVIEW _____ DATE _____
~~R.C.E.~~/L.S. NO. 5390 DATE 2/5/90	TIE BOOK 15 PAGE 60

3228

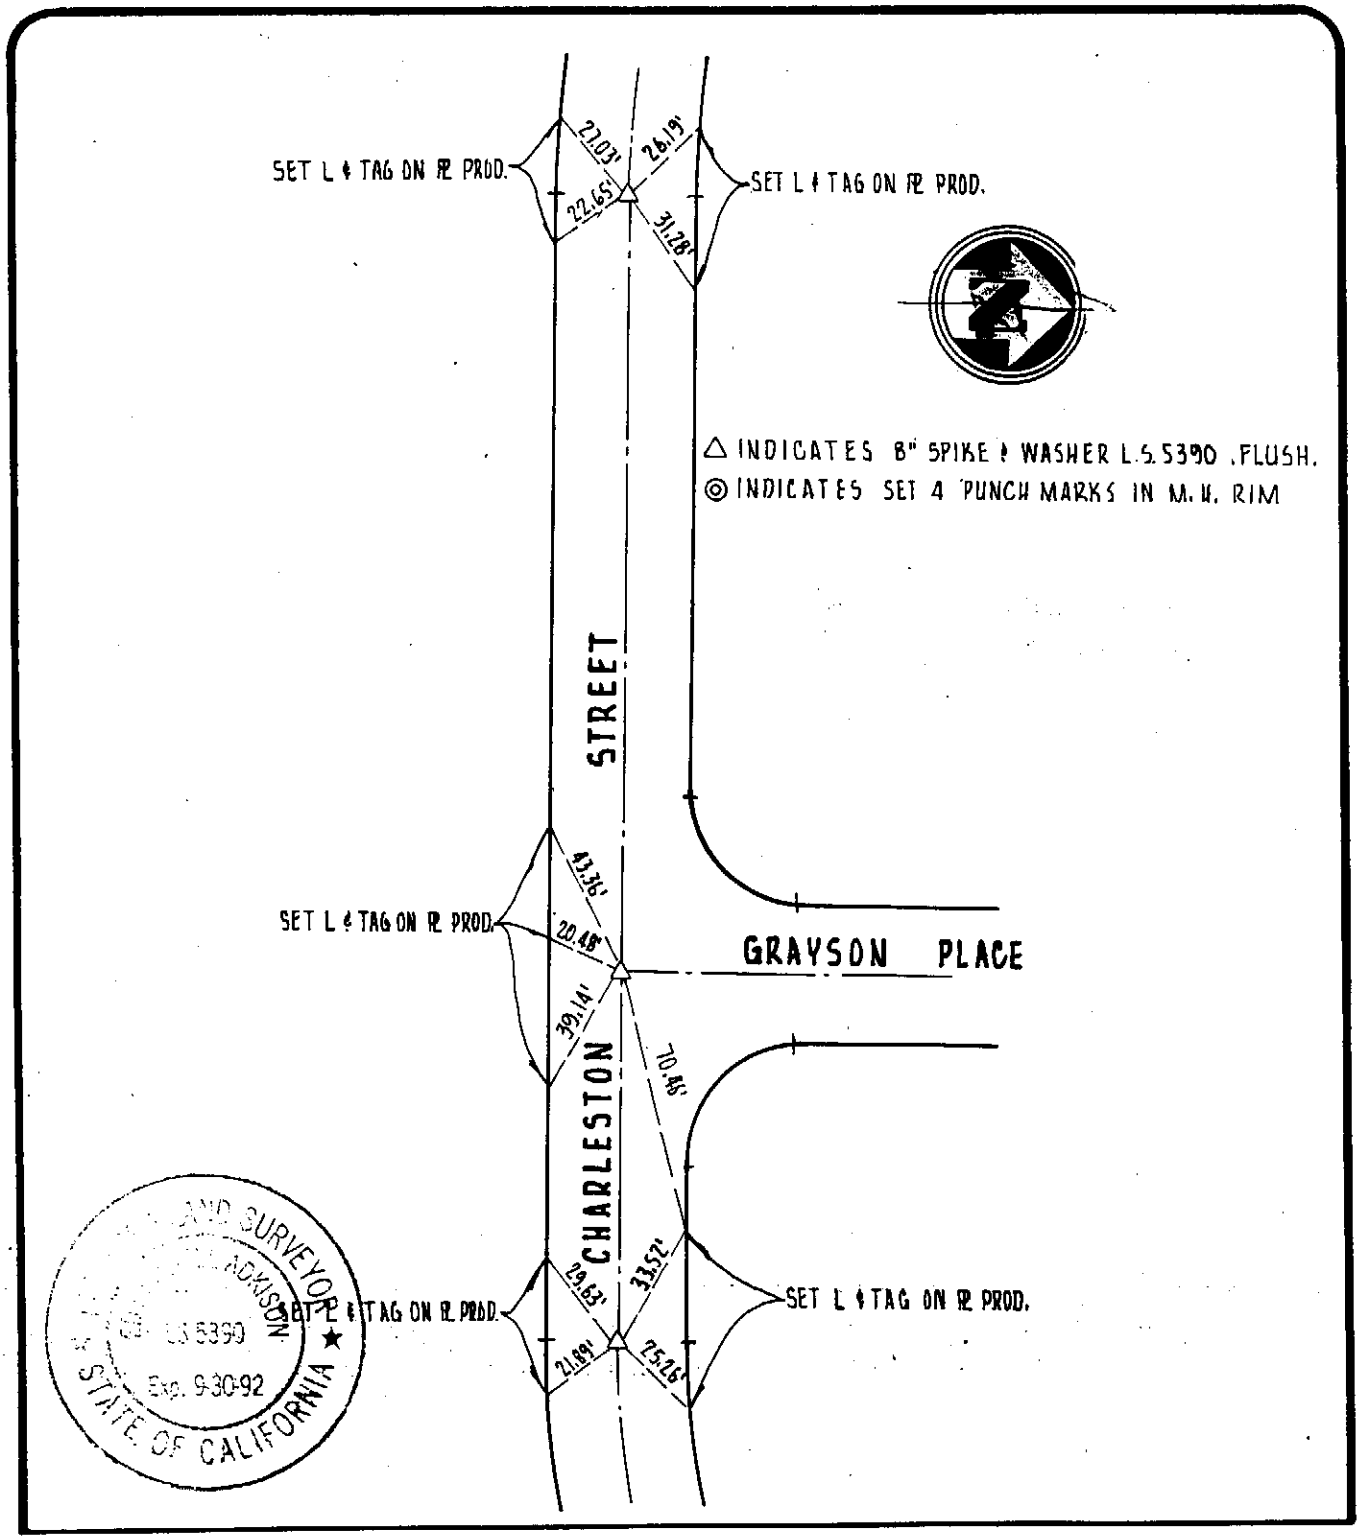

city of rancho cucamonga — STREET TIE	**TRACT NO. 13058**
ADKAN ENGINEERS 6830 AIRPORT DRIVE RIVERSIDE, CA. 92504 (714)688-0241 CIVIL ENGINEERING, PLANNING, LAND SURVEYING	GRAYSON PLACE & CHARLESTON STREET
~~ENGR~~./L.S.	FIELD REVIEW _____ DATE _____
~~R.C.E.~~/L.S. NO. 5390 DATE 2/5/90	TIE BOOK 15 PAGE 61

3228

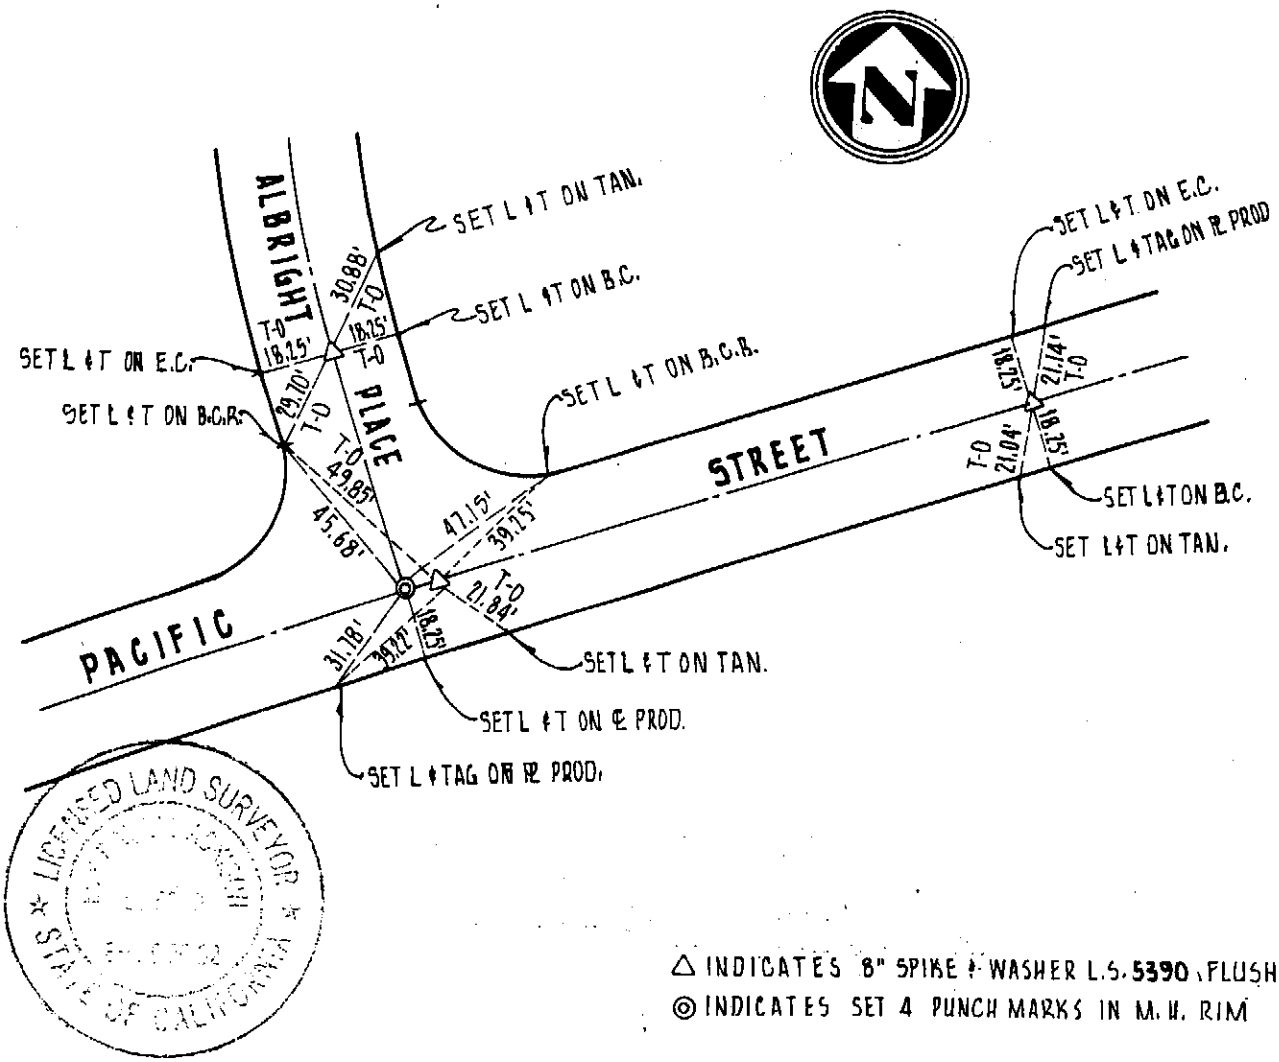

△ INDICATES 8" SPIKE & WASHER L.S. 5390, FLUSH.
◎ INDICATES SET 4 PUNCH MARKS IN M.H. RIM

LICENSED LAND SURVEYOR ★ STATE OF CALIFORNIA

city of rancho cucamonga — STREET TIE	**TRACT NO. 13058**
ADKAN ENGINEERS 6830 AIRPORT DRIVE RIVERSIDE, CA. 92504 (714)688-0241 CIVIL ENGINEERING, PLANNING, LAND SURVEYING	PACIFIC STREET & ALBRIGHT PLACE
~~ENGR~~./L.S.	FIELD REVIEW _____ DATE _____
~~R.C.E.~~/L.S. NO. 5390 DATE 2/5/90	TIE BOOK 15 PAGE 62

3228

△ INDICATES 8" SPIKE & WASHER L.S. 5390, FLUSH.
◎ INDICATES SET 4 PUNCH MARKS IN M.H. RIM

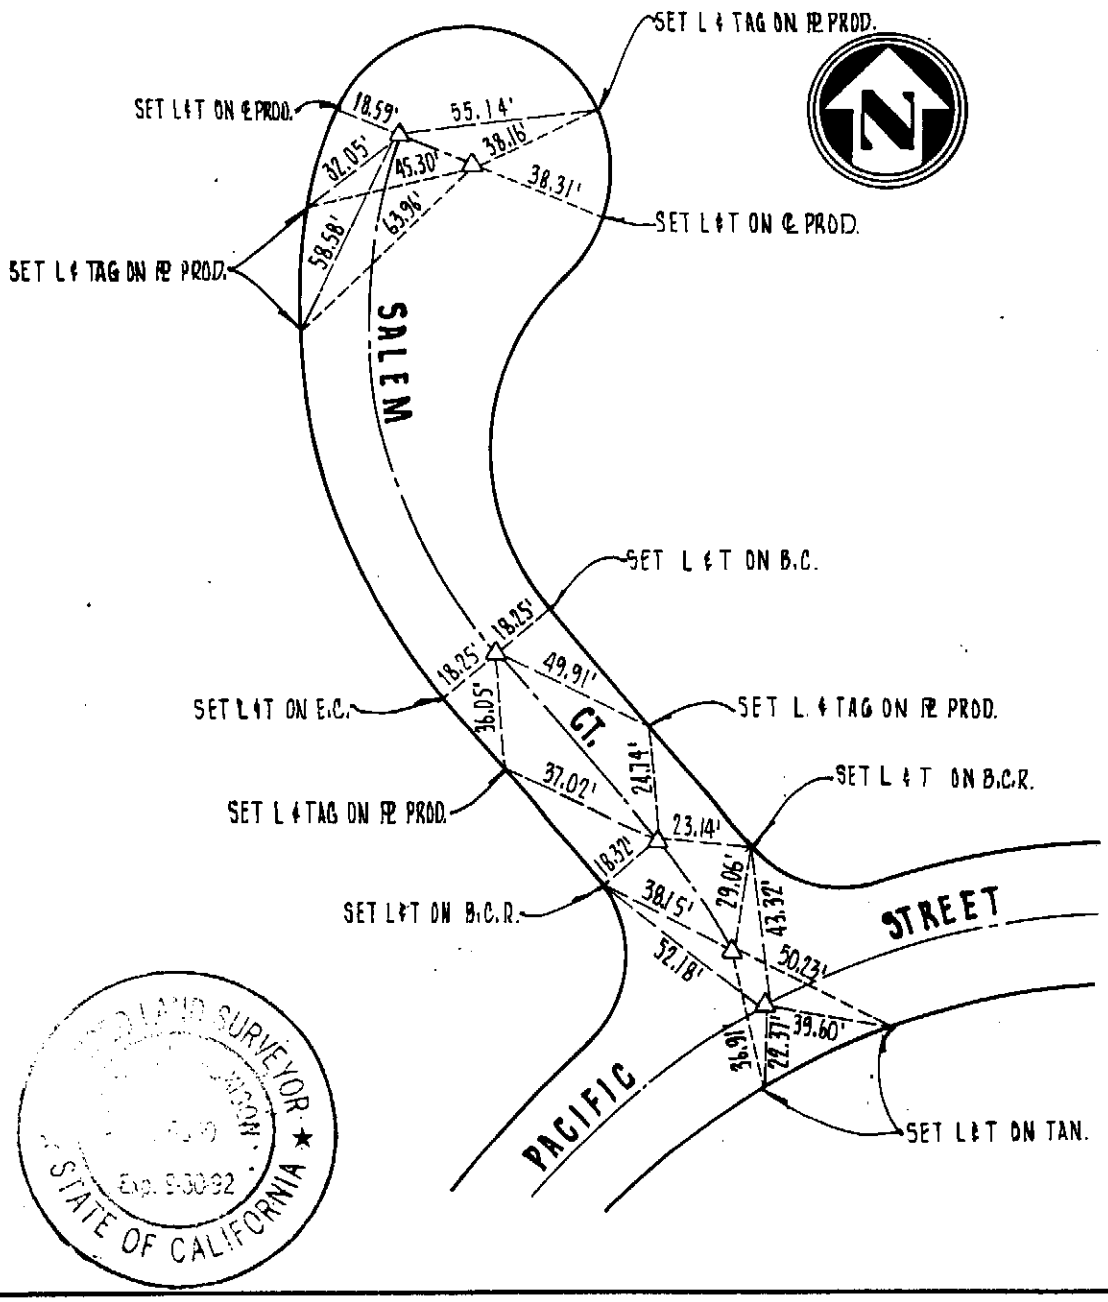

LAND SURVEYOR
Exp. 9-30-92
STATE OF CALIFORNIA

city of rancho cucamonga — STREET TIE	**TRACT NO. 13058**
ADKAN ENGINEERS 6830 AIRPORT DRIVE RIVERSIDE, CA. 92504 (714)688-0241 CIVIL ENGINEERING, PLANNING, LAND SURVEYING	SALEM COURT & PACIFIC STREET
~~ENGR.~~/L.S.	FIELD REVIEW _____ DATE _____
~~R.C.E.~~/L.S. NO. 5390 DATE 2/5/90	TIE BOOK 15 PAGE 63

3228

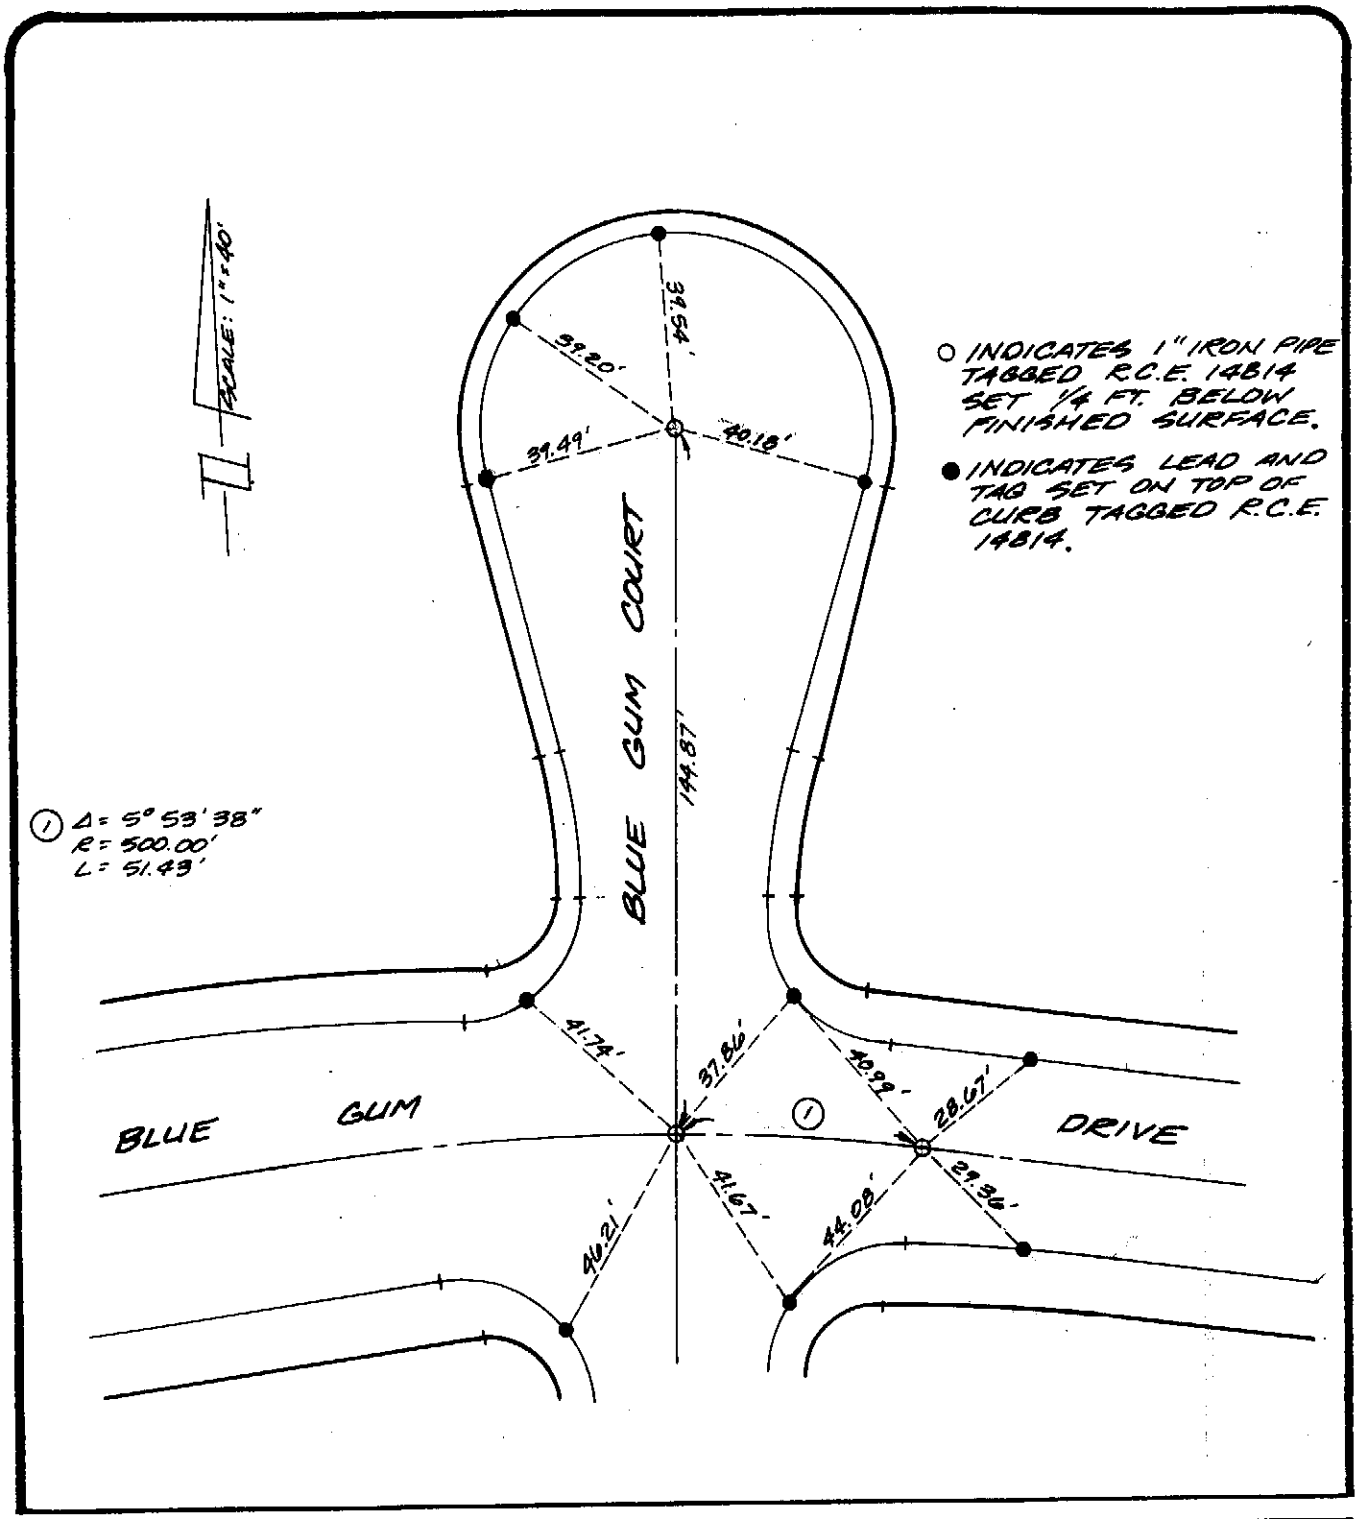

city of rancho cucamonga — STREET TIE	TRACT NO. 11549-1
MADOLE AND ASSOCIATES, INC. OF SAN BERNARDINO COUNTY 545 N. Mountain Ave., Suite 105 UPLAND, CALIFORNIA 91786 PHONE (714) 946-2949	BLUE GUM COURT AND BLUE GUM DRIVE
ENGR. / L. S. J. M. MADOLE	FIELD REVIEW _____ DATE _____
R.C.E. / L.S. No. 14814 DATE _____	TIE BOOK 15 PAGE 64

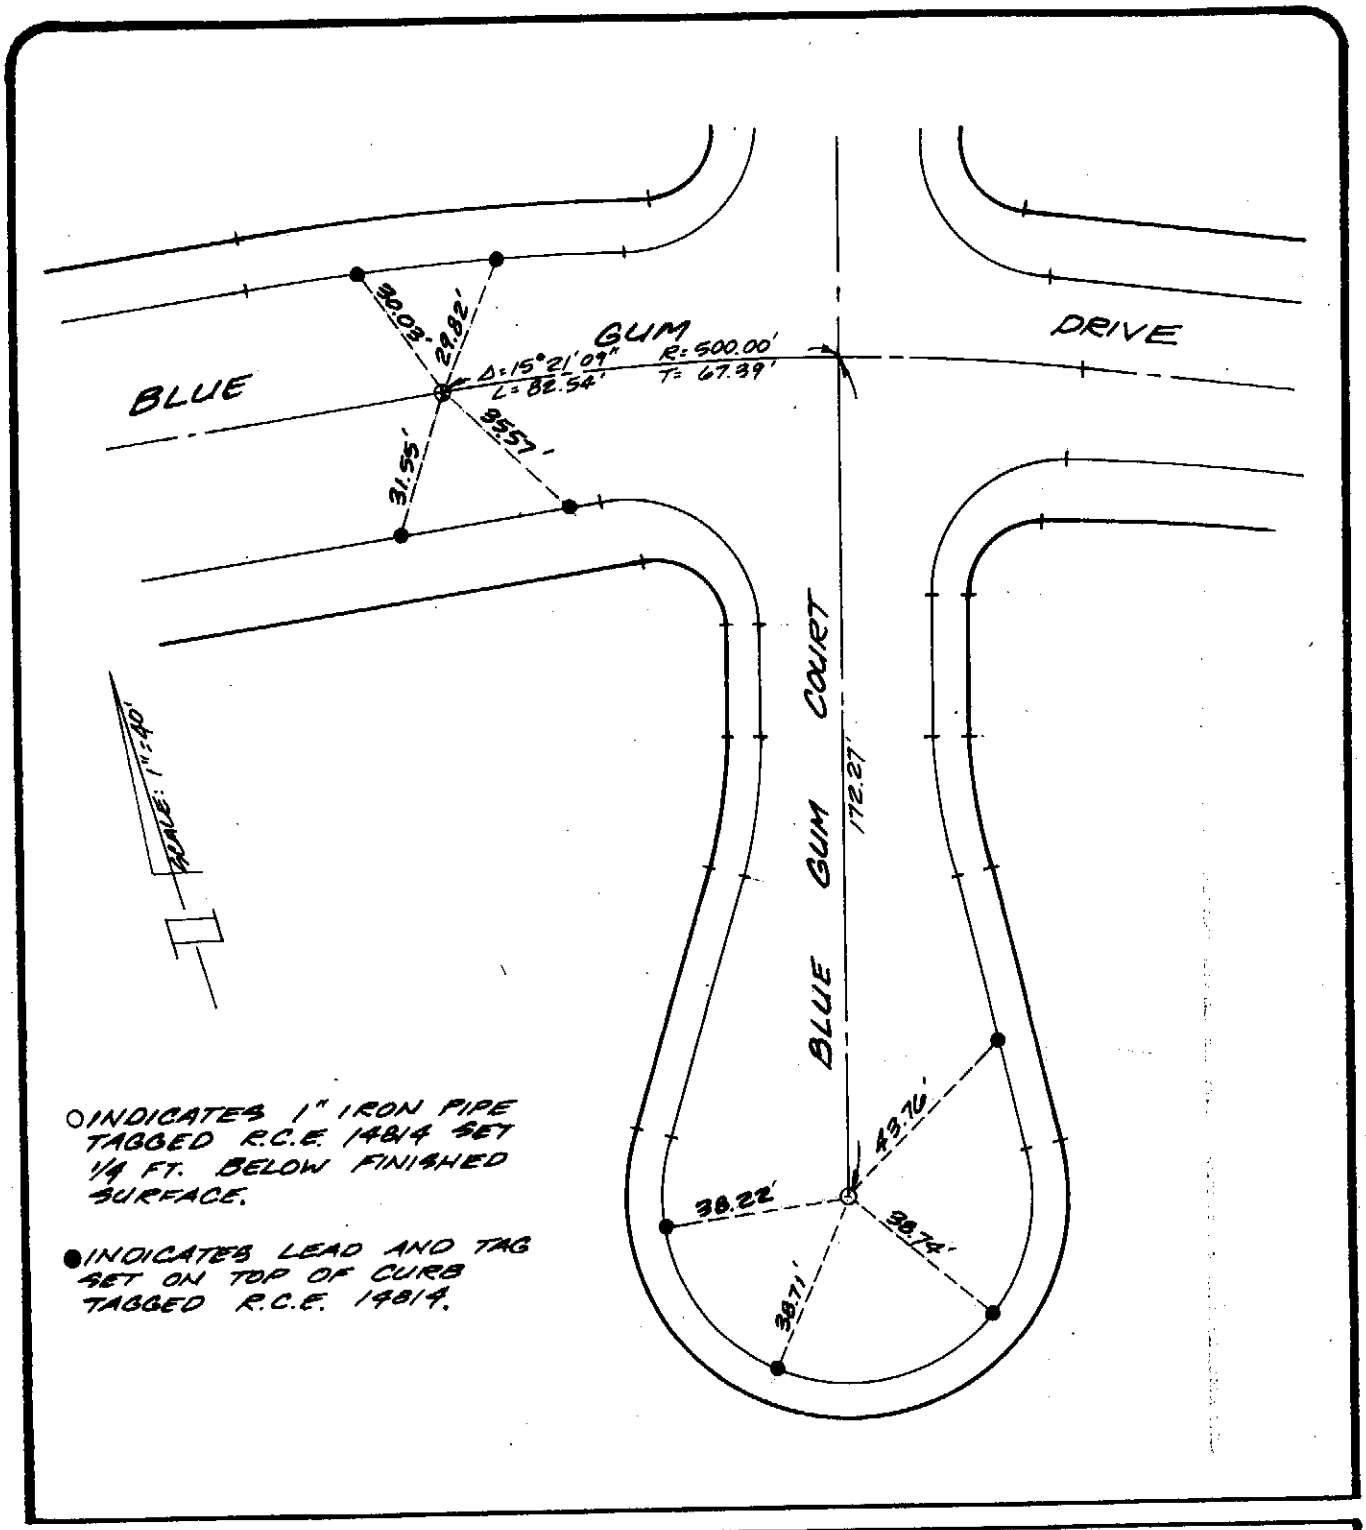

city of rancho cucamonga — STREET TIE	TRACT NO. 11549-1
MADOLE AND ASSOCIATES, INC. OF SAN BERNARDINO COUNTY 545 N. Mountain Ave., Suite 105 UPLAND, CALIFORNIA 91786 PHONE (714) 946-2949	BLUE GUM COURT AND BLUE GUM DRIVE
ENGR. / L.S. J. M. MADOLE	FIELD REVIEW _____ DATE _____
R.C.E. / L.S. No. 14814 DATE _____	TIE BOOK 15 PAGE 65

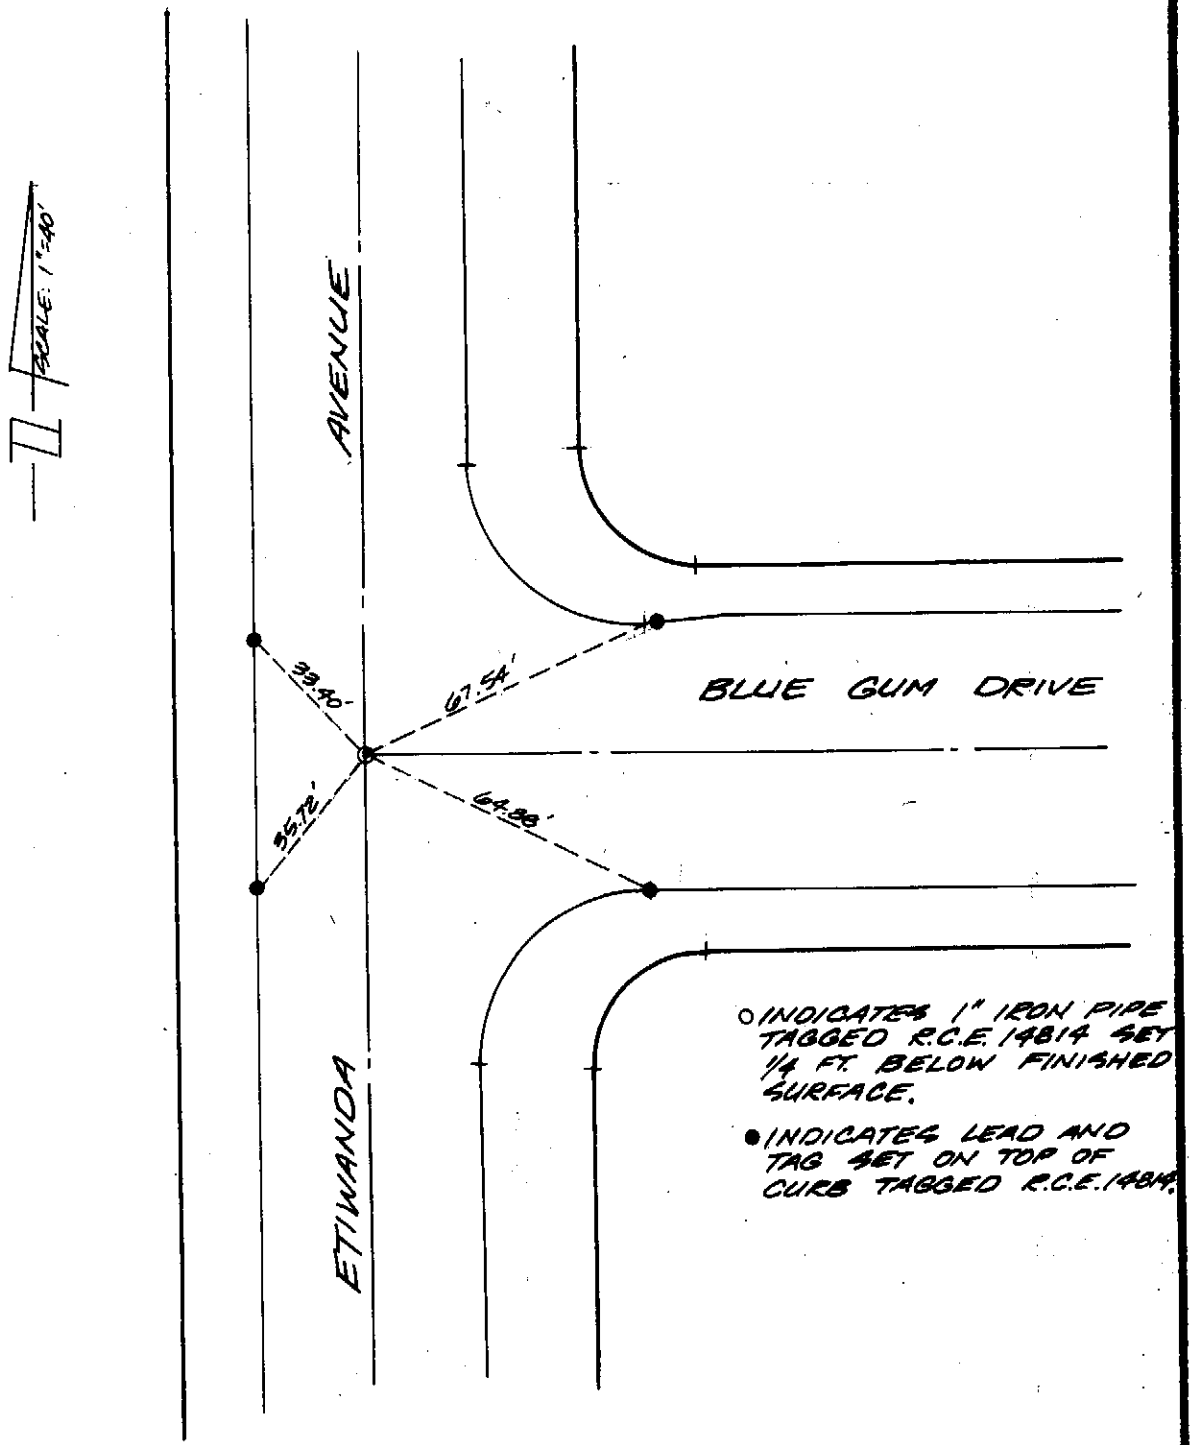

city of rancho cucamonga

STREET TIE

MADOLE AND ASSOCIATES, INC.
OF SAN BERNARDINO COUNTY
545 N. Mountain Ave., Suite 105
UPLAND, CALIFORNIA 91786
PHONE (714) 946-2949

BLUE GUM DRIVE
ETIWANDA AVENUE

ENGR. / L. S. _____

FIELD REVIEW _____ DATE _____

R.C.E. / L.S. No. _____ DATE _____

TIE BOOK 15 PAGE 66

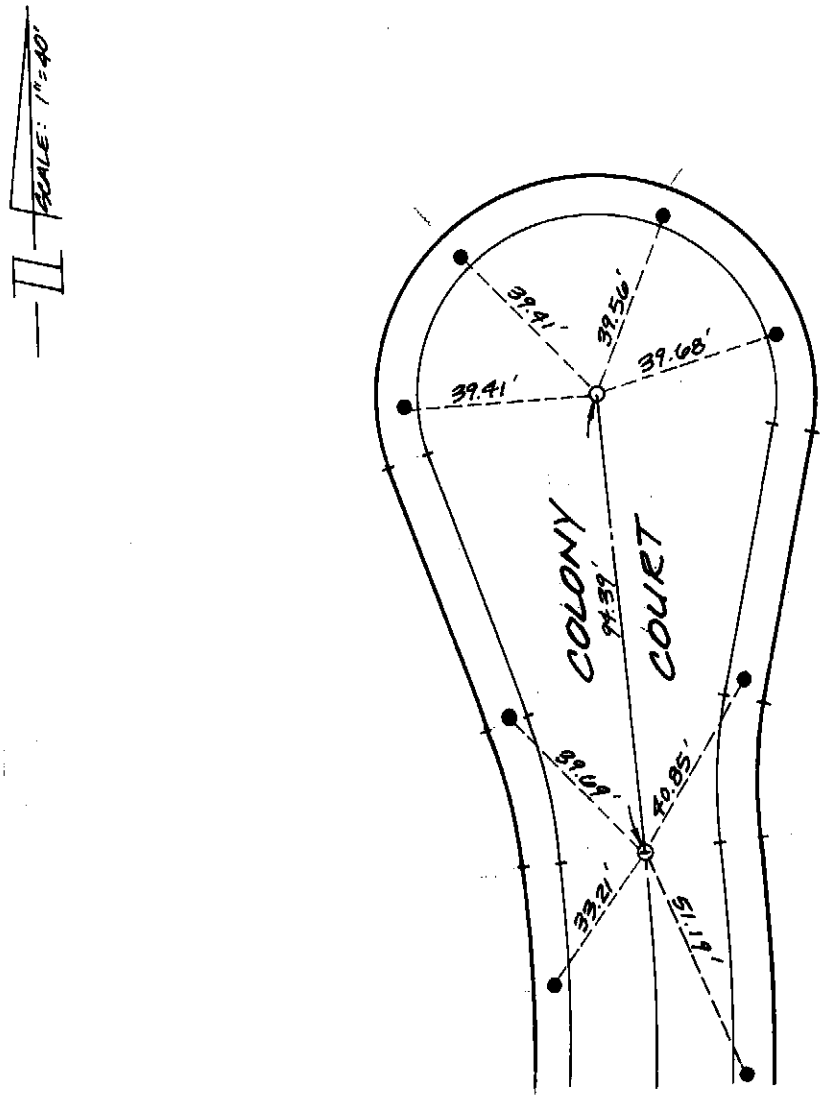

○ INDICATES 1" IRON PIPE TAGGED R.C.E. 14814 SET 1/4 FT. BELOW FINISHED SURFACE.

● INDICATES LEAD AND TAG SET ON TOP OF CURB TAGGED R.C.E. 14814.

city of rancho cucamonga — STREET TIE	TRACT NO. 11549-1
MADOLE AND ASSOCIATES, INC. OF SAN BERNARDINO COUNTY 545 N. Mountain Ave., Suite 105 UPLAND, CALIFORNIA 91786 PHONE(714)946-2949	COLONY COURT
ENGR./L.S. J. M. MADOLE	FIELD REVIEW _____ DATE _____
R.C.E./L.S. No. 14814 DATE _____	TIE BOOK 15 PAGE 67

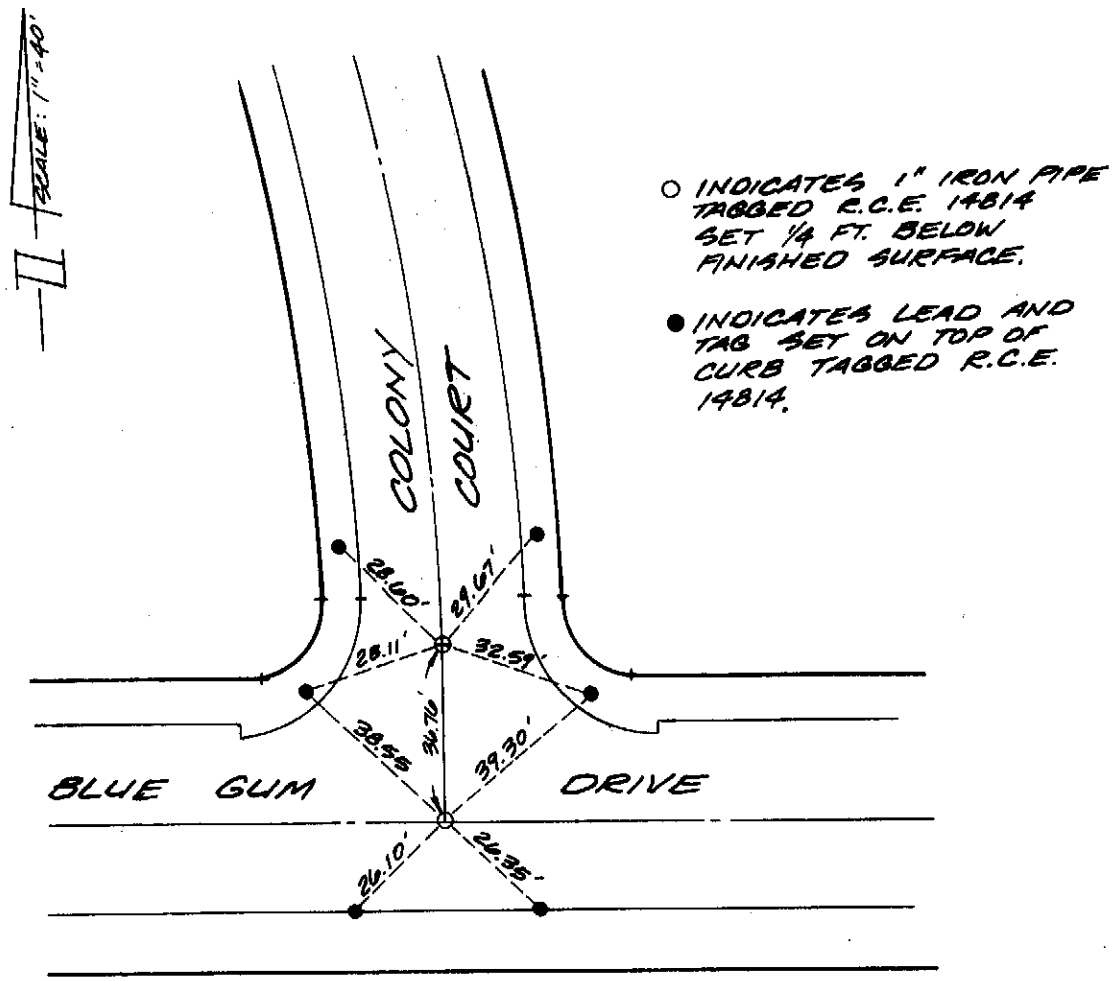

city of rancho cucamonga — STREET TIE	TRACT NO. 11549-1
MADOLE AND ASSOCIATES, INC. OF SAN BERNARDINO COUNTY 545 N. Mountain Ave., Suite 105 UPLAND, CALIFORNIA 91786 PHONE (714) 946-2949	COLONY COURT AND BLUE GUM DRIVE
ENGR./L.S. J. M. MADOLE	FIELD REVIEW _____ DATE _____
R.C.E./L.S. No. 14814 DATE _____	TIE BOOK 15 PAGE 68

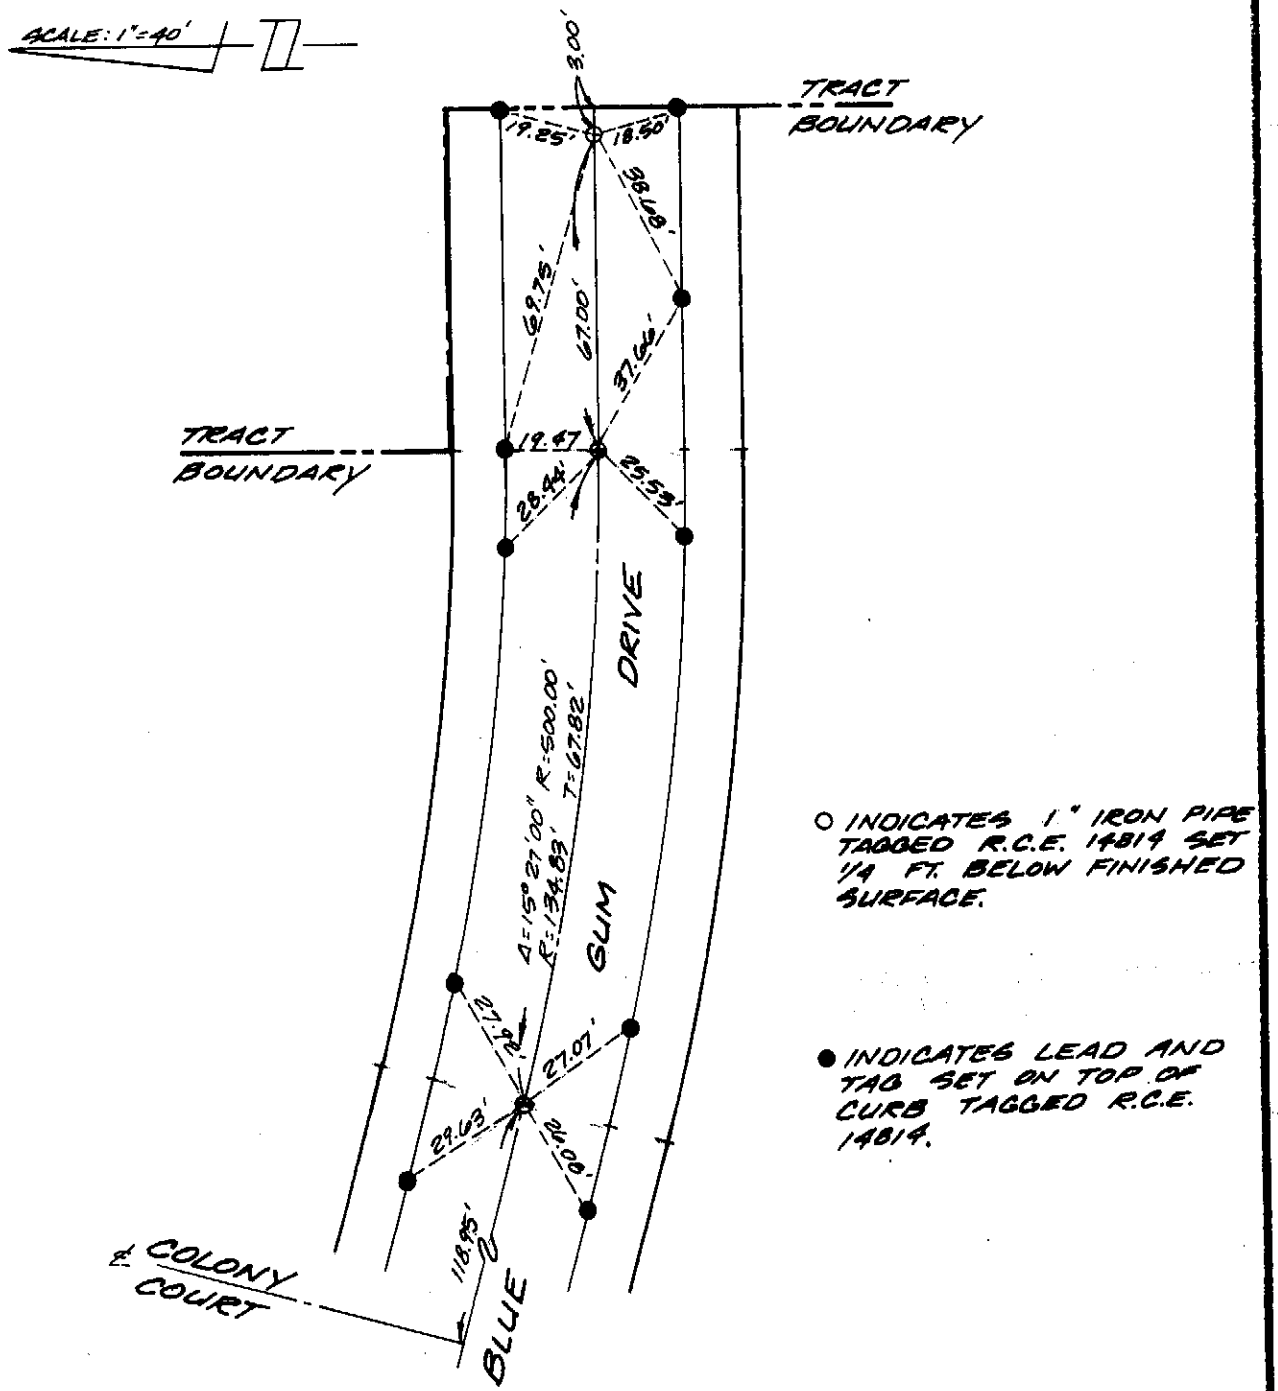

city of rancho cucamonga — STREET TIE	TRACT NO. 11549-1
MADOLE AND ASSOCIATES, INC. OF SAN BERNARDINO COUNTY 545 N. Mountain Ave., Suite 105 UPLAND, CALIFORNIA 91786 PHONE (714) 946-2949	BLUE GUM DRIVE
ENGR./L.S. J. M. MADOLE	FIELD REVIEW _____ DATE _____
R.C.E./L.S. No. 14814 DATE _____	TIE BOOK 15 PAGE 69

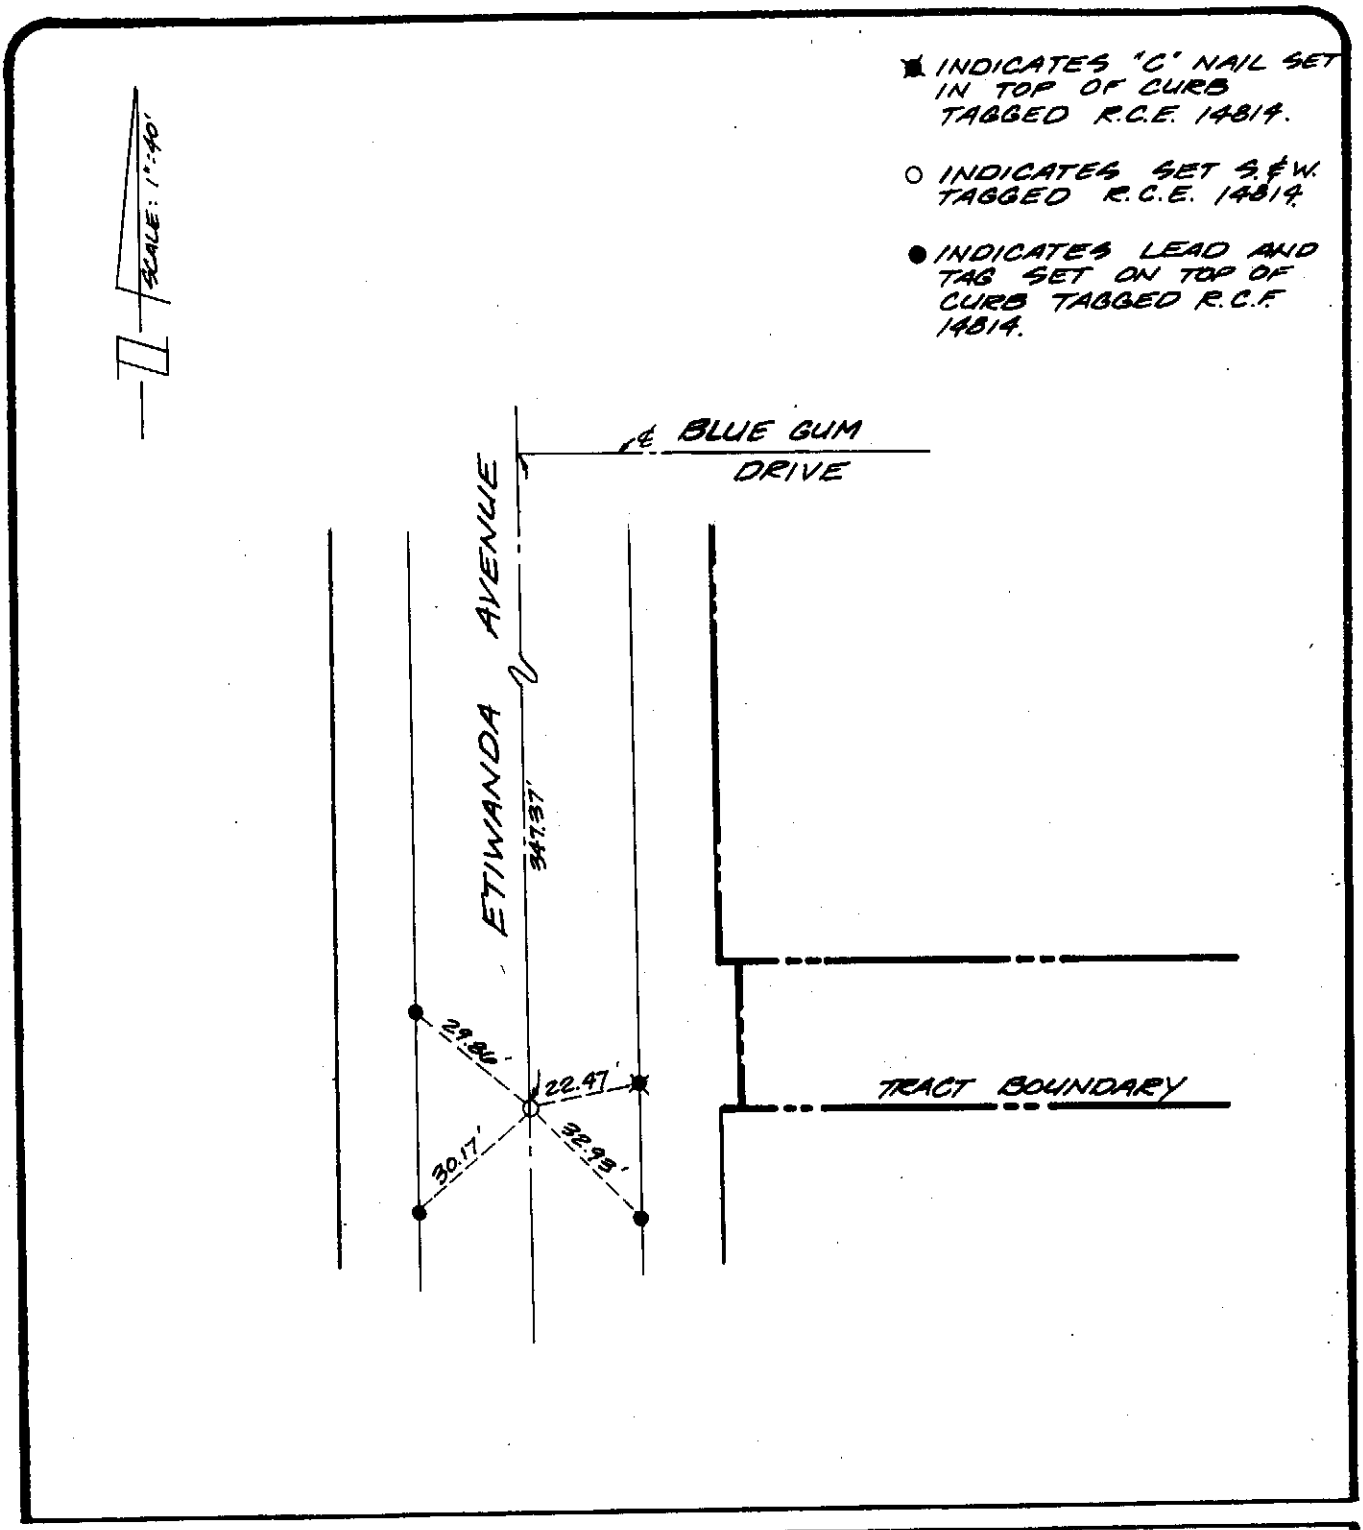

city of rancho cucamonga — STREET TIE	TRACT NO. 11549-1
MADOLE AND ASSOCIATES, INC. OF SAN BERNARDINO COUNTY 545 N. Mountain Ave., Suite 105 UPLAND, CALIFORNIA 91786 PHONE (714) 946-2949	ETIWANDA AVENUE
ENGR./L.S. J. M. MADOLE	FIELD REVIEW _____ DATE _____
R.C.E./L.S. No. 14814 DATE _____	TIE BOOK 15 PAGE 70

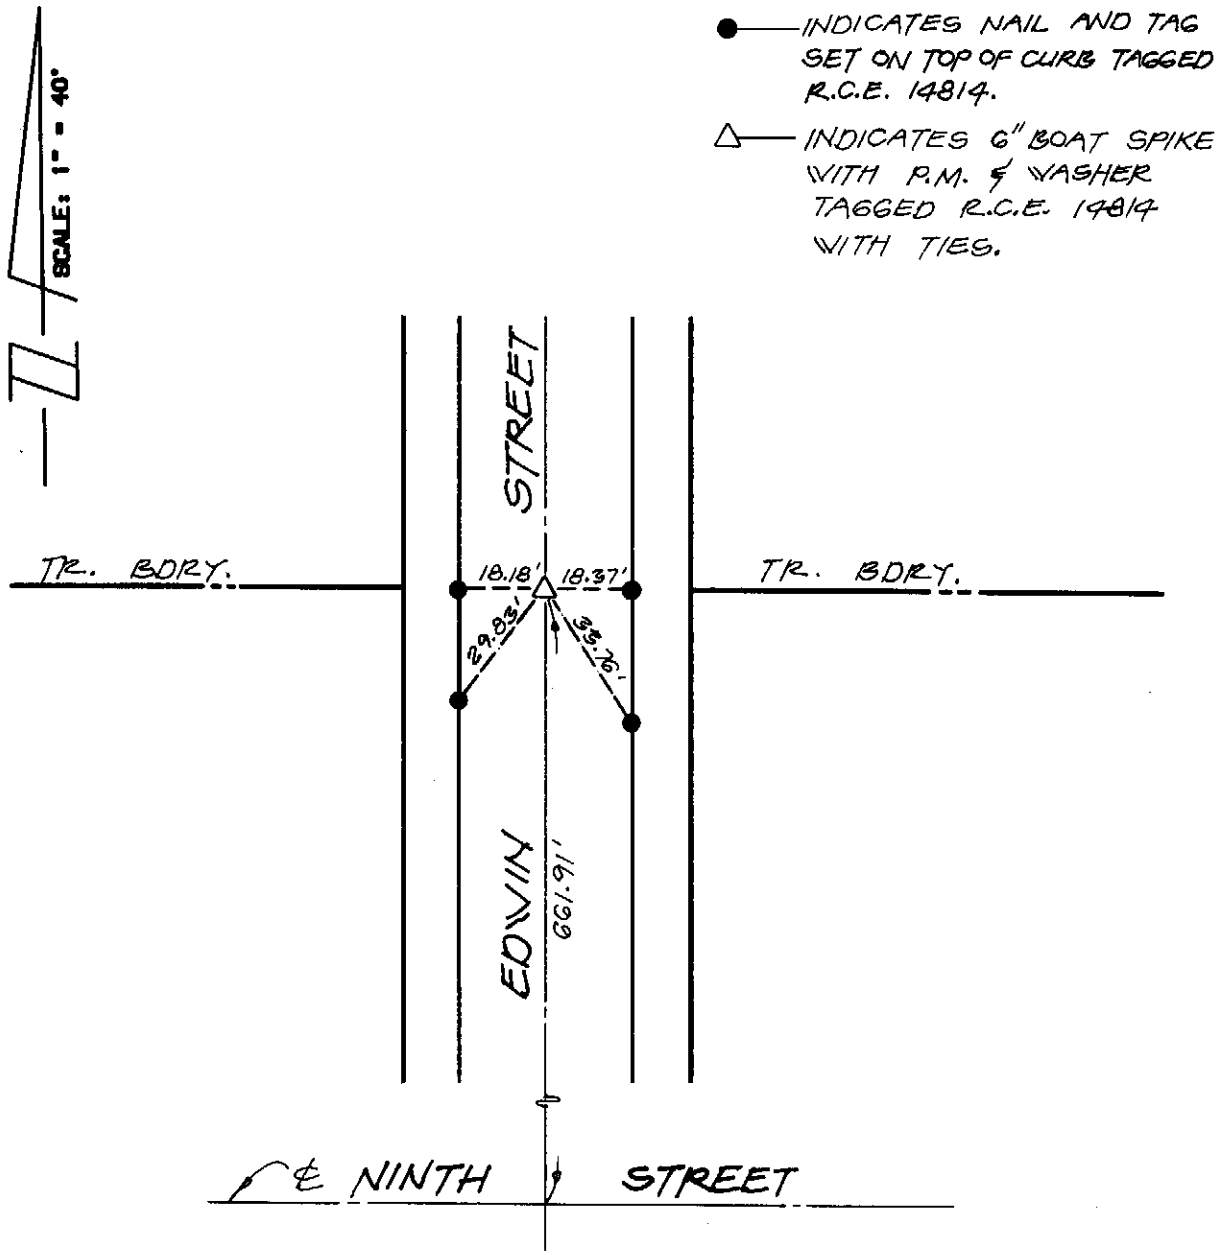

CITY OF RANCHO CUCAMONGA — STREET TIE	TRACT No. 12969
MADOLE AND ASSOCIATES, INC. OF SAN BERNARDINO COUNTY 545 N. Mountain Ave., Suite 105 UPLAND, CALIFORNIA 91786 PHONE (714) 946-2949	EDWIN STREET
ENGR./L.S. J. M. MADOLE	FIELD REVIEW _____ DATE _____
R.C.E./L.S. No. 14814 DATE _____	TIE BOOK 15 PAGE 71

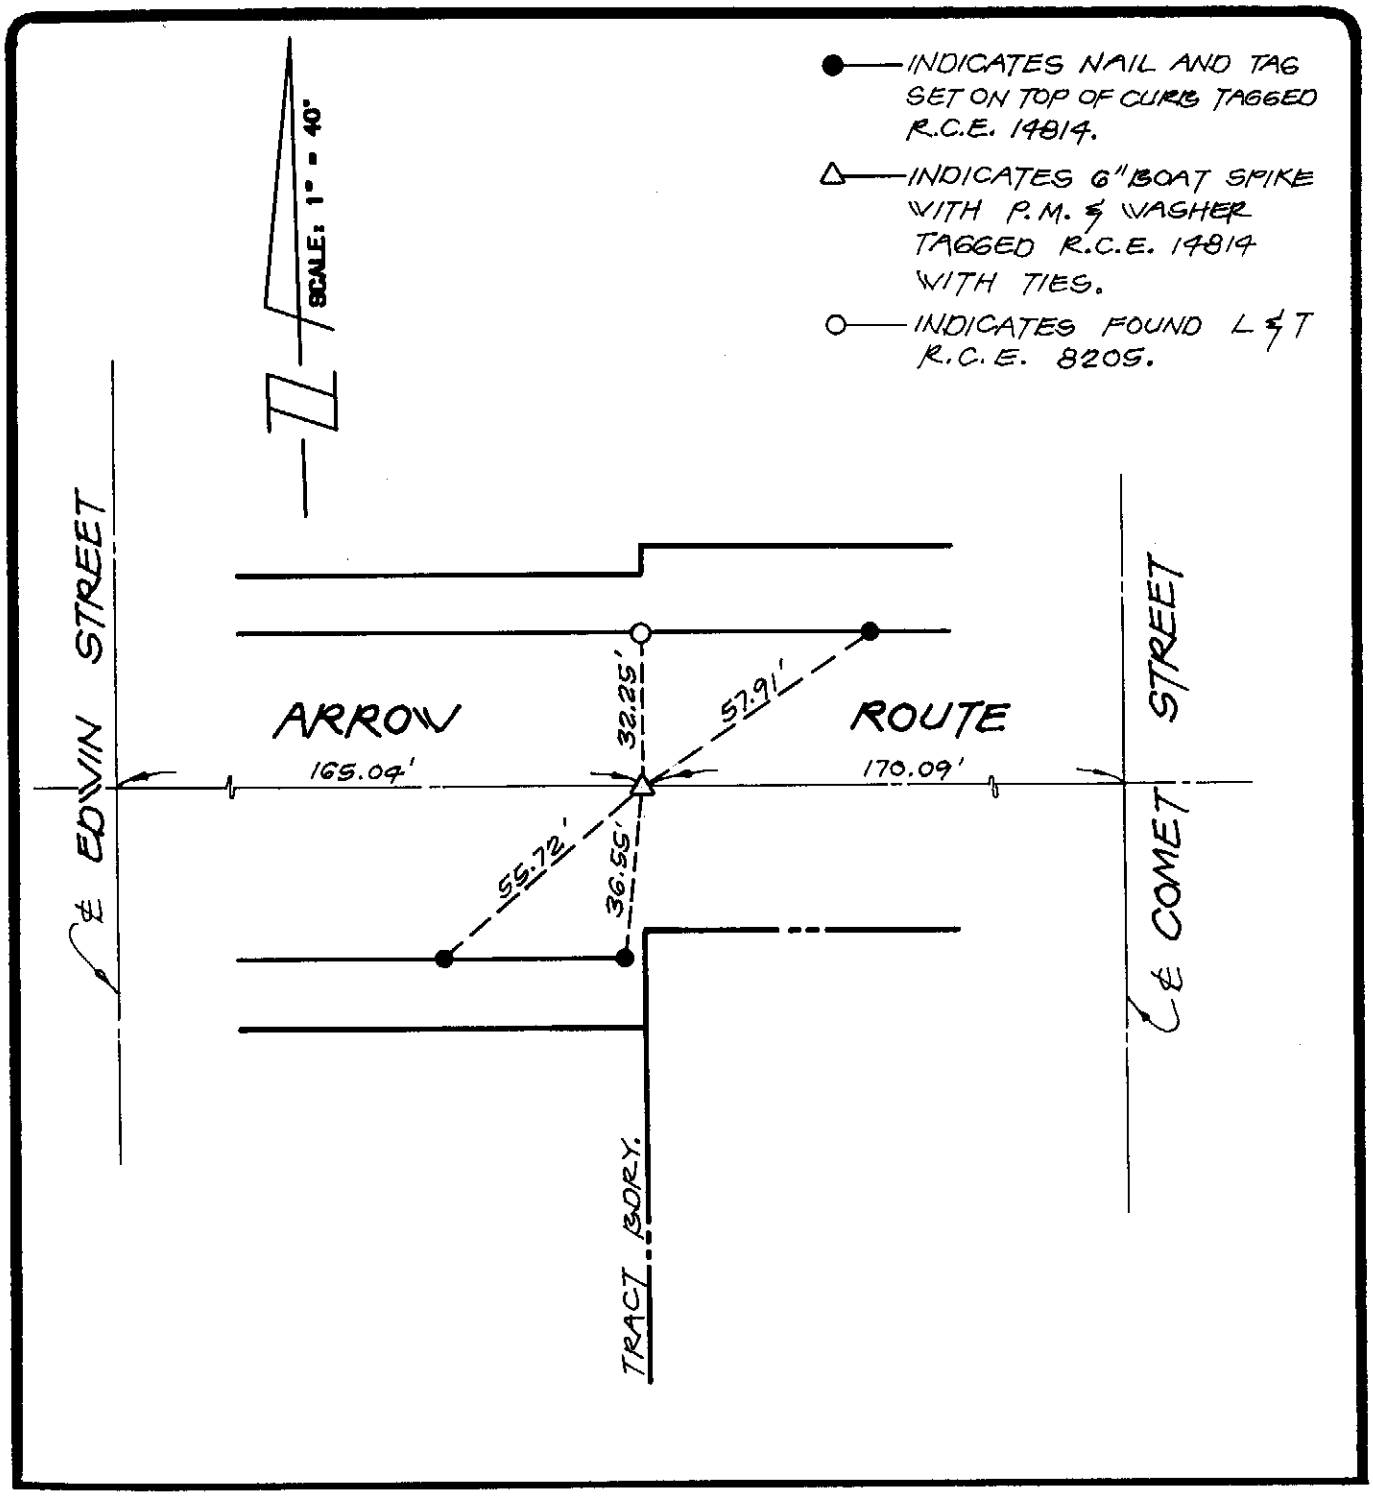

CITY OF RANCHO CUCAMONGA — STREET TIE	TRACT No. 12969
MADOLE AND ASSOCIATES, INC. OF SAN BERNARDINO COUNTY 545 N. Mountain Ave., Suite 105 UPLAND, CALIFORNIA 91786 PHONE (714) 946-2949	ARROW ROUTE
ENGR./L.S. J. M. MADOLE	FIELD REVIEW _____ DATE _____
R.C.E./L.S. No. 14814 DATE _____	TIE BOOK 15 PAGE 72

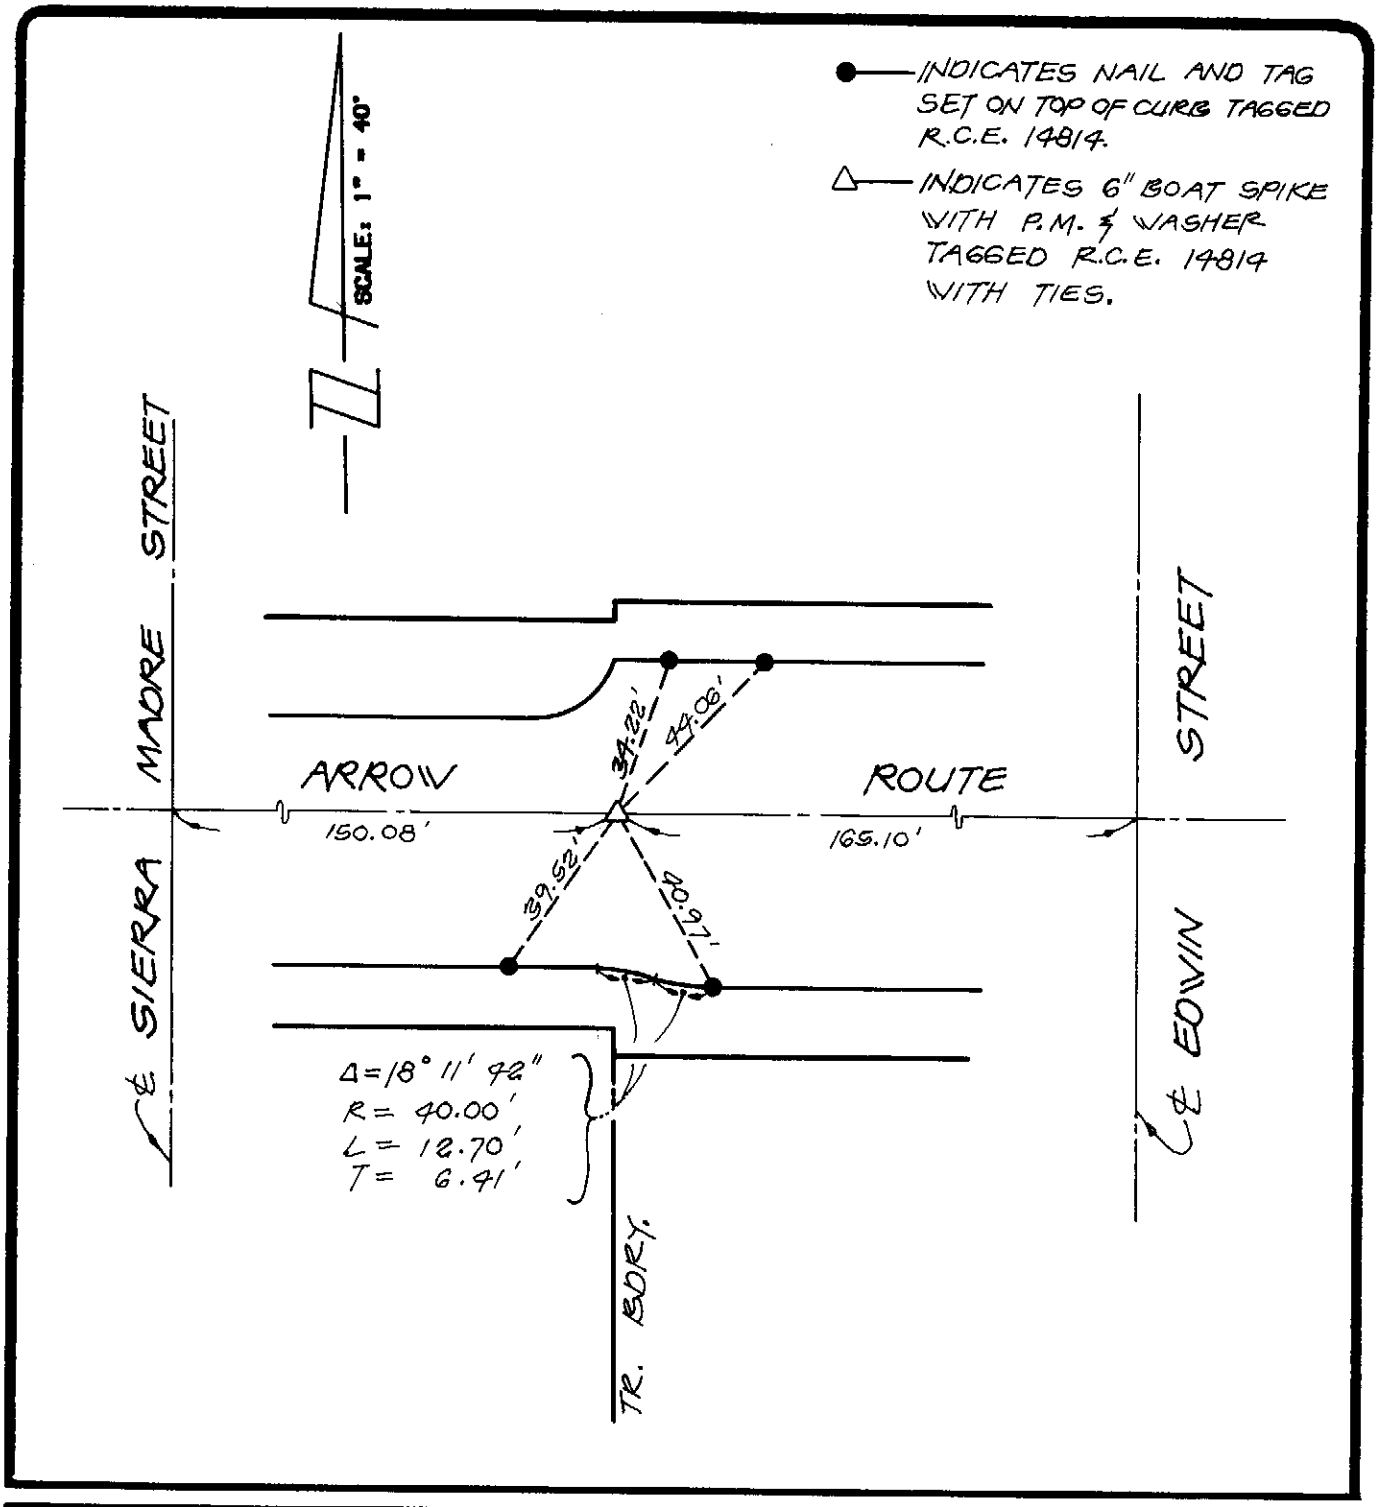

CITY OF RANCHO CUCAMONGA — STREET TIE	TRACT No. 12969
MADOLE AND ASSOCIATES, INC. OF SAN BERNARDINO COUNTY 545 N. Mountain Ave., Suite 105 UPLAND, CALIFORNIA 91786 PHONE (714) 946-2949	ARROW ROUTE
ENGR./L.S. J. M. MADOLE	FIELD REVIEW _____ DATE _____
R.C.E./L.S. No. 14814 DATE _____	TIE BOOK 15 PAGE 73

TRACT NO. 13542-3

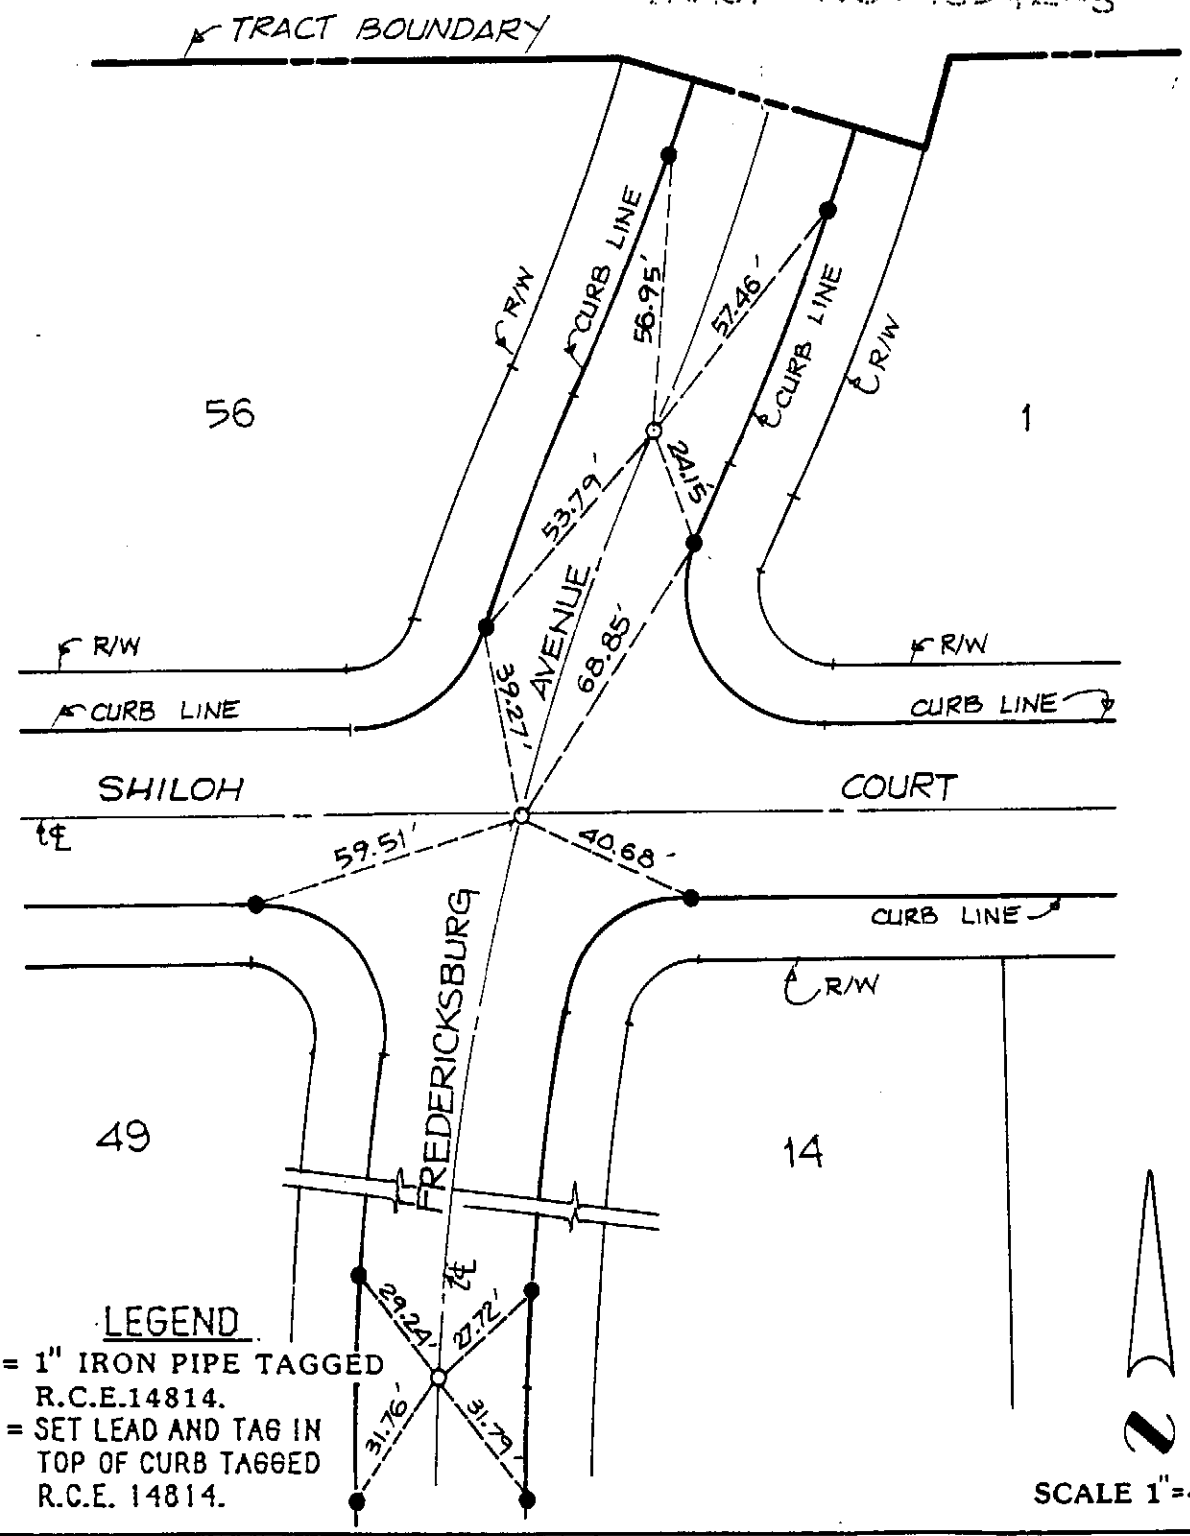

CITY OF RANCHO CUCAMONGA — STREET TIE	TRACT NO. 13542
MADOLE AND ASSOCIATES, INC. 1820 E. 16th Street SANTA ANA, CALIFORNIA 92701 PHONE 714 • 835-2548	SHILOH COURT AT FREDERICKSBURG AVE.
ENGR. J.M. MADOLE	FIELD REVIEW _____ DATE _____
R.C.E. NO. 14814 DATE _____	TIE BOOK 15 PAGE 74

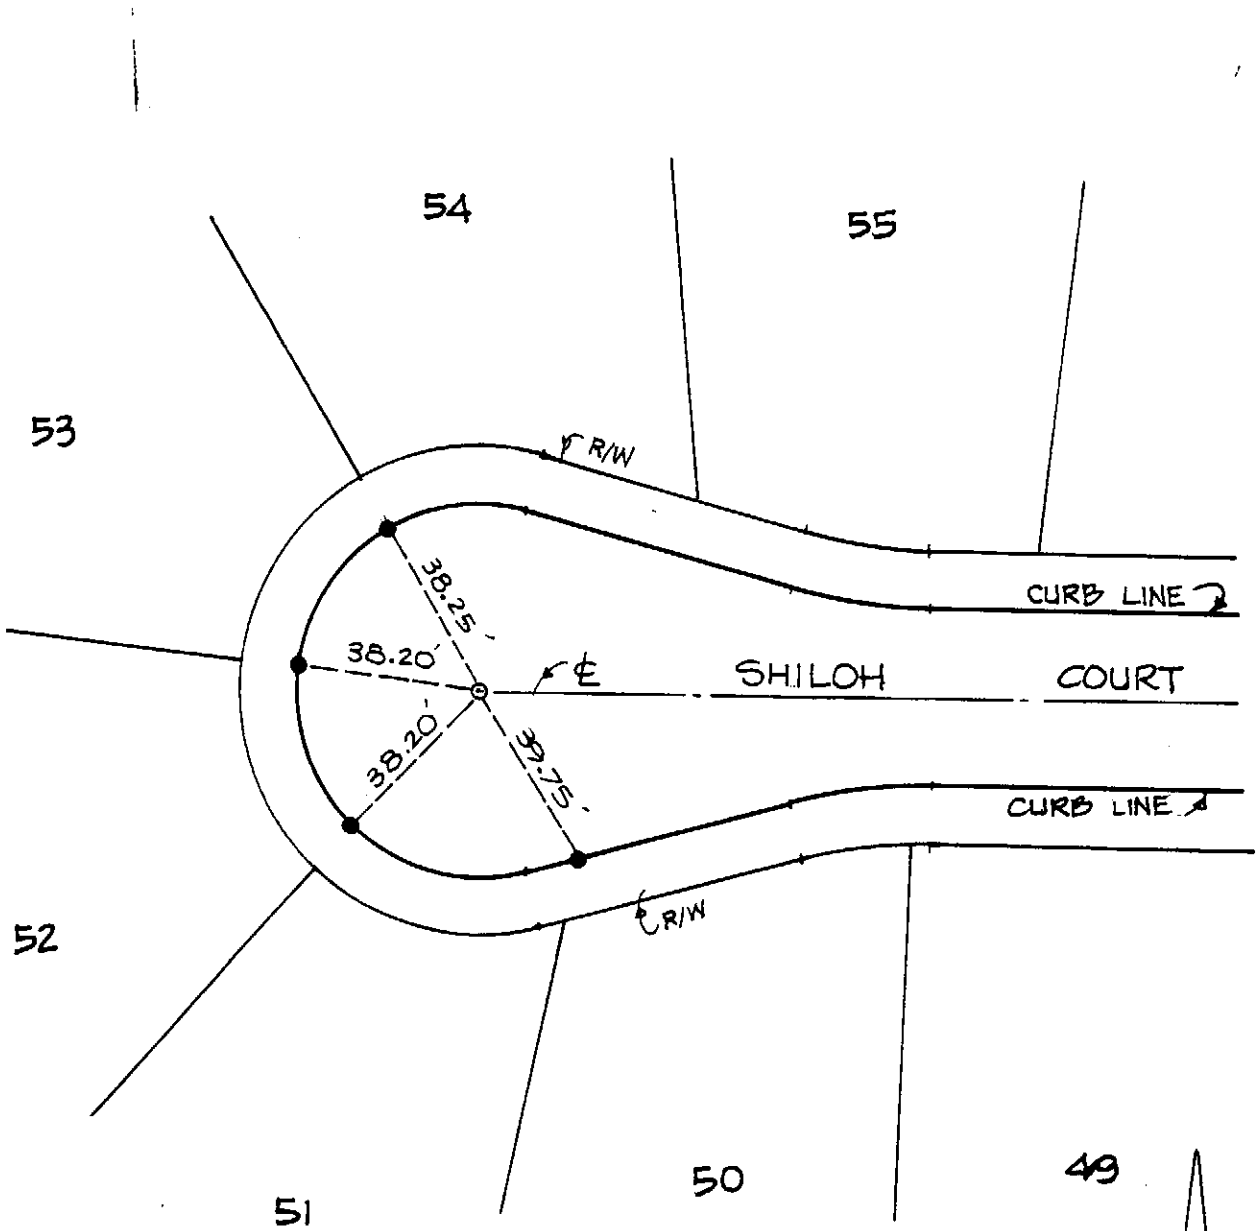

LEGEND

o = 1" IRON PIPE TAGGED R.C.E.14814.

• = SET LEAD AND TAG IN TOP OF CURB TAGGED R.C.E. 14814.

N

SCALE 1"=40'

CITY OF RANCHO CUCAMONGA — STREET TIE	TRACT NO. 13542
MADOLE AND ASSOCIATES, INC. 1820 E. 16th Street SANTA ANA, CALIFORNIA 92701 PHONE 714 • 835-2548	SHILOH COURT WESTERLY CUL-DE-SAC
ENGR. J.M. MADOLE	FIELD REVIEW _____ DATE _____
R.C.E. NO. 14814 DATE _____	TIE BOOK 15 PAGE 75

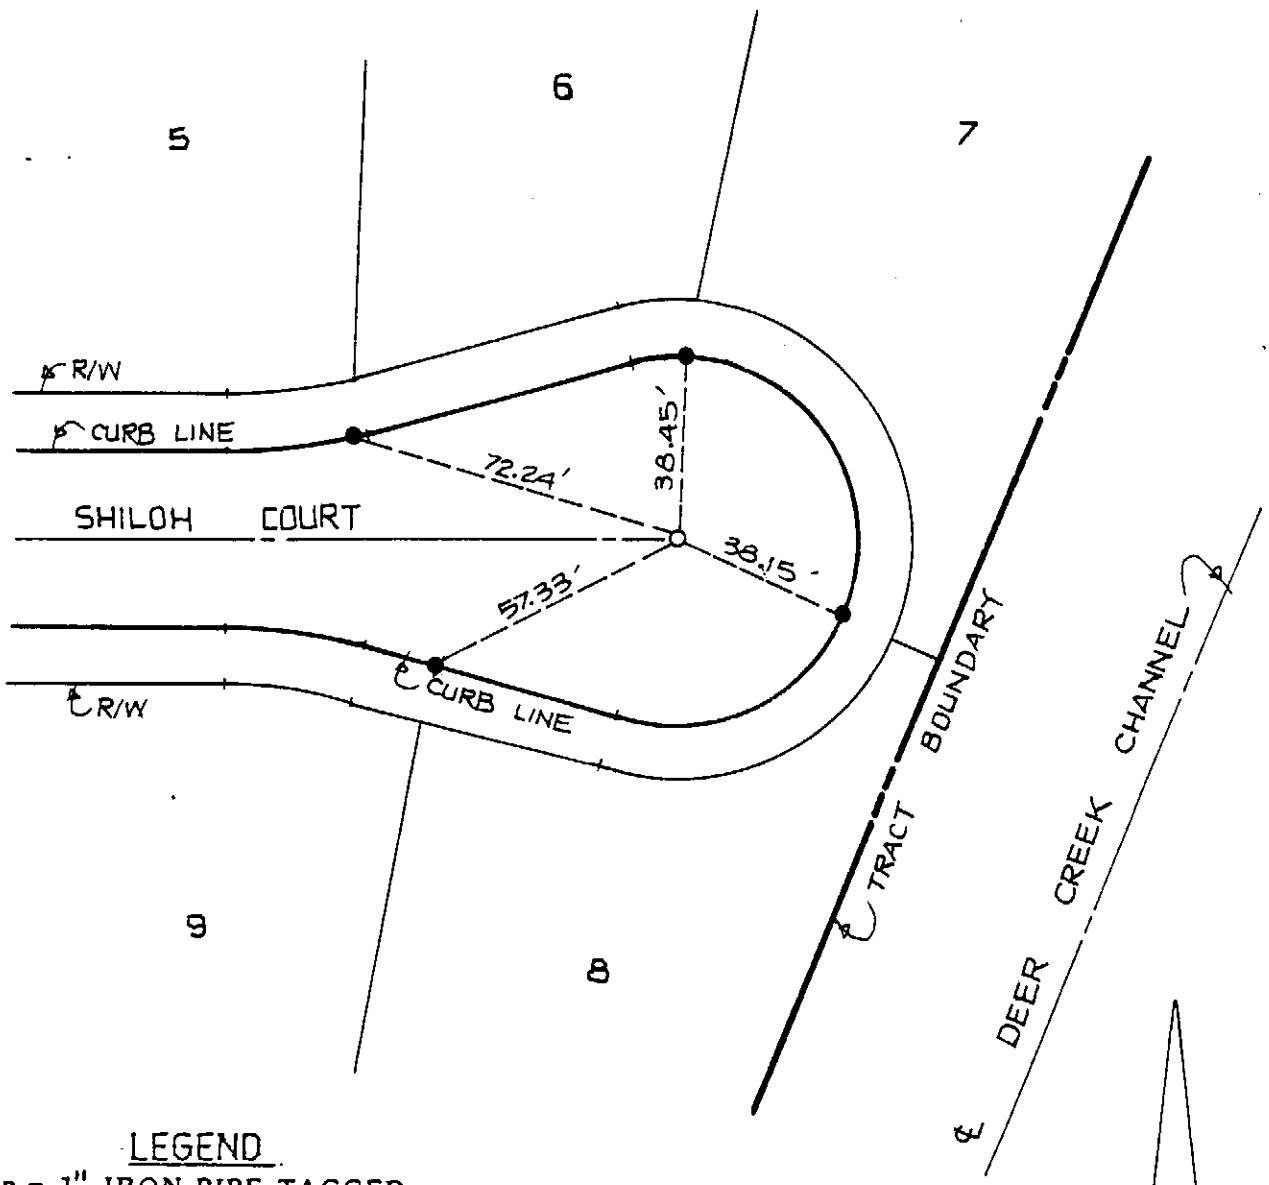

LEGEND

▫ = 1" IRON PIPE TAGGED R.C.E.14814.

• = SET LEAD AND TAG IN TOP OF CURB TAGGED R.C.E. 14814.

SCALE 1"=40'

CITY OF RANCHO CUCAMONGA — STREET TIE	TRACT NO. 13542
MADOLE AND ASSOCIATES, INC. 1820 E. 16th Street SANTA ANA, CALIFORNIA 92701 PHONE 714 • 835-2548	SHILOH COURT EASTERLY CUL-DE-SAC
ENGR. J.M. MADOLE	FIELD REVIEW _____ DATE _____
R.C.E. NO. 14814 DATE _____	TIE BOOK 15 PAGE 76

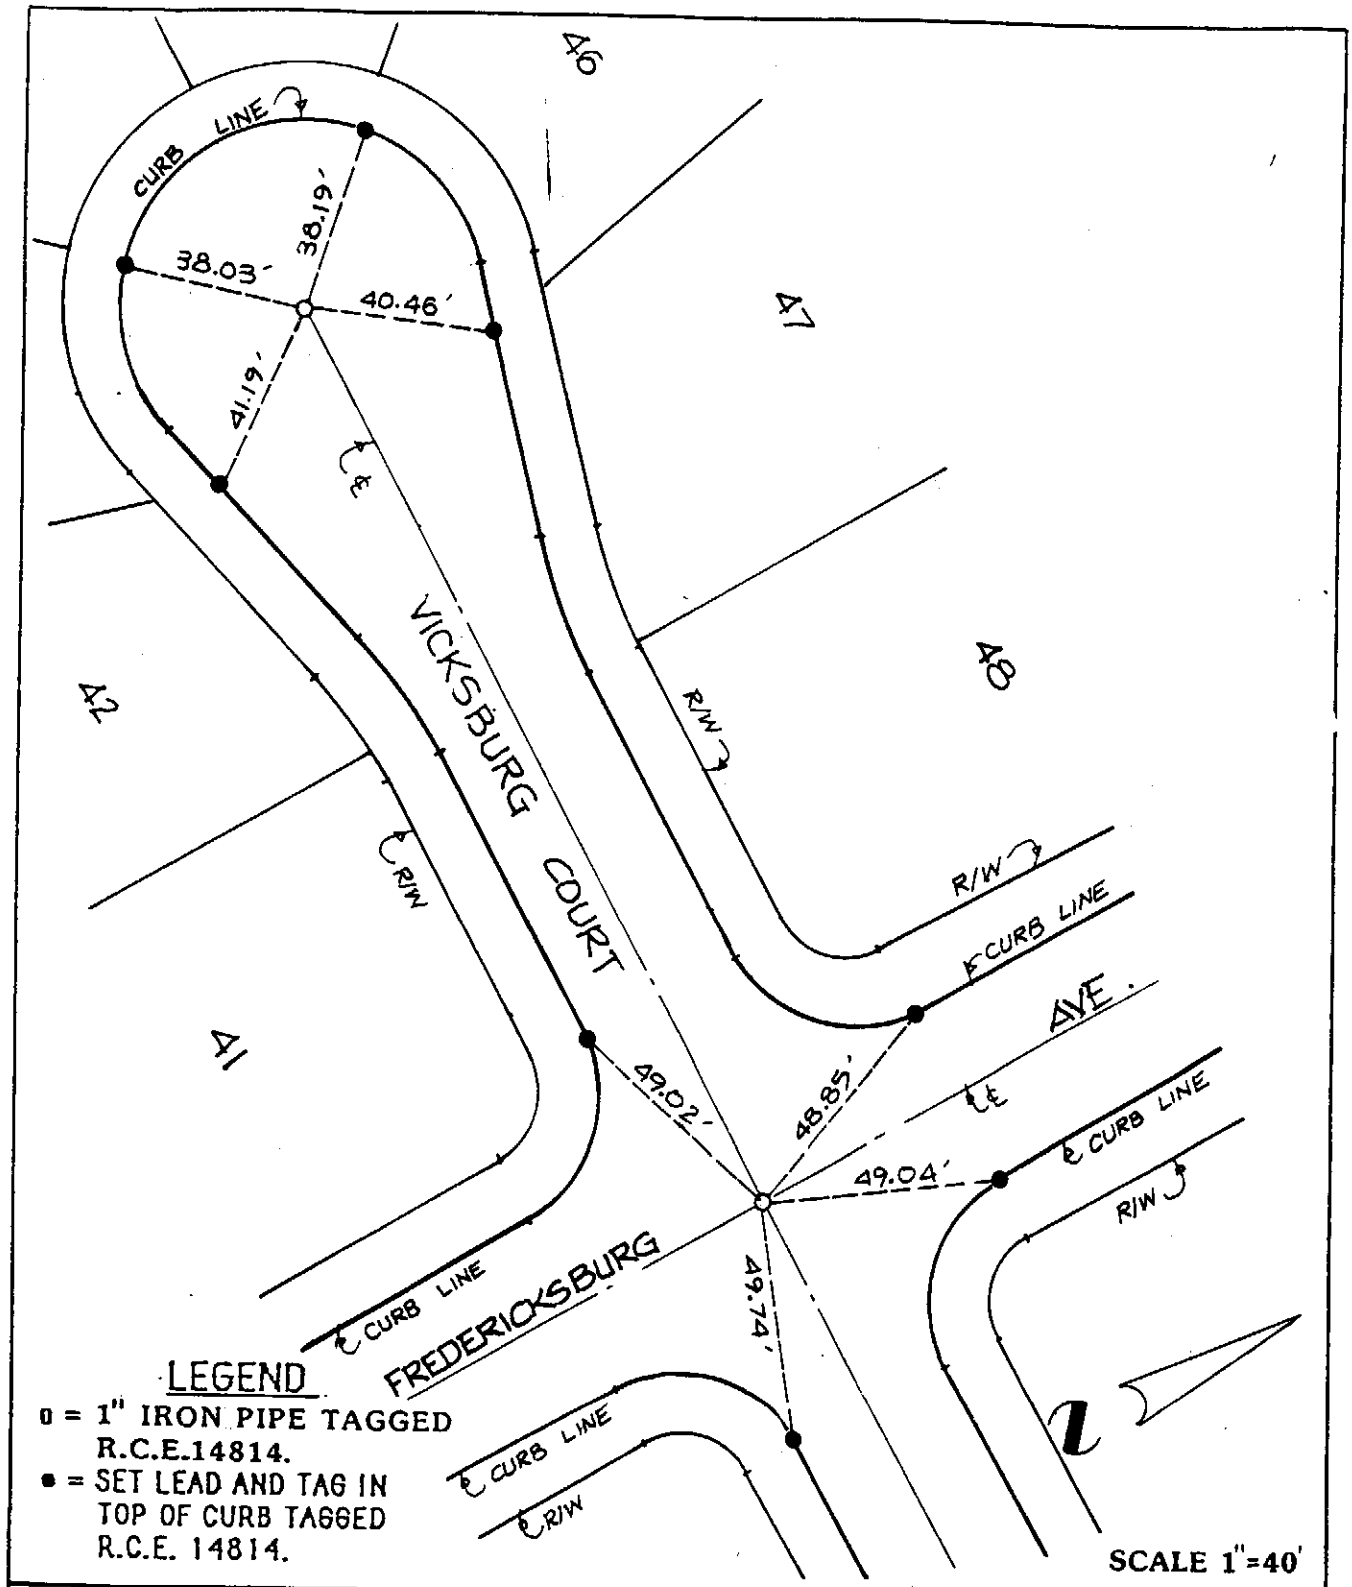

CITY OF RANCHO CUCAMONGA — STREET TIE	TRACT NO. 13542
MADOLE AND ASSOCIATES, INC. 1820 E. 16th Street SANTA ANA, CALIFORNIA 92701 PHONE 714 • 835-2548	VICKSBURG COURT WESTERLY CUL-DE-SAC
ENGR. J.M. MADOLE	FIELD REVIEW _____ DATE _____
R.C.E. NO. 14814 DATE _____	TIE BOOK 15 PAGE 77

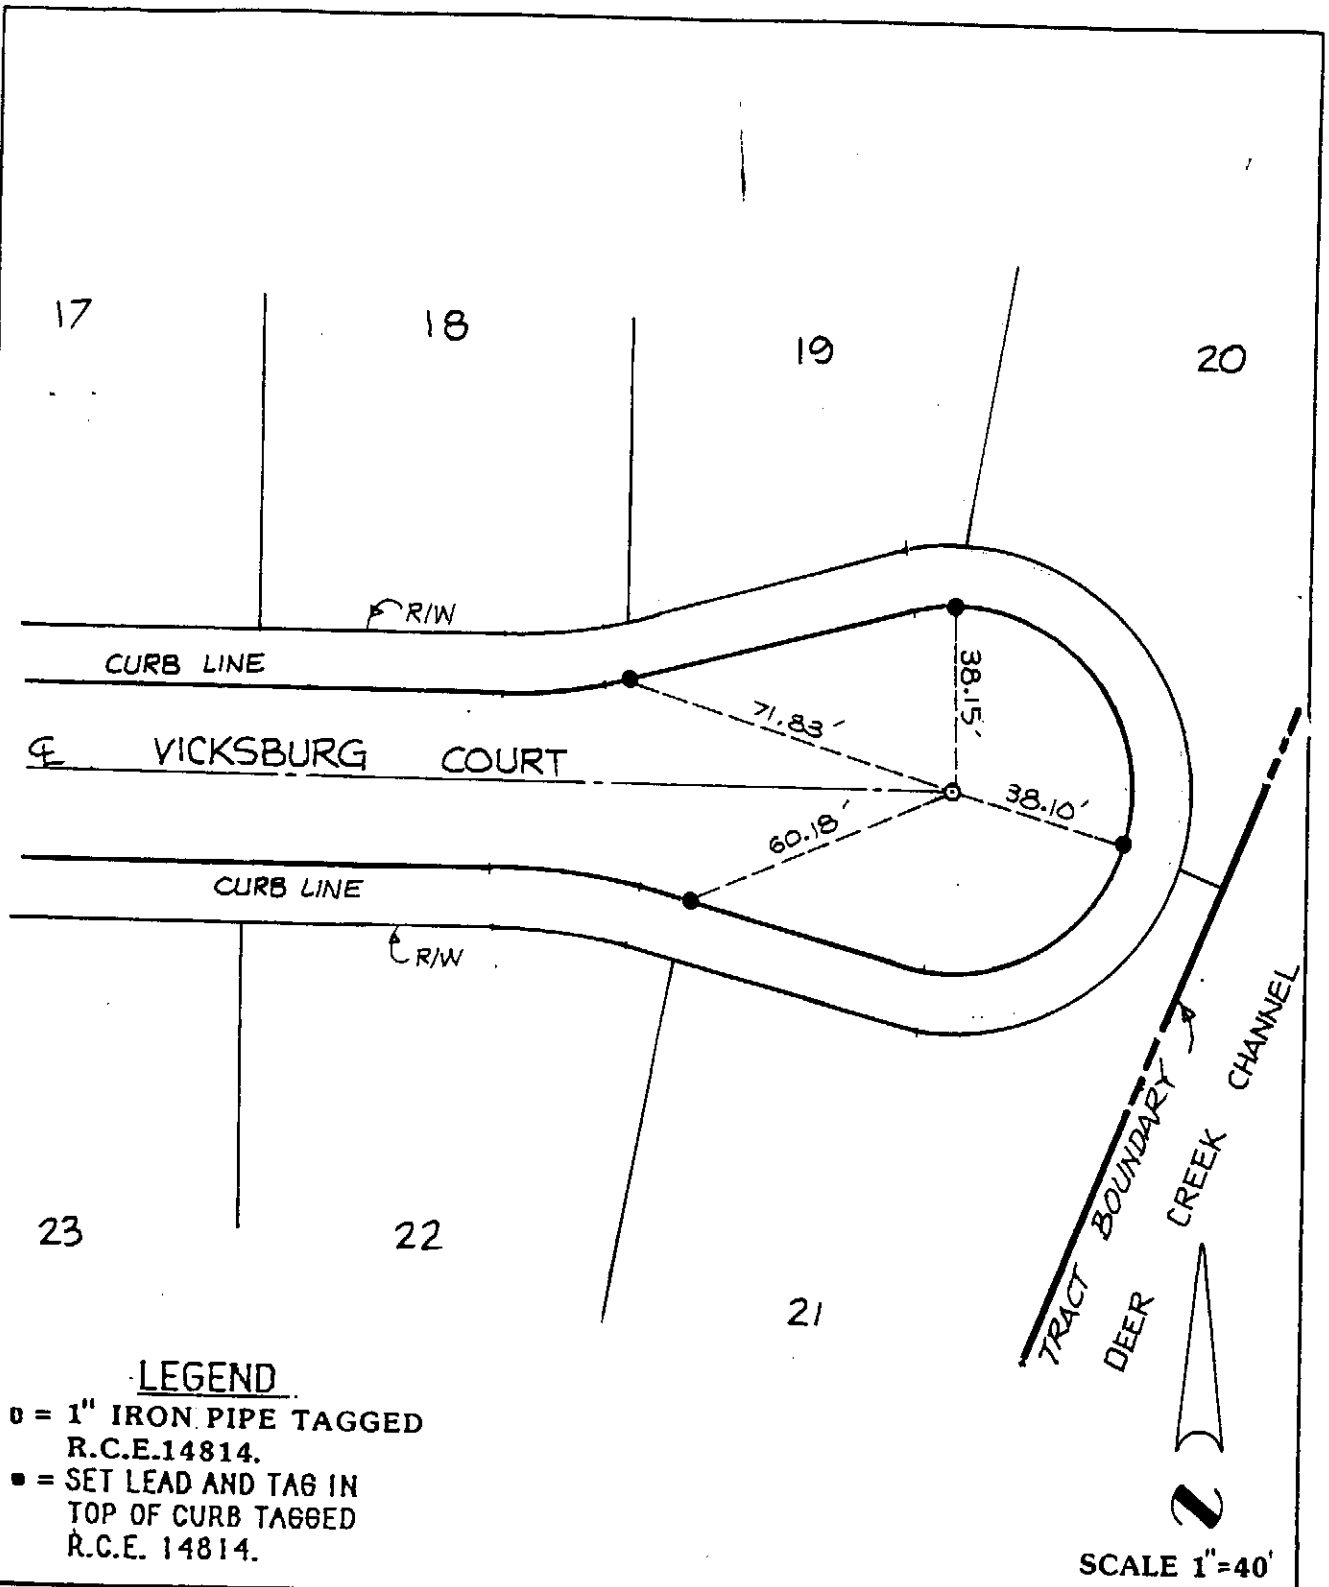

LEGEND

o = 1" IRON PIPE TAGGED R.C.E.14814.

■ = SET LEAD AND TAG IN TOP OF CURB TAGGED R.C.E. 14814.

SCALE 1"=40'

CITY OF RANCHO CUCAMONGA STREET TIE	TRACT NO. 13542
MADOLE AND ASSOCIATES, INC. 1820 E. 16th Street SANTA ANA, CALIFORNIA 92701 PHONE 714 • 835-2548	VICKSBURG COURT EASTERLY CUL-DE-SAC
ENGR. J.M. MADOLE	FIELD REVIEW _____ DATE _____
R.C.E. NO. 14814 DATE _____	TIE BOOK 15 PAGE 78

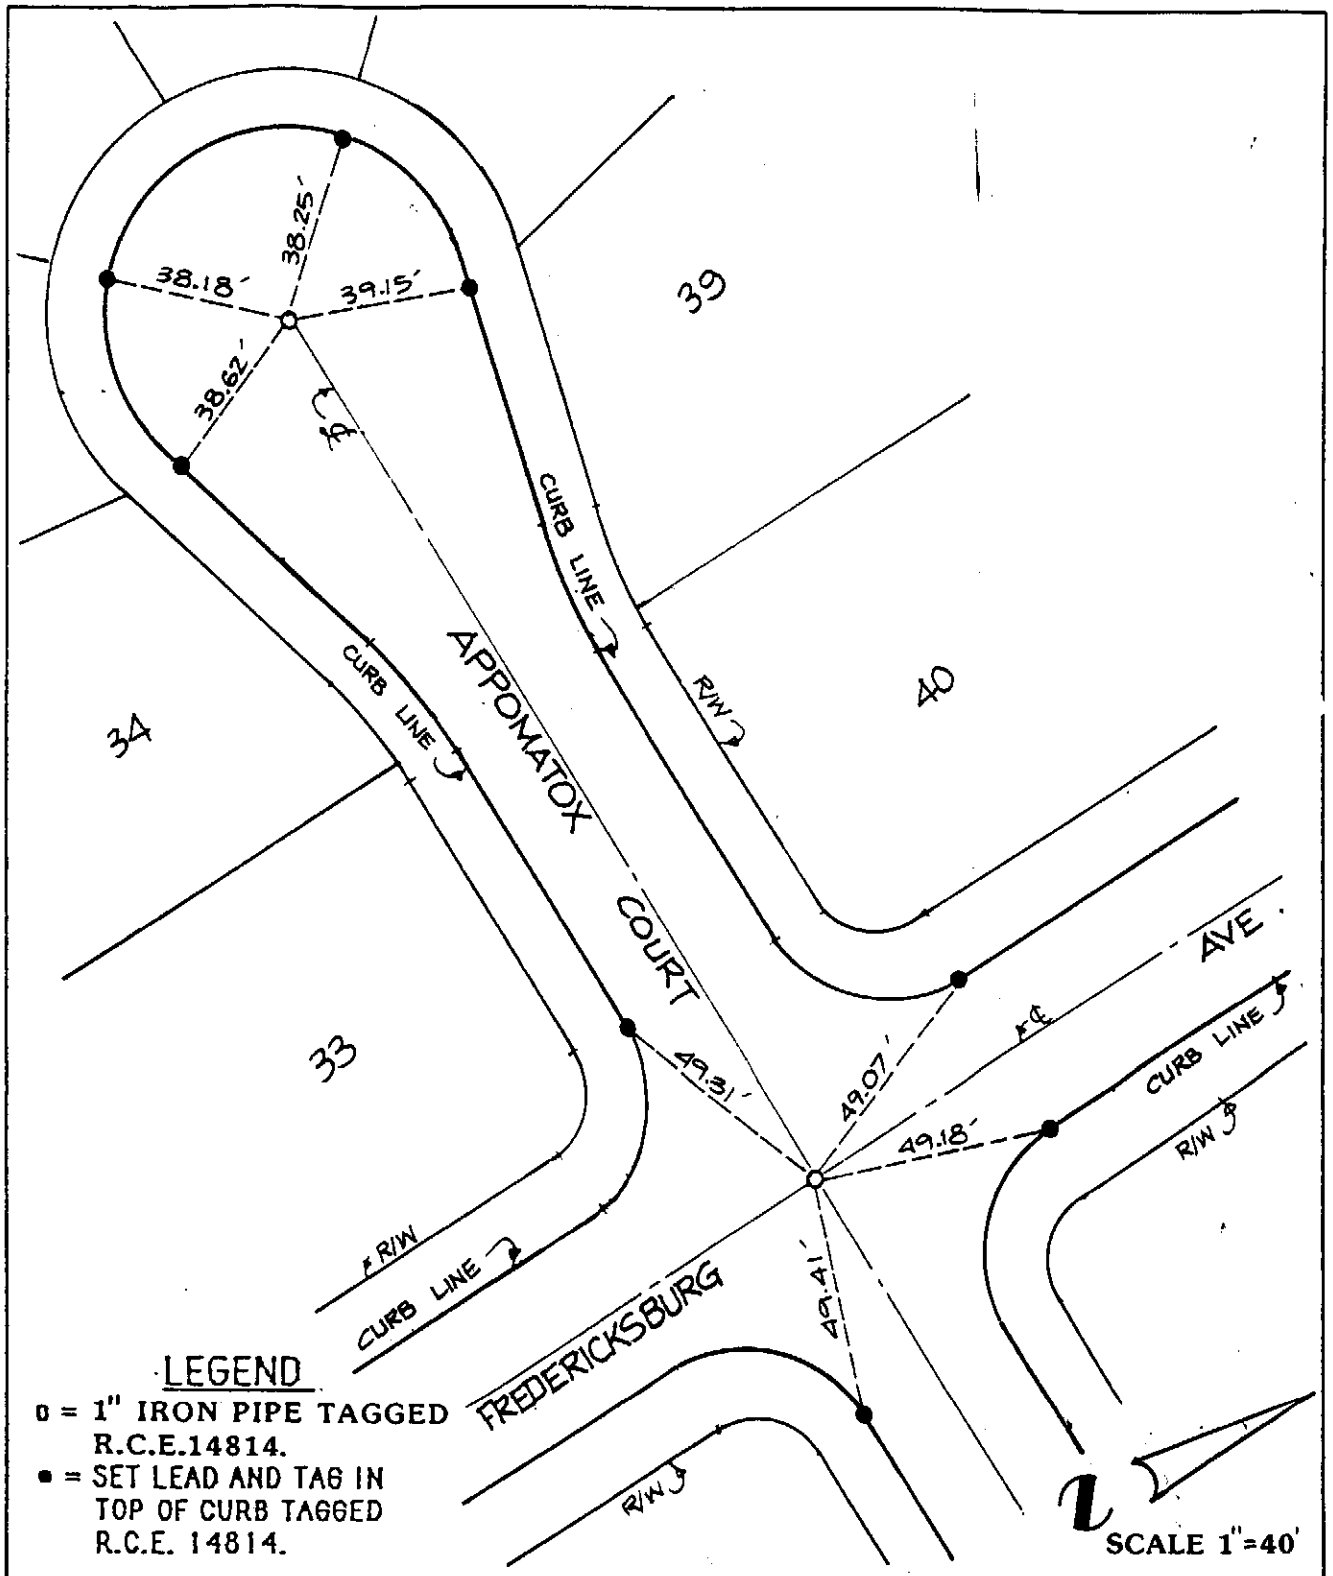

CITY OF RANCHO CUCAMONGA — STREET TIE	TRACT NO. 13542
MADOLE AND ASSOCIATES, INC. 1820 E. 16th Street SANTA ANA, CALIFORNIA 92701 PHONE 714 • 835-2548	APPOMATOX COURT AT FREDERICKSBURG WESTERLY CUL-DE-SAC
ENGR. J.M. MADOLE	FIELD REVIEW _____ DATE _____
R.C.E. NO. 14814 DATE _____	TIE BOOK 15 PAGE 79

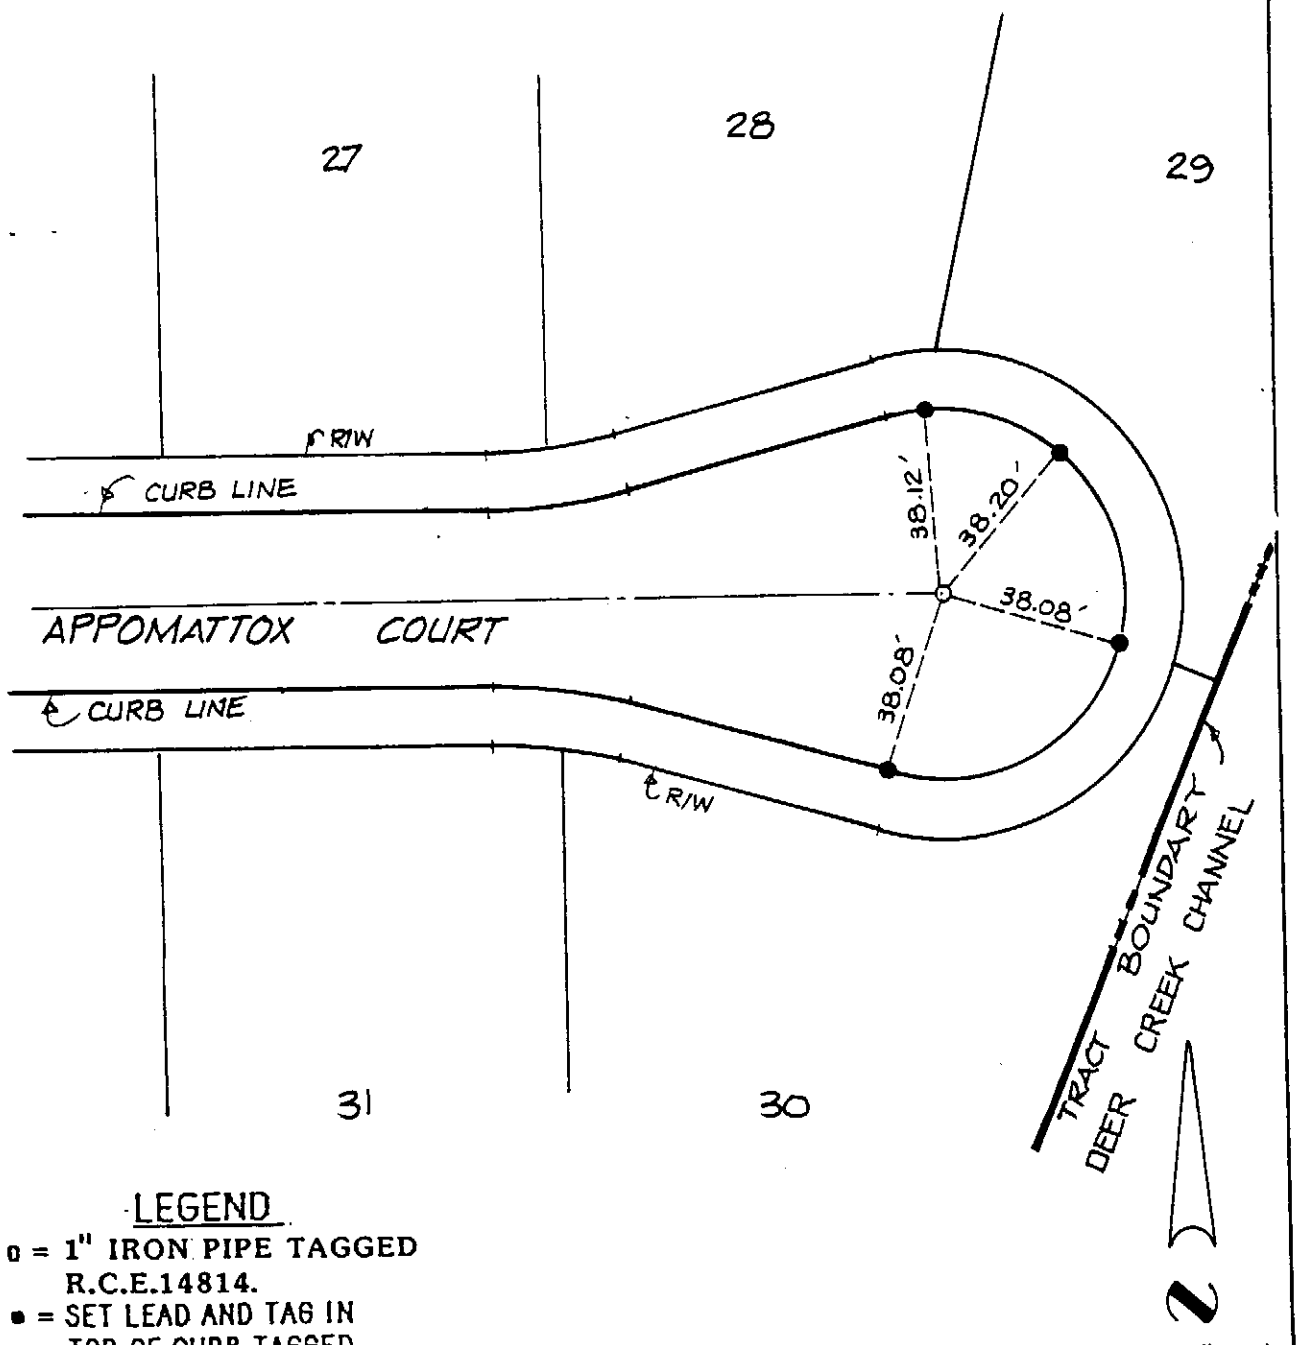

LEGEND

o = 1" IRON PIPE TAGGED R.C.E.14814.

• = SET LEAD AND TAG IN TOP OF CURB TAGGED R.C.E. 14814.

SCALE 1"=40'

CITY OF RANCHO CUCAMONGA — STREET TIE	TRACT NO. 13542
MADOLE AND ASSOCIATES, INC. 1820 E. 16th Street SANTA ANA, CALIFORNIA 92701 PHONE 714 • 835-2548	APPOMATOX COURT EASTERLY CUL-DE-SAC
ENGR. J.M. MADOLE	FIELD REVIEW _____ DATE _____
R.C.E. NO. 14814 DATE _____	TIE BOOK 15 PAGE 80

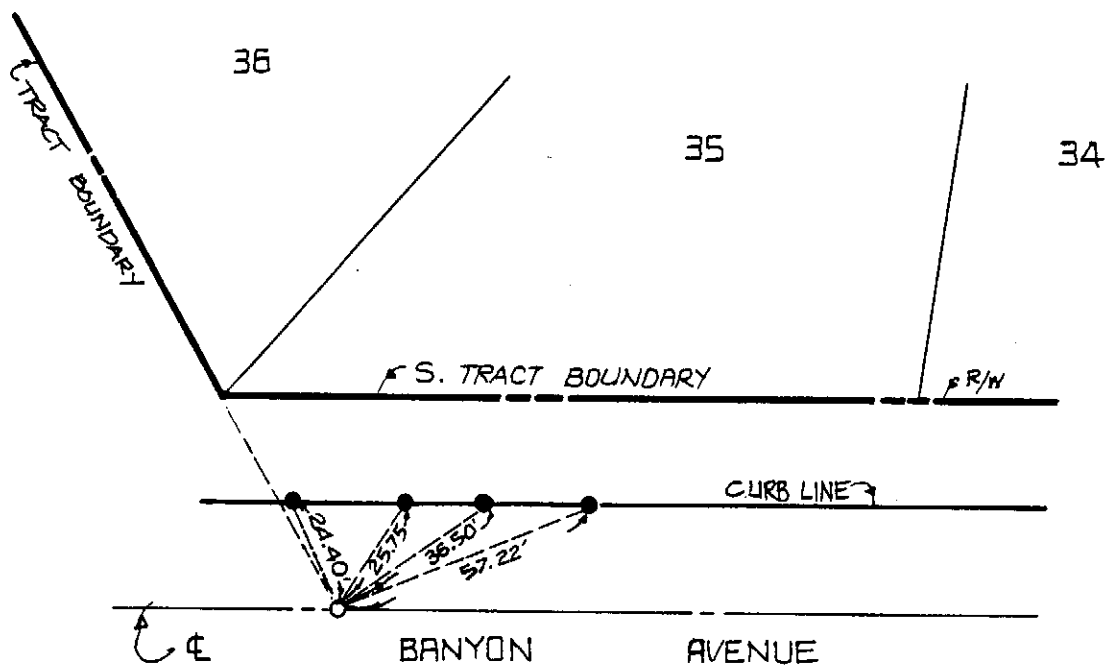

LEGEND

o = 1" IRON PIPE TAGGED R.C.E.14814.

• = SET LEAD AND TAG IN TOP OF CURB TAGGED R.C.E. 14814.

N

SCALE 1"=40'

CITY OF RANCHO CUCAMONGA — STREET TIE	TRACT NO. 13542
MADOLE AND ASSOCIATES, INC. 1820 E. 16th Street SANTA ANA, CALIFORNIA 92701 PHONE 714 • 835-2548	BANYON AVENUE AT TR 13542 TRACT WESTERLY BOUNDRY
ENGR. J.M. MADOLE	FIELD REVIEW _____ DATE _____
R.C.E. NO. 14814 DATE _____	TIE BOOK 15 PAGE 81

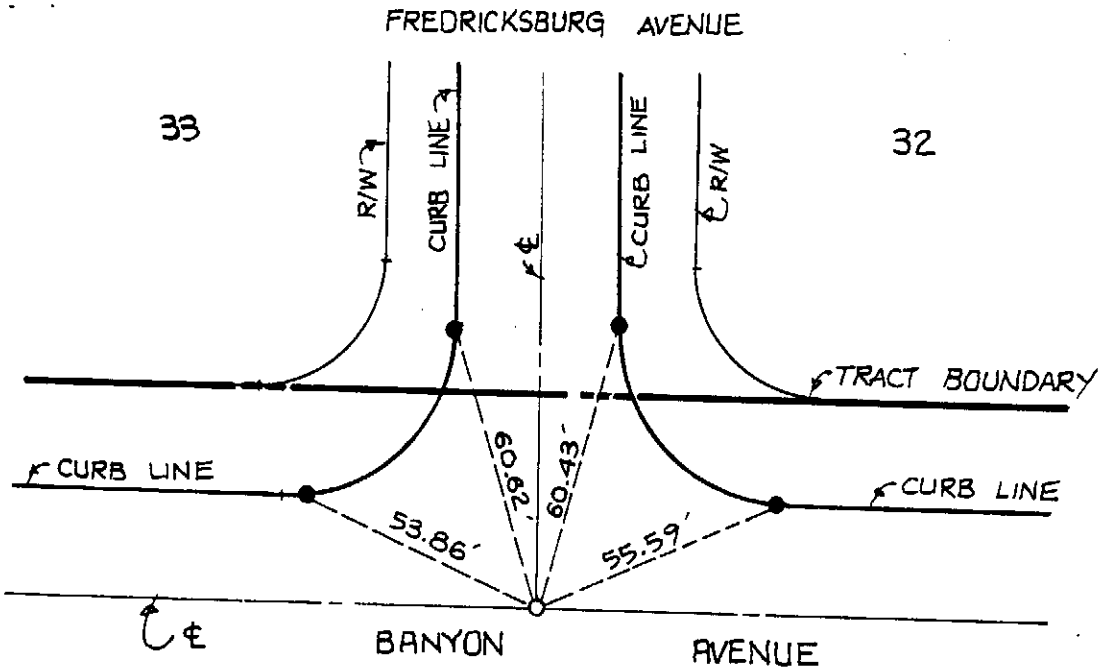

LEGEND

o = 1" IRON PIPE TAGGED R.C.E.14814.

• = SET LEAD AND TAG IN TOP OF CURB TAGGED R.C.E. 14814.

SCALE 1"=40'

CITY OF RANCHO CUCAMONGA — STREET TIE	TRACT NO. 13542
MADOLE AND ASSOCIATES, INC. 1820 E. 16th Street SANTA ANA, CALIFORNIA 92701 PHONE 714 • 835-2548	BANYAN AVENUE AT FREDRICKSBURG
ENGR. J.M. MADOLE	FIELD REVIEW _____ DATE _____
R.C.E. NO. 14814 DATE _____	TIE BOOK 15 PAGE 82

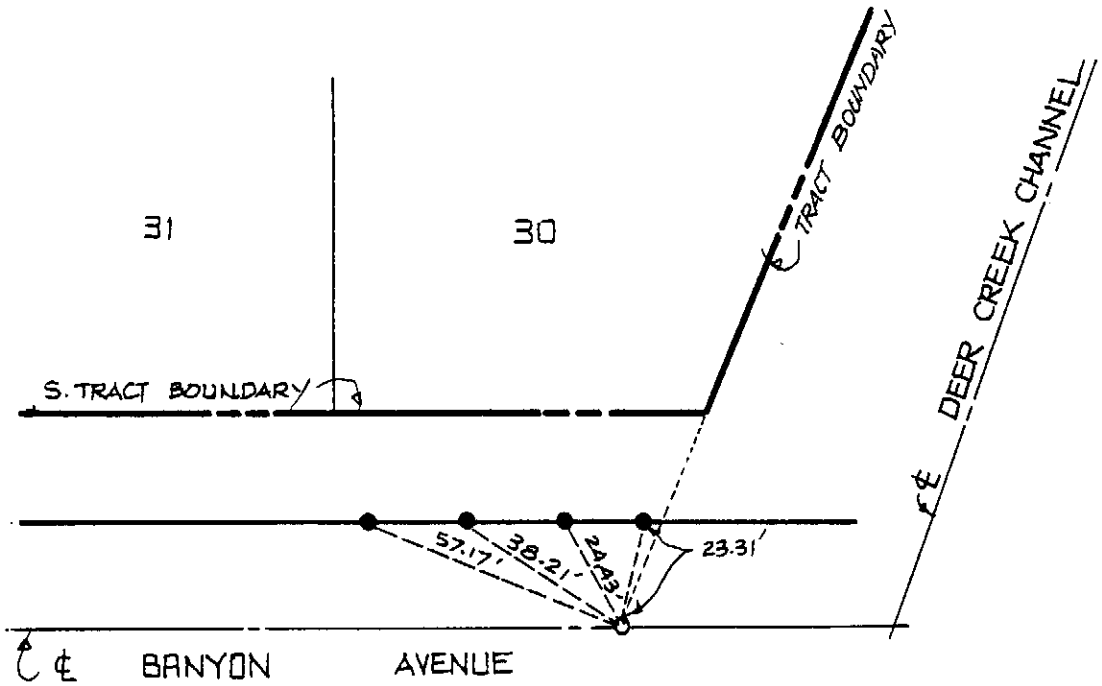

LEGEND

o = 1" IRON PIPE TAGGED R.C.E.14814.

• = SET LEAD AND TAG IN TOP OF CURB TAGGED R.C.E. 14814.

SCALE 1"=40'

CITY OF RANCHO CUCAMONGA — STREET TIE	TRACT NO. 13542
MADOLE AND ASSOCIATES, INC. 1820 E. 16th Street SANTA ANA, CALIFORNIA 92701 PHONE 714 • 835-2548	BANYAN AVENUE AT TRACT 13542 EASTERLY BOUNDARY
ENGR. J.M. MADOLE	FIELD REVIEW _____ DATE _____
R.C.E. NO. 14814 DATE _____	TIE BOOK 15 PAGE 83

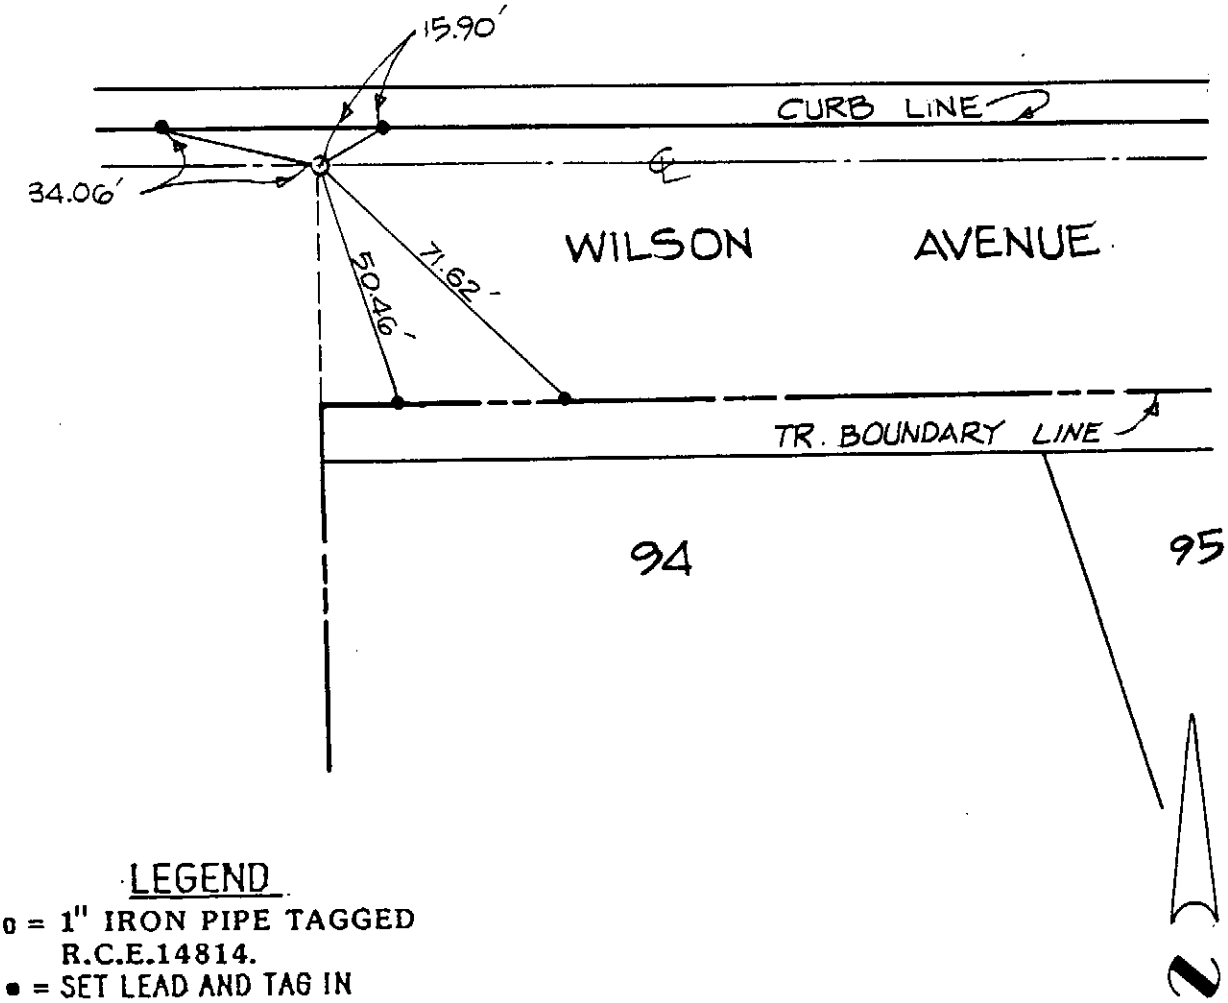

LEGEND

o = 1" IRON PIPE TAGGED R.C.E.14814.

• = SET LEAD AND TAG IN TOP OF CURB TAGGED R.C.E. 14814.

SCALE 1"=40'

CITY OF RANCHO CUCAMONGA — STREET TIE	TRACT NO. 13542-1
MADOLE AND ASSOCIATES, INC. 1820 E. 16th Street SANTA ANA, CALIFORNIA 92701 PHONE 714 • 835-2548	WILSON AVENUE TR 13542-1 WESTERLY BOUNDARY
ENGR. J.M. MADOLE	FIELD REVIEW _____ DATE _____
R.C.E. NO. 14814 DATE _____	TIE BOOK 15 PAGE 84

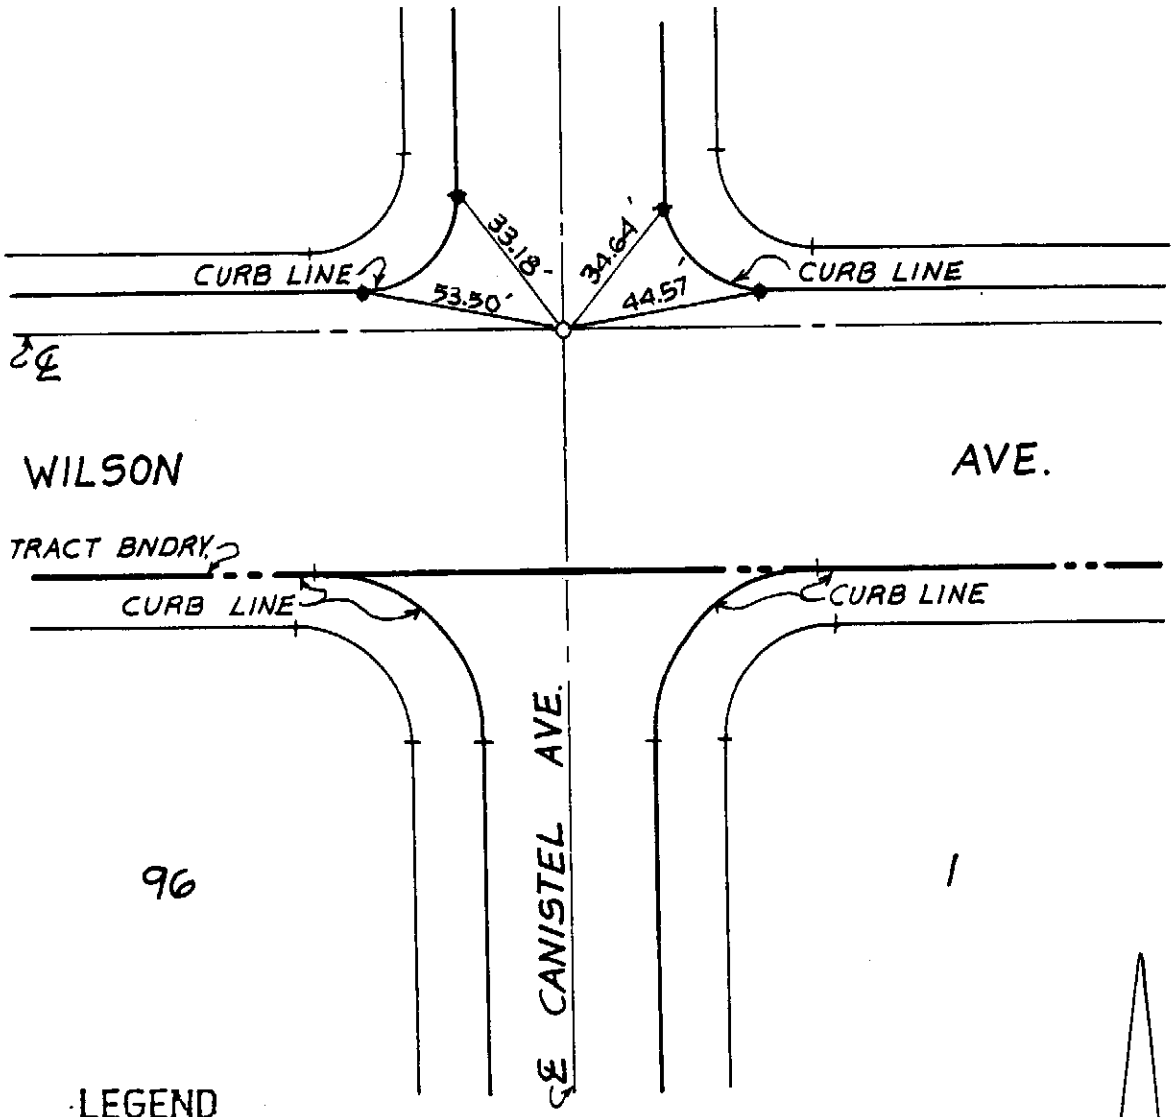

LEGEND

o = 1" IRON PIPE TAGGED R.C.E.14814.

• = SET LEAD AND TAG IN TOP OF CURB TAGGED R.C.E. 14814.

N

SCALE 1"=40'

CITY OF RANCHO CUCAMONGA — STREET TIE	TRACT NO. 13542-1
MADOLE AND ASSOCIATES, INC. 1820 E. 16th Street SANTA ANA, CALIFORNIA 92701 PHONE 714 • 835-2548	WILSON AVENUE ℄ CANISTEL AVENUE
ENGR. J.M. MADOLE	FIELD REVIEW _____ DATE _____
R.C.E. NO. 14814 DATE _____	TIE BOOK 15 PAGE 85

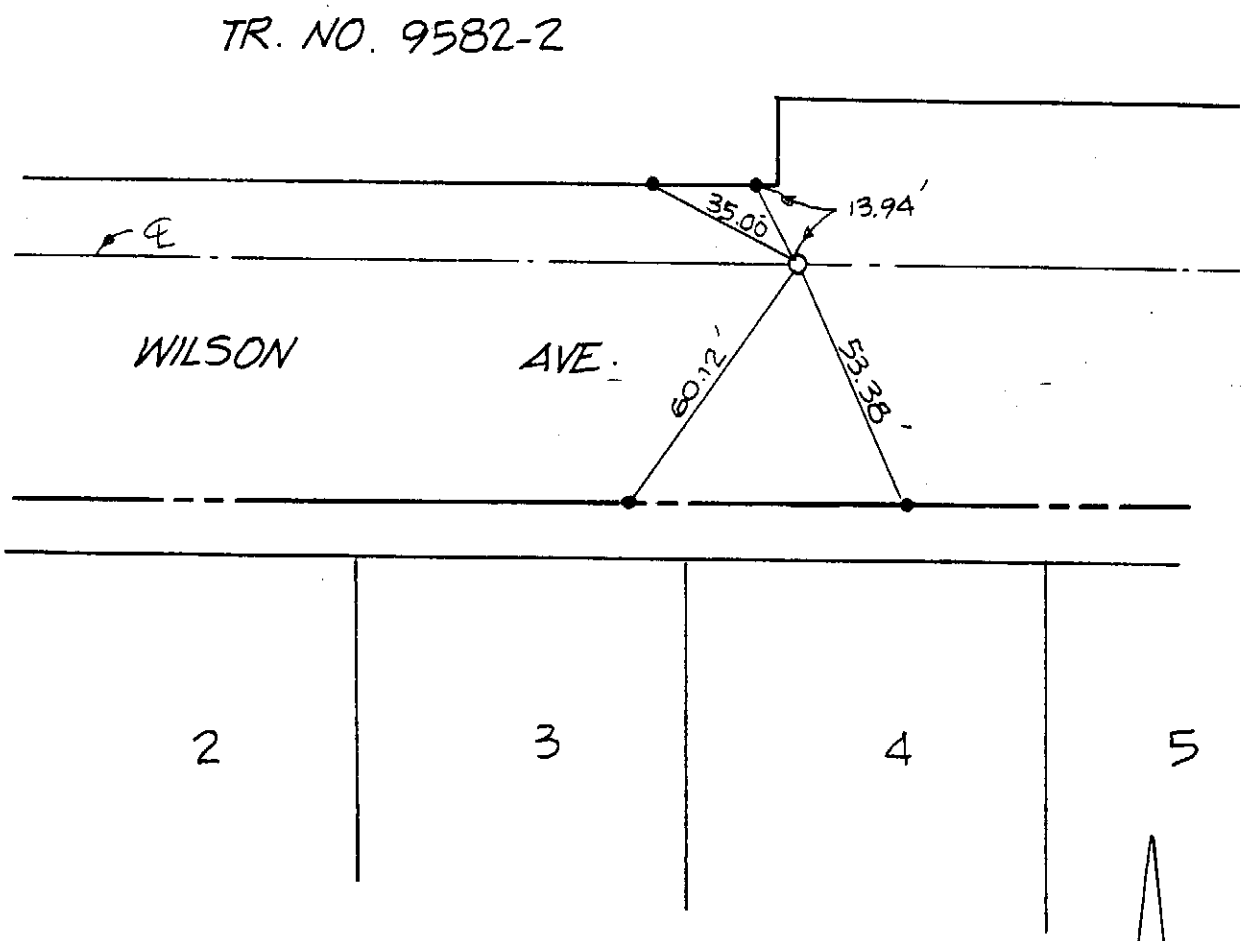

LEGEND

o = 1" IRON PIPE TAGGED R.C.E.14814.

• = SET LEAD AND TAG IN TOP OF CURB TAGGED R.C.E. 14814.

SCALE 1"=40'

CITY OF RANCHO CUCAMONGA — STREET TIE	TRACT NO. 13542-1
MADOLE AND ASSOCIATES, INC. 1820 E. 16th Street SANTA ANA, CALIFORNIA 92701 PHONE 714 • 835-2548	WILSON AVENUE WESTERLY OF DEER CREEK
ENGR. J.M. MADOLE	FIELD REVIEW _____ DATE _____
R.C.E. NO. 14814 DATE _____	TIE BOOK 15 PAGE 86

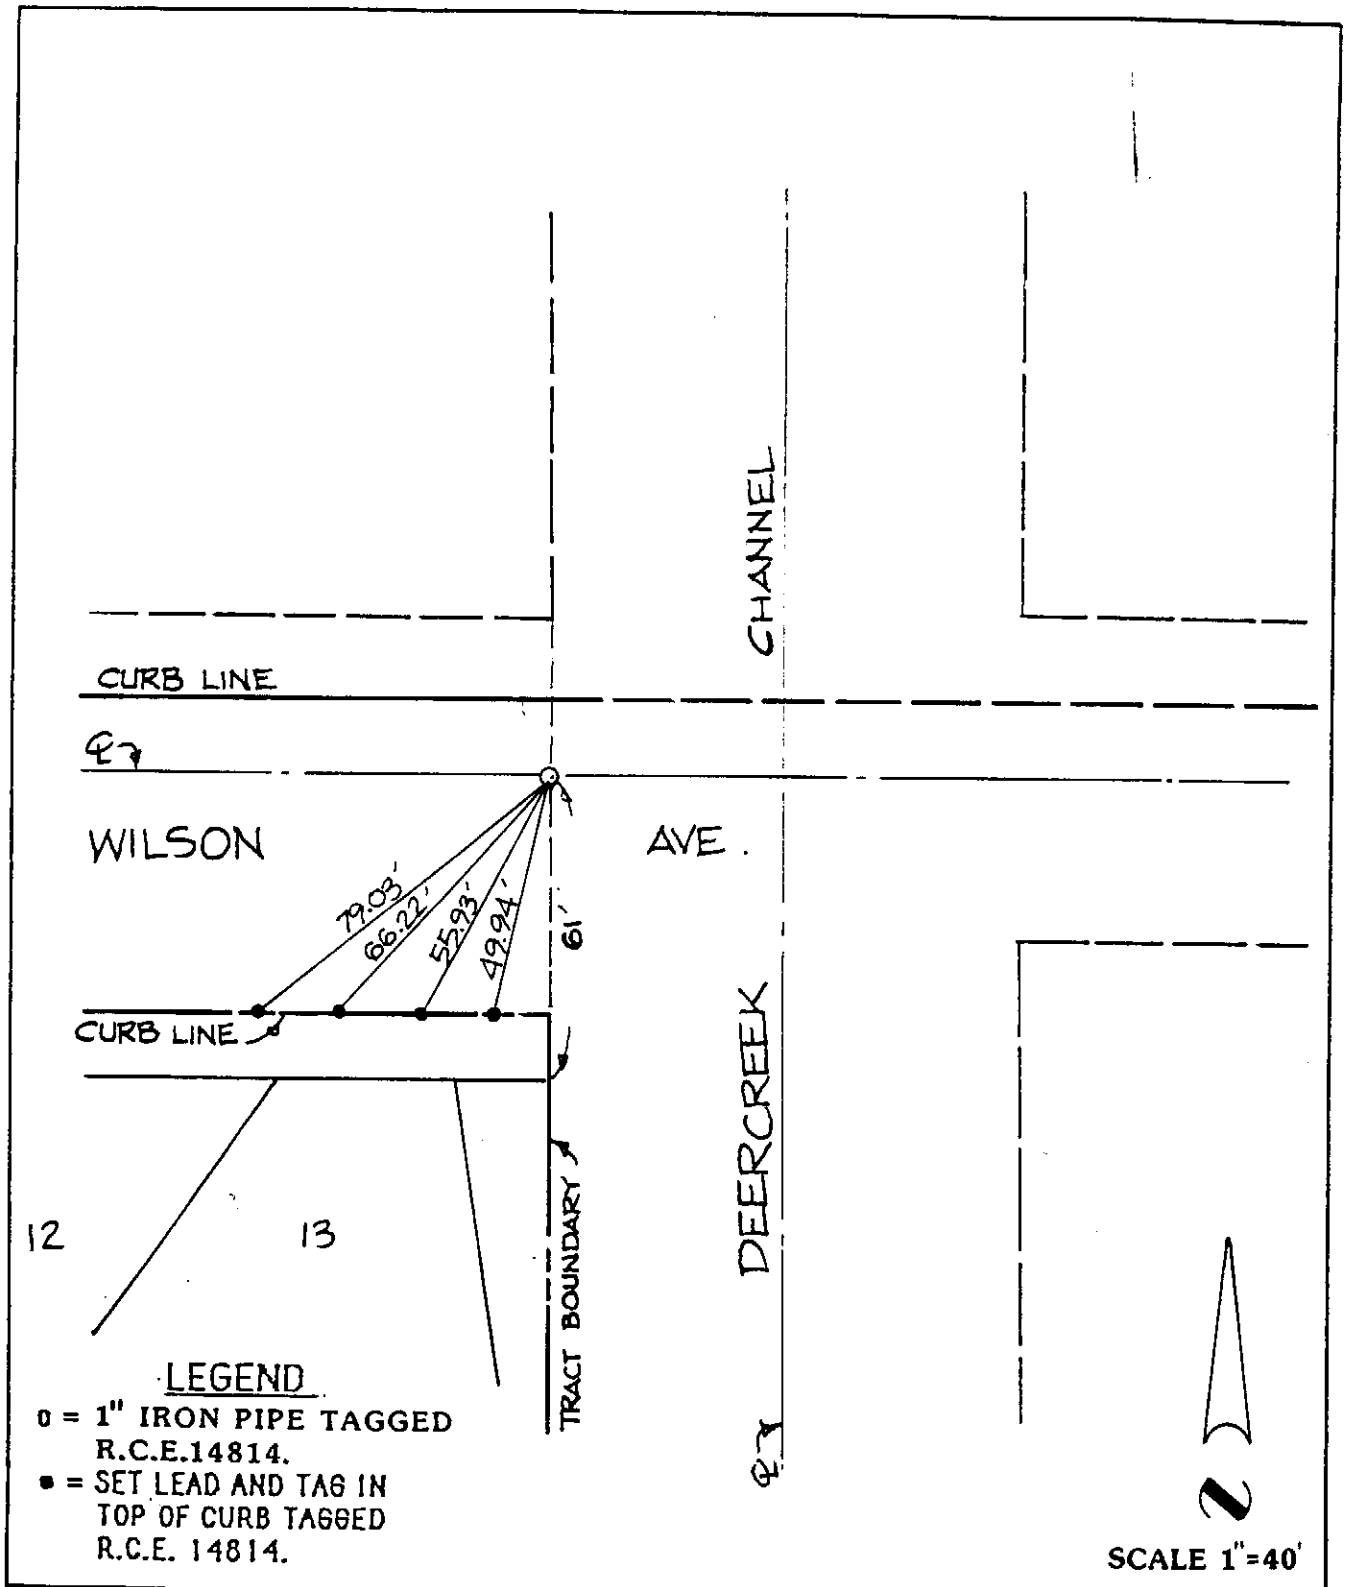

CITY OF RANCHO CUCAMONGA — STREET TIE	TRACT NO. 13542-1
MADOLE AND ASSOCIATES, INC. 1820 E. 16th Street SANTA ANA, CALIFORNIA 92701 PHONE 714 • 835-2548	WILSON AVENUE AT DEER CREEK CHANNEL
ENGR. J.M. MADOLE	FIELD REVIEW _____ DATE _____
R.C.E. NO. 14814 DATE _____	TIE BOOK 15 PAGE 87

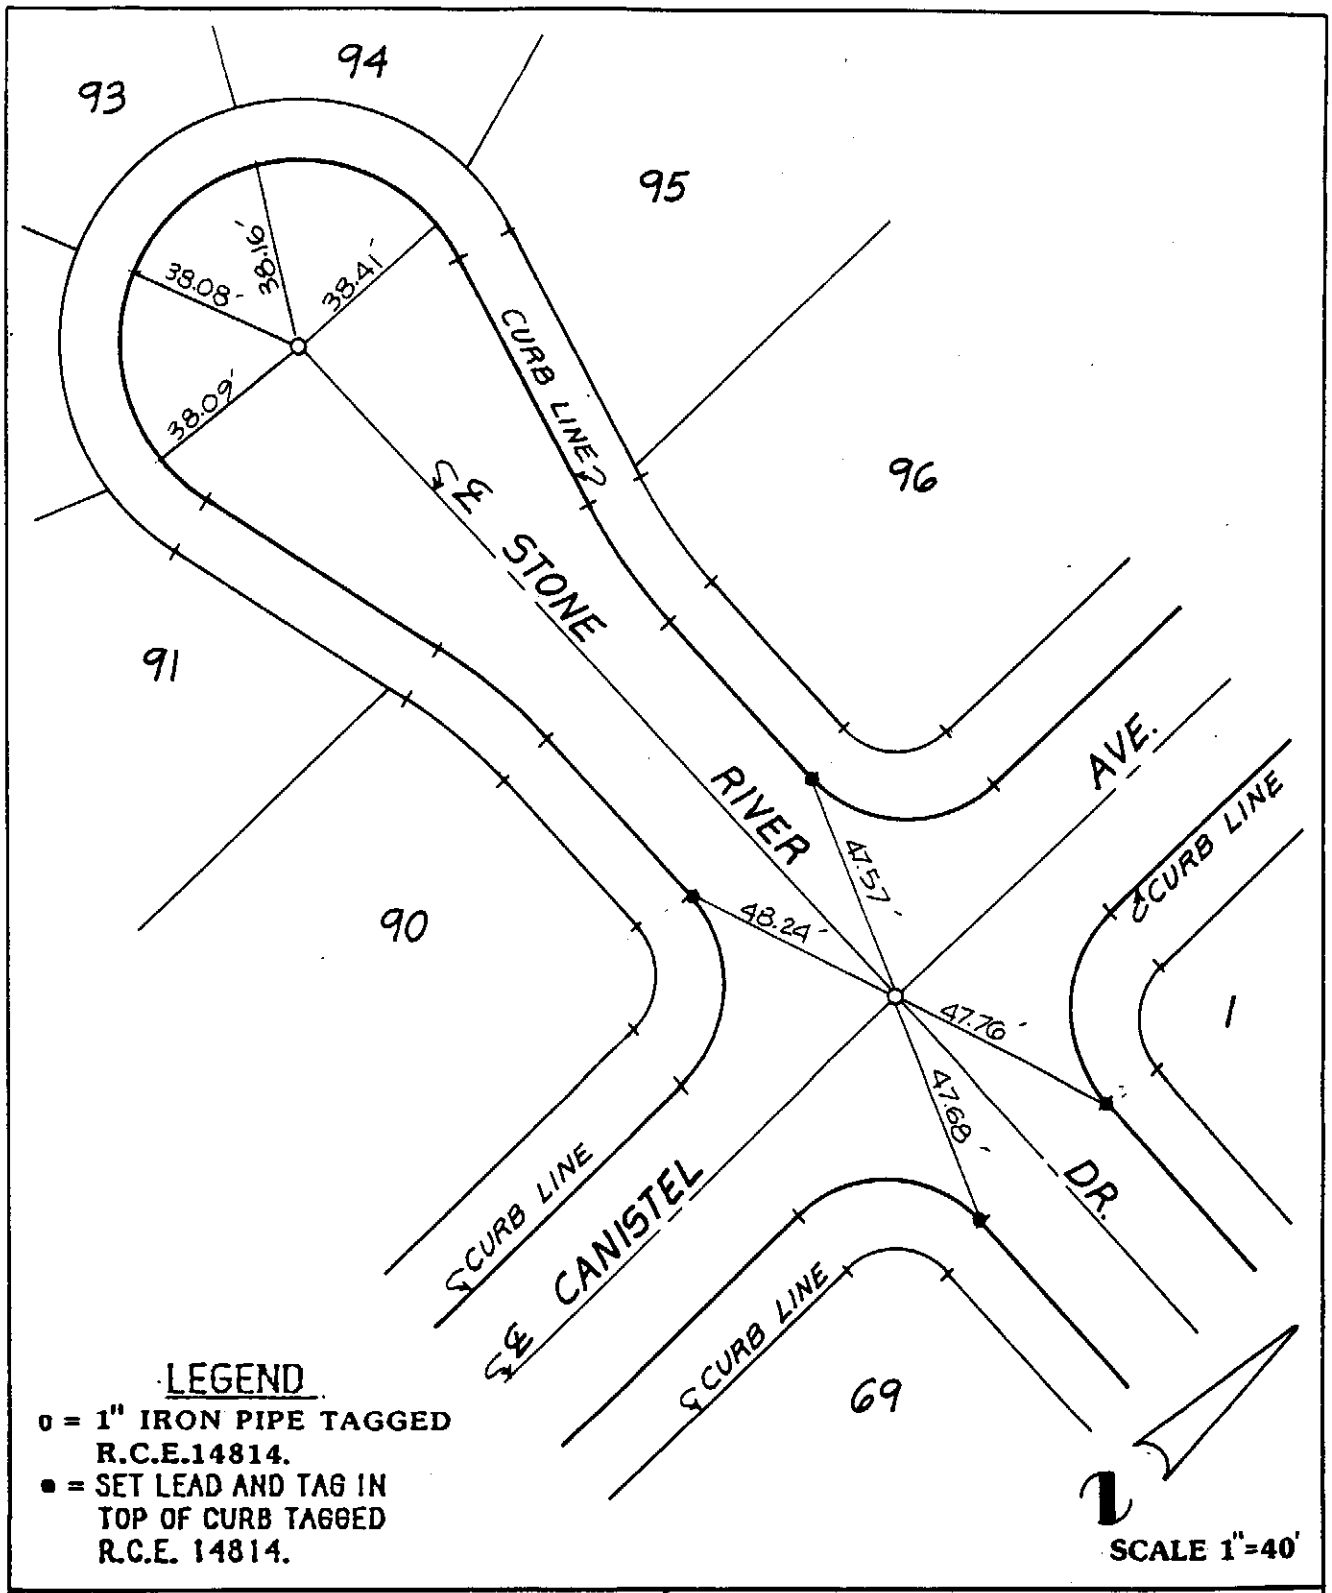

LEGEND

o = 1" IRON PIPE TAGGED R.C.E.14814.

• = SET LEAD AND TAG IN TOP OF CURB TAGGED R.C.E. 14814.

SCALE 1"=40'

CITY OF RANCHO CUCAMONGA — STREET TIE	TRACT NO. 13542-1
MADOLE AND ASSOCIATES, INC. 1820 E. 16th Street SANTA ANA, CALIFORNIA 92701 PHONE 714 • 835-2548	STONE RIVER DRIVE & CANISTEL AVENUE
ENGR. J.M. MADOLE	FIELD REVIEW _____ DATE _____
R.C.E. NO. 14814 DATE _____	TIE BOOK 15 PAGE 88

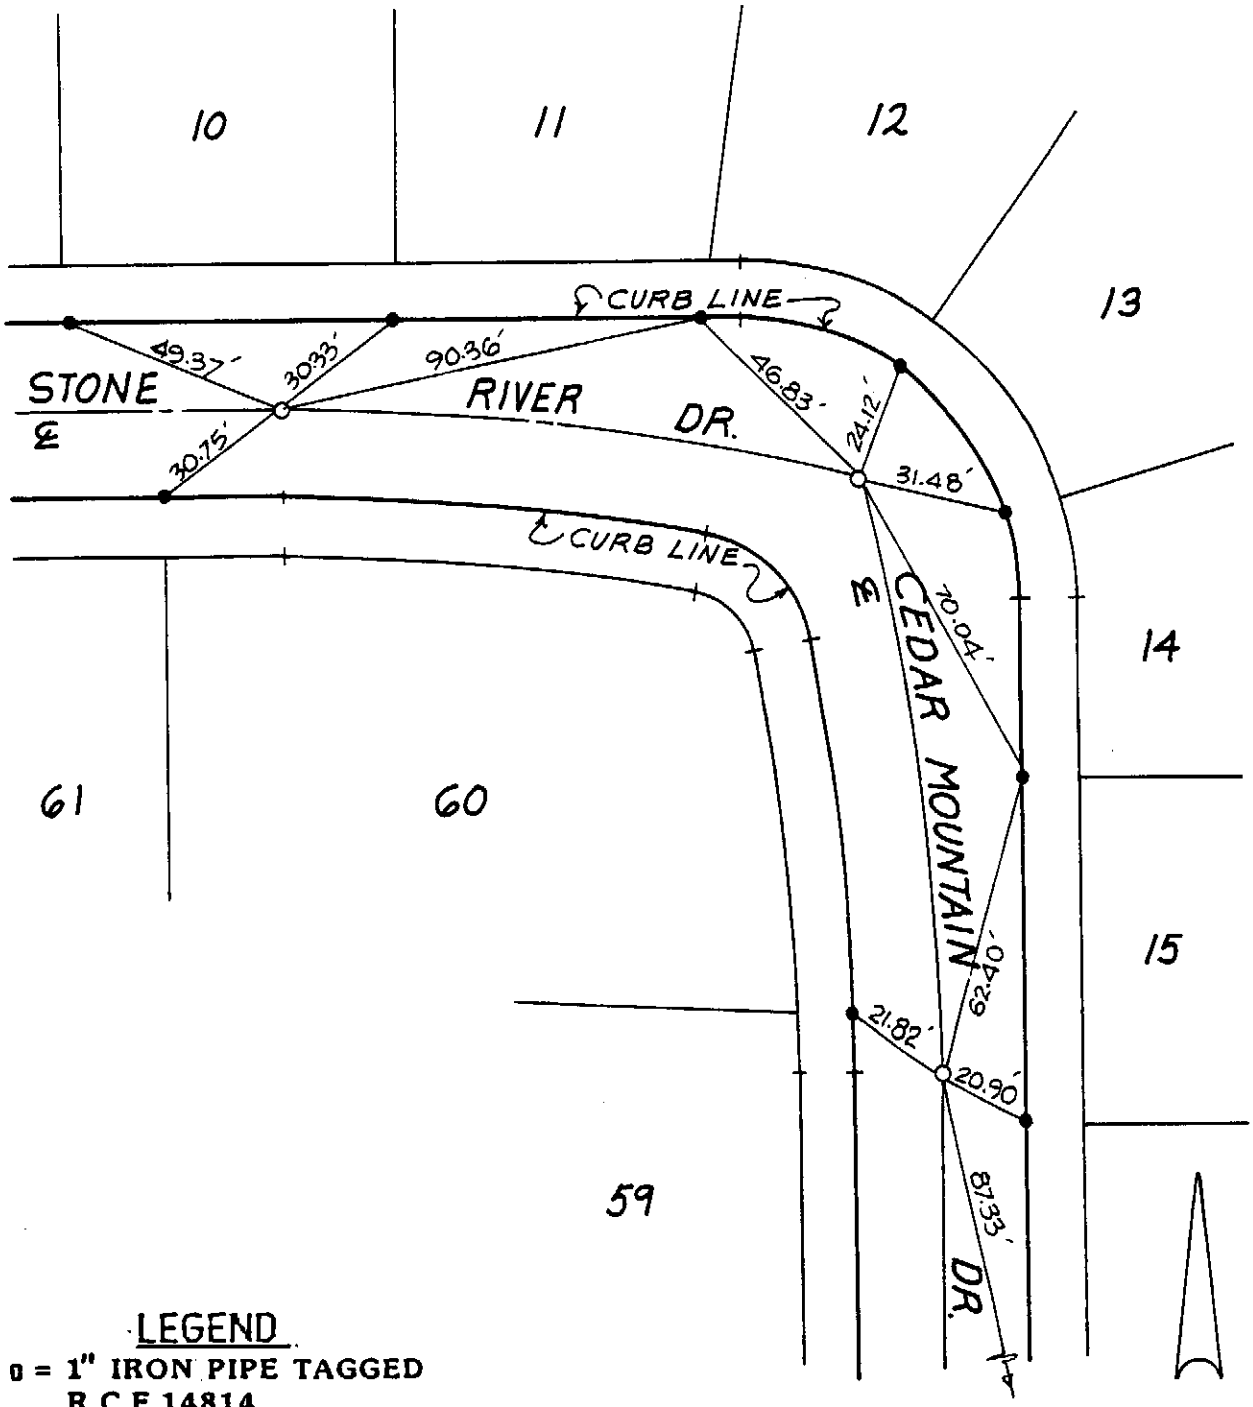

LEGEND

o = 1" IRON PIPE TAGGED R.C.E.14814.

■ = SET LEAD AND TAG IN TOP OF CURB TAGGED R.C.E. 14814.

SCALE 1"=40'

CITY OF RANCHO CUCAMONGA — STREET TIE	TRACT NO. 13542-1
MADOLE AND ASSOCIATES, INC. 1820 E. 16th Street SANTA ANA, CALIFORNIA 92701 PHONE 714 • 835-2548	STONE RIVER DRIVE ℄ CEDAR MOUNTAIN DRIVE
ENGR. J.M. MADOLE	FIELD REVIEW _____ DATE _____
R.C.E. NO. 14814 DATE _____	TIE BOOK 15 PAGE 89

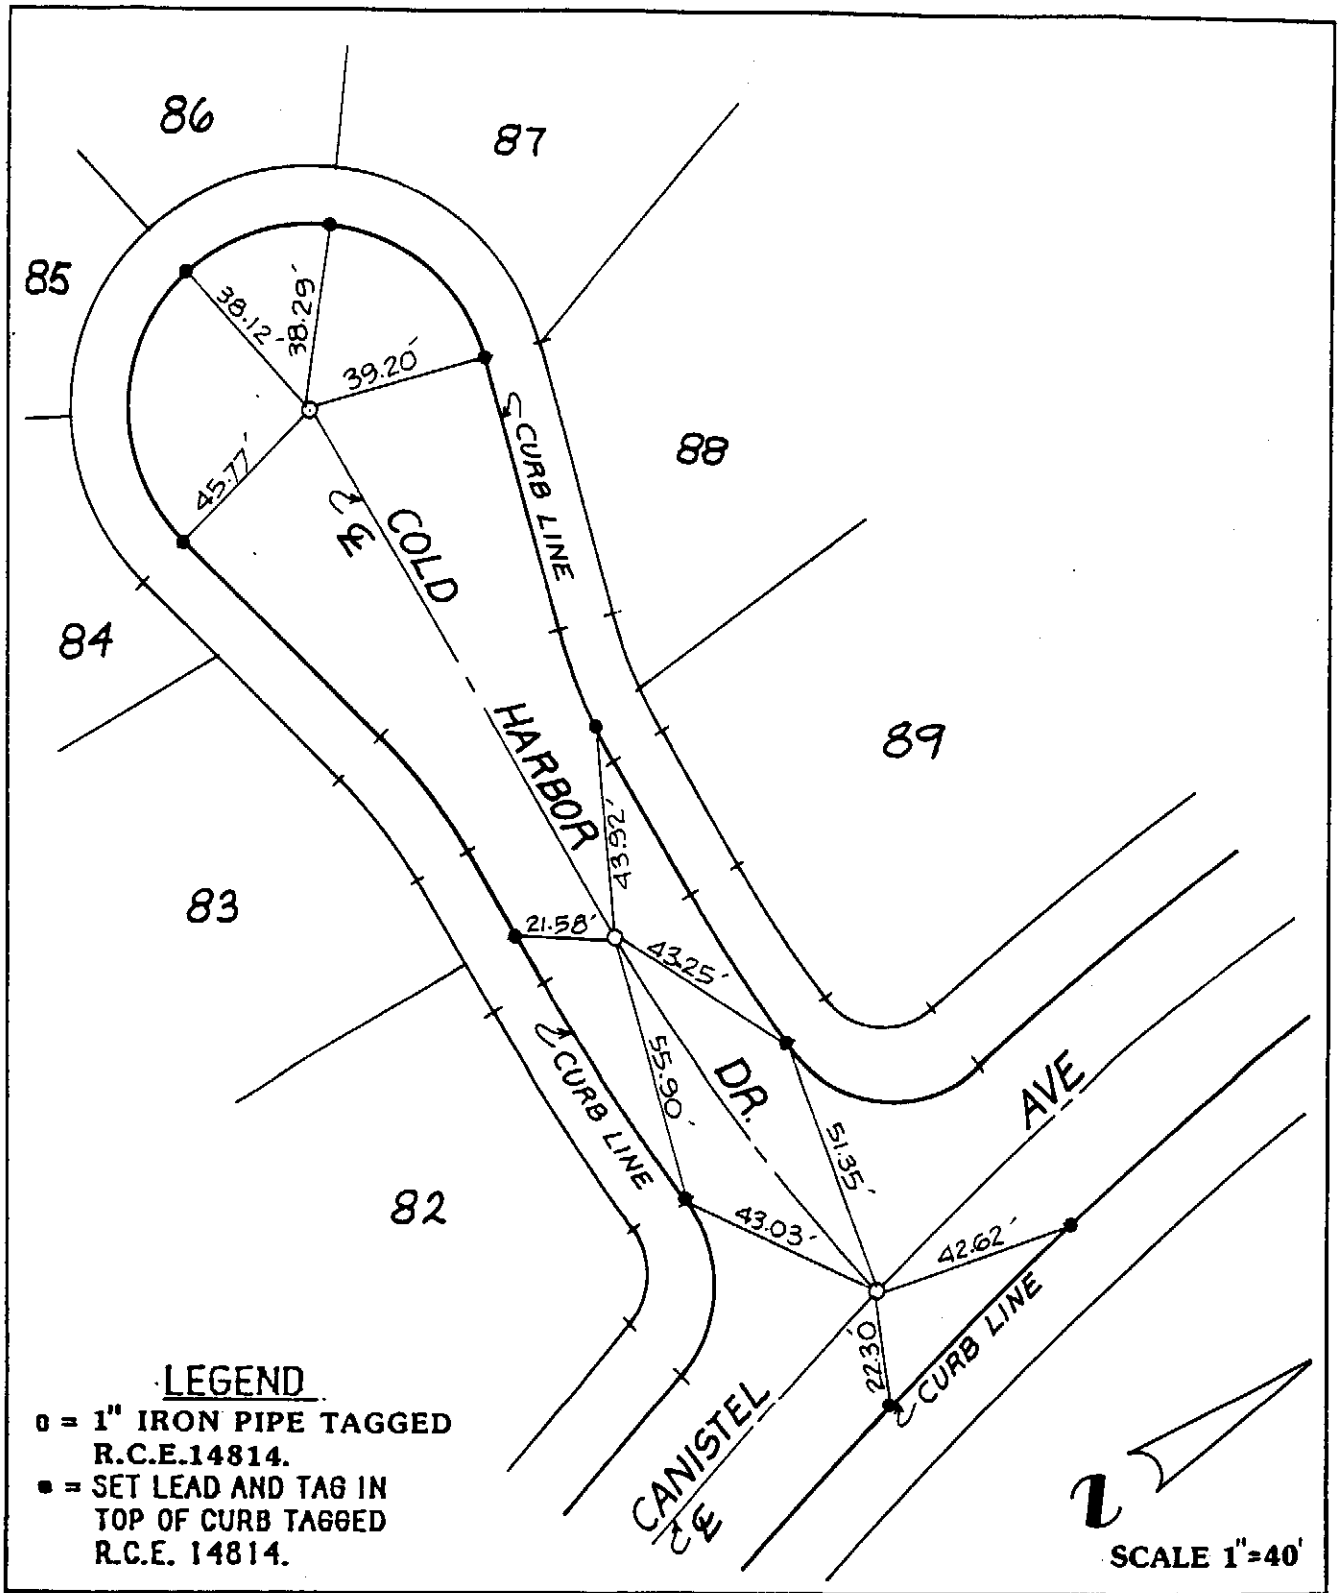

CITY OF RANCHO CUCAMONGA — STREET TIE	TRACT NO. 13542-1
MADOLE AND ASSOCIATES, INC. 1820 E. 16th Street SANTA ANA, CALIFORNIA 92701 PHONE 714 • 835-2548	COLD HARBOR DRIVE & CANISTEL AVENUE
ENGR. J.M. MADOLE	FIELD REVIEW _____ DATE _____
R.C.E. NO. 14814 DATE _____	TIE BOOK 15 PAGE 90

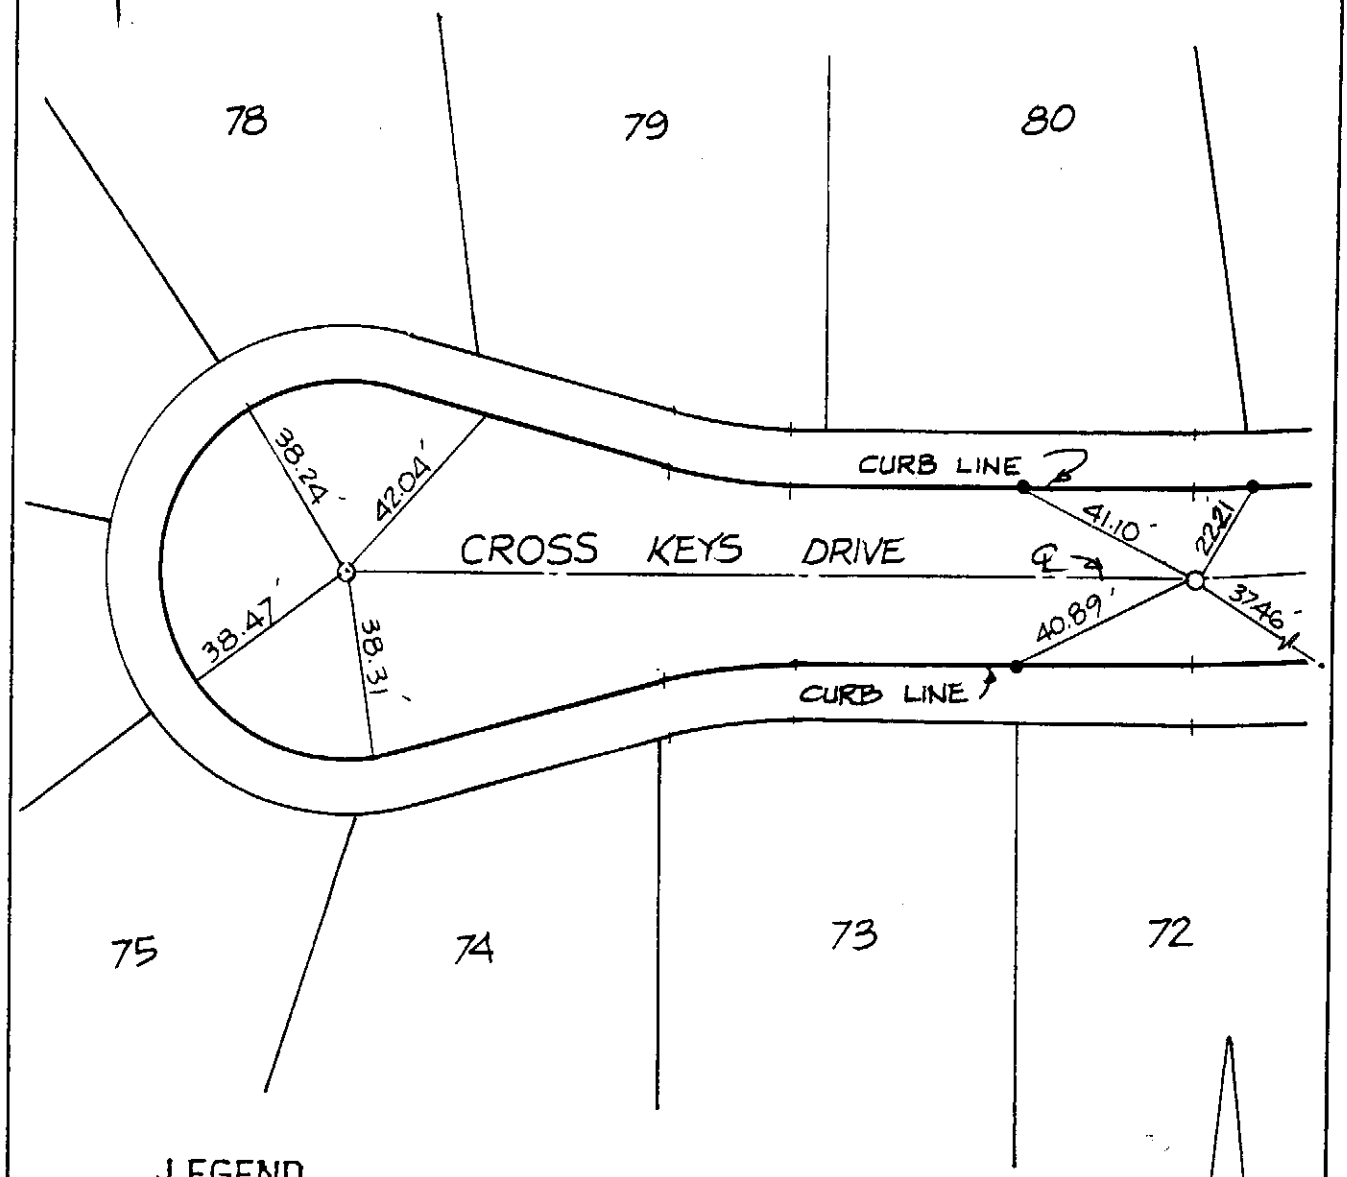

LEGEND

o = 1" IRON PIPE TAGGED R.C.E.14814.

• = SET LEAD AND TAG IN TOP OF CURB TAGGED R.C.E. 14814.

SCALE 1"=40'

CITY OF RANCHO CUCAMONGA STREET TIE	TRACT NO. 13542-1
MADOLE AND ASSOCIATES, INC. 1820 E. 16th Street SANTA ANA, CALIFORNIA 92701 PHONE 714 • 835-2548	CROSS KEYS DRIVE W/O CANISTEL
ENGR. J.M. MADOLE	FIELD REVIEW _____ DATE _____
R.C.E. NO. 14814 DATE _____	TIE BOOK 15 PAGE 91

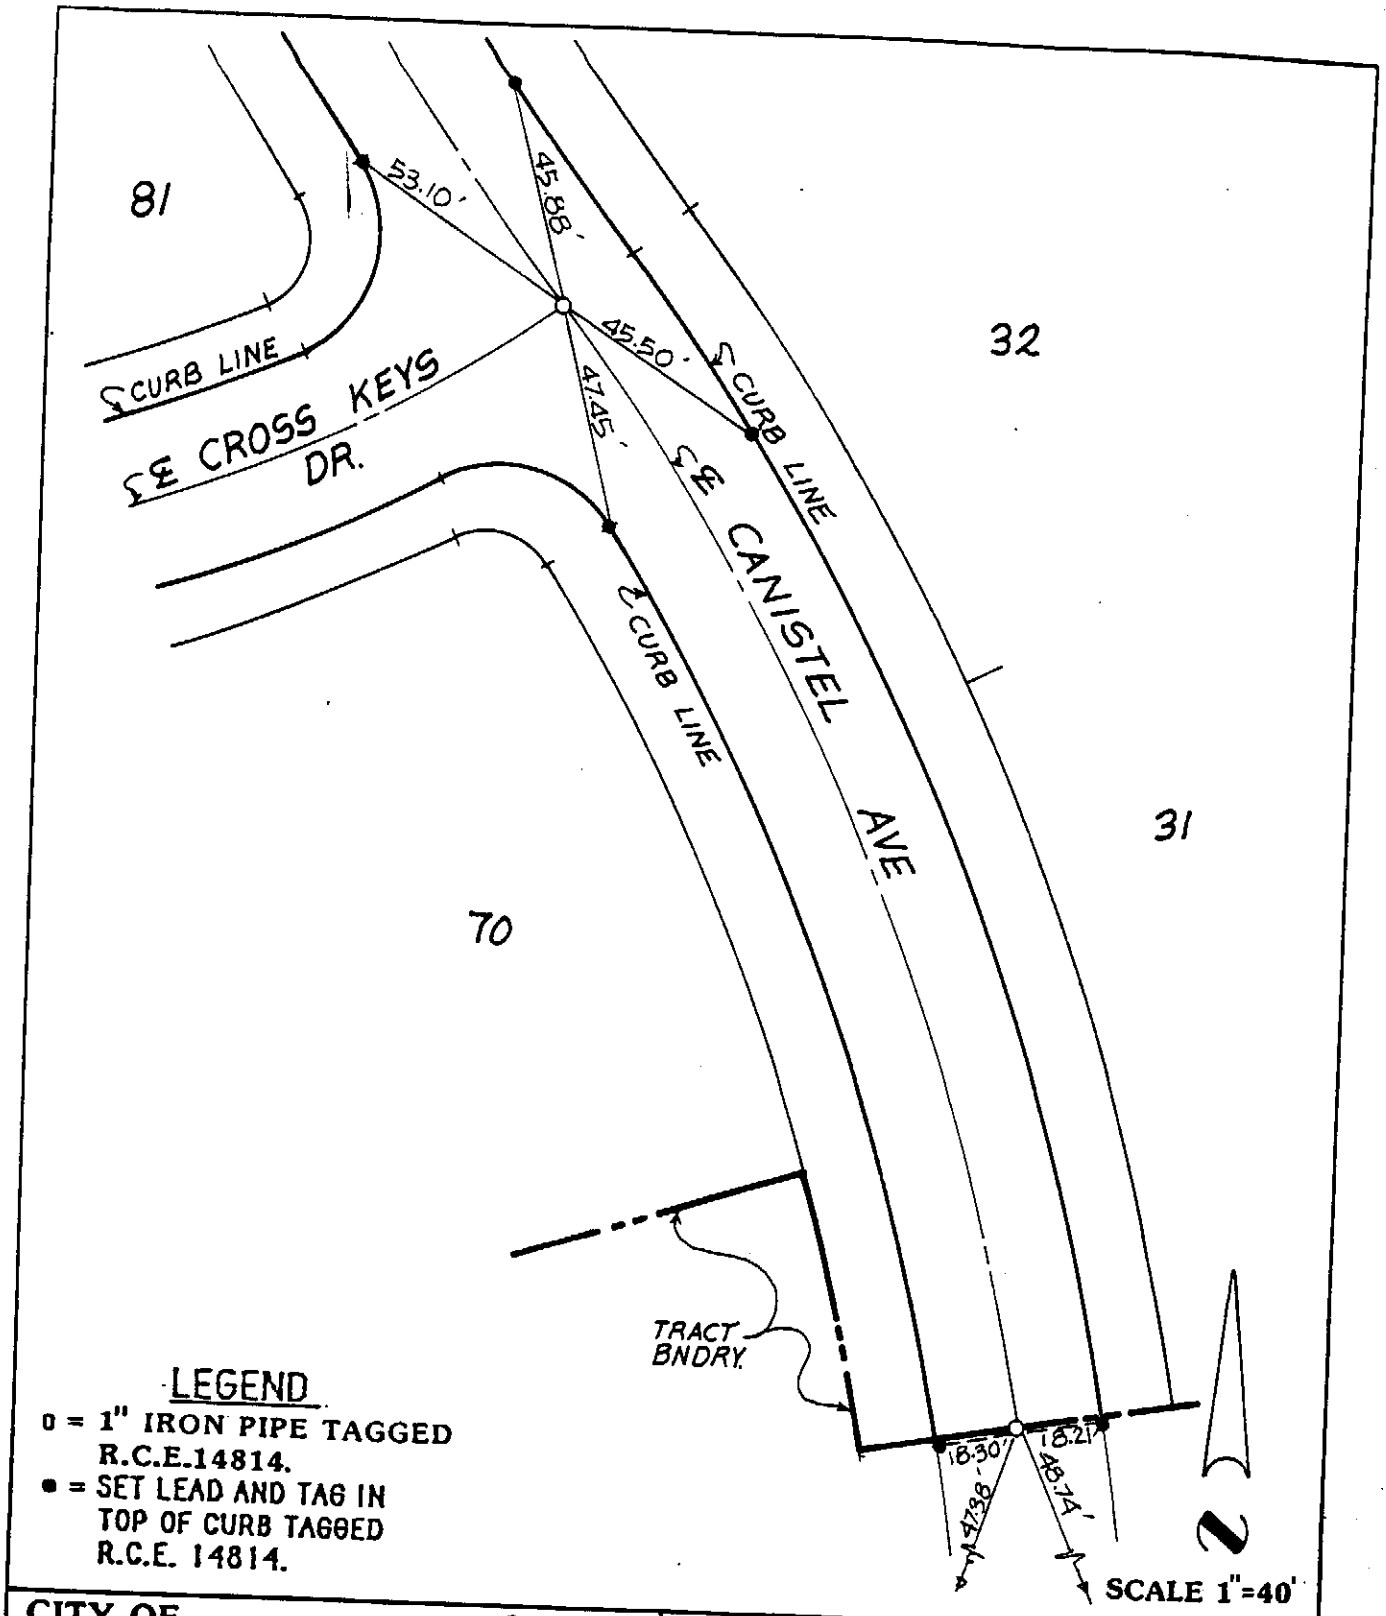

LEGEND

o = 1" IRON PIPE TAGGED R.C.E.14814.

• = SET LEAD AND TAG IN TOP OF CURB TAGGED R.C.E. 14814.

CITY OF RANCHO CUCAMONGA STREET TIE	TRACT NO. 13542-1
MADOLE AND ASSOCIATES, INC. 1820 E. 16th Street SANTA ANA, CALIFORNIA 92701 PHONE 714 • 835-2548	CROSS KEYS DRIVE ℄ CANISTEL AVENUE
ENGR. J.M. MADOLE	FIELD REVIEW _____ DATE _____
R.C.E. NO. 14814 DATE _____	TIE BOOK 15 PAGE 92

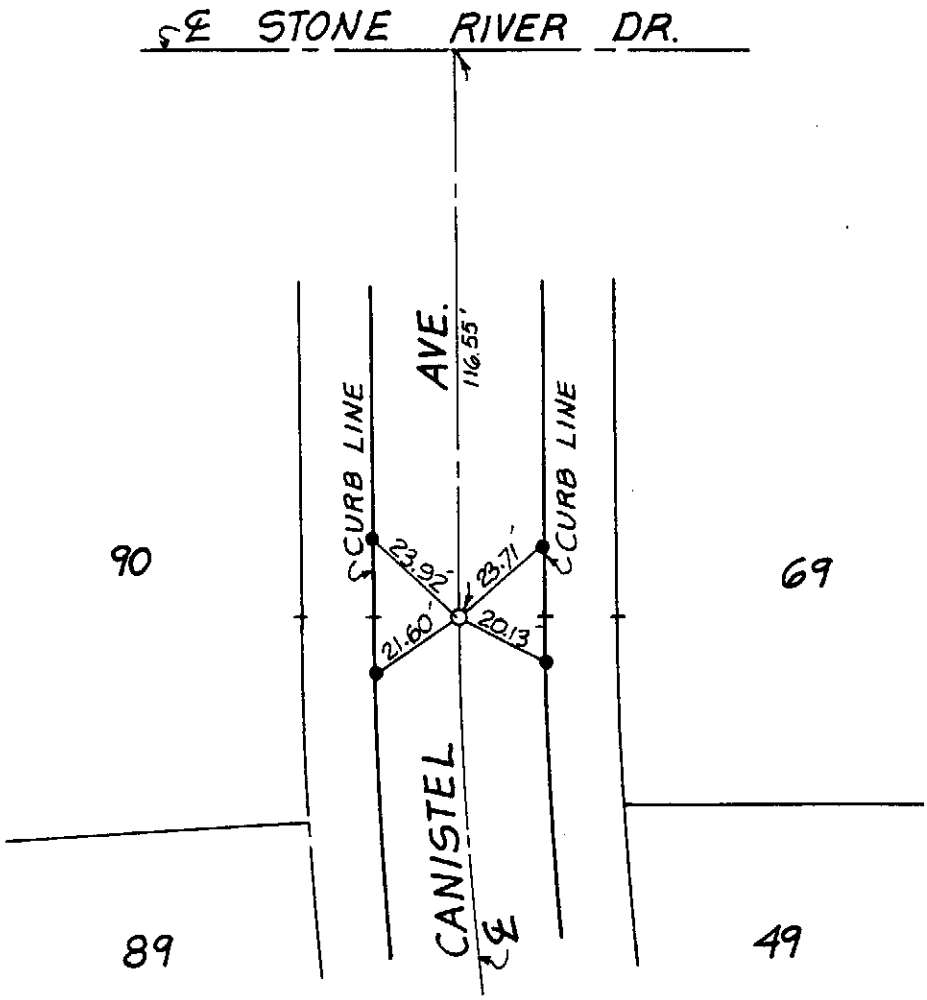

LEGEND

o = 1" IRON PIPE TAGGED R.C.E.14814.

• = SET LEAD AND TAG IN TOP OF CURB TAGGED R.C.E. 14814.

N

SCALE 1"=40'

CITY OF RANCHO CUCAMONGA — STREET TIE	TRACT NO. 13542-1
MADOLE AND ASSOCIATES, INC. 1820 E. 16th Street SANTA ANA, CALIFORNIA 92701 PHONE 714 • 835-2548	CANISTEL AVENUE
ENGR. J.M. MADOLE	FIELD REVIEW _____ DATE _____
R.C.E. NO. 14814 DATE _____	TIE BOOK 15 PAGE 93

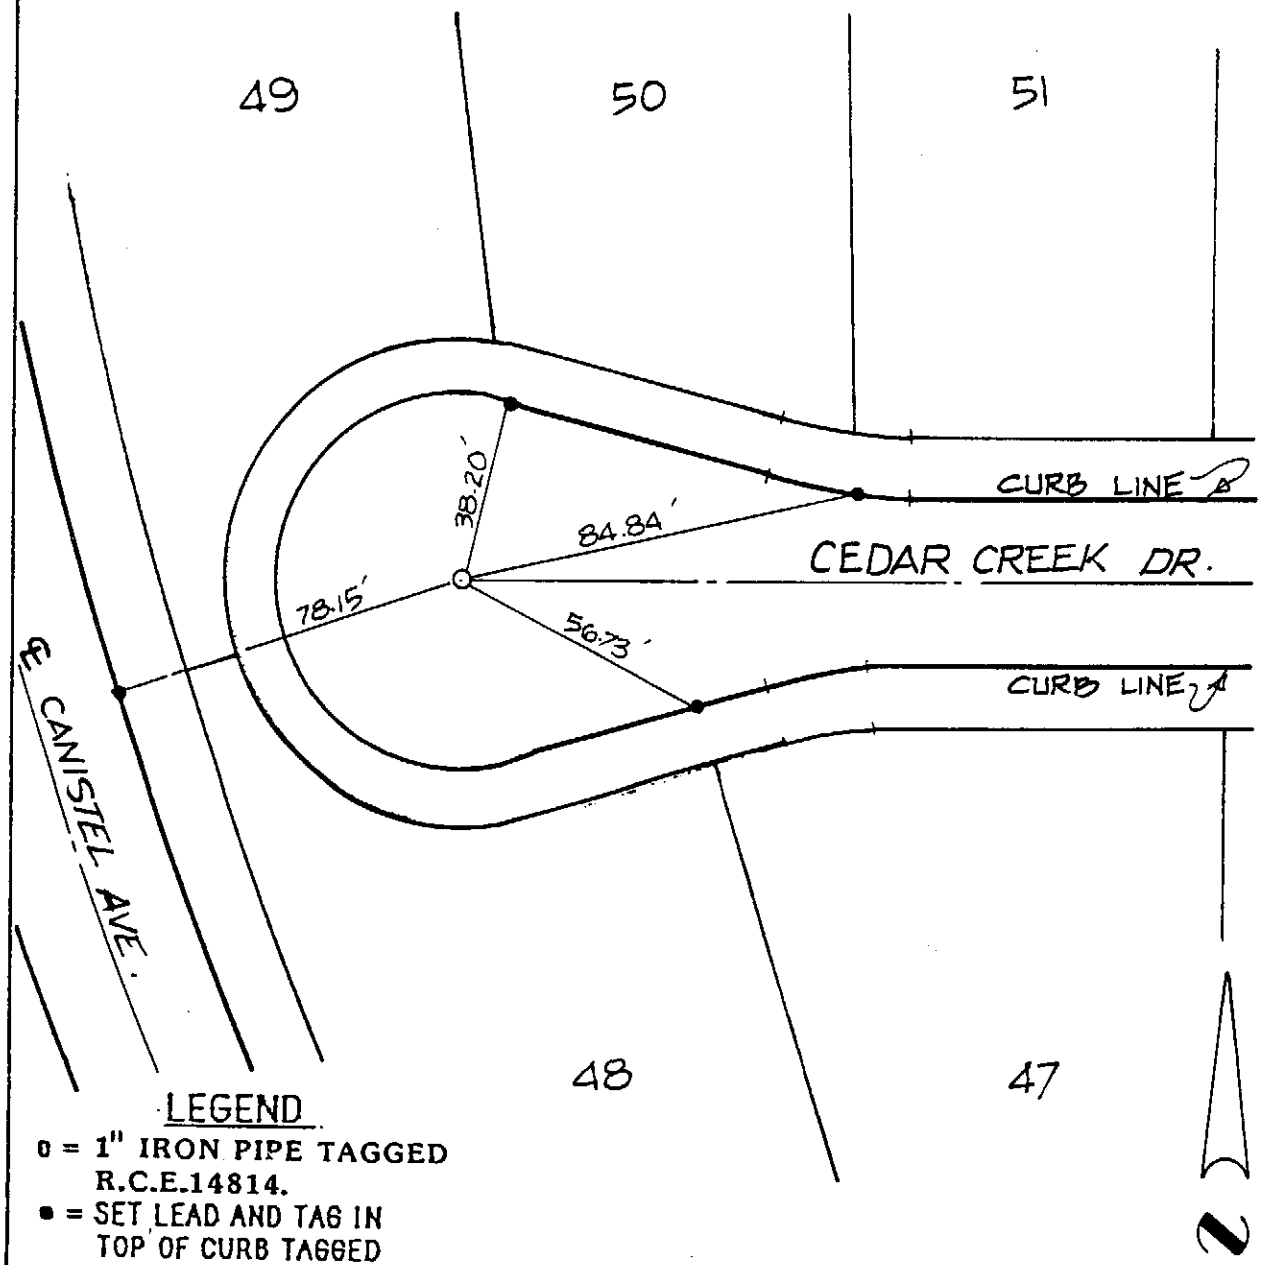

LEGEND

o = 1" IRON PIPE TAGGED R.C.E.14814.

• = SET LEAD AND TAG IN TOP OF CURB TAGGED R.C.E. 14814.

SCALE 1"=40'

CITY OF RANCHO CUCAMONGA — STREET TIE	TRACT NO. 13542-1
MADOLE AND ASSOCIATES, INC. 1820 E. 16th Street SANTA ANA, CALIFORNIA 92701 PHONE 714 • 835-2548	CEDAR CREEK DR. CUL-DEC-SAC
ENGR. J.M. MADOLE	FIELD REVIEW _____ DATE _____
R.C.E. NO. 14814 DATE _____	TIE BOOK 15 PAGE 94

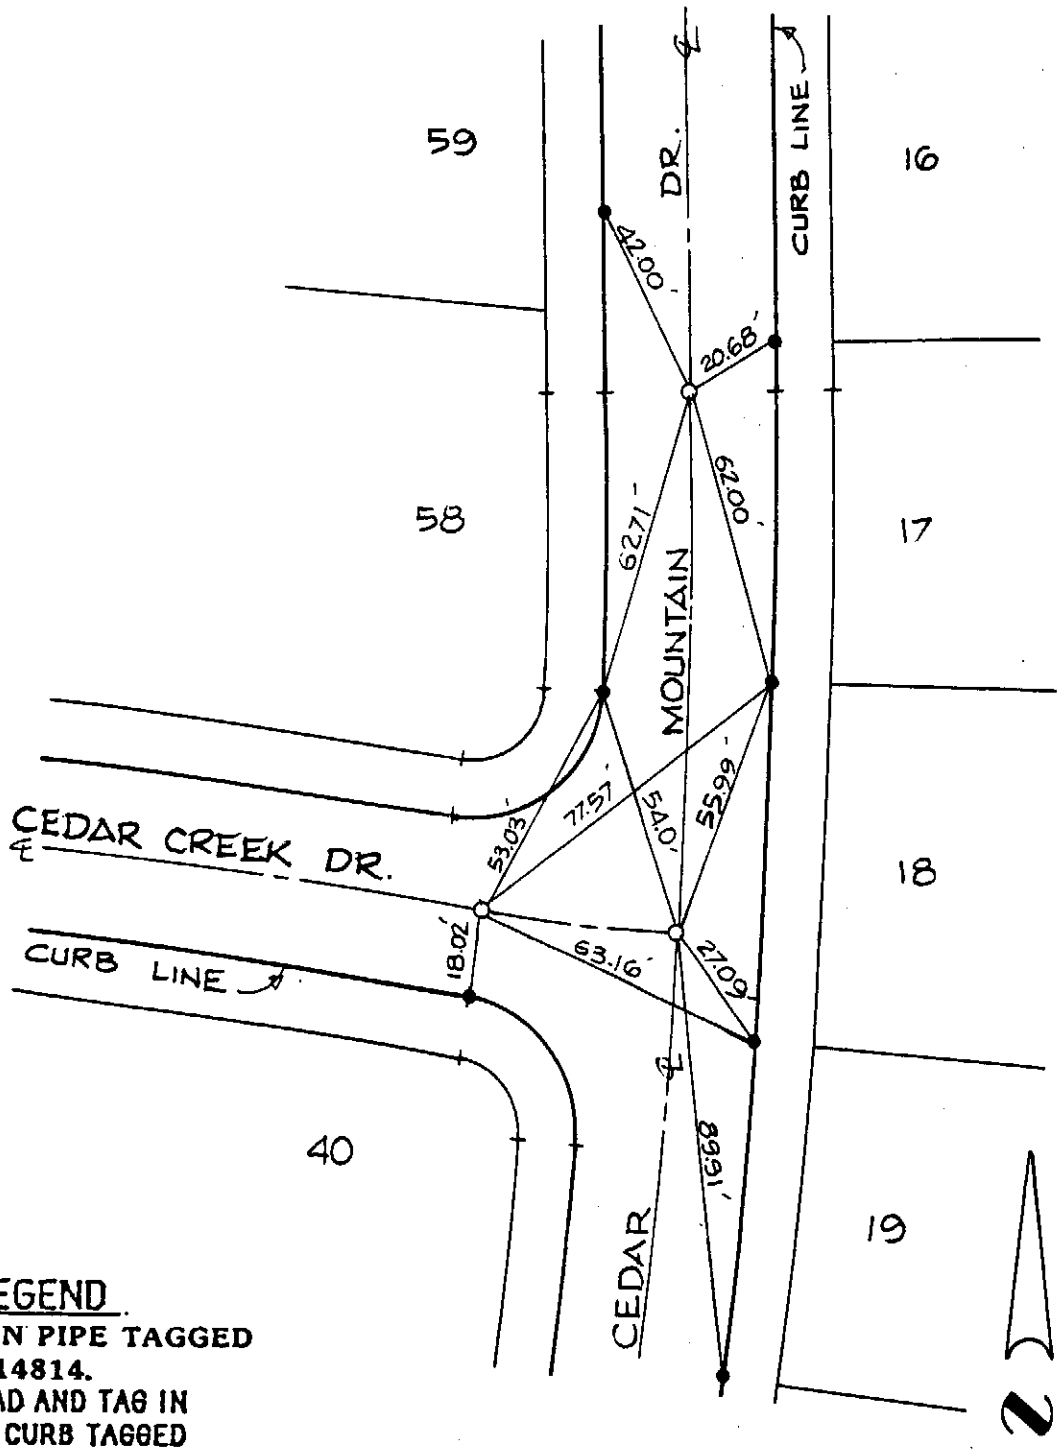

LEGEND

o = 1" IRON PIPE TAGGED R.C.E.14814.

■ = SET LEAD AND TAG IN TOP OF CURB TAGGED R.C.E. 14814.

SCALE 1"=40'

CITY OF RANCHO CUCAMONGA — STREET TIE	TRACT NO. 13542-1
MADOLE AND ASSOCIATES, INC. 1820 E. 16th Street SANTA ANA, CALIFORNIA 92701 PHONE 714 • 835-2548	CEDAR CREEK DR. AT CEDAR MTN. DRIVE
ENGR. J.M. MADOLE	FIELD REVIEW _____ DATE _____
R.C.E. NO. 14814 DATE _____	TIE BOOK 15 PAGE 95

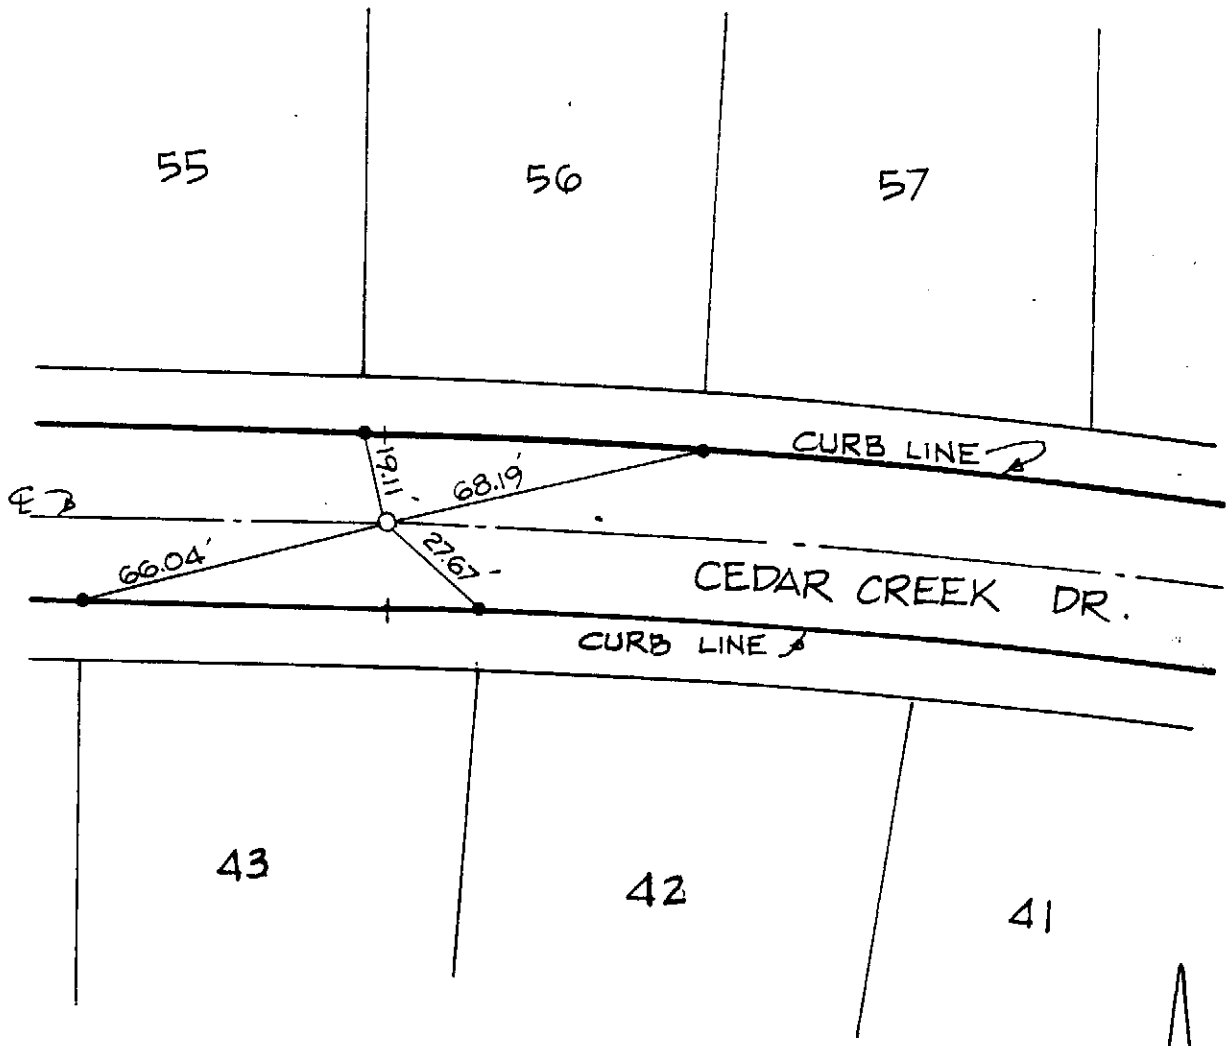

LEGEND

o = 1" IRON PIPE TAGGED R.C.E.14814.

• = SET LEAD AND TAG IN TOP OF CURB TAGGED R.C.E. 14814.

N

SCALE 1"=40'

CITY OF RANCHO CUCAMONGA STREET TIE	TRACT NO. 13542-1
MADOLE AND ASSOCIATES, INC. 1820 E. 16th Street SANTA ANA, CALIFORNIA 92701 PHONE 714 • 835-2548	CEDAR CREEK DR. W/O CEDAR MTN. DRIVE
ENGR. J.M. MADOLE	FIELD REVIEW _____ DATE _____
R.C.E. NO. 14814 DATE _____	TIE BOOK 15 PAGE 96

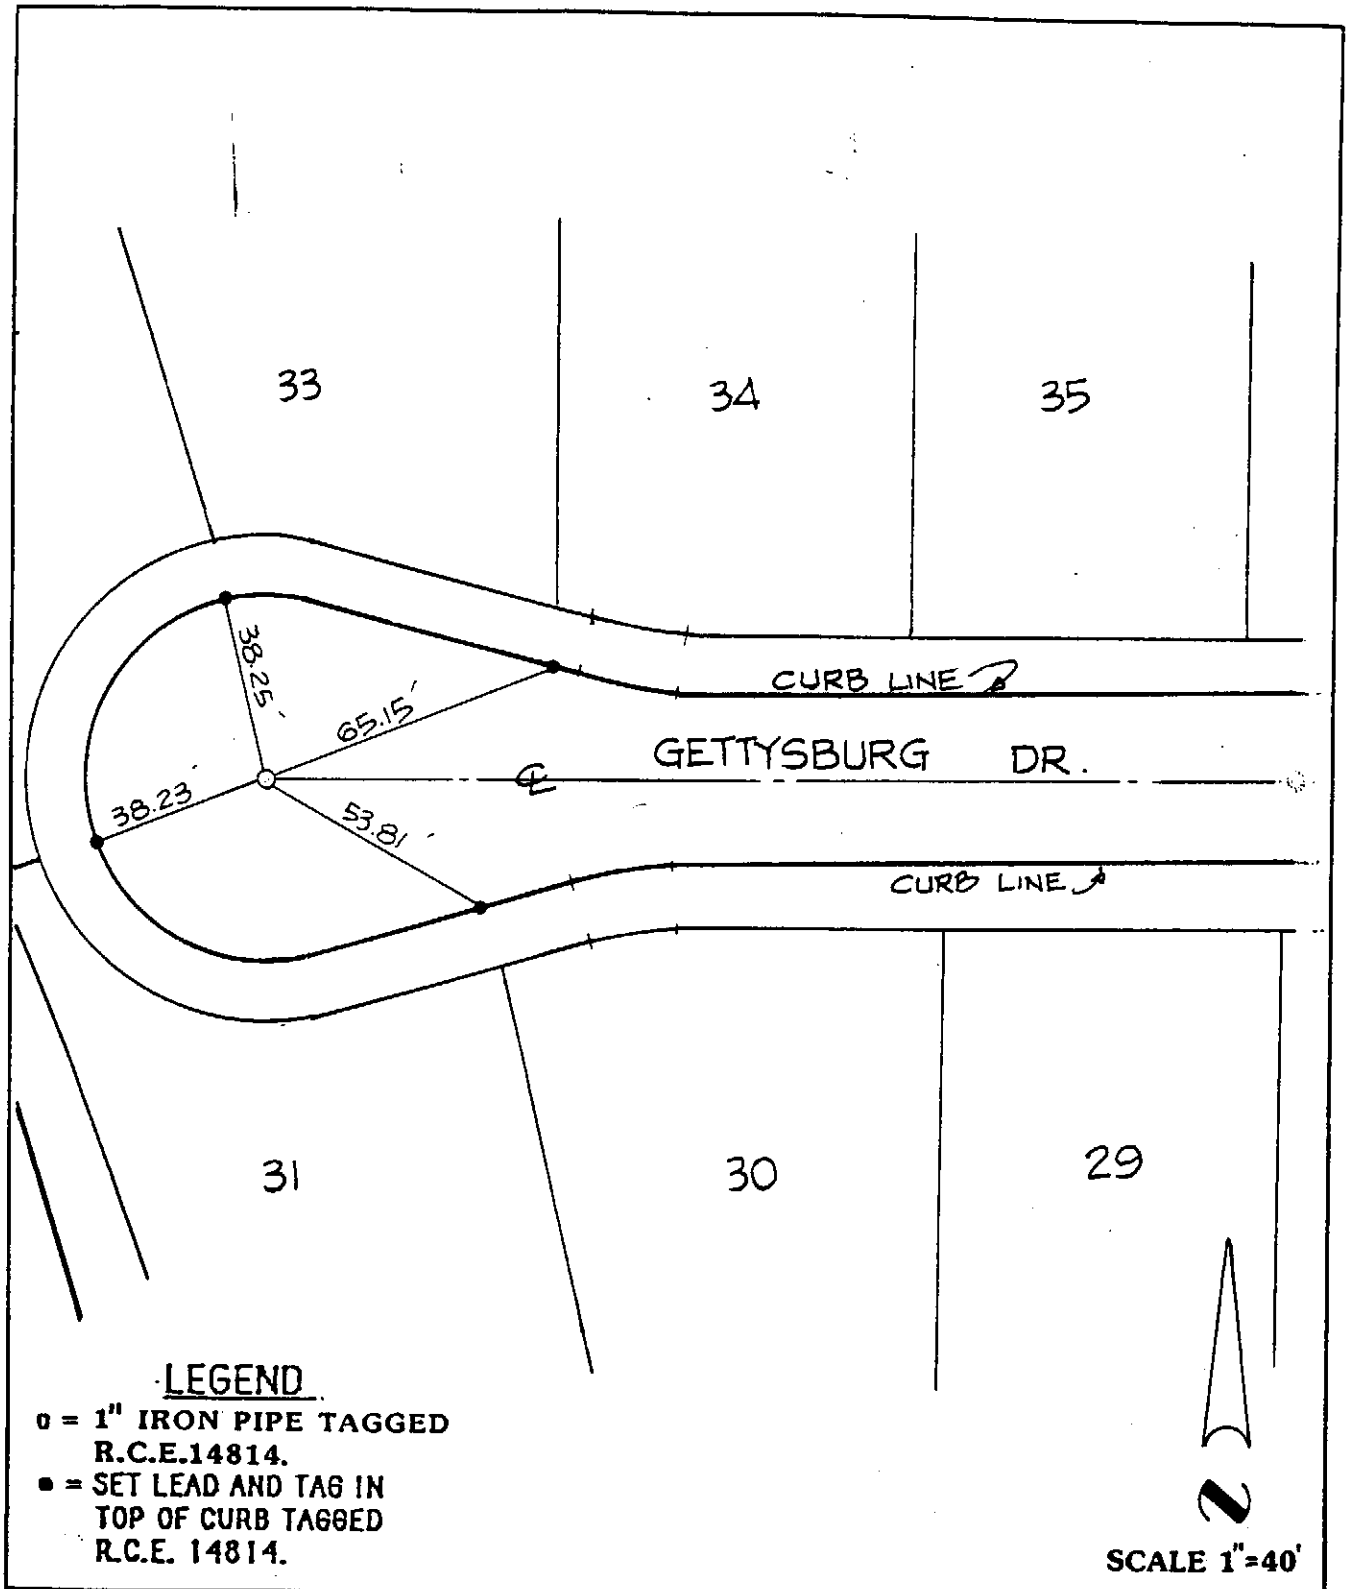

LEGEND

o = 1" IRON PIPE TAGGED R.C.E.14814.

• = SET LEAD AND TAG IN TOP OF CURB TAGGED R.C.E. 14814.

CITY OF RANCHO CUCAMONGA STREET TIE	TRACT NO. 13542-1
MADOLE AND ASSOCIATES, INC. 1820 E. 16th Street SANTA ANA, CALIFORNIA 92701 PHONE 714 • 835-2548	GETTYSBURG DRIVE CUL-DE-SAC
ENGR. J.M. MADOLE	FIELD REVIEW _____ DATE _____
R.C.E. NO. 14814 DATE _____	TIE BOOK 15 PAGE 97

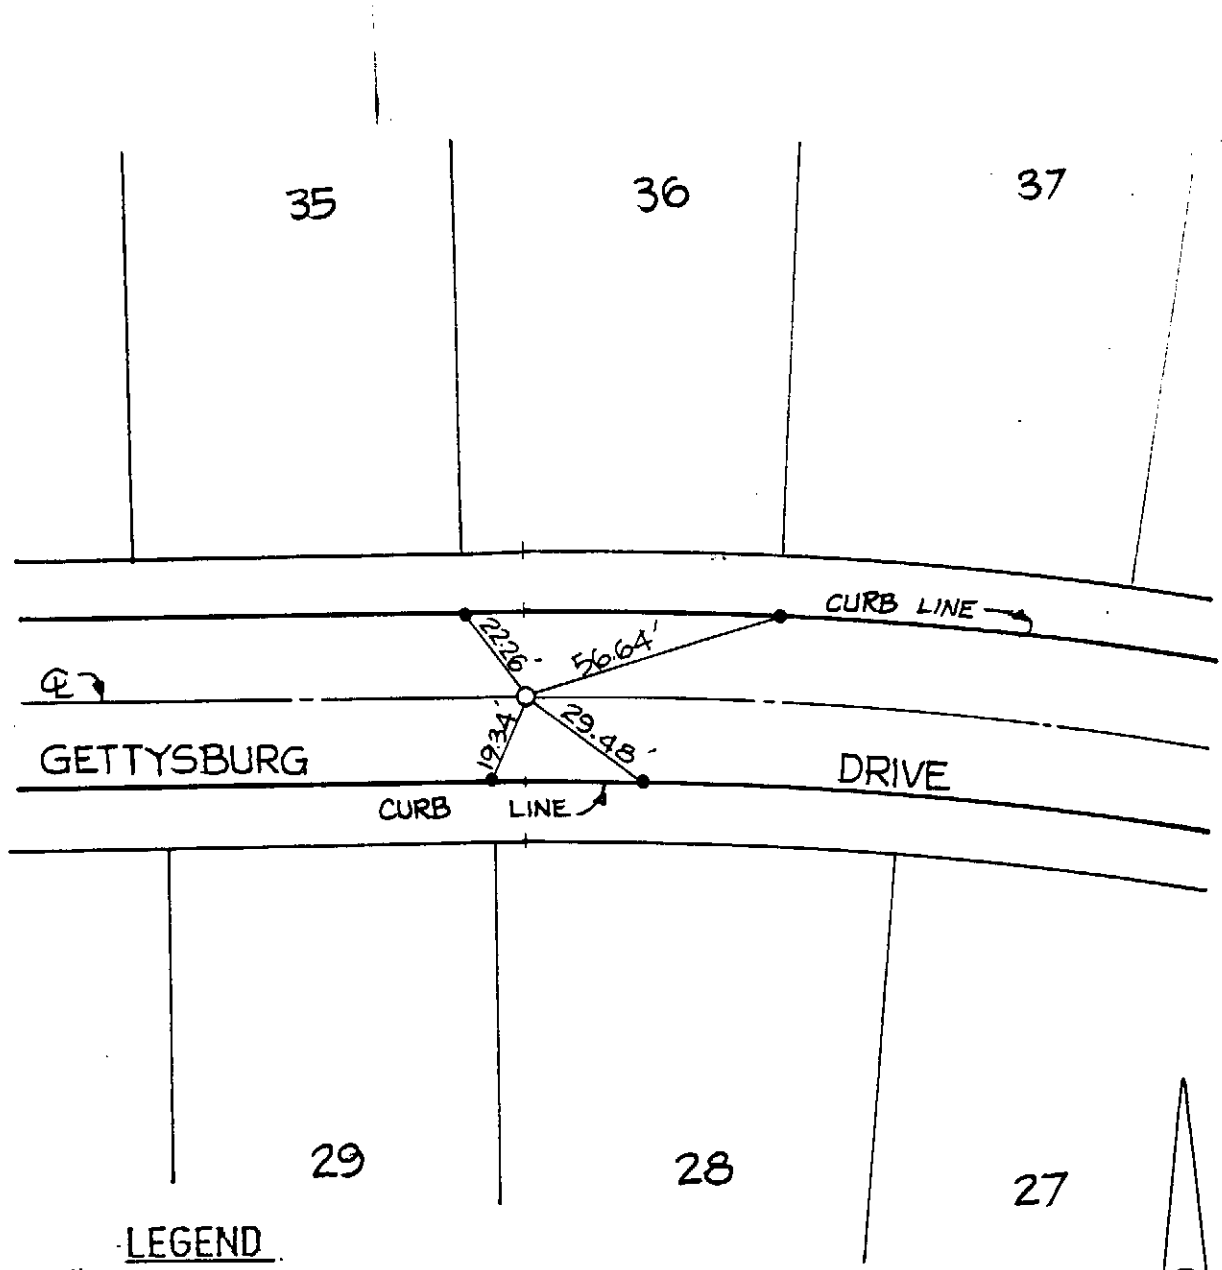

LEGEND

o = 1" IRON PIPE TAGGED R.C.E.14814.

• = SET LEAD AND TAG IN TOP OF CURB TAGGED R.C.E. 14814.

SCALE 1"=40'

CITY OF RANCHO CUCAMONGA — STREET TIE	TRACT NO. 13542-1
MADOLE AND ASSOCIATES, INC. 1820 E. 16th Street SANTA ANA, CALIFORNIA 92701 PHONE 714 • 835-2548	GETTYSBURG DRIVE W/O CEDAR MTN. DR.
ENGR. J.M. MADOLE	FIELD REVIEW _____ DATE _____
R.C.E. NO. 14814 DATE _____	TIE BOOK 15 PAGE 92

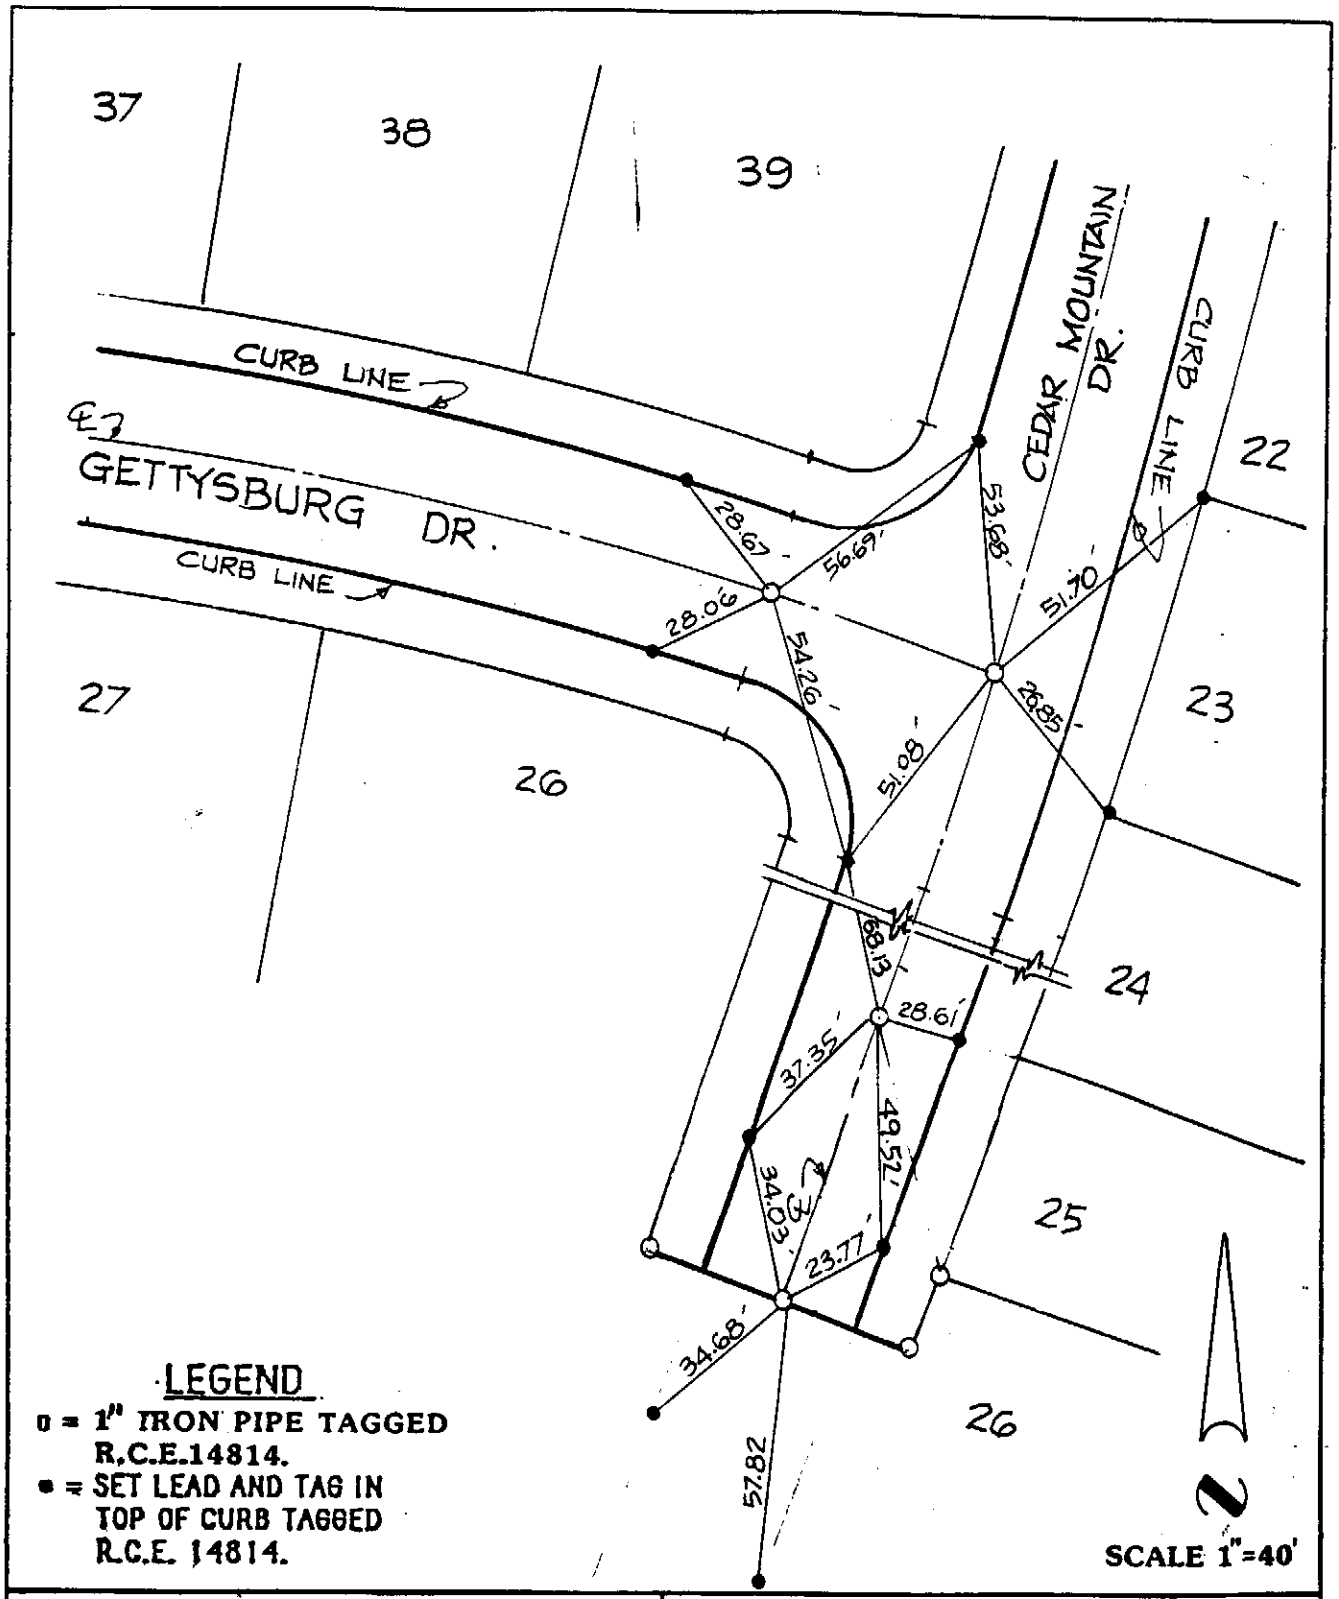

CITY OF RANCHO CUCAMONGA — STREET TIE	TRACT NO. 13542-1
MADOLE AND ASSOCIATES, INC. 1820 E. 16th Street SANTA ANA, CALIFORNIA 92701 PHONE 714 • 835-2548	GETTYSBURG DRIVE AT CEDAR MT. DR.
ENGR. J.M. MADOLE	FIELD REVIEW _____ DATE _____
R.C.E. NO. 14814 DATE _____	TIE BOOK 15 PAGE 99

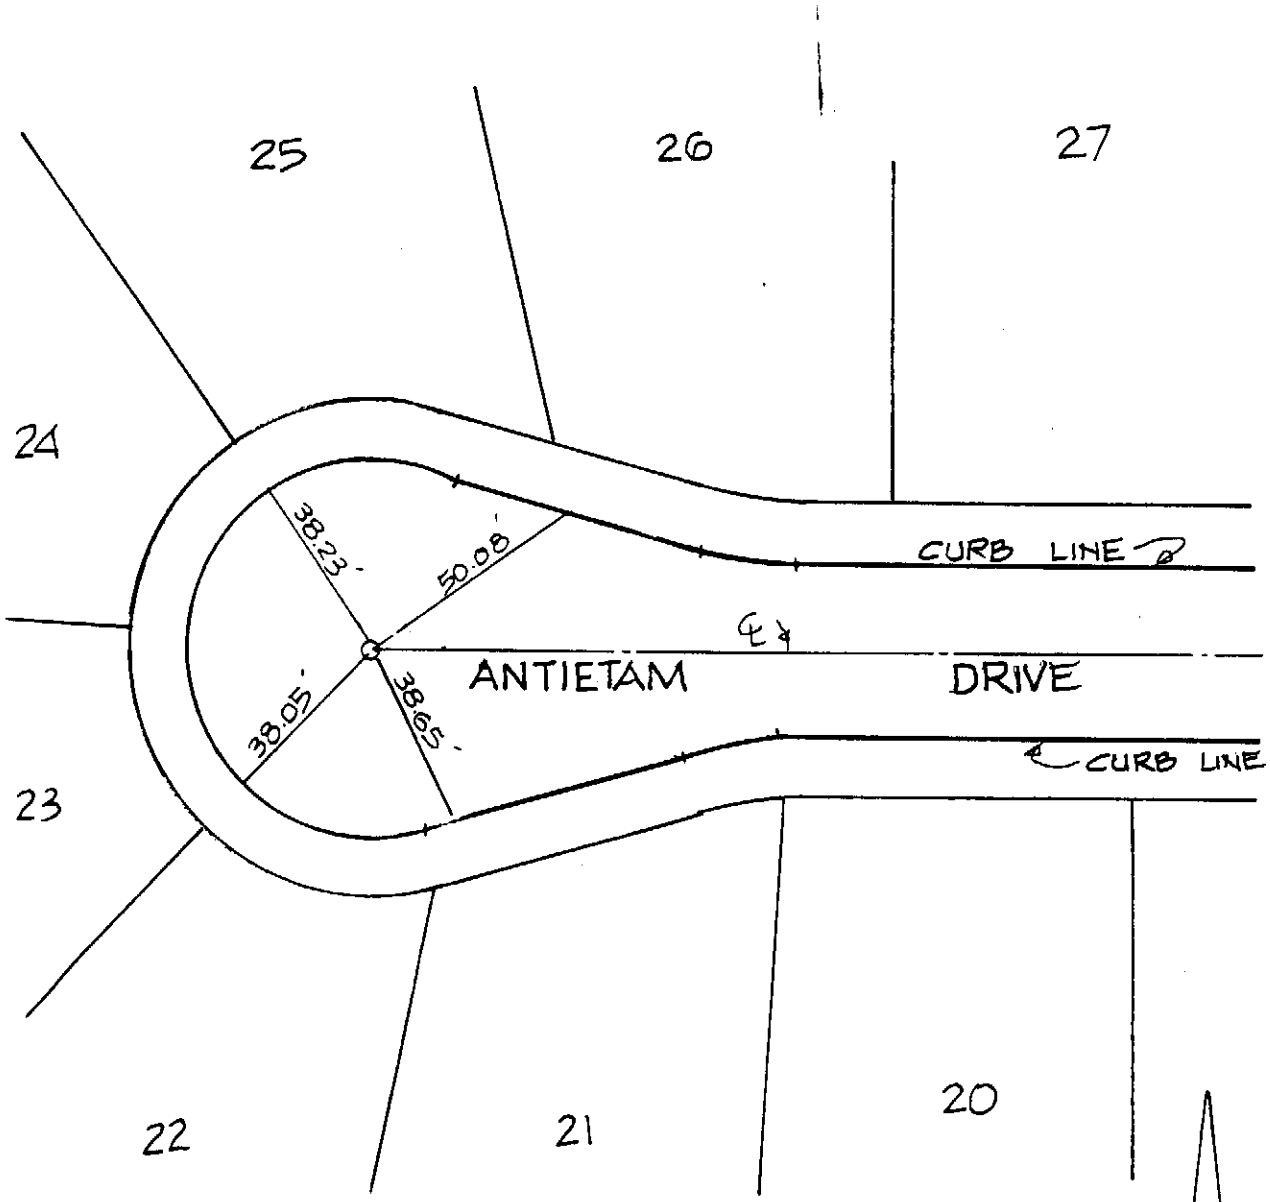

LEGEND

o = 1" IRON PIPE TAGGED R.C.E.14814.

• = SET LEAD AND TAG IN TOP OF CURB TAGGED R.C.E. 14814.

SCALE 1"=40'

CITY OF RANCHO CUCAMONGA STREET TIE	TRACT NO. 13542-2
MADOLE AND ASSOCIATES, INC. 1820 E. 16th Street SANTA ANA, CALIFORNIA 92701 PHONE 714 • 835-2548	ANTIETAM DRIVE CUL-DE-SAC
ENGR. J.M. MADOLE	FIELD REVIEW _____ DATE _____
R.C.E. NO. 14814 DATE _____	TIE BOOK 15 PAGE 100

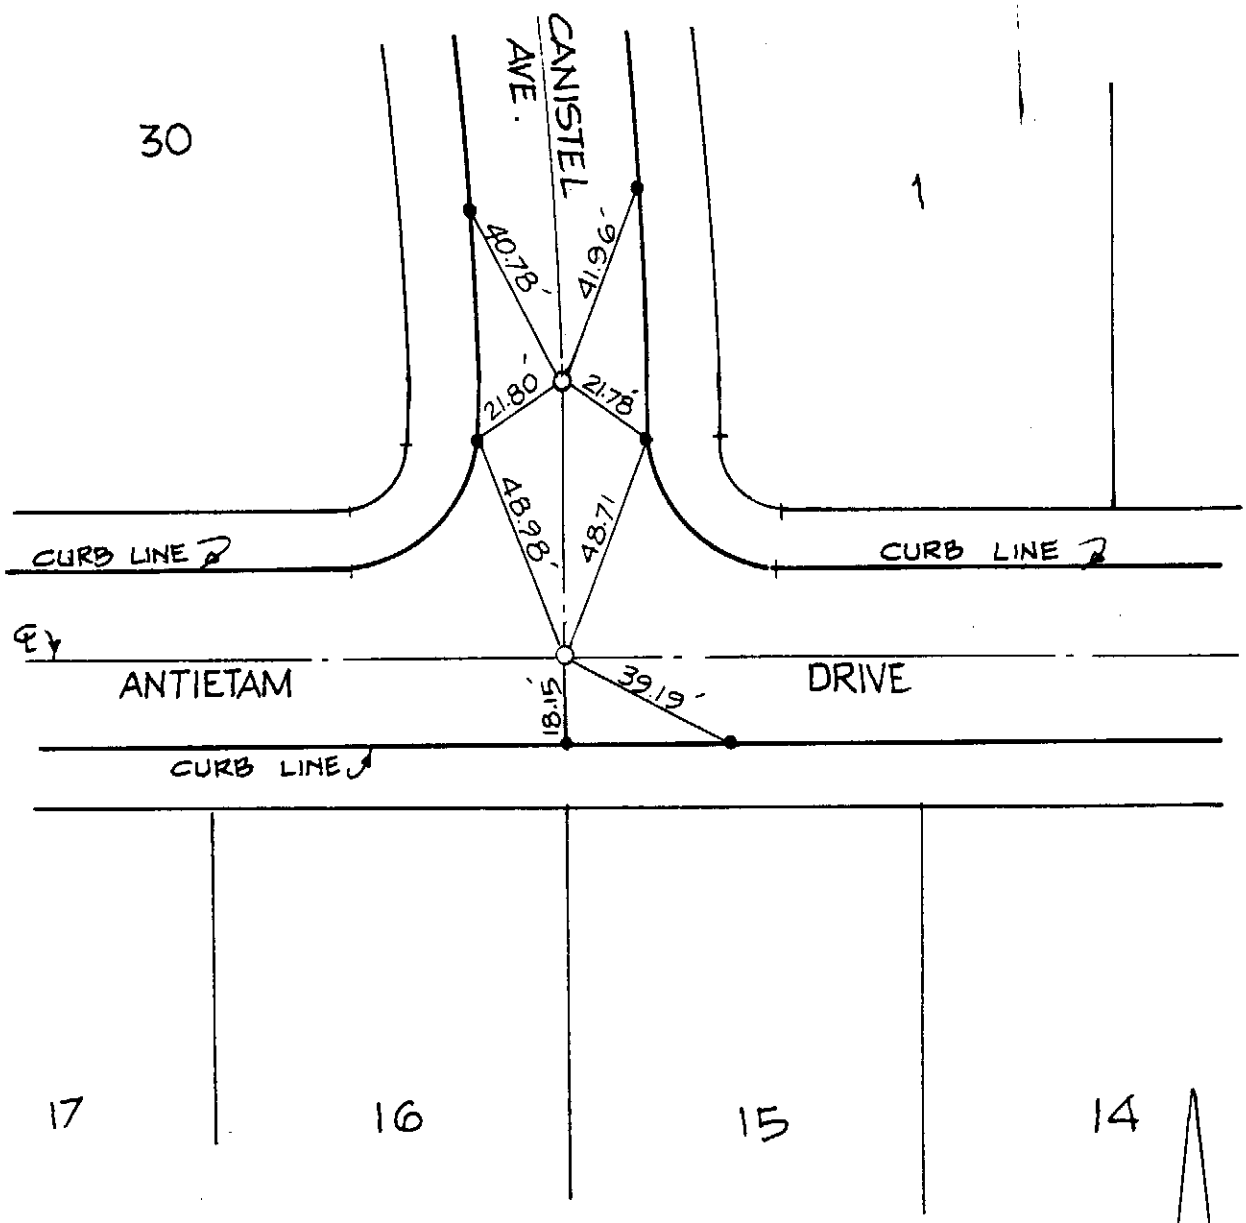

LEGEND

o = 1" IRON PIPE TAGGED R.C.E.14814.

• = SET LEAD AND TAG IN TOP OF CURB TAGGED R.C.E. 14814.

SCALE 1"=40'

CITY OF RANCHO CUCAMONGA — STREET TIE	TRACT NO. 13542-2
MADOLE AND ASSOCIATES, INC. 1820 E. 16th Street SANTA ANA, CALIFORNIA 92701 PHONE 714 • 835-2548	ANTIETAM DRIVE AT CANISTEL DR.
ENGR. J.M. MADOLE	FIELD REVIEW _____ DATE _____
R.C.E. NO. 14814 DATE _____	TIE BOOK 15 PAGE 101

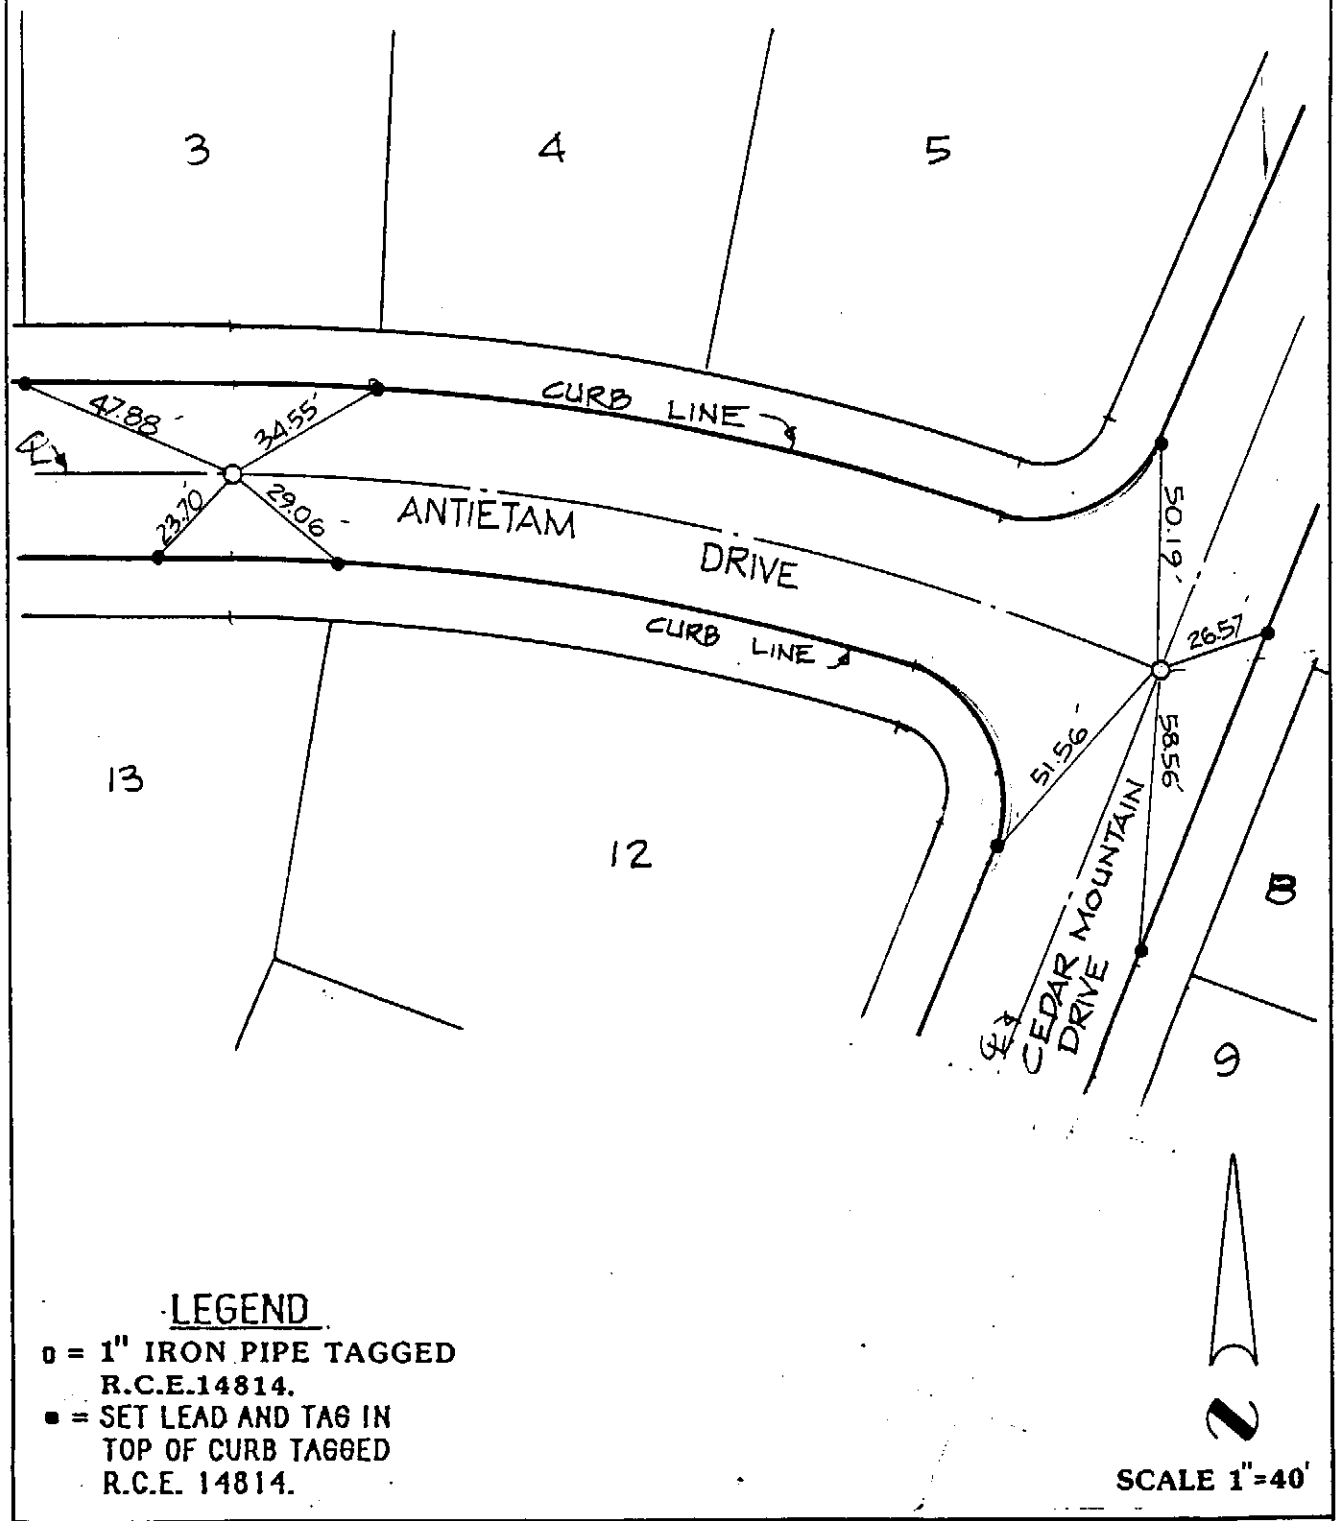

LEGEND

o = 1" IRON PIPE TAGGED R.C.E.14814.

■ = SET LEAD AND TAG IN TOP OF CURB TAGGED R.C.E. 14814.

SCALE 1"=40'

CITY OF RANCHO CUCAMONGA — STREET TIE	TRACT NO. 13542-2
MADOLE AND ASSOCIATES, INC. 1820 E. 16th Street SANTA ANA, CALIFORNIA 92701 PHONE 714 • 835-2548	ANTIETAM DRIVE W/O CEDAR MTN DRIVE
ENGR. J.M. MADOLE	FIELD REVIEW _____ DATE _____
R.C.E. NO. 14814 DATE _____	TIE BOOK 15 PAGE 102

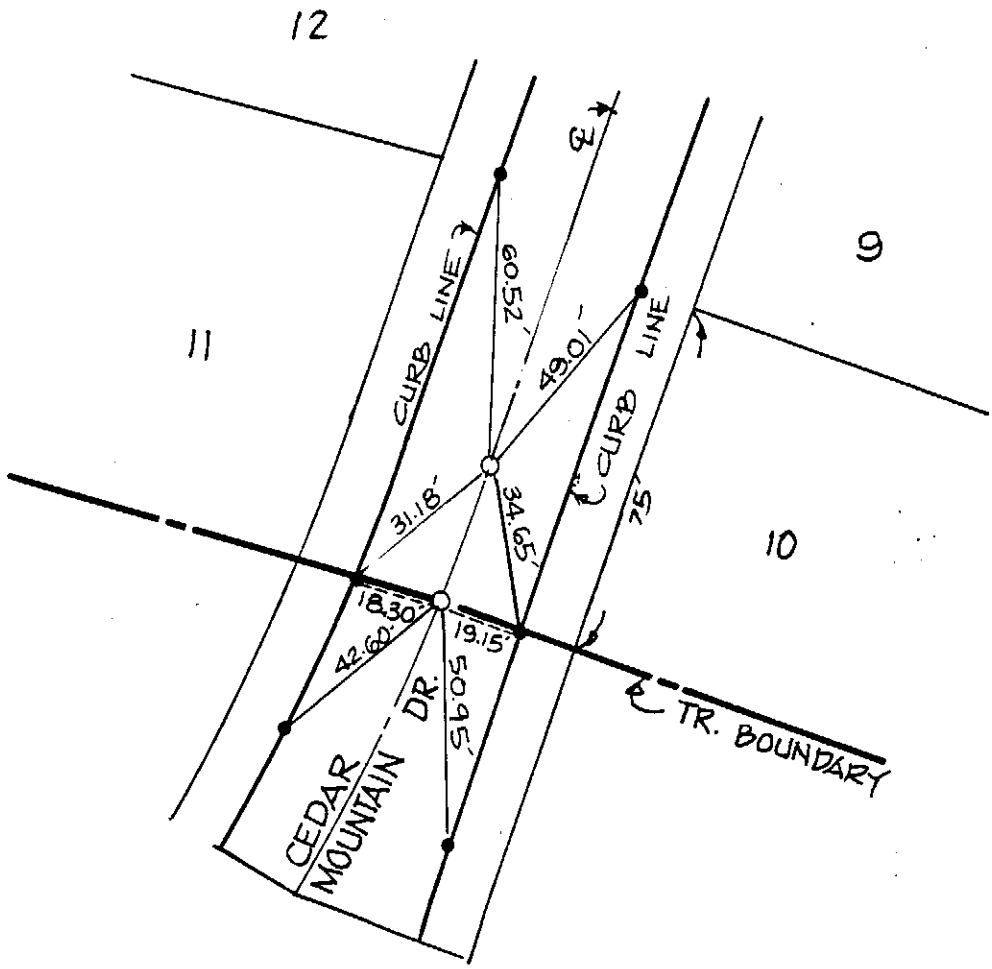

LEGEND

o = 1" IRON PIPE TAGGED R.C.E.14814.

▪ = SET LEAD AND TAG IN TOP OF CURB TAGGED R.C.E. 14814.

SCALE 1"=40'

CITY OF RANCHO CUCAMONGA — STREET TIE	TRACT NO. 13542-2
MADOLE AND ASSOCIATES, INC. 1820 E. 16th Street SANTA ANA, CALIFORNIA 92701 PHONE 714 • 835-2548	CEDAR MOUNTAIN DR. AT TR 13542-2 BNDRY
ENGR. J.M. MADOLE	FIELD REVIEW _____ DATE _____
R.C.E. NO. 14814 DATE _____	TIE BOOK 15 PAGE 103

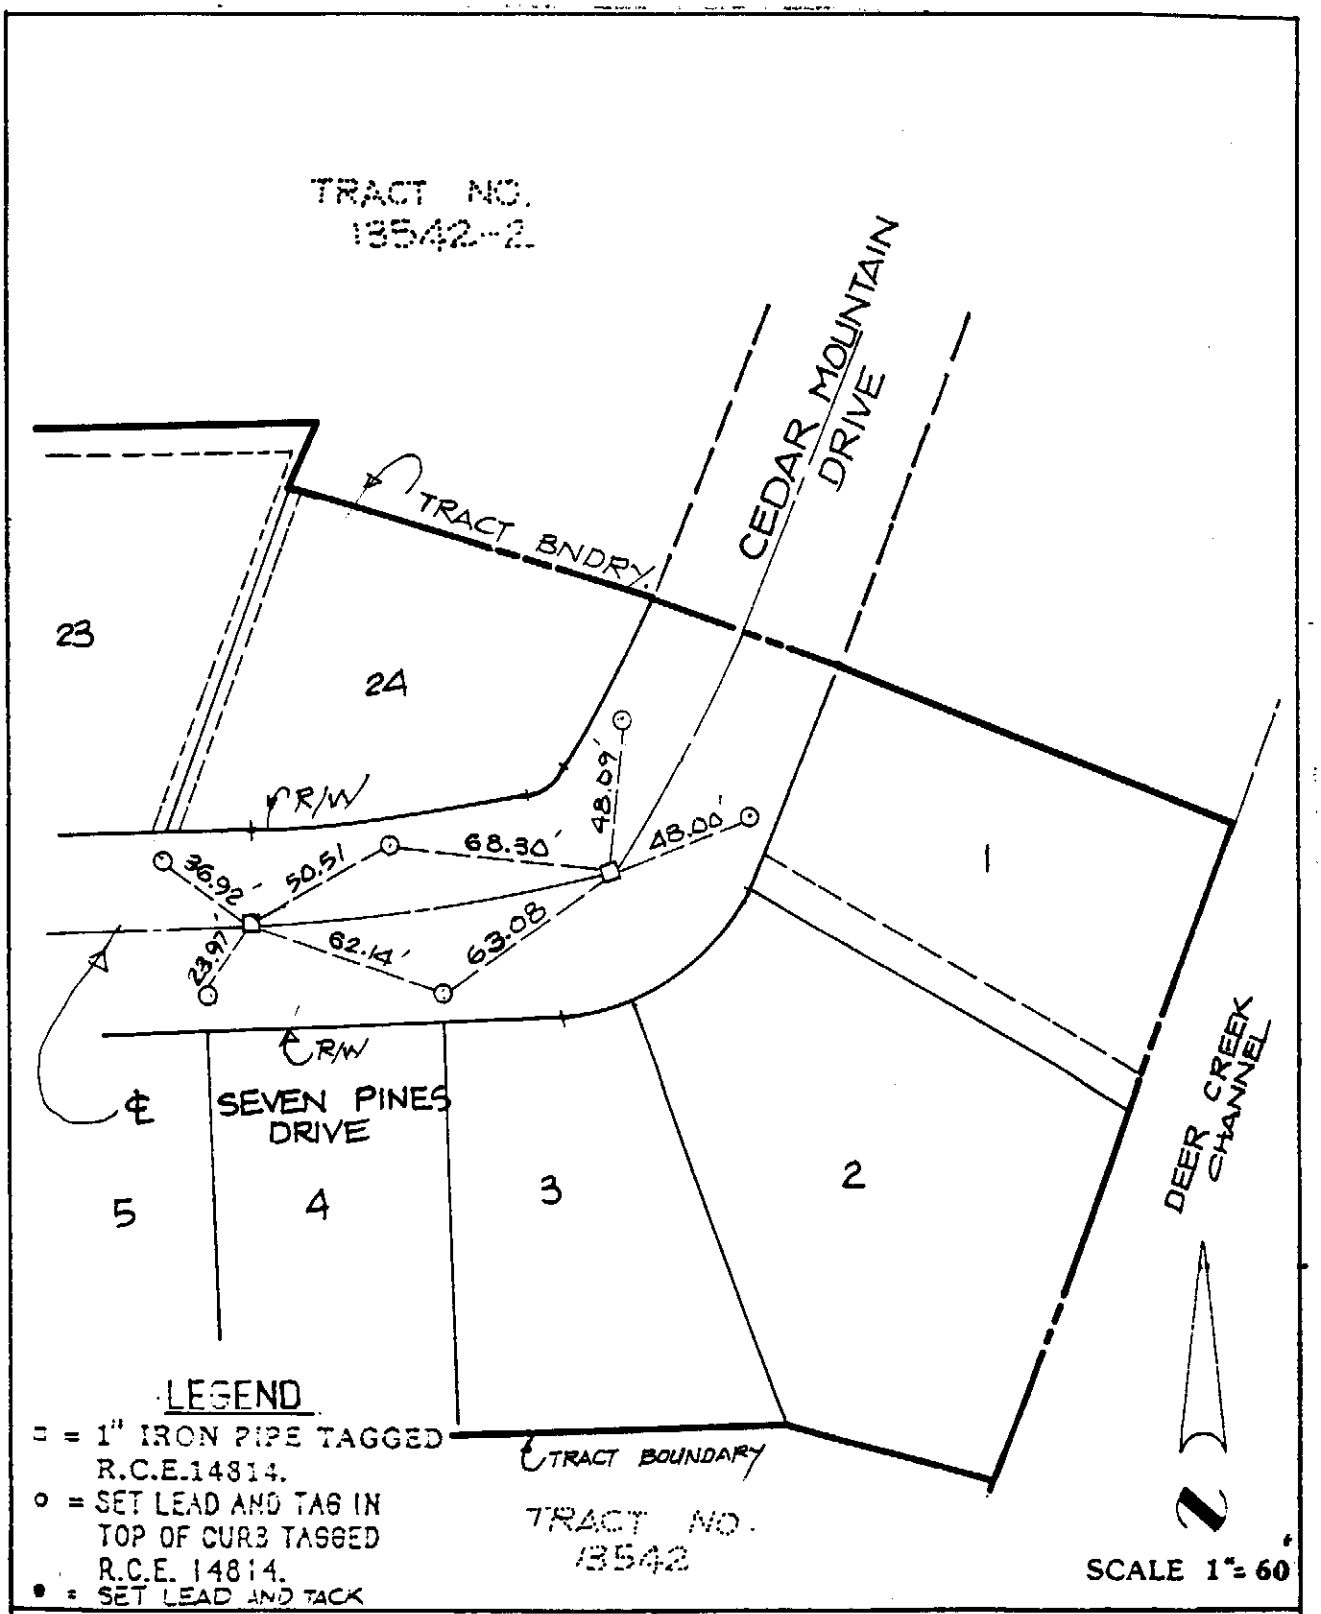

LEGEND

□ = 1" IRON PIPE TAGGED R.C.E.14814.

○ = SET LEAD AND TAG IN TOP OF CURB TAGGED R.C.E. 14814.

● = SET LEAD AND TACK

CITY OF RANCHO CUCAMONGA STREET TIE	TRACT NO. 13542-3
MADOLE AND ASSOCIATES, INC. 1820 E. 16th Street SANTA ANA, CALIFORNIA 92701 PHONE 714 • 835-2548	CEDAR MTN. DR & SEVEN PINES DRIVE
ENGR. J.M. MADOLE	FIELD REVIEW _____ DATE _____
R.C.E. NO. 14814 DATE _____	TIE BOOK 15 PAGE 104

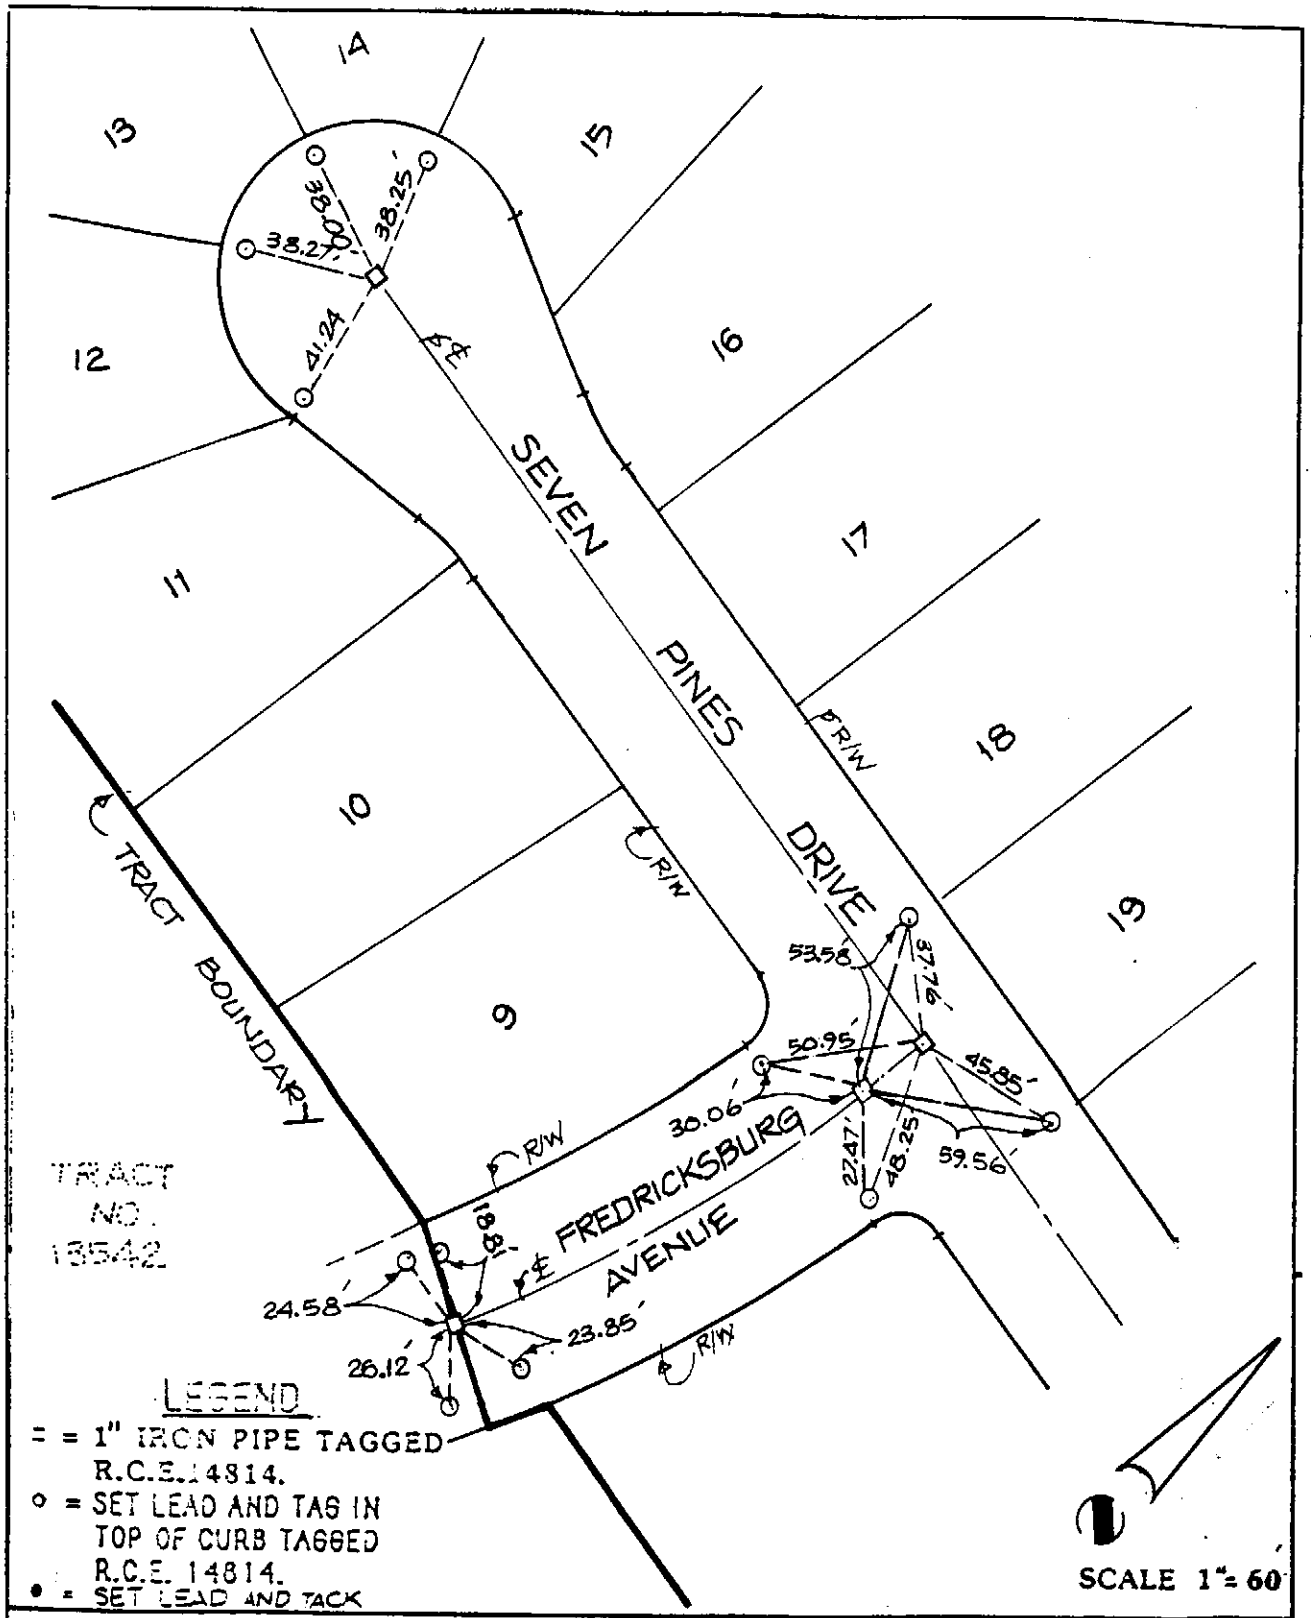

CITY OF RANCHO CUCAMONGA STREET TIE	TRACT NO. 13542-3
MADOLE AND ASSOCIATES, INC. 1820 E. 16th Street SANTA ANA, CALIFORNIA 92701 PHONE 714 • 835-2548	SEVEN PINES DRIVE AT FREDRICKSBURG
ENGR. J.M. MADOLE	FIELD REVIEW _____ DATE _____
R.C.E. NO. 14814 DATE _____	TIE BOOK 15 PAGE 105

SCALE: 1" = 40'

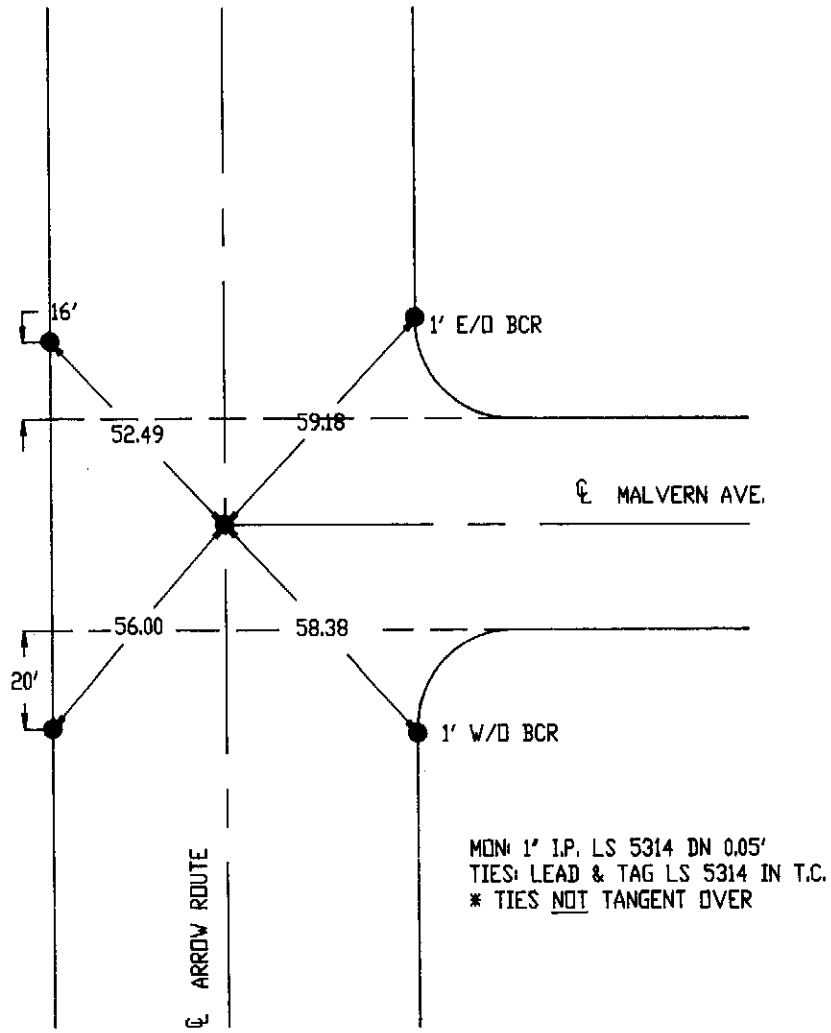

LICENSED LAND SURVEYOR
ROBERT N. MIMMACK
Exp. 12/31/91
No. 5314
STATE OF CALIFORNIA

city of rancho cucamonga

STREET TIE

Wagner Pacific
INCORPORATED
CIVIL ENGINEERS
SURVEYORS
201-B YORBA LINDA BLVD.
PLACENTIA, CA. 92670-3418
714 993 4500

ARROW ROUTE
AND
MALVERN AVE.

ENGR./L.S. ROBERT N. MIMMACK

FIELD REVIEW _____ DATE _____

R.C.E./L.S. No. LS 5314 DATE 5-14-90

TIE BOOK 15 PAGE 106

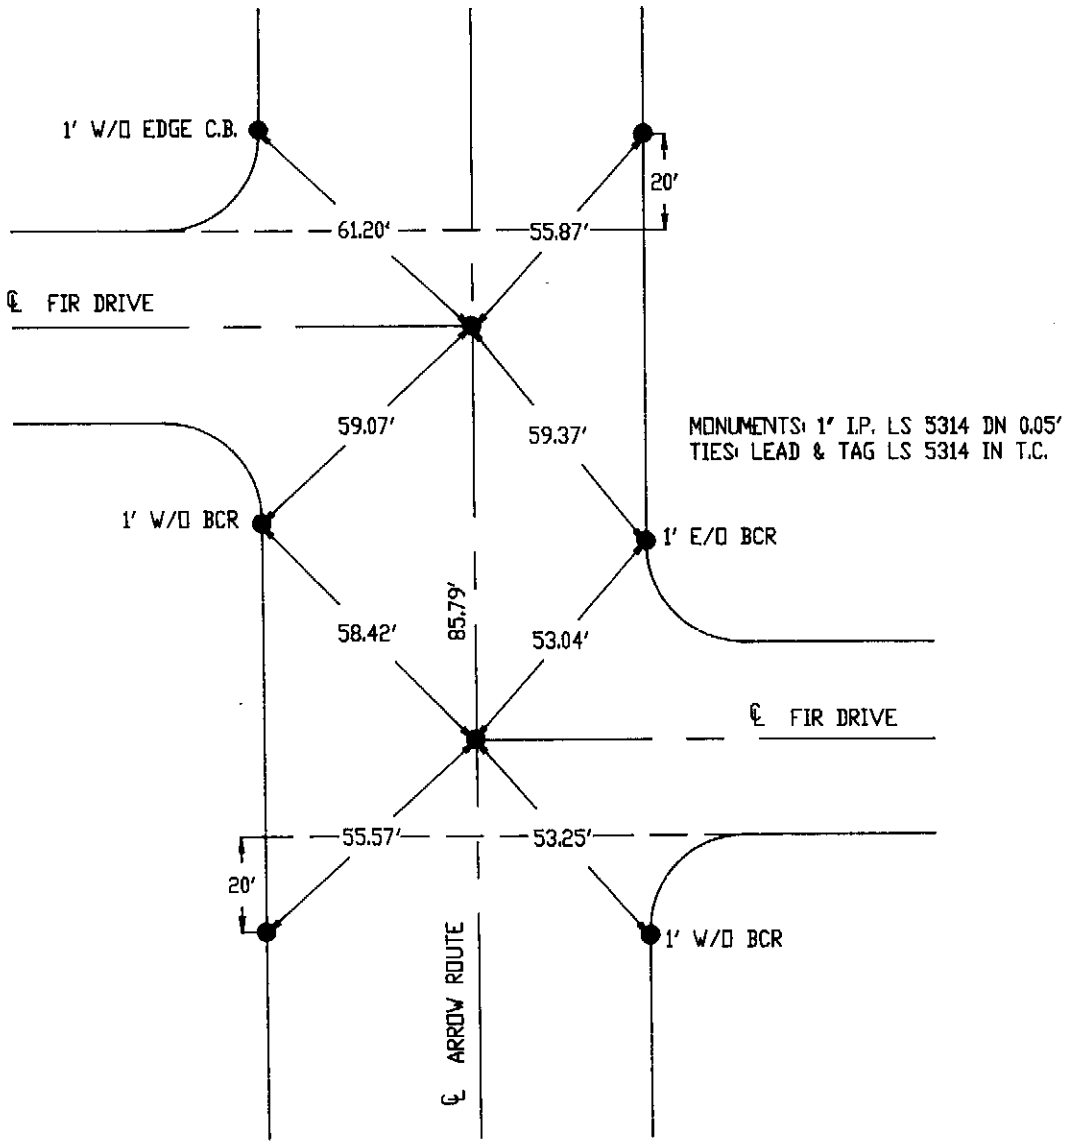

SCALE: 1" = 40'

LICENSED LAND SURVEYOR
ROBERT N MIM MACK
Exp 12/31/91
No. 5314
STATE OF CALIFORNIA

city of rancho cucamonga

STREET TIE

Wagner Pacific
INCORPORATED
CIVIL ENGINEERS
SURVEYORS
201-B YORBA LINDA BLVD.
PLACENTIA, CA. 92670-3418
714 993 4500

ARROW ROUTE
AND
- FIR DRIVE

ENGR./L.S. ROBERT N. MIMMACK

FIELD REVIEW _____ DATE _____

R.C.E./L.S. No. LS 5314 DATE 5-14-90

TIE BOOK 15 PAGE 107

SCALE: 1" = 40'

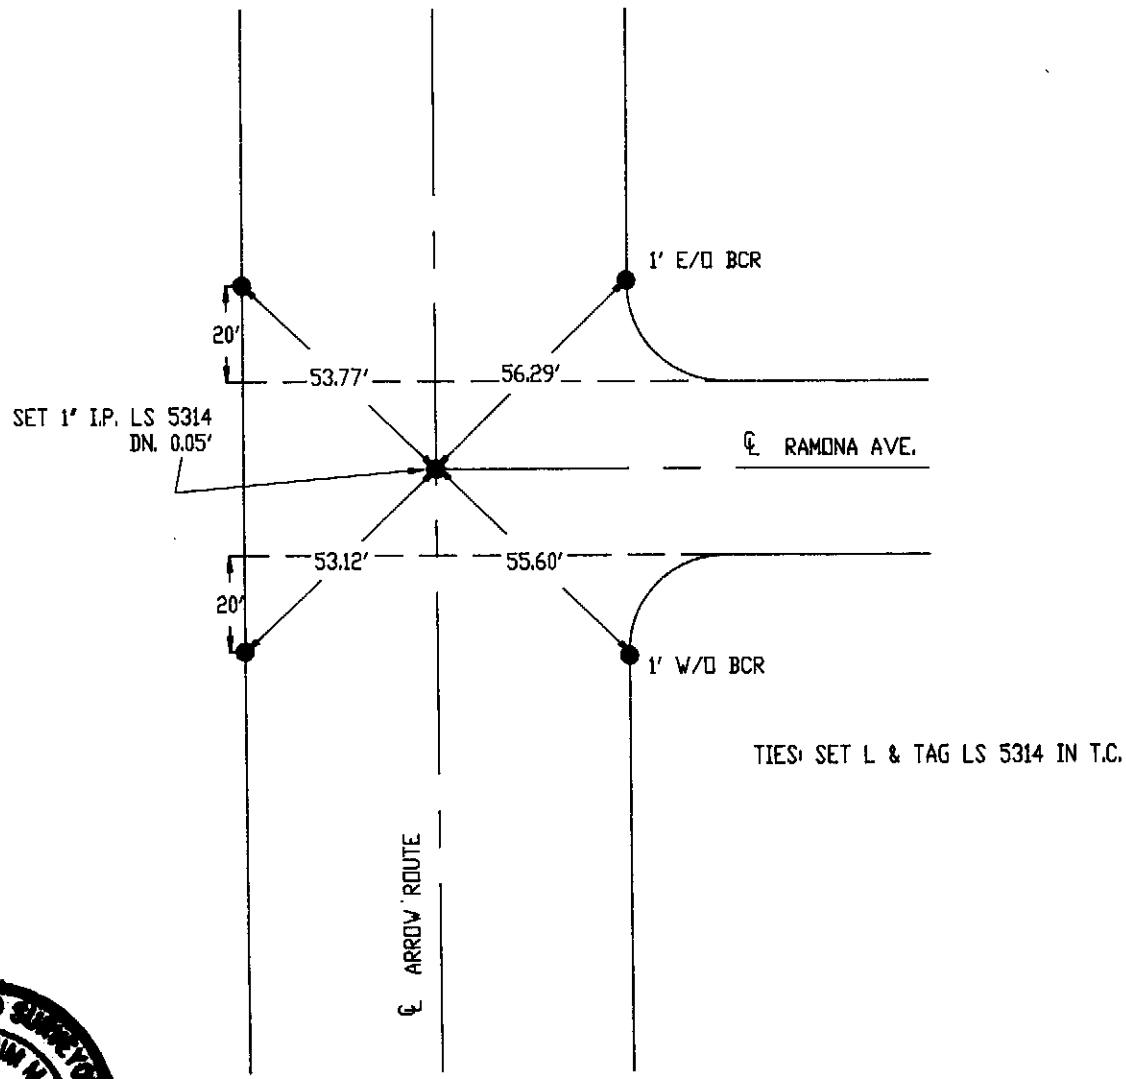

LICENSED LAND SURVEYOR
ROBERT N. MIM MACK
Exp. 12/31/91
No. 5314

city of rancho cucamonga — STREET TIE	
Wagner Pacific INCORPORATED CIVIL ENGINEERS SURVEYORS 201-B YORBA LINDA BLVD. PLACENTIA, CA. 92670-3418 714 993 4500	ARROW ROUTE AND RAMONA AVE.
ENGR./L.S. ROBERT N. MIM MACK	FIELD REVIEW _____ DATE _____
R.C.E./L.S. No. L.S. 5314 DATE 5-14-90	TIE BOOK 15 PAGE 108

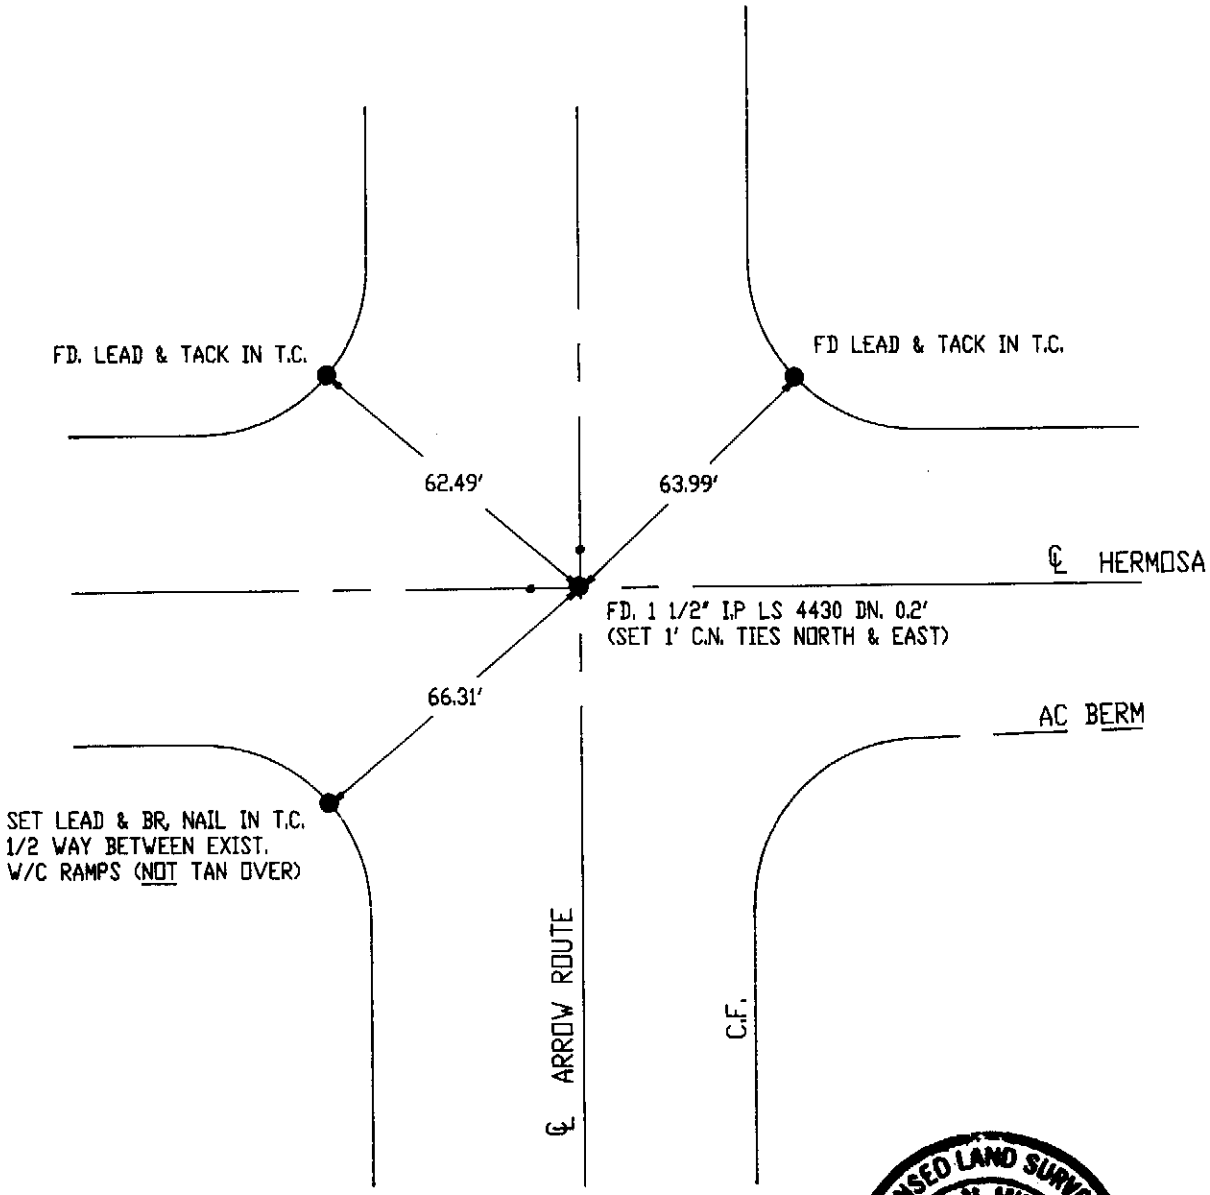

LICENSED LAND SURVEYOR
ROBERT N. MIM MACK
Exp. 12/31/91
No. 5314
STATE OF CALIFORNIA

city of
rancho cucamonga

STREET
TIE

Wagner Pacific
INCORPORATED
CIVIL ENGINEERS
SURVEYORS
201-B YORBA LINDA BLVD.
PLACENTIA, CA. 92670-3418
714 993 4500

ARROW ROUTE
AND
HERMOSA

ENGR./L.S. ROBERT N. MIM MACK

FIELD REVIEW _____ DATE _____

R.C.E./L.S. No. L.S. 5314 DATE 5-14-90

TIE BOOK 15 PAGE 109

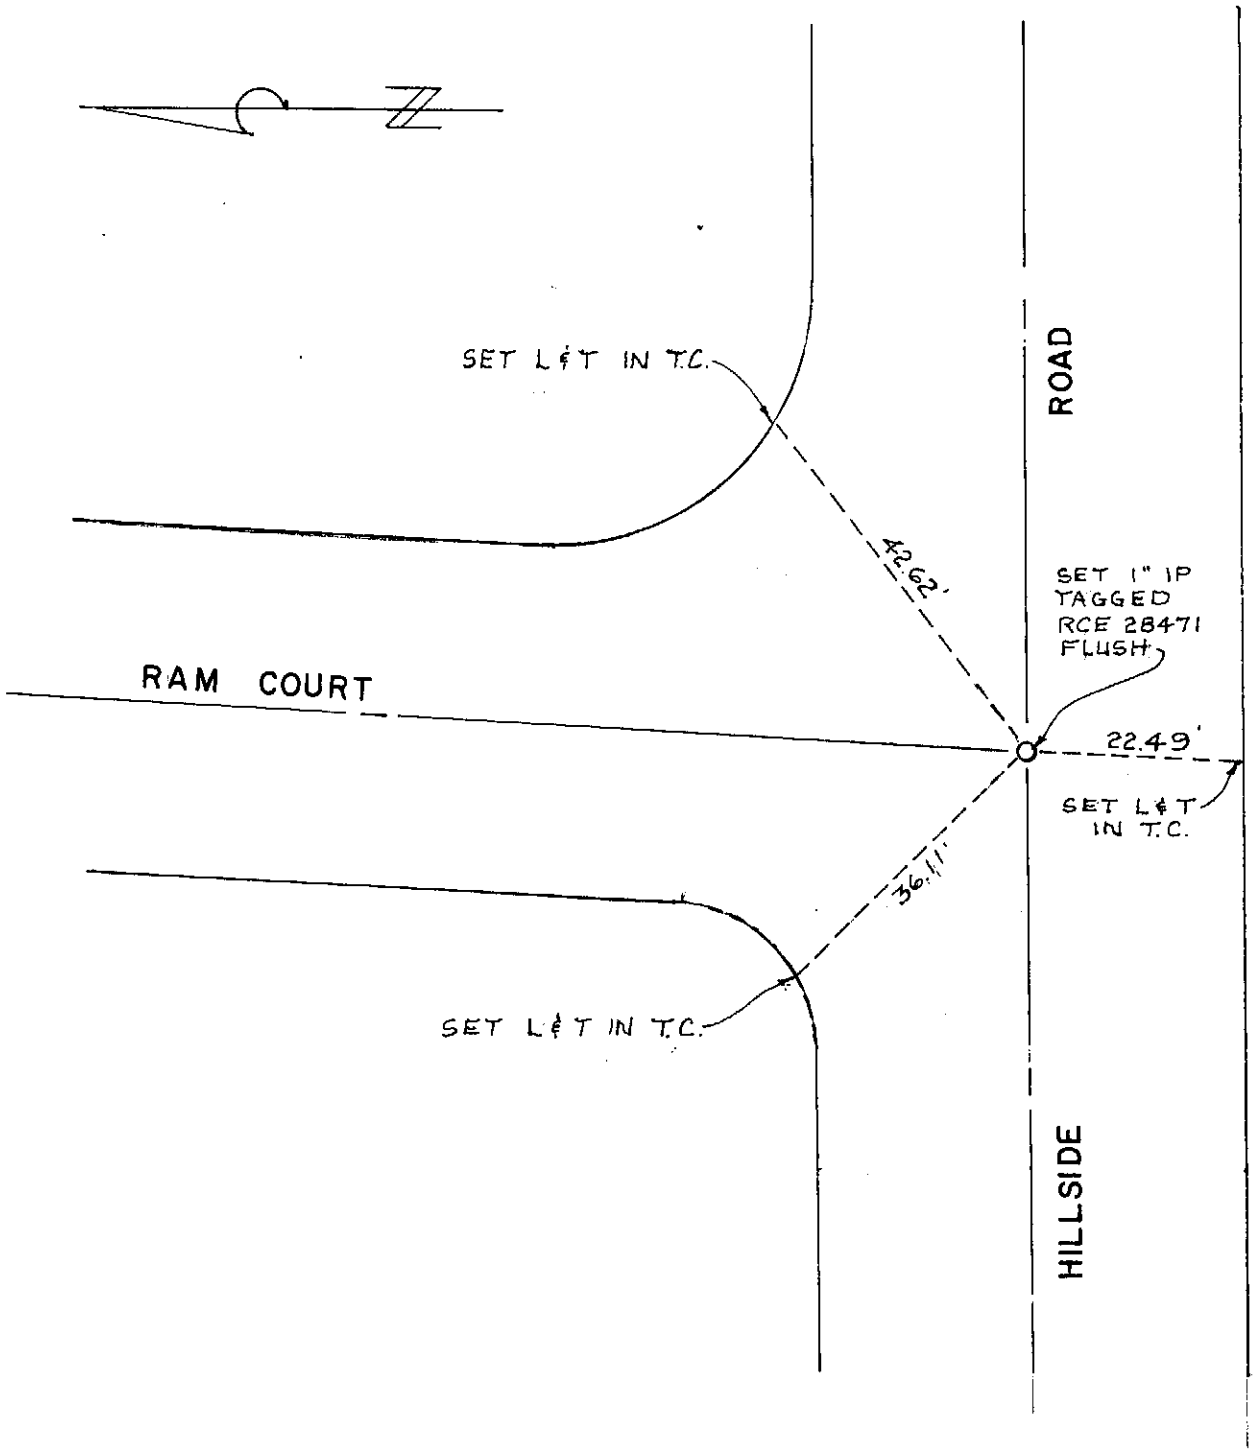

CITY OF RANCHO CUCAMONGA — STREET TIE	TRACT NO. 13810
CMS ENGINEERING 5206 BENITO ST. STE. 102 MONTCLAIR, CA. 91763 714-625-7969	RAM COURT
ENGR. RICHARD V. COSTALES	FIELD REVIEW _____ DATE _____
R.C.E. NO. 28471 DATE 7-20-90	TIE BOOK 15 PAGE 110

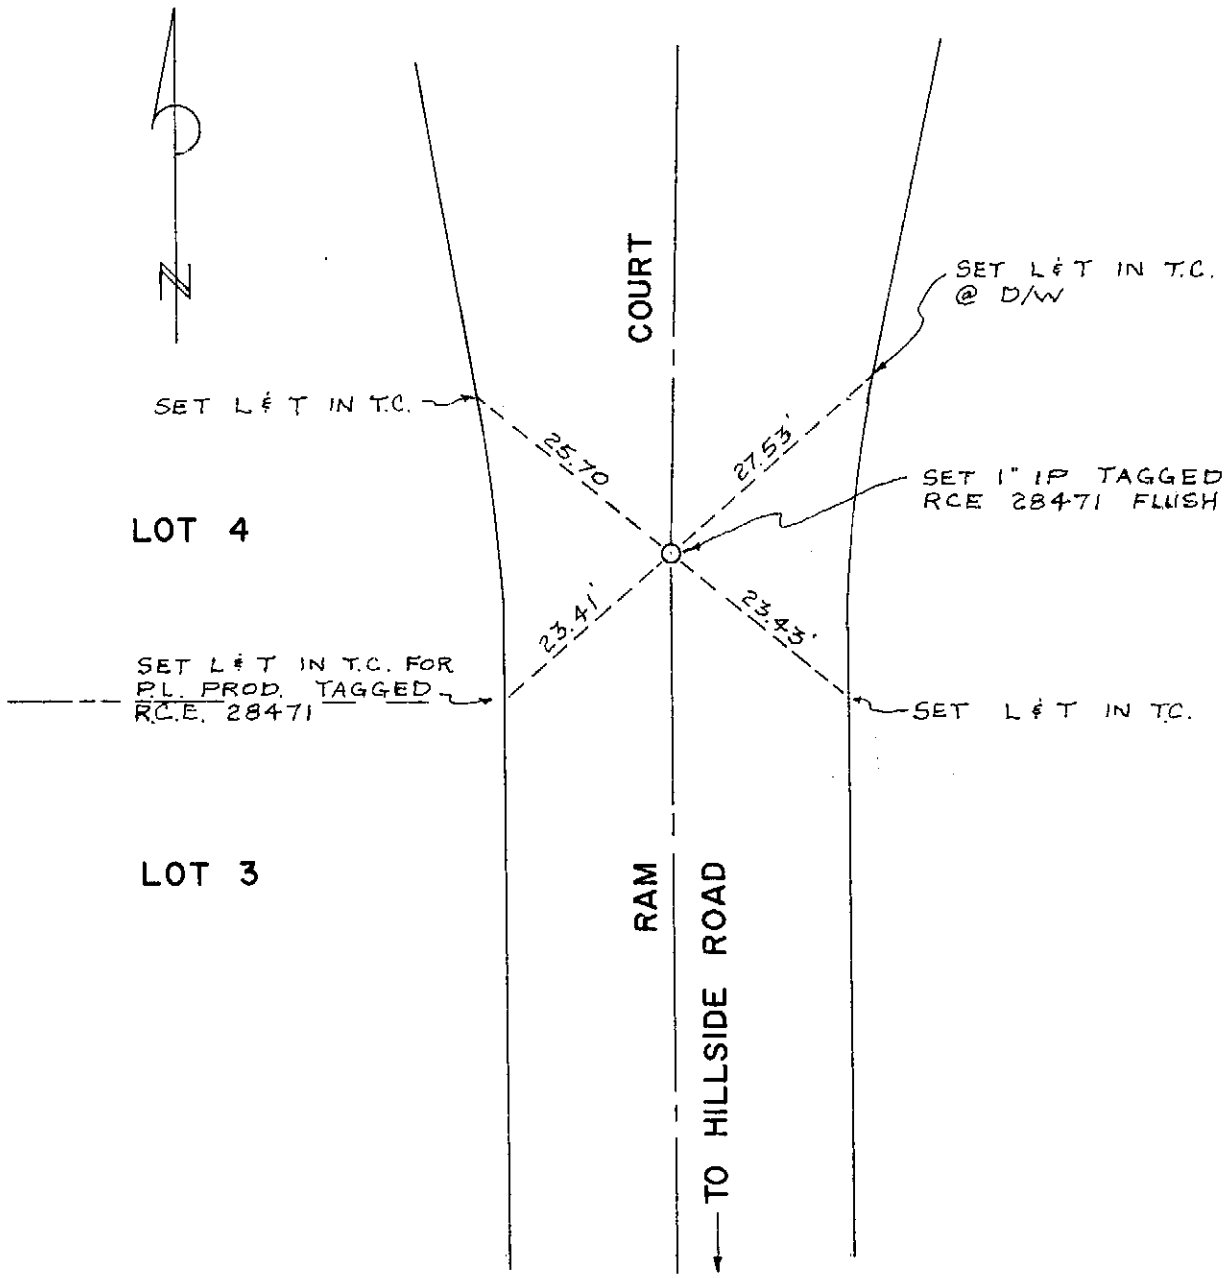

CITY OF RANCHO CUCAMONGA — STREET TIE	TRACT NO. 13810
CMS ENGINEERING 5206 BENITO ST. STE. 102 MONTCLAIR, CA. 91763 714-625-7969	RAM COURT
ENGR. RICHARD V. COSTALES	FIELD REVIEW _____ DATE _____
R.C.E. NO. 28471 DATE 7-20-90	TIE BOOK 15 PAGE 111

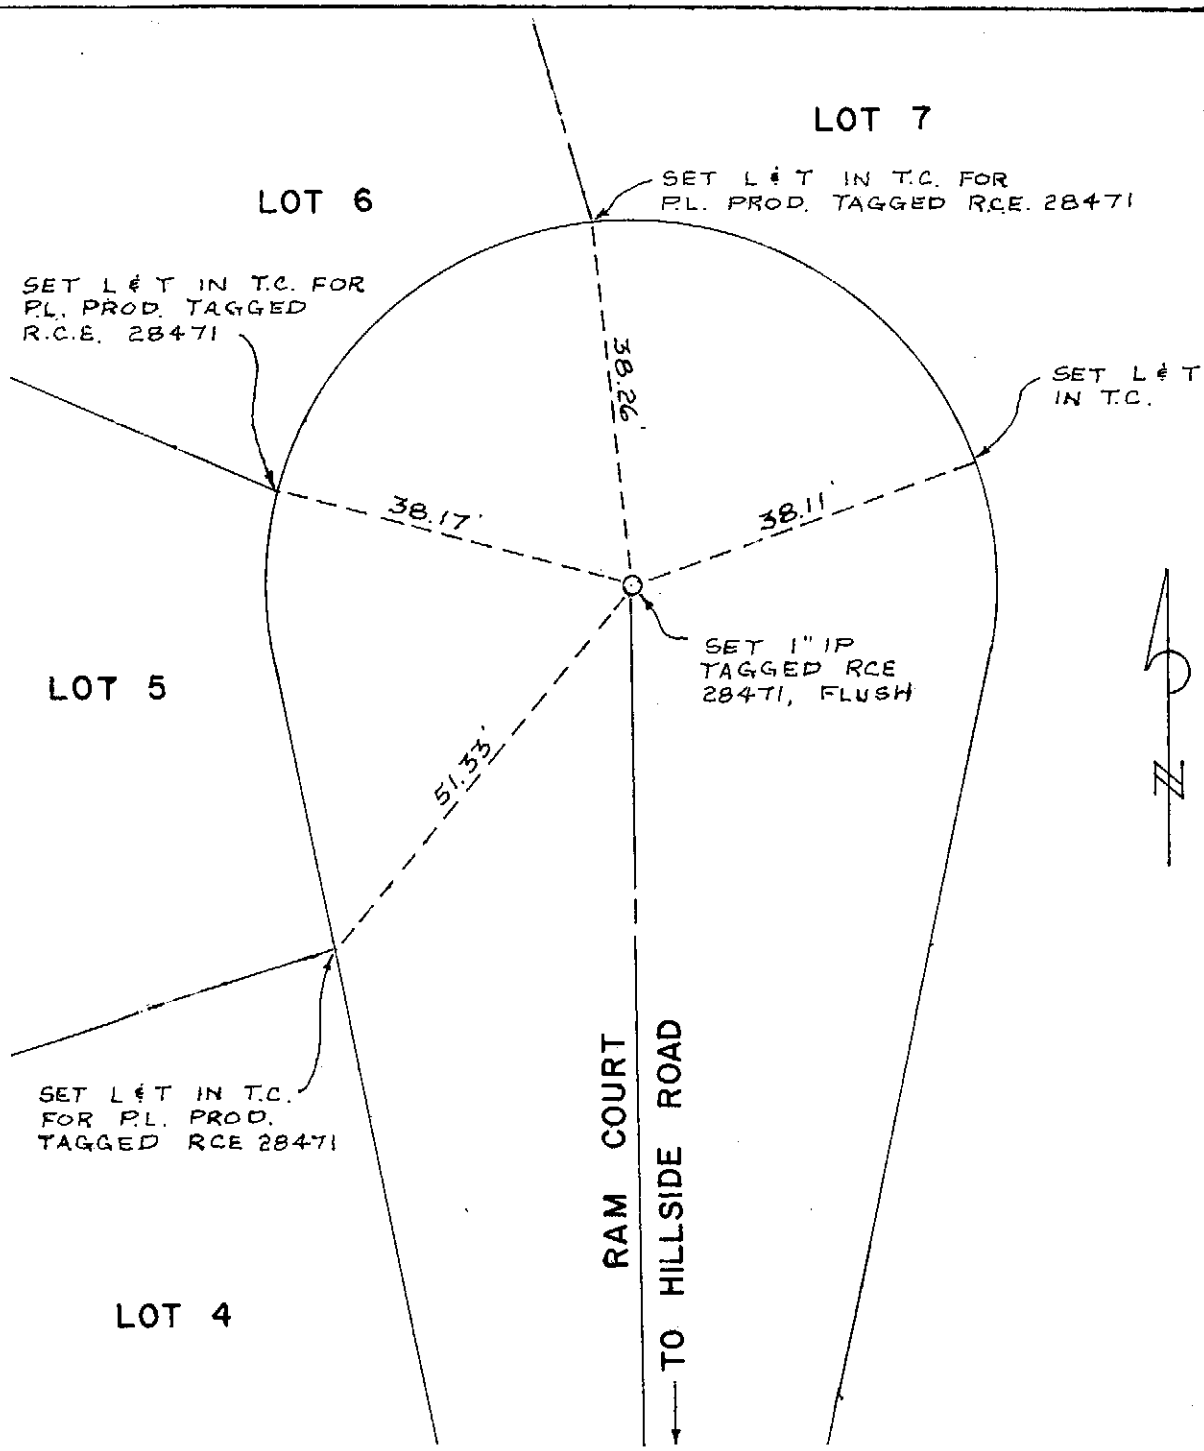

CITY OF RANCHO CUCAMONGA — STREET TIE	TRACT NO. 13810
CMS ENGINEERING 5206 BENITO ST. STE. 102 MONTCLAIR, CA. 91763 714-625-7969	RAM COURT
ENGR. RICHARD V. COSTALES	FIELD REVIEW _____ DATE _____
R.C.E. NO. 28471 DATE 7-20-90	TIE BOOK 15 PAGE 112

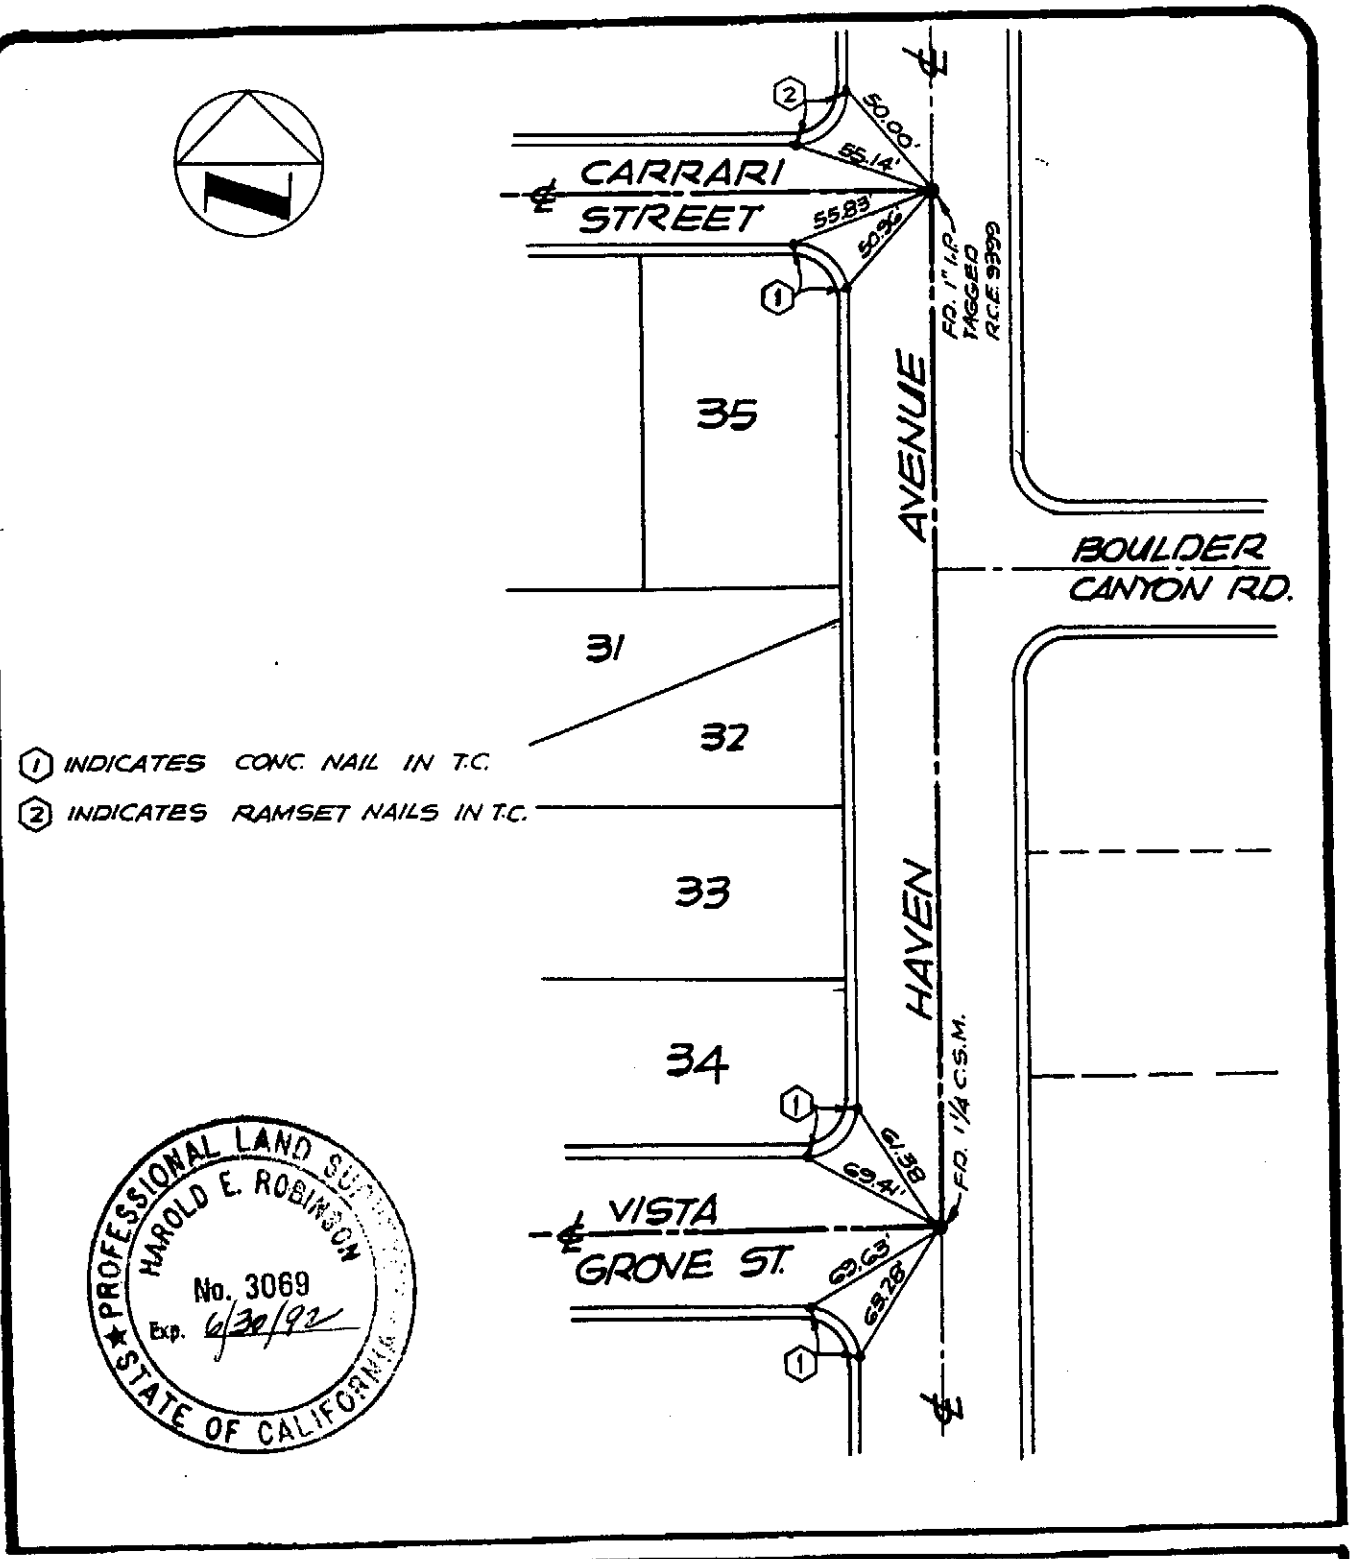

city of rancho cucamonga — STREET TIE	TRACT No. 13697
	INTERSECTION OF CARRARI ST. & HAVEN AVE. & VISTA GROVE ST.
ENGR. / L.S.	FIELD REVIEW ____ DATE ____
R.C.E. / L.S. No. PLS 3069 DATE 5/6/92	TIE BOOK 15 PAGE 113

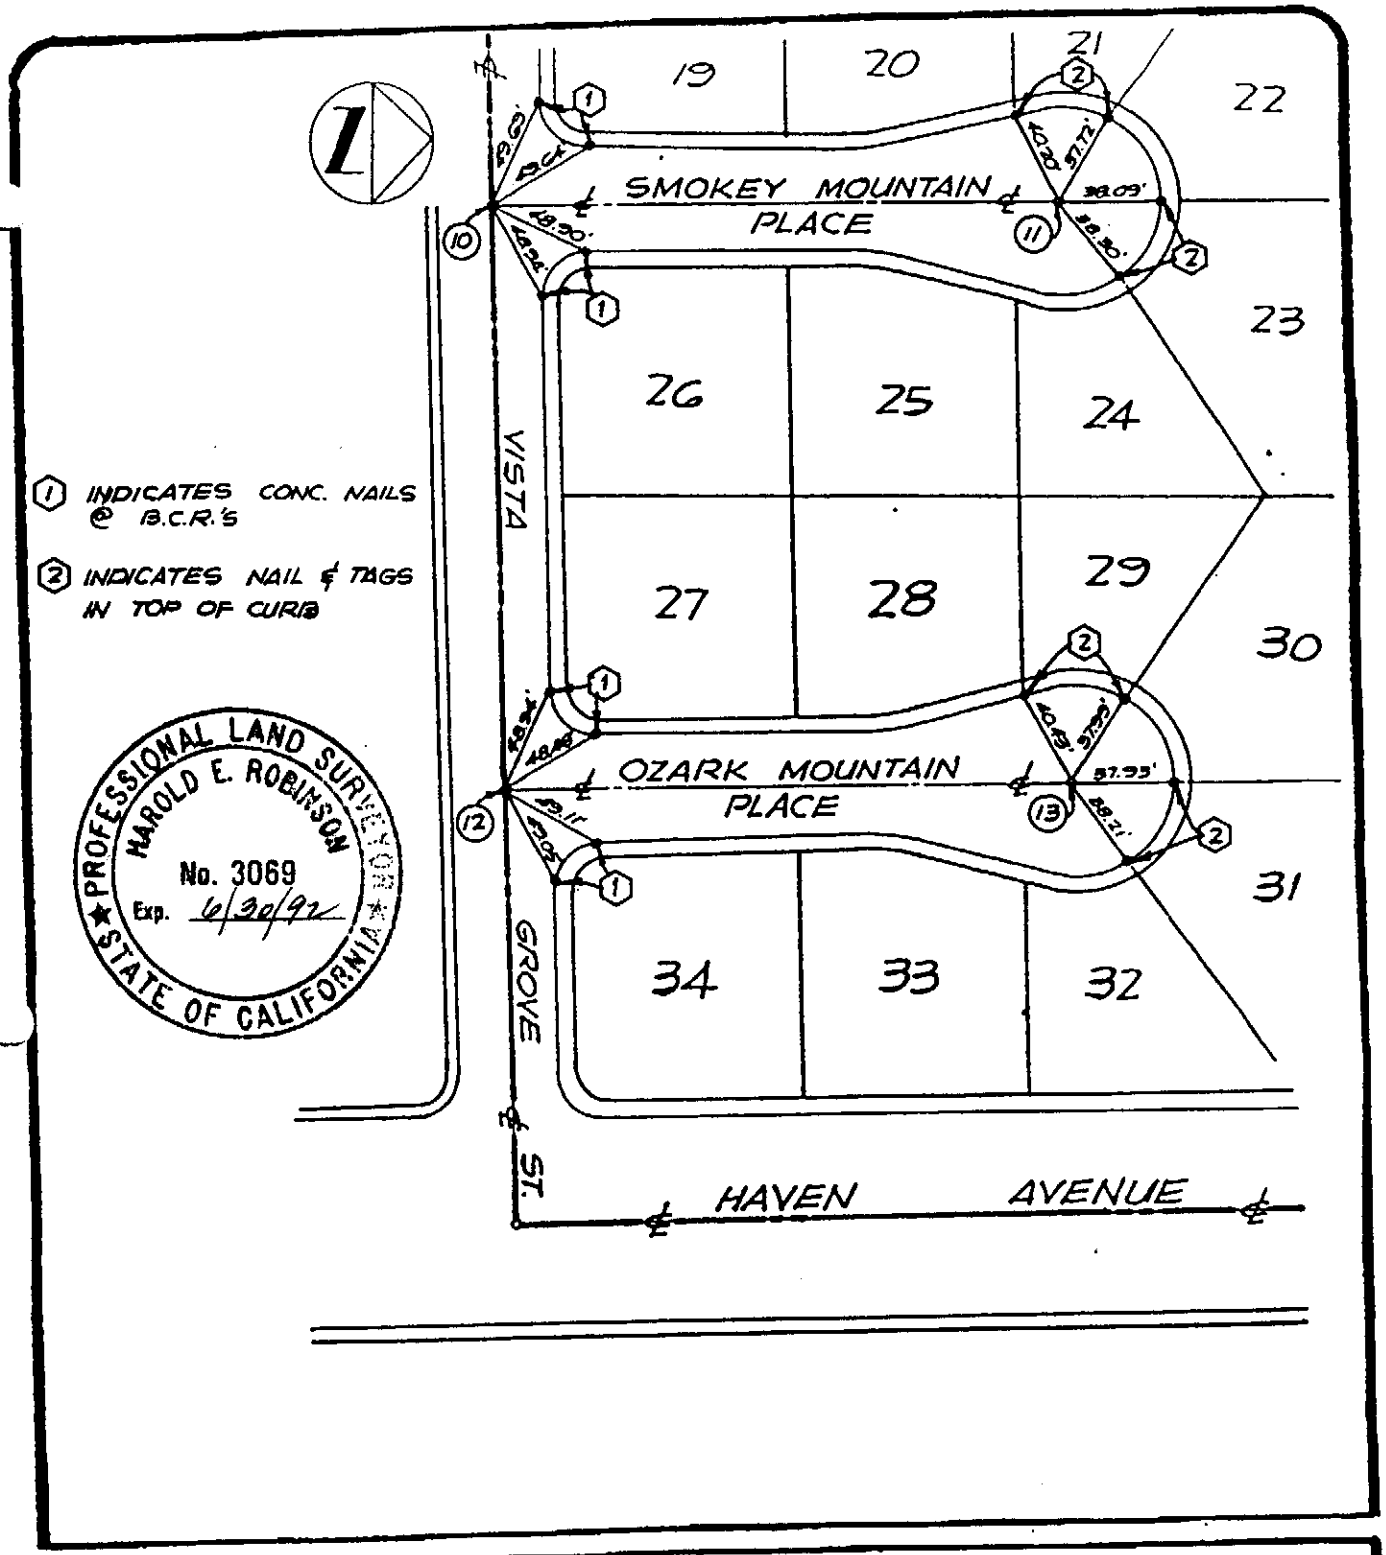

city of rancho cucamonga — STREET TIE	TRACT No. 13697
	INTERSECTION OF SMOKEY MOUNTAIN PLACE & OZARK MOUNTAIN PLACE & VISTA GROVE ST.
ENGR. / L.S.	FIELD REVIEW _____ DATE _____
R.C.E. / L.S. No. PLS 3069 DATE 8/1/92	TIE BOOK 15 PAGE 114

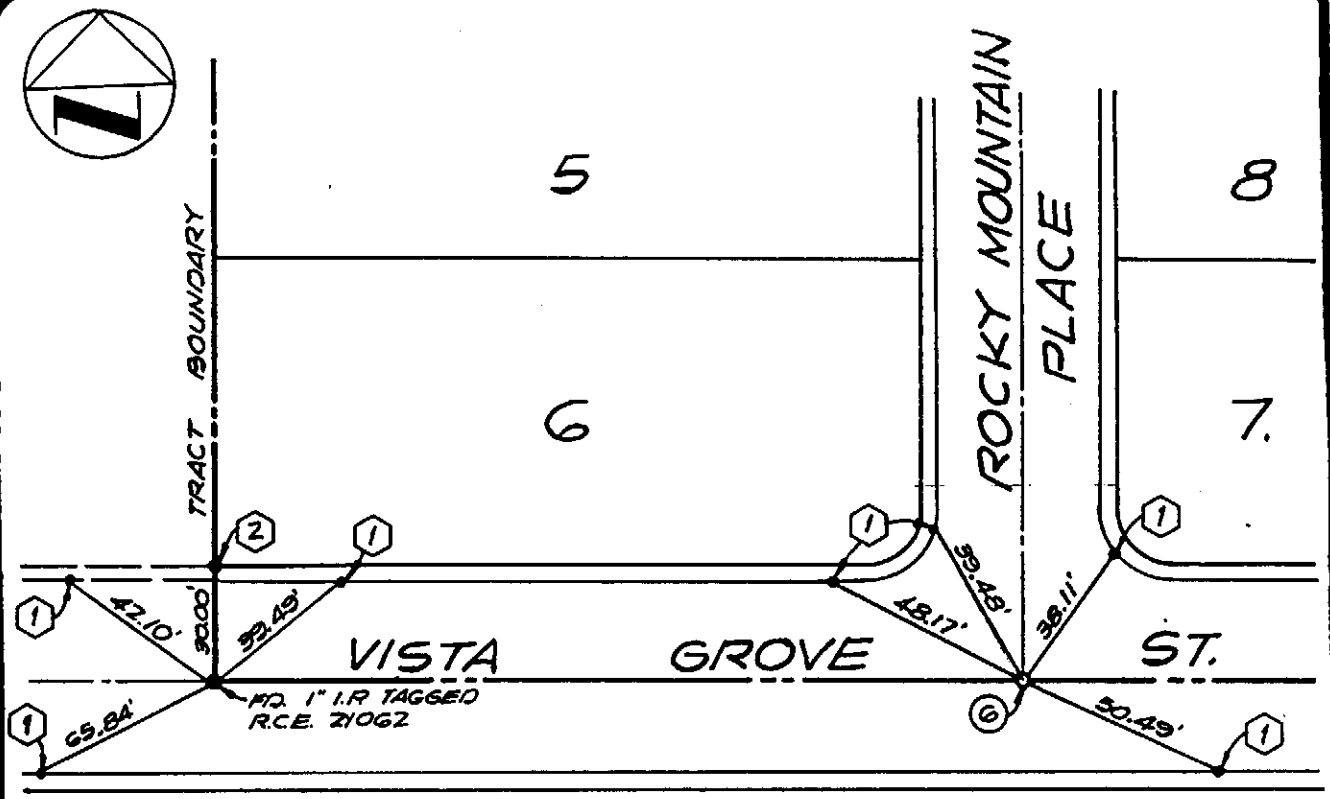

(1) INDICATES CONC. IN TOP OF CURB.

(2) INDICATES NAIL & TAG

PROFESSIONAL LAND SURVEYOR
HAROLD E. ROBINSON
No. 3069
Exp. 6/30/92
STATE OF CALIFORNIA

city of rancho cucamonga — STREET TIE	TRACT No. 13697
	INTERSECTION OF VISTA GROVE ST. & ROCKY MOUNTAIN PLACE
ENGR. / L.S. Harold E. Robinson	FIELD REVIEW _____ DATE _____
R.C.E. / L.S. No. PLS 3069 DATE 8/10/90	TIE BOOK 15 PAGE 115

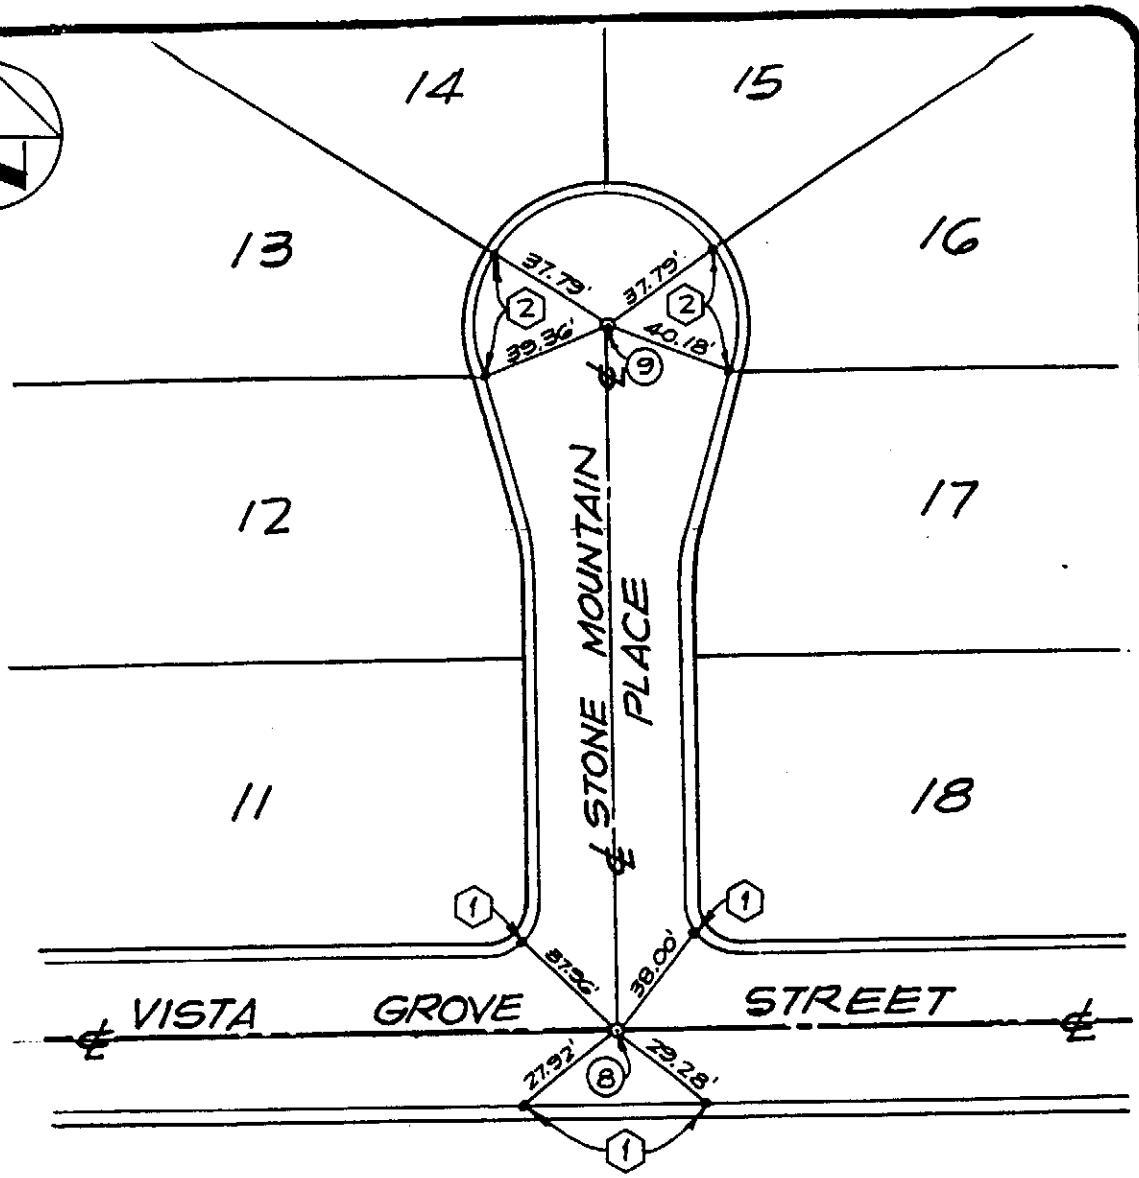

(1) INDICATES CONC. NAIL IN T.C.

(2) INDICATES CONC. NAIL TAGGED P.L.S. 3069 IN T.C.

PROFESSIONAL LAND SURVEYOR
HAROLD E. ROBINSON
No. 3069
Exp. 6/30/92
STATE OF CALIFORNIA

city of rancho cucamonga — STREET TIE	TRACT No. 13697
	INTERSECTION OF STONE MOUNTAIN PLACE & VISTA GROVE ST.
ENGR. / L.S.	FIELD REVIEW ____ DATE ____
R.C.E. / L.S. No. PLS 3069 DATE 8/10/90	TIE BOOK 15 PAGE 116

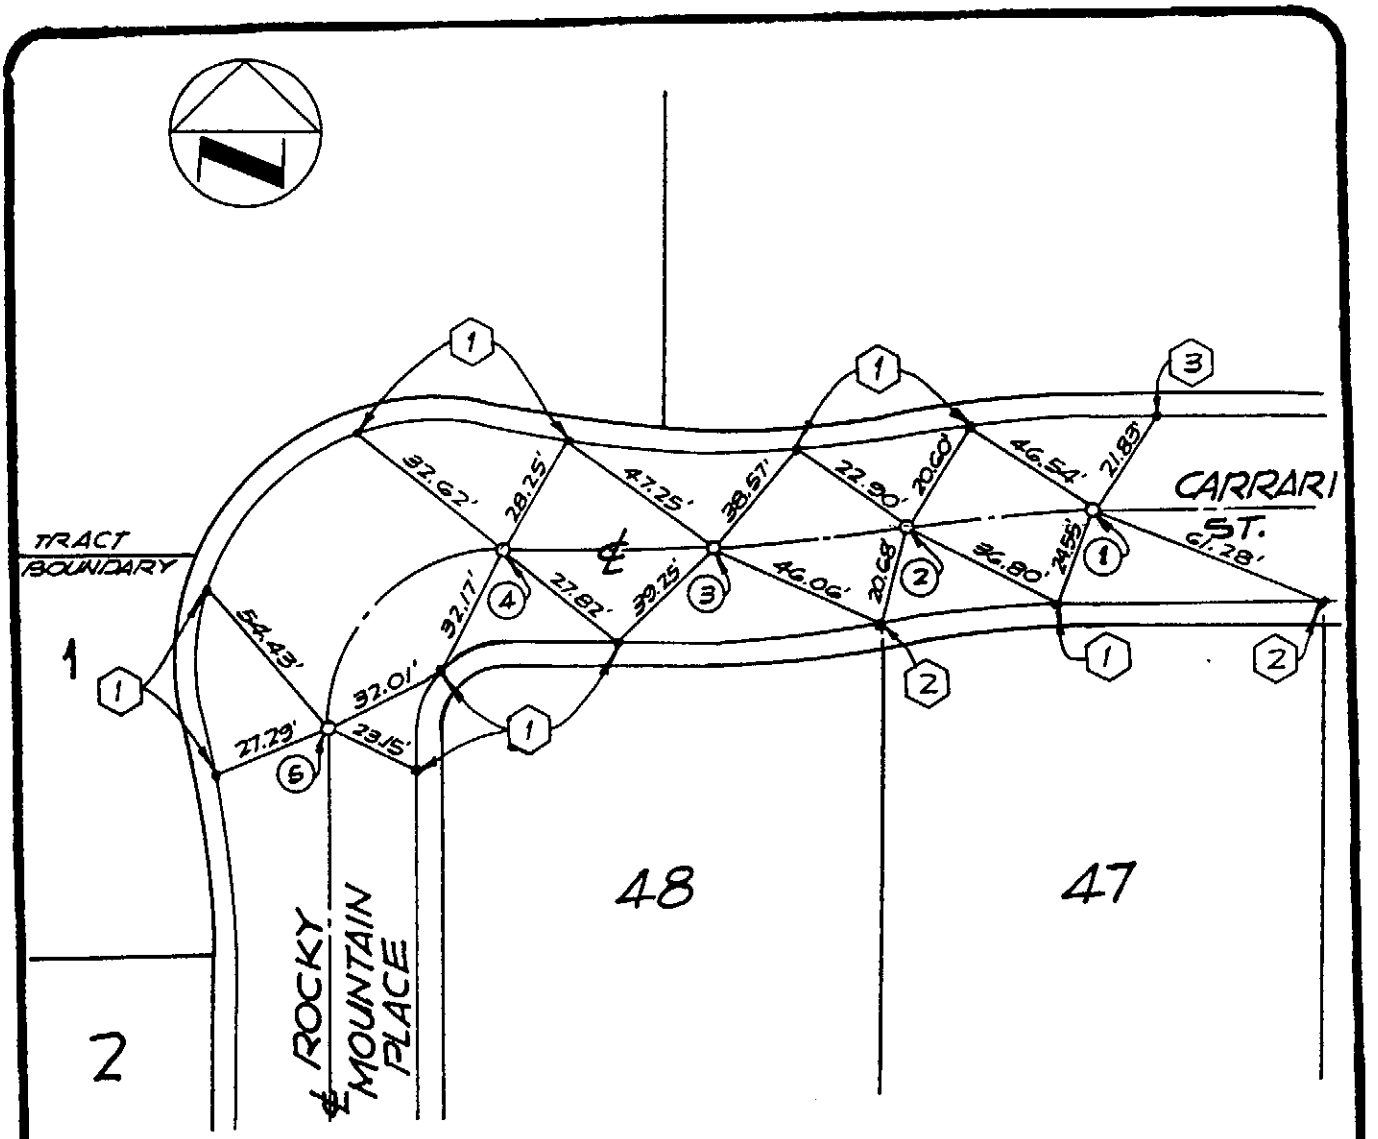

(1) INDICATES CONC. NAIL IN TOP OF CURB

(2) INDICATES NAIL & TAG P.L.S. 3069 IN T.C.

(3) INDICATES RAMSET NAIL W/ C.C.W.D. TAG IN T.C.

PROFESSIONAL LAND SURVEYOR
HAROLD E. ROBINSON
No. 3069
Exp. 6/30/92
STATE OF CALIFORNIA

city of rancho cucamonga — STREET TIE	TRACT No. 13697
	ROCKY MOUNTAIN PLACE & CARRARI ST.
ENGR. / L.S. Harold E. Robinson	FIELD REVIEW _____ DATE _____
R.C.E. / L.S. No. PLS 3069 DATE 8/10/90	TIE BOOK 15 PAGE 117

O: SET LEAD AND SCRIBED TACK IN TOP OF CURB

△: INDICATES SET 8" SPIKE AND WASHER TAGGED "LS 4693", FLUSH

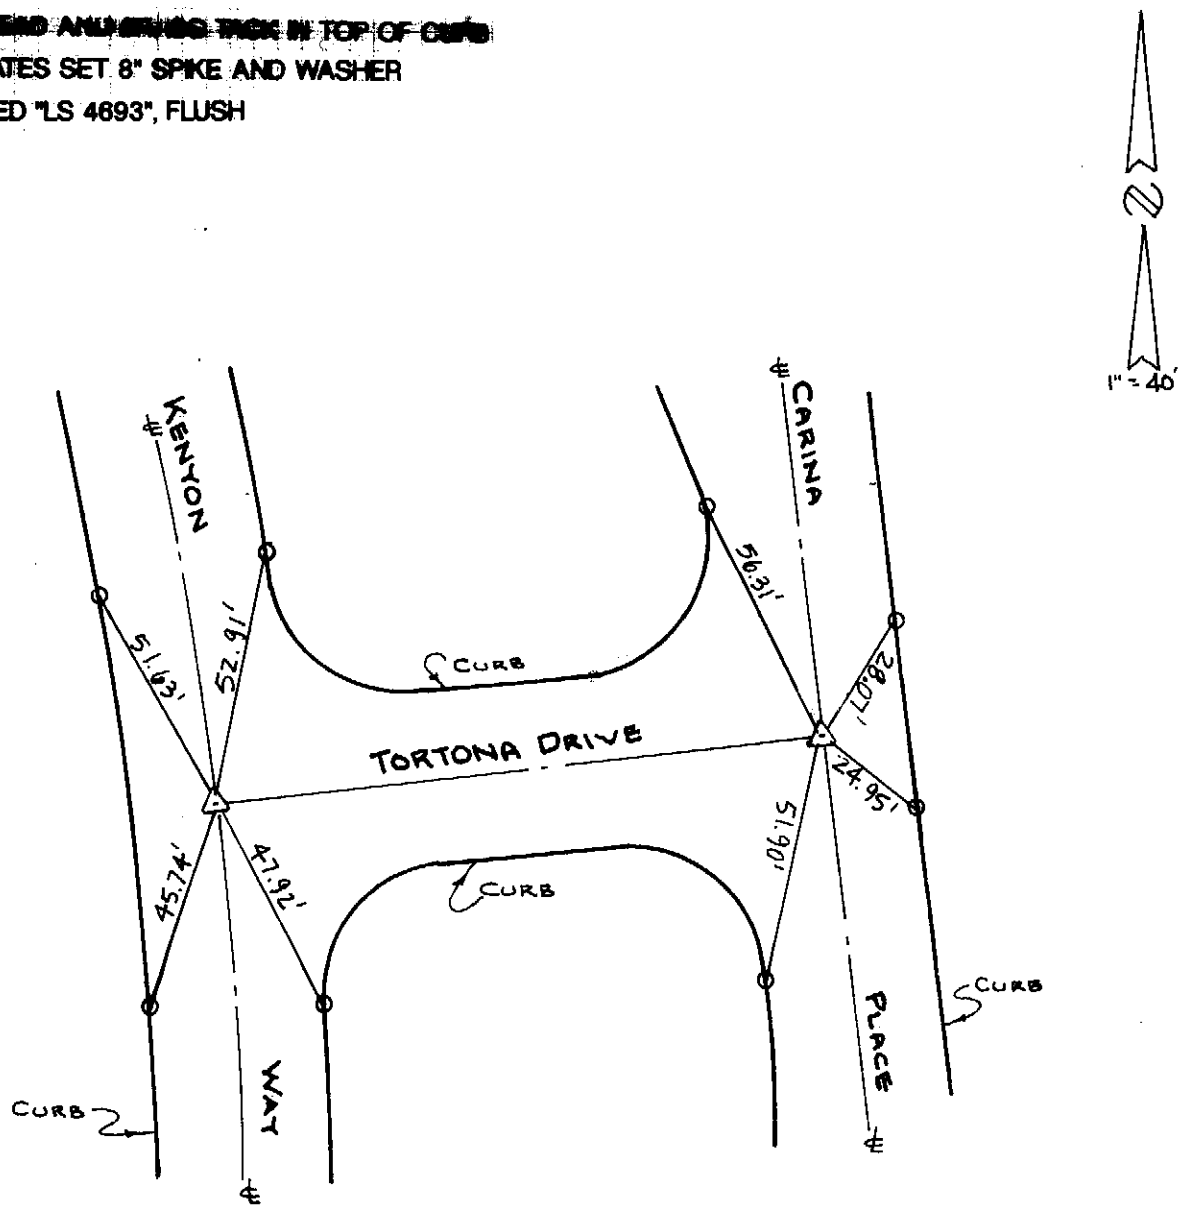

city of rancho cucamonga — STREET TIE	TRACT NO. 13445
MORSE CONSULTING GROUP — PLANNING • ENGINEERING • SURVEYING 4690 IRVINE BOULEVARD, SUITE #201 IRVINE, CALIFORNIA 92720-1999 (714) 730-7117 • FAX (714) 730-7260	TORTONA DRIVE KENYON WAY & CARINA PLACE
L.S. Gary W. Dokich	FIELD REVIEW _____ DATE _____
L.S. # 4693 DATE _____	TIE BOOK 15 PAGE 118

○ = SET LEAD AND BRASS TACK IN TOP OF CURB

△ = INDICATES SET 8" SPIKE AND WASHER TAGGED "LS 4693", FLUSH

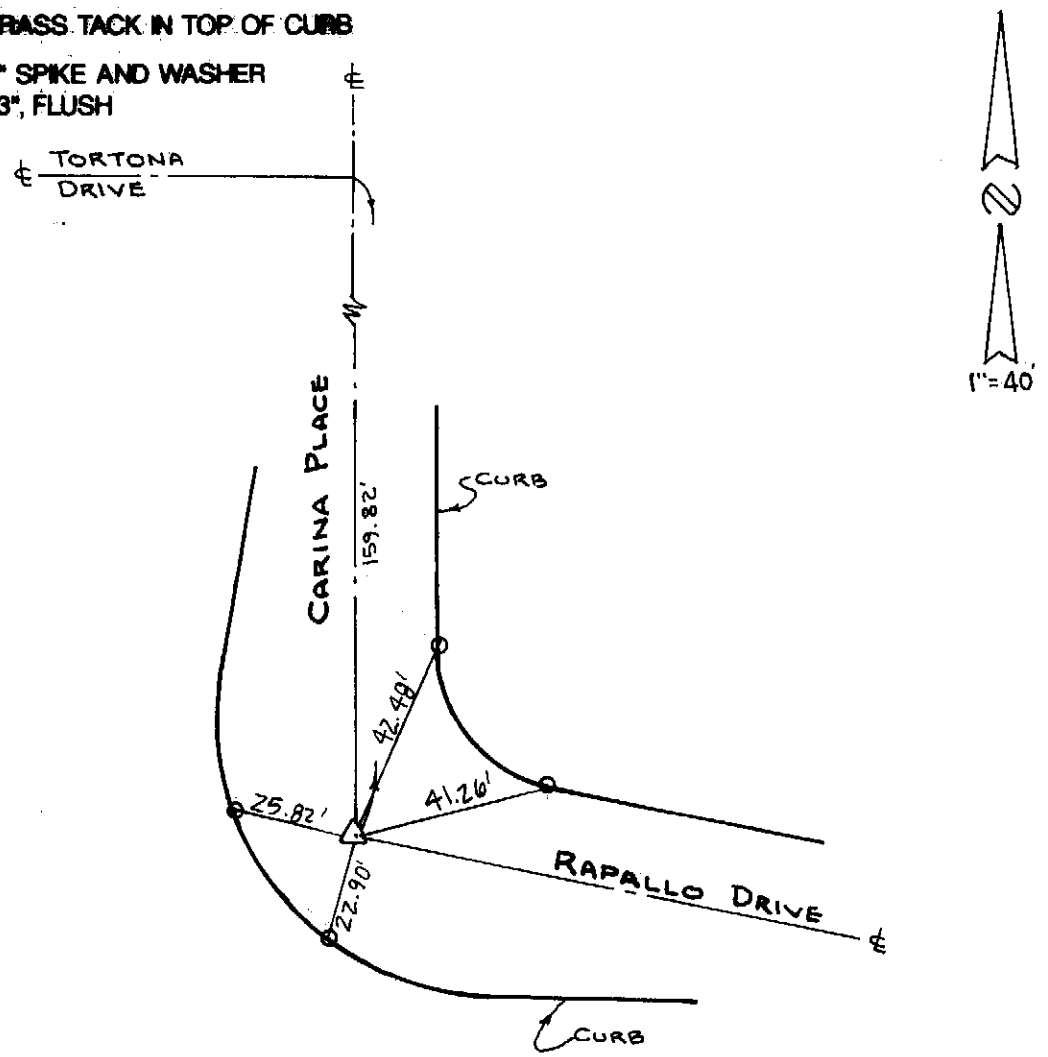

city of rancho cucamonga — STREET TIE	TRACT NO. 13445
MORSE CONSULTING GROUP PLANNING • ENGINEERING • SURVEYING 4990 IRVINE BOULEVARD, SUITE #201 IRVINE, CALIFORNIA 92720-1999 (714) 730-7117 • FAX (714) 730-7260	CARINA PLACE ℄ RAPALLO DRIVE
L.S. Gary W. Dokich	FIELD REVIEW _____ DATE _____
L.S. # 4693 DATE _____	TIE BOOK 15 PAGE 119

O = SET LEAD AND BRASS TACK IN TOP OF CURB

△ = INDICATES SET 8" SPIKE AND WASHER TAGGED "LS 4693", FLUSH

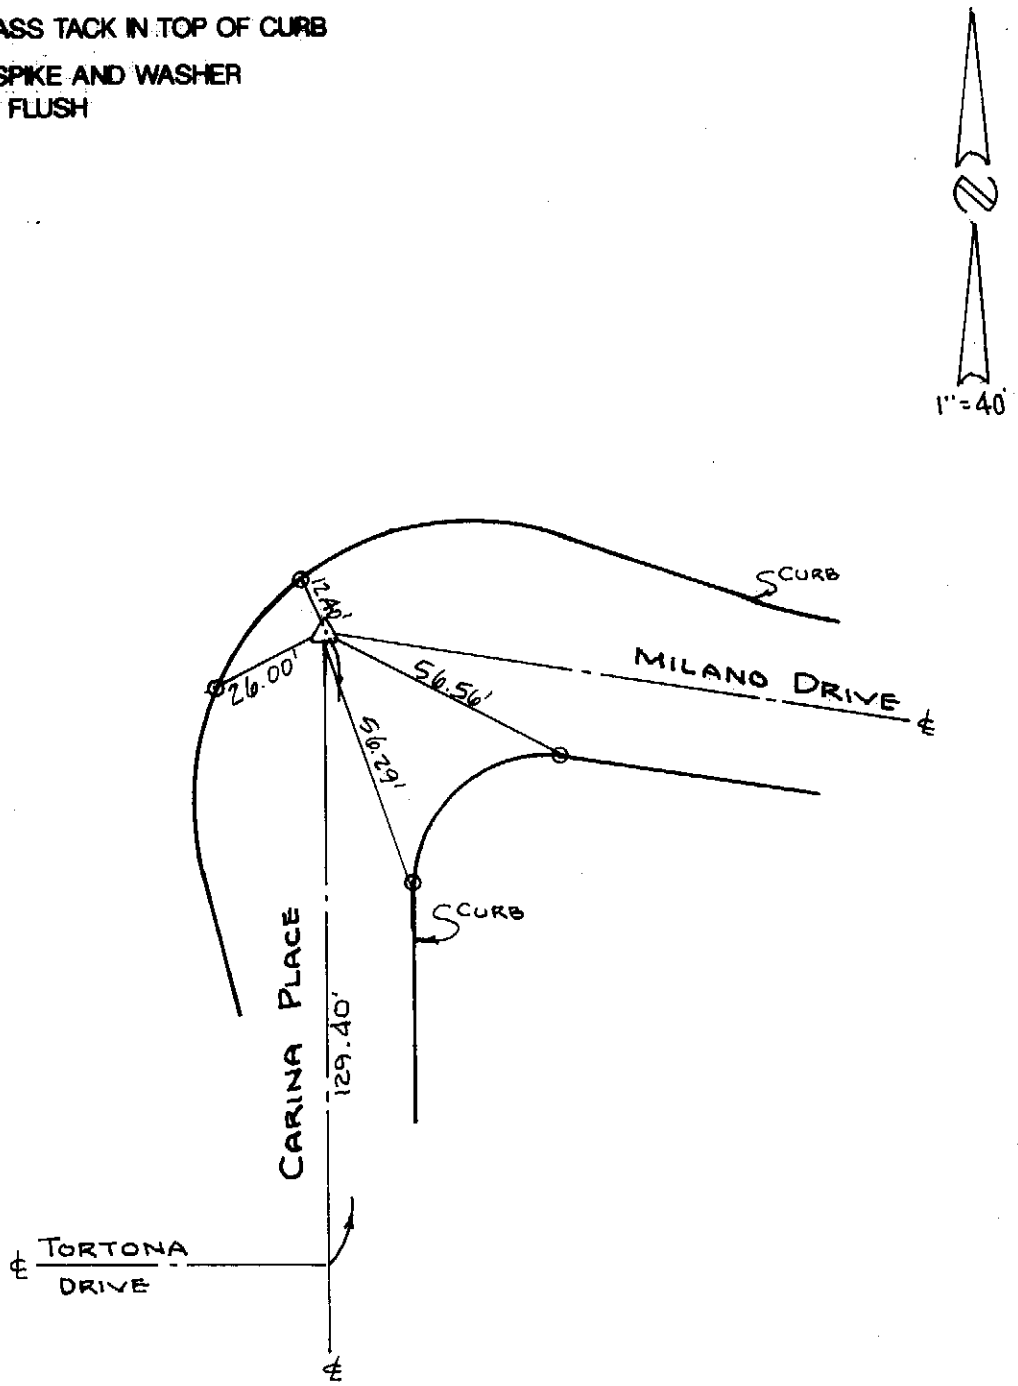

city of rancho cucamonga — STREET TIE	TRACT NO. 13445
MORSE CONSULTING GROUP — PLANNING • ENGINEERING • SURVEYING — 4990 IRVINE BOULEVARD, SUITE #201, IRVINE, CALIFORNIA 92720-1999, (714) 730-7117 • FAX (714) 730-7260	CARINA PLACE & MILANO DRIVE
L.S. Gary W. Dokich	FIELD REVIEW _____ DATE _____
L.S. # 4693 DATE _____	TIE BOOK 15 PAGE 120

○ = SET LEAD AND BRASS TACK IN TOP OF CURB

Ⓐ = INDICATES SET 4 PUNCHMARKS IN MANHOLE RIM WITH CROSS TIES

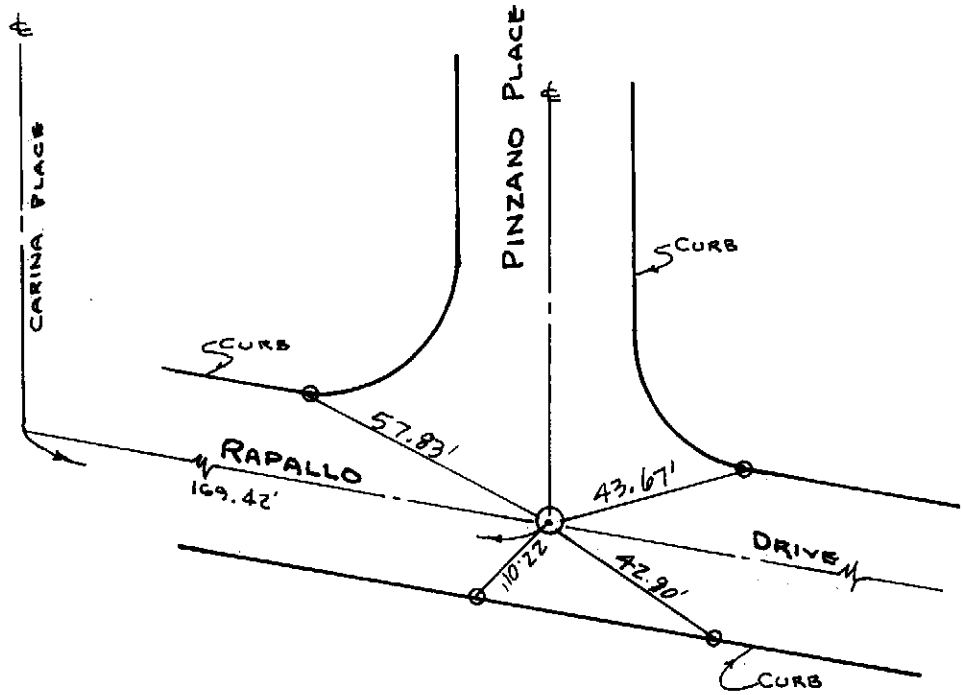

N

1" = 40'

city of rancho cucamonga — STREET TIE	TRACT NO. 13445
MORSE CONSULTING GROUP — PLANNING • ENGINEERING • SURVEYING 4968 IRVINE BOULEVARD, SUITE #201 IRVINE, CALIFORNIA 92720-1999 (714) 730-7117 • FAX (714) 730-7260	RAPALLO DRIVE ℄ PINZANO PLACE
L.S. Gary W. Dokich	FIELD REVIEW _____ DATE _____
L.S. # 4693 DATE _____	TIE BOOK 15 PAGE 121

○ = SET LEAD AND BRASS TACK IN TOP OF CURB

⊙ = INDICATES SET 4 PUNCHMARKS IN MANHOLE RIM WITH CROSS TIES

N

1" = 40'

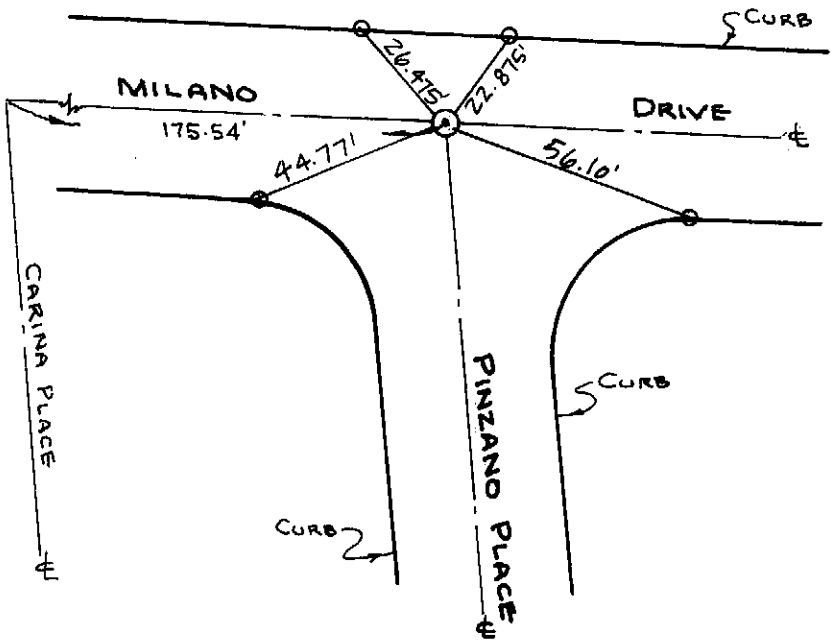

city of rancho cucamonga — STREET TIE	TRACT NO. 13445
MORSE CONSULTING GROUP — PLANNING • ENGINEERING • SURVEYING — 4960 IRVINE BOULEVARD, SUITE #201, IRVINE, CALIFORNIA 92720-1999, (714) 730-7117 • FAX (714) 730-7260	MILANO DRIVE ℄ PINZANO PLACE
L.S. Gary W. Dokich	FIELD REVIEW _____ DATE _____
L.S. # 4693 DATE _____	TIE BOOK 15 PAGE 122

○ = SET LEAD AND BRASS TACK IN TOP OF CURB

△ = INDICATES SET 8" SPIKE AND WASHER TAGGED "LS 4693", FLUSH

⊙ = INDICATES SET 4 PUNCHMARKS IN MANHOLE RIM WITH CROSS TIES

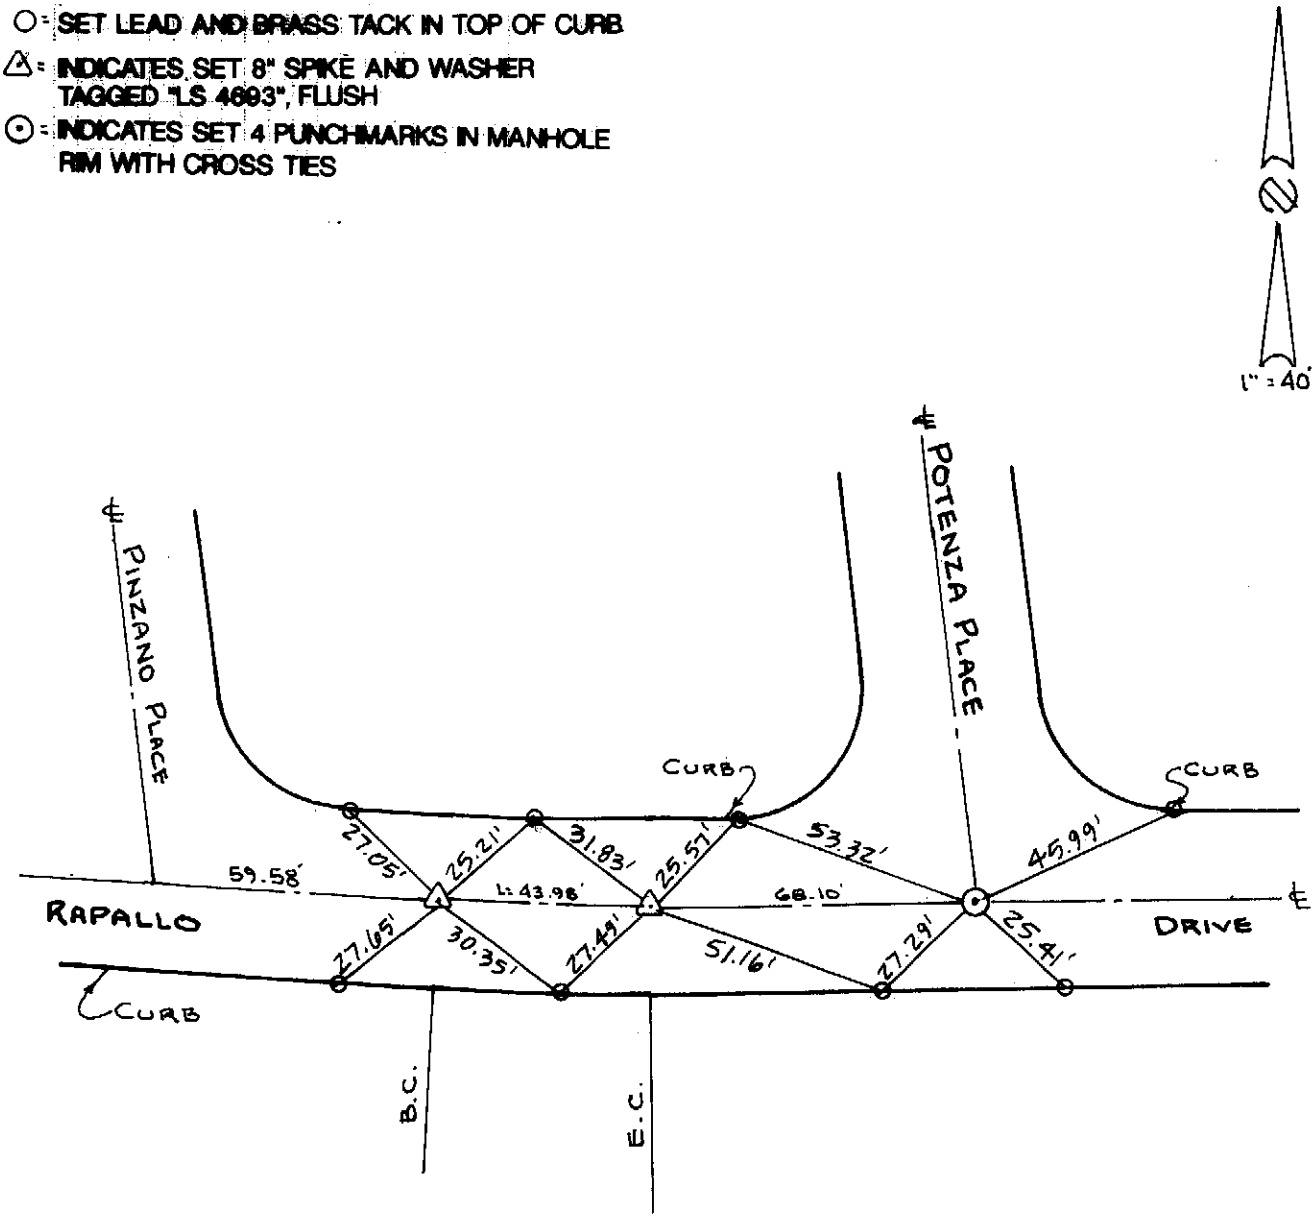

city of rancho cucamonga — STREET TIE	TRACT NO. 13445
MORSE CONSULTING GROUP — PLANNING • ENGINEERING • SURVEYING — 4990 IRVINE BOULEVARD, SUITE #201, IRVINE, CALIFORNIA 92720-1999, (714) 730-7117 • FAX (714) 730-7260	RAPALLO DRIVE ℄ POTENZA PLACE
L.S. Gary W. Dokich	FIELD REVIEW _____ DATE _____
L.S. # 4693 DATE _____	TIE BOOK 15 PAGE 123

○ = SET LEAD AND BRASS TACK IN TOP OF CURB

⊙ = INDICATES SET 4 PUNCHMARKS IN MANHOLE RIM WITH CROSS TIES

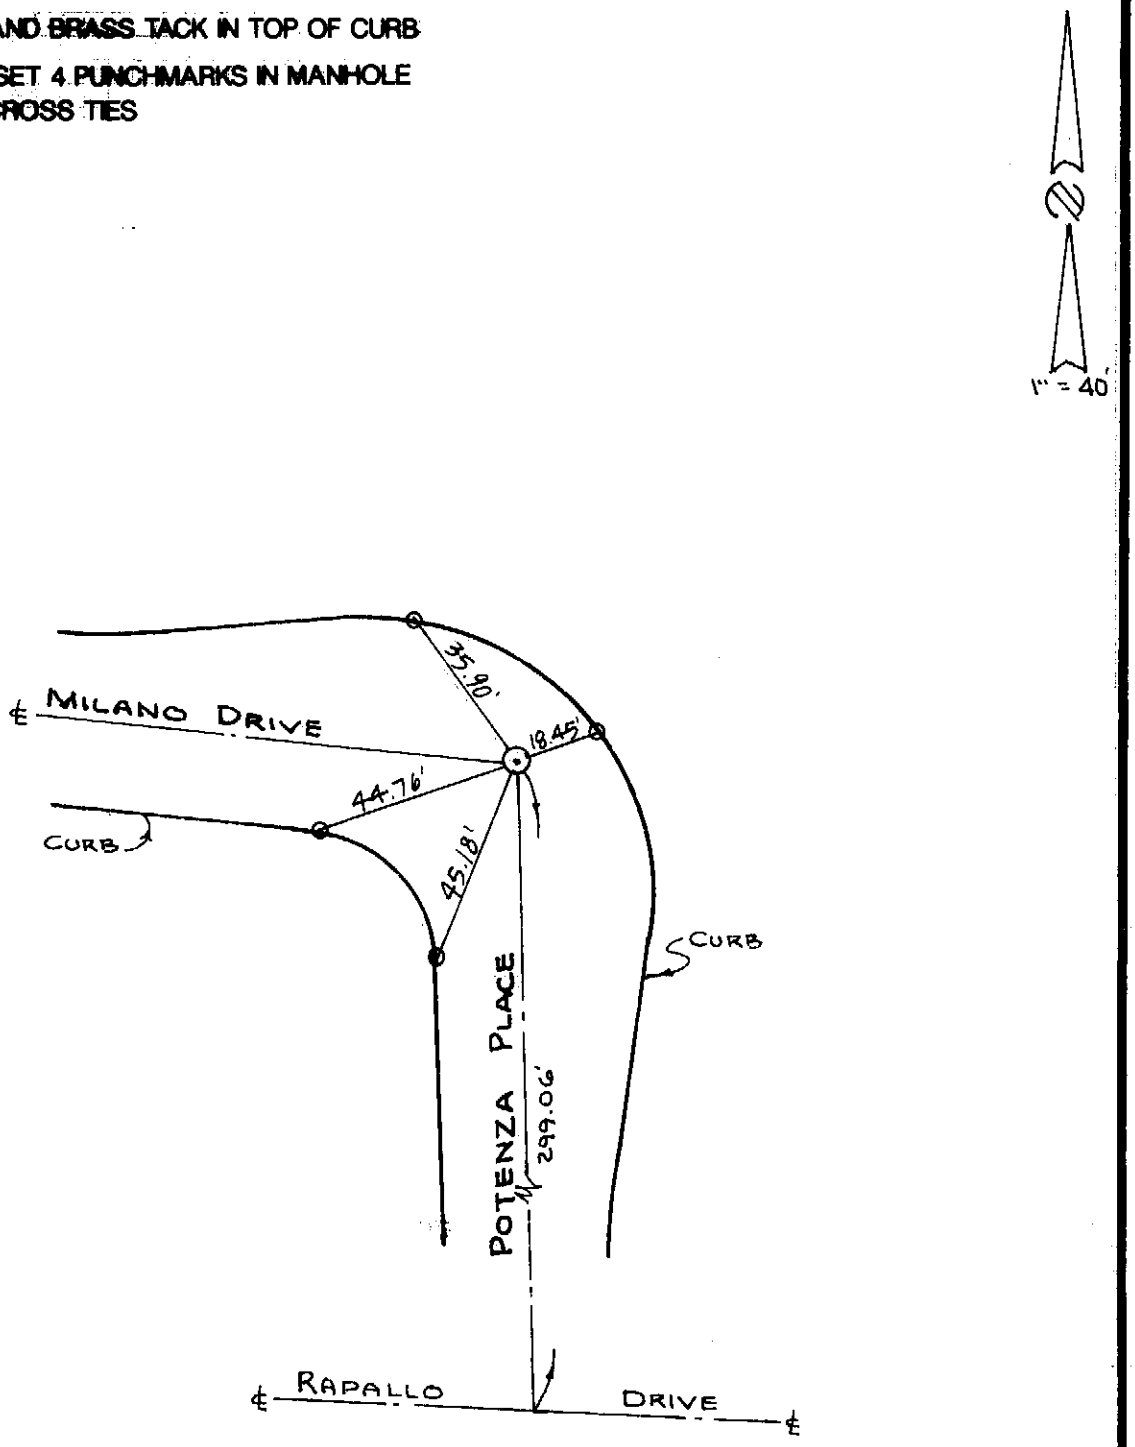

city of rancho cucamonga — STREET TIE	TRACT NO. 13445
MORSE CONSULTING GROUP — PLANNING • ENGINEERING • SURVEYING 4000 IRVINE BOULEVARD, SUITE #201 IRVINE, CALIFORNIA 92720-1999 (714) 730-7117 • FAX (714) 730-7260	POTENZA PLACE ℄ MILANO DRIVE
L.S. Gary W. Dokich	FIELD REVIEW _____ DATE _____
L.S. # 4693 DATE _____	TIE BOOK 15 PAGE 124

○: SET LEAD AND BRASS TACK IN TOP OF CURB

△: INDICATES SET 8" SPIKE AND WASHER TAGGED "LS 4693", FLUSH

⊙: INDICATES SET 4 PUNCHMARKS IN MANHOLE RIM WITH CROSS TIES

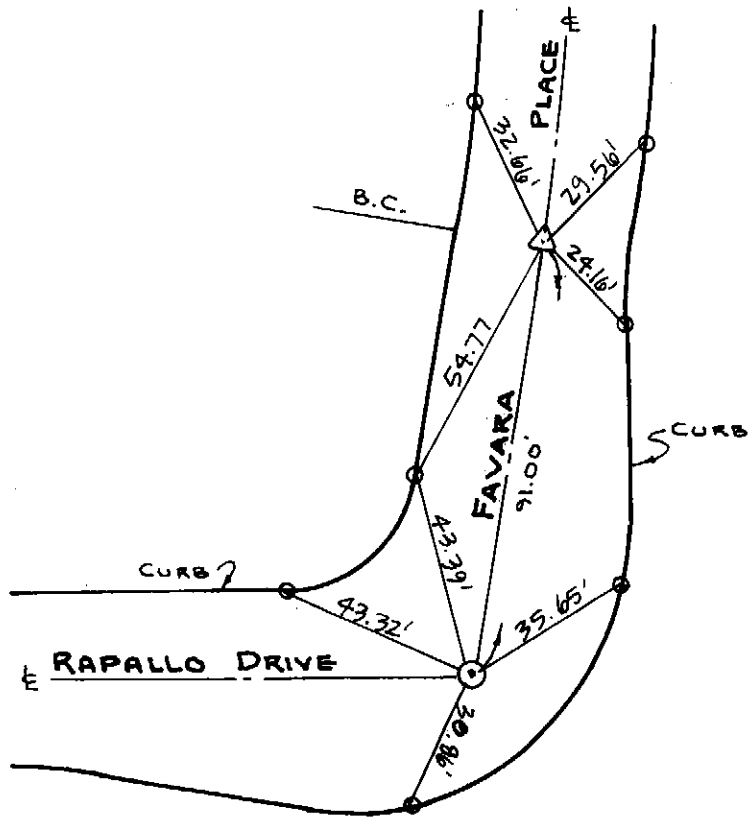

1" = 40'

city of rancho cucamonga — STREET TIE	TRACT NO. 13445
MORSE CONSULTING GROUP — PLANNING • ENGINEERING • SURVEYING 4990 IRVINE BOULEVARD, SUITE #201 IRVINE, CALIFORNIA 92720-1999 (714) 730-7117 • FAX (714) 730-7260	RAPALLO DRIVE & FAVARA PLACE
L.S. Gary W. Dokich	FIELD REVIEW _____ DATE _____
L.S. # 4693 DATE _____	TIE BOOK 15 PAGE 125

○ = SET LEAD AND BRASS TACK IN TOP OF CURB

△ = INDICATES SET 8" SPIKE AND WASHER TAGGED "LS 4693", FLUSH

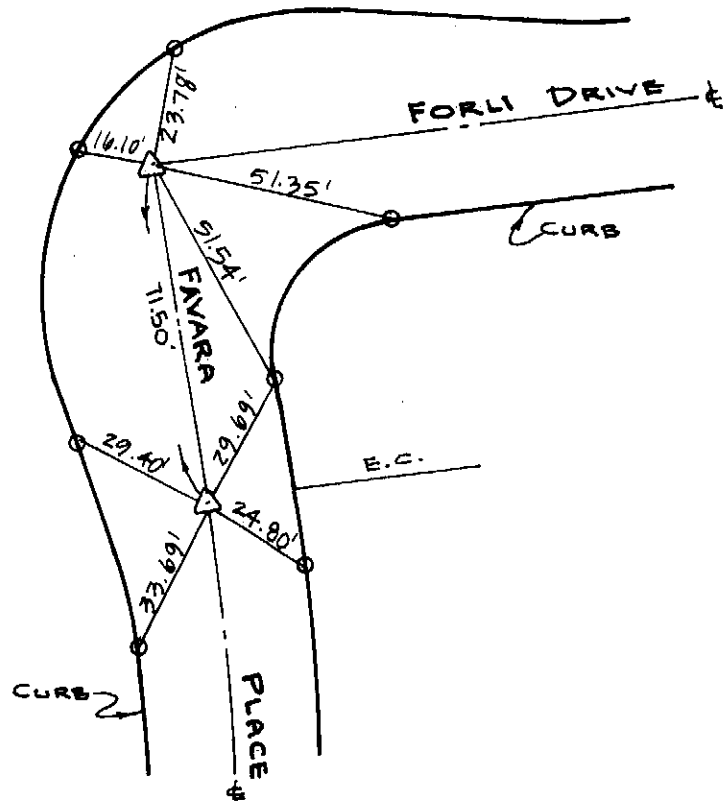

city of rancho cucamonga — STREET TIE	TRACT NO. 13445
MORSE CONSULTING GROUP — PLANNING • ENGINEERING • SURVEYING 4980 IRVINE BOULEVARD, SUITE #201 IRVINE, CALIFORNIA 92720-1999 (714) 730-7117 • FAX (714) 730-7260	FAVARA PLACE ℄ FORLI DRIVE
L.S. Gary W. Dokich	FIELD REVIEW _____ DATE _____
L.S. # 4693 DATE _____	TIE BOOK 15 PAGE 126

O = SET LEAD AND BRASS TACK IN TOP OF CURB

△ = INDICATES SET 8" SPIKE AND WASHER TAGGED "LS 4693", FLUSH

⊙ = INDICATES SET 4 PUNCHMARKS IN MANHOLE RIM WITH CROSS TIES

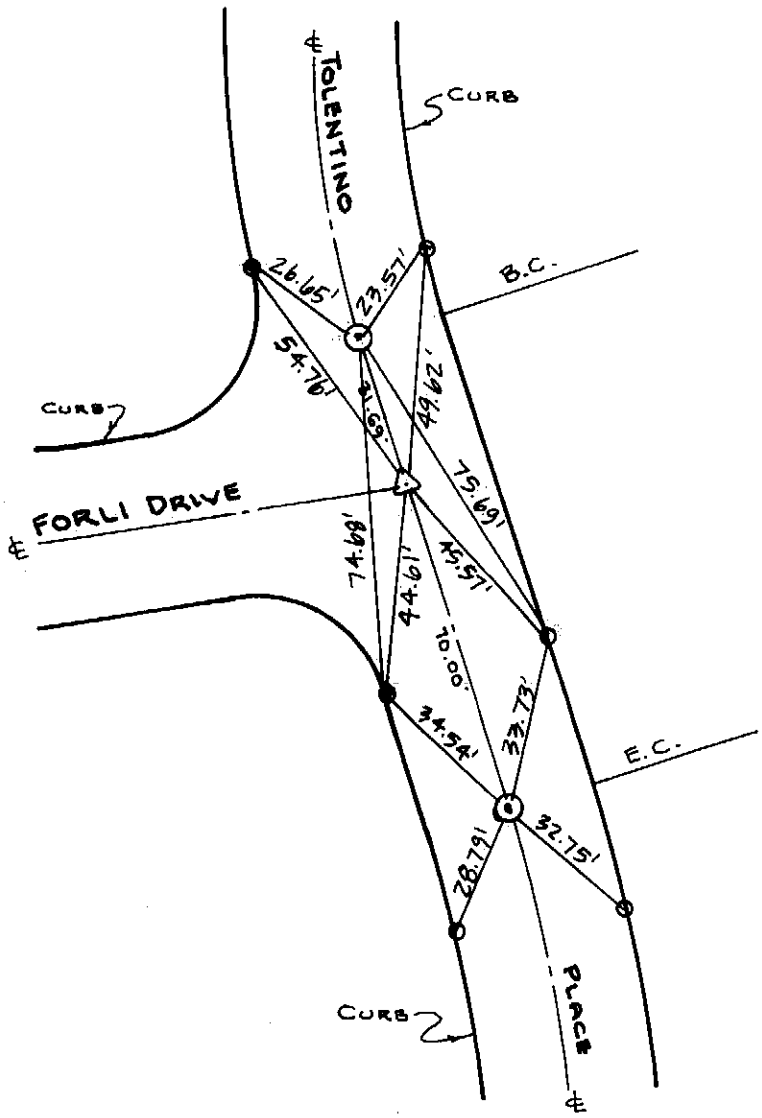

1" = 40'

city of rancho cucamonga — STREET TIE	TRACT NO. 13445
MORSE CONSULTING GROUP — PLANNING • ENGINEERING • SURVEYING 4980 IRVINE BOULEVARD, SUITE #201 IRVINE, CALIFORNIA 92720-1999 (714) 730-7117 • FAX (714) 730-7260	TOLENTINO ℄ PLACE FORLI DRIVE
L.S. Gary W. Dokich	FIELD REVIEW _____ DATE _____
L.S. # 4693 DATE _____	TIE BOOK 15 PAGE 127

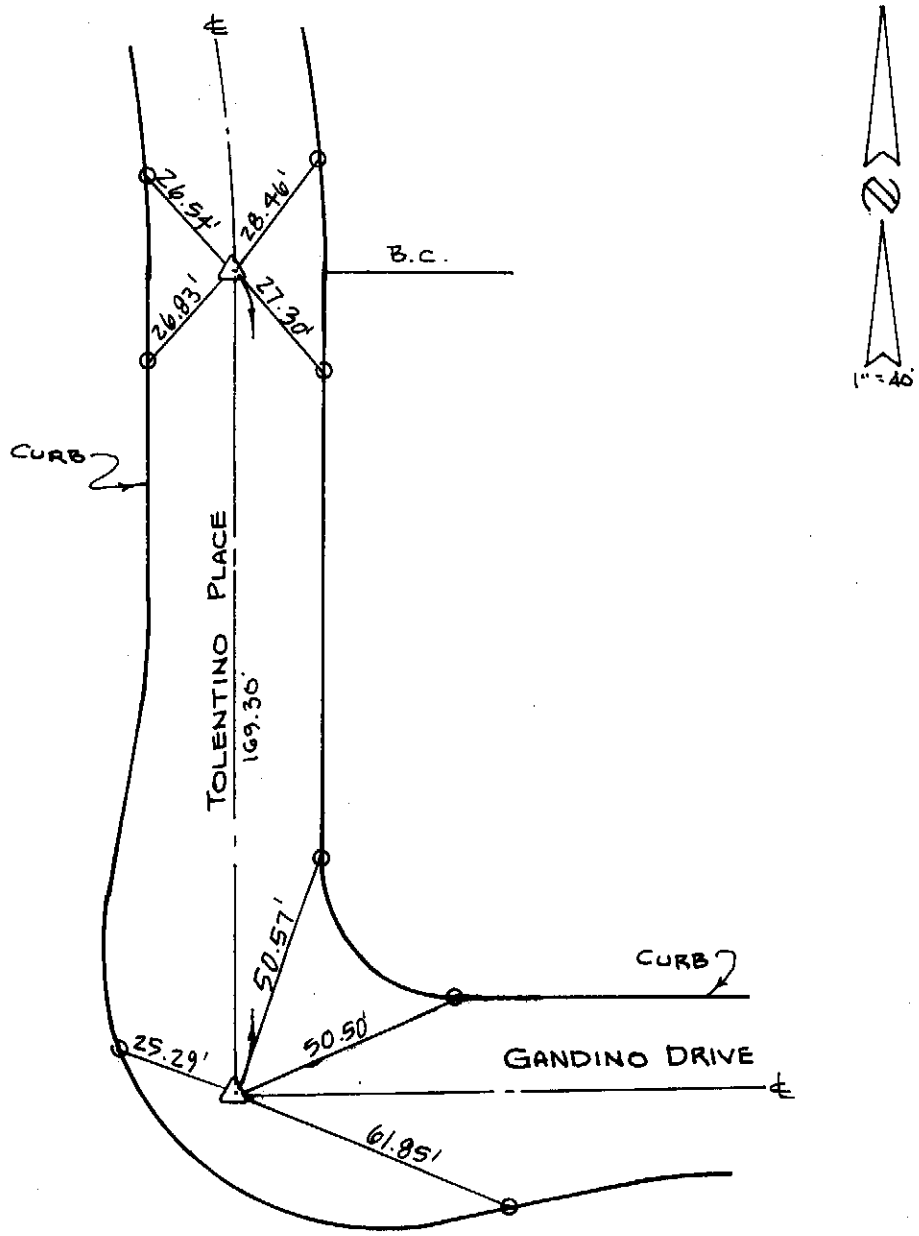

O= SET LEAD AND BRASS TACK IN TOP OF CURB

△= [redacted] SET 8" SPIKE AND WASHER TAGGED "LS 4693", FLUSH

city of rancho cucamonga — STREET TIE	TRACT NO. 13445
MORSE CONSULTING GROUP PLANNING • ENGINEERING • SURVEYING 4000 IRVINE BOULEVARD, SUITE #201 IRVINE, CALIFORNIA 92720-1999 (714) 730-7117 • FAX (714) 730-7260	TOLENTINO PLACE ℄ GANDINO DRIVE
L.S. Gary W. Dokich	FIELD REVIEW _____ DATE _____
L.S. # 4693 DATE _____	TIE BOOK 15 PAGE 128

○= SET LEAD AND BRASS TACK IN TOP OF CURB

⊙= INDICATES SET 4 PUNCHMARKS IN MANHOLE RIM WITH CROSS TIES

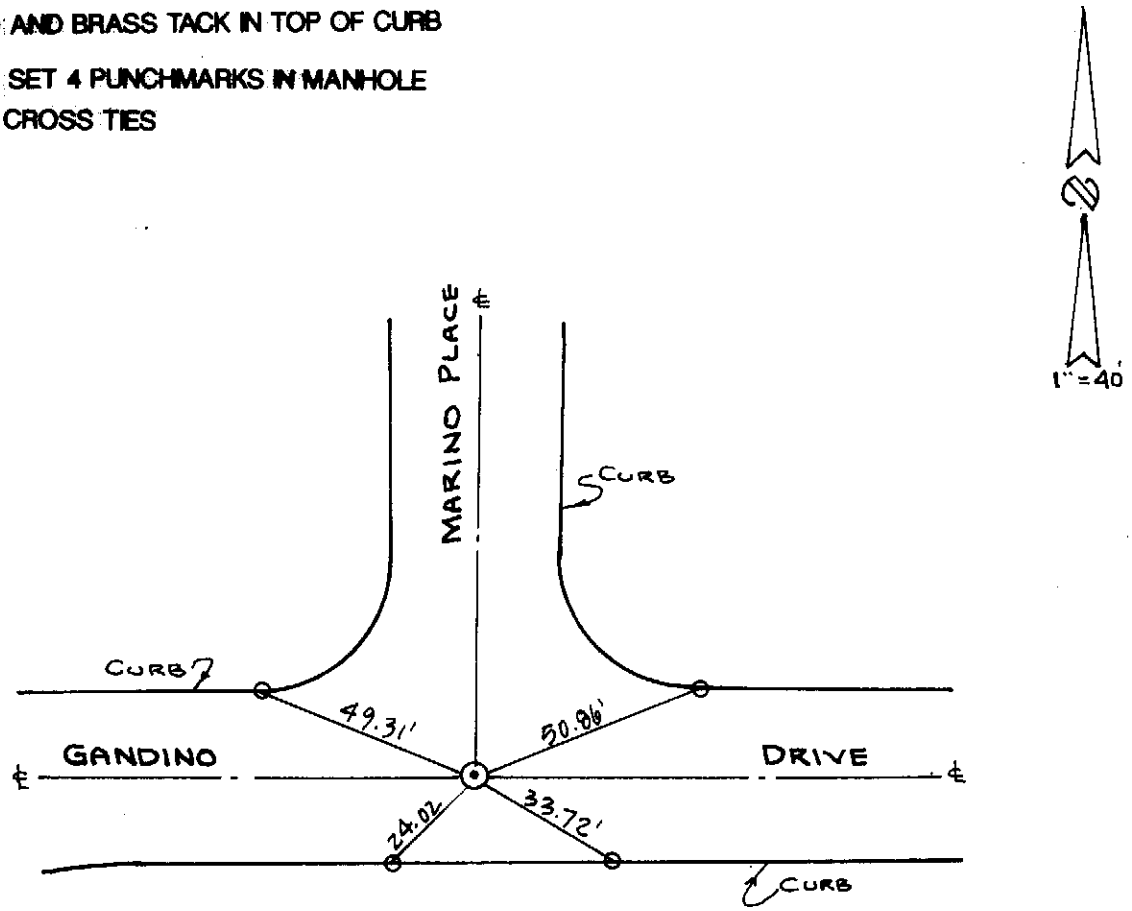

city of rancho cucamonga — STREET TIE	TRACT NO. 13445
MORSE CONSULTING GROUP — PLANNING • ENGINEERING • SURVEYING 4980 IRVINE BOULEVARD, SUITE #201 IRVINE, CALIFORNIA 92720-1999 (714) 730-7117 • FAX (714) 730-7290	GANDINO DRIVE ℄ MARINO PLACE
L.S. Gary W. Dokich	FIELD REVIEW _____ DATE _____
L.S. # 4693 DATE _____	TIE BOOK 15 PAGE 129

○ = SET LEAD AND BRASS TACK IN TOP OF CURB

△ = INDICATES SET 8" SPIKE AND WASHER TAGGED "LS 4693", FLUSH

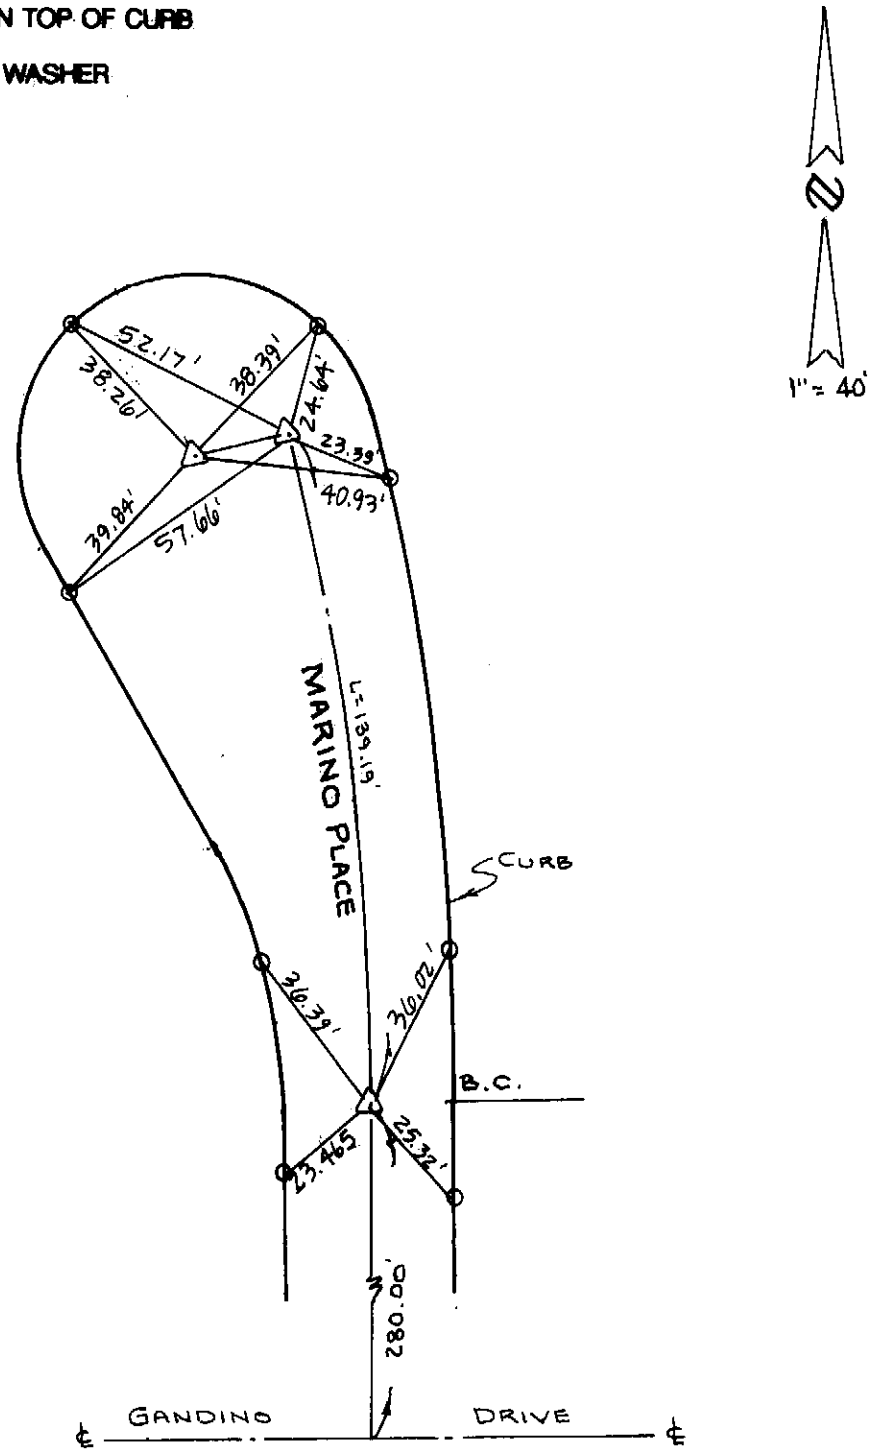

city of rancho cucamonga — STREET TIE	TRACT NO. 13445
MORSE CONSULTING GROUP — PLANNING • ENGINEERING • SURVEYING 4000 IRVINE BOULEVARD, SUITE #201 IRVINE, CALIFORNIA 92720-1999 (714) 730-7117 • FAX (714) 730-7280	MARINO PLACE
L.S. Gary W. Dokich	FIELD REVIEW _____ DATE _____
L.S. # 4693 DATE _____	TIE BOOK 15 PAGE 130

○ = SET LEAD AND BRASS TACK IN TOP OF CURB

⊙ = INDICATES SET 4 PUNCHMARKS IN MANHOLE RIM WITH CROSS TIES

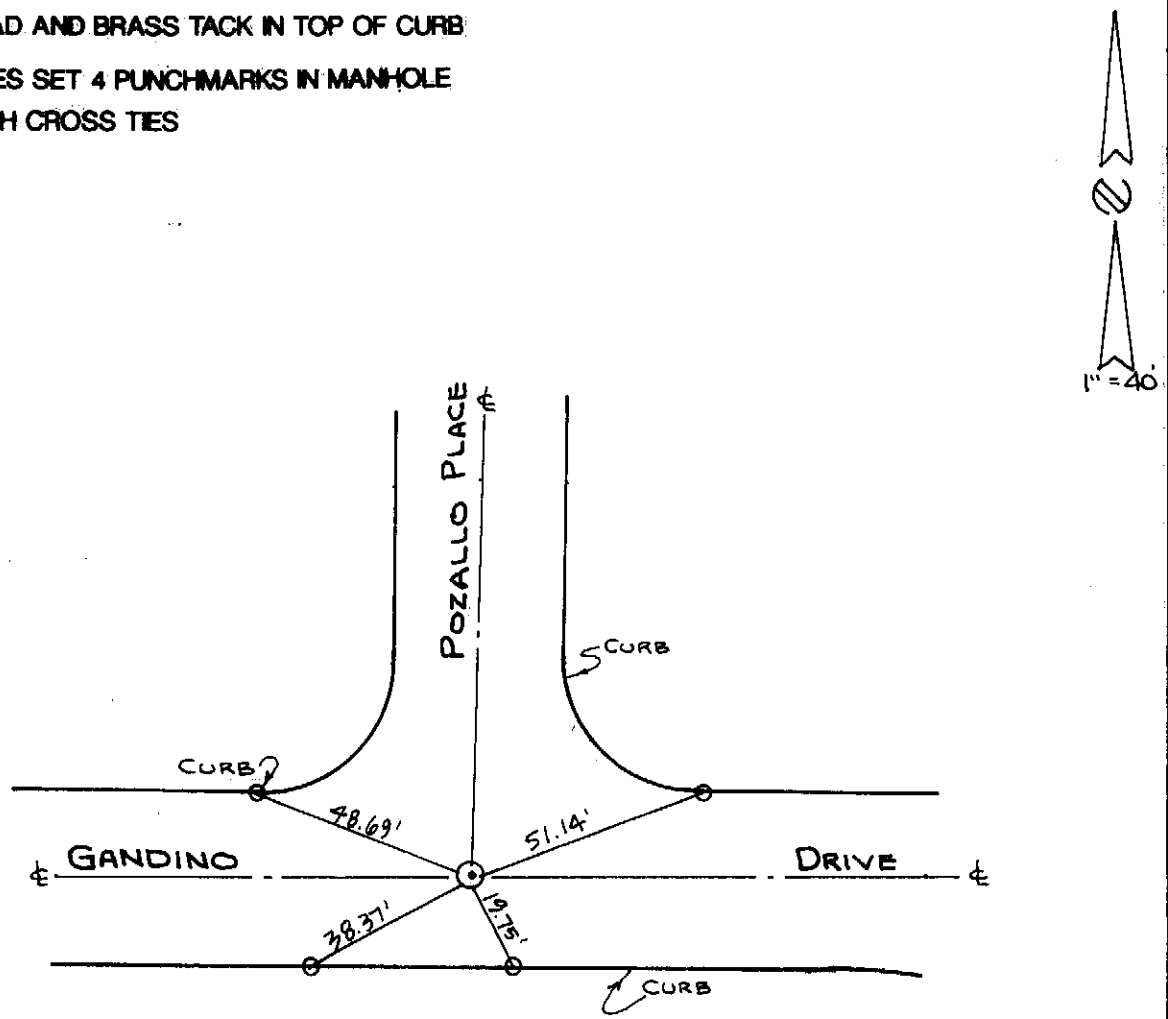

city of rancho cucamonga — STREET TIE	TRACT NO. 13445
MORSE CONSULTING GROUP — PLANNING • ENGINEERING • SURVEYING 4900 IRVINE BOULEVARD, SUITE #201 IRVINE, CALIFORNIA 92720-1999 (714) 730-7117 • FAX (714) 730-7260	GANDINO DRIVE ℄ POZALLO PLACE
L.S. Gary W. Dokich	FIELD REVIEW _____ DATE _____
L.S. # 4693 DATE _____	TIE BOOK 15 PAGE 131

○ = SET LEAD AND BRASS TACK IN TOP OF CURB

△ = INDICATES SET 8" SPIKE AND WASHER TAGGED "LS 4693", FLUSH

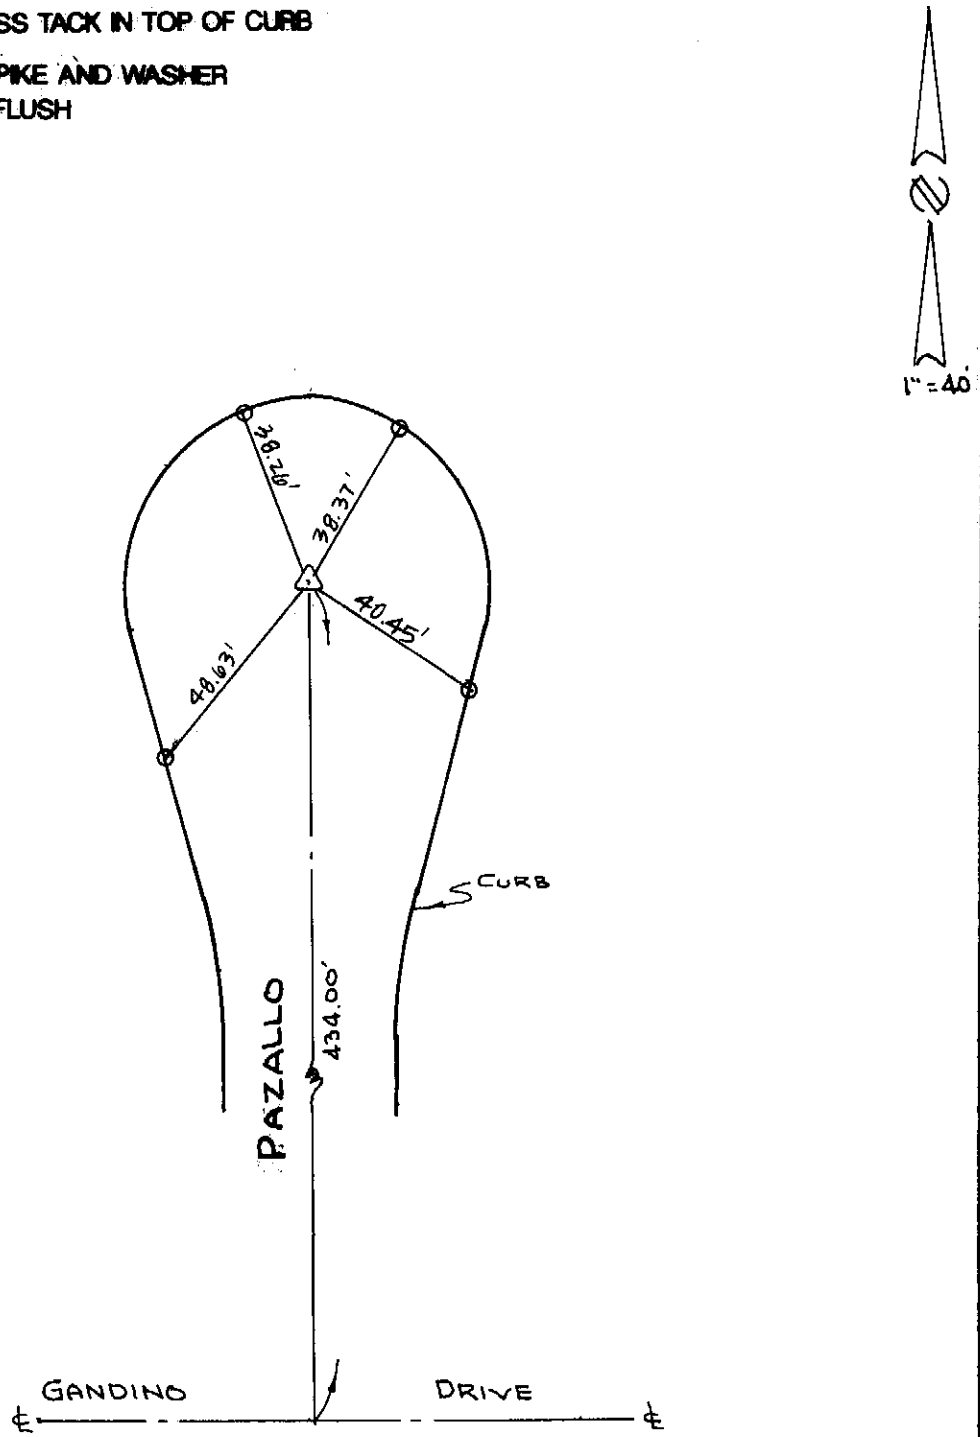

city of rancho cucamonga — STREET TIE	TRACT NO. 13445
MORSE CONSULTING GROUP — PLANNING • ENGINEERING • SURVEYING 4000 IRVINE BOULEVARD, SUITE #201 IRVINE, CALIFORNIA 92720-1999 (714) 730-7117 • FAX (714) 730-7280	PAZALLO PLACE
L.S. Gary W. Dokich	FIELD REVIEW _____ DATE _____
L.S. # 4693 DATE _____	TIE BOOK 15 PAGE 132

○ SET LEAD AND BRASS TACK IN TOP OF CURB

△ INDICATES SET 8" SPIKE AND WASHER TAGGED "LS 4693", FLUSH

⊙ INDICATES SET 4 PUNCH MARKS IN MANHOLE RIM WITH CROSS TIES

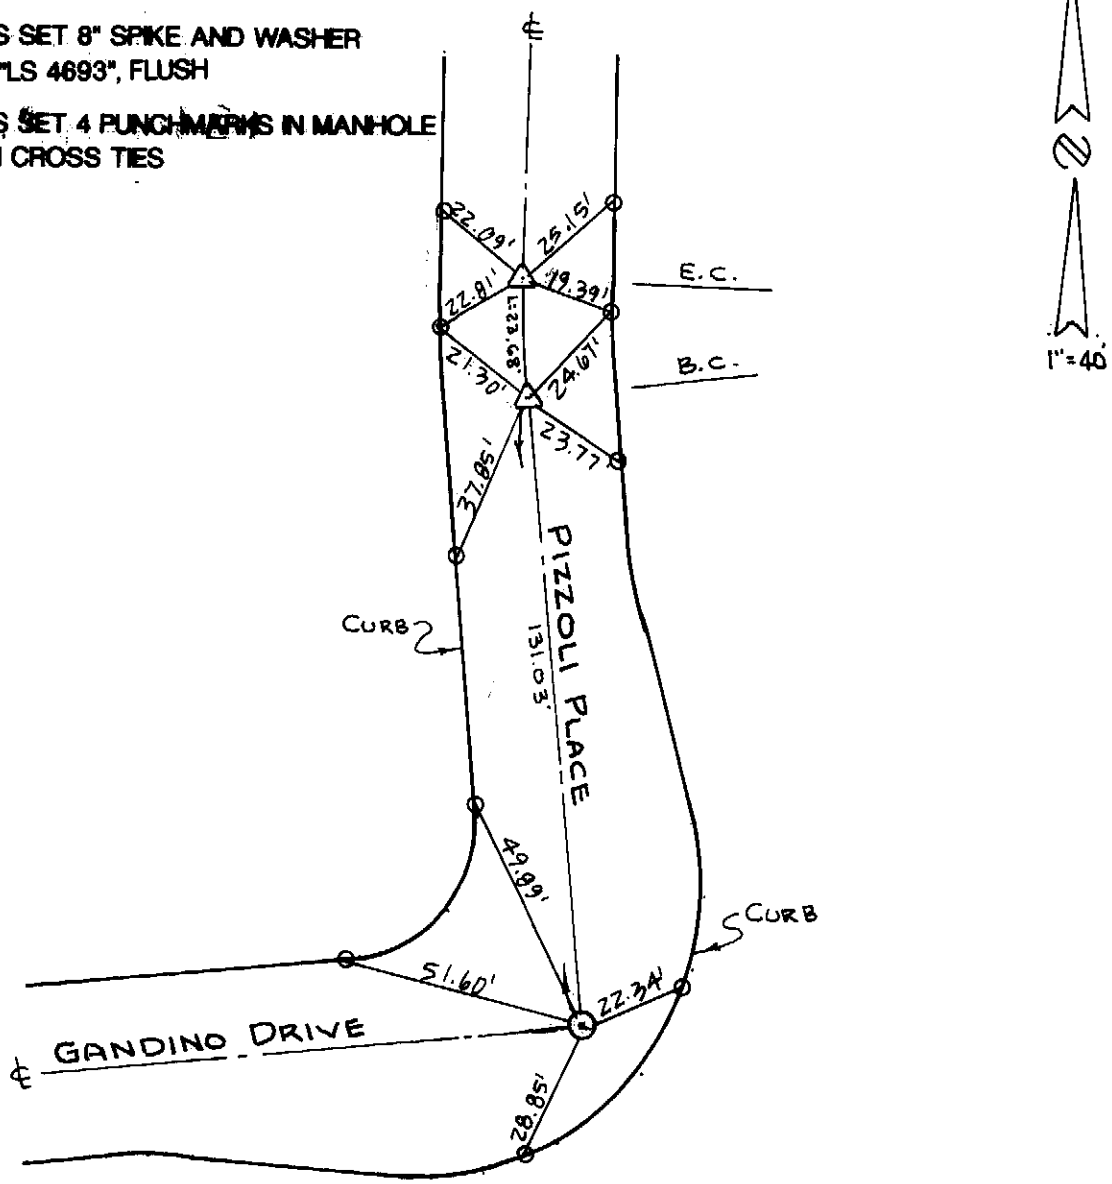

city of rancho cucamonga — STREET TIE	TRACT NO. 13445
MORSE CONSULTING GROUP — PLANNING • ENGINEERING • SURVEYING 4000 IRVINE BOULEVARD, SUITE #201 IRVINE, CALIFORNIA 92720-1999 (714) 730-7117 • FAX (714) 730-7200	GANDINO DRIVE PIZZOLI PLACE
L.S. Gary W. Dokich	FIELD REVIEW _____ DATE _____
L.S. # 4693 DATE _____	TIE BOOK 15 PAGE 133

○ = SET LEAD AND BRASS TACK IN TOP OF CURB

△ = INDICATES SET 8" SPIKE AND WASHER TAGGED "LS 4693", FLUSH

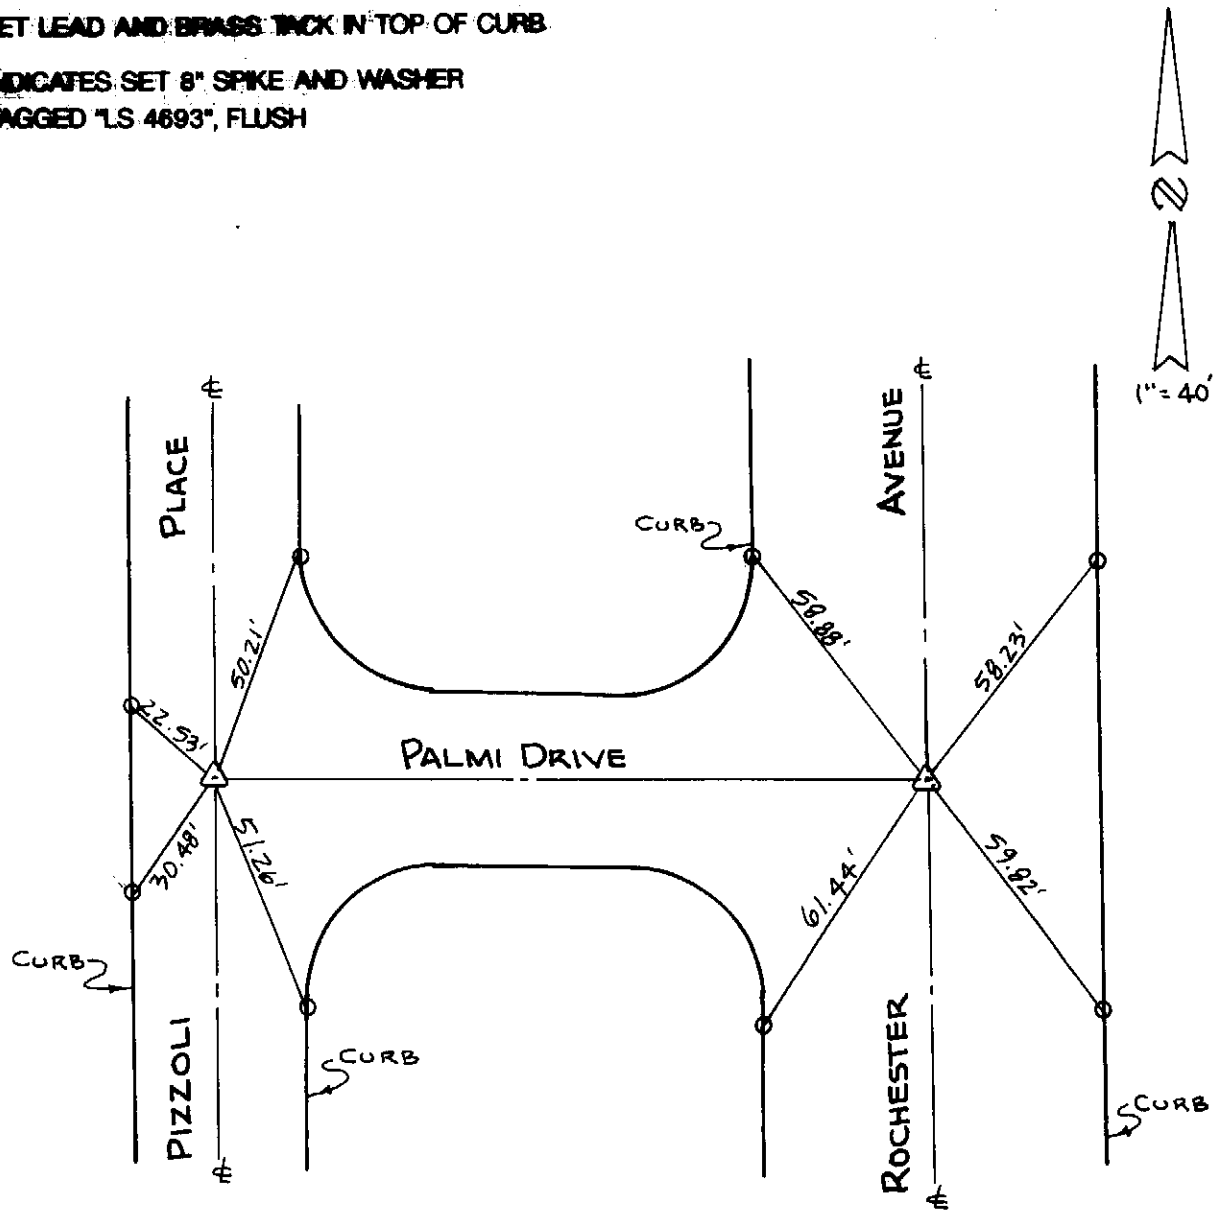

city of rancho cucamonga — STREET TIE	TRACT NO. 13445
MORSE CONSULTING GROUP — PLANNING • ENGINEERING • SURVEYING 4000 IRVINE BOULEVARD, SUITE #201 IRVINE, CALIFORNIA 92720-1999 (714) 730-7117 • FAX (714) 730-7280	PALMI DRIVE ROCHESTER AVENUE PIZZOLI PLACE
L.S. Gary W. Dokich	FIELD REVIEW _____ DATE _____
L.S. # 4693 DATE _____	TIE BOOK 15 PAGE 134

○ = SET LEAD AND BRASS TACK IN TOP OF CURB

△ = INDICATES SET 8" SPIKE AND WASHER TAGGED "LS 4693", FLUSH

⊙ = INDICATES SET 4 PUNCHMARKS IN MANHOLE RIM WITH CROSS TIES

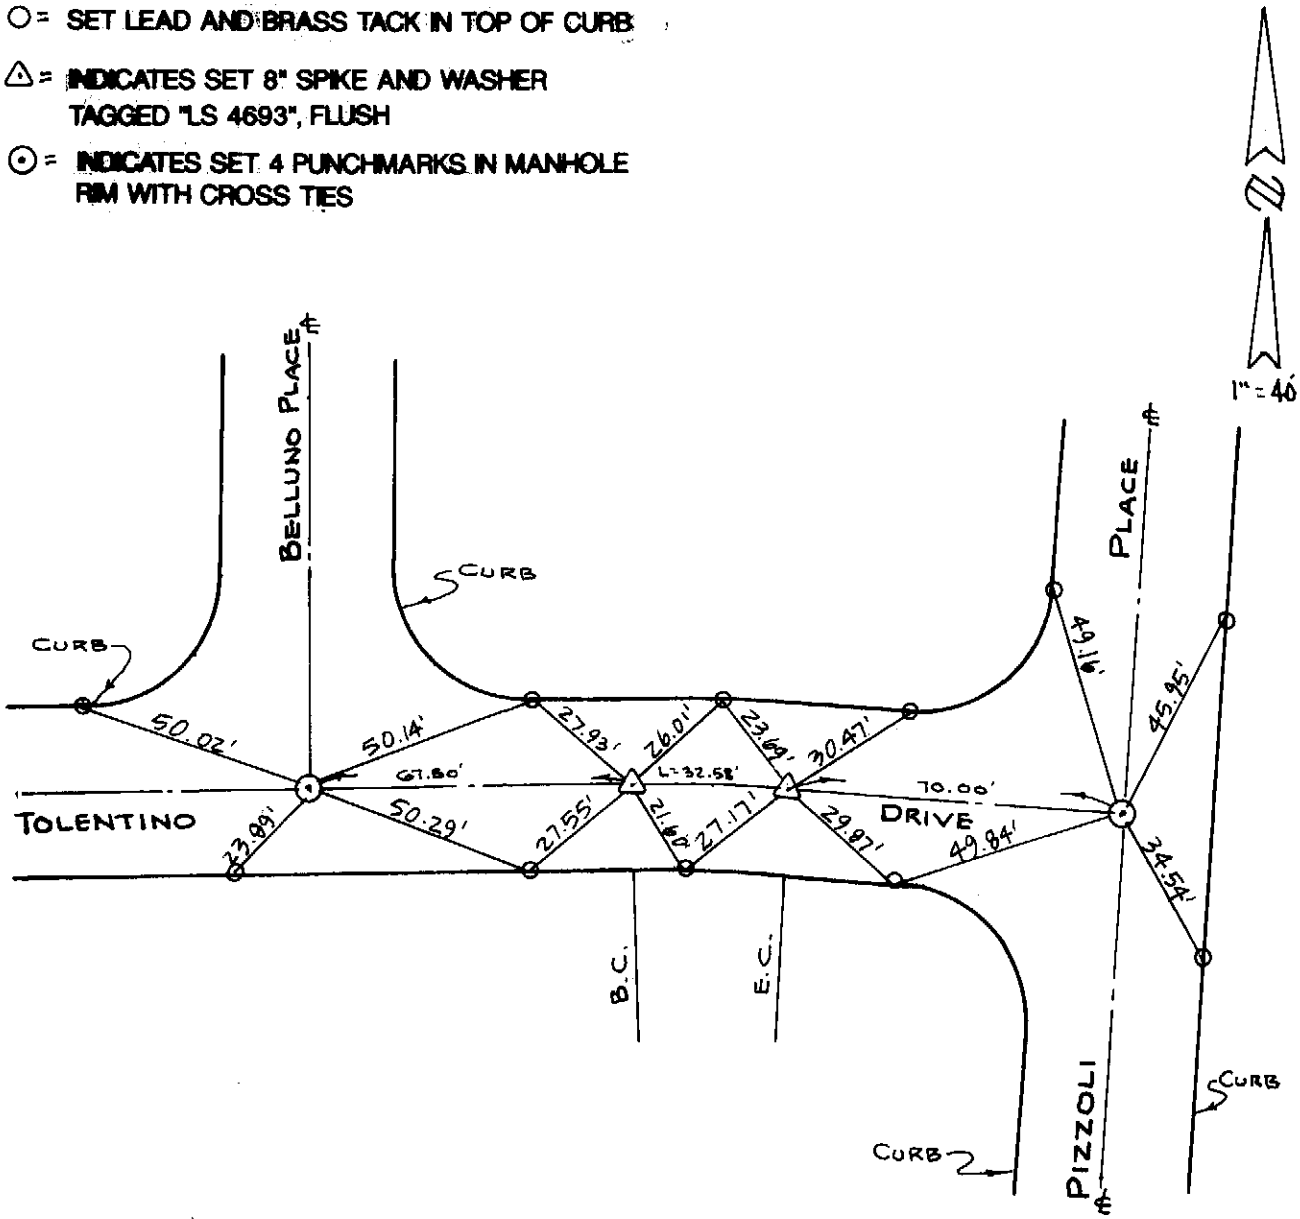

city of rancho cucamonga — STREET TIE	TRACT NO. 13445
MORSE CONSULTING GROUP — PLANNING • ENGINEERING • SURVEYING 4000 IRVINE BOULEVARD, SUITE #201 IRVINE, CALIFORNIA 92720-1999 (714) 730-7117 • FAX (714) 730-7200	TOLENTINO DRIVE PIZZOLI PLACE BELLUNO PLACE
L.S. Gary W. Dokich	FIELD REVIEW _____ DATE _____
L.S. # 4693 DATE _____	TIE BOOK 15 PAGE 135

○ = SET LEAD AND BRASS TACK IN TOP OF CURB

△ = INDICATES SET 8" SPIKE AND WASHER TAGGED "LS 4693", FLUSH

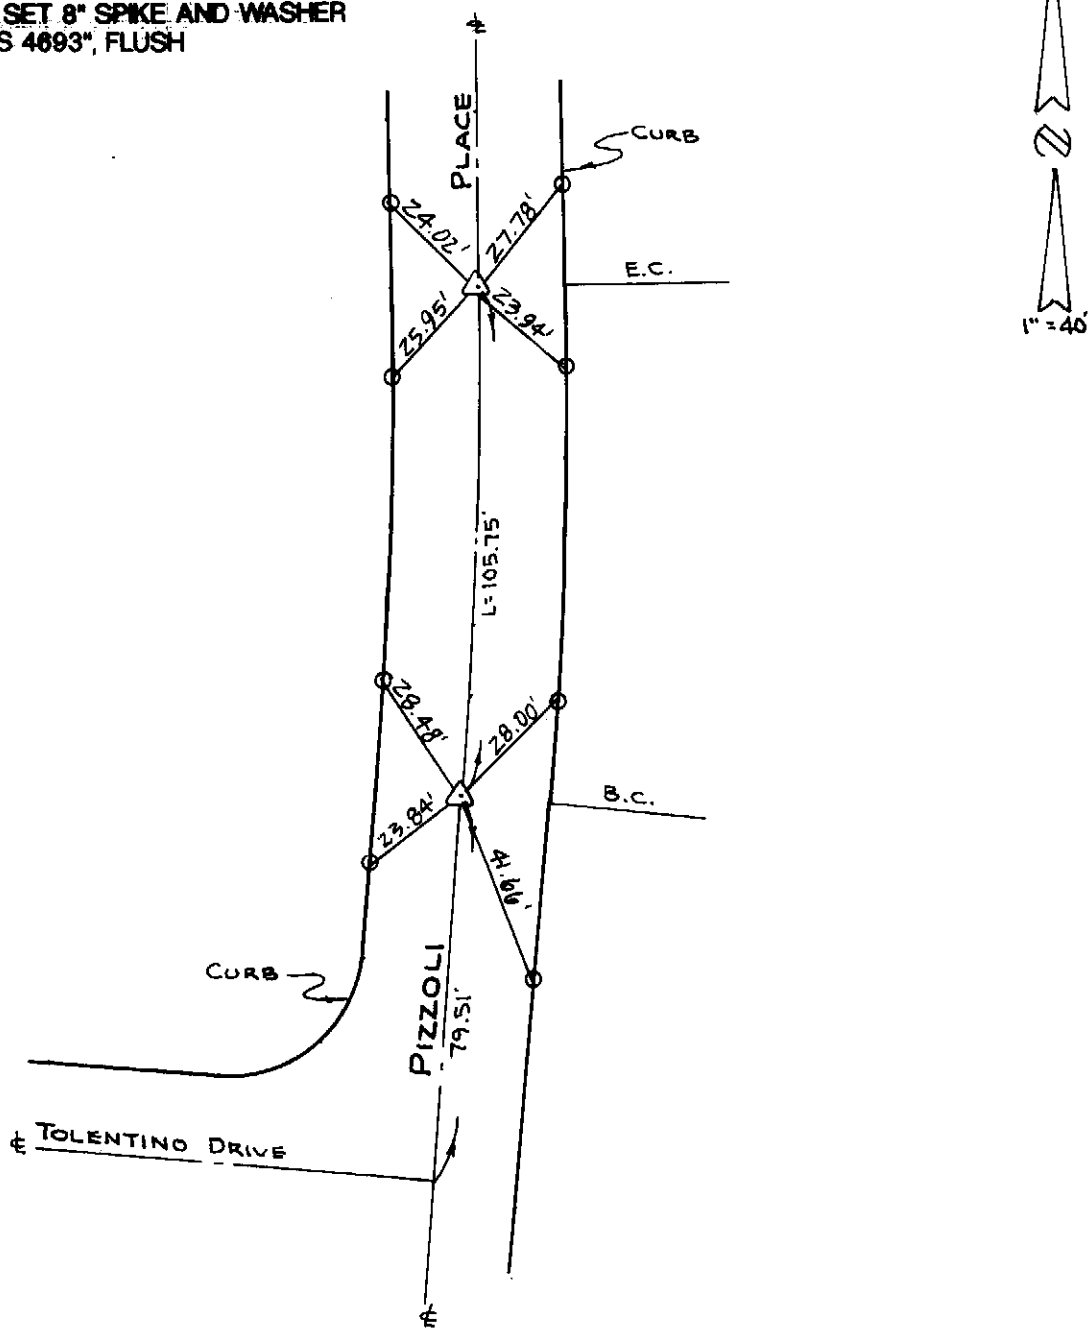

city of rancho cucamonga — STREET TIE	TRACT NO. 13445
MORSE CONSULTING GROUP — PLANNING • ENGINEERING • SURVEYING 4680 IRVINE BOULEVARD, SUITE #201 IRVINE, CALIFORNIA 92720-1999 (714) 730-7117 • FAX (714) 730-7280	PIZZOLI PLACE
L.S. Gary W. Dokich	FIELD REVIEW _____ DATE _____
L.S. # 4693 DATE _____	TIE BOOK 15 PAGE 136

○ = SET LEAD AND BRASS TACK IN TOP OF CURB

△ = INDICATES SET 8" SPIKE AND WASHER TAGGED "LS 4693", FLUSH

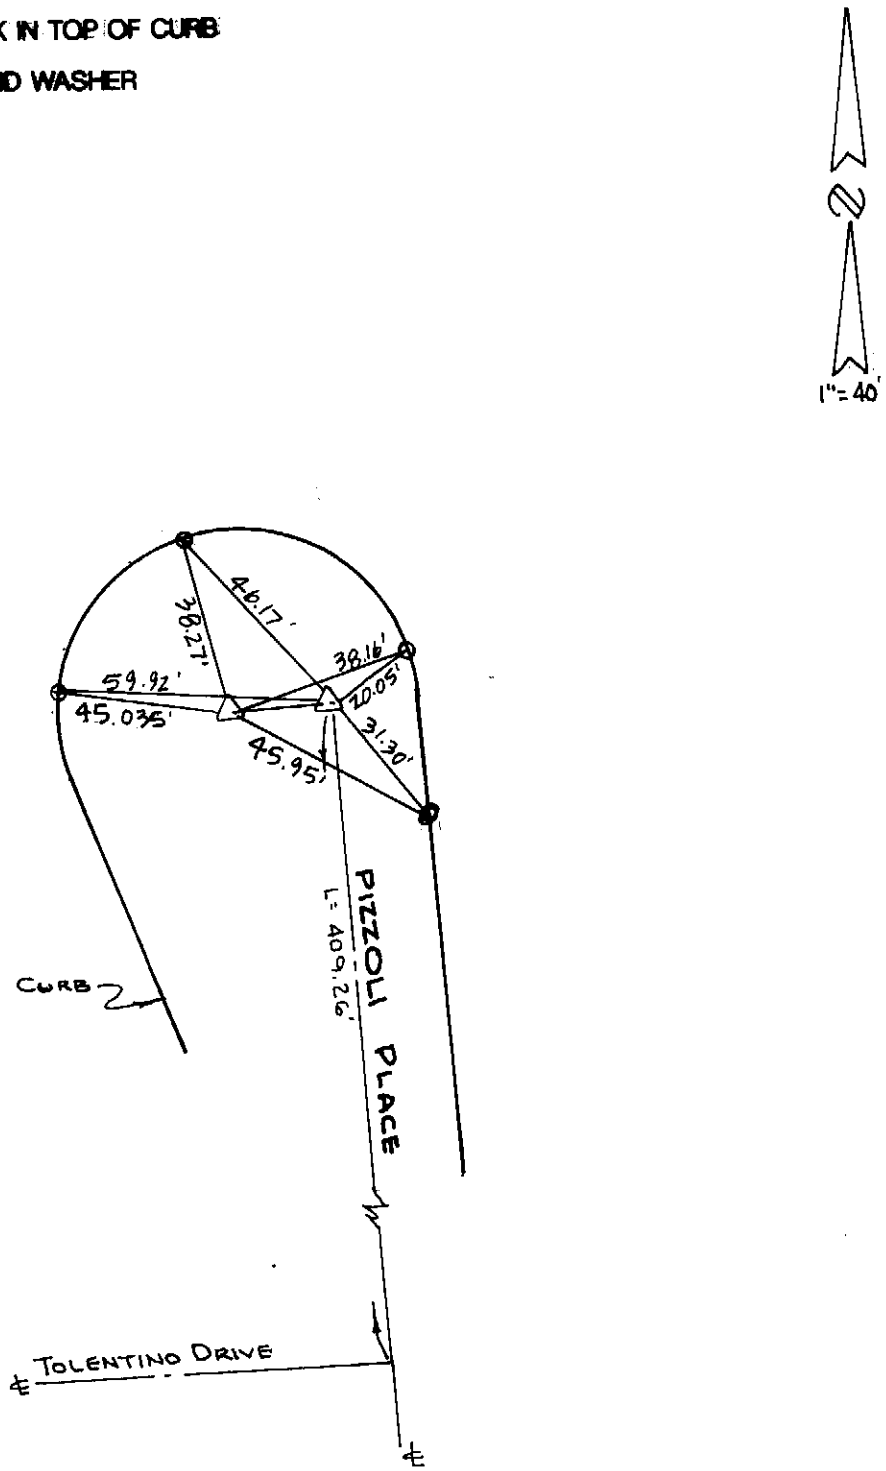

city of rancho cucamonga — STREET TIE	TRACT NO. 13445
MORSE CONSULTING GROUP — PLANNING • ENGINEERING • SURVEYING 4000 IRVINE BOULEVARD, SUITE #201 IRVINE, CALIFORNIA 92720-1990 (714) 730-7117 • FAX (714) 730-7200	PIZZOLI PLACE
L.S. Gary W. Dokich	FIELD REVIEW _____ DATE _____
L.S. # 4693 DATE _____	TIE BOOK 15 PAGE 137

⊙ = SET LEAD AND BRASS TACK IN TOP OF CURB

△ = INDICATES SET 8" SPIKE AND WASHER TAGGED "LS 4693", FLUSH

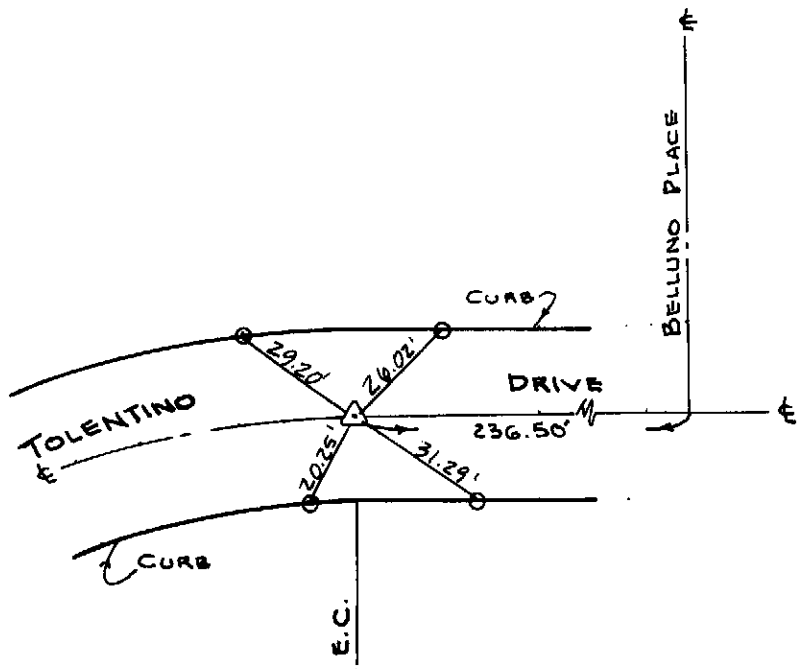

city of rancho cucamonga — STREET TIE	TRACT NO. 13445
MORSE CONSULTING GROUP — PLANNING • ENGINEERING • SURVEYING 4000 IRVINE BOULEVARD, SUITE #201 IRVINE, CALIFORNIA 92720-1999 (714) 730-7117 • FAX (714) 730-7280	TOLENTINO DRIVE
L.S. Gary W. Dokich	FIELD REVIEW _____ DATE _____
L.S. # 4693 DATE _____	TIE BOOK 15 PAGE 138

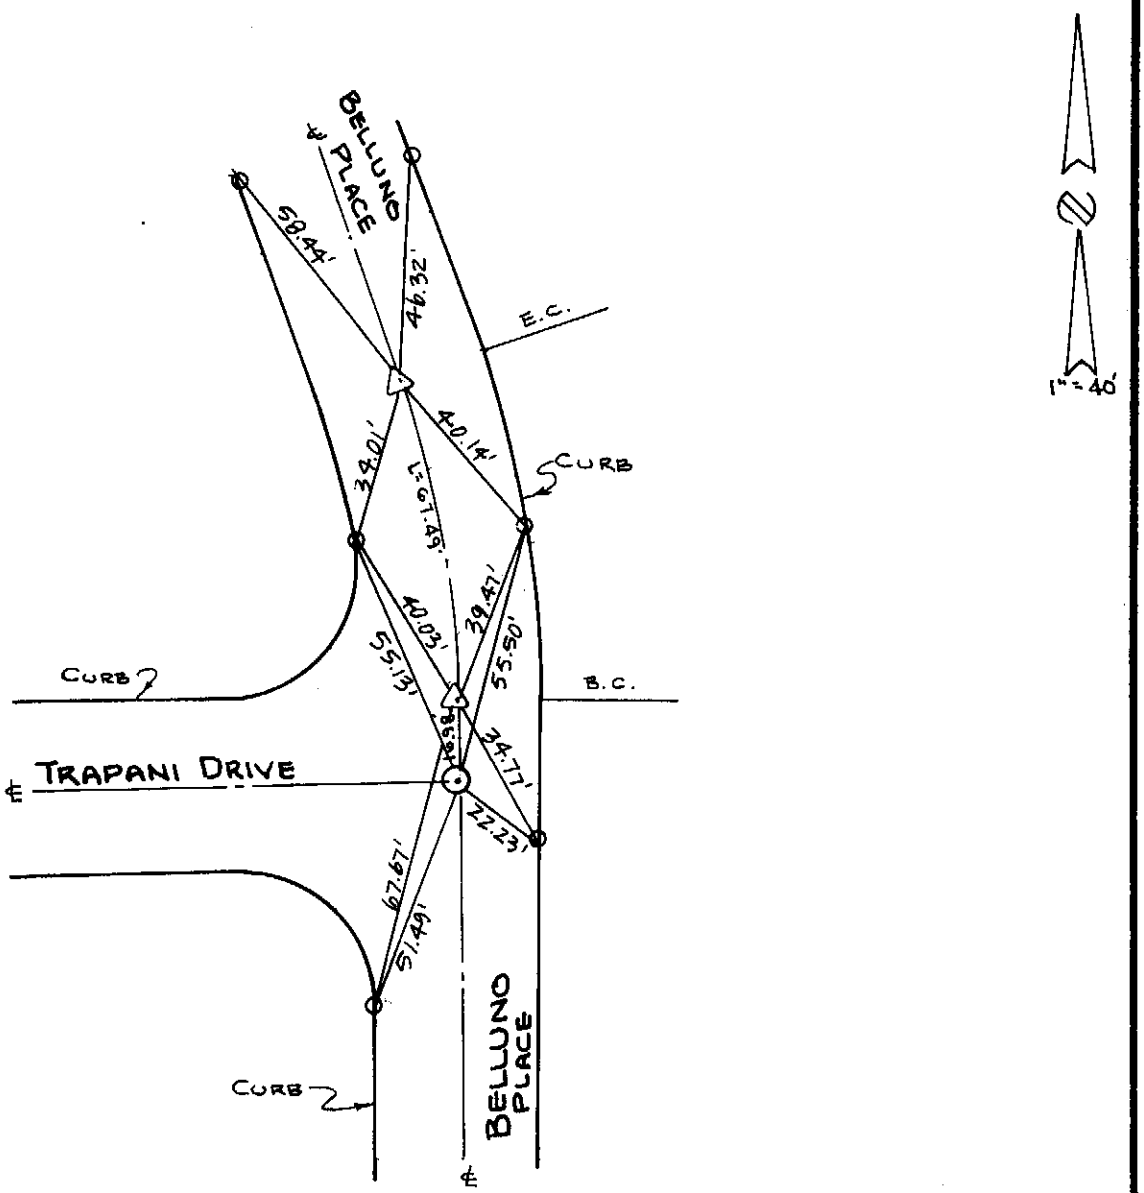

○ = SET LEAD AND BRASS TACK IN TOP OF CURB

△ = INDICATES SET 8" SPIKE AND WASHER TAGGED "LS 4693", FLUSH

⊙ = INDICATES SET 4 PUNCHMARKS IN MANHOLE RIM WITH CROSS TIES

city of rancho cucamonga — STREET TIE	TRACT NO. 13445
MORSE CONSULTING GROUP PLANNING • ENGINEERING • SURVEYING 4000 IRVINE BOULEVARD, SUITE #201 IRVINE, CALIFORNIA 92720-1999 (714) 730-7117 • FAX (714) 730-7200	BELLUNO PLACE TRAPANI DRIVE
L.S. Gary W. Dokich	FIELD REVIEW _____ DATE _____
L.S. # 4693 DATE _____	TIE BOOK 15 PAGE 139

○ = SET LEAD AND BRASS TACK IN TOP OF CURB

△ = INDICATES SET 8" SPIKE AND WASHER TAGGED "LS 4693", FLUSH

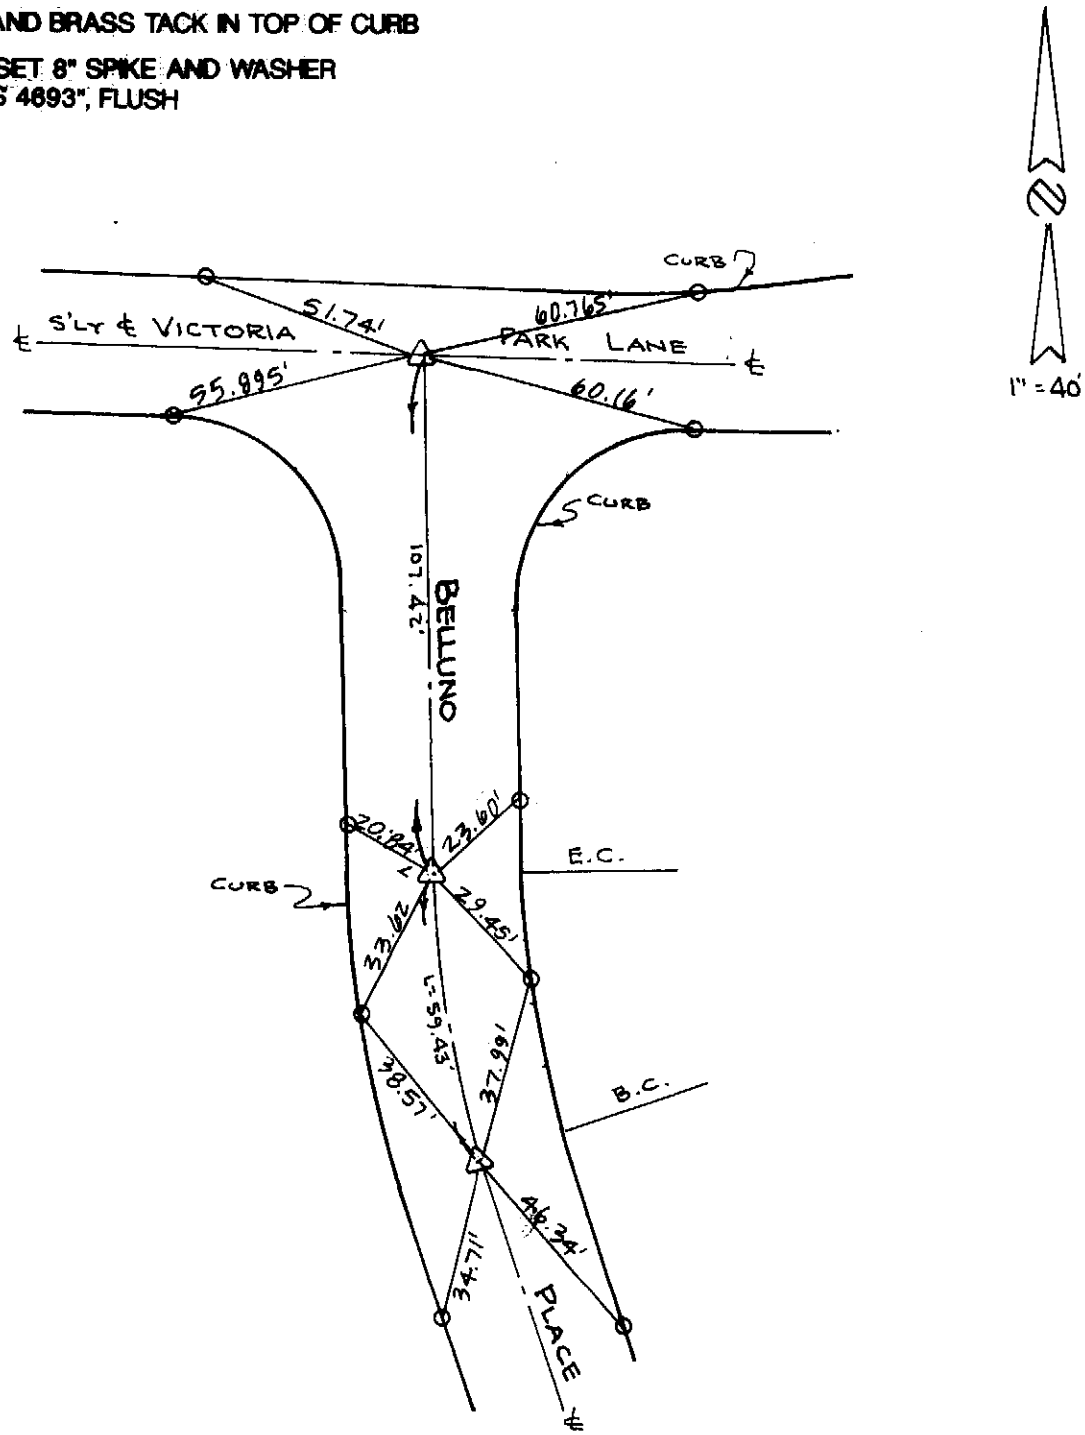

city of rancho cucamonga — STREET TIE	TRACT NO. 13445
MORSE CONSULTING GROUP — PLANNING • ENGINEERING • SURVEYING 4000 IRVINE BOULEVARD, SUITE #201 IRVINE, CALIFORNIA 92720-1999 (714) 730-7117 • FAX (714) 730-7200	BELLUNO PLACE
L.S. Gary W. Dokich	FIELD REVIEW _____ DATE _____
L.S. # 4693 DATE _____	TIE BOOK 15 PAGE 140

○ [redacted]

⊙ INDICATES SET 4 PUNCHMARKS IN MANHOLE RIM WITH CROSS TIES

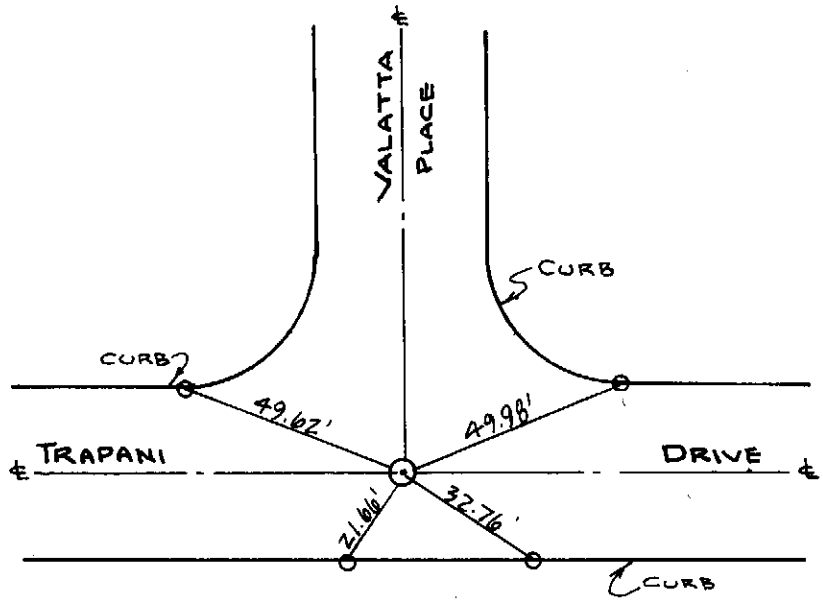

N

1" = 40'

city of rancho cucamonga — STREET TIE	TRACT NO. 13445
MORSE CONSULTING GROUP PLANNING • ENGINEERING • SURVEYING 4000 IRVINE BOULEVARD, SUITE #201 IRVINE, CALIFORNIA 92720-1999 (714) 730-7117 • FAX (714) 730-7200	TRAPANI DRIVE VALATTA PLACE
L.S. Gary W. Dokich	FIELD REVIEW _____ DATE _____
L.S. # 4693 DATE _____	TIE BOOK 15 PAGE 141

○ = SET LEAD AND BRASS TACK IN TOP OF CURB

△ = INDICATES SET 8" SPIKE AND WASHER TAGGED "LS 4693", FLUSH

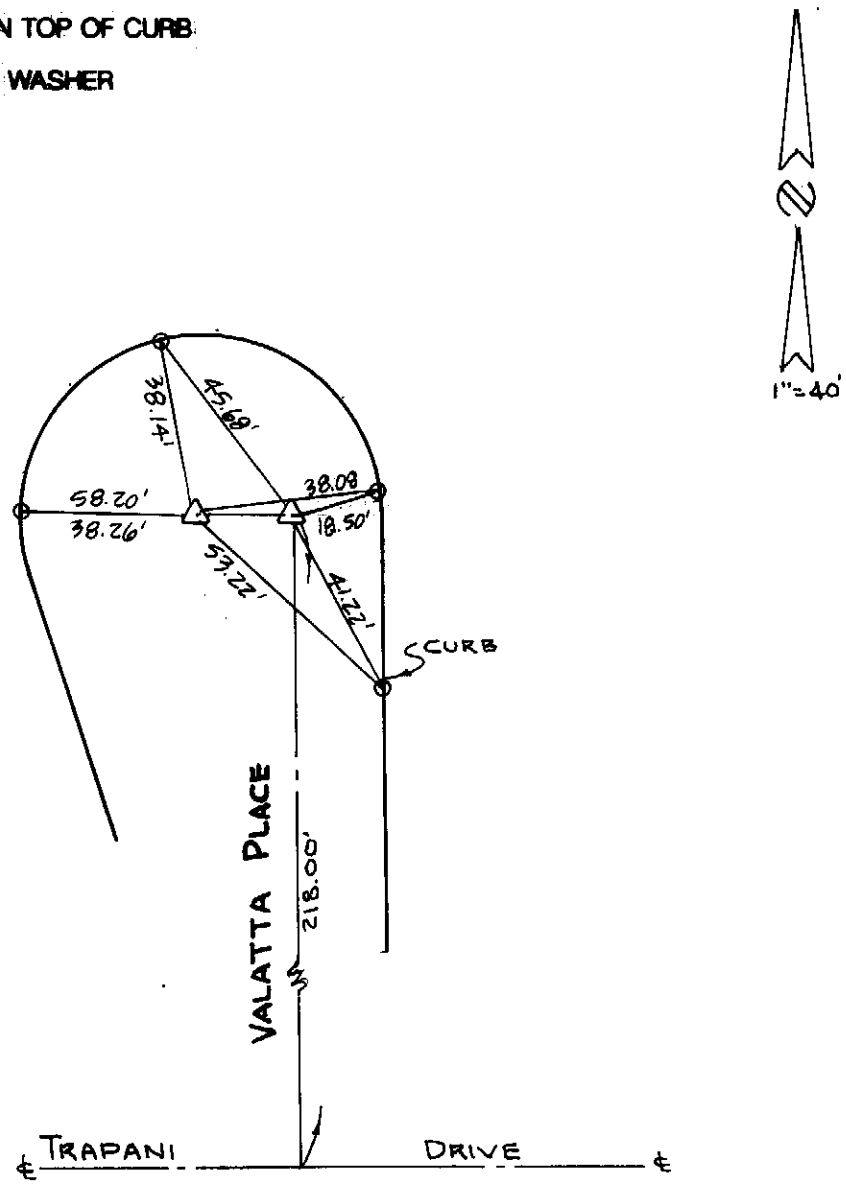

city of rancho cucamonga — STREET TIE	TRACT NO. 13445
MORSE CONSULTING GROUP — PLANNING • ENGINEERING • SURVEYING 4000 IRVINE BOULEVARD, SUITE #201 IRVINE, CALIFORNIA 92720-1999 (714) 730-7117 • FAX (714) 730-7260	VALATTA PLACE
L.S. Gary W. Dokich	FIELD REVIEW _____ DATE _____
L.S. # 4693 DATE _____	TIE BOOK 15 PAGE 142

○ = SET LEAD AND BRASS TACK IN TOP OF CURB

⊙ = INDICATES SET 4 PUNCHMARKS IN MANHOLE RIM WITH CROSS TIES

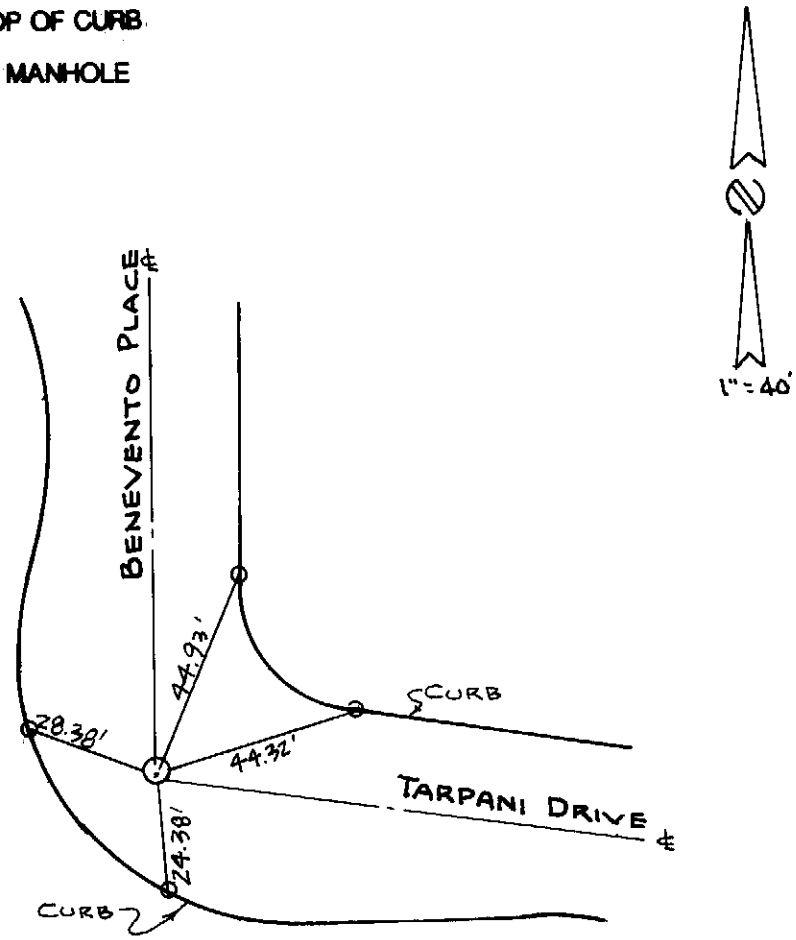

city of rancho cucamonga — STREET TIE	TRACT NO. 13445
MORSE CONSULTING GROUP PLANNING • ENGINEERING • SURVEYING 4000 IRVINE BOULEVARD, SUITE #204 IRVINE, CALIFORNIA 92720-1999 (714) 730-7117 • FAX (714) 730-7280	TARPANI DRIVE BENEVENTO PLACE
L.S. Gary W. Dokich	FIELD REVIEW _____ DATE _____
L.S. # 4693 DATE _____	TIE BOOK 15 PAGE 143

○ = SET LEAD AND BRASS TACK IN TOP OF CURB

△ = INDICATES SET 8" SPIKE AND WASHER TAGGED "LS 4693", FLUSH

1" = 40'

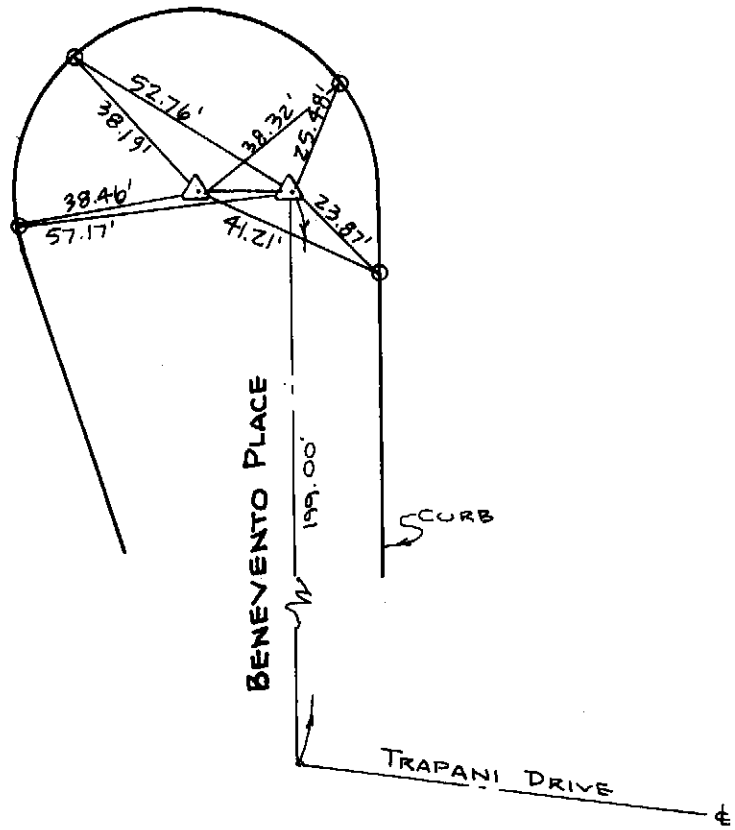

city of rancho cucamonga — STREET TIE	TRACT NO. 13445
MORSE CONSULTING GROUP — PLANNING • ENGINEERING • SURVEYING 4000 IRVINE BOULEVARD, SUITE #201 IRVINE, CALIFORNIA 92720-1999 (714) 730-7117 • FAX (714) 730-7280	BENEVENTO PLACE
L.S. Gary W. Dokich	FIELD REVIEW _____ DATE _____
L.S. # 4693 DATE _____	TIE BOOK 15 PAGE 144

℄ TIES-P.M. № 11671 SHEET 1 OF 12

WILLIAMSON AND SCHMID-CIVIL ENGINEERS

JAMES B. DUNLAP, L.S. 4189 JULY 1990

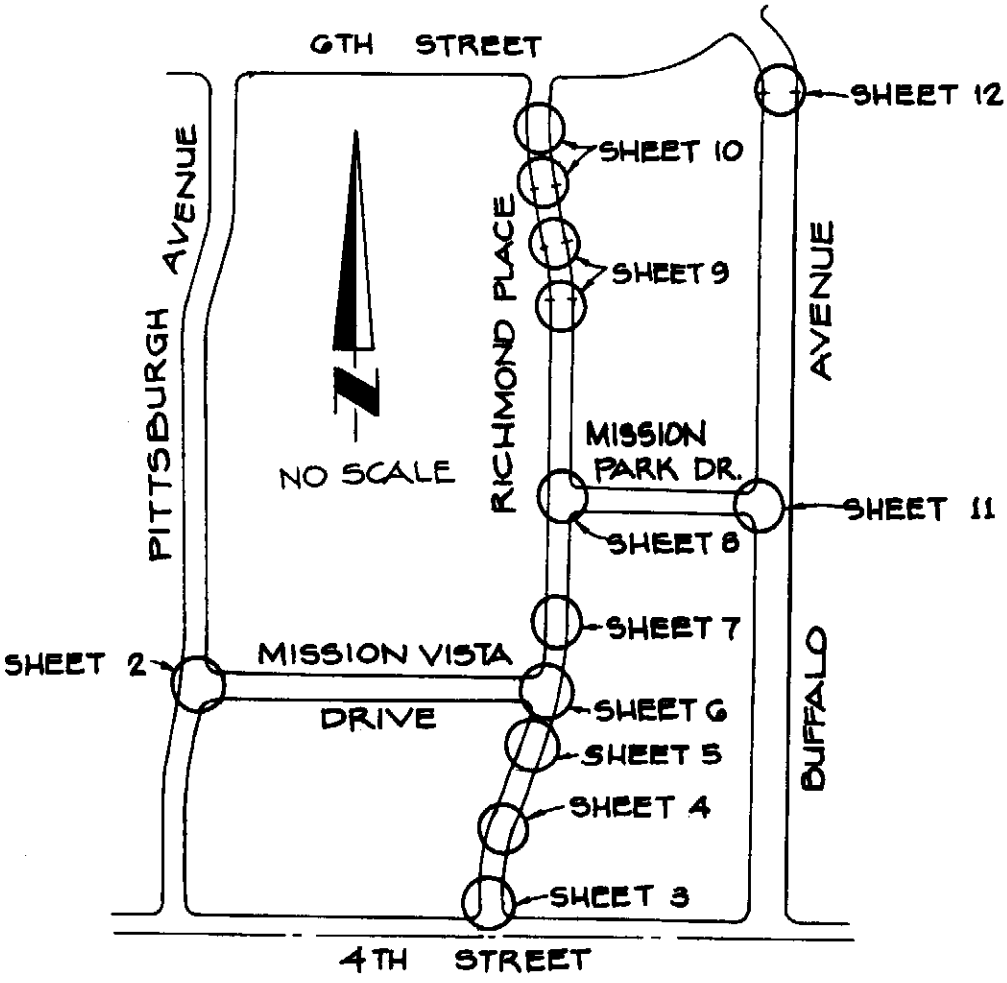

SHEET INDEX MAP

88157

℄ TIES - P.M. № 11671 SHEET 2 OF 12

WILLIAMSON AND SCHMID - CIVIL ENGINEERS

JAMES B. DUNLAP, L.S. 4189 JULY 1990

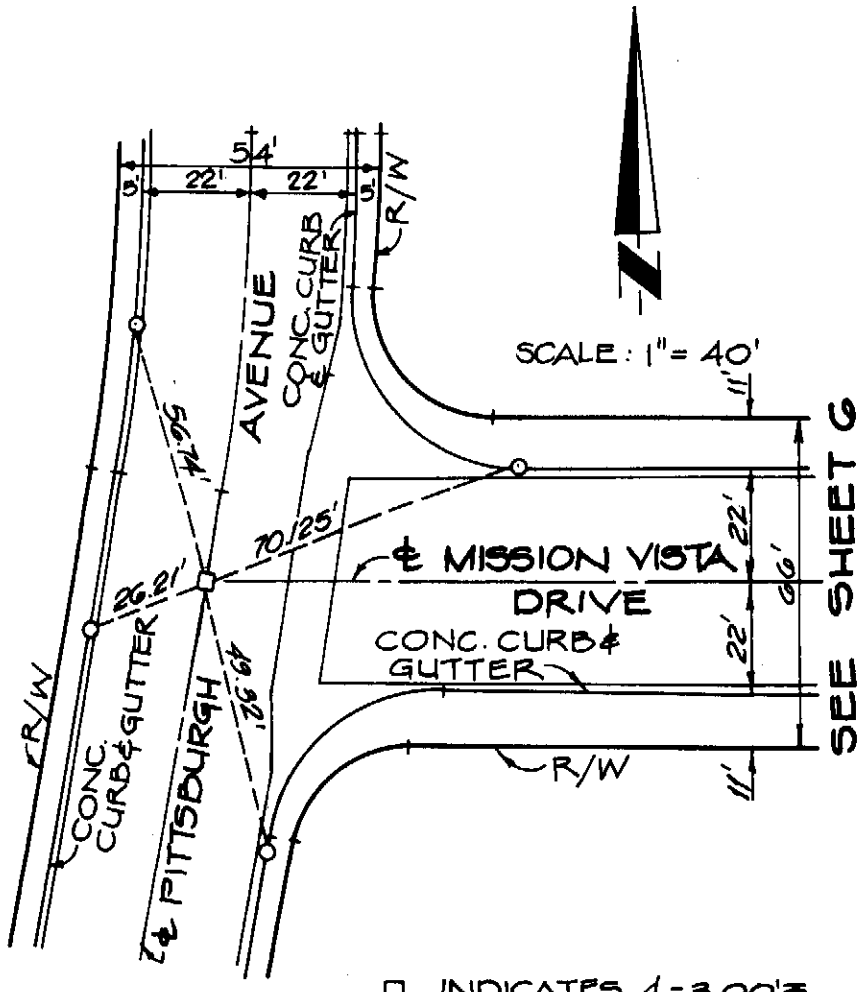

□ INDICATES 4 - 3.00'ø C-NAIL & TAG, STAMPED "L.S. 4189", TIES

○ INDICATES LEAD & BRASS NAIL IN TOP OF CURB

88157

TIE BOOK 15 PG. 145

℄ TIES-P.M. № 11671 SHEET 3 OF 12

WILLIAMSON AND SCHMID-CIVIL ENGINEERS

JAMES B. DUNLAP, L.S. 4189 JULY 1990

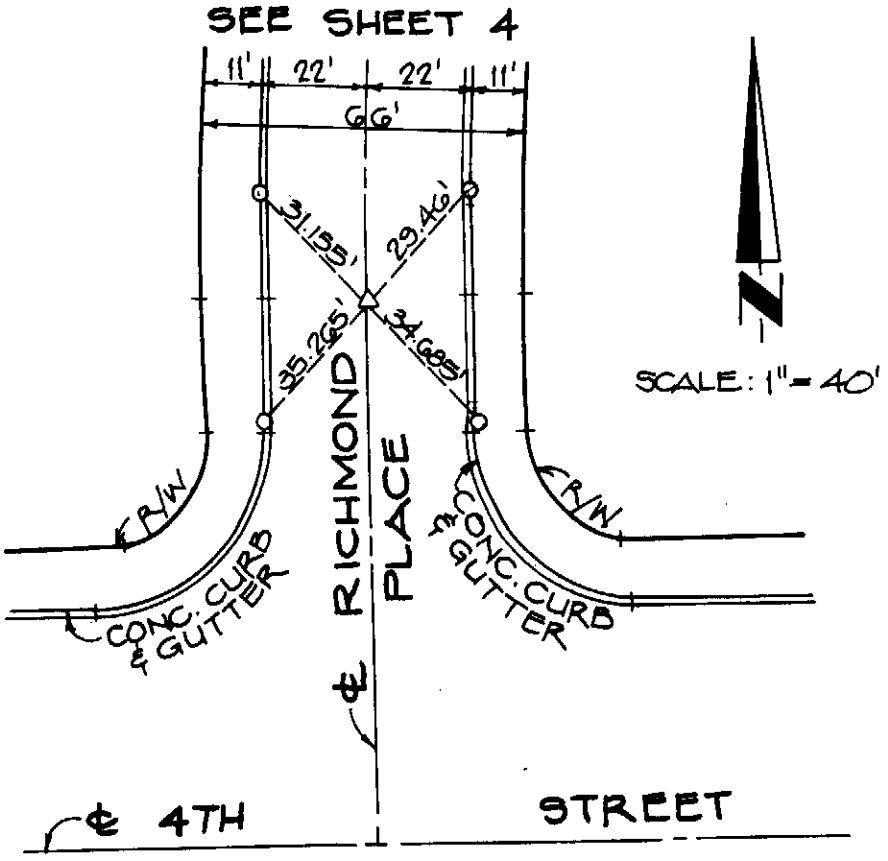

△ INDICATES SPIKE & WASHER STAMPED "L.S. 4189"

O INDICATES LEAD & BRASS NAIL IN TOP OF CURB

88157

TIE BOOK 15 PG. 146

℄ TIES-P.M. № 11671 SHEET 4 OF 12

WILLIAMSON AND SCHMID-CIVIL ENGINEERS

JAMES B. DUNLAP, L.S. 4189 JULY 1990

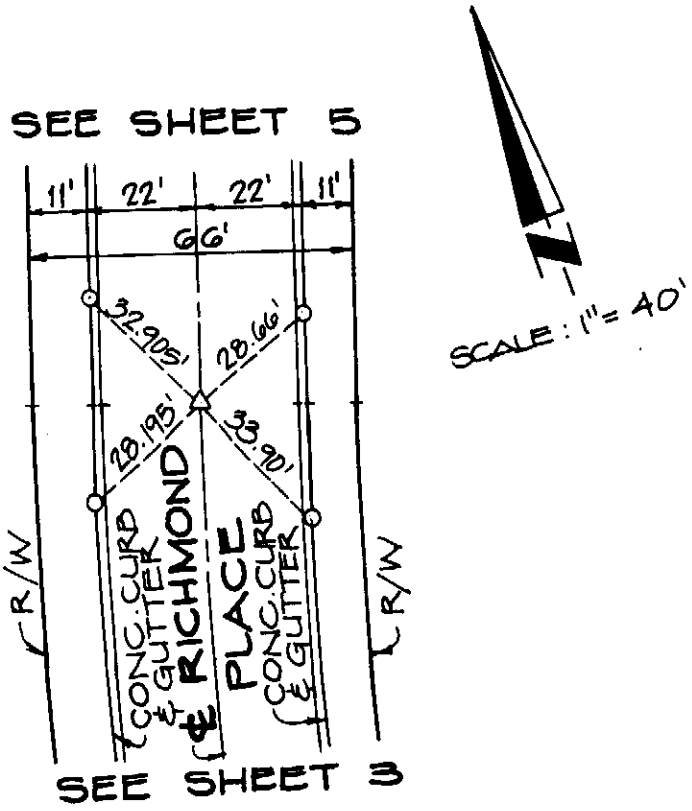

△ INDICATES SPIKE & WASHER STAMPED "L.S. 4189"

○ INDICATES LEAD & BRASS NAIL IN TOP OF CURB

88157

TIE BOOK 15 PG. 147

℄ TIES-P.M. № 11671 SHEET 5 OF 12

WILLIAMSON AND SCHMID-CIVIL ENGINEERS

JAMES B. DUNLAP, L.S. 4189 JULY 1990

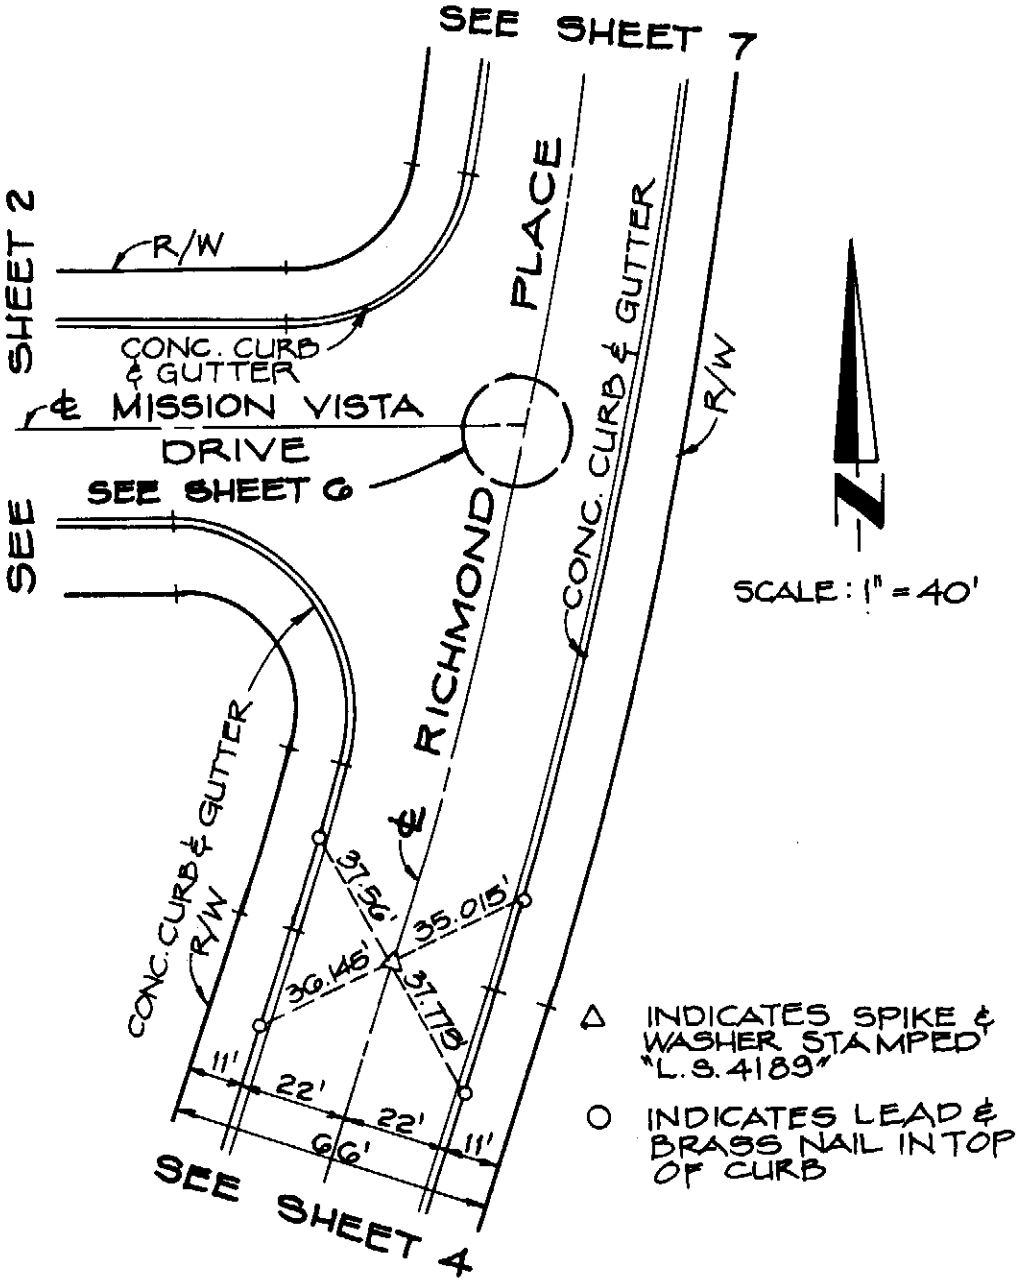

88157

TIE BOOK 15 PG. 148

℄ TIES - P.M. № 11671 SHEET 6 OF 12

WILLIAMSON AND SCHMID - CIVIL ENGINEERS

JAMES B. DUNLAP, L.S. 4189 JULY 1990

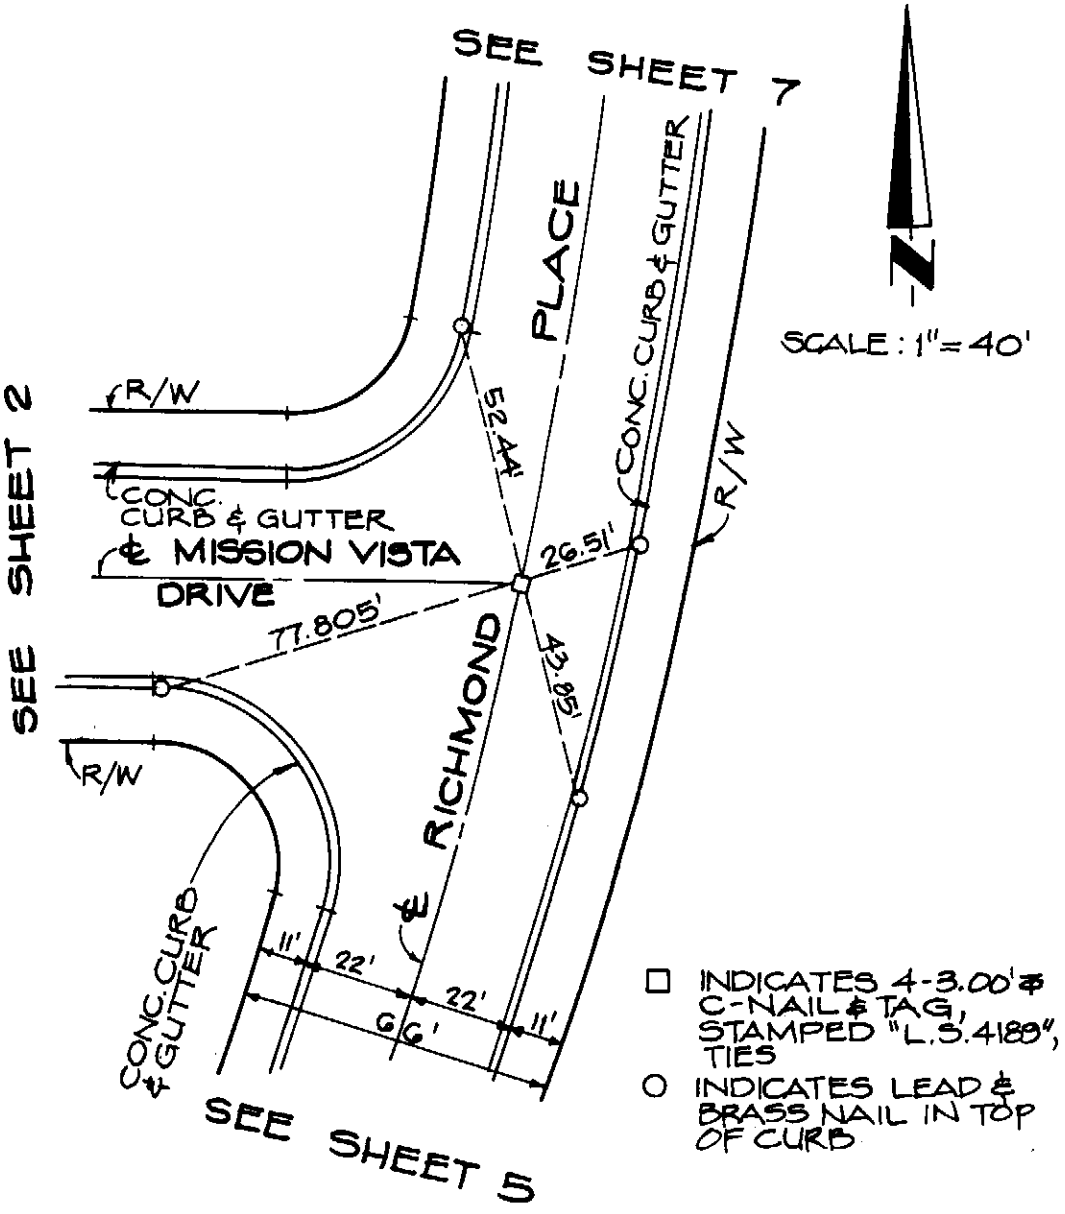

88157

TIE BOOK 15 PG. 149

℄ TIES - P.M. No 11671 SHEET 7 OF 12

WILLIAMSON AND SCHMID - CIVIL ENGINEERS

JAMES B. DUNLAP, L.S. 4189 JULY 1990

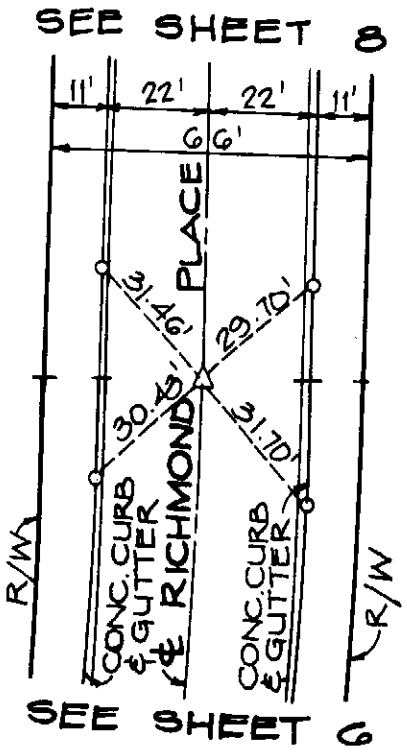

SCALE: 1" = 40'

△ INDICATES SPIKE & WASHER STAMPED "L.S. 4189"

○ INDICATES LEAD & BRASS NAIL IN TOP OF CURB

88157

TIE BOOK 15 PG. 150

℄ TIES - P.M. № 11671 SHEET 8 OF 12

WILLIAMSON AND SCHMID - CIVIL ENGINEERS

JAMES B. DUNLAP, L.S. 4189 JULY 1990

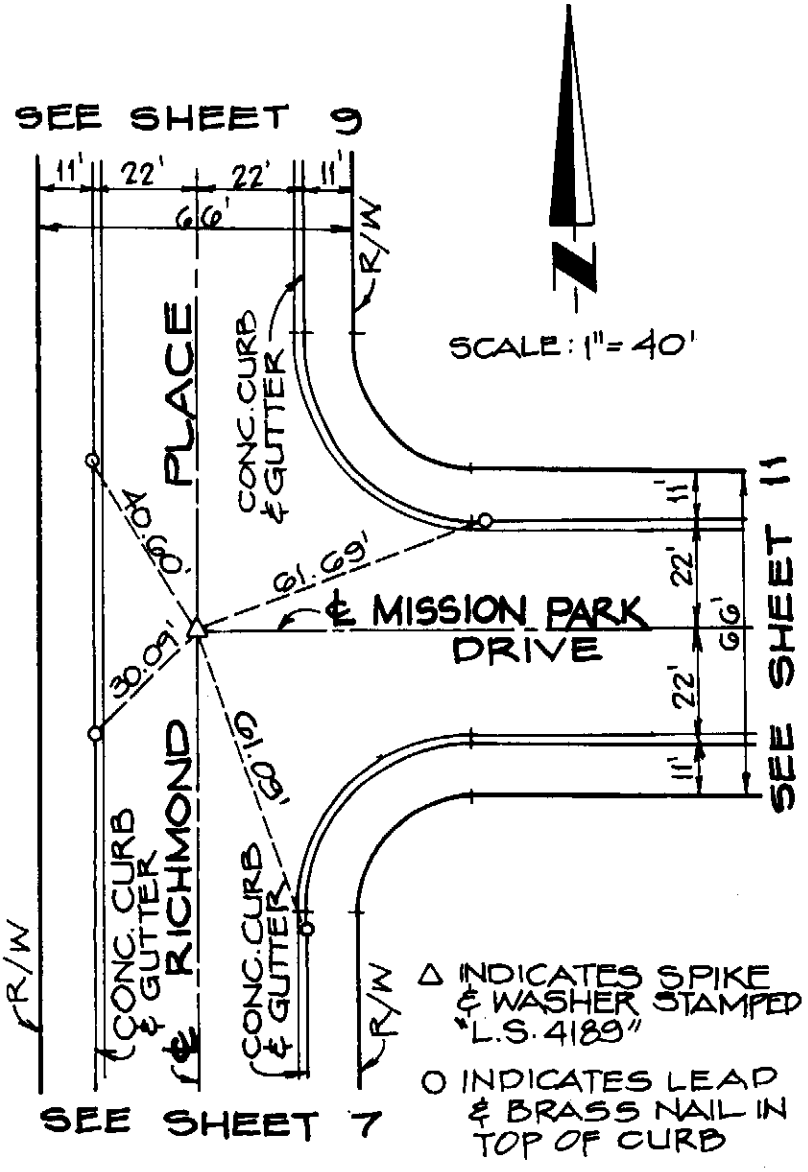

88157

TIE BOOK 15 PG. 151

℄ TIES-P.M. № 11671 SHEET 9 OF 12

WILLIAMSON AND SCHMID-CIVIL ENGINEERS

JAMES B. DUNLAP, L.S. 4189 JULY 1990

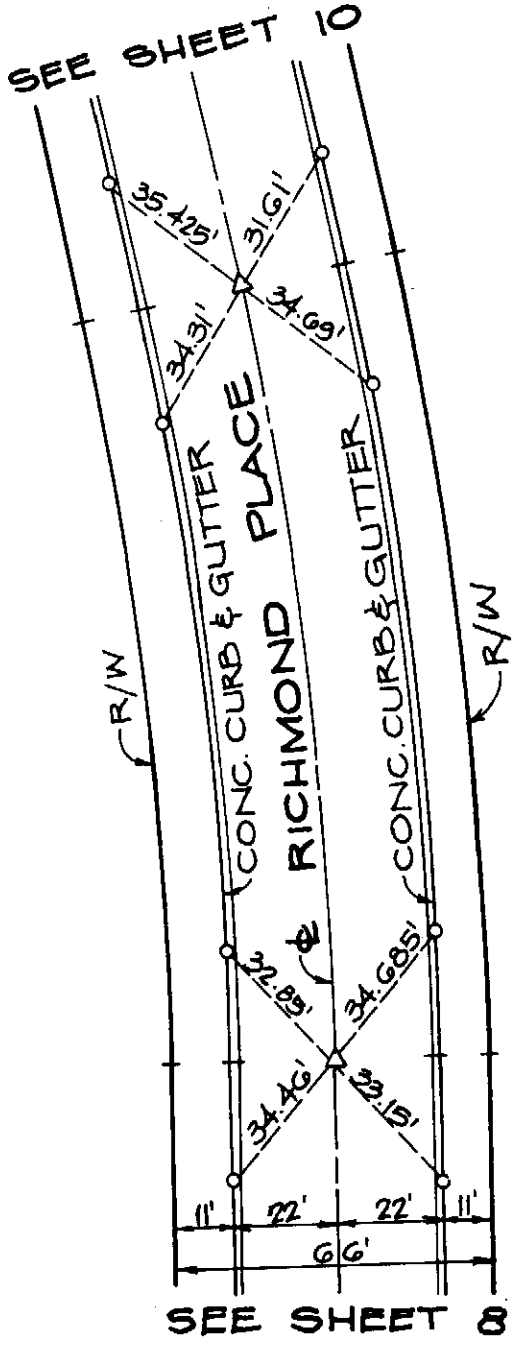

SCALE: 1" = 40'

△ INDICATES SPIKE & WASHER STAMPED "L.S. 4189"

○ INDICATES LEAD & BRASS NAIL IN TOP OF CURB

88157

TIE BOOK 15 PG. 152

℄ TIES - P.M. № 11671 SHEET 10 OF 12

WILLIAMSON AND SCHMID - CIVIL ENGINEERS

JAMES B. DUNLAP, L.S. 4189 JULY 1990

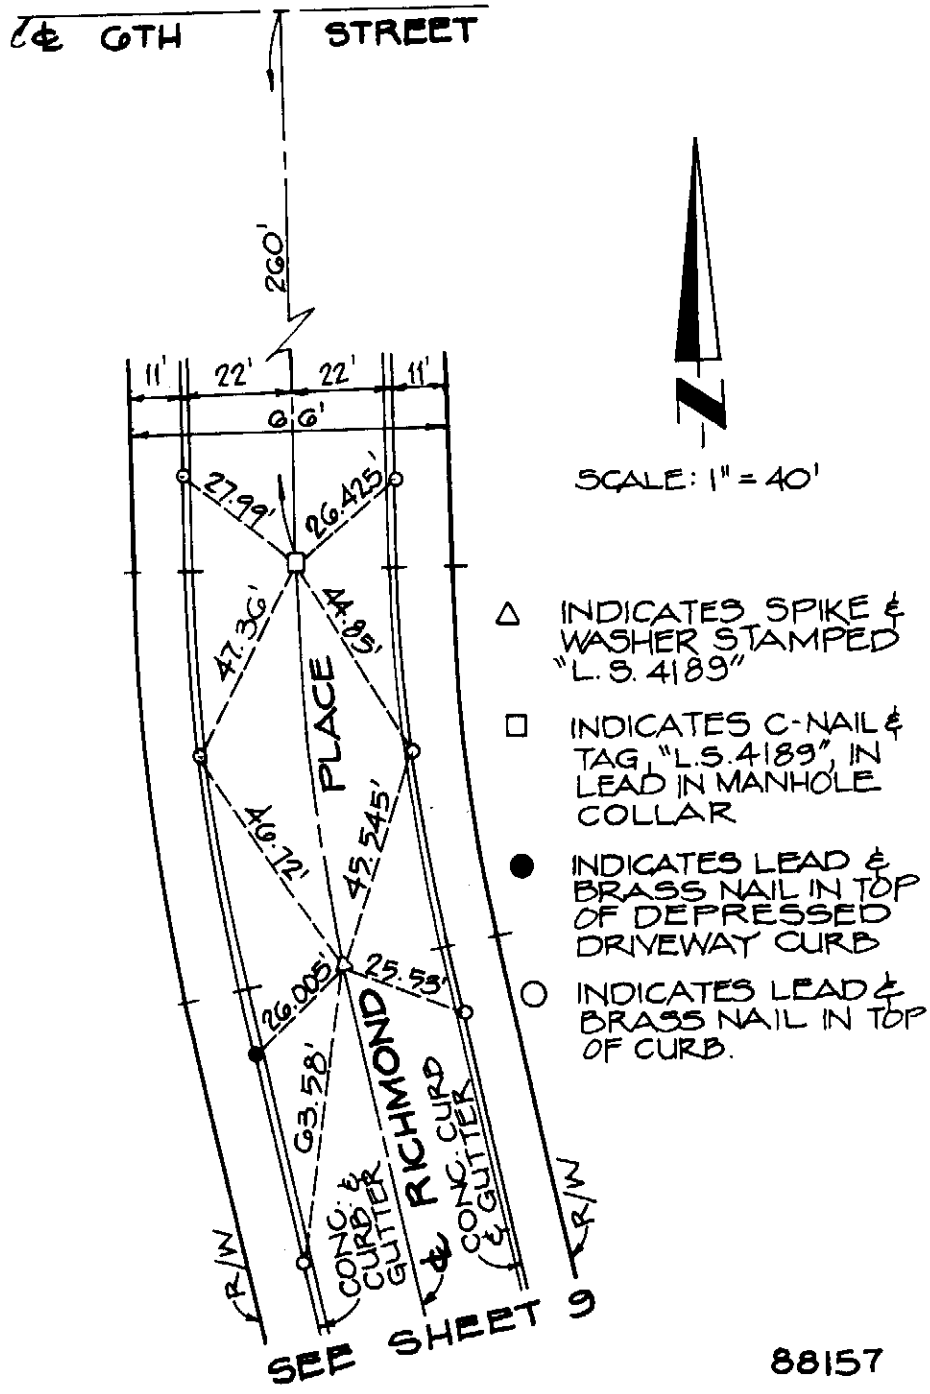

88157

TIE BOOK 15 PG. 153

℄ TIES-P.M. № 11671 SHEET 11 OF 12

WILLIAMSON AND SCHMID-CIVIL ENGINEERS

JAMES B. DUNLAP, L.S. 4189 JULY 1990

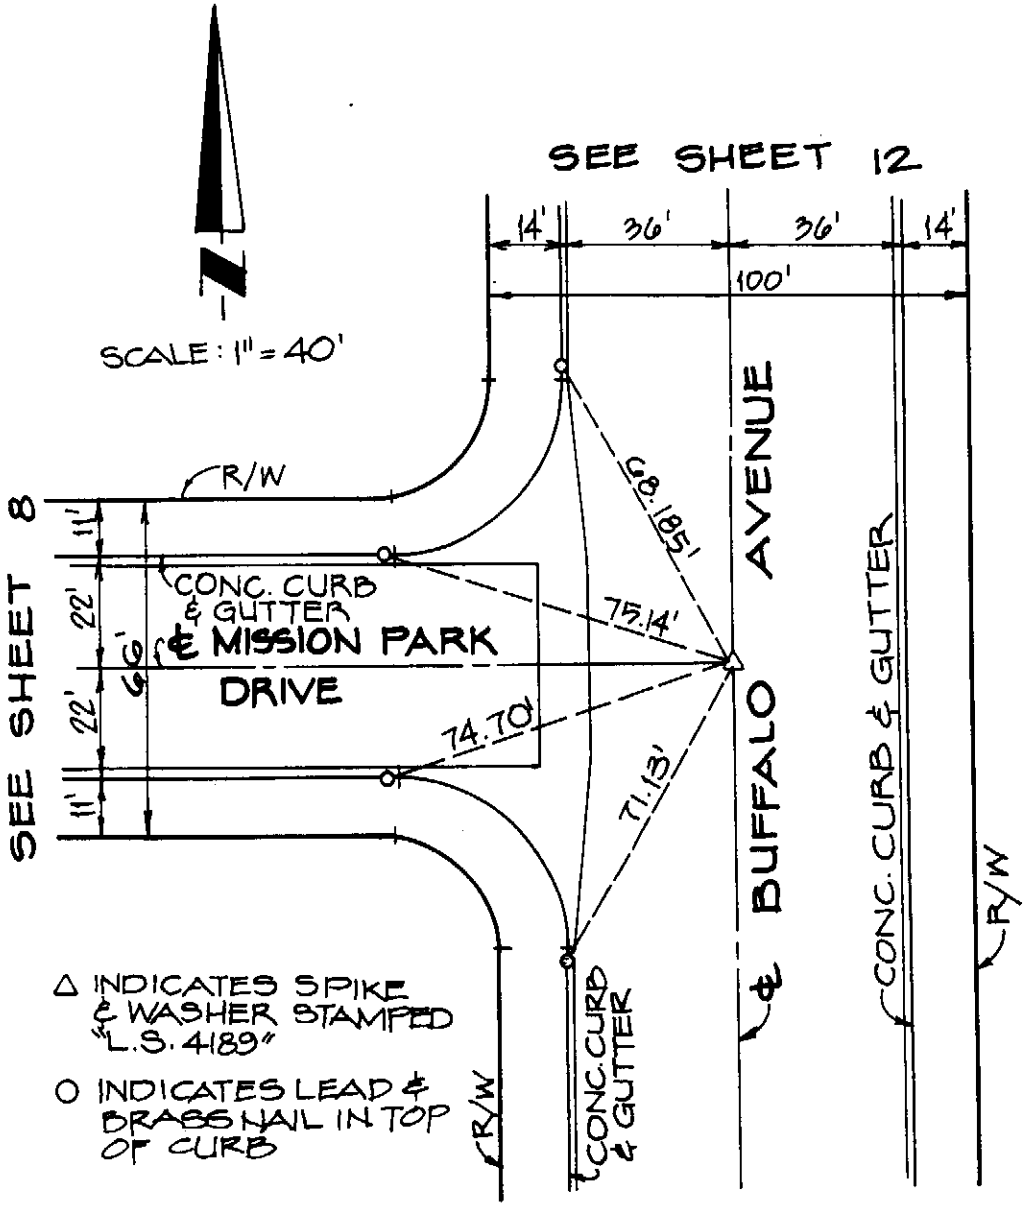

88157

TIE BOOK 15 PG. 154

℄ TIES - P.M. № 11671 SHEET 12 OF 12

WILLIAMSON AND SCHMID - CIVIL ENGINEERS

JAMES B. DUNLAP, L.S. 4189 JULY 1990

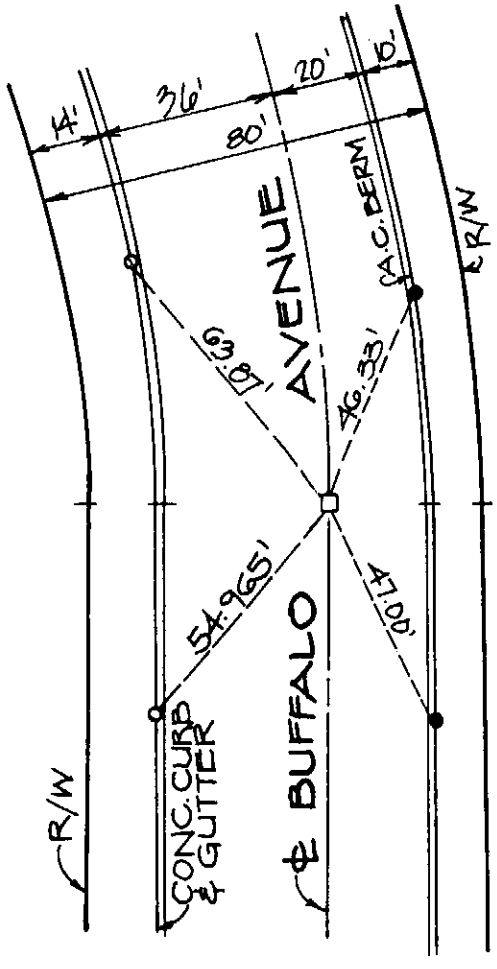

SCALE: 1" = 40'

SEE SHEET 11

□ INDICATES FOUND 4-2.00' ⌀ NAIL & TAG, STAMPED "R.C.E. 31737", TIES

○ INDICATES LEAD & BRASS NAIL IN TOP OF CURB

● INDICATES LEAD & BRASS NAIL IN TOP OF A.C. BERM

88157

TIE BOOK 15 PG. 155

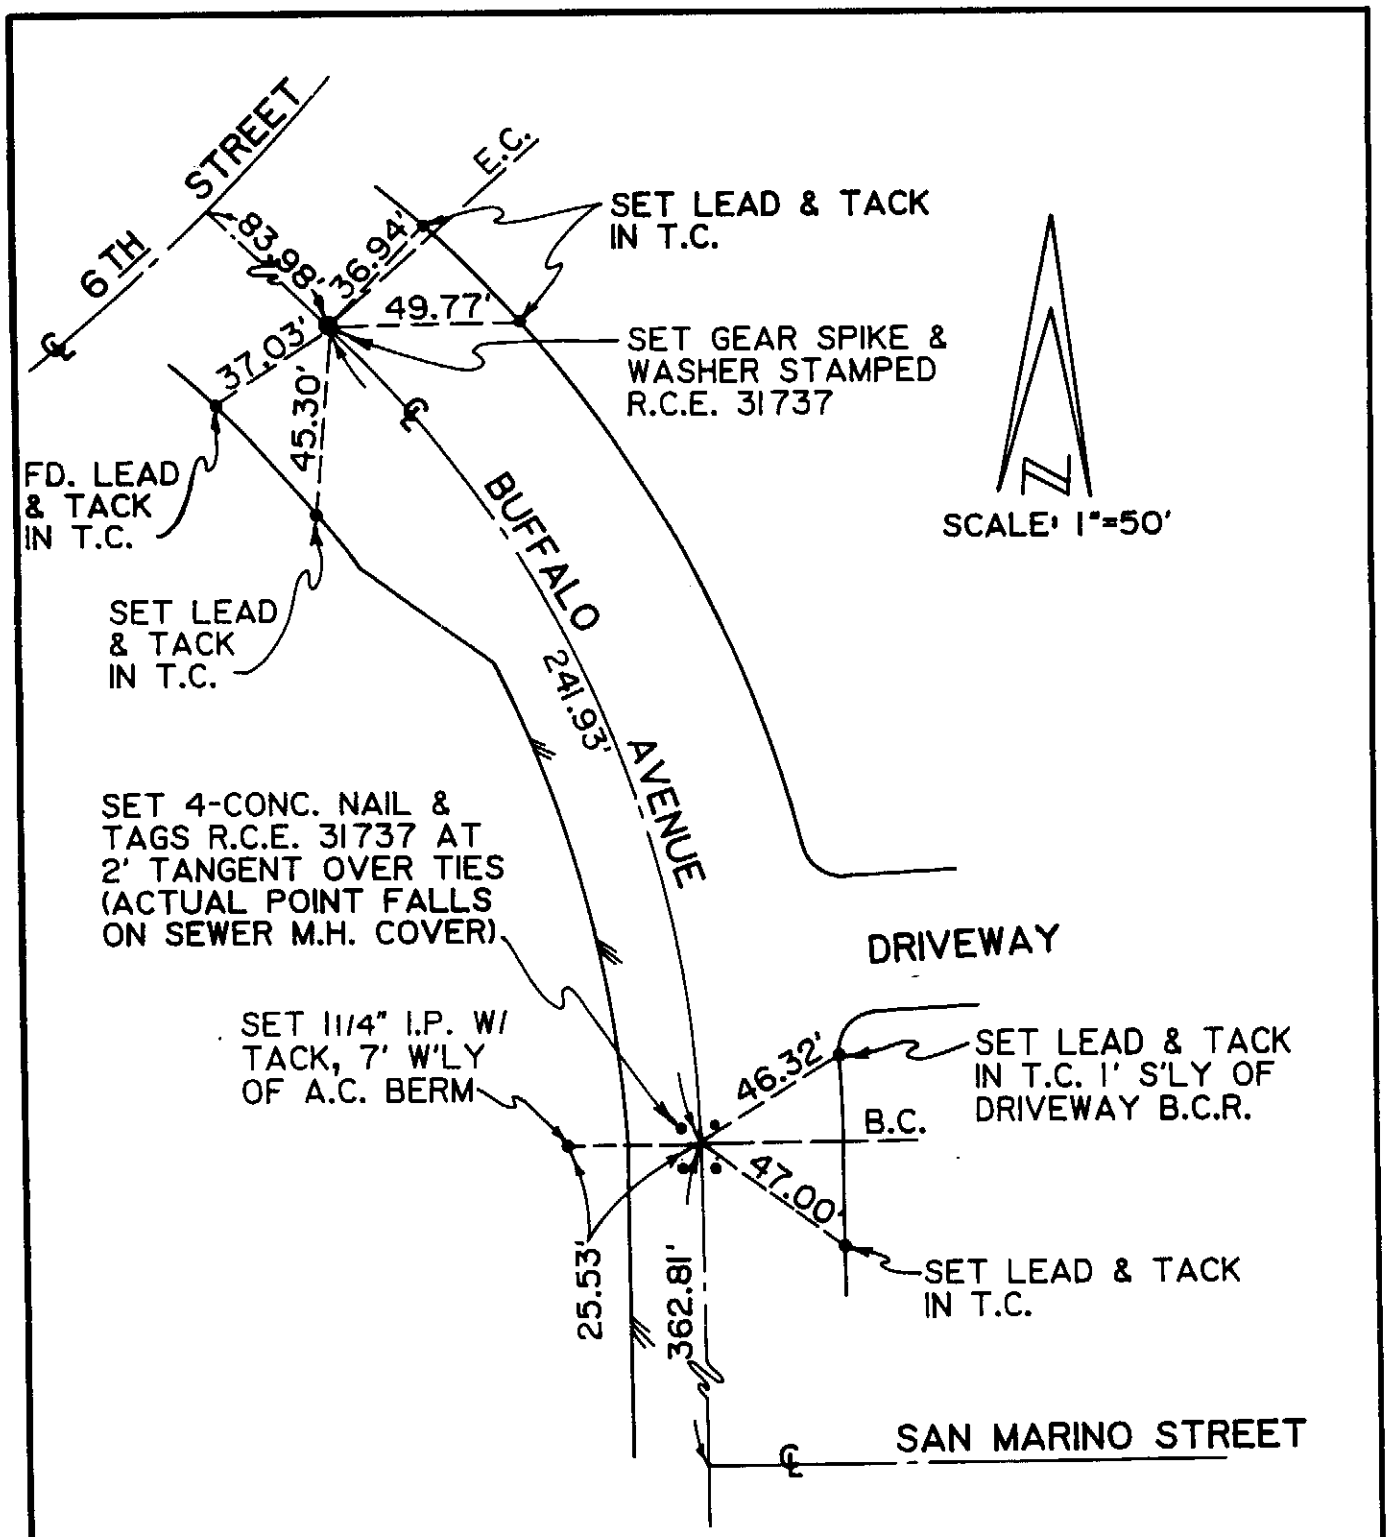

city of rancho cucamonga — STREET TIE	P.M. 11222
JOHNSON-FRANK & ASSOC. 5150 EAST HUNTER AVE. ANAHEIM, CA. 92807 (714) 777-8877	BUFFALO AVENUE S'LY OF 6TH STREET
ENGR. / ~~L.S.~~ WILLIAM L. HARRIS	FIELD REVIEW _____ DATE _____
R.C.E. / ~~L.S.~~ NO. 31737 DATE 6-15-89	TIE BOOK 15 PAGE 156

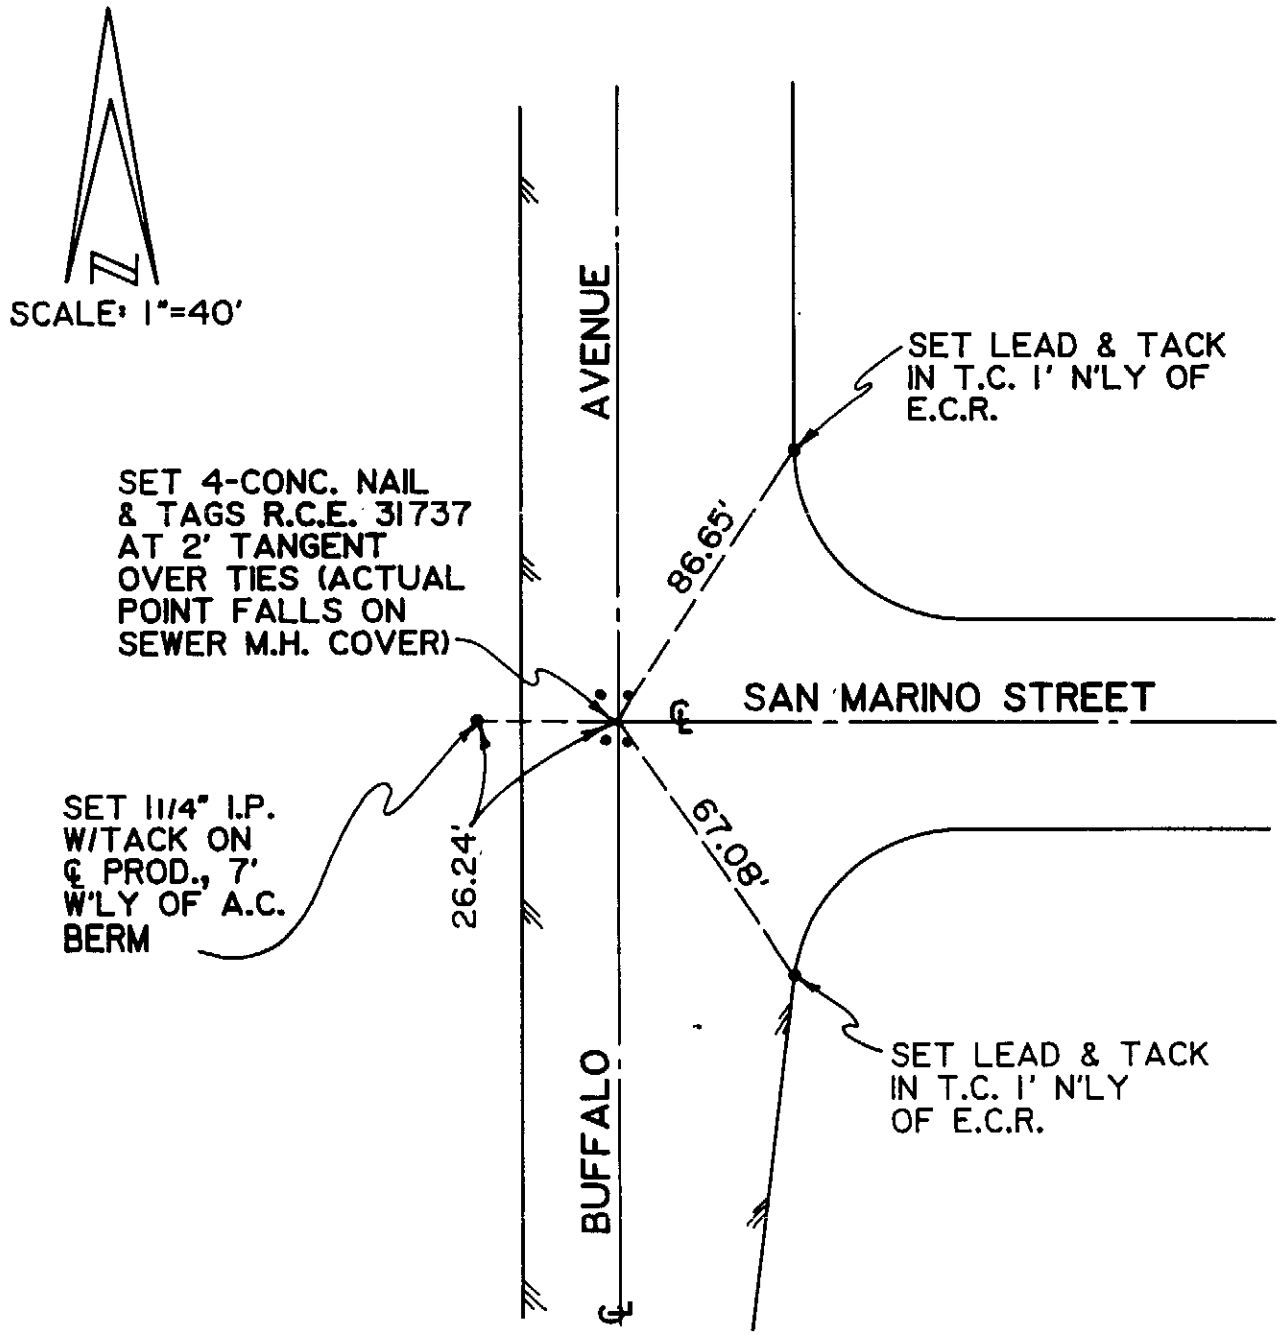

city of rancho cucamonga — STREET TIE	P.M. 11222
JOHNSON-FRANK & ASSOC. 5150 EAST HUNTER AVE. ANAHEIM, CA. 92807 (714) 777-8877	BUFFALO AVENUE & SAN MARINO STREET
ENGR. / ~~L.S.~~ WILLIAM L. HARRIS	FIELD REVIEW _____ DATE _____
R.C.E. / ~~L.S.~~ NO. 31737 DATE 6-15-89	TIE BOOK 15 PAGE 157

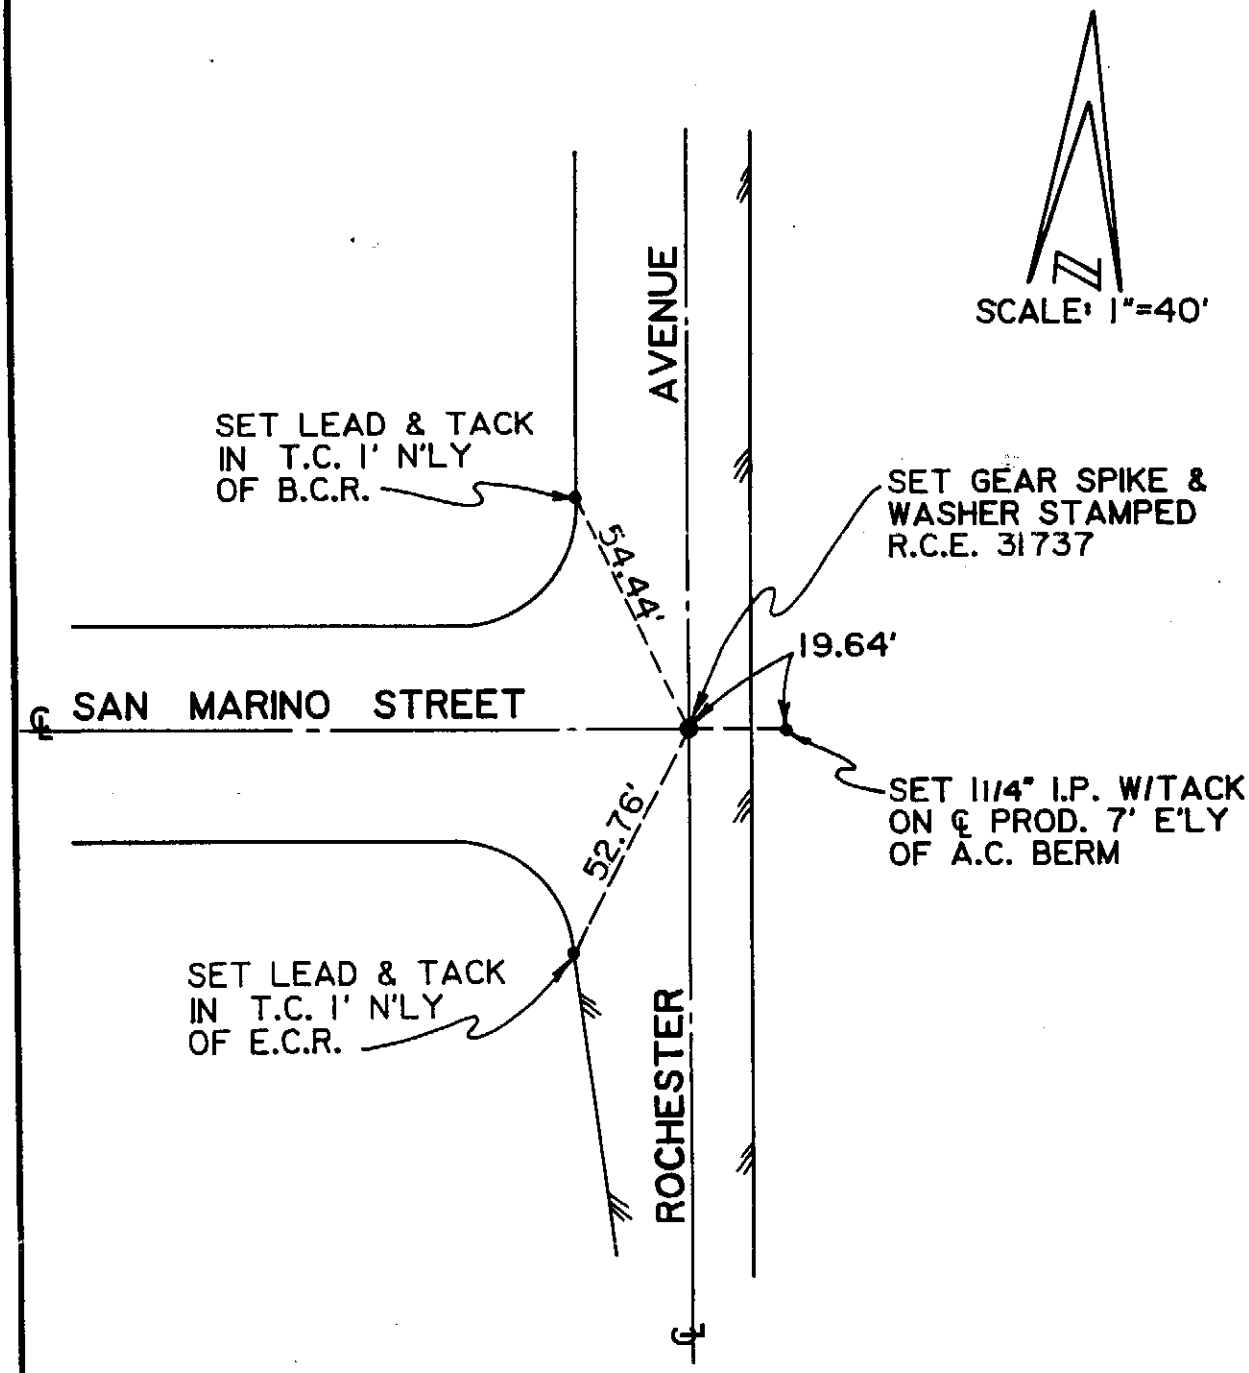

city of rancho cucamonga — STREET TIE	P.M. 11222
JOHNSON-FRANK & ASSOC. 5150 EAST HUNTER AVE. ANAHEIM, CA. 92807 (714) 777-8877	ROCHESTER AVENUE & SAN MARINO STREET
ENGR. / ~~L.S.~~ WILLIAM L. HARRIS	FIELD REVIEW _____ DATE _____
R.C.E. / ~~L.S.~~ NO. 31737 DATE 6-15-89	TIE BOOK 15 PAGE 158