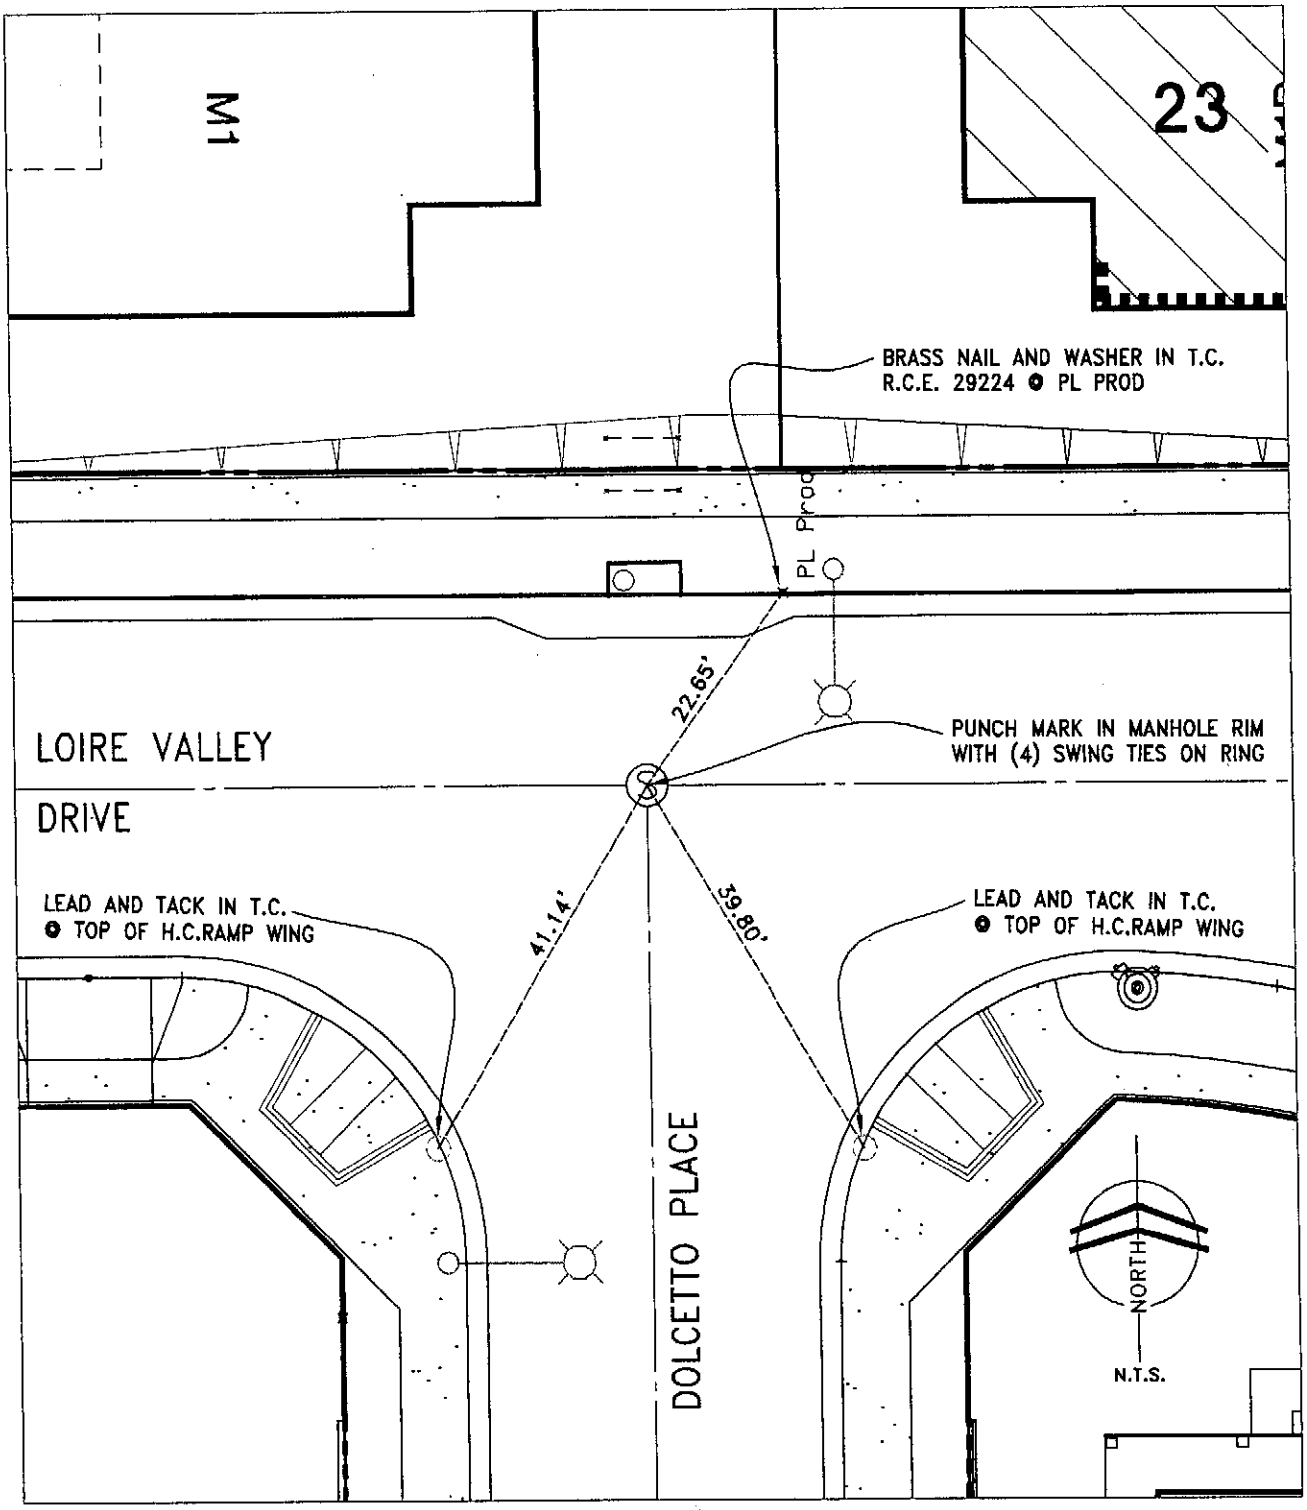

CITY OF RANCHO CUCAMONGA STREET TIES	TRACT 15711-0
Dan Guerra & Associates 10271-B TRADEMARK STREET RANCHO CUCAMONGA, CA 91730 (909) 987-4306 CIVIL ENGINEERS • LAND SURVEYORS	AT CENTERLINE INTERSECTION DOLCETTO PLACE AND LOIRE VALLEY DRIVE, ON SEWER MANHOLE RIM
ENGINEER: DANIEL E. GUERRA	FIELD REVIEW: _____ DATE: _____
R.C.E. No. 29224	TIE BOOK: 24 PAGE: 1

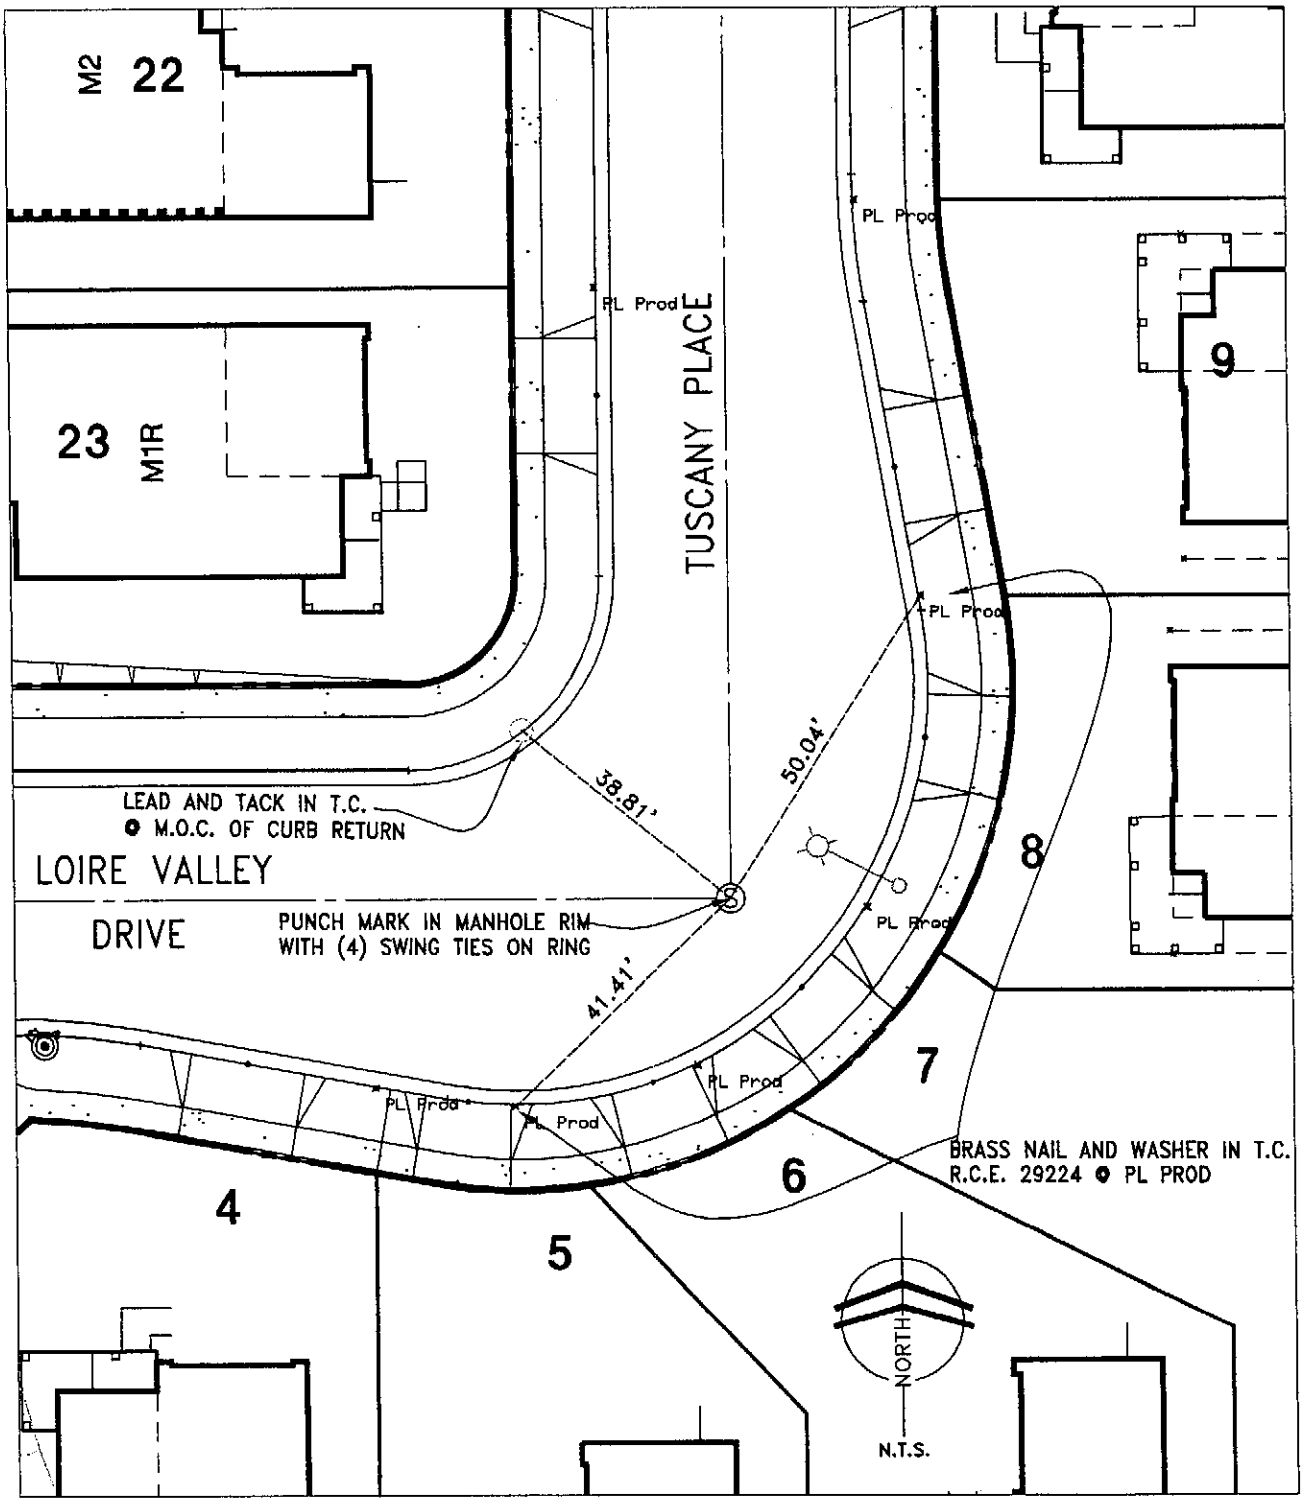

CITY OF RANCHO CUCAMONGA STREET TIES	TRACT 15711-0
Dan Guerra & Associates 10271-B TRADEMARK STREET RANCHO CUCAMONGA, CA 91730 (909) 987-4306 CIVIL ENGINEERS • LAND SURVEYORS	AT CENTERLINE INTERSECTION TUSCANY PLACE AND LOIRE VALLEY DRIVE, ON SEWER MANHOLE RIM
ENGINEER: DANIEL E. GUERRA	FIELD REVIEW: _____ DATE: _____
R.C.E. No. 29224	TIE BOOK: 24 PAGE: 2

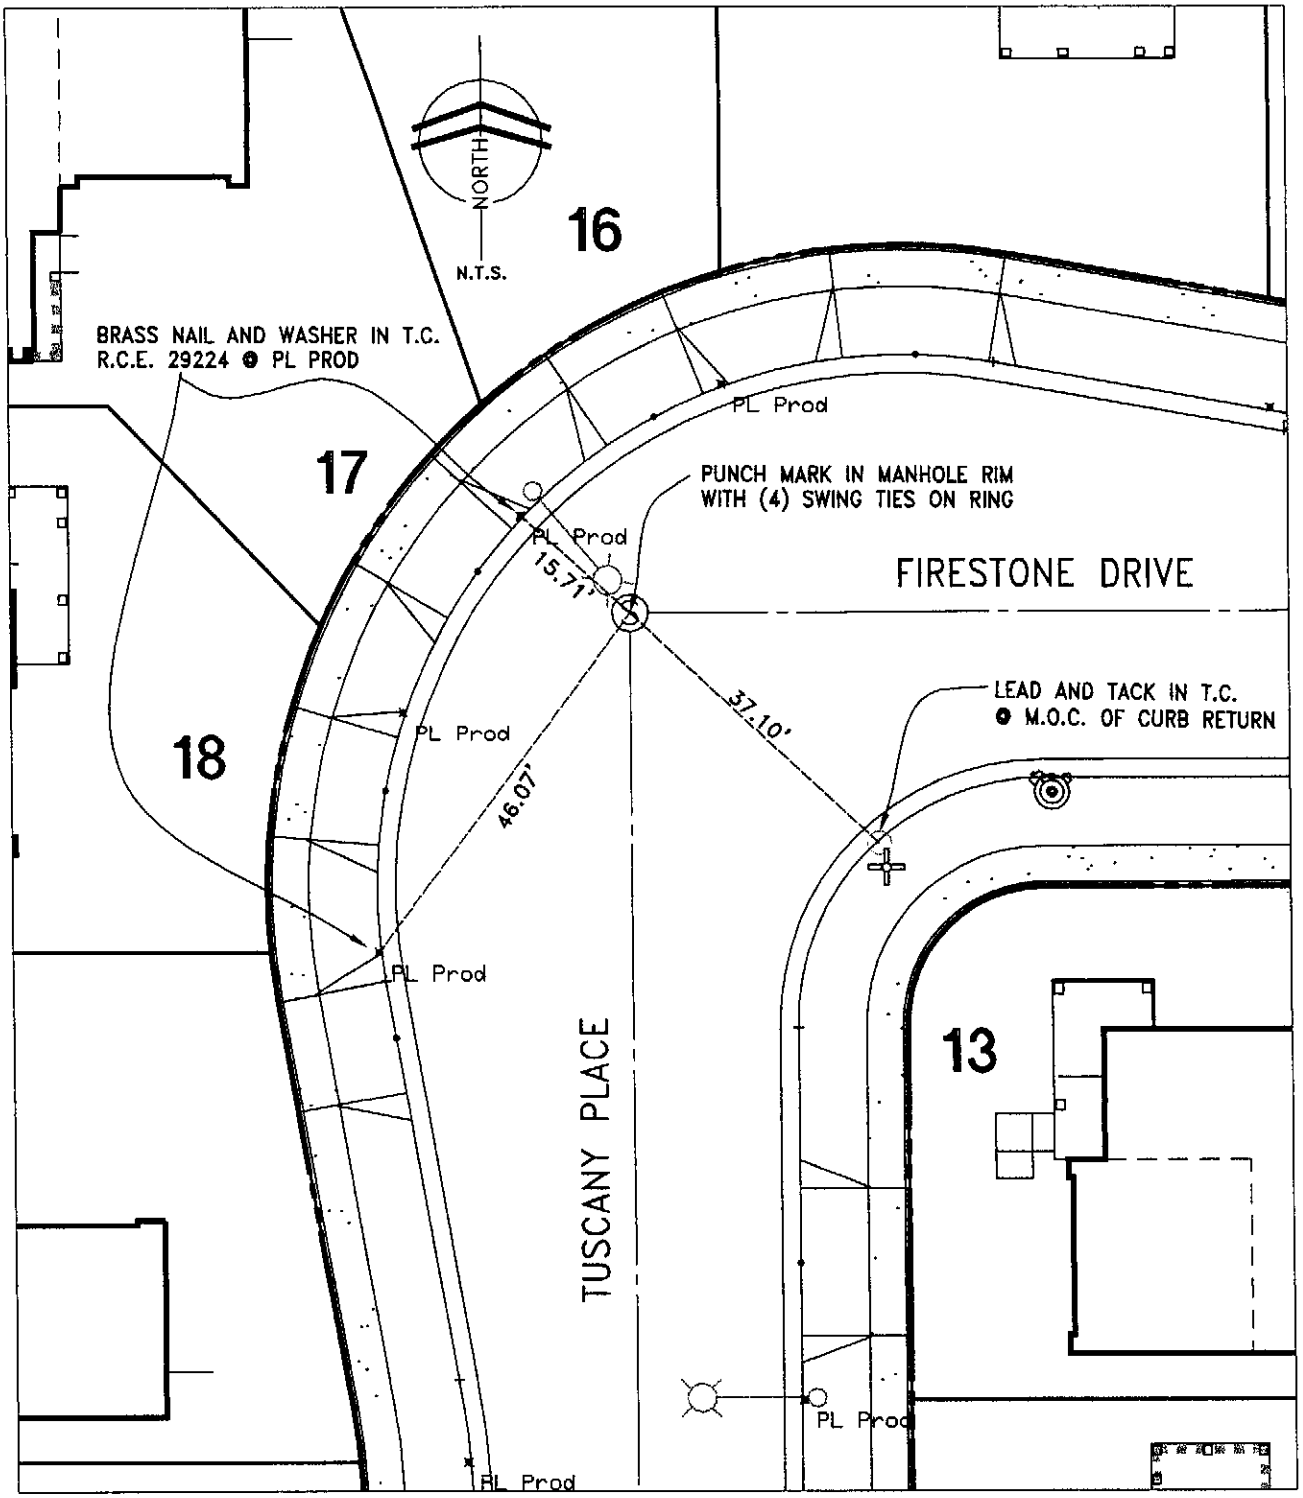

CITY OF RANCHO CUCAMONGA STREET TIES	TRACT 15711-0
Dan Guerra & Associates 10271-B TRADEMARK STREET RANCHO CUCAMONGA, CA 91730 (909) 987-4306 CIVIL ENGINEERS • LAND SURVEYORS	AT CENTERLINE INTERSECTION TUSCANY PLACE AND FIRESTONE DRIVE, ON SEWER MANHOLE RIM
ENGINEER: DANIEL E. GUERRA	FIELD REVIEW: _____ DATE: _____
R.C.E. No. 29224	TIE BOOK: 24 PAGE: 3

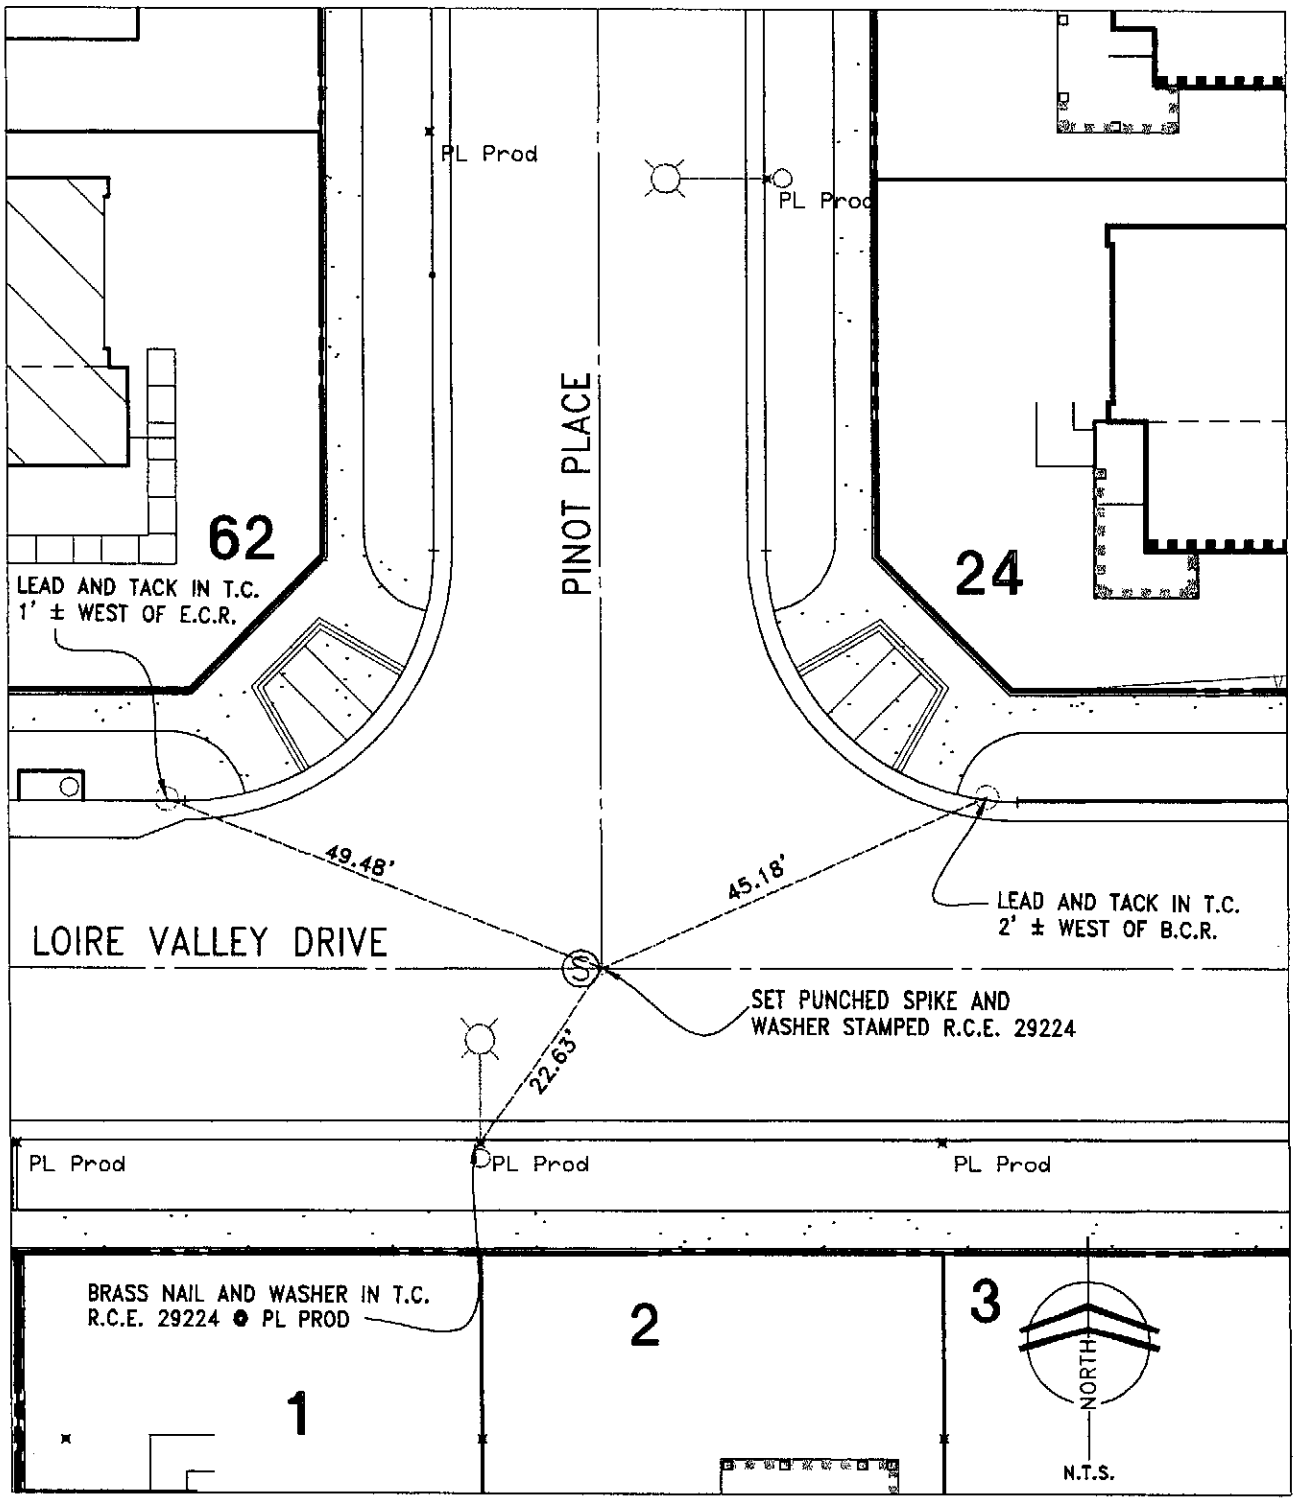

CITY OF RANCHO CUCAMONGA STREET TIES	TRACT 15711-0
Dan Guerra & Associates 10271-B TRADEMARK STREET RANCHO CUCAMONGA, CA 91730 (909) 987-4306 CIVIL ENGINEERS • LAND SURVEYORS	BOAT SPIKE AND WASHER, STAMPED R.C.E. 29224 AT CENTERLINE INTERSECTION PINOT PLACE AND LOIRE VALLEY DRIVE
ENGINEER: DANIEL E. GUERRA	FIELD REVIEW: _____ DATE: _____
R.C.E. No. 29224	TIE BOOK: 24 PAGE: 4

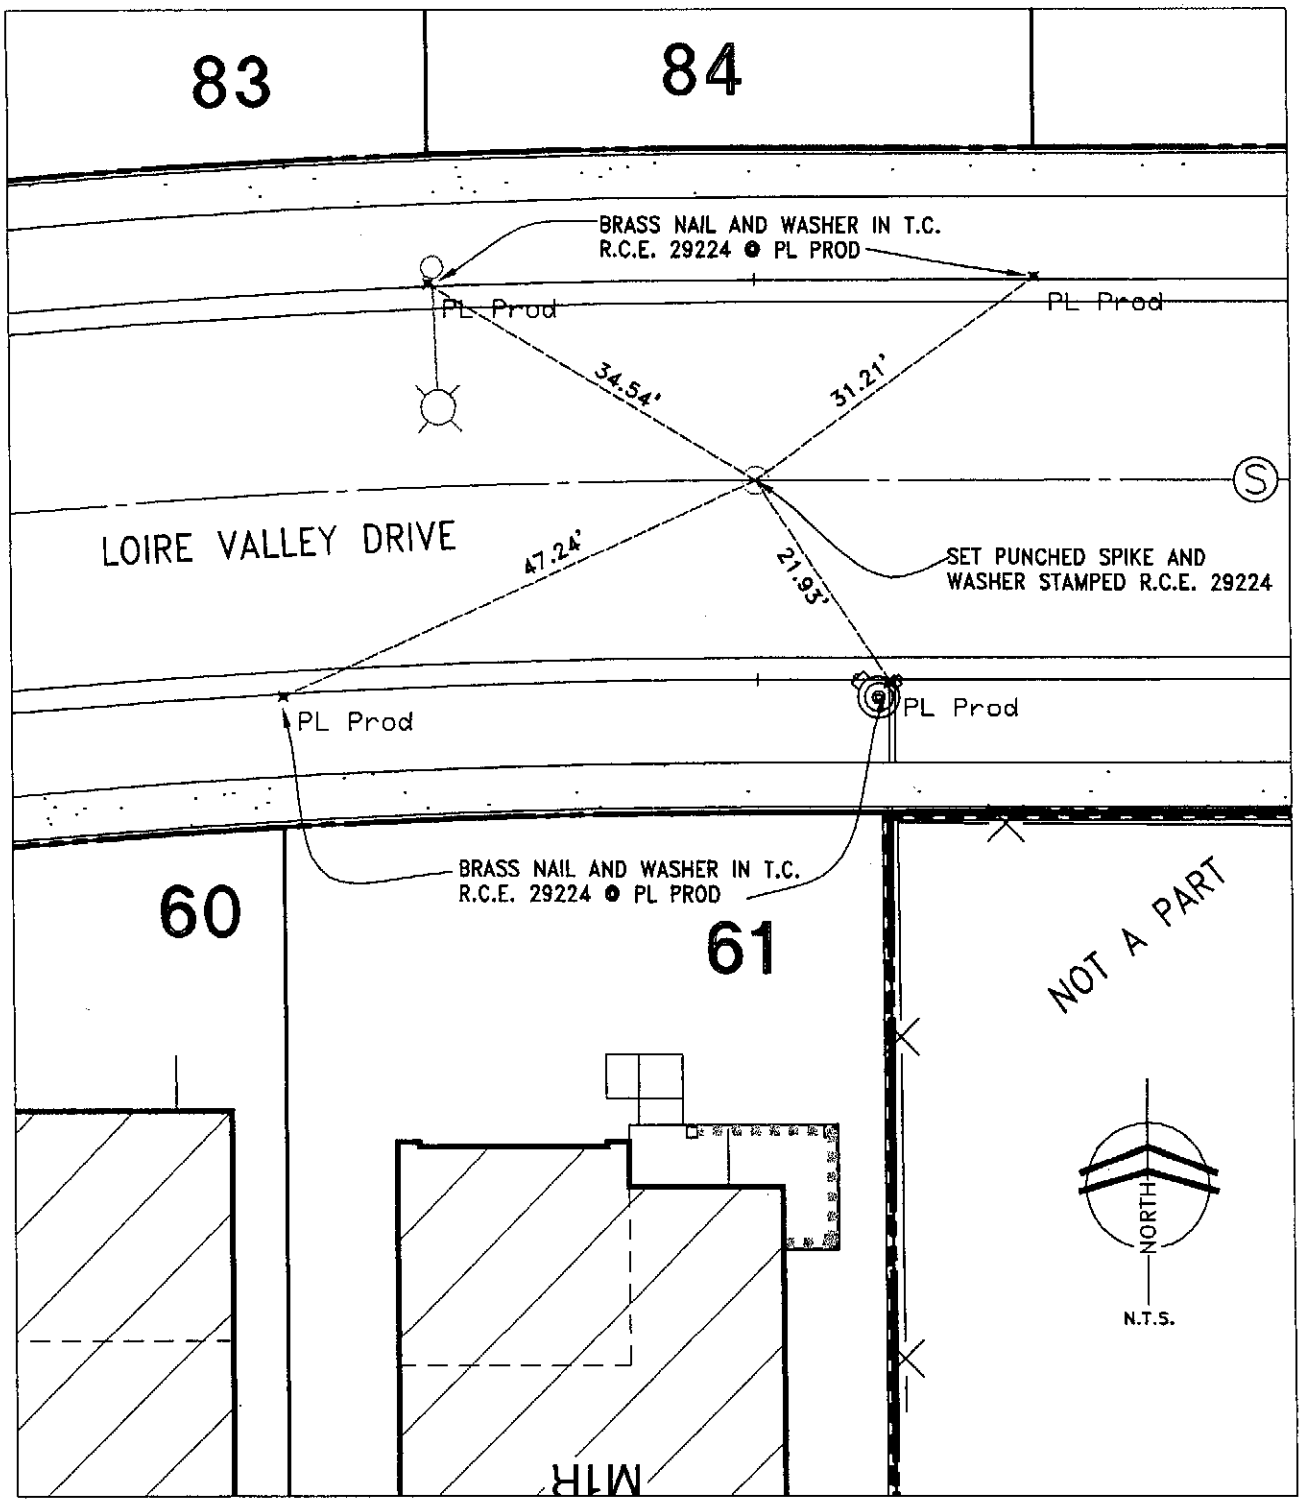

CITY OF RANCHO CUCAMONGA STREET TIES	TRACT 15711-0
Dan Guerra & Associates 10271-B TRADEMARK STREET RANCHO CUCAMONGA, CA 91730 (909) 987-4306 CIVIL ENGINEERS • LAND SURVEYORS	BOAT SPIKE AND WASHER STAMPED R.C.E. 29224 AT E.C. ON LOIRE VALLEY DRIVE
ENGINEER: DANIEL E. GUERRA	FIELD REVIEW: _____ DATE: _____
R.C.E. No. 29224	TIE BOOK: 24 PAGE: 5

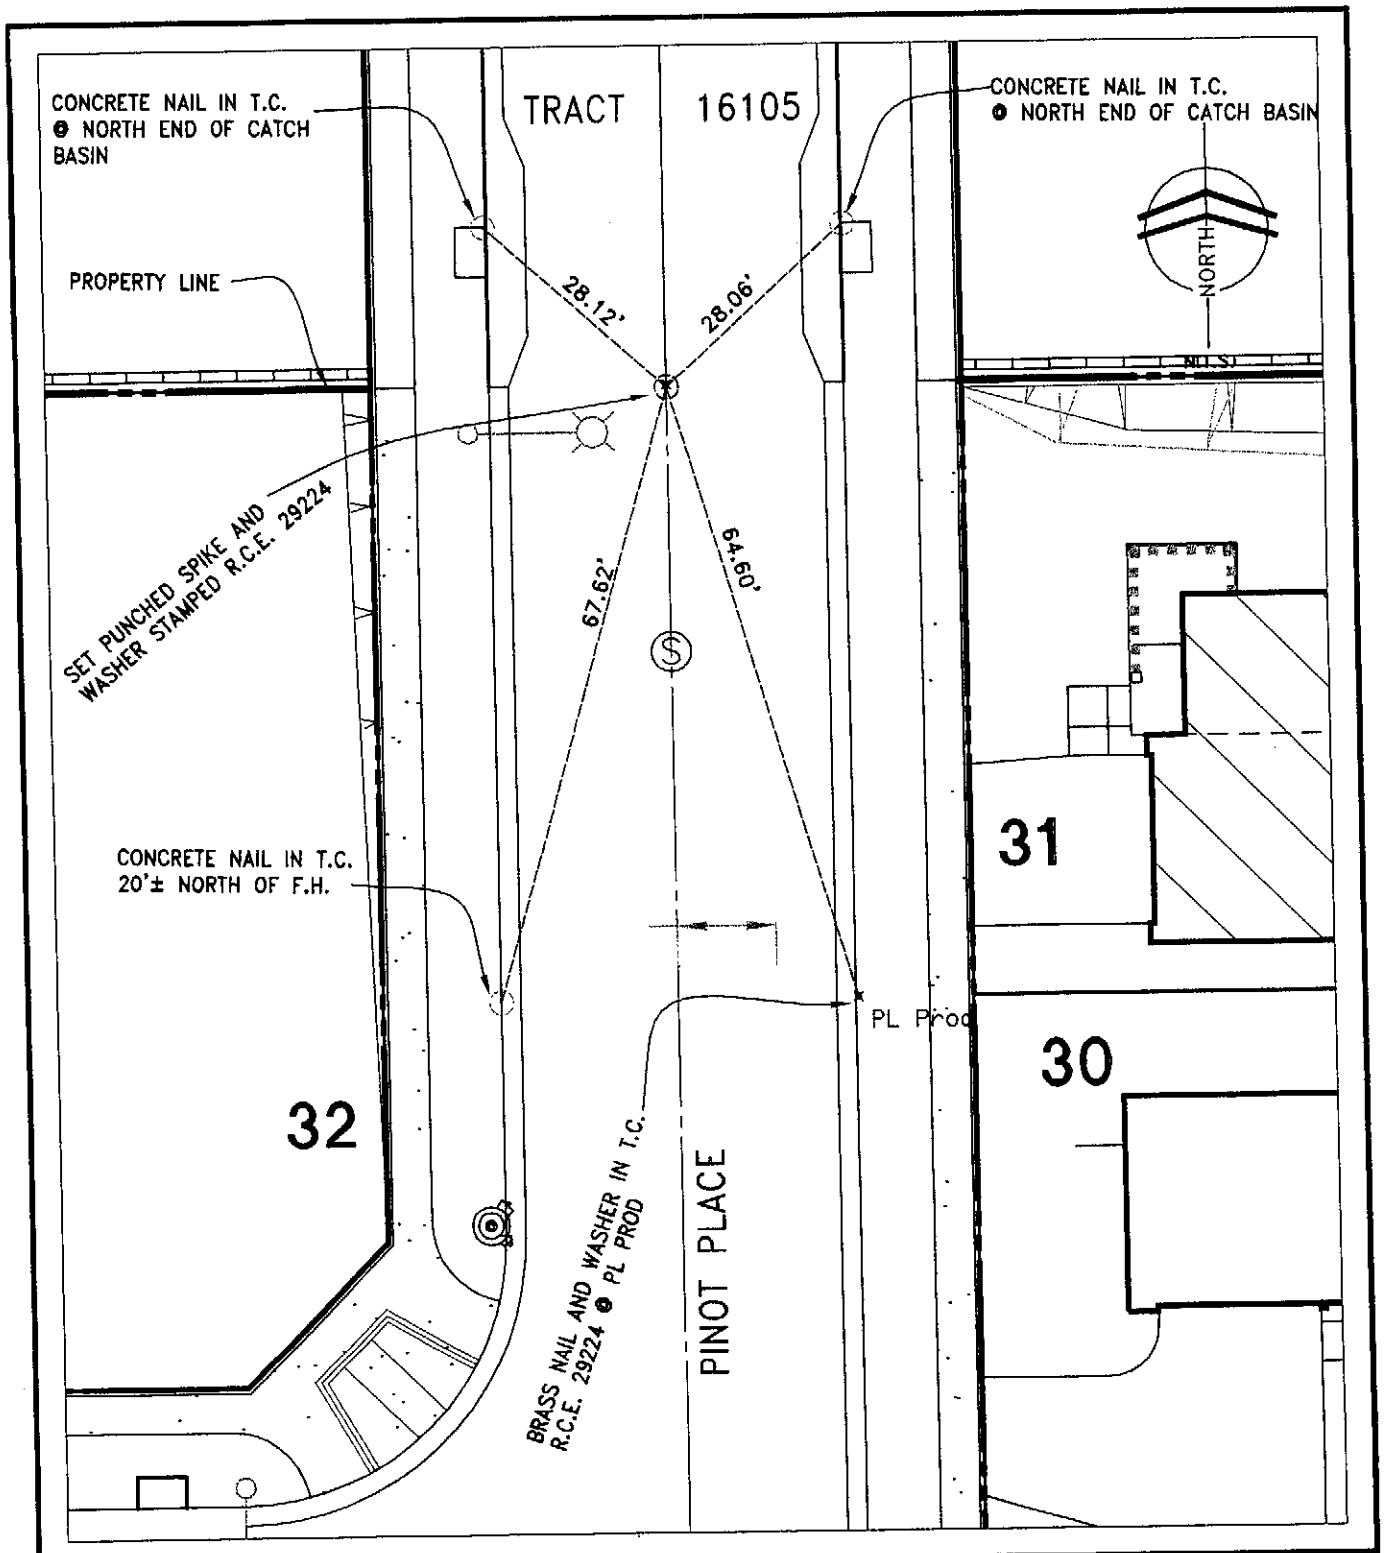

CITY OF RANCHO CUCAMONGA STREET TIES	TRACT 15711-0
Dan Guerra & Associates 10271-B TRADEMARK STREET RANCHO CUCAMONGA, CA 91730 (909) 987-4306 CIVIL ENGINEERS • LAND SURVEYORS	BOAT SPIKE AND WASHER, STAMPED R.C.E.29224 AT CENTERLINE INTERSECTION PINOT PLACE NORTH TRACT BOUNDARY
ENGINEER: DANIEL E. GUERRA	FIELD REVIEW: _____ DATE: _____
R.C.E. No. 29224	TIE BOOK: 24 PAGE: 6

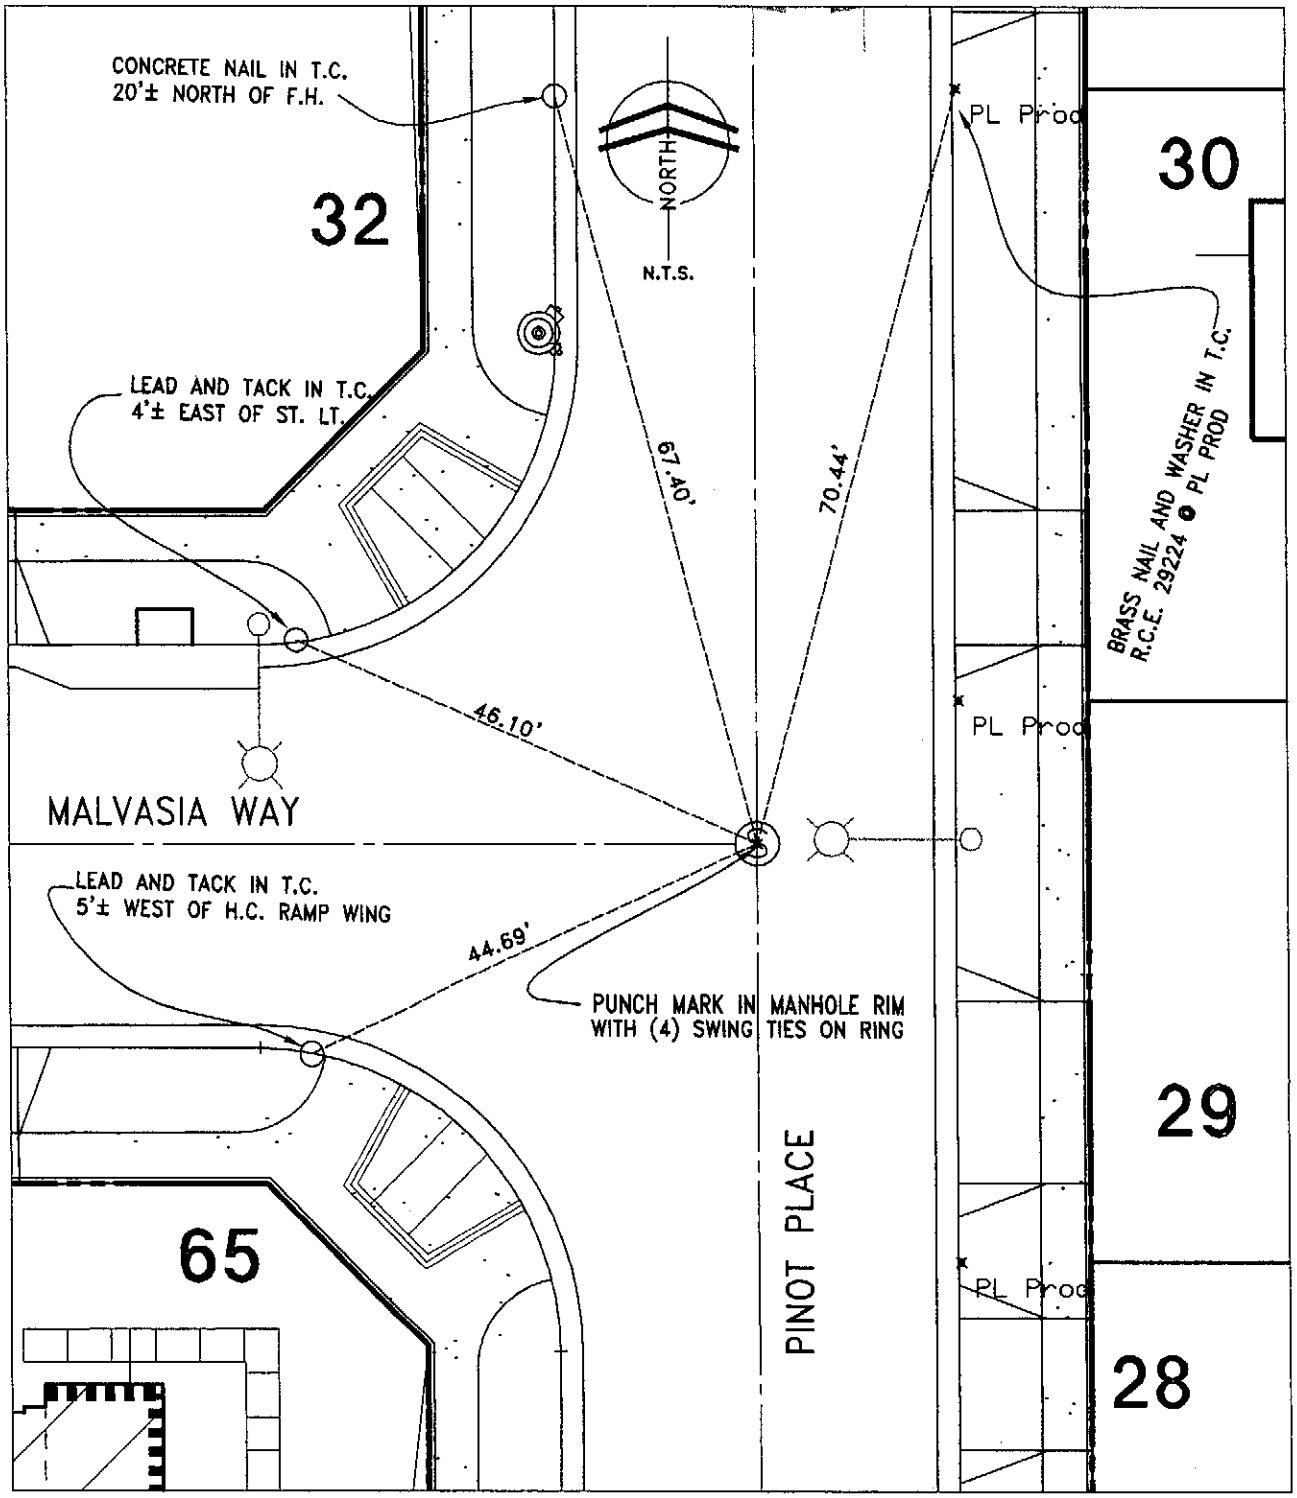

CITY OF RANCHO CUCAMONGA STREET TIES	TRACT 15711-0
Dan Guerra & Associates 10271-B TRADEMARK STREET RANCHO CUCAMONGA, CA 91730 (909) 987-4306 CIVIL ENGINEERS • LAND SURVEYORS	AT CENTERLINE INTERSECTION PINOT PLACE AND MALVASIA WAY, ON SEWER MANHOLE RIM
ENGINEER: DANIEL E. GUERRA	FIELD REVIEW: _____ DATE: _____
R.C.E. No. 29224	TIE BOOK: 24 PAGE: 7

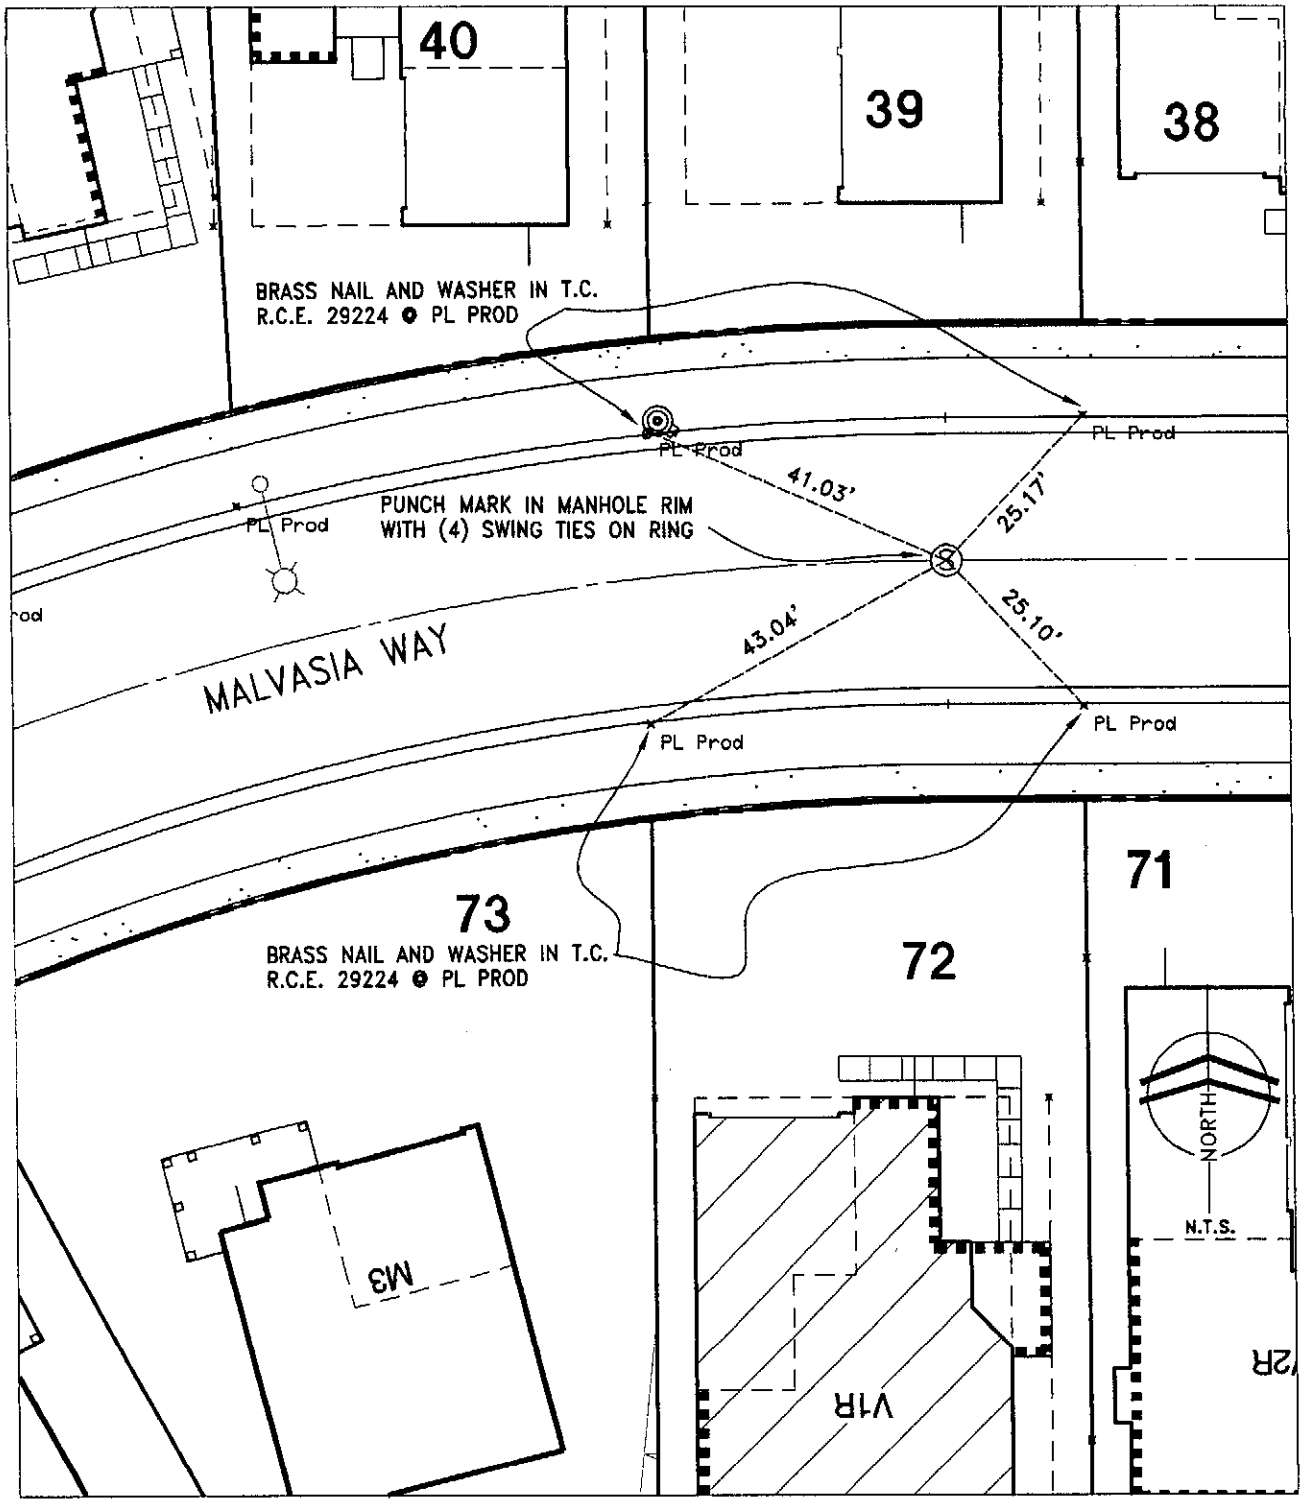

CITY OF RANCHO CUCAMONGA STREET TIES	TRACT 15711-0
Dan Guerra & Associates 10271-B TRADEMARK STREET RANCHO CUCAMONGA, CA 91730 (909) 987-4306 CIVIL ENGINEERS • LAND SURVEYORS	AT E.C. ON MALVASIA WAY, JUST EAST OF PINOT PLACE
ENGINEER: DANIEL E. GUERRA	FIELD REVIEW: _____ DATE: _____
R.C.E. No. 29224	TIE BOOK: 24 PAGE: 8

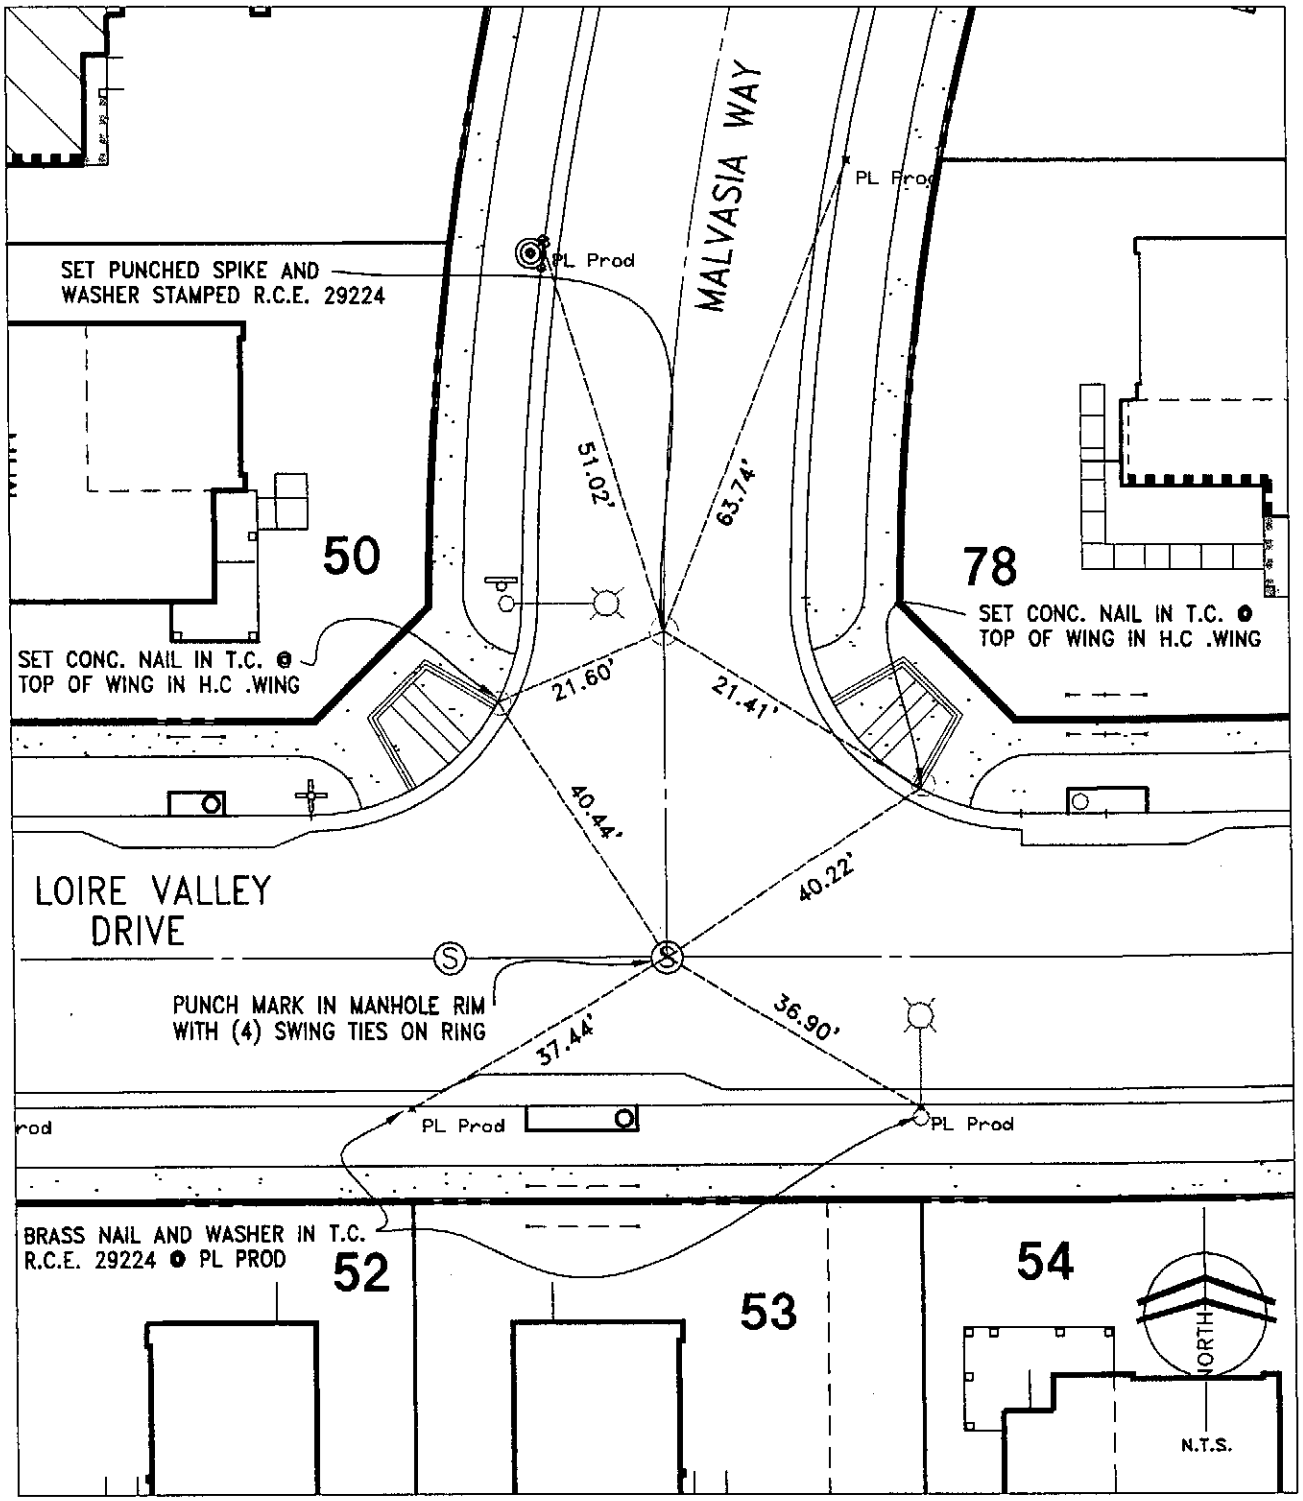

CITY OF RANCHO CUCAMONGA STREET TIES	TRACT 15711-0
Dan Guerra & Associates 10271-B TRADEMARK STREET RANCHO CUCAMONGA, CA 91730 (909) 987-4306 CIVIL ENGINEERS • LAND SURVEYORS	AT CENTERLINE INTERSECTION OF LOIRE VALLEY DRIVE AND MALVAYSIA WAY
ENGINEER: DANIEL E. GUERRA	FIELD REVIEW: _____ DATE: _____
R.C.E. No. 29224	TIE BOOK: 24 PAGE: 9

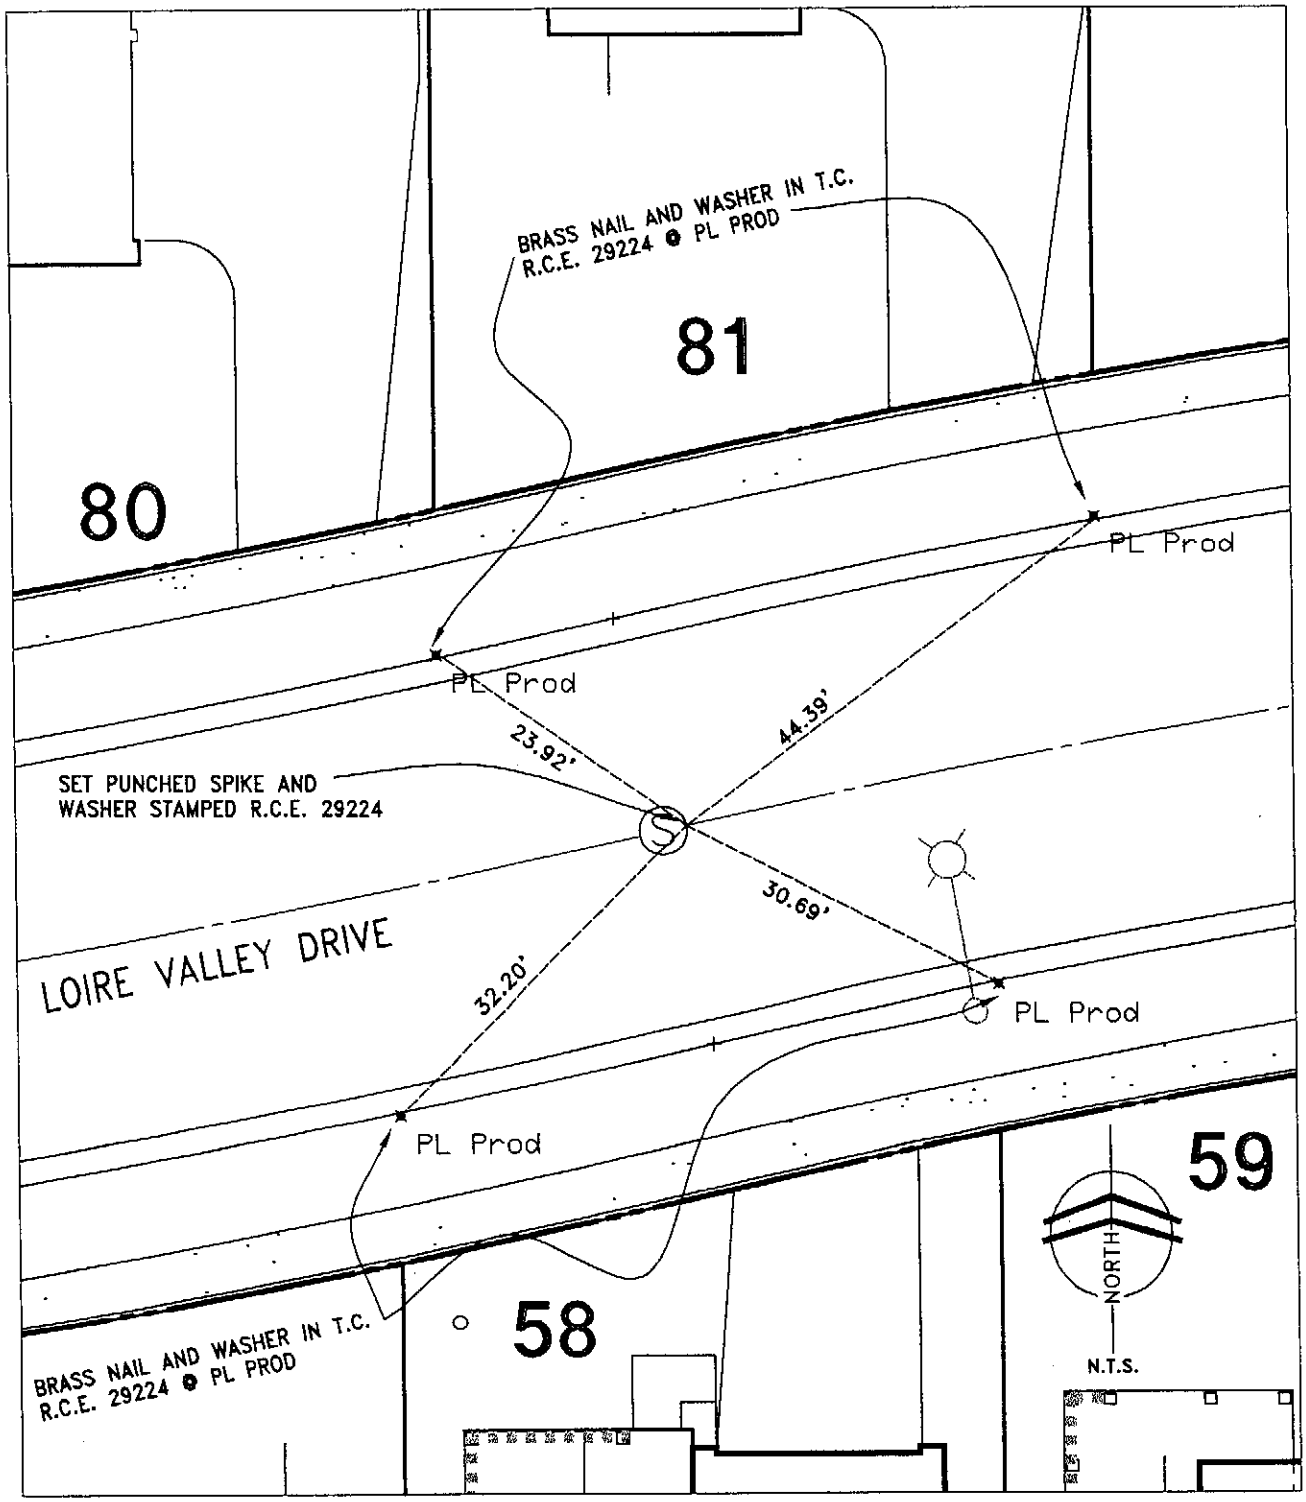

CITY OF RANCHO CUCAMONGA STREET TIES	TRACT 15711-0
Dan Guerra & Associates 10271-B TRADEMARK STREET RANCHO CUCAMONGA, CA 91730 (909) 987-4306 CIVIL ENGINEERS • LAND SURVEYORS	BOAT SPIKE AND WASHER STAMPED R.C.E. 29224, AT B.C. ON LOIRE VALLEY DRIVE, JUST EAST OF MALVASIA WAY
ENGINEER: DANIEL E. GUERRA	FIELD REVIEW: _____ DATE: _____
R.C.E. No. 29224	TIE BOOK: 24 PAGE: 10

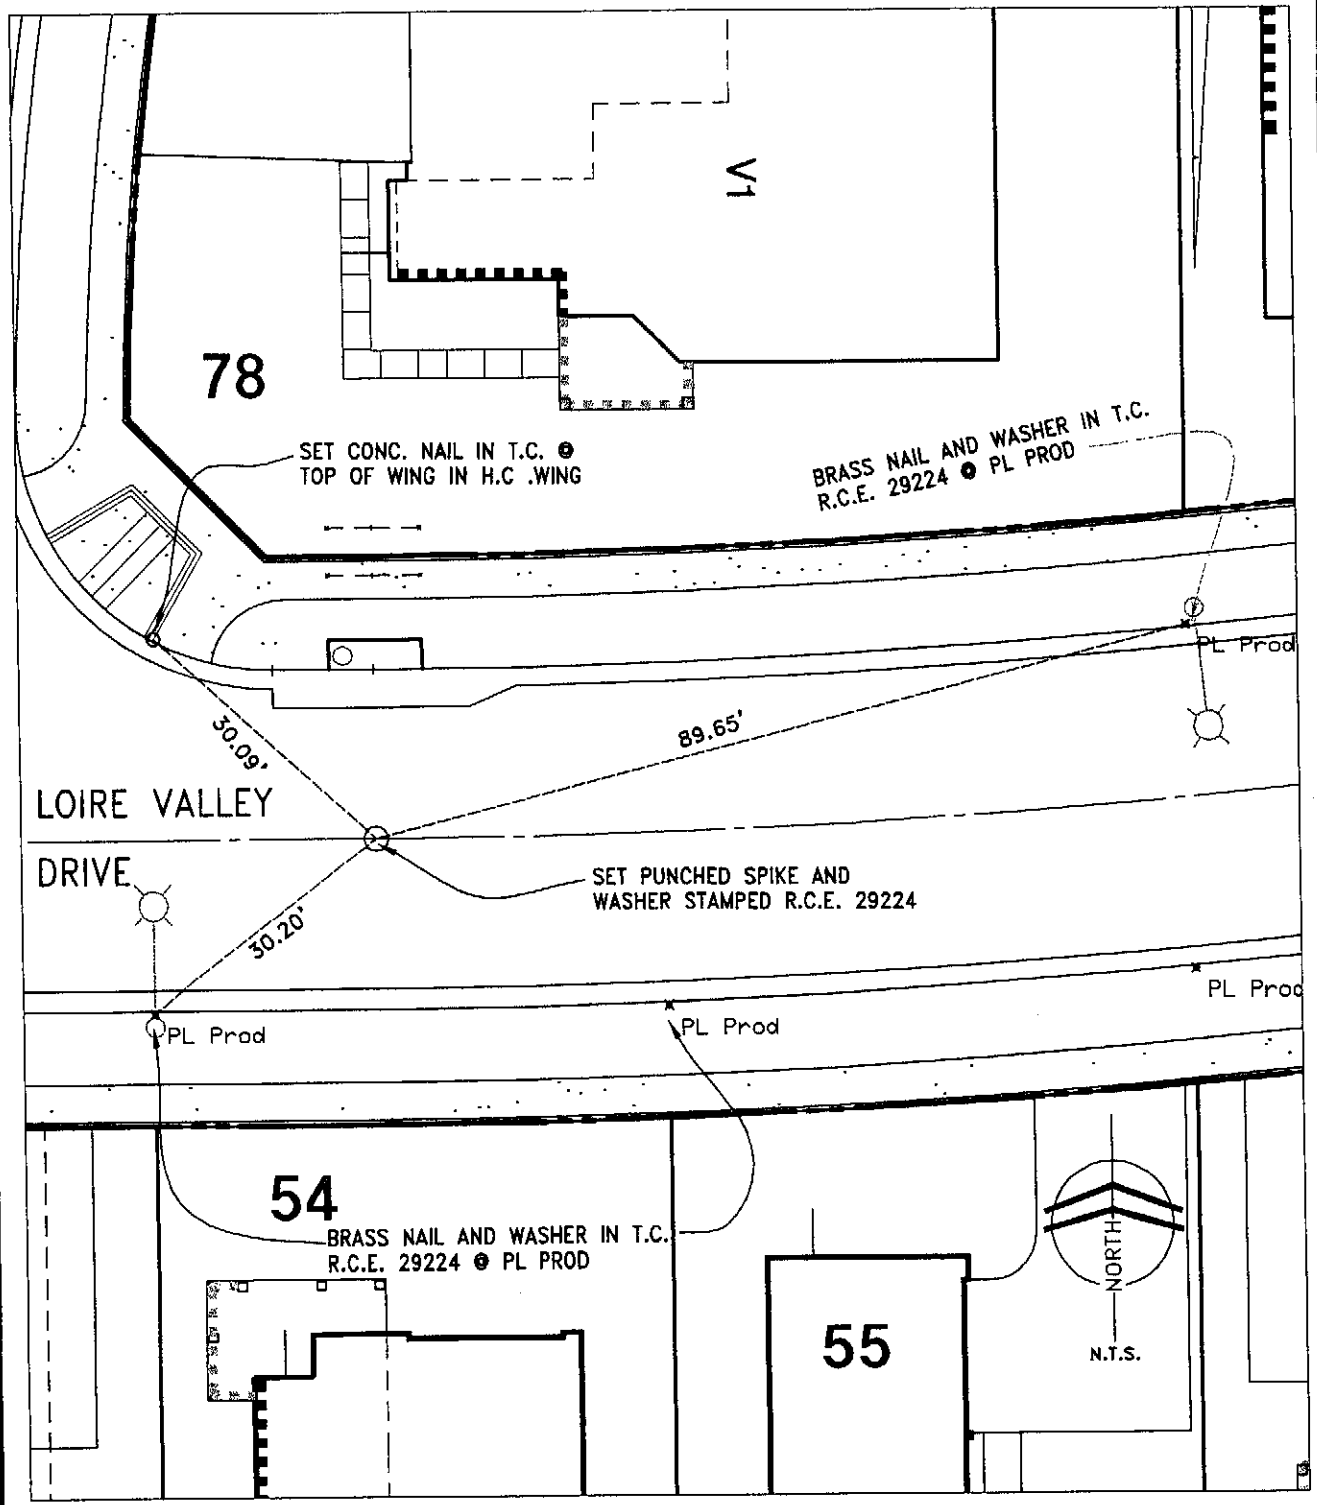

CITY OF RANCHO CUCAMONGA STREET TIES	TRACT 15711-0
Dan Guerra & Associates 10271-B TRADEMARK STREET RANCHO CUCAMONGA, CA 91730 (909) 987-4306 CIVIL ENGINEERS • LAND SURVEYORS	JUST EAST OF MALVASIA WAY ON LOIRE VALLEY DRIVE
ENGINEER: DANIEL E. GUERRA	FIELD REVIEW: _____ DATE: _____
R.C.E. No. 29224	TIE BOOK: 24 PAGE: 11

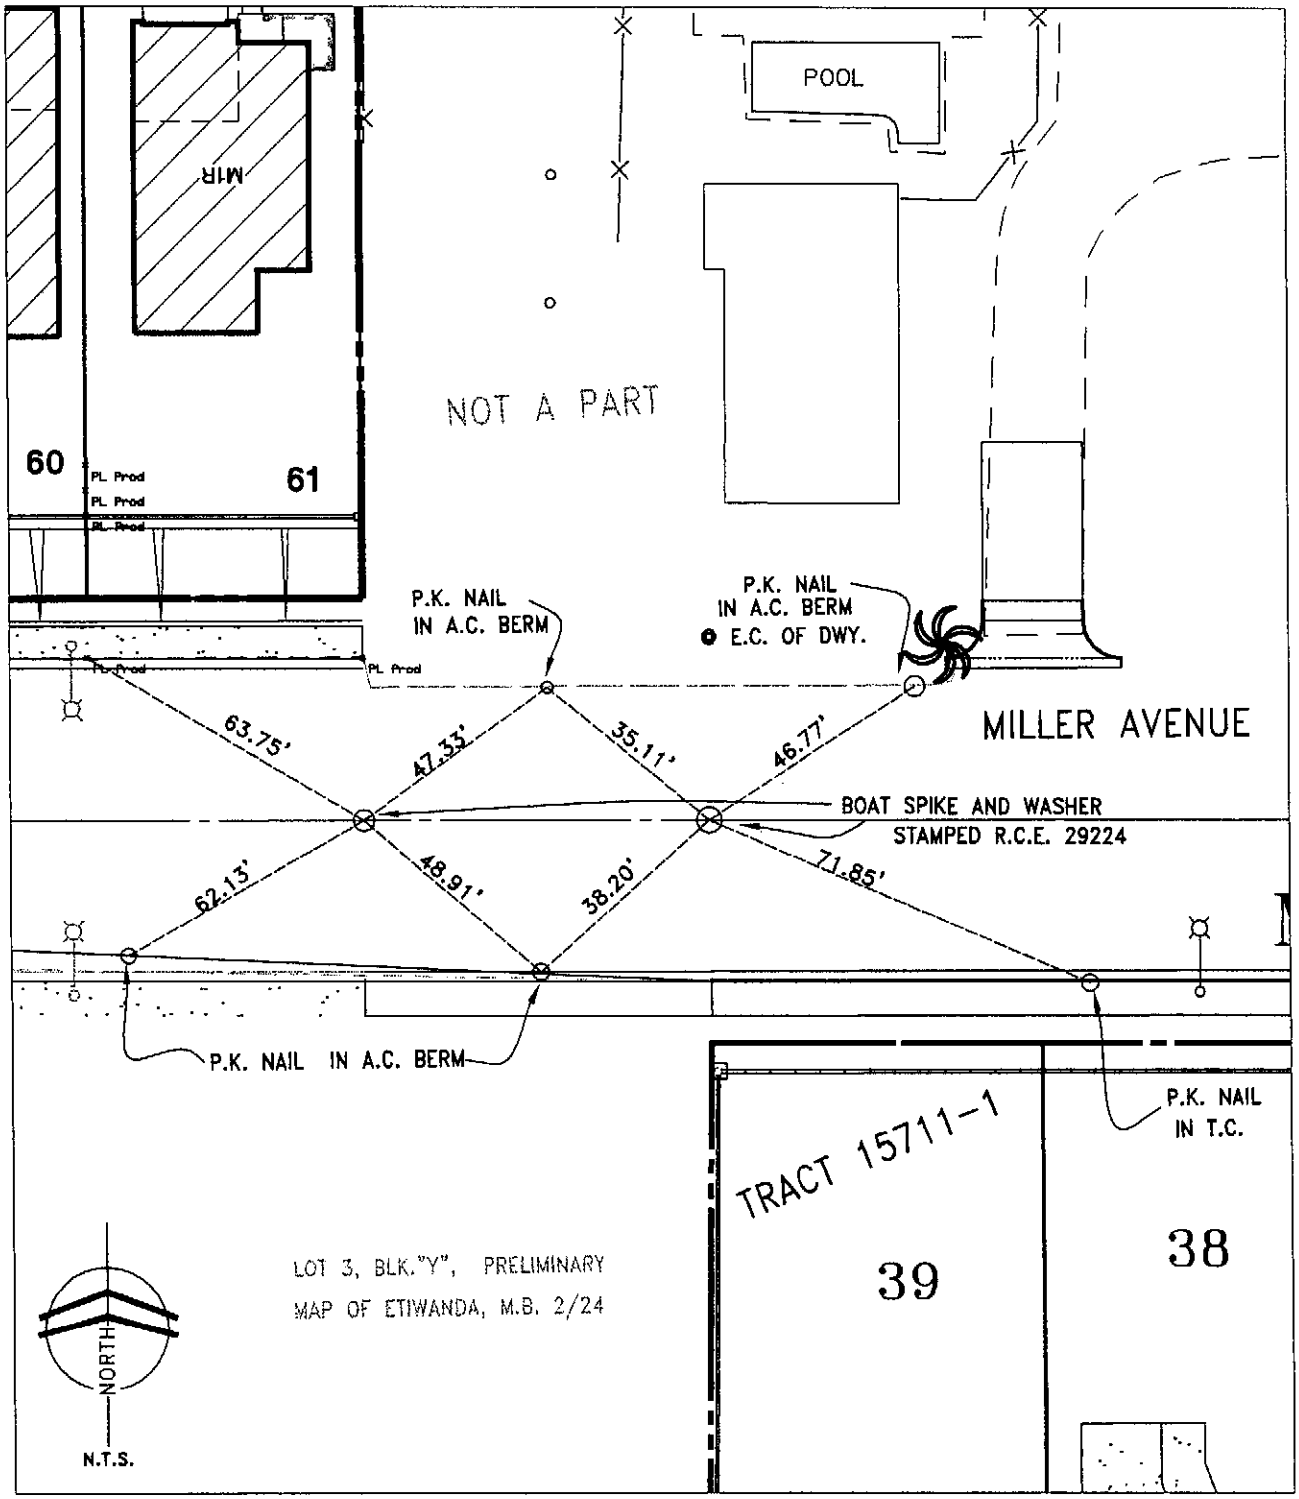

CITY OF RANCHO CUCAMONGA STREET TIES	TRACT 15711-0
Dan Guerra & Associates 10271-B TRADEMARK STREET RANCHO CUCAMONGA, CA 91730 (909) 987-4306 CIVIL ENGINEERS • LAND SURVEYORS	BOAT SPIKE AND WASHER STAMPED R.C.E. 29224 ● PROD OF WEST P.L. NOT A PART PARCEL AND TRACT 15711-0 BOAT SPIKE AND WASHER STAMPED R.C.E. 29224 ● PROD OF WEST P.L. TRACT 15711-1
ENGINEER: DANIEL E. GUERRA	FIELD REVIEW: _____ DATE: _____
R.C.E. No. 29224	TIE BOOK: 24 PAGE: 12

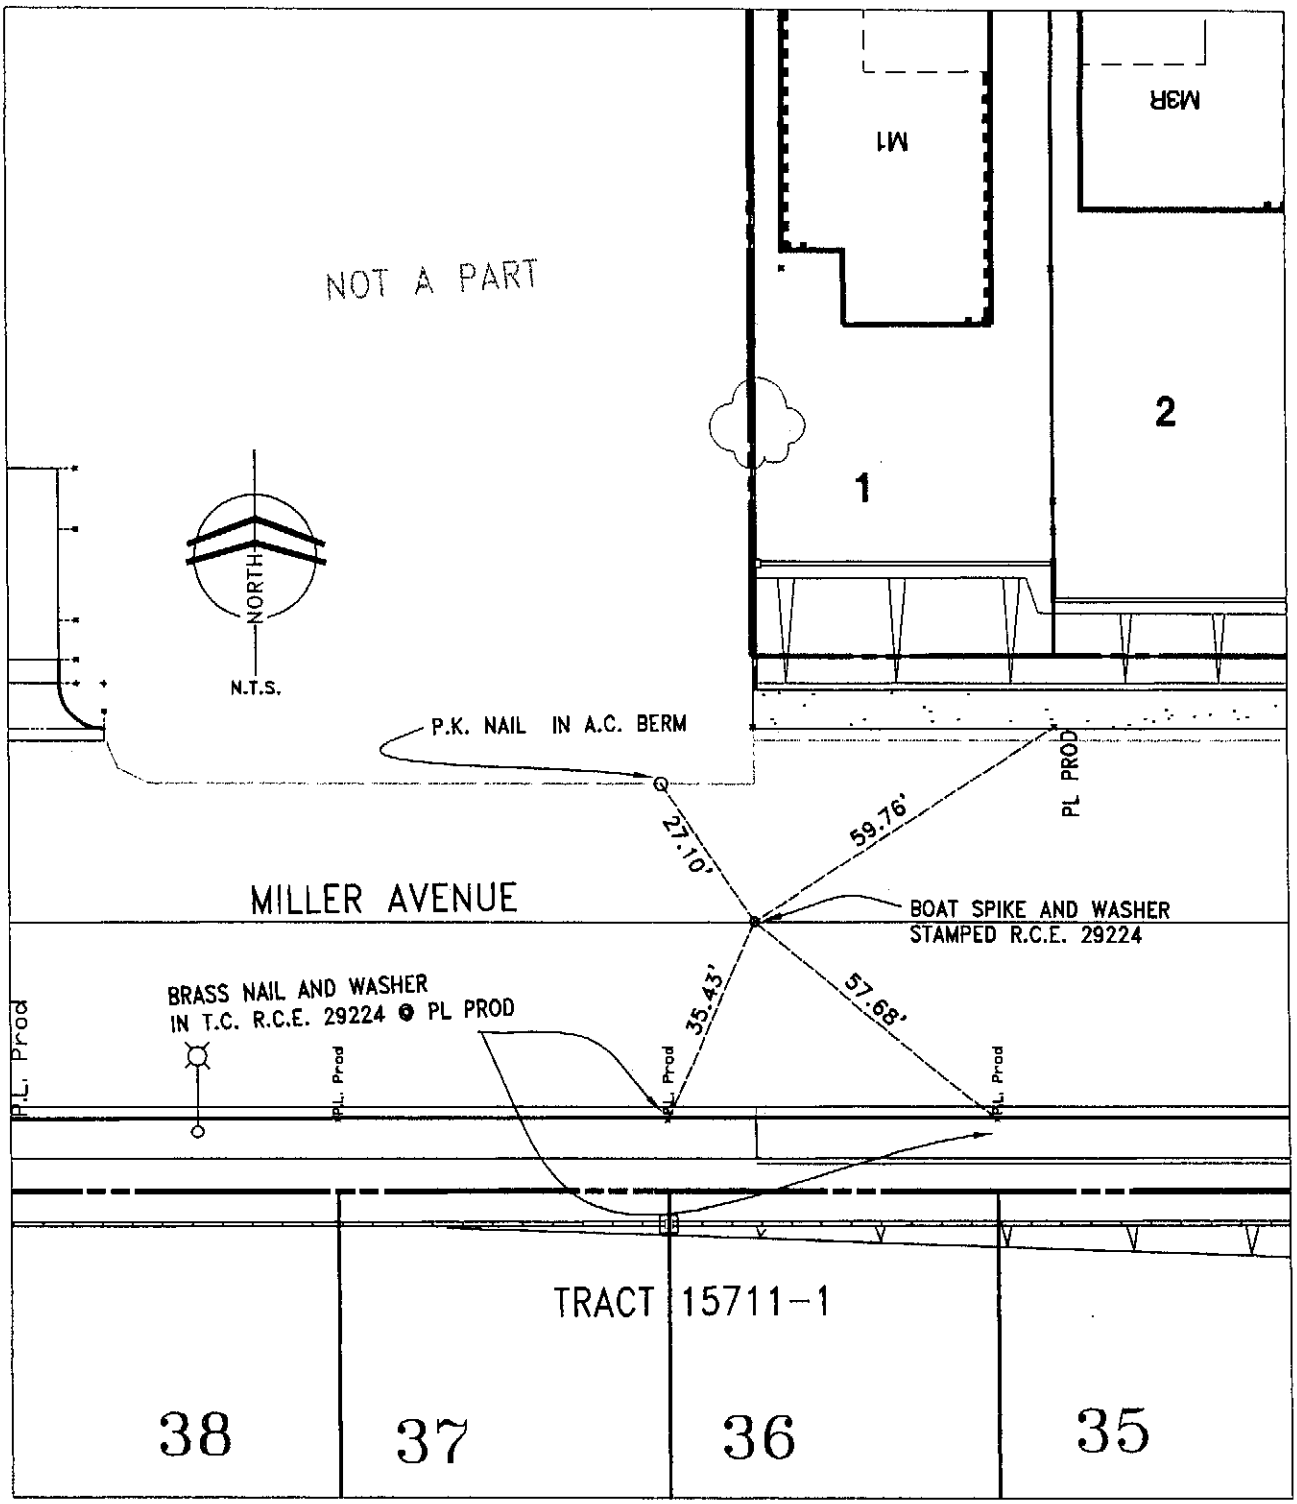

CITY OF RANCHO CUCAMONGA STREET TIES	TRACT 15711-0
Dan Guerra & Associates 10271-B TRADEMARK STREET RANCHO CUCAMONGA, CA 91730 (909) 987-4306 CIVIL ENGINEERS • LAND SURVEYORS	BOAT SPIKE AND WASHER STAMPED R.C.E. 29224 @ EAST PL PROD OF NOT A PART PARCEL AND TRACT 15711-0
ENGINEER: DANIEL E. GUERRA	FIELD REVIEW: _____ DATE: _____
R.C.E. No. 29224	TIE BOOK: 24 PAGE: 13

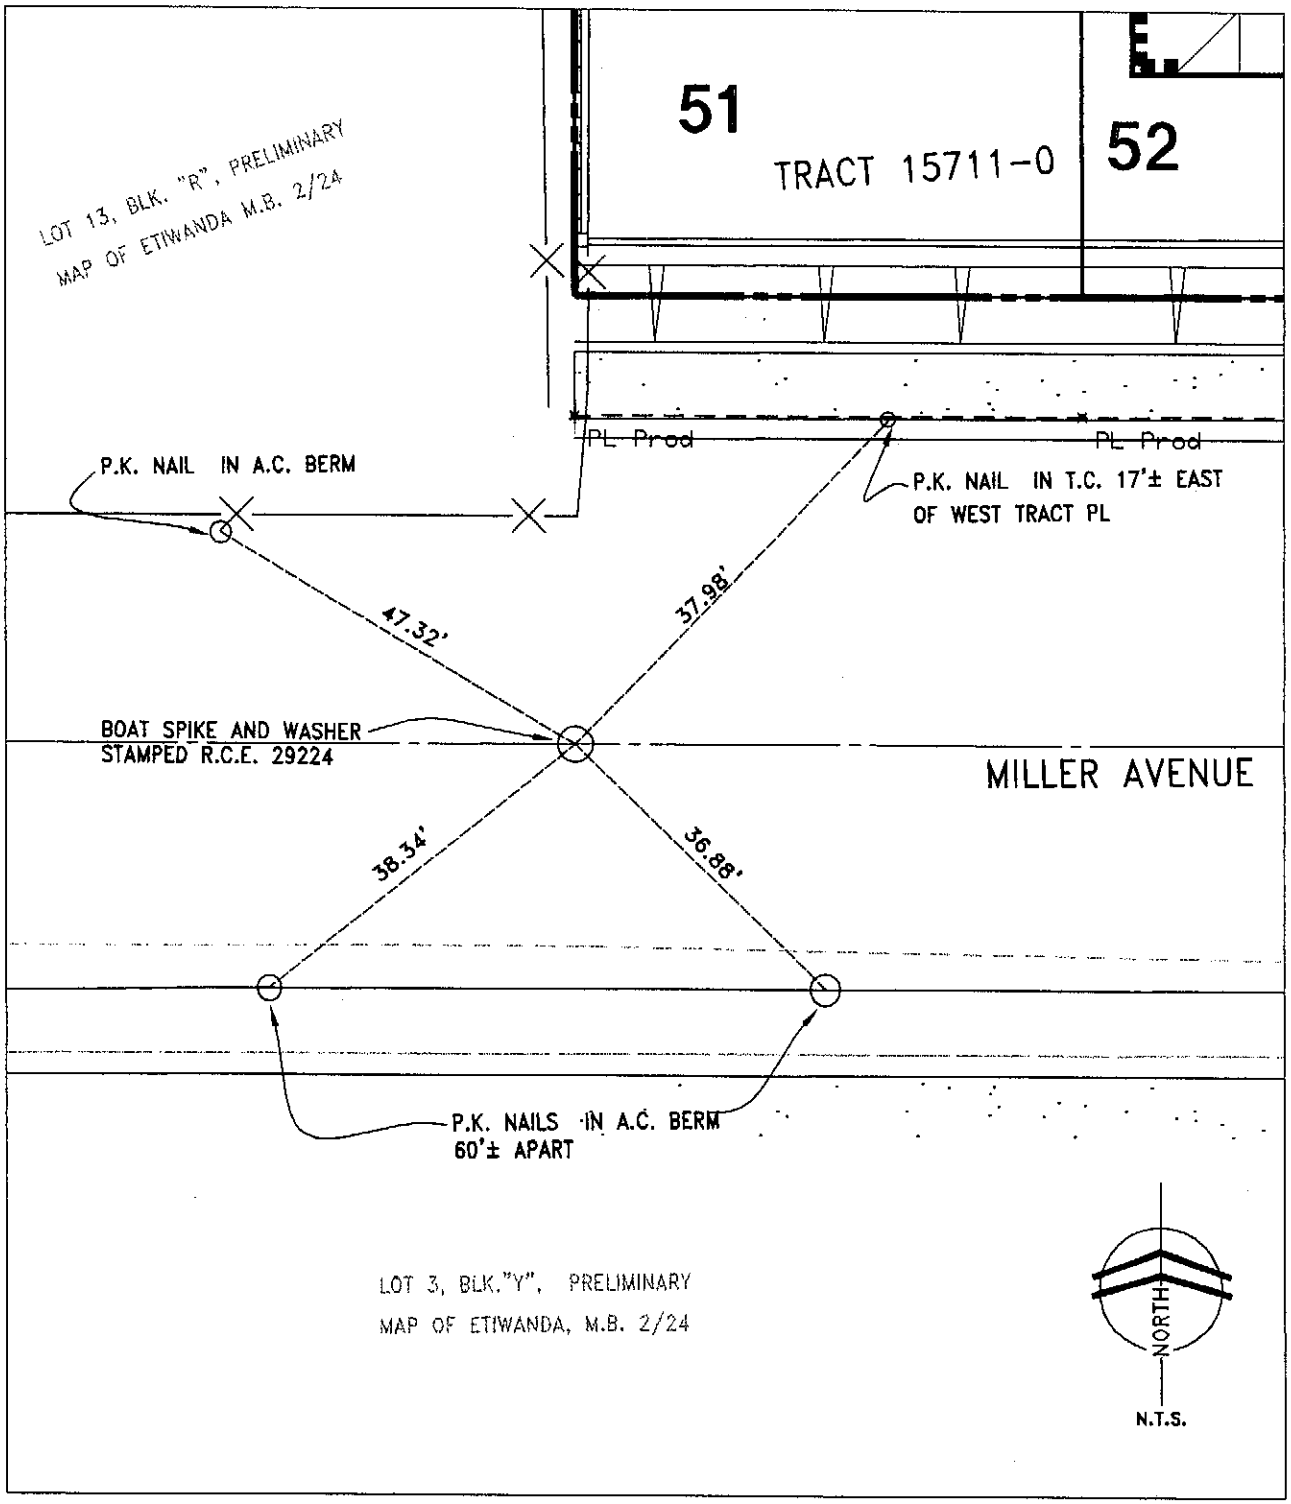

CITY OF RANCHO CUCAMONGA STREET TIES	TRACT 15711-0
Dan Guerra & Associates 10271-B TRADEMARK STREET RANCHO CUCAMONGA, CA 91730 (909) 987-4306 CIVIL ENGINEERS • LAND SURVEYORS	BOAT SPIKE AND WASHER STAMPED R.C.E. 29224 ⊙ PROD OF WEST P.L. TRACT 15711-0
ENGINEER: DANIEL E. GUERRA	FIELD REVIEW: _____ DATE: _____
R.C.E. No. 29224	TIE BOOK: 24 PAGE: 14

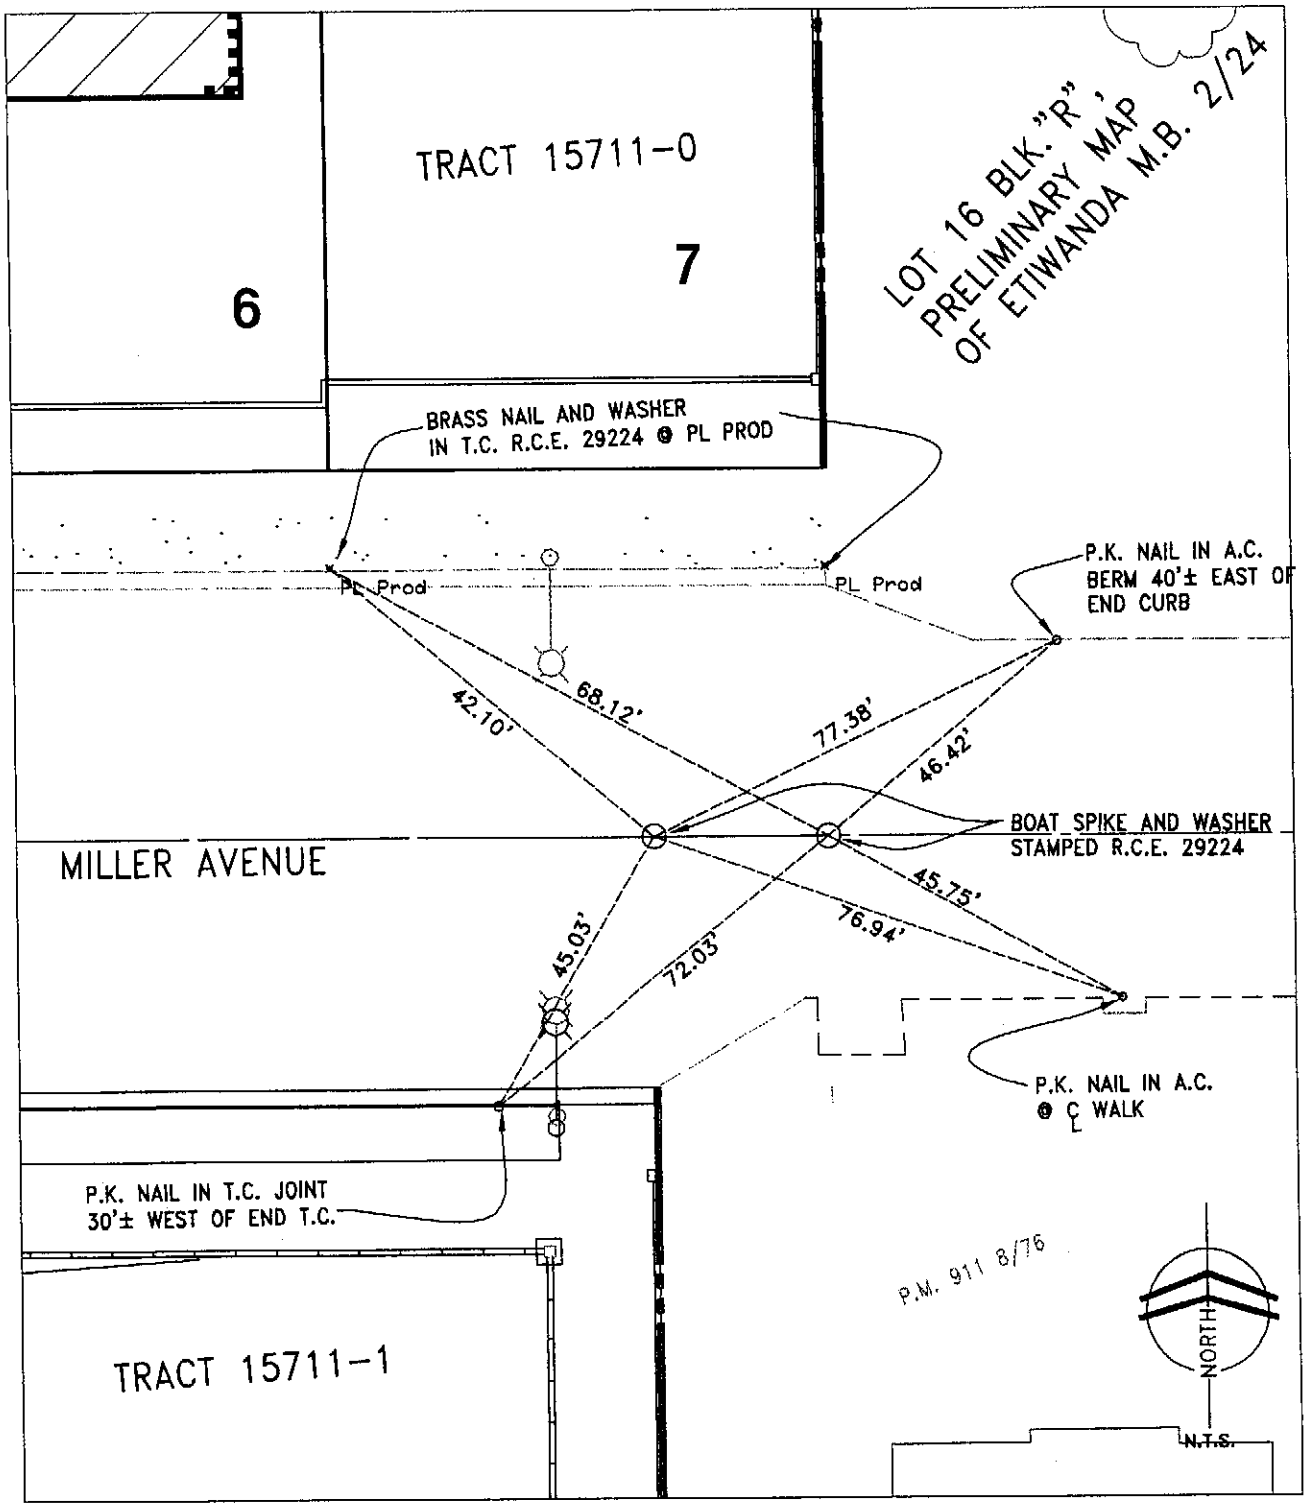

CITY OF RANCHO CUCAMONGA STREET TIES	TRACT 15711-0
Dan Guerra & Associates 10271-B TRADEMARK STREET RANCHO CUCAMONGA, CA 91730 (909) 987-4306 CIVIL ENGINEERS • LAND SURVEYORS	BOAT SPIKE AND WASHER STAMPED R.C.E. 29224 @ PROD OF EAST P.L. TRACT 15711-1. BOAT SPIKE AND WASHER STAMPED R.C.E. 29224 @PROD OF EAST P.L. TRACT 15711-0
ENGINEER: DANIEL E. GUERRA	FIELD REVIEW: _____ DATE: _____
R.C.E. No. 29224	TIE BOOK: 24 PAGE: 15

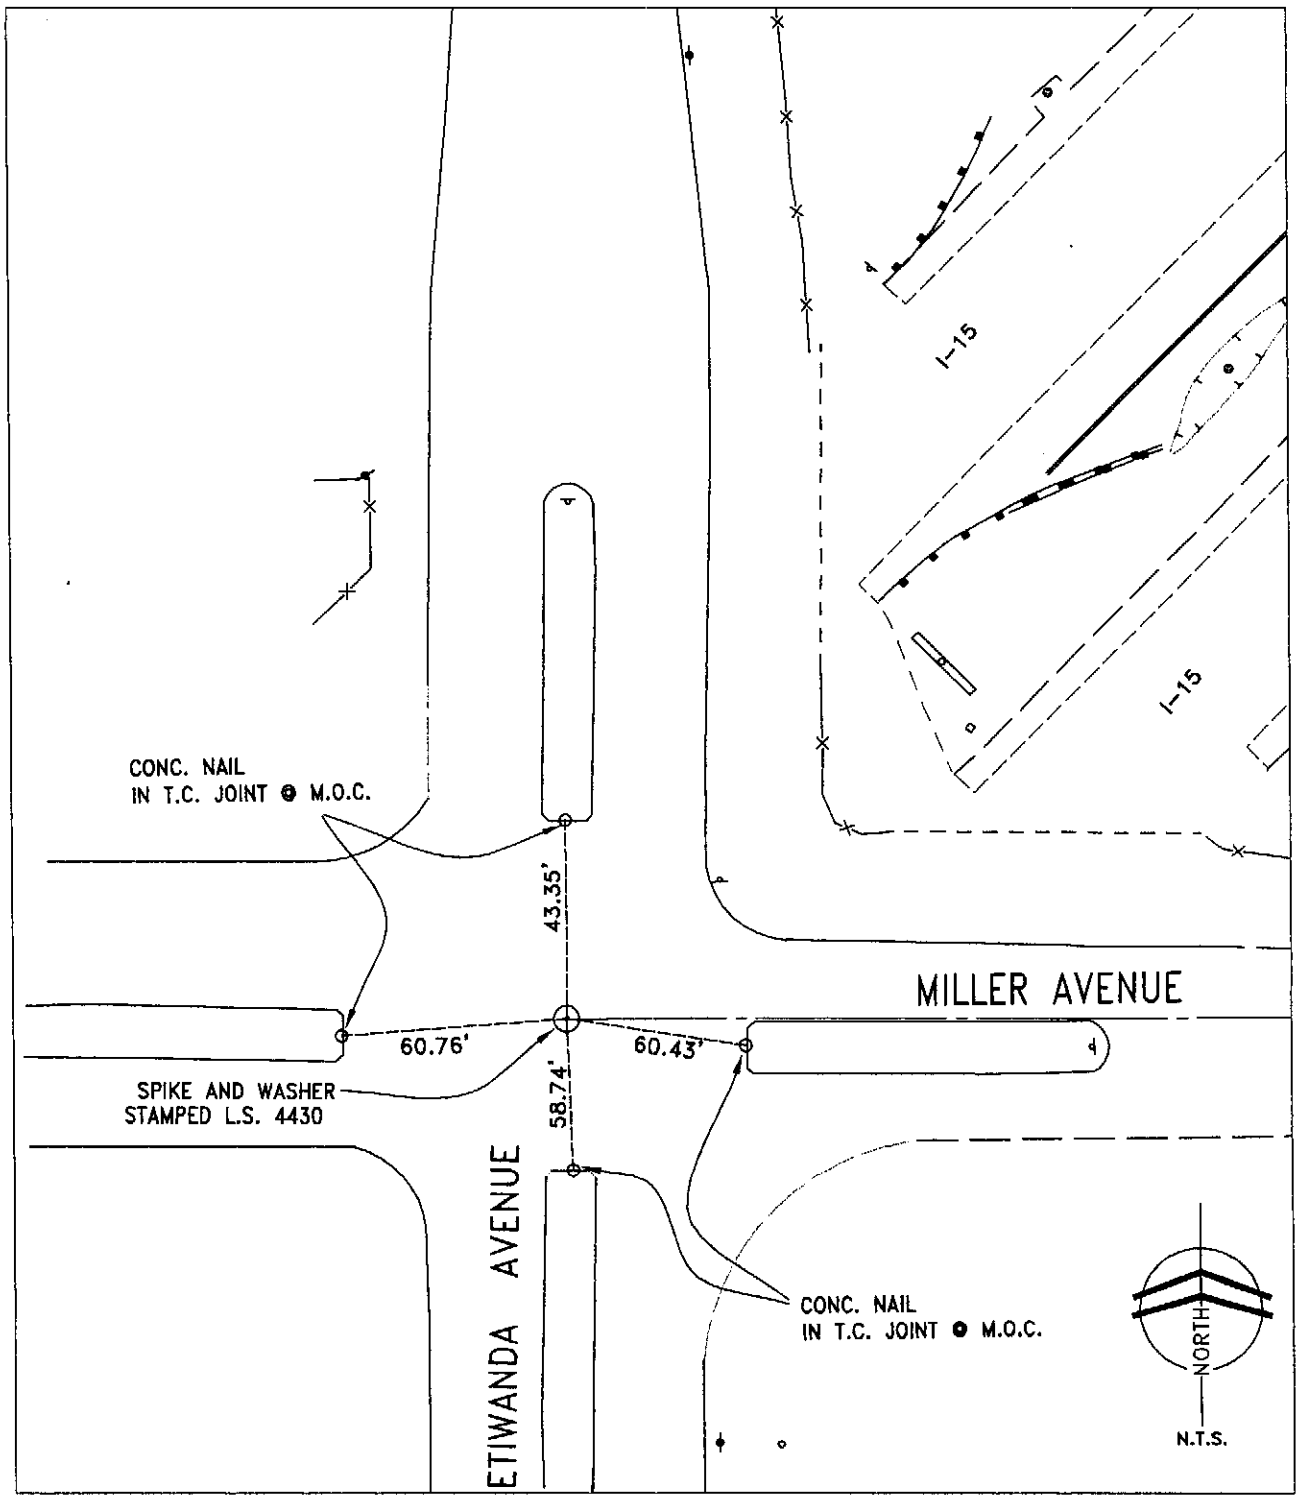

CITY OF RANCHO CUCAMONGA STREET TIES	TRACT 15711-0
Dan Guerra & Associates 10271-B TRADEMARK STREET RANCHO CUCAMONGA, CA 91730 (909) 987-4306 CIVIL ENGINEERS • LAND SURVEYORS	BOAT SPIKE AND WASHER STAMPED L.S. 4430 ⊙ CENTERLINE INTERSECTION MILLER AVENUE AND ETIWANDA AVENUE
ENGINEER: DANIEL E. GUERRA	FIELD REVIEW: _____ DATE: _____
R.C.E. No. 29224	TIE BOOK: 24 PAGE: 16

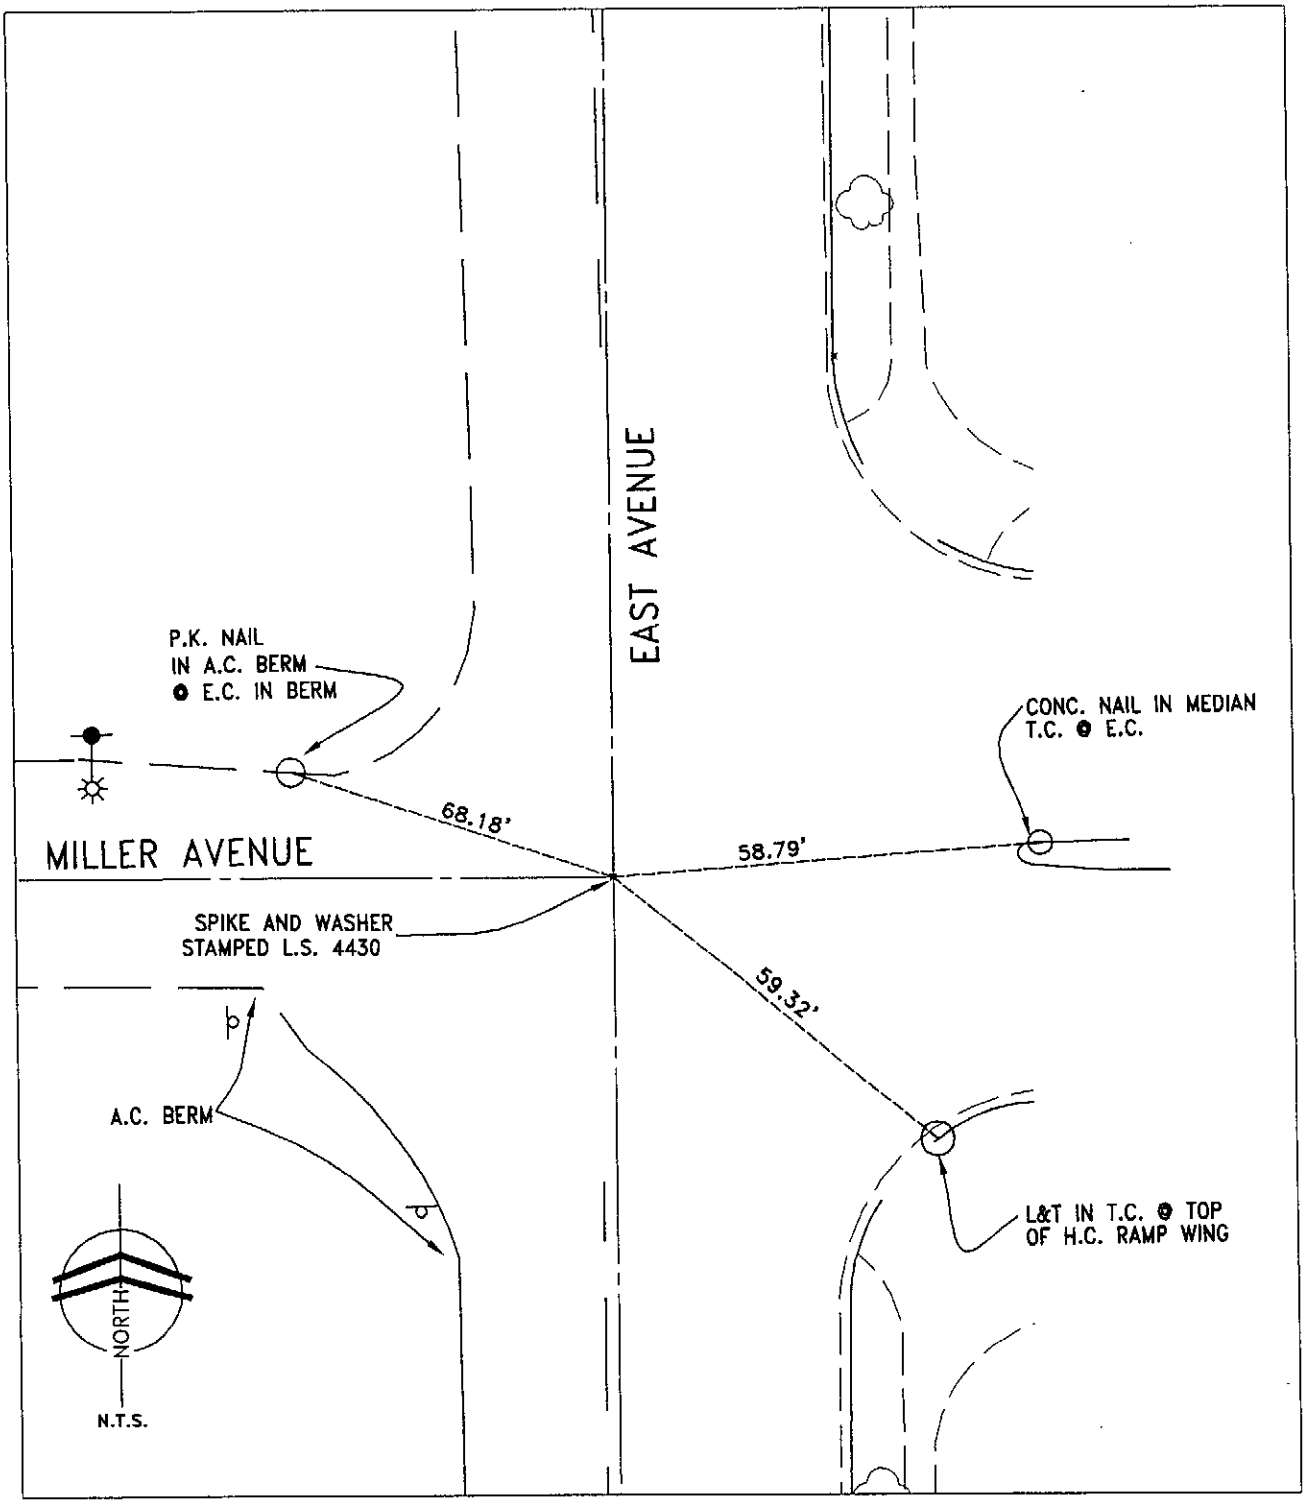

CITY OF RANCHO CUCAMONGA STREET TIES	TRACT 15711-0
Dan Guerra & Associates 10271-B TRADEMARK STREET RANCHO CUCAMONGA, CA 91730 (909) 987-4306 CIVIL ENGINEERS • LAND SURVEYORS	SPIKE AND WASHER STAMPED L.S. 4430 ● CENTERLINE INTERSECTION EAST AVENUE AND MILLER AVENUE
ENGINEER: DANIEL E. GUERRA	FIELD REVIEW: _____ DATE: _____
R.C.E. No. 29224	TIE BOOK: 24 PAGE: 17

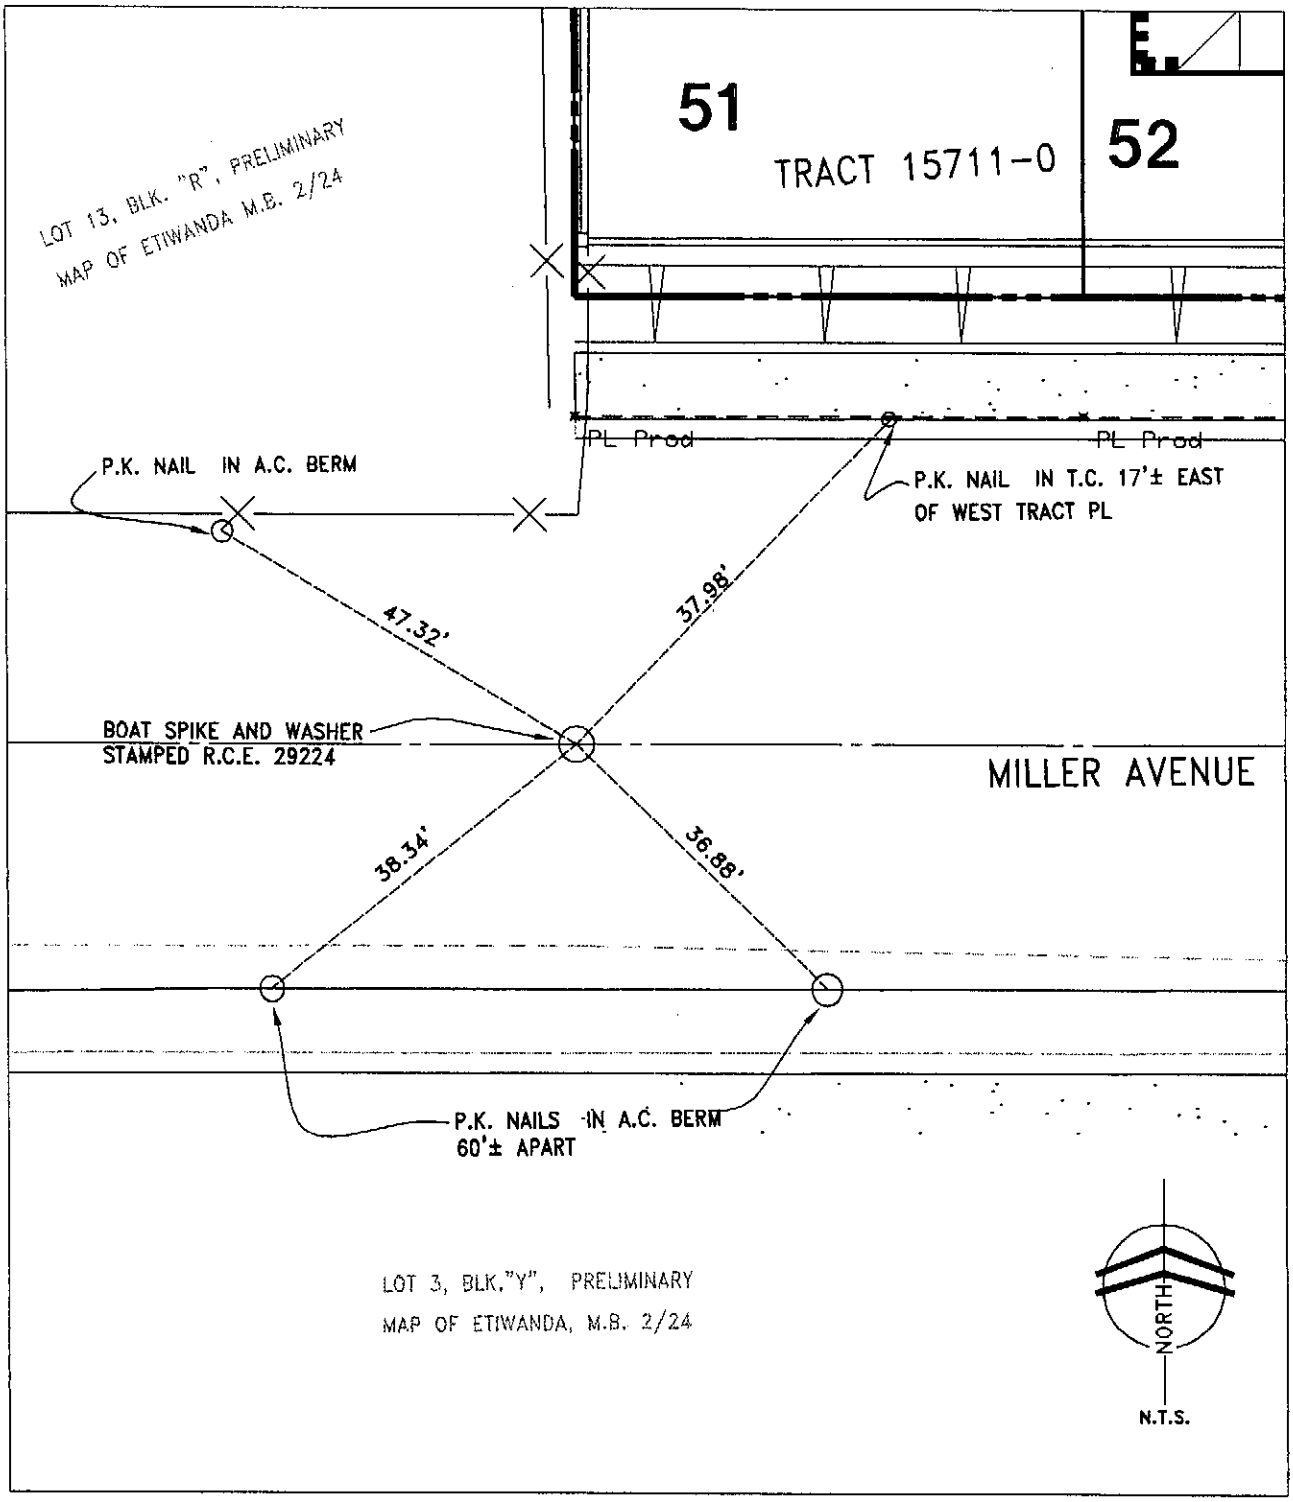

CITY OF RANCHO CUCAMONGA STREET TIES	TRACT 15711-0
Dan Guerra & Associates 10271-B TRADEMARK STREET RANCHO CUCAMONGA, CA 91730 (909) 987-4306 CIVIL ENGINEERS • LAND SURVEYORS	BOAT SPIKE AND WASHER STAMPED R.C.E. 29224 ⊙ PROD OF WEST P.L. TRACT 15711-0
ENGINEER: DANIEL E. GUERRA	FIELD REVIEW: _____ DATE: _____
R.C.E. No. 29224	TIE BOOK: 24 PAGE: 18

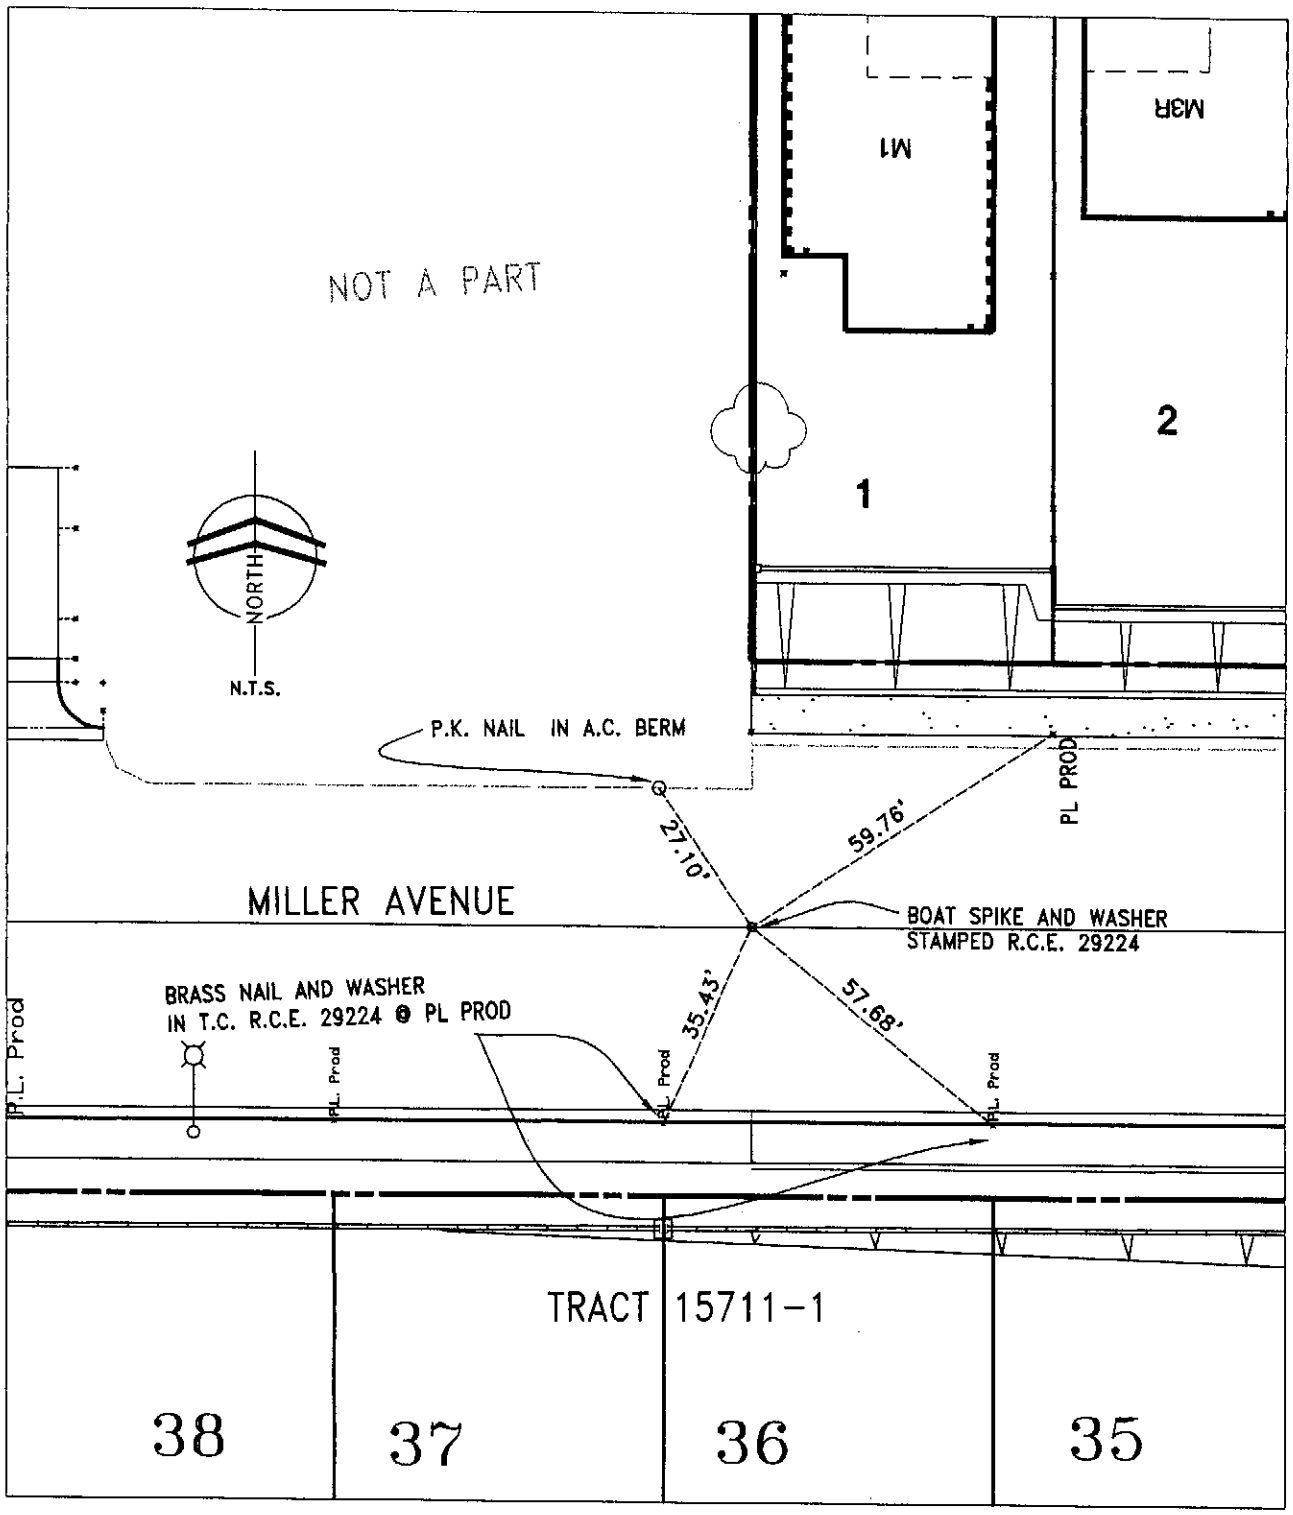

CITY OF RANCHO CUCAMONGA STREET TIES	TRACT 15711-0
Dan Guerra & Associates 10271-B TRADEMARK STREET RANCHO CUCAMONGA, CA 91730 (909) 987-4306 CIVIL ENGINEERS • LAND SURVEYORS	BOAT SPIKE AND WASHER STAMPED R.C.E. 29224 @ EAST PL PROD OF NOT A PART PARCEL AND TRACT 15711-0
ENGINEER: DANIEL E. GUERRA	FIELD REVIEW: _____ DATE: _____
R.C.E. No. 29224	TIE BOOK: 24 PAGE: 19

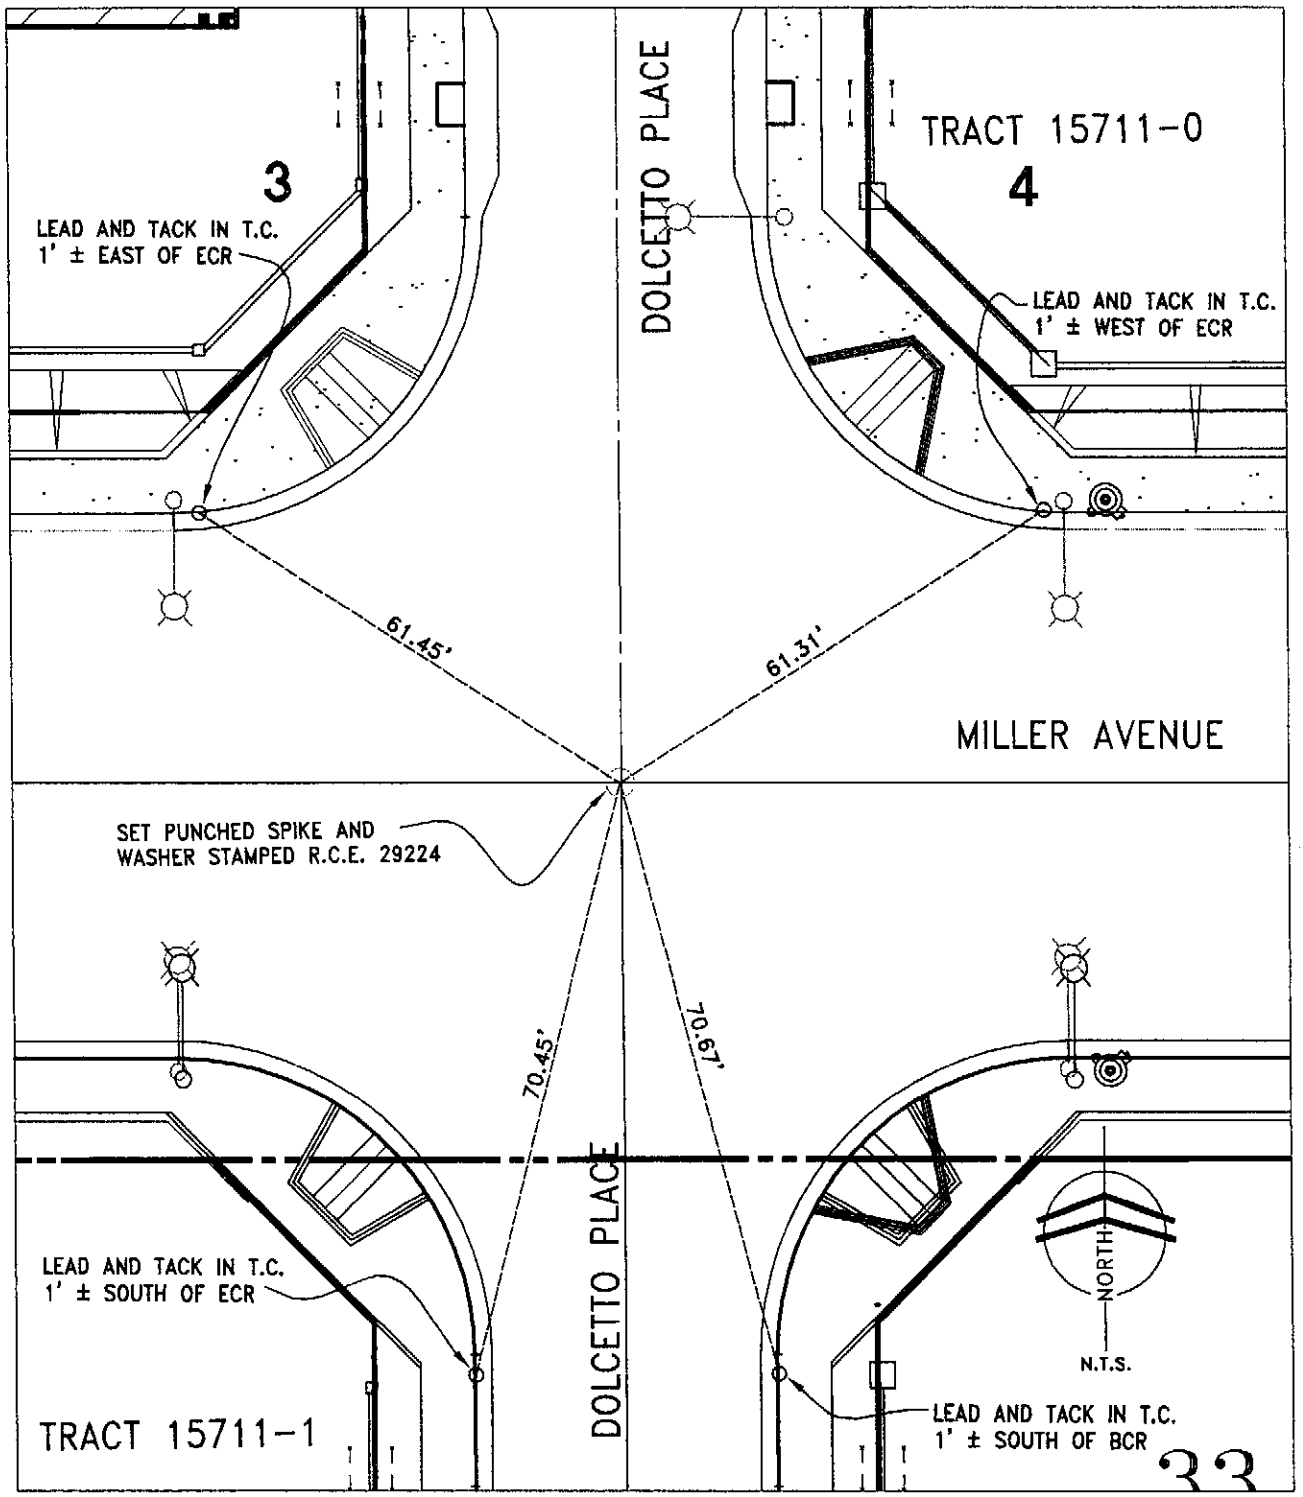

CITY OF RANCHO CUCAMONGA STREET TIES	TRACT 15711-1
Dan Guerra & Associates 10271-B TRADEMARK STREET RANCHO CUCAMONGA, CA 91730 (909) 987-4306 CIVIL ENGINEERS • LAND SURVEYORS	AT CENTERLINE INTERSECTION OF DOLCETTO PLACE AND MILLER AVENUE
ENGINEER: DANIEL E. GUERRA	FIELD REVIEW: _____ DATE: _____
R.C.E. No. 29224	TIE BOOK: 24 PAGE: 20

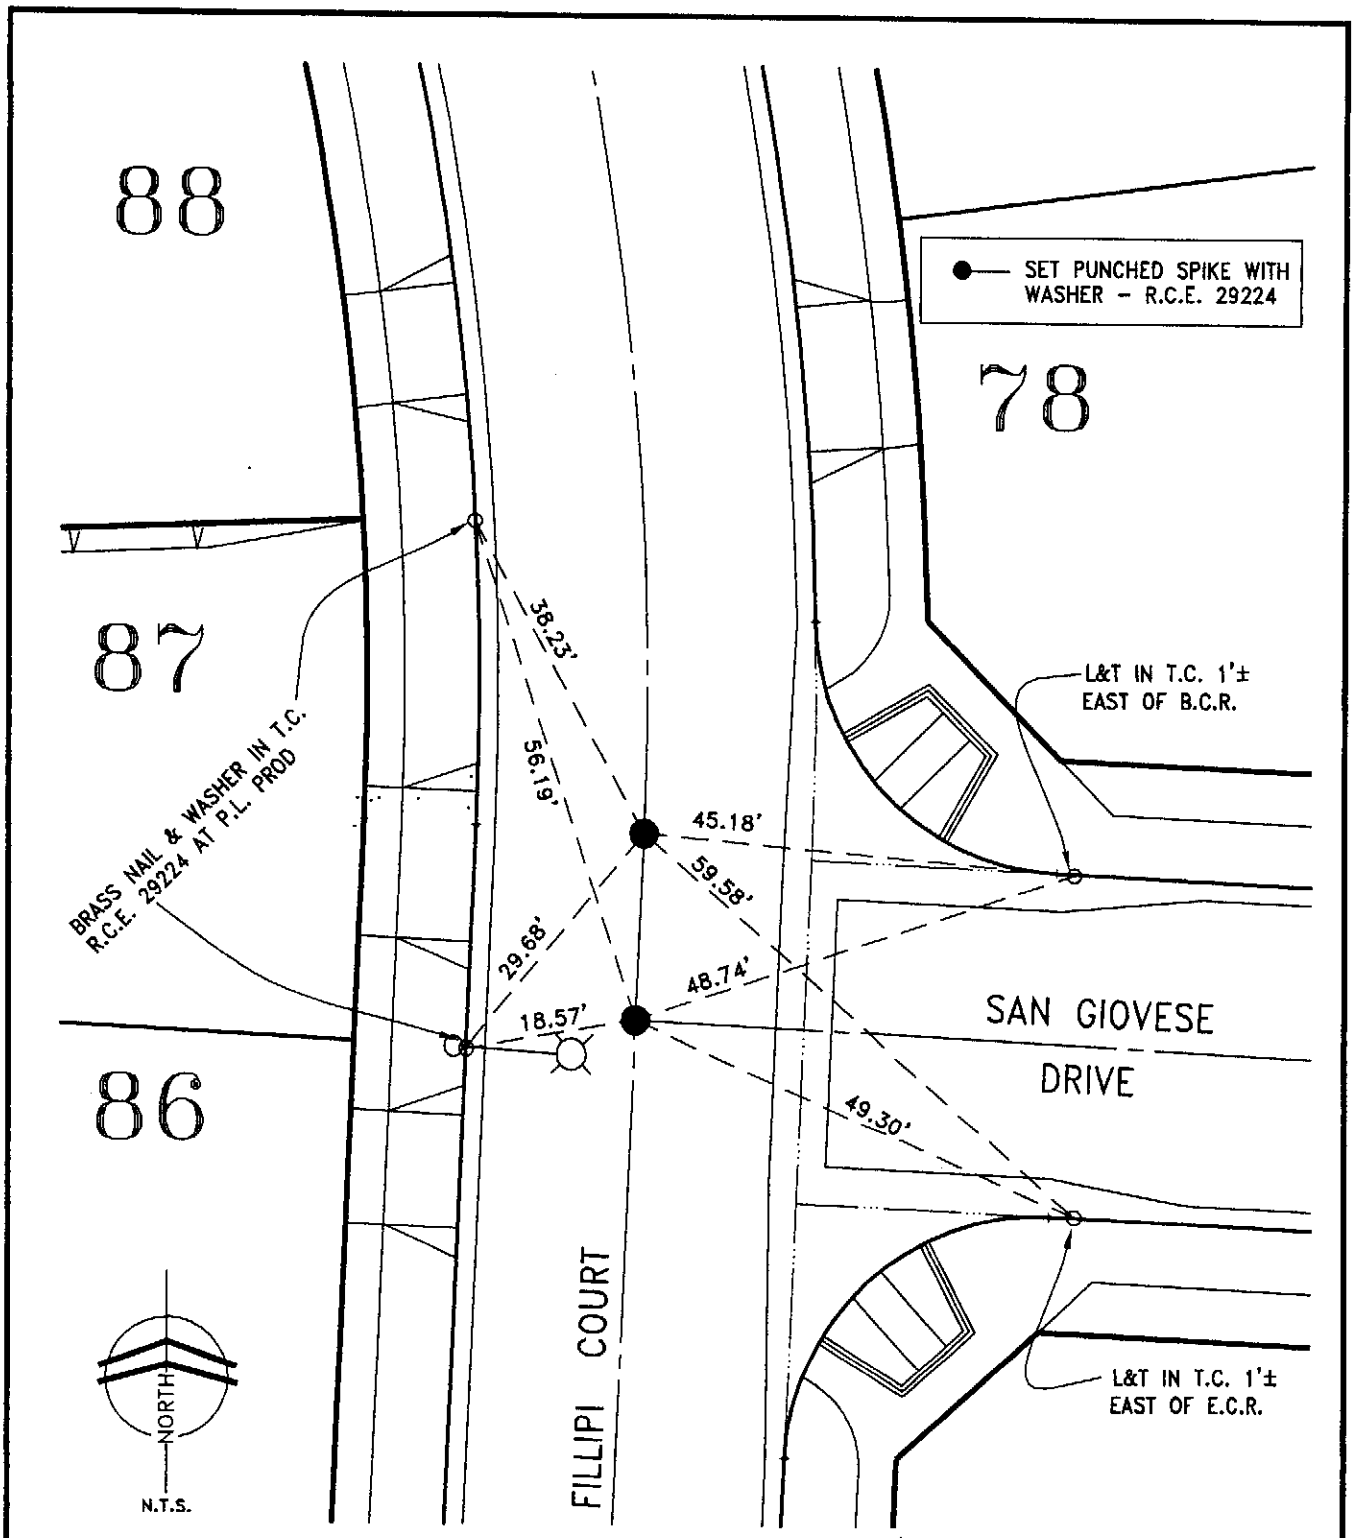

CITY OF RANCHO CUCAMONGA STREET TIES	TRACT NO. 15711-1
Dan Guerra & Associates 10271-B TRADEMARK STREET RANCHO CUCAMONGA, CA 91730 (909) 987-4306 CIVIL ENGINEERS • LAND SURVEYORS	AT INTERSECTION OF SAN GIOVESE DRIVE AND FILLIPI COURT AT B.C. ON FILLIPI COURT
ENGINEER: DANIEL E. GUERRA	FIELD REVIEW: _____ DATE: _____
R.C.E. No. 29224	TIE BOOK: 24 PAGE: 21

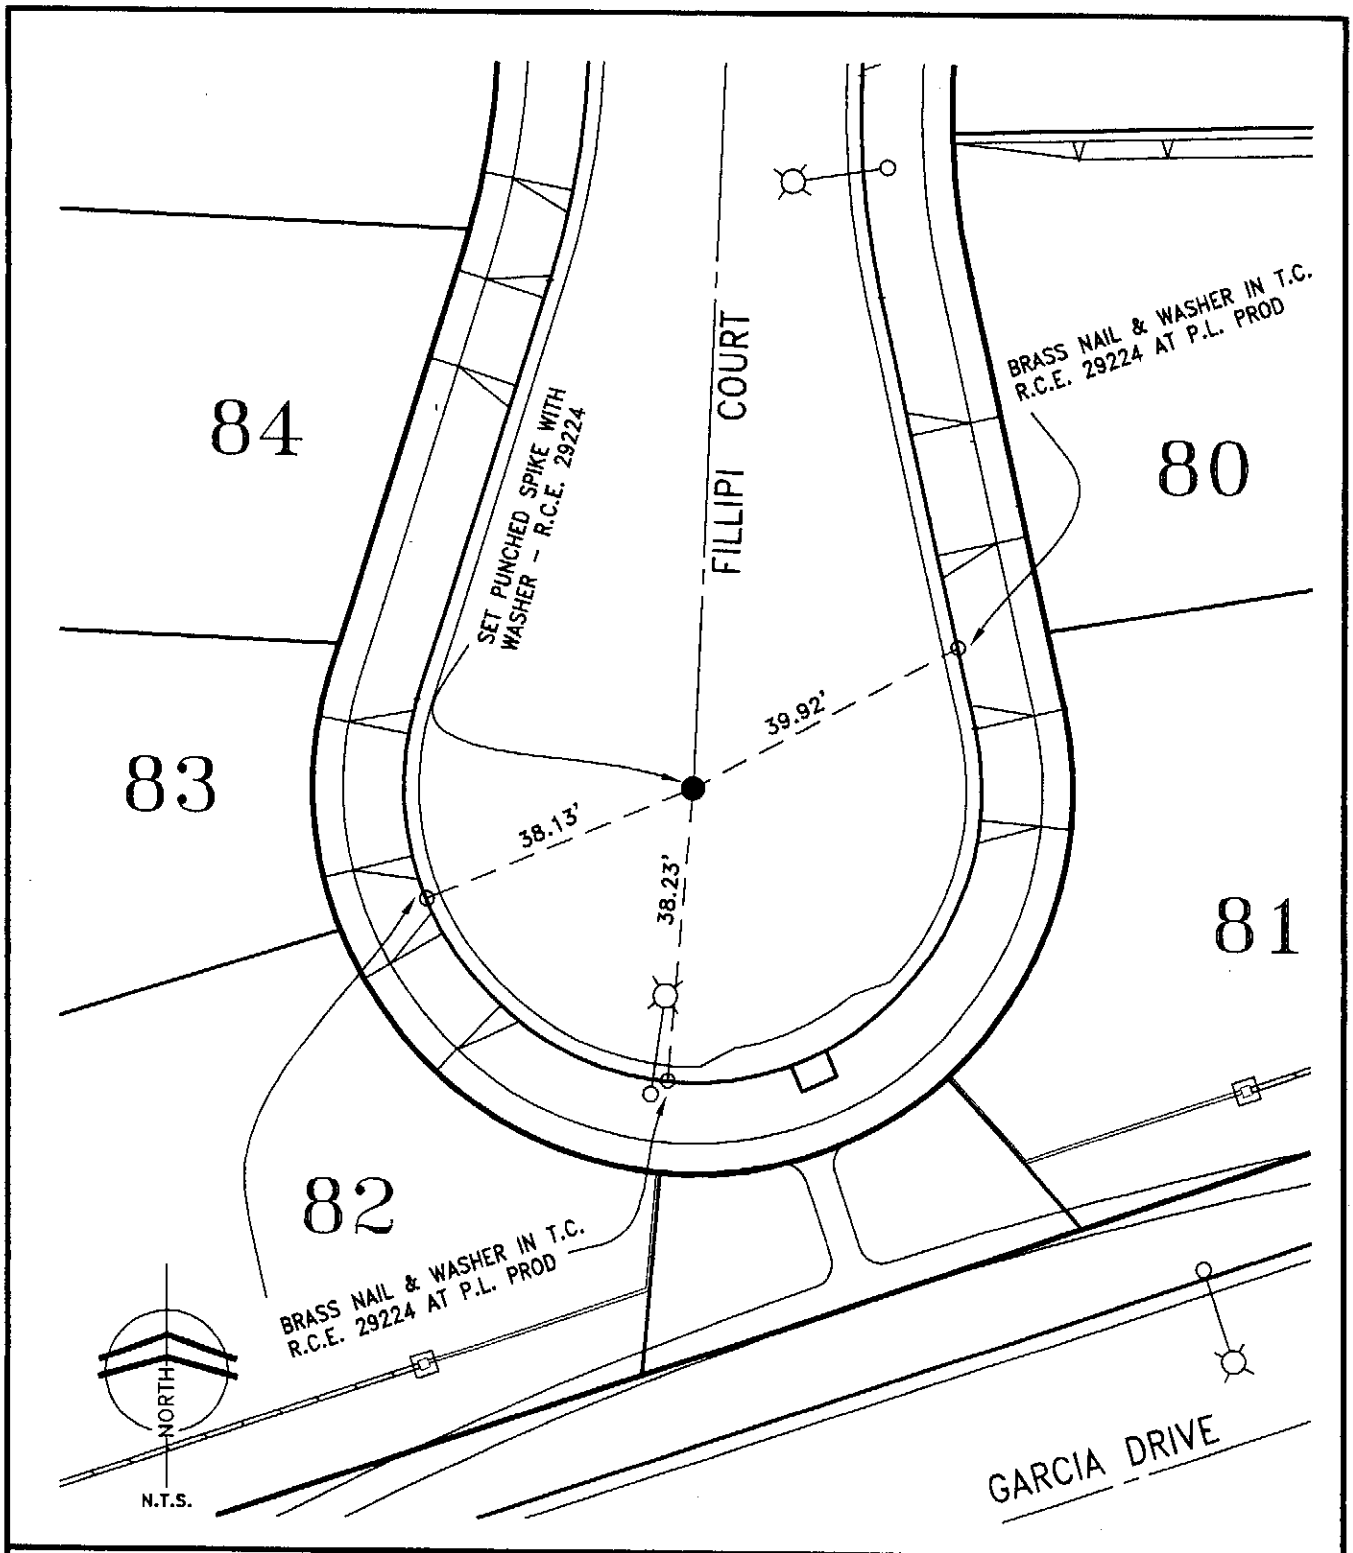

CITY OF RANCHO CUCAMONGA STREET TIES	TRACT NO. 15711-1
Dan Guerra & Associates 10271-B TRADEMARK STREET RANCHO CUCAMONGA, CA 91730 (909) 987-4306 CIVIL ENGINEERS • LAND SURVEYORS	AT CUL-DE-SAC OF FILLIPI COURT
ENGINEER: DANIEL E. GUERRA	FIELD REVIEW: _____ DATE: _____
R.C.E. No. 29224	TIE BOOK: 24 PAGE: 22

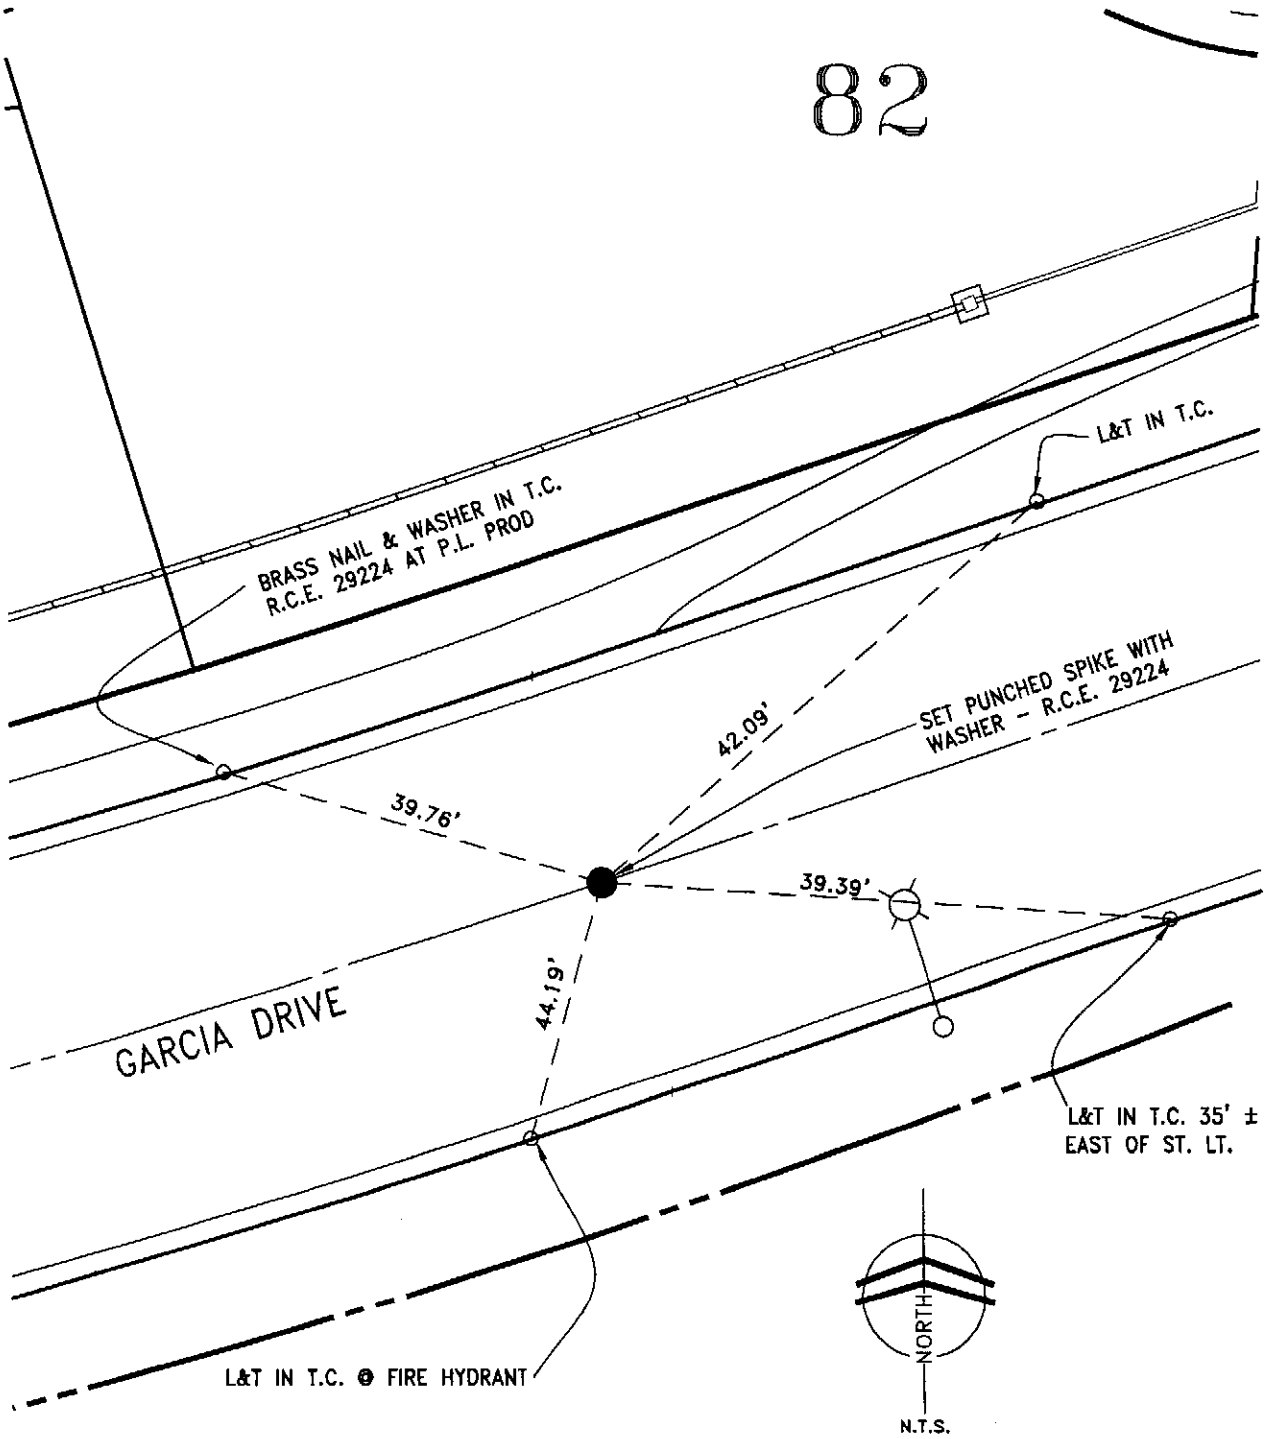

CITY OF RANCHO CUCAMONGA STREET TIES	TRACT 15711-1
Dan Guerra & Associates 10271-B TRADEMARK STREET RANCHO CUCAMONGA, CA 91730 (909) 987-4306 CIVIL ENGINEERS • LAND SURVEYORS	AT E.C. ON GARCIA DRIVE, BETWEEN FILLIPI COURT, AND RHEIN COURT
ENGINEER: DANIEL E. GUERRA	FIELD REVIEW: _____ DATE: _____
R.C.E. No. 29224	TIE BOOK: 24 PAGE: 23

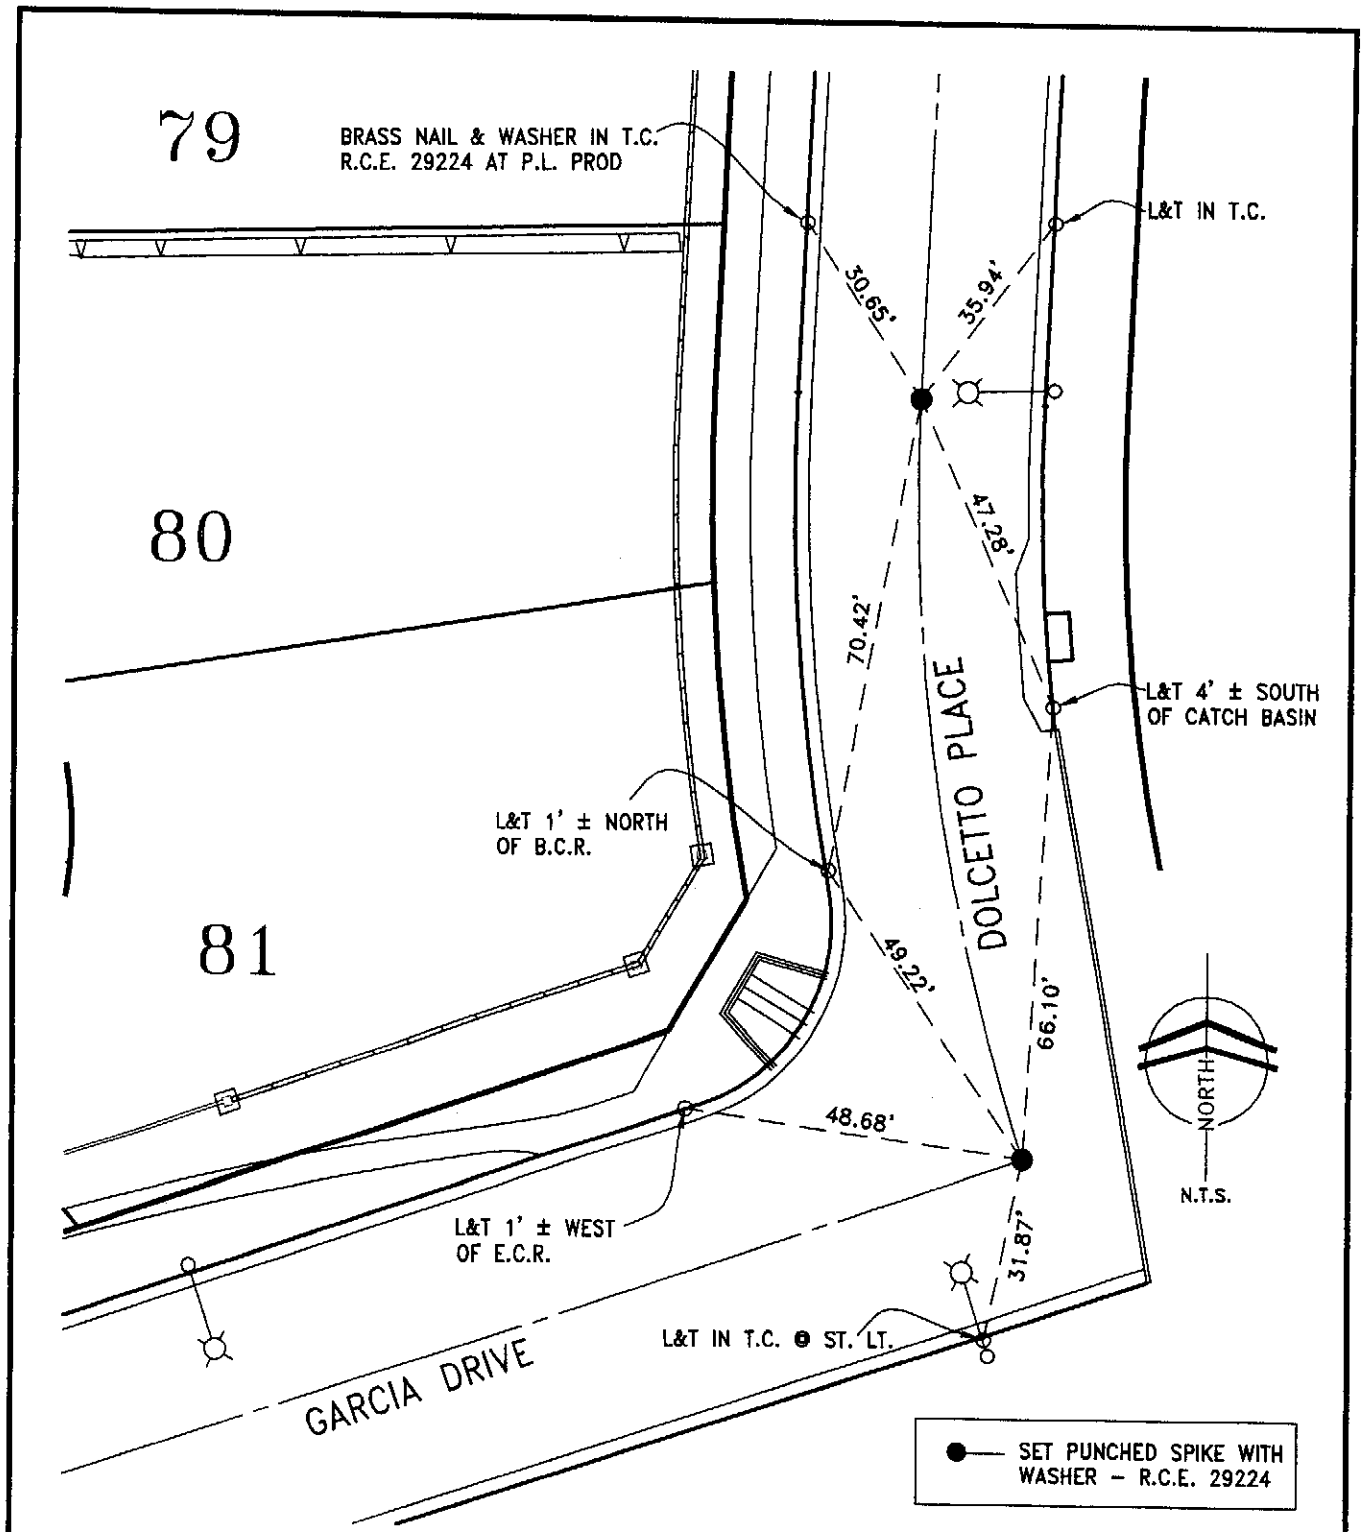

CITY OF RANCHO CUCAMONGA STREET TIES	TRACT 15711-1
Dan Guerra & Associates 10271-B TRADEMARK STREET RANCHO CUCAMONGA, CA 91730 (909) 987-4306 CIVIL ENGINEERS • LAND SURVEYORS	AT THE INTERSECTION OF DOLCETTO PLACE AND GARCIA DRIVE AT E.C. ON DOLCETTO PLACE
ENGINEER: DANIEL E. GUERRA	FIELD REVIEW: _____ DATE: _____
R.C.E. No. 29224	TIE BOOK: 24 PAGE: 24

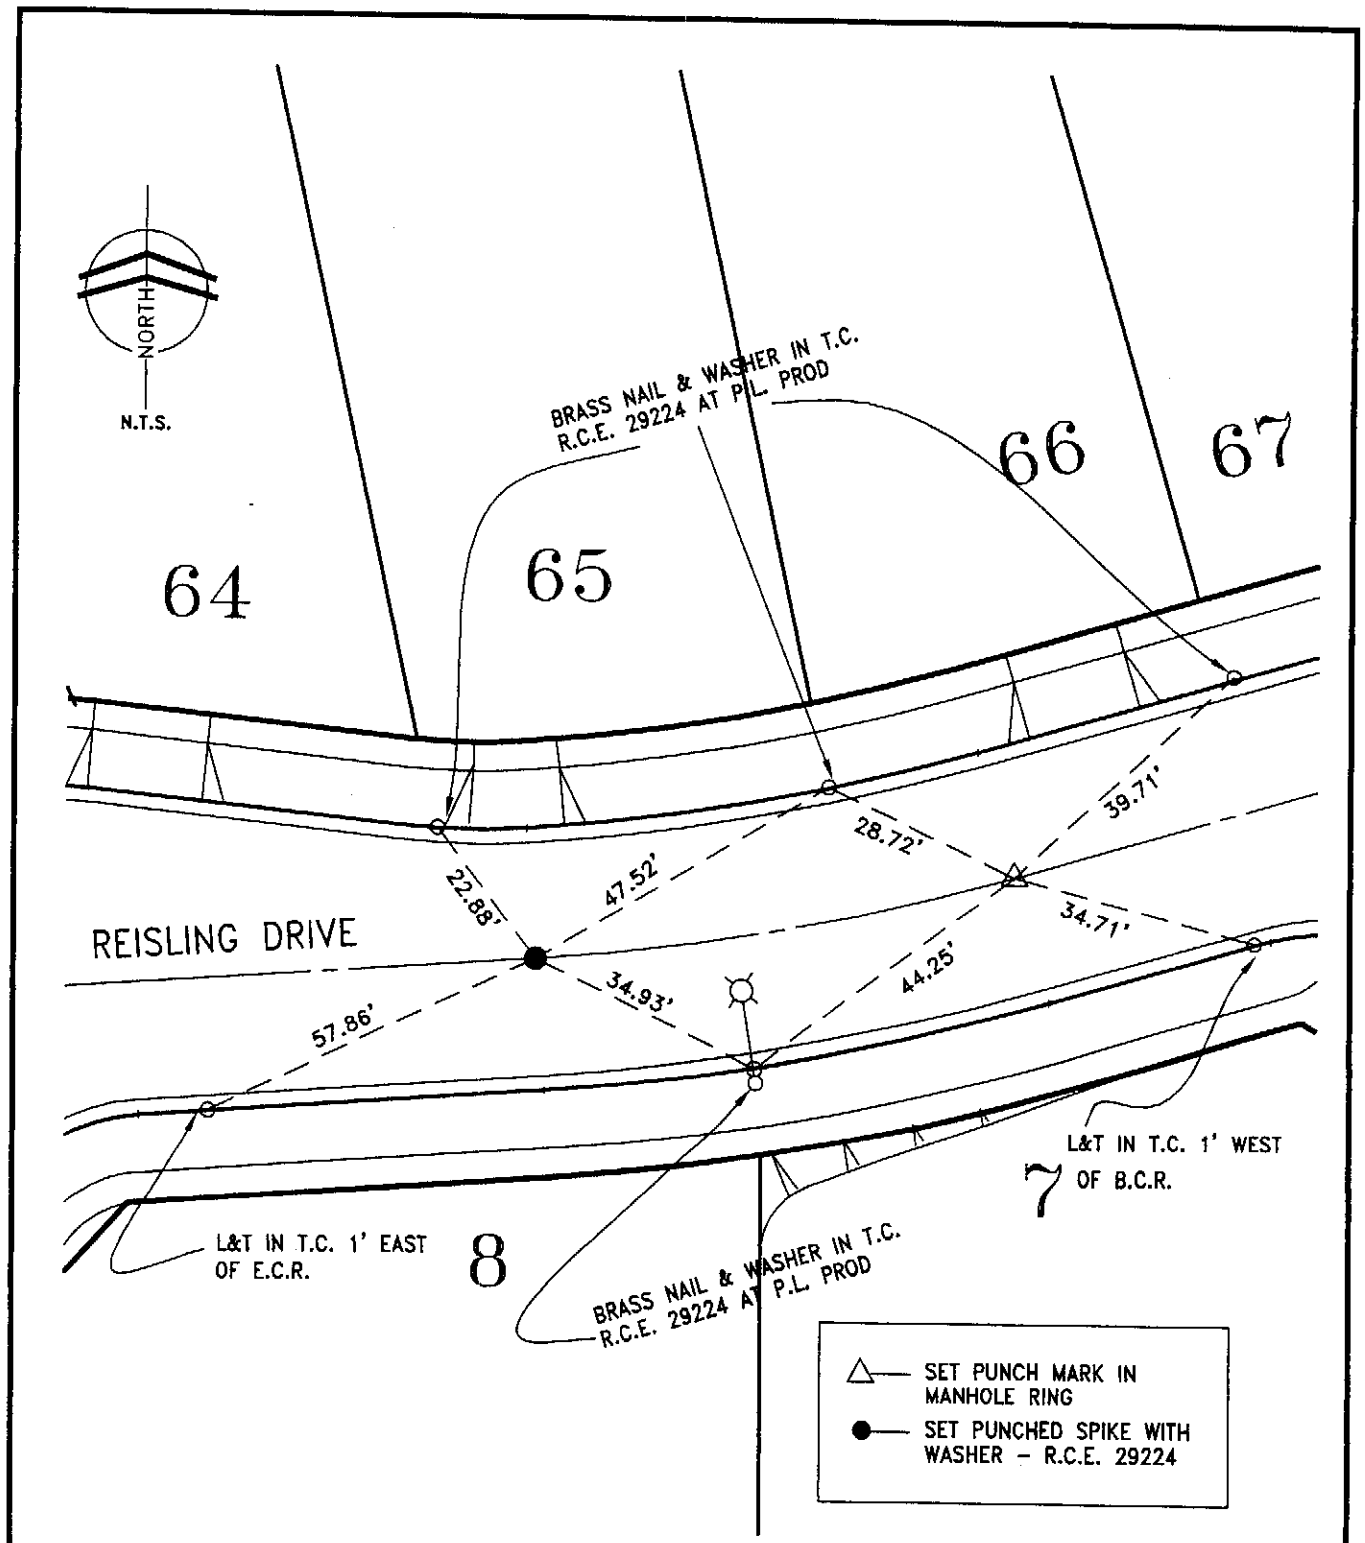

CITY OF RANCHO CUCAMONGA STREET TIES	TRACT NO. 15711-1
Dan Guerra & Associates 10271-B TRADEMARK STREET RANCHO CUCAMONGA, CA 91730 (909) 987-4306 CIVIL ENGINEERS • LAND SURVEYORS	AT B.C. ON REISLING DRIVE AT E.C. ON REISLING DRIVE
ENGINEER: DANIEL E. GUERRA	FIELD REVIEW: _____ DATE: _____
R.C.E. No. 29224	TIE BOOK: 24 PAGE: 25

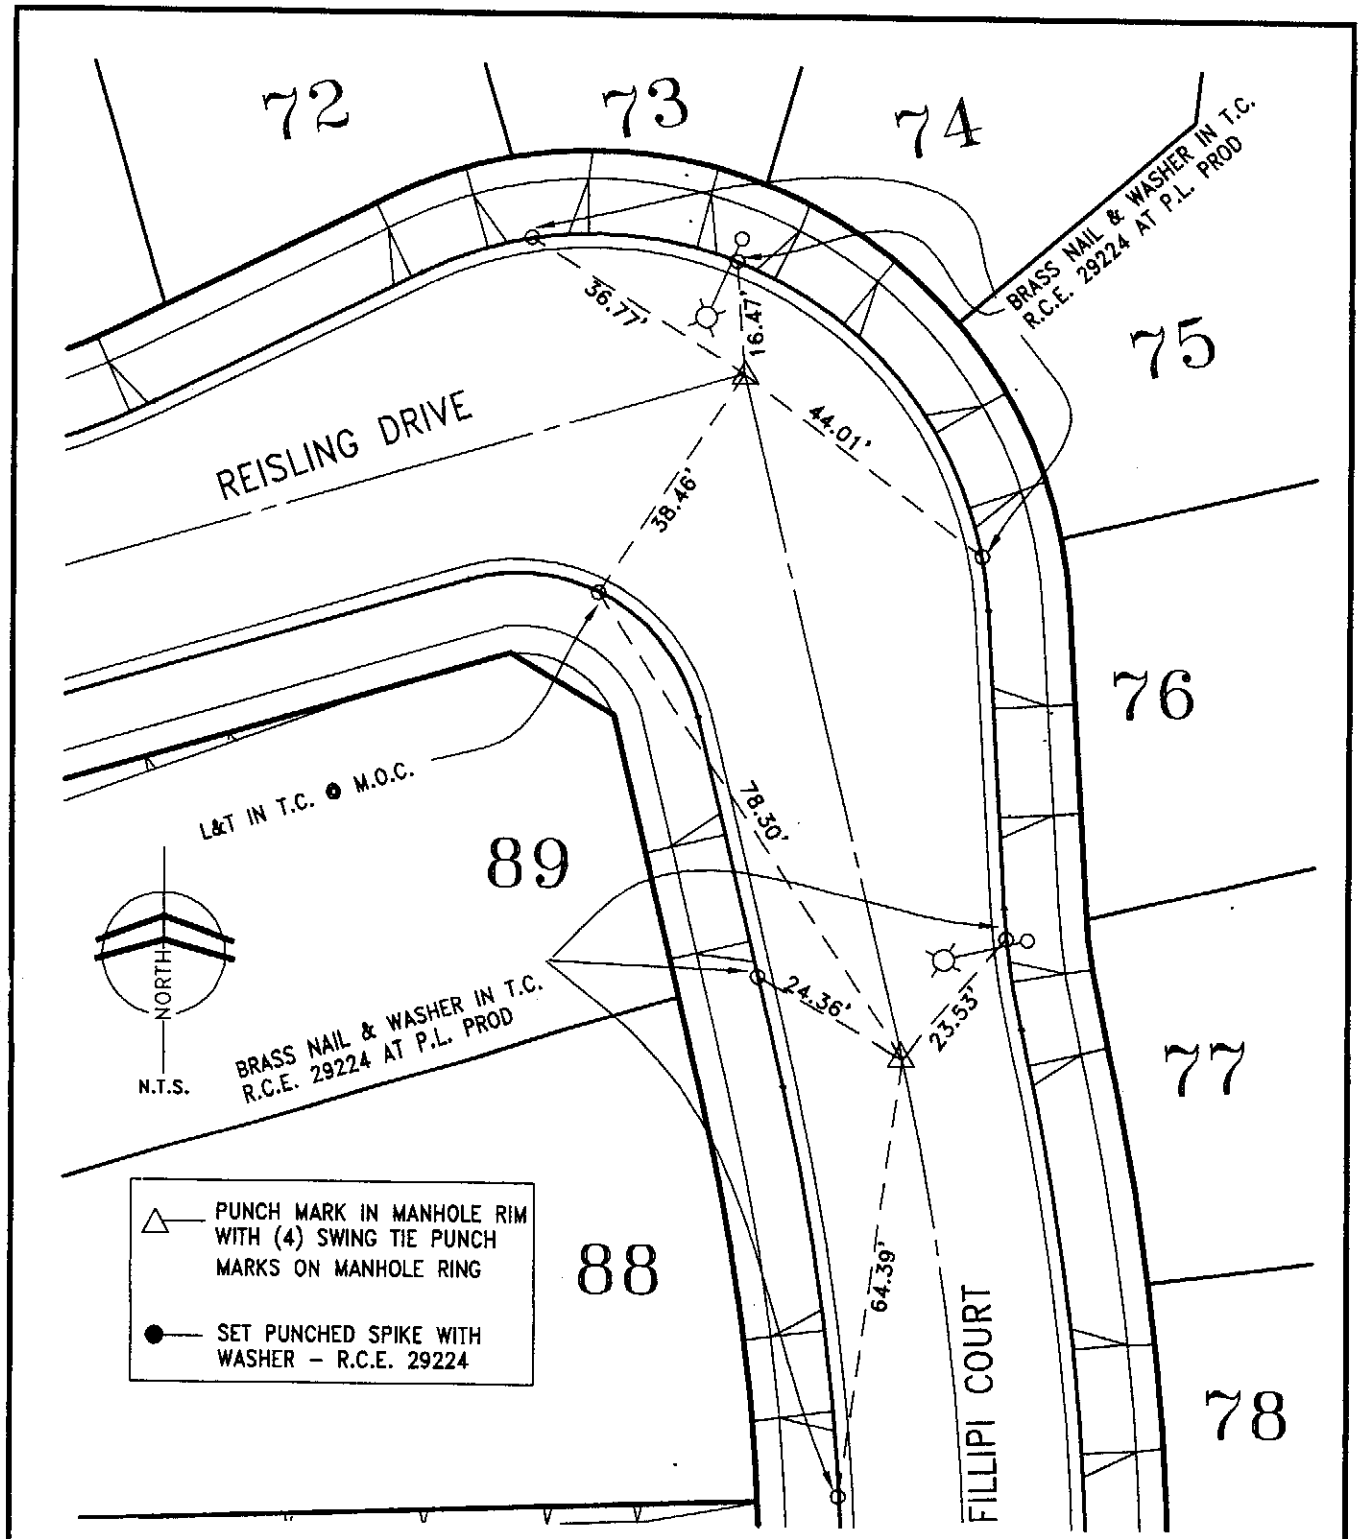

CITY OF RANCHO CUCAMONGA STREET TIES	TRACT 15711-1
Dan Guerra & Associates 10271-B TRADEMARK STREET RANCHO CUCAMONGA, CA 91730 (909) 987-4306 CIVIL ENGINEERS • LAND SURVEYORS	AT E.C. FILLIPI COURT AT INTERSECTION FILLIPI COURT AND REISLING DRIVE
ENGINEER: DANIEL E. GUERRA	FIELD REVIEW: _____ DATE: _____
R.C.E. No. 29224	TIE BOOK: 24 PAGE: 26

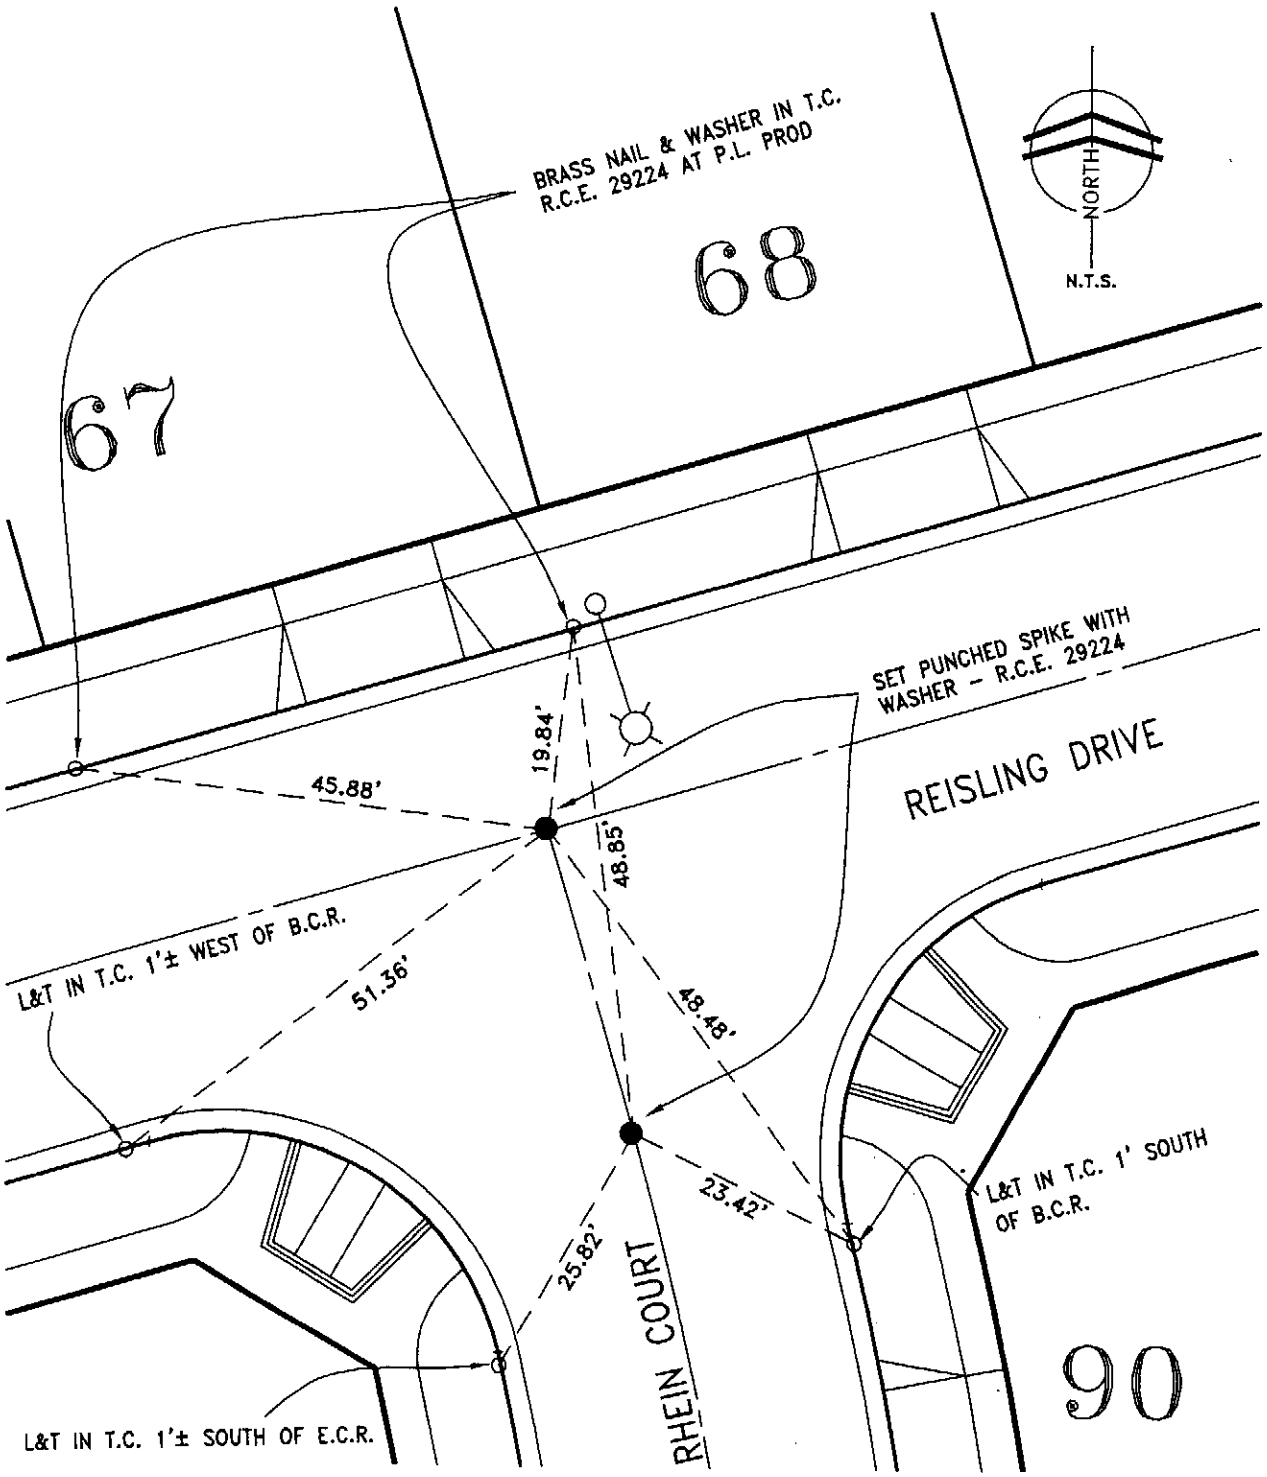

CITY OF RANCHO CUCAMONGA STREET TIES	TRACT NO. 15711-1
Dan Guerra & Associates 10271-B TRADEMARK STREET RANCHO CUCAMONGA, CA 91730 (909) 987-4306 CIVIL ENGINEERS • LAND SURVEYORS	AT INTERSECTION REISLING DRIVE AND RHEIN COURT AT B.C. RHEIN COURT
ENGINEER: DANIEL E. GUERRA	FIELD REVIEW: _____ DATE: _____
R.C.E. No. 29224	TIE BOOK: 24 PAGE: 27

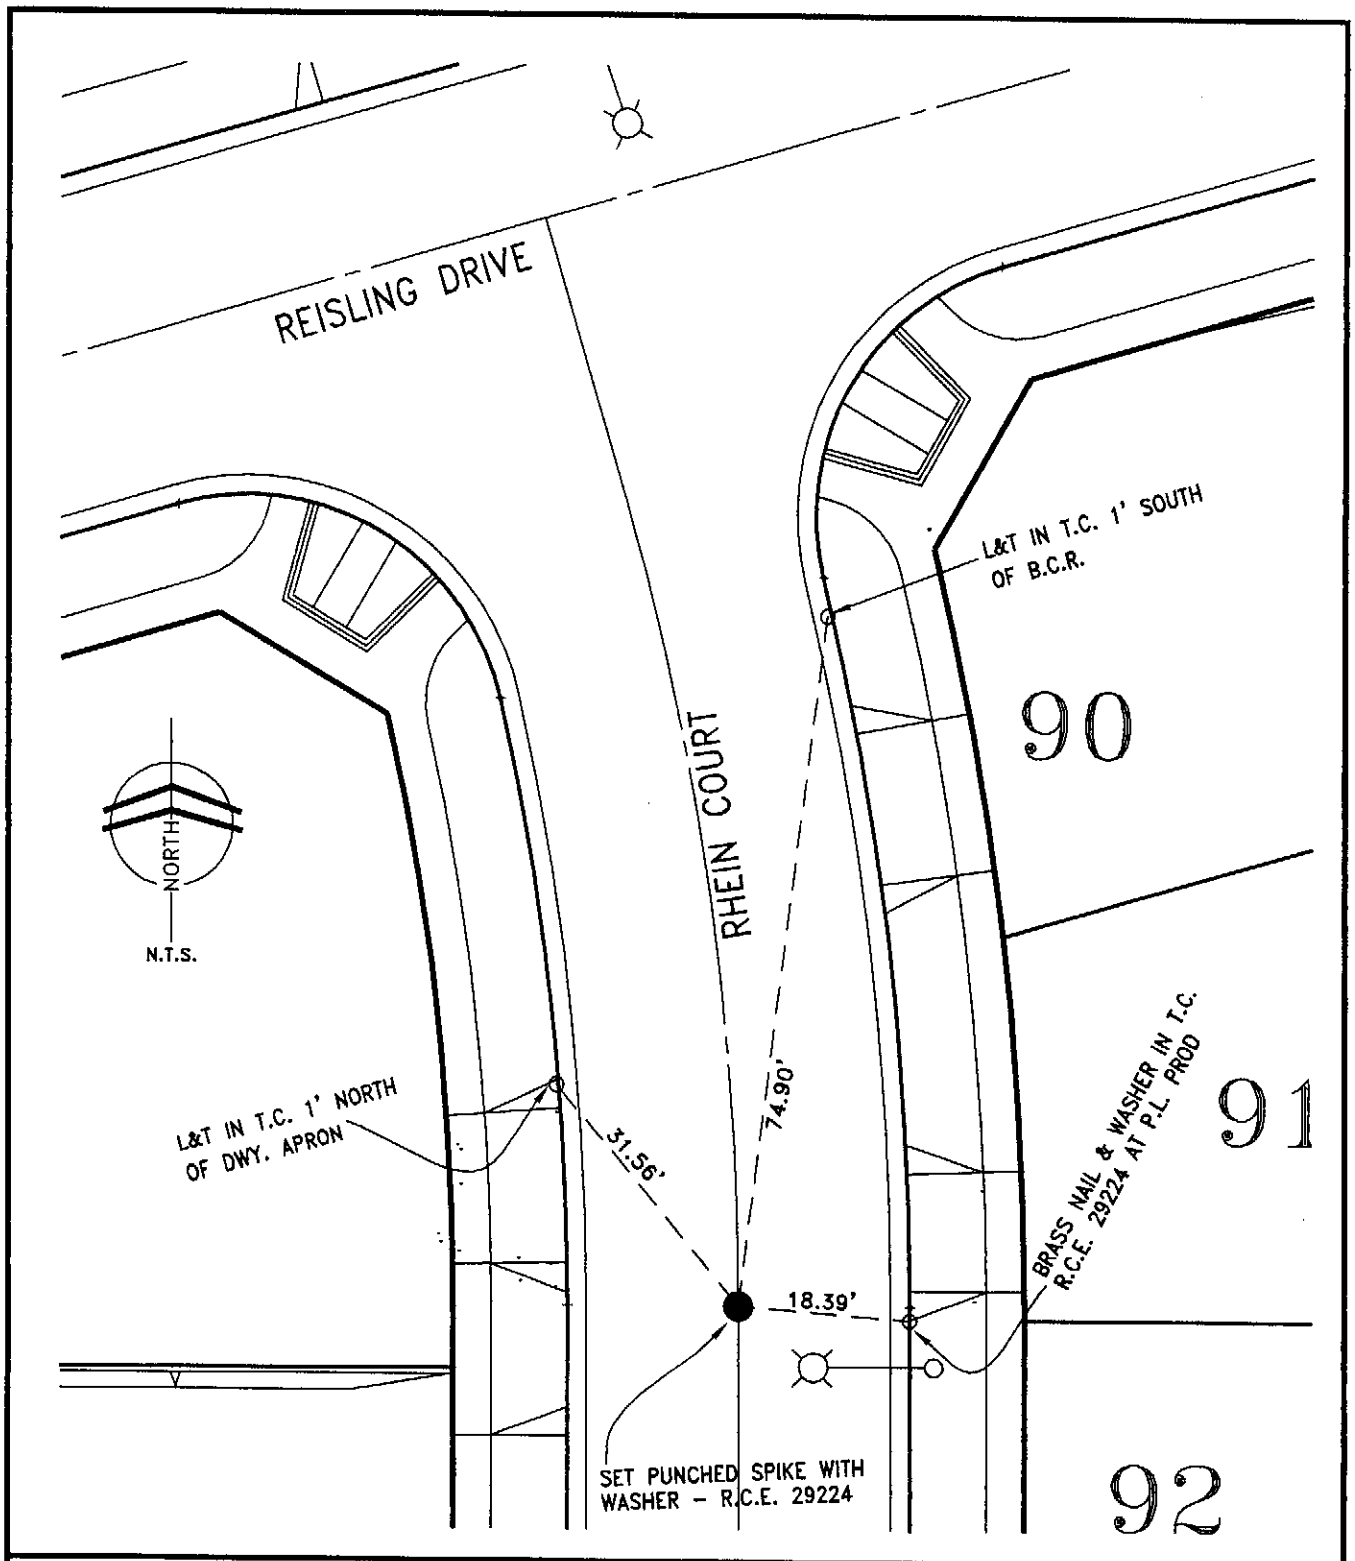

CITY OF RANCHO CUCAMONGA STREET TIES	TRACT NO. 15711-1
Dan Guerra & Associates 10271-B TRADEMARK STREET RANCHO CUCAMONGA, CA 91730 (909) 987-4306 CIVIL ENGINEERS • LAND SURVEYORS	AT E.C. RHEIN COURT
ENGINEER: DANIEL E. GUERRA	FIELD REVIEW: _____ DATE: _____
R.C.E. No. 29224	TIE BOOK: 24 PAGE: 28

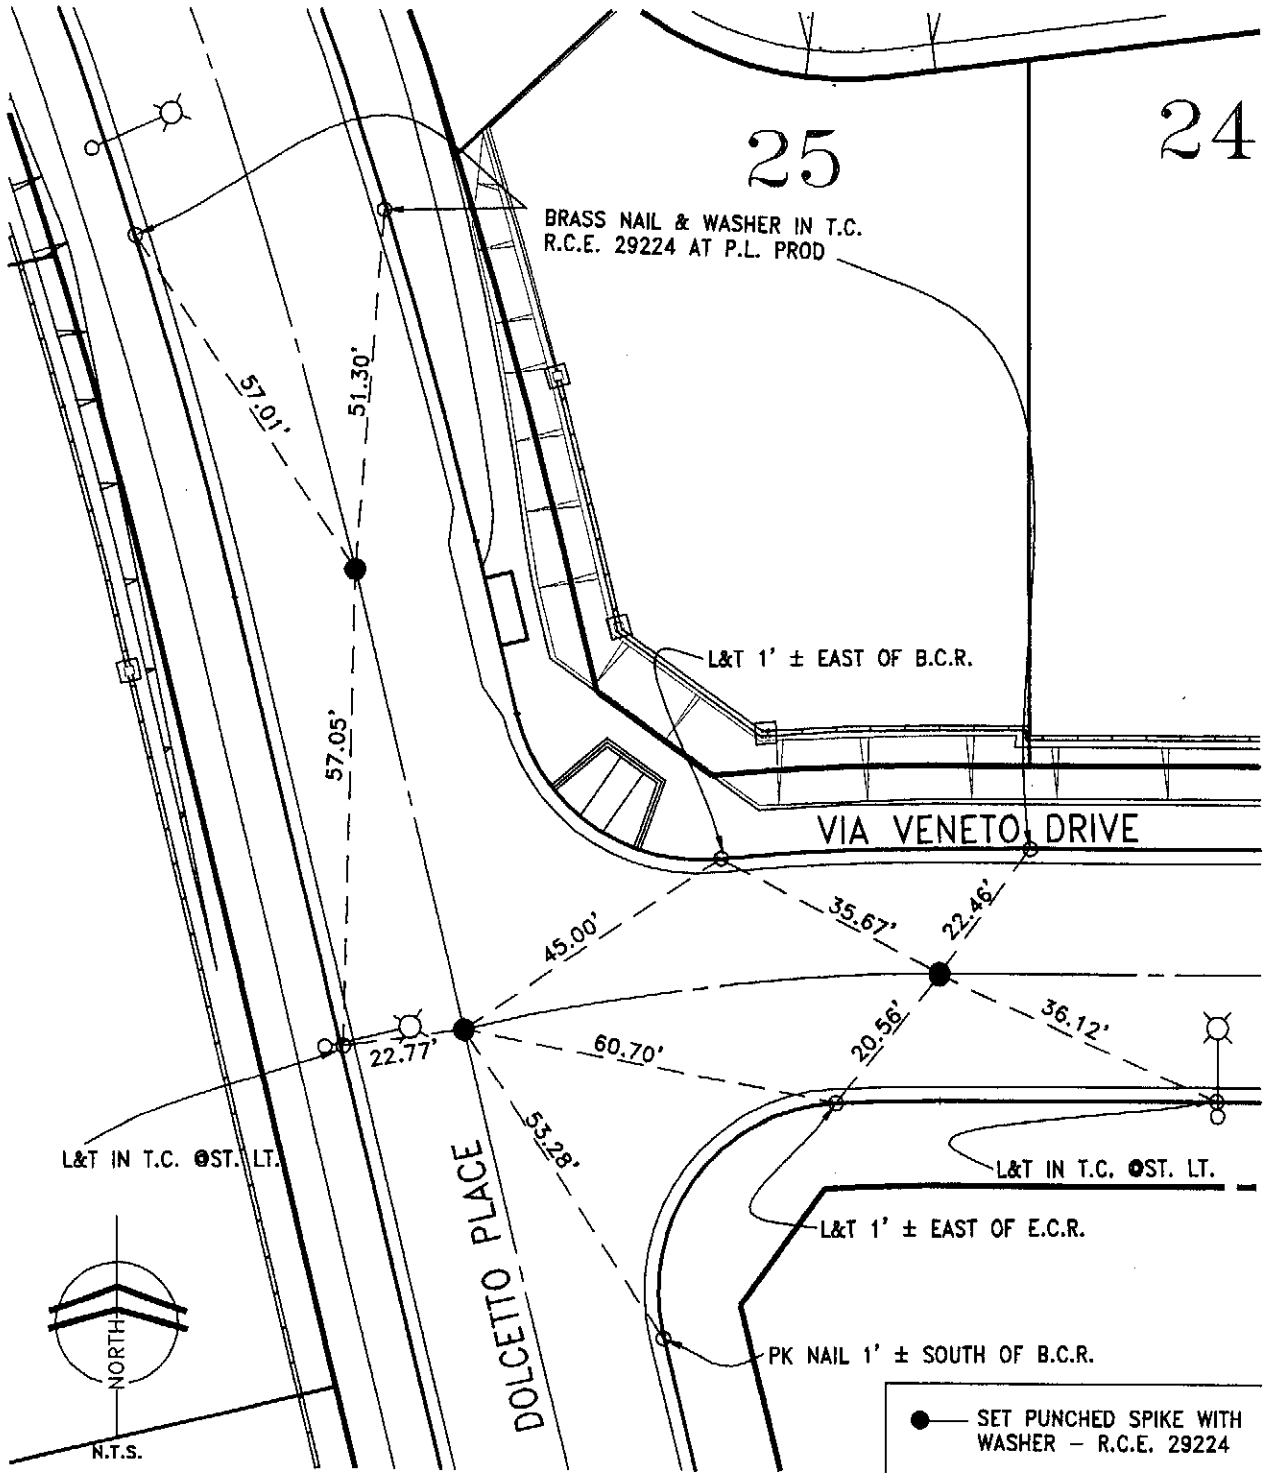

CITY OF RANCHO CUCAMONGA STREET TIES	TRACT NO. 15711-1
Dan Guerra & Associates 10271-B TRADEMARK STREET RANCHO CUCAMONGA, CA 91730 (909) 987-4306 CIVIL ENGINEERS • LAND SURVEYORS	AT INTERSECTION DOLCETTO PLACE AND VIA VENETO DRIVE
ENGINEER: DANIEL E. GUERRA	FIELD REVIEW: _____ DATE: _____
R.C.E. No. 29224	TIE BOOK: 24 PAGE: 29

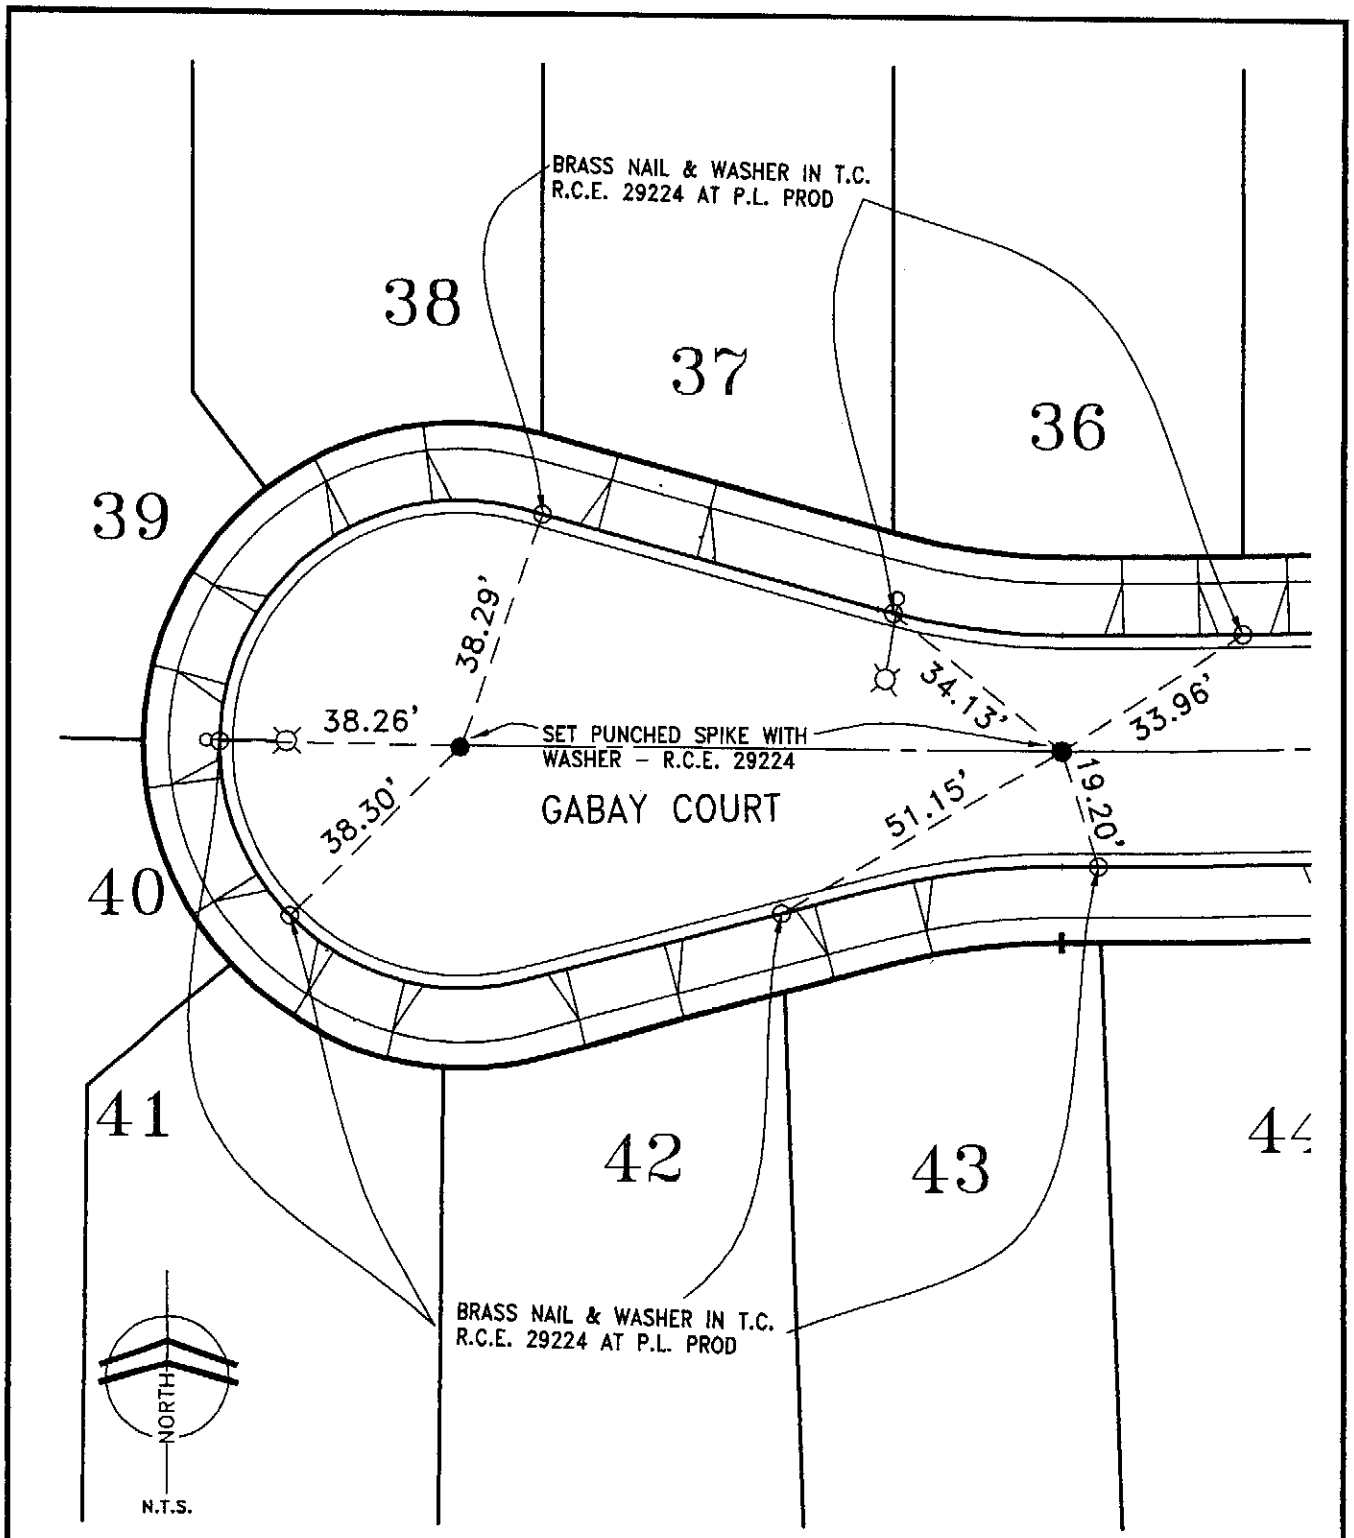

CITY OF RANCHO CUCAMONGA STREET TIES	TRACT NO. 15711-1
Dan Guerra & Associates 10271-B TRADEMARK STREET RANCHO CUCAMONGA, CA 91730 (909) 987-4306 CIVIL ENGINEERS • LAND SURVEYORS	AT CUL-DE-SAC OF GABAY COURT
ENGINEER: DANIEL E. GUERRA	FIELD REVIEW: _____ DATE: _____
R.C.E. No. 29224	TIE BOOK: 24 PAGE: 30

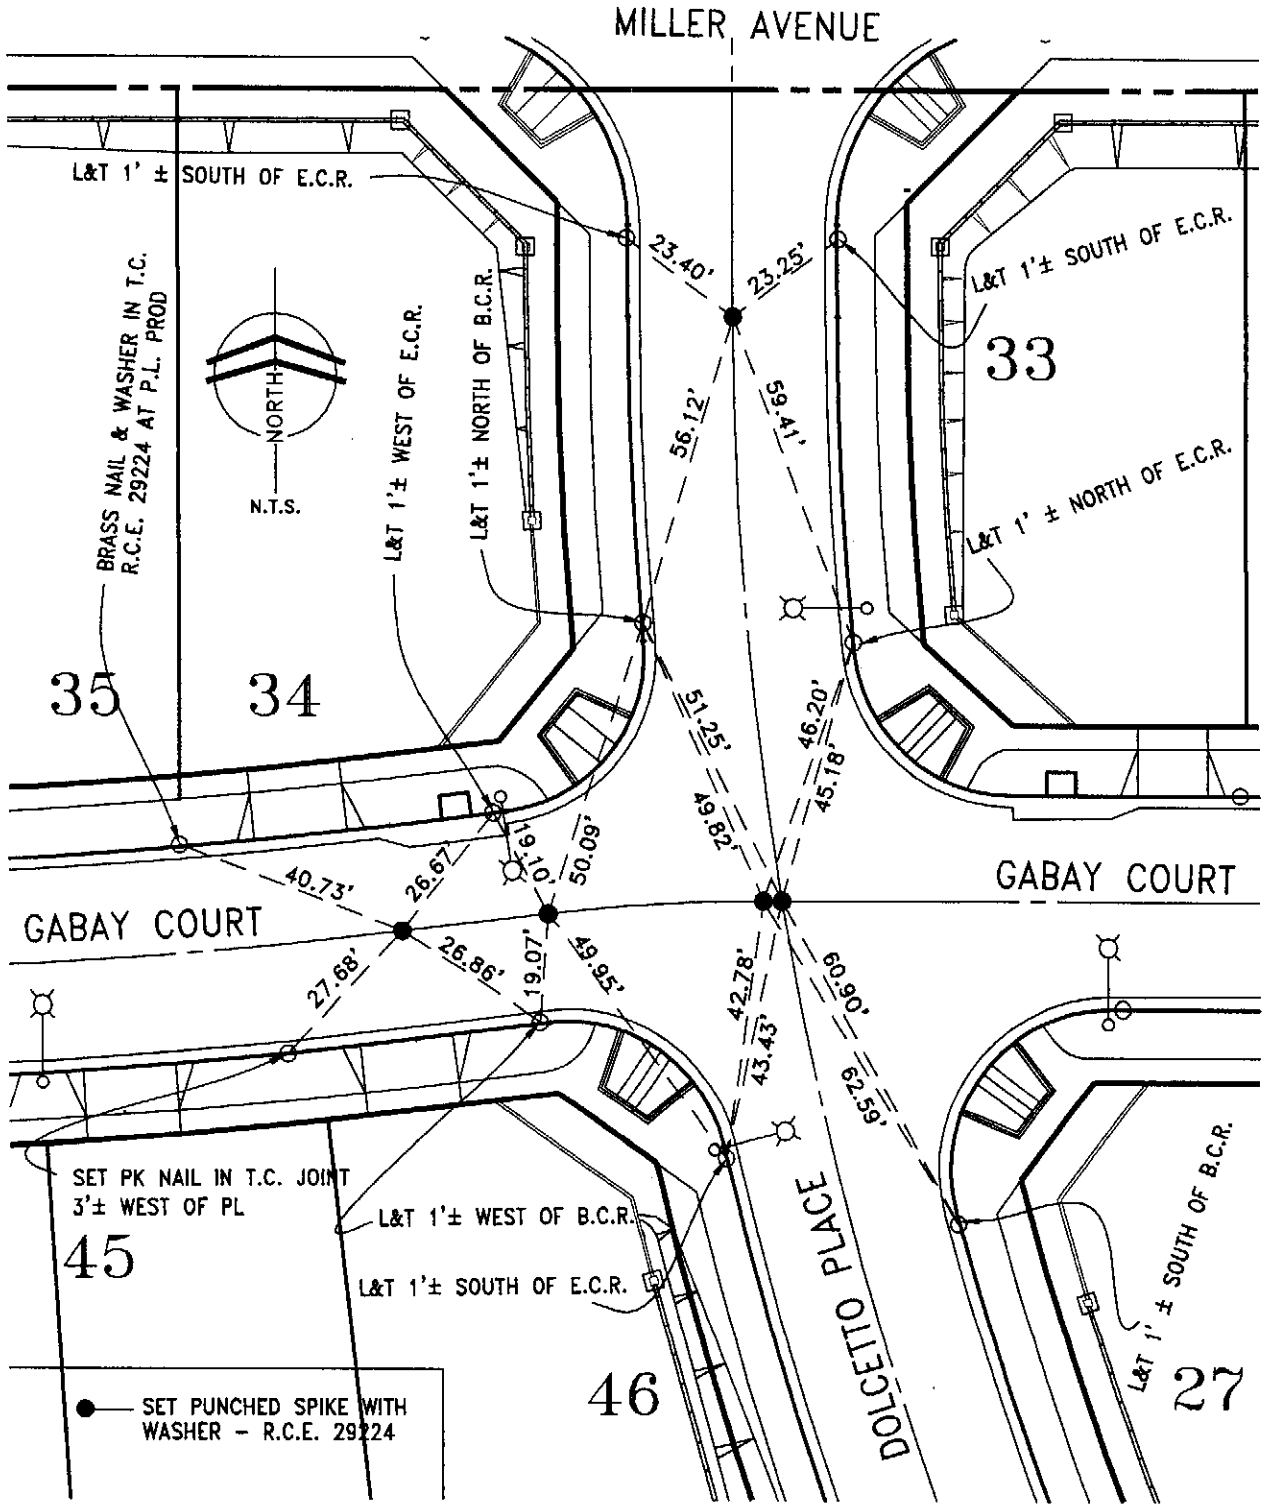

CITY OF RANCHO CUCAMONGA STREET TIES	TRACT 15711-1
Dan Guerra & Associates 10271-B TRADEMARK STREET RANCHO CUCAMONGA, CA 91730 (909) 987-4306 CIVIL ENGINEERS • LAND SURVEYORS	AT INTERSECTION GABAY COURT, AND DOLCETTO PLACE
ENGINEER: DANIEL E. GUERRA	FIELD REVIEW: _____ DATE: _____
R.C.E. No. 29224	TIE BOOK: 24 PAGE: 31

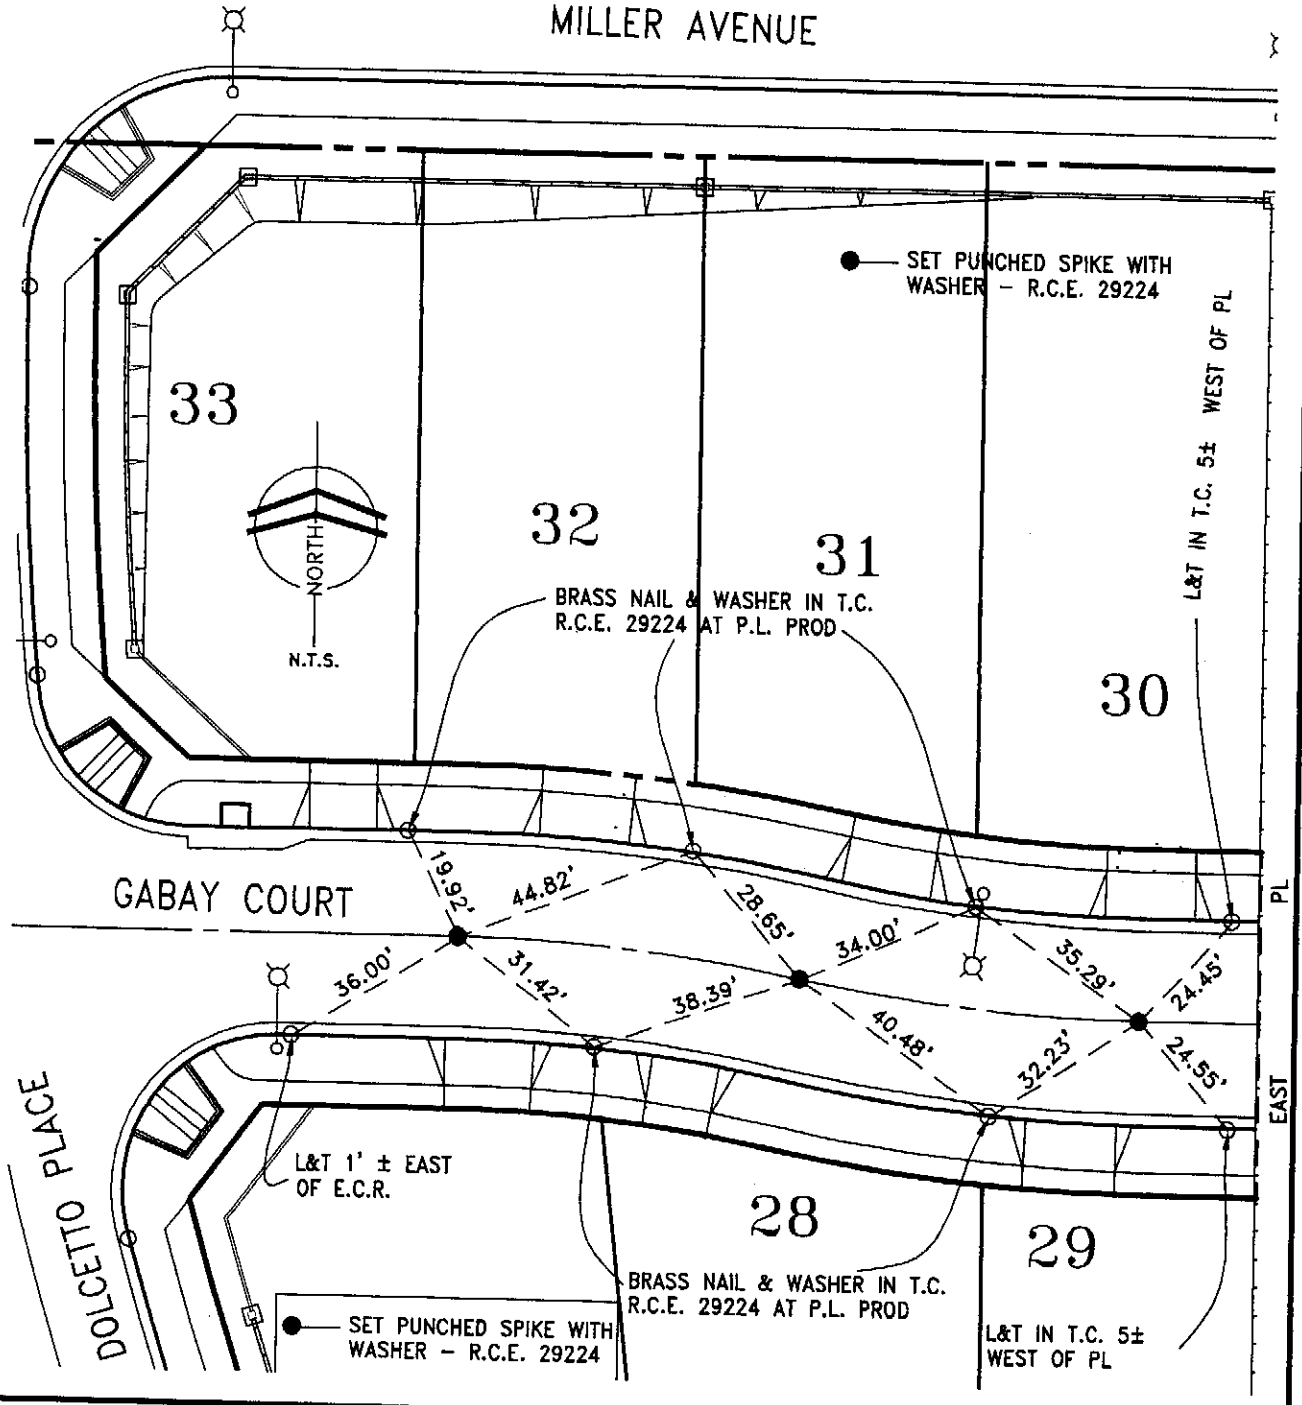

CITY OF RANCHO CUCAMONGA
STREET TIES

TRACT 15711-1

Dan Guerra & Associates
10271-B TRADEMARK STREET
RANCHO CUCAMONGA, CA 91730
(909) 987-4306
CIVIL ENGINEERS • LAND SURVEYORS

AT JUST EAST OF INTERSECTION GABAY COURT, AND DOLCETTO PLACE

ENGINEER: DANIEL E. GUERRA

R.C.E. No. 29224

FIELD REVIEW: _____ DATE: _____

TIE BOOK: 24 PAGE: 32

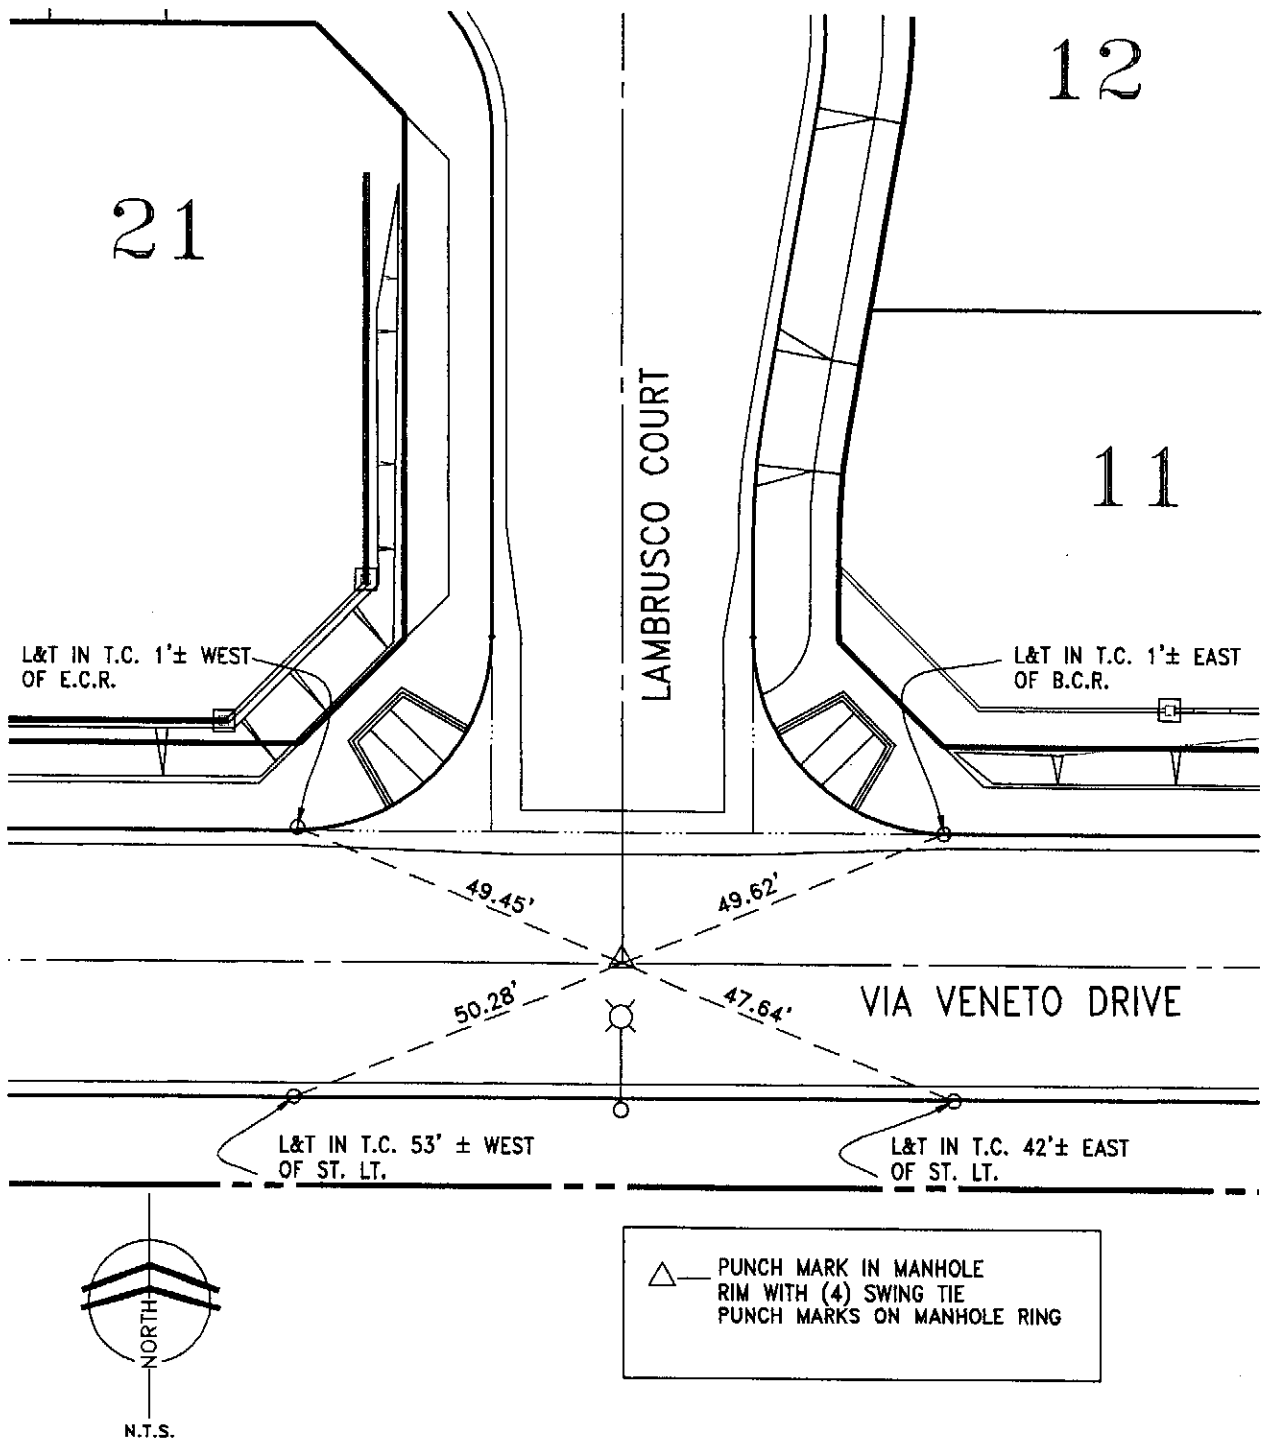

CITY OF RANCHO CUCAMONGA STREET TIES	TRACT NO. 15711-1
Dan Guerra & Associates 10271-B TRADEMARK STREET RANCHO CUCAMONGA, CA 91730 (909) 987-4306 CIVIL ENGINEERS • LAND SURVEYORS	AT INTERSECTION OF VIA VENETO DRIVE LAMBRUSCO COURT
ENGINEER: DANIEL E. GUERRA	FIELD REVIEW: _____ DATE: _____
R.C.E. No. 29224	TIE BOOK: 24 PAGE: 33

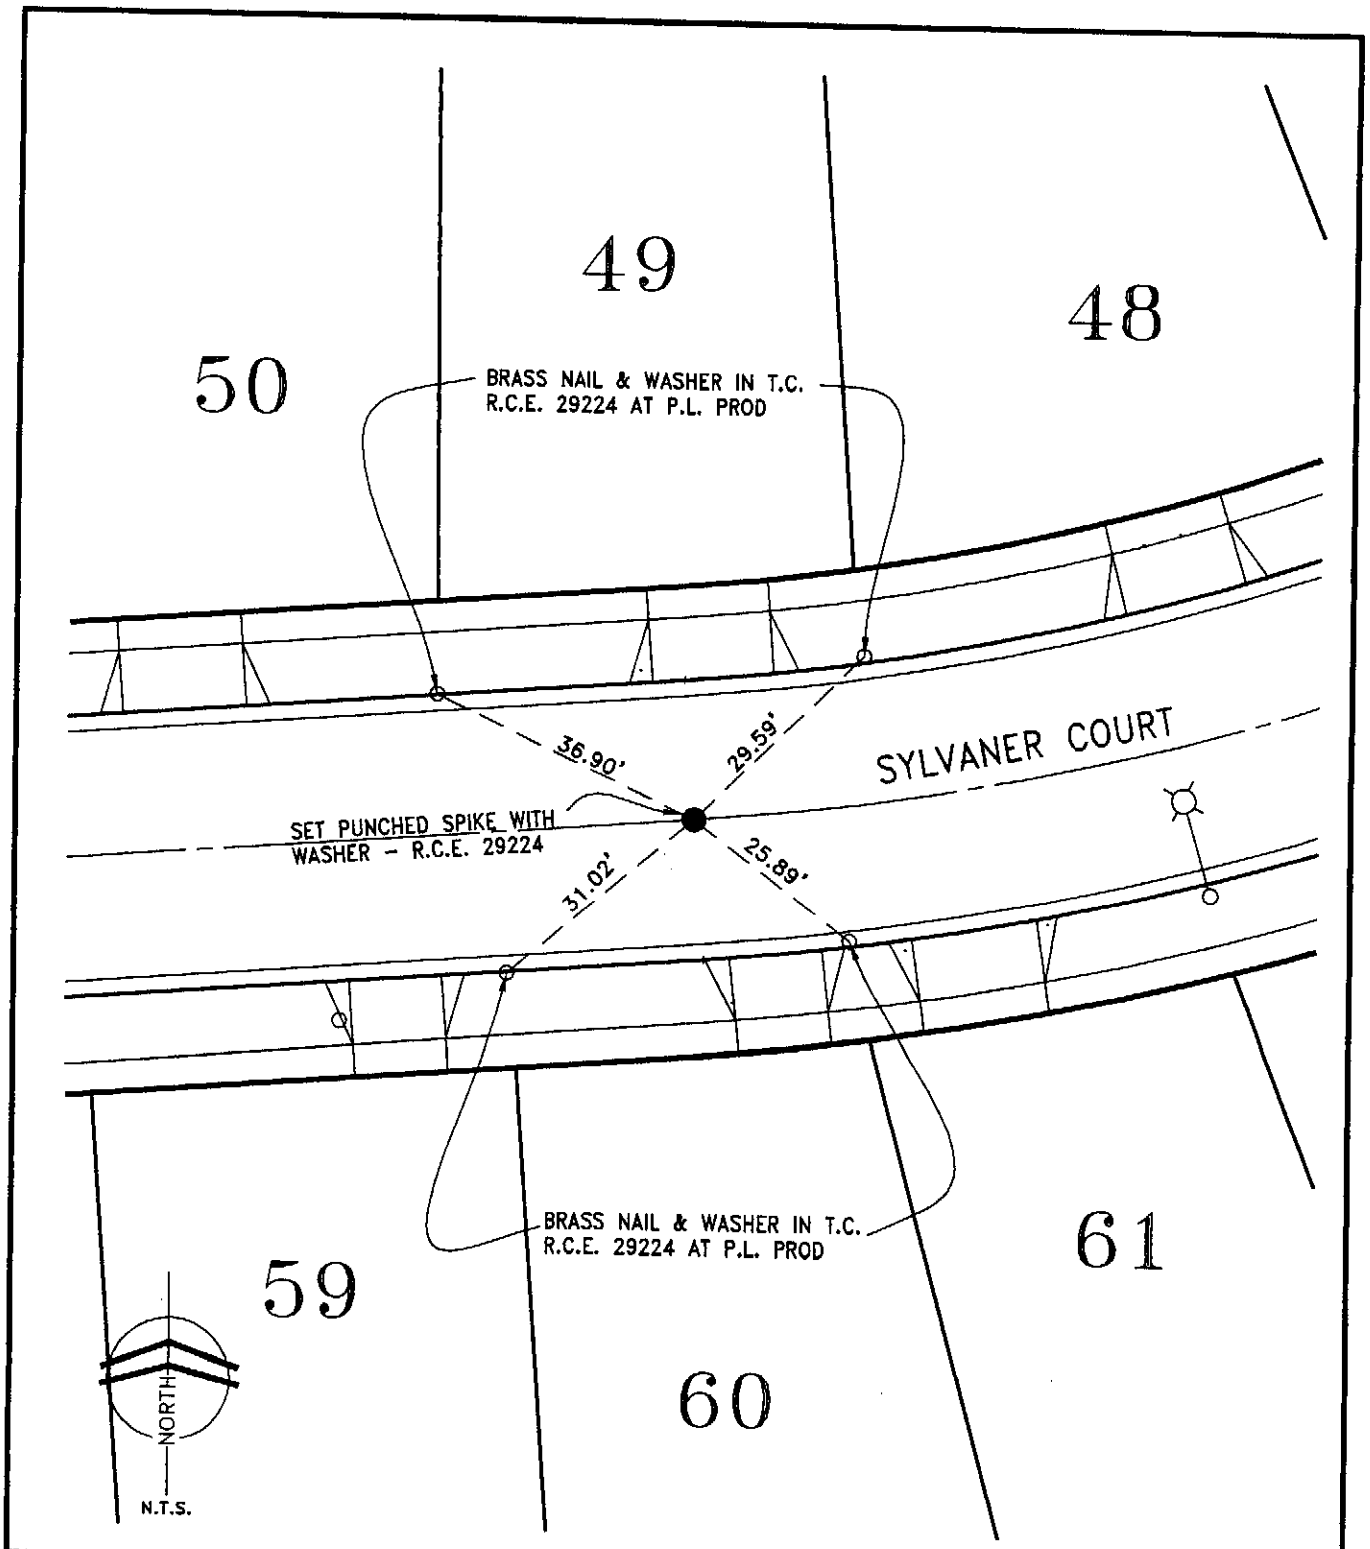

CITY OF RANCHO CUCAMONGA STREET TIES	TRACT NO. 15711-1
Dan Guerra & Associates 10271-B TRADEMARK STREET RANCHO CUCAMONGA, CA 91730 (909) 987-4306 CIVIL ENGINEERS • LAND SURVEYORS	AT E.C. SYLVANER COURT
ENGINEER: DANIEL E. GUERRA	FIELD REVIEW: _____ DATE: _____
R.C.E. No. 29224	TIE BOOK: 24 PAGE: 34

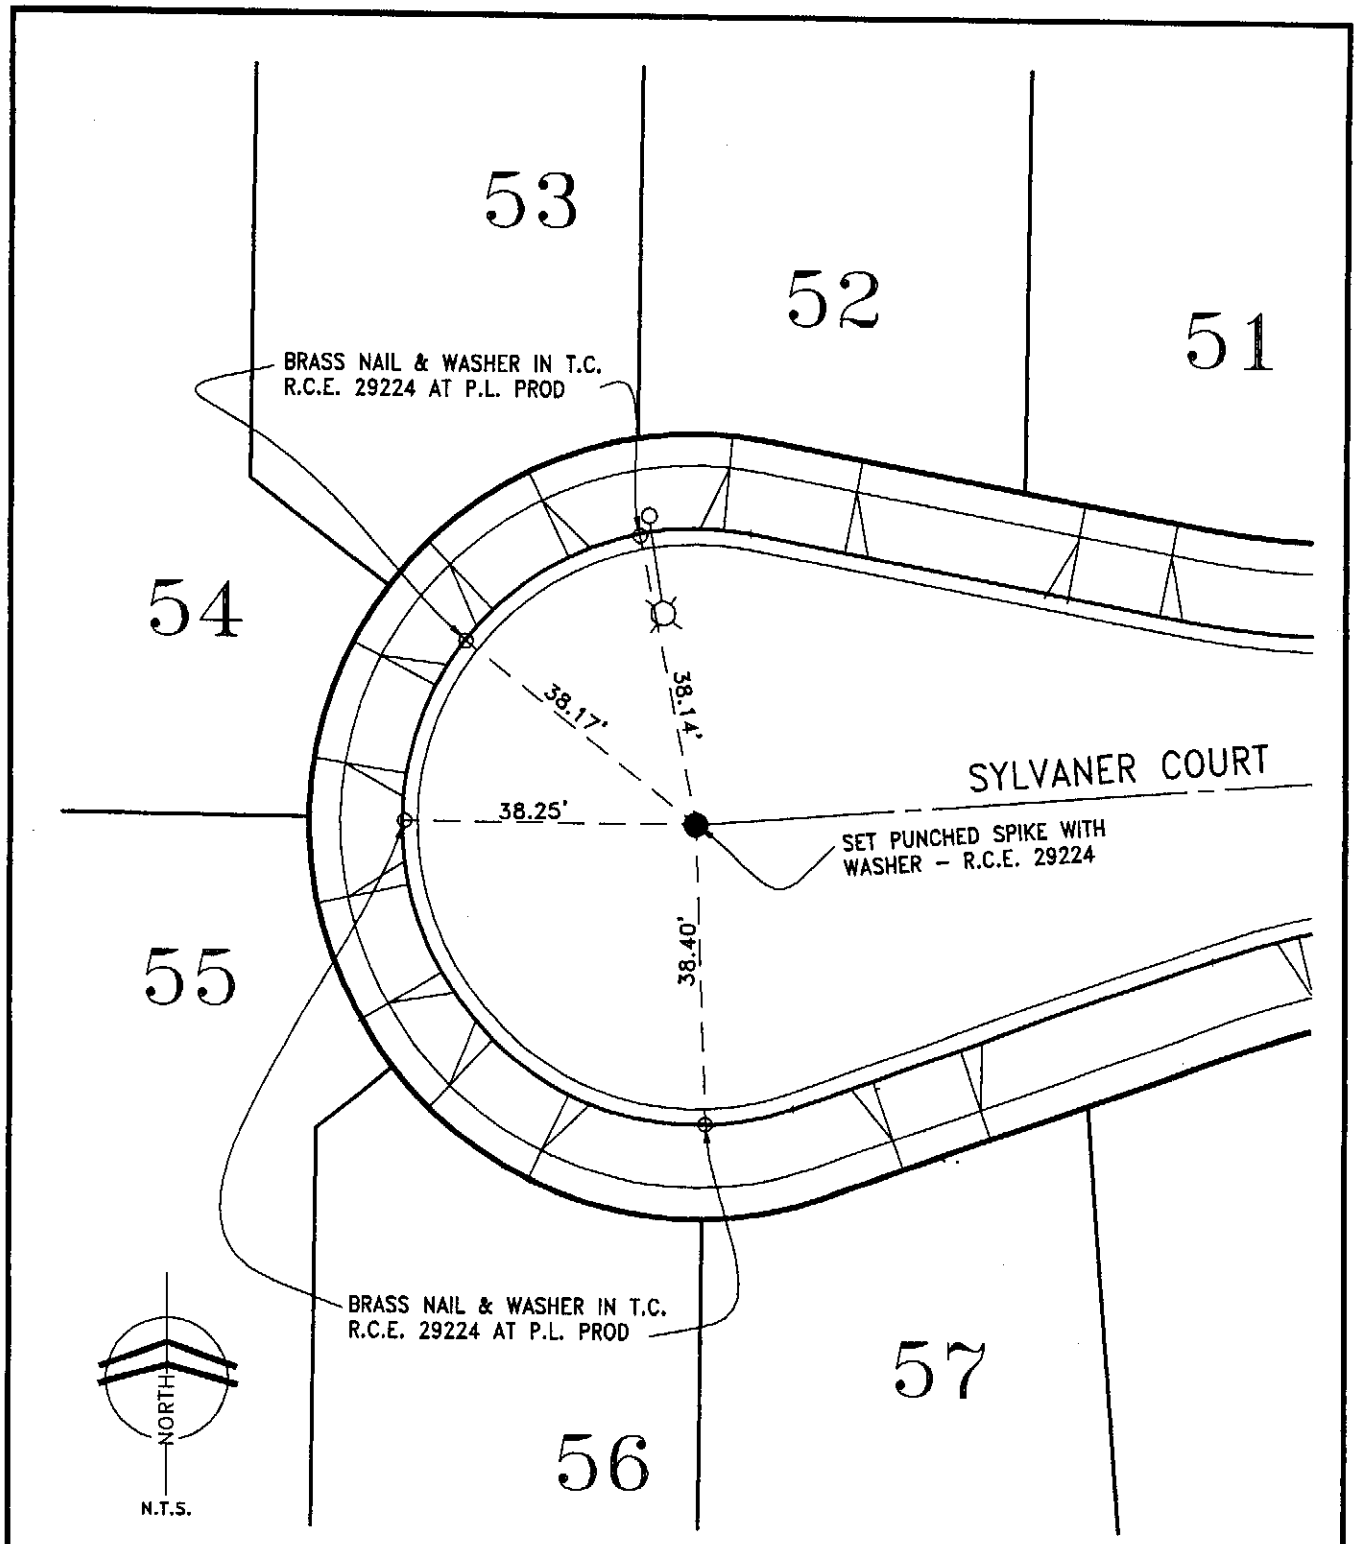

CITY OF RANCHO CUCAMONGA STREET TIES	TRACT NO. 15711-1
Dan Guerra & Associates 10271-B TRADEMARK STREET RANCHO CUCAMONGA, CA 91730 (909) 987-4306 CIVIL ENGINEERS • LAND SURVEYORS	AT CUL-DE-SAC SYLVANER COURT
ENGINEER: DANIEL E. GUERRA	FIELD REVIEW: _____ DATE: _____
R.C.E. No. 29224	TIE BOOK: 24 PAGE: 35

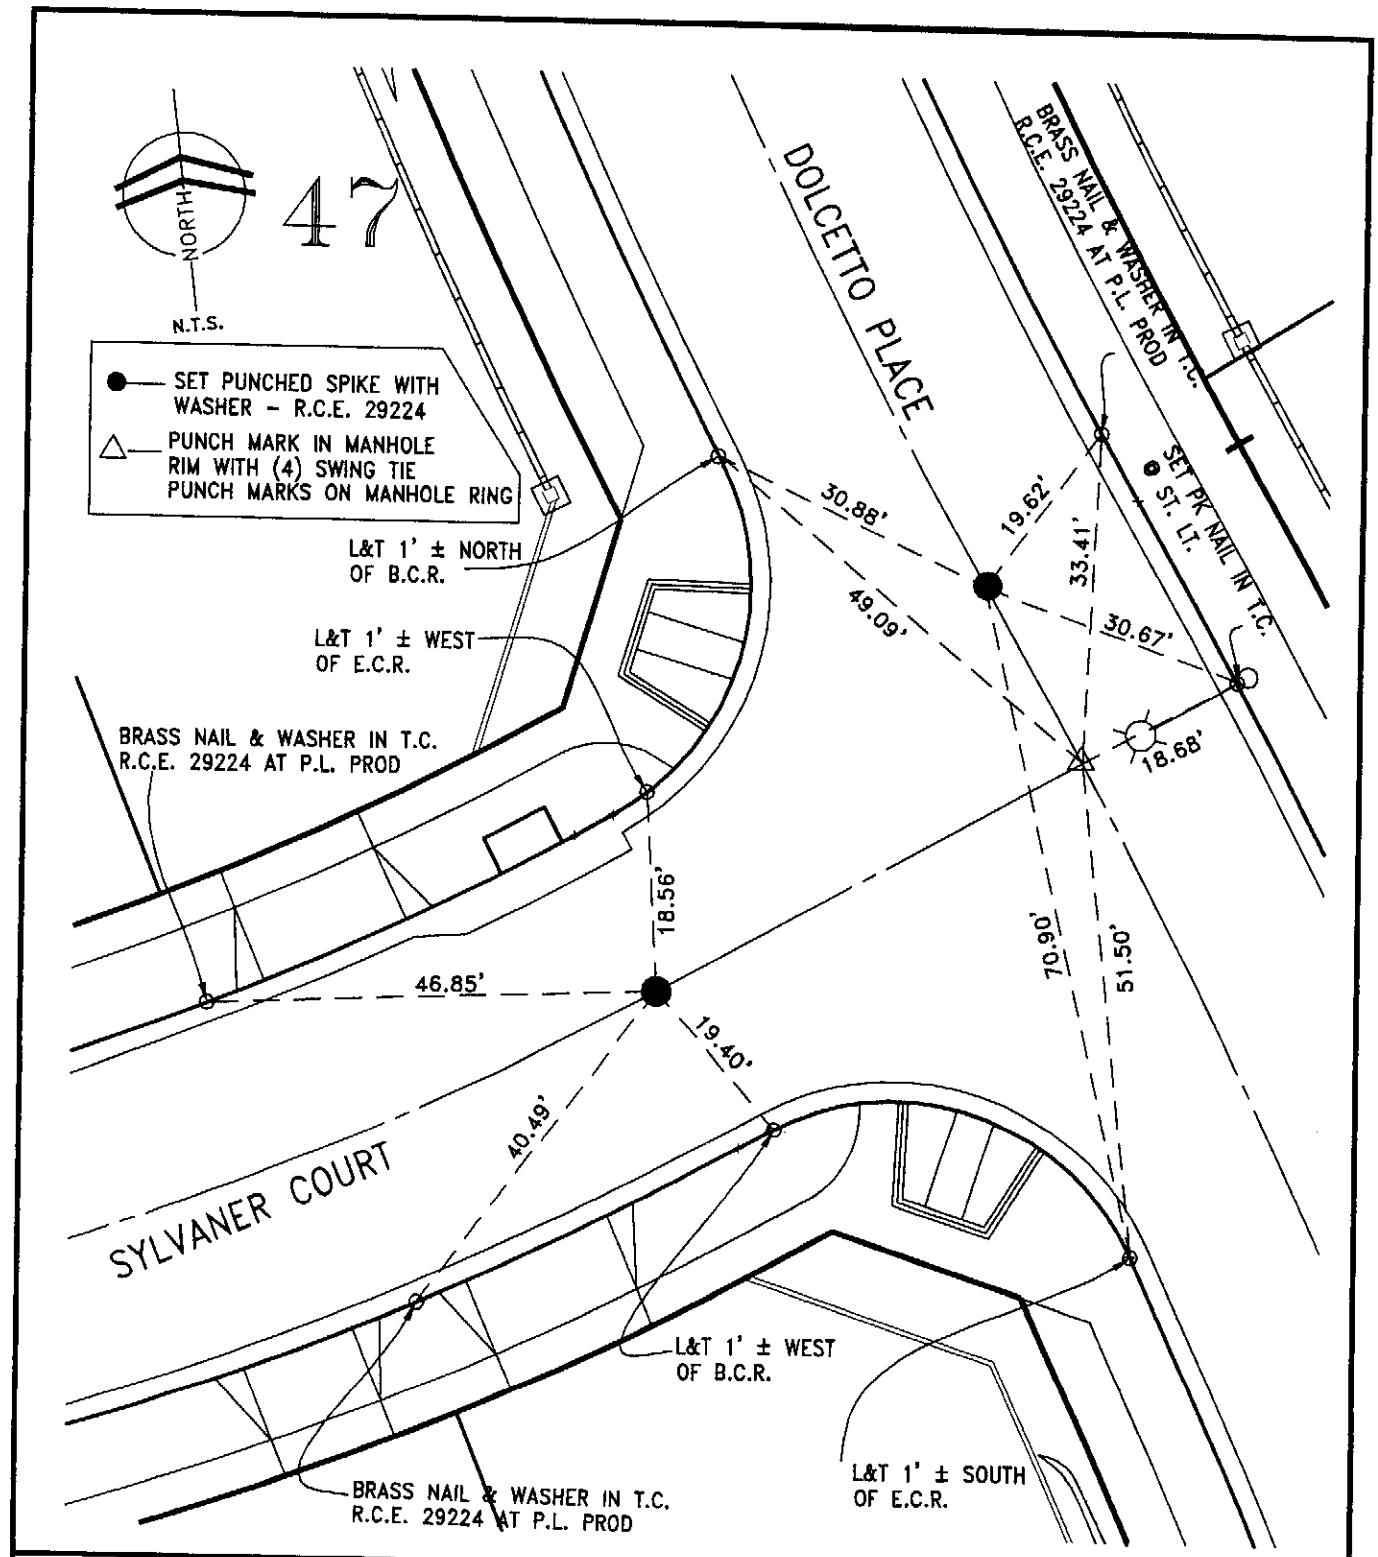

CITY OF RANCHO CUCAMONGA STREET TIES	TRACT 15711-1
Dan Guerra & Associates 10271-B TRADEMARK STREET RANCHO CUCAMONGA, CA 91730 (909) 987-4306 CIVIL ENGINEERS • LAND SURVEYORS	AT INTERSECTION OF SYLVANER COURT AND DOLCETTO PLACE
ENGINEER: DANIEL E. GUERRA	FIELD REVIEW: _____ DATE: _____
R.C.E. No. 29224	TIE BOOK: 24 PAGE: 36

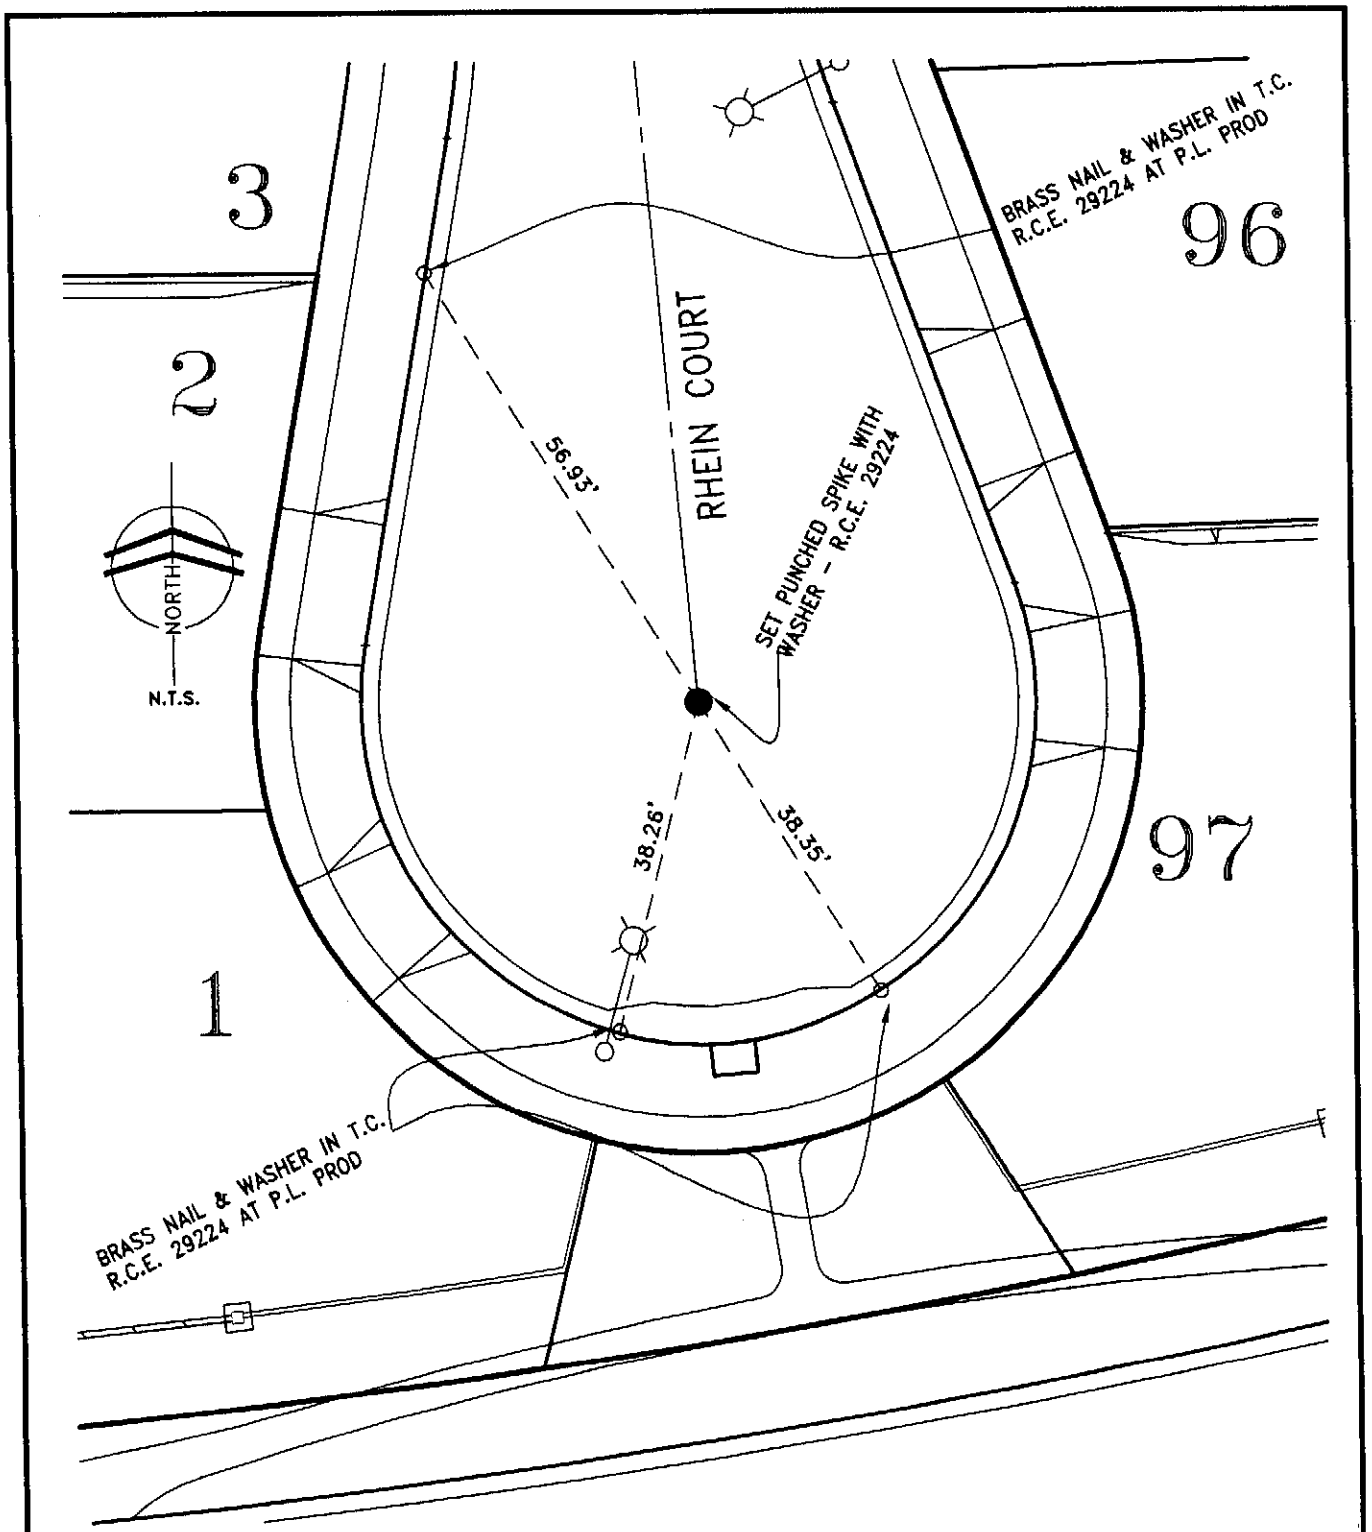

CITY OF RANCHO CUCAMONGA STREET TIES	TRACT NO. 15711-1
Dan Guerra & Associates 10271-B TRADEMARK STREET RANCHO CUCAMONGA, CA 91730 (909) 987-4306 CIVIL ENGINEERS • LAND SURVEYORS	AT CUL-DE-SAC- OF RHEIN COURT
ENGINEER: DANIEL E. GUERRA	FIELD REVIEW: _____ DATE: _____
R.C.E. No. 29224	TIE BOOK: 24 PAGE: 37

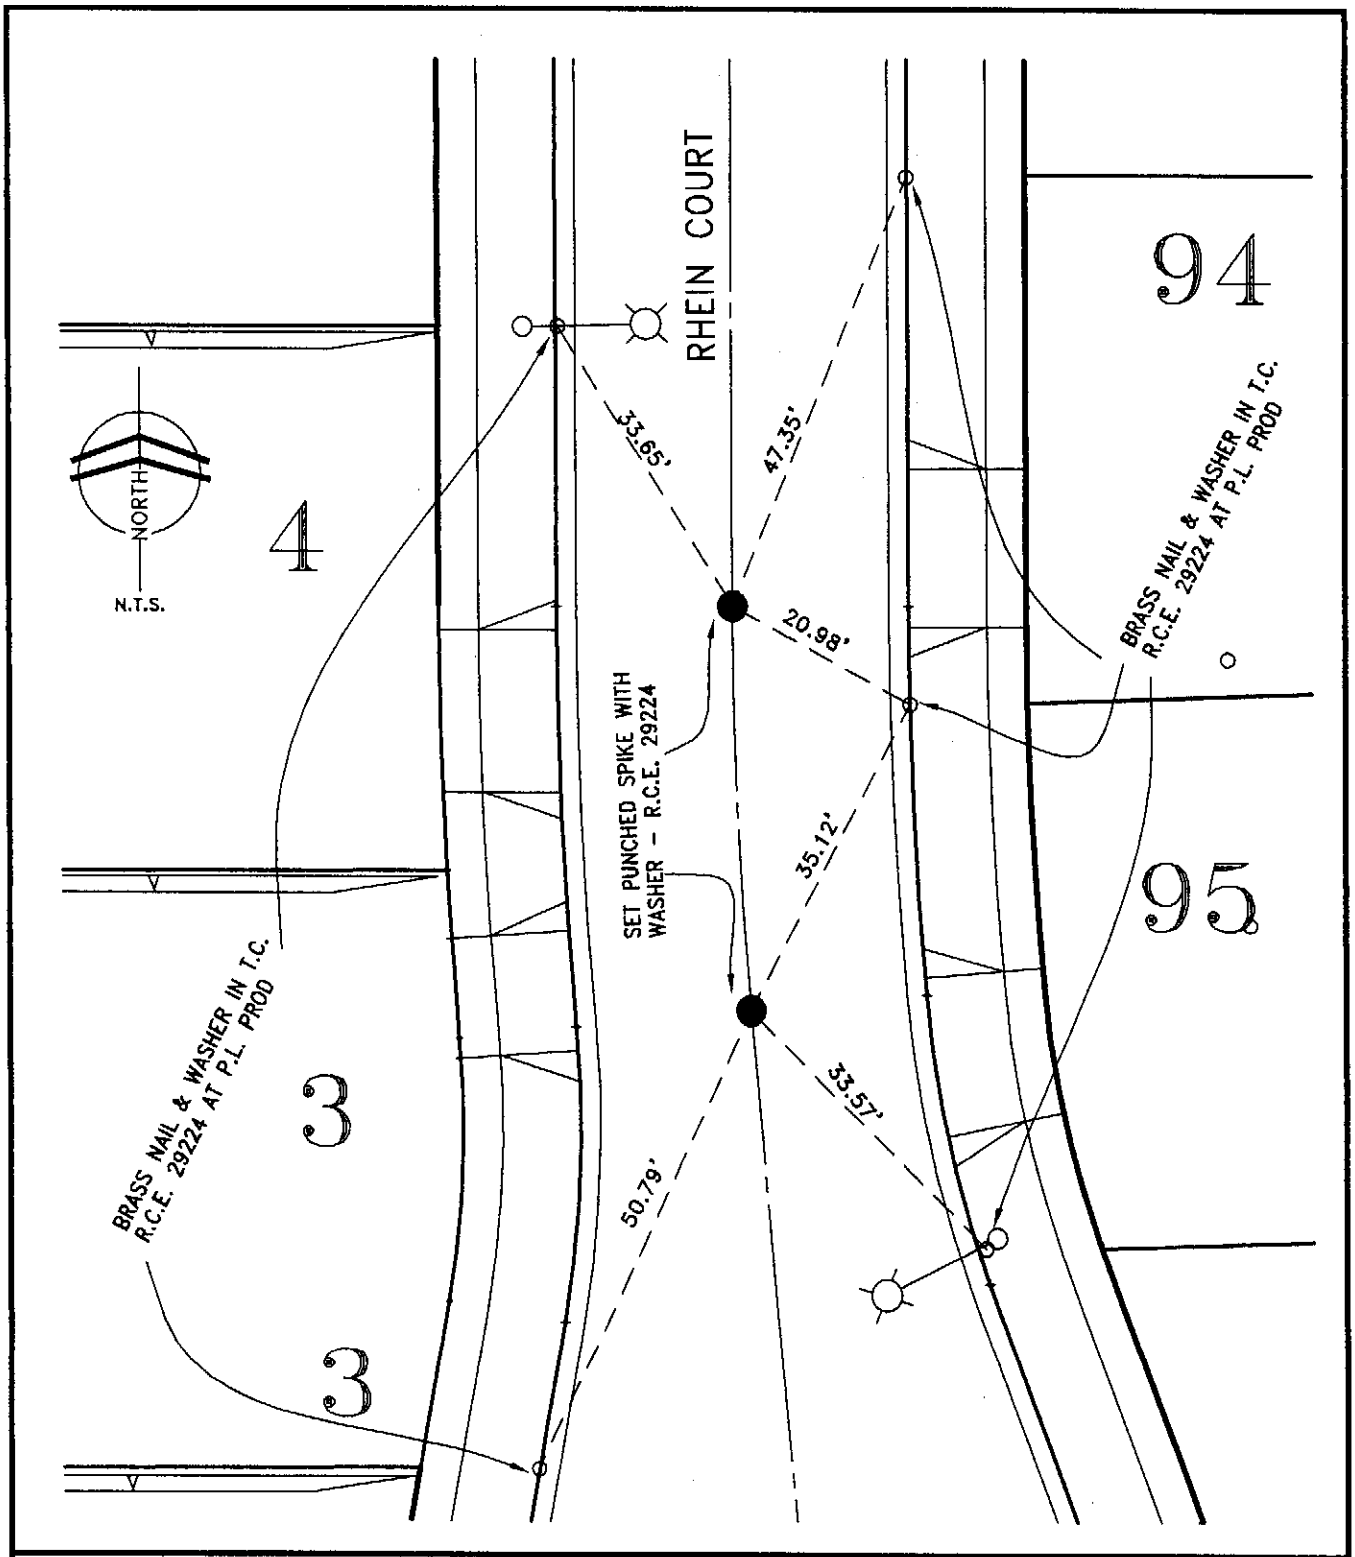

CITY OF RANCHO CUCAMONGA STREET TIES	TRACT NO. 15711-1
Dan Guerra & Associates 10271-B TRADEMARK STREET RANCHO CUCAMONGA, CA 91730 (909) 987-4306 CIVIL ENGINEERS • LAND SURVEYORS	AT E.C. OF RHEIN COURT AT B.C. OF RHEIN COURT
ENGINEER: DANIEL E. GUERRA	FIELD REVIEW: _____ DATE: _____
R.C.E. No. 29224	TIE BOOK: 24 PAGE: 38

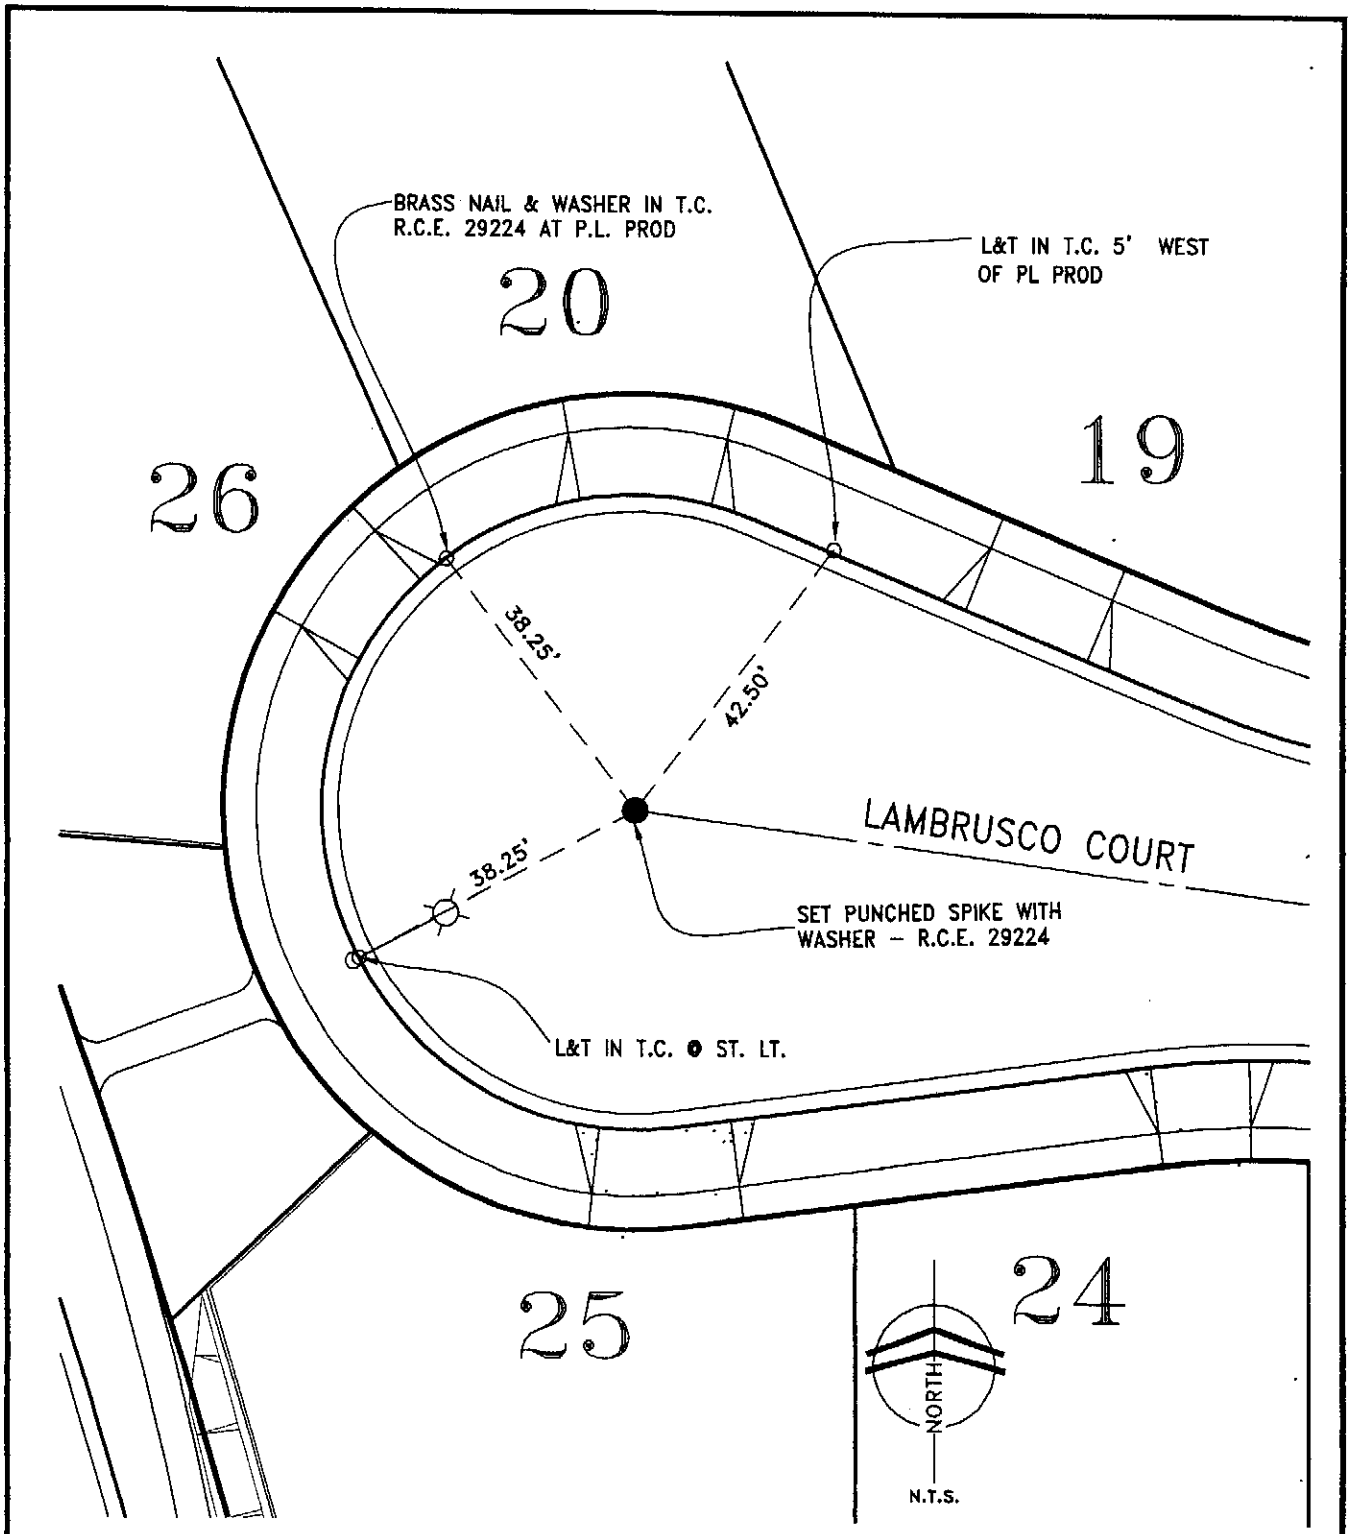

CITY OF RANCHO CUCAMONGA STREET TIES	TRACT NO. 15711-1
Dan Guerra & Associates 10271-B TRADEMARK STREET RANCHO CUCAMONGA, CA 91730 (909) 987-4306 CIVIL ENGINEERS • LAND SURVEYORS	AT CUL-DE-SAC OF LAMBRUSCO COURT
ENGINEER: DANIEL E. GUERRA	FIELD REVIEW: _____ DATE: _____
R.C.E. No. 29224	TIE BOOK: 24 PAGE: 39

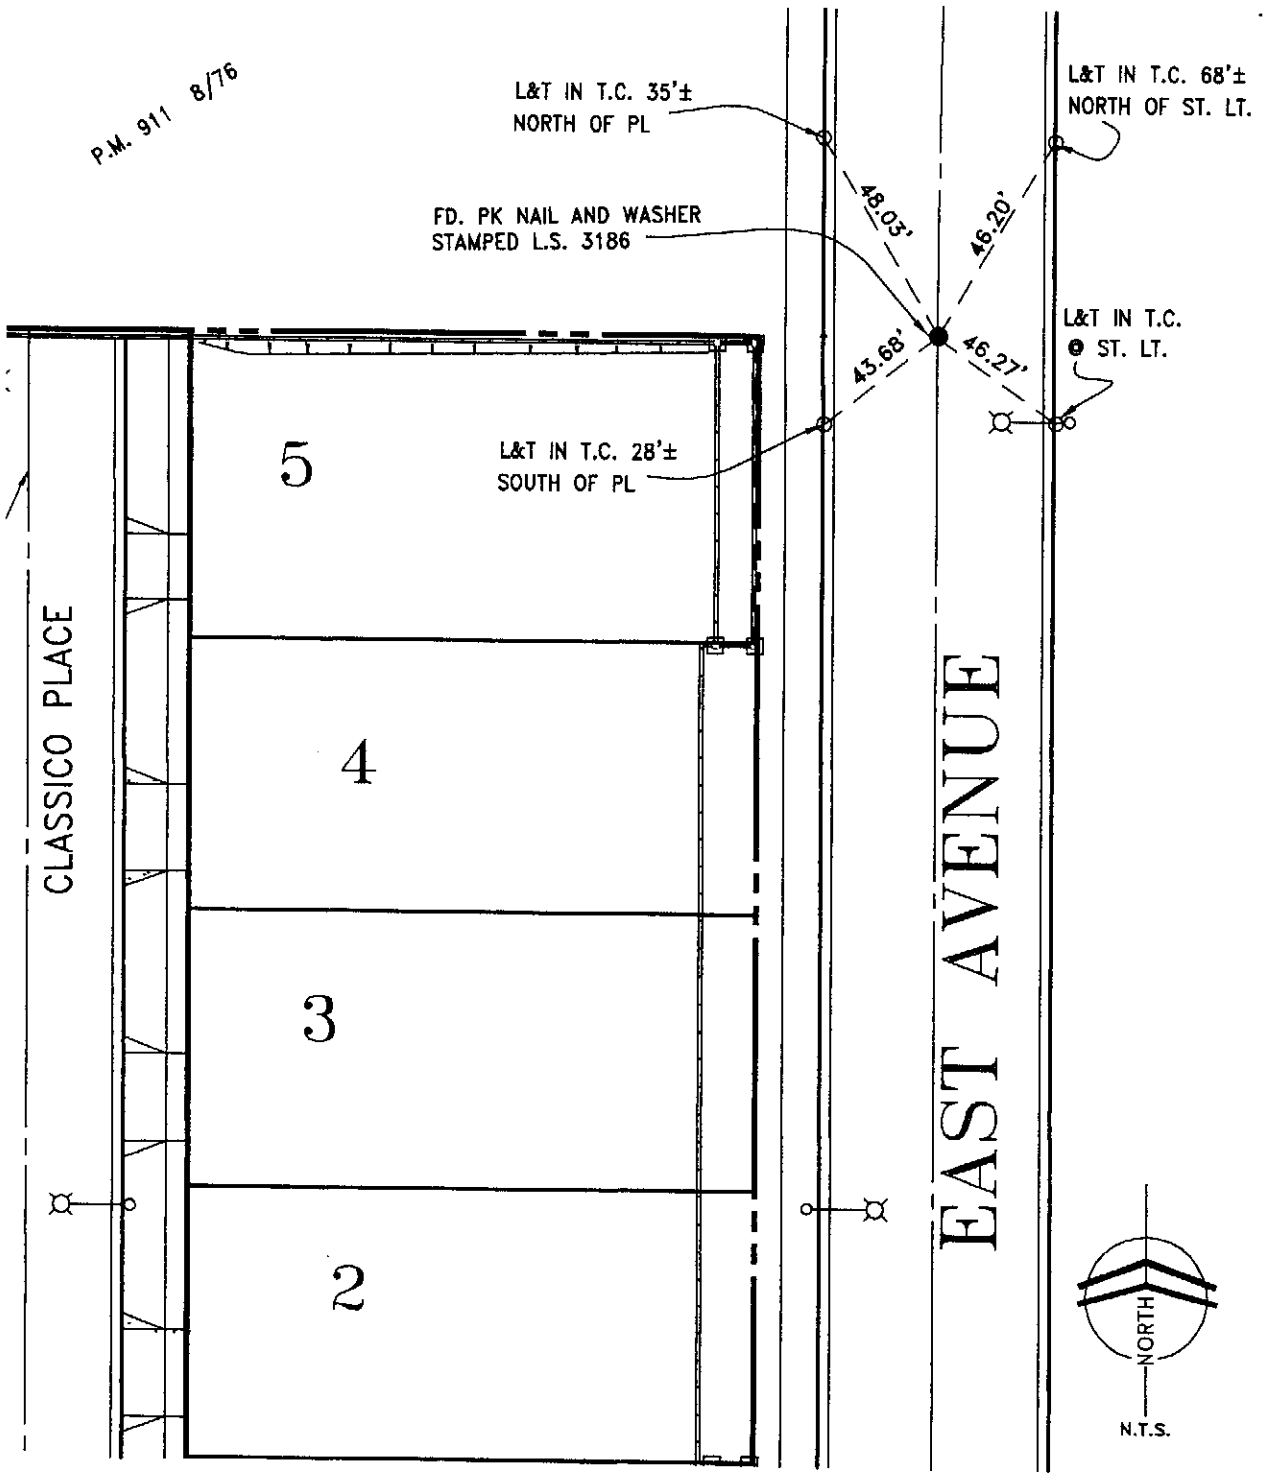

CITY OF RANCHO CUCAMONGA STREET TIES	TRACT NO. 15711-1
Dan Guerra & Associates 10271-B TRADEMARK STREET RANCHO CUCAMONGA, CA 91730 (909) 987-4306 CIVIL ENGINEERS • LAND SURVEYORS	CENTERLINE EAST AVENUE AT NORTH PL OF TRACT 15711-1
ENGINEER: DANIEL E. GUERRA	FIELD REVIEW: _____ DATE: _____
R.C.E. No. 29224	TIE BOOK: 24 PAGE: 40

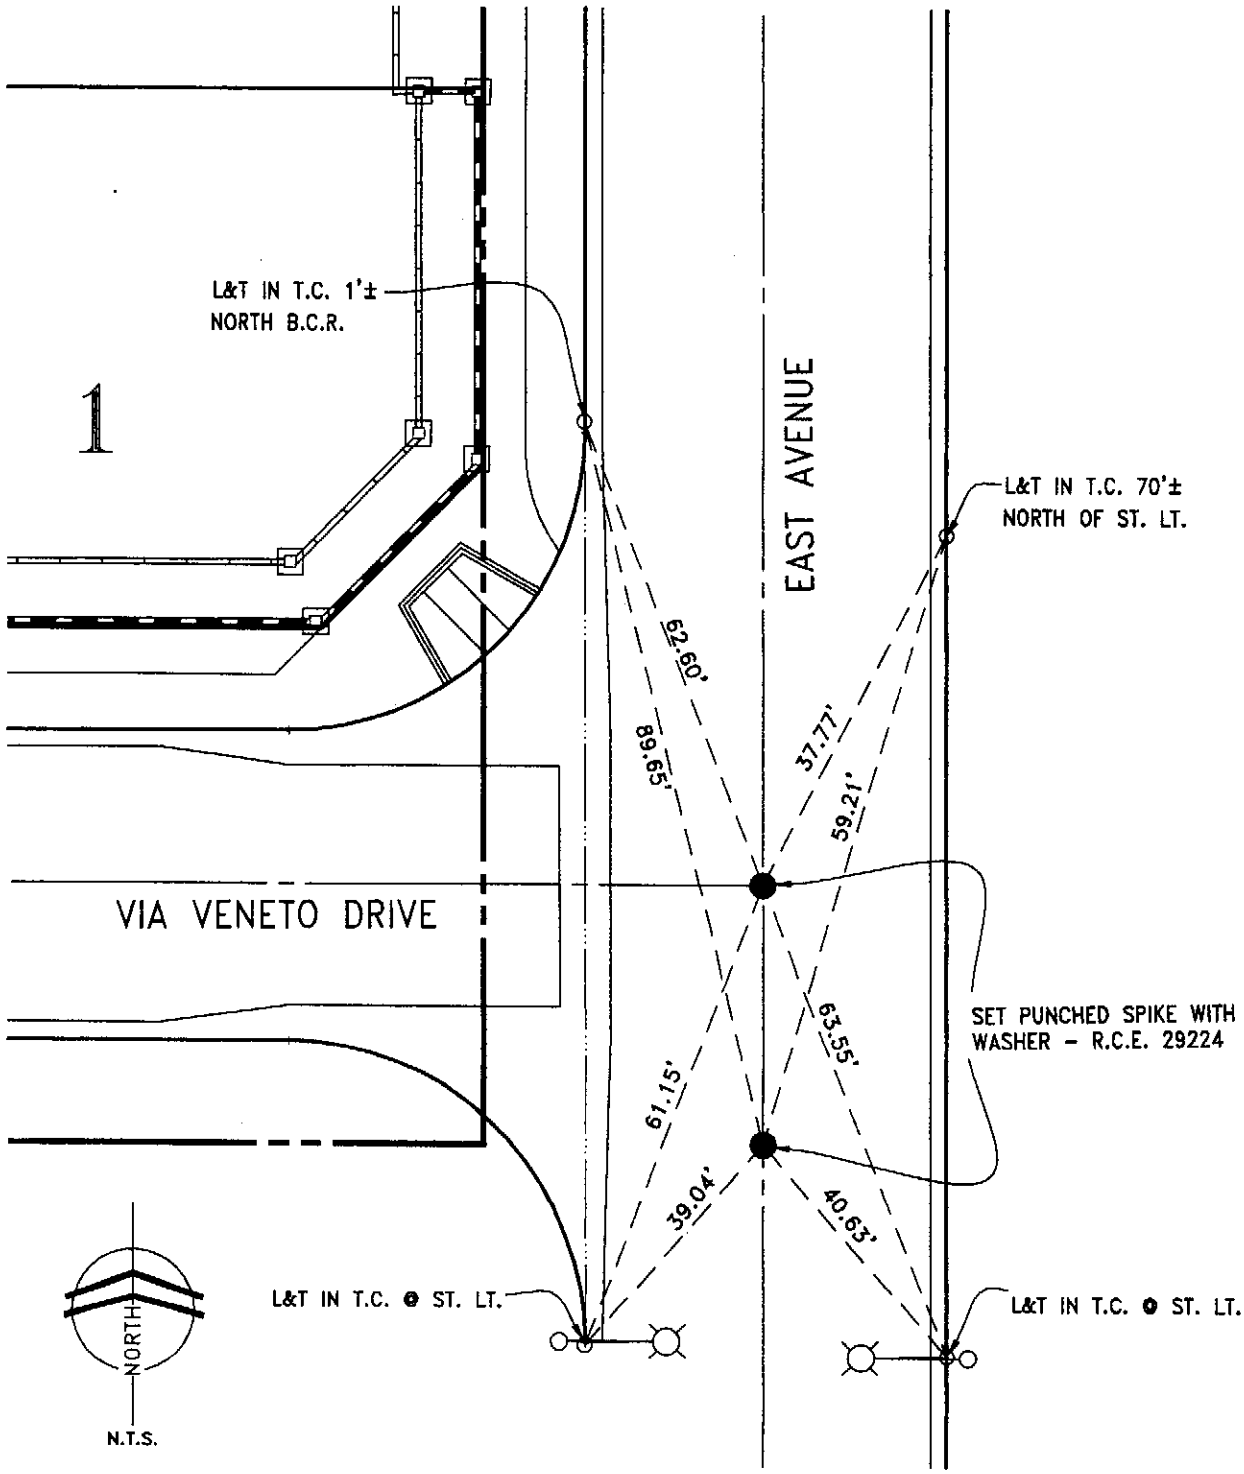

CITY OF RANCHO CUCAMONGA STREET TIES	TRACT NO. 15711-1
Dan Guerra & Associates 10271-B TRADEMARK STREET RANCHO CUCAMONGA, CA 91730 (909) 987-4306 CIVIL ENGINEERS • LAND SURVEYORS	AT INTERSECTION OF EAST AVENUE AND VIA VENETO DRIVE
ENGINEER: DANIEL E. GUERRA	FIELD REVIEW: _____ DATE: _____
R.C.E. No. 29224	TIE BOOK: 24 PAGE: 41

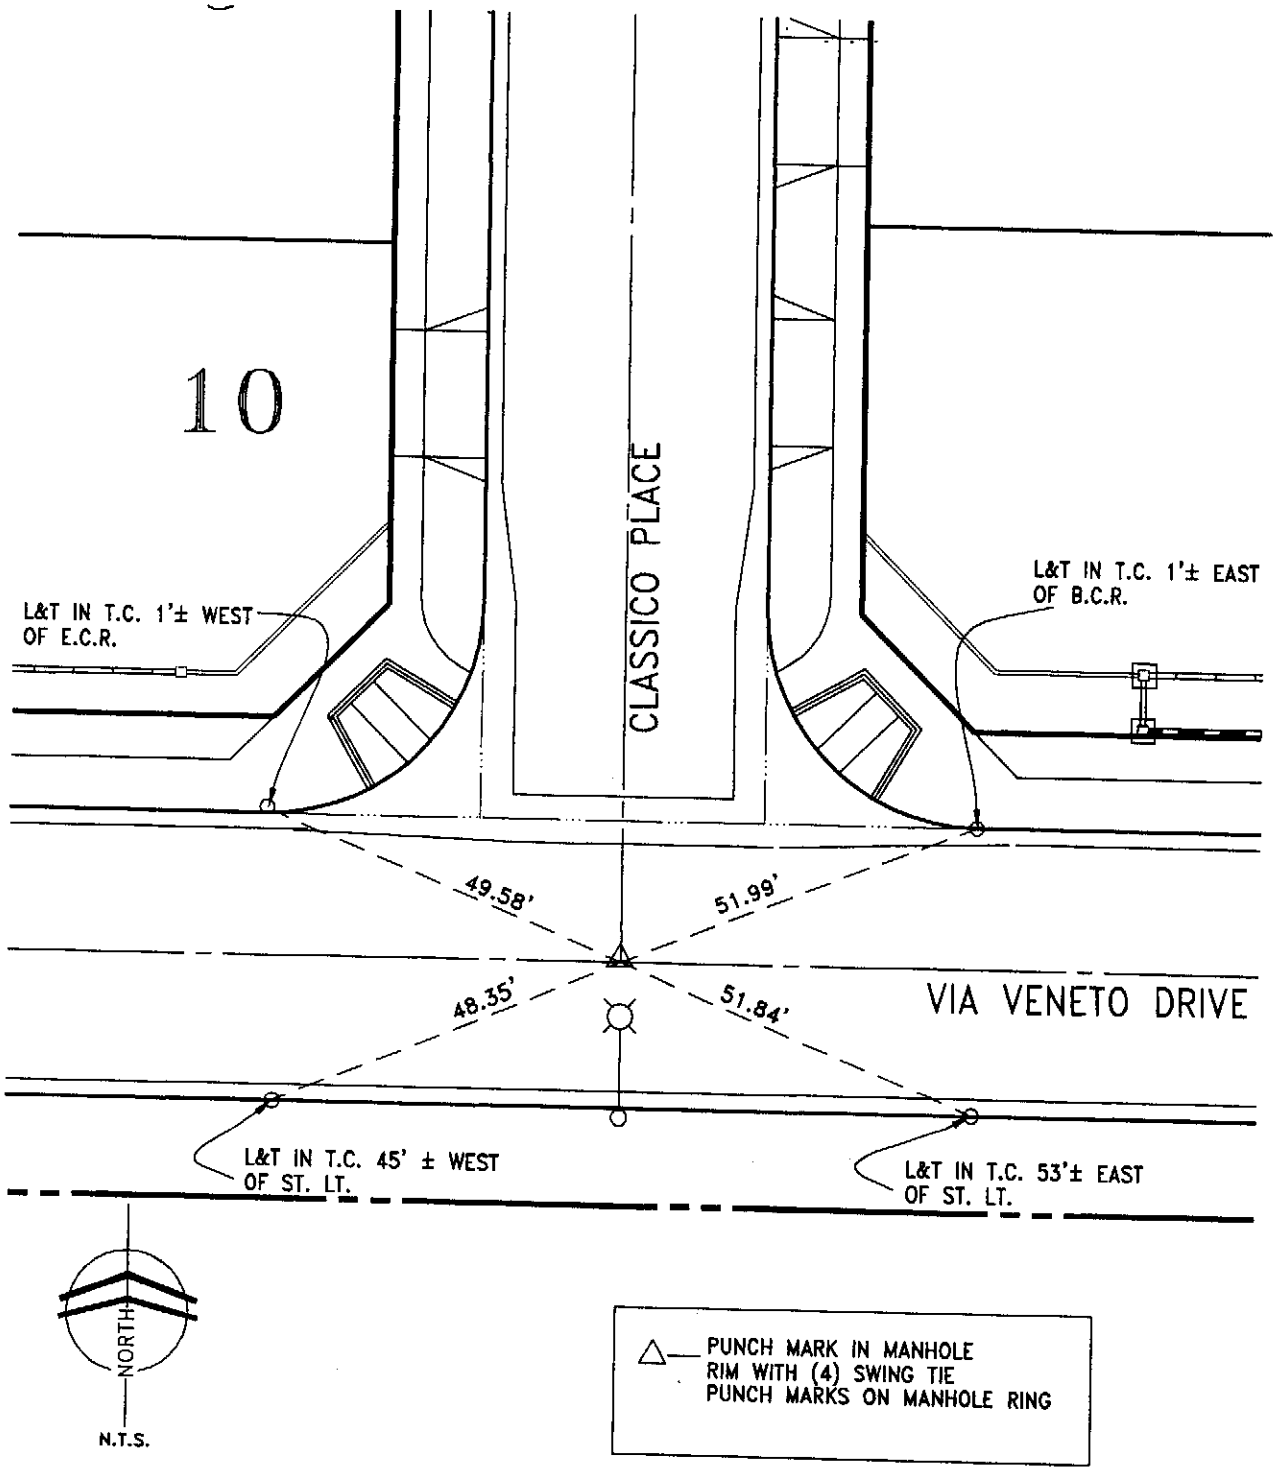

CITY OF RANCHO CUCAMONGA
STREET TIES

TRACT NO. 15711-1

Dan Guerra & Associates
10271-B TRADEMARK STREET
RANCHO CUCAMONGA, CA 91730
(909) 987-4306
CIVIL ENGINEERS • LAND SURVEYORS

AT INTERSECTION OF VIA VENETO DRIVE
CLASSICO PLACE

ENGINEER: DANIEL E. GUERRA

R.C.E. No. 29224

FIELD REVIEW: _____ DATE: _____

TIE BOOK: 24 PAGE: 42

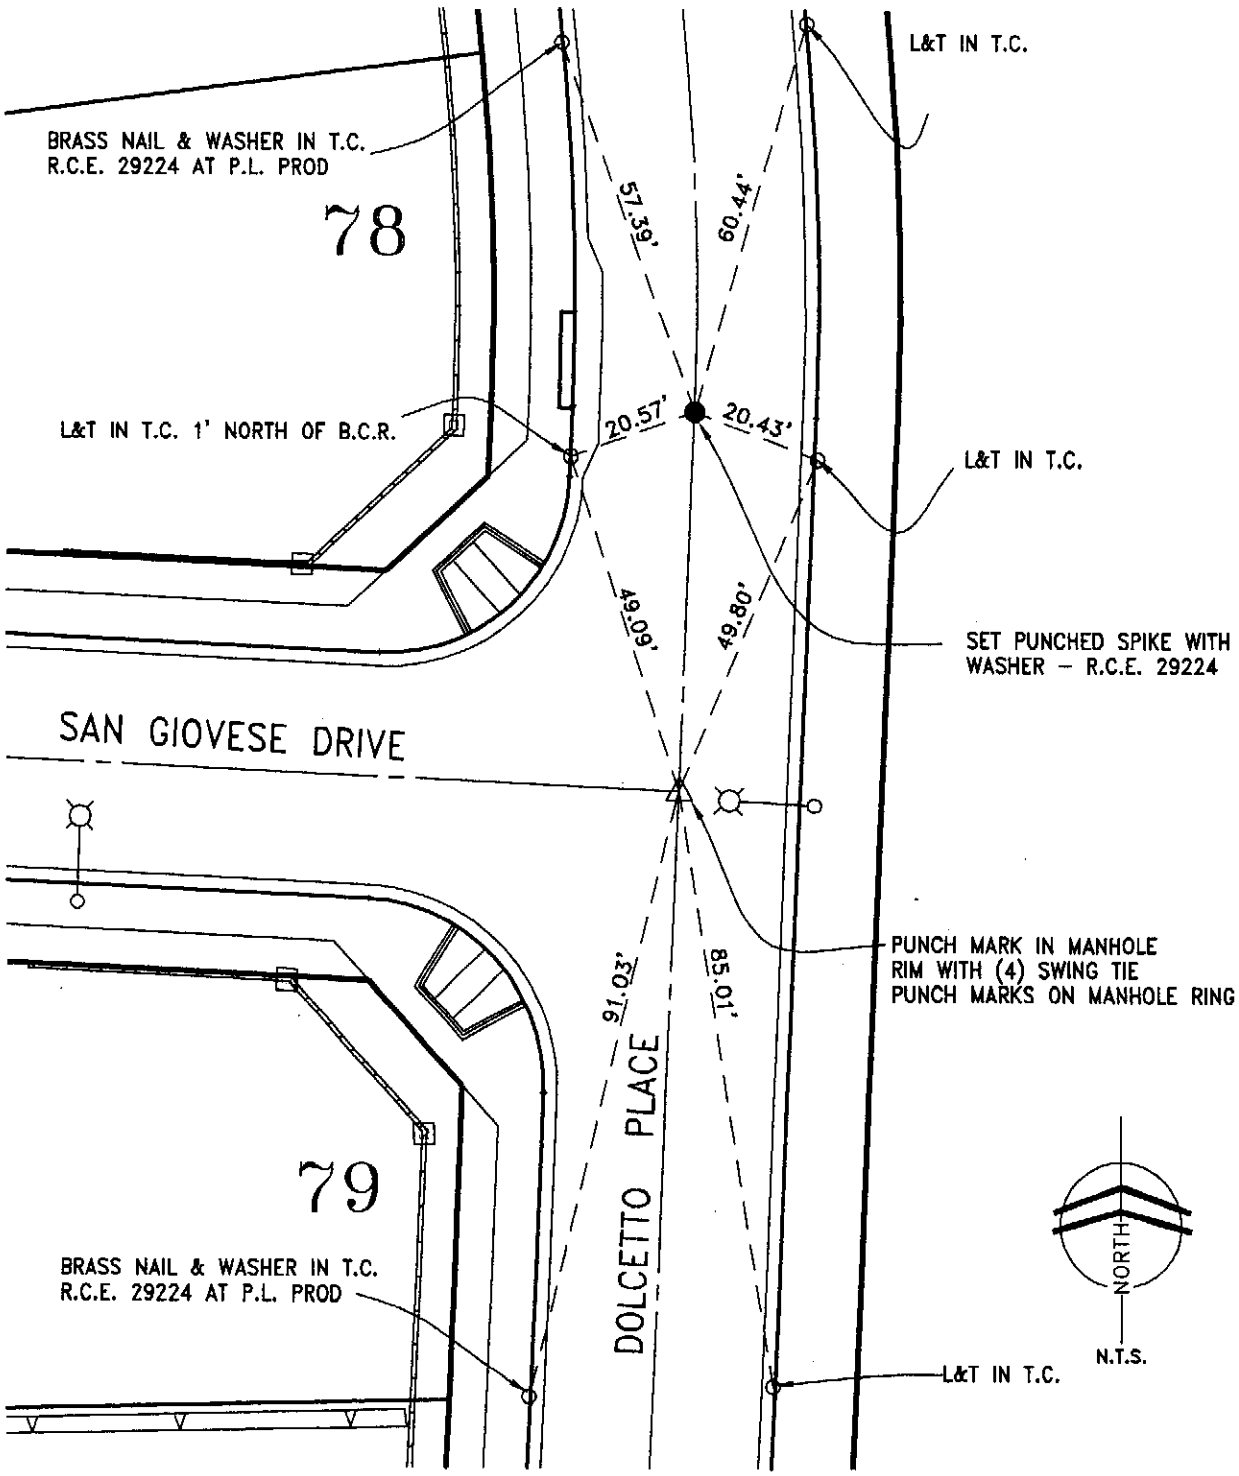

CITY OF RANCHO CUCAMONGA STREET TIES	TRACT NO. 15711-1
Dan Guerra & Associates 10271-B TRADEMARK STREET RANCHO CUCAMONGA, CA 91730 (909) 987-4306 CIVIL ENGINEERS • LAND SURVEYORS	AT INTERSECTION SAN GIOVESE DRIVE AND DOLCETTO PLACE AT E.C. DOLCETTO PLACE
ENGINEER: DANIEL E. GUERRA	FIELD REVIEW: _____ DATE: _____
R.C.E. No. 29224	TIE BOOK: 24 PAGE: 44

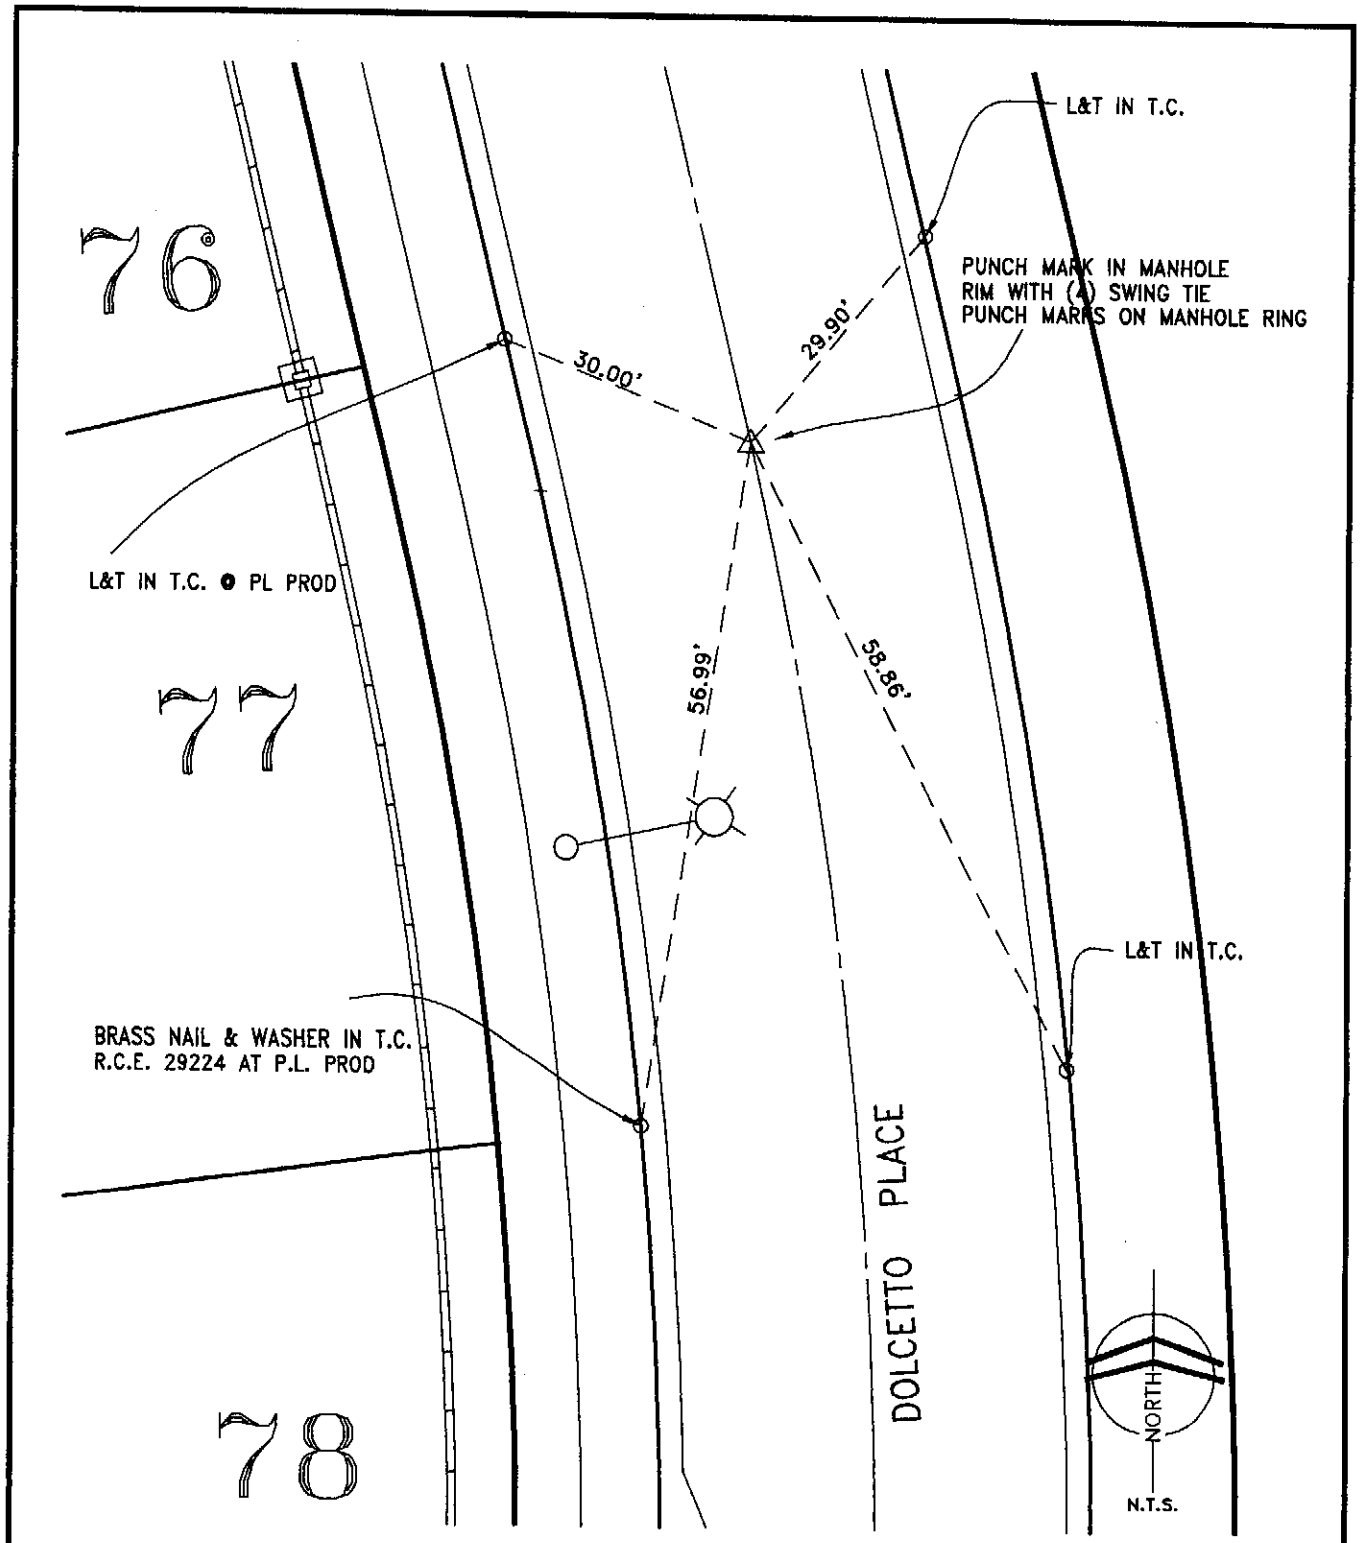

CITY OF RANCHO CUCAMONGA STREET TIES	TRACT NO. 15711-1
Dan Guerra & Associates 10271-B TRADEMARK STREET RANCHO CUCAMONGA, CA 91730 (909) 987-4306 CIVIL ENGINEERS • LAND SURVEYORS	AT B.C. DOLCETTO PLACE
ENGINEER: DANIEL E. GUERRA	FIELD REVIEW: _____ DATE: _____
R.C.E. No. 29224	TIE BOOK: 24 PAGE: 45

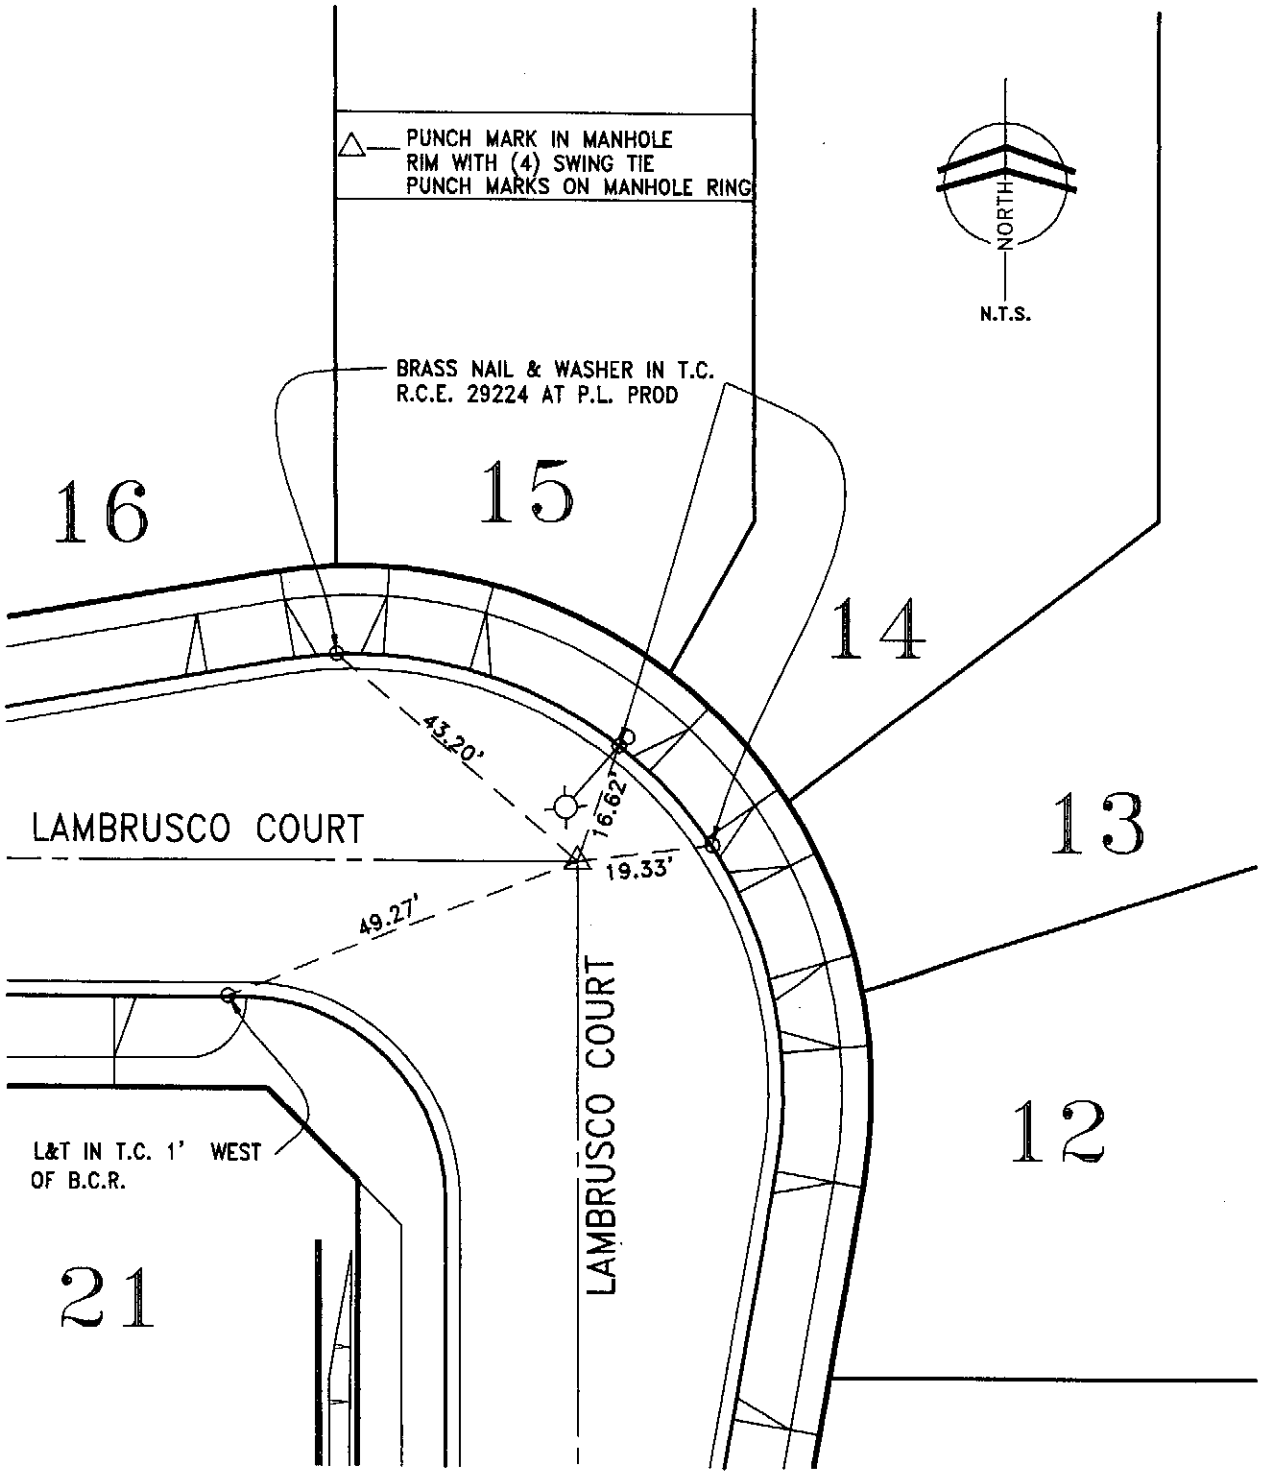

CITY OF RANCHO CUCAMONGA STREET TIES	TRACT NO. 15711-1
Dan Guerra & Associates 10271-B TRADEMARK STREET RANCHO CUCAMONGA, CA 91730 (909) 987-4306 CIVIL ENGINEERS • LAND SURVEYORS	AT ANGLE POINT LAMBRUSCO COURT
ENGINEER: DANIEL E. GUERRA	FIELD REVIEW: _____ DATE: _____
R.C.E. No. 29224	TIE BOOK: 24 PAGE: 46

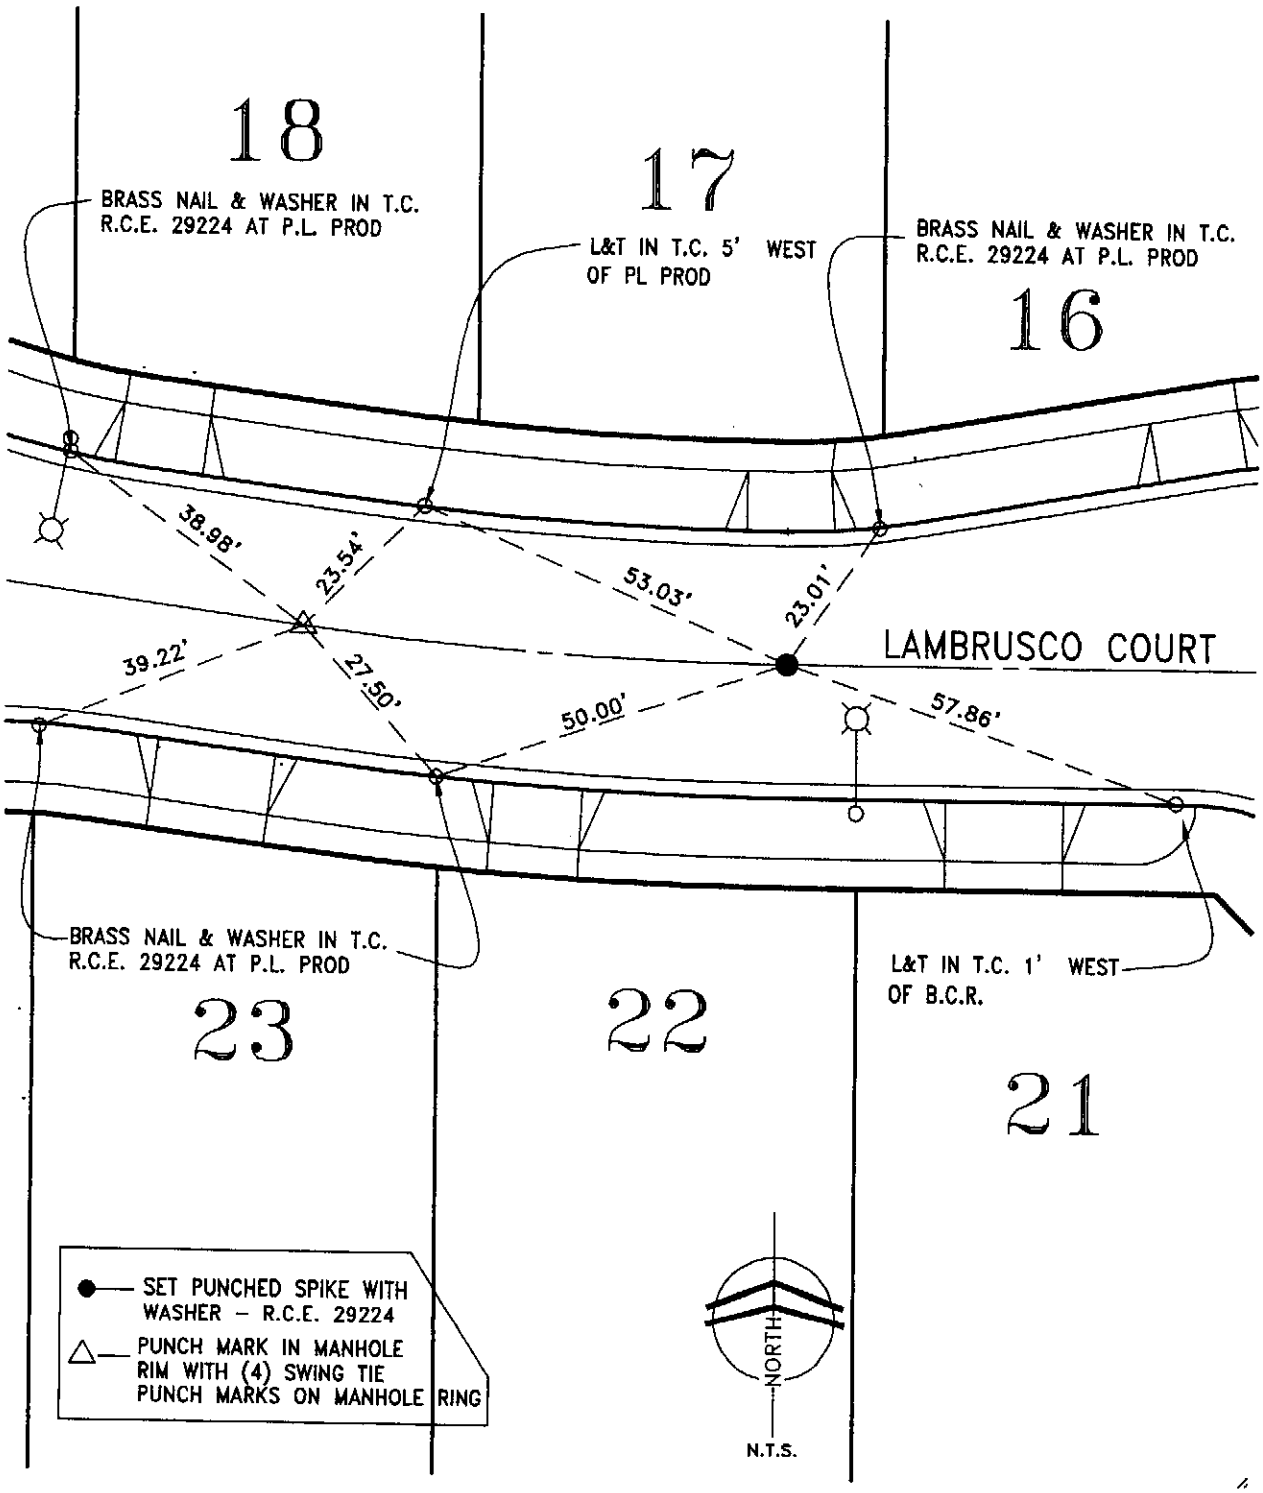

CITY OF RANCHO CUCAMONGA STREET TIES	TRACT NO. 15711-1
Dan Guerra & Associates 10271-B TRADEMARK STREET RANCHO CUCAMONGA, CA 91730 (909) 987-4306 CIVIL ENGINEERS • LAND SURVEYORS	AT B.C. AND E.C. OF LAMBRUSCO COURT
ENGINEER: DANIEL E. GUERRA	FIELD REVIEW: _____ DATE: _____
R.C.E. No. 29224	TIE BOOK: 24 PAGE: 47

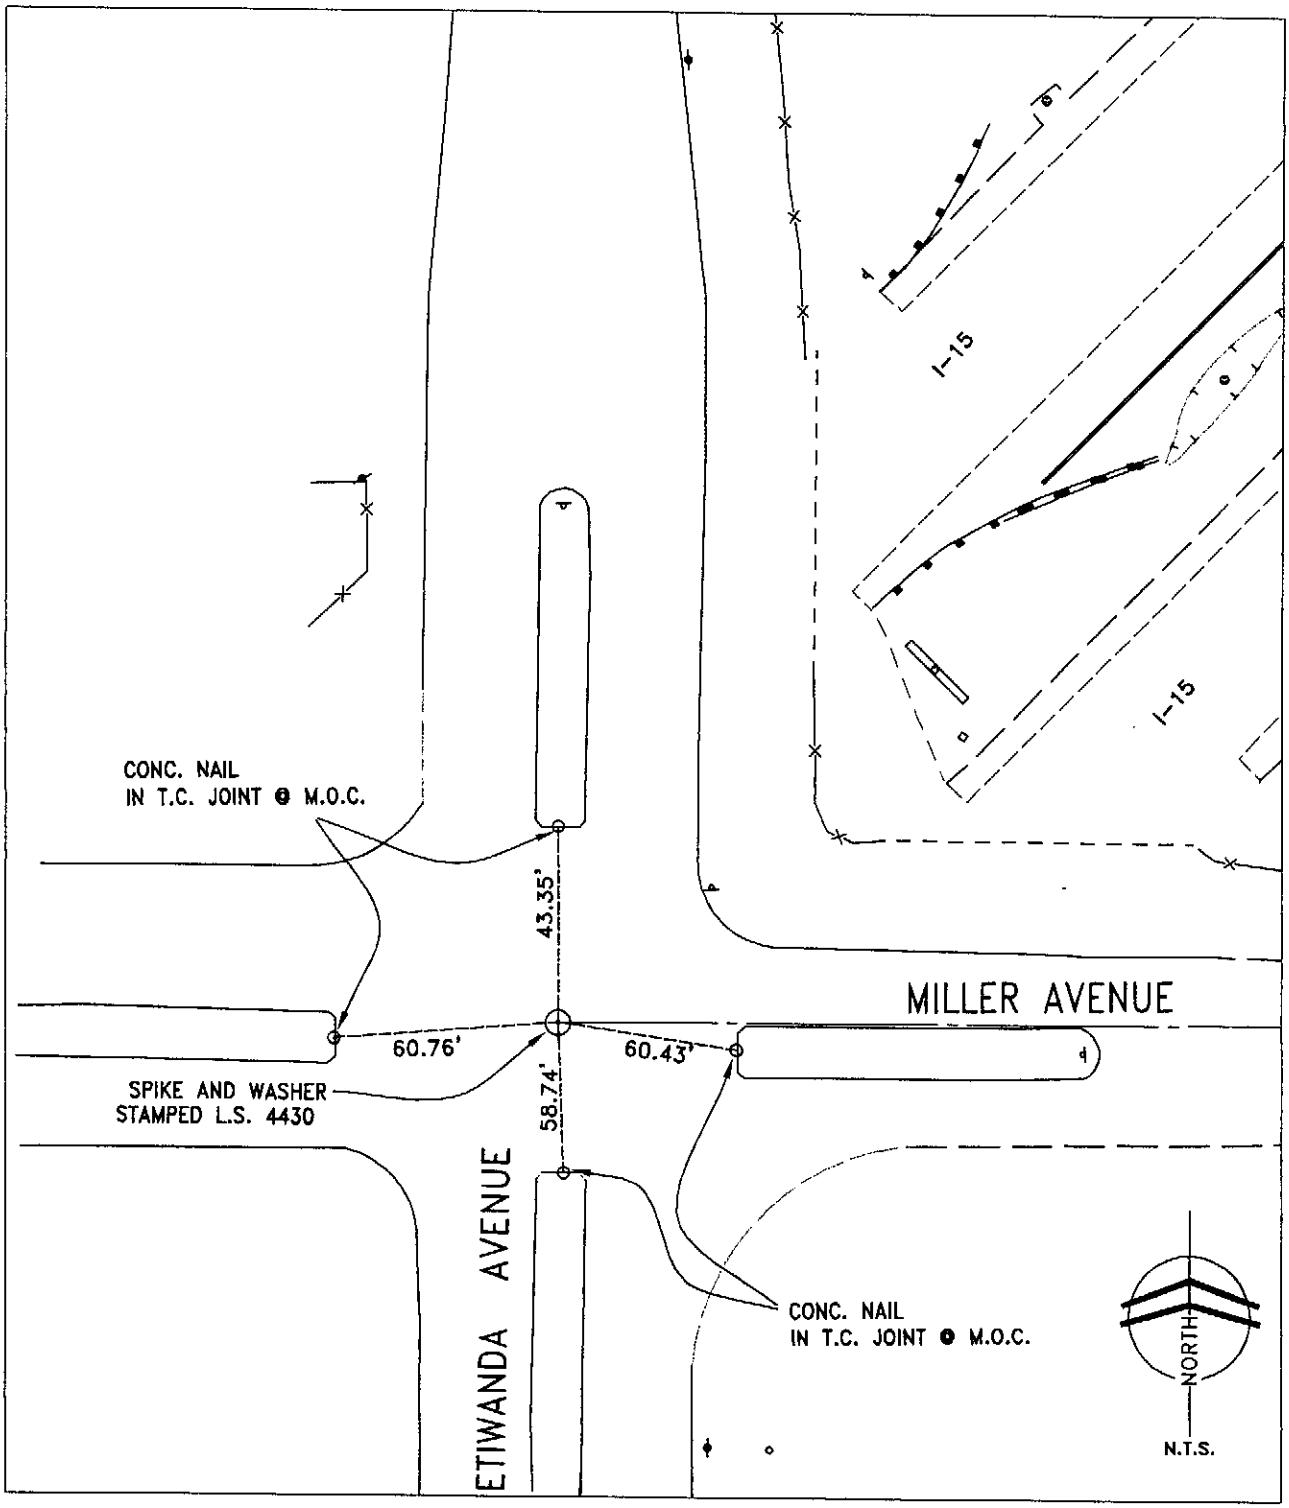

CITY OF RANCHO CUCAMONGA STREET TIES	TRACT 15711-1
Dan Guerra & Associates 10271-B TRADEMARK STREET RANCHO CUCAMONGA, CA 91730 (909) 987-4306 CIVIL ENGINEERS • LAND SURVEYORS	BOAT SPIKE AND WASHER STAMPED L.S. 4430 @ CENTERLINE INTERSECTION MILLER AVENUE AND ETIWANDA AVENUE
ENGINEER: DANIEL E. GUERRA	FIELD REVIEW: _____ DATE: _____
R.C.E. No. 29224	TIE BOOK: 24 PAGE: 48

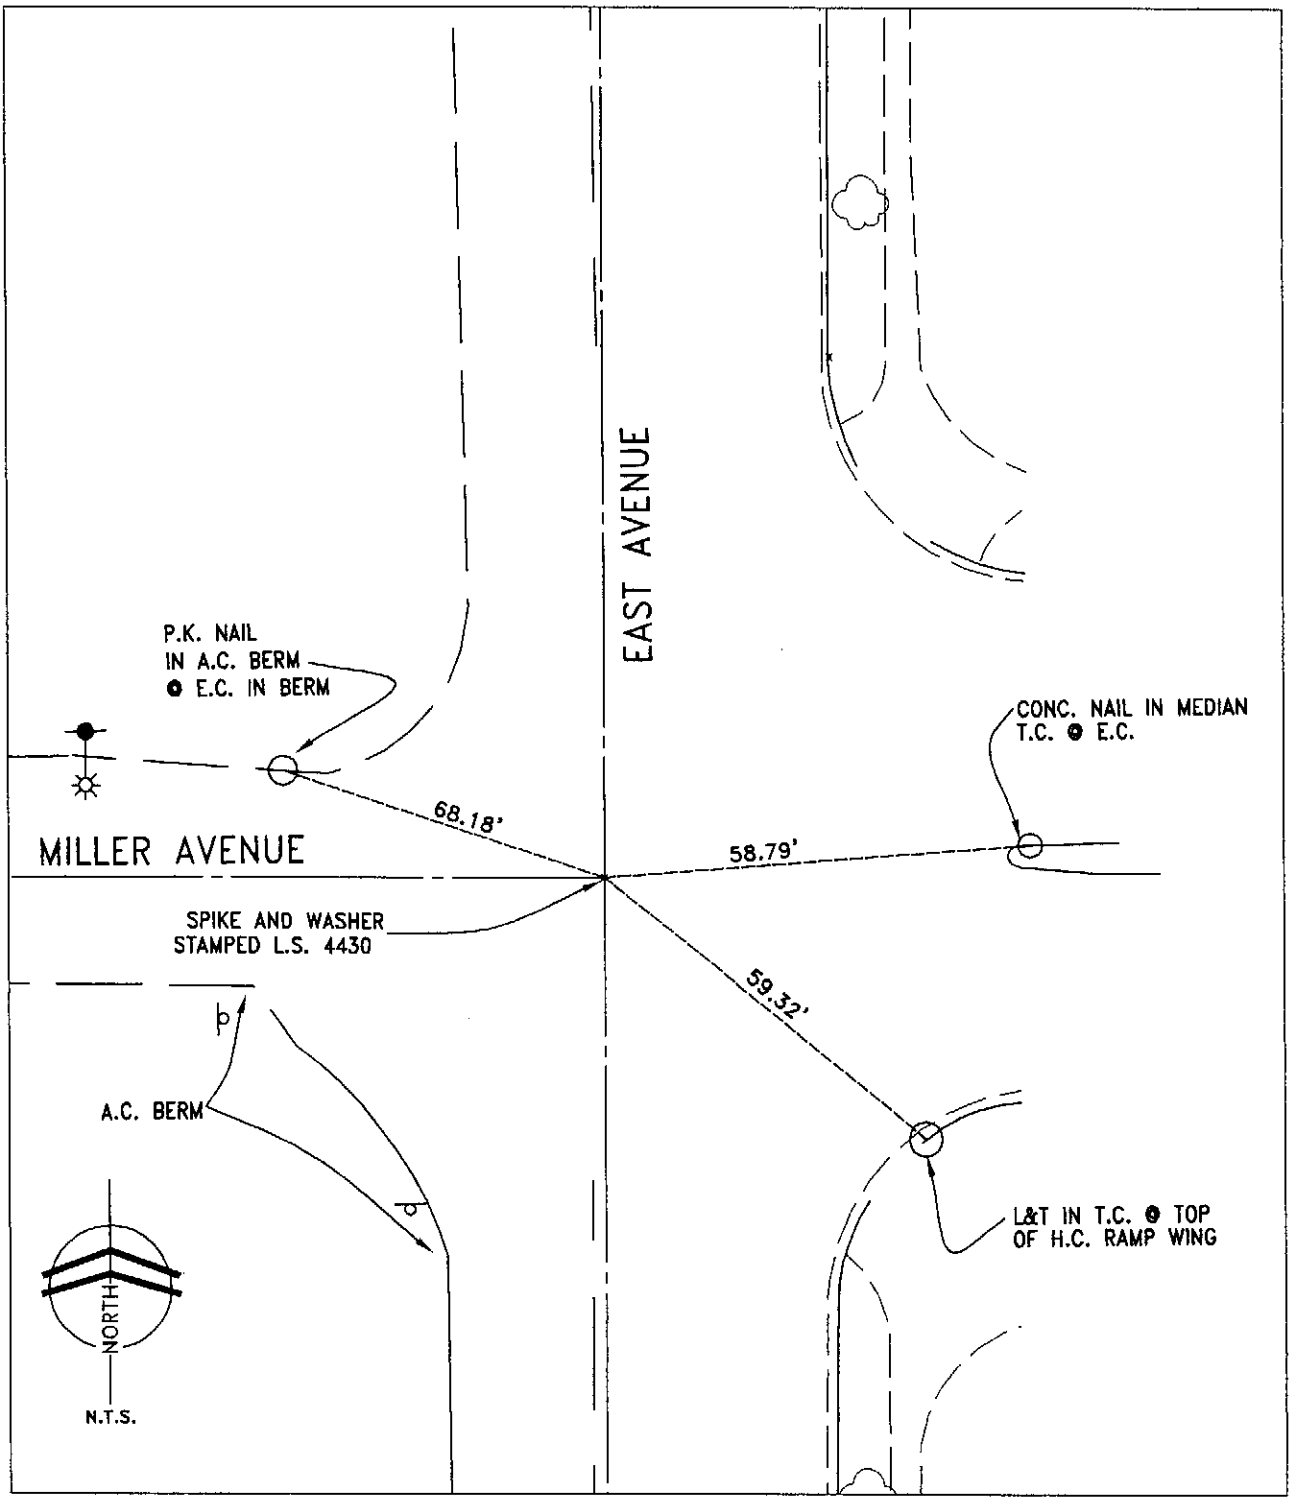

CITY OF RANCHO CUCAMONGA STREET TIES	TRACT 15711-1
Dan Guerra & Associates 10271-B TRADEMARK STREET RANCHO CUCAMONGA, CA 91730 (909) 987-4306 CIVIL ENGINEERS • LAND SURVEYORS	SPIKE AND WASHER STAMPED L.S. 4430 @ CENTERLINE INTERSECTION EAST AVENUE AND MILLER AVENUE
ENGINEER: DANIEL E. GUERRA	FIELD REVIEW: _____ DATE: _____
R.C.E. No. 29224	TIE BOOK: 24 PAGE: 49

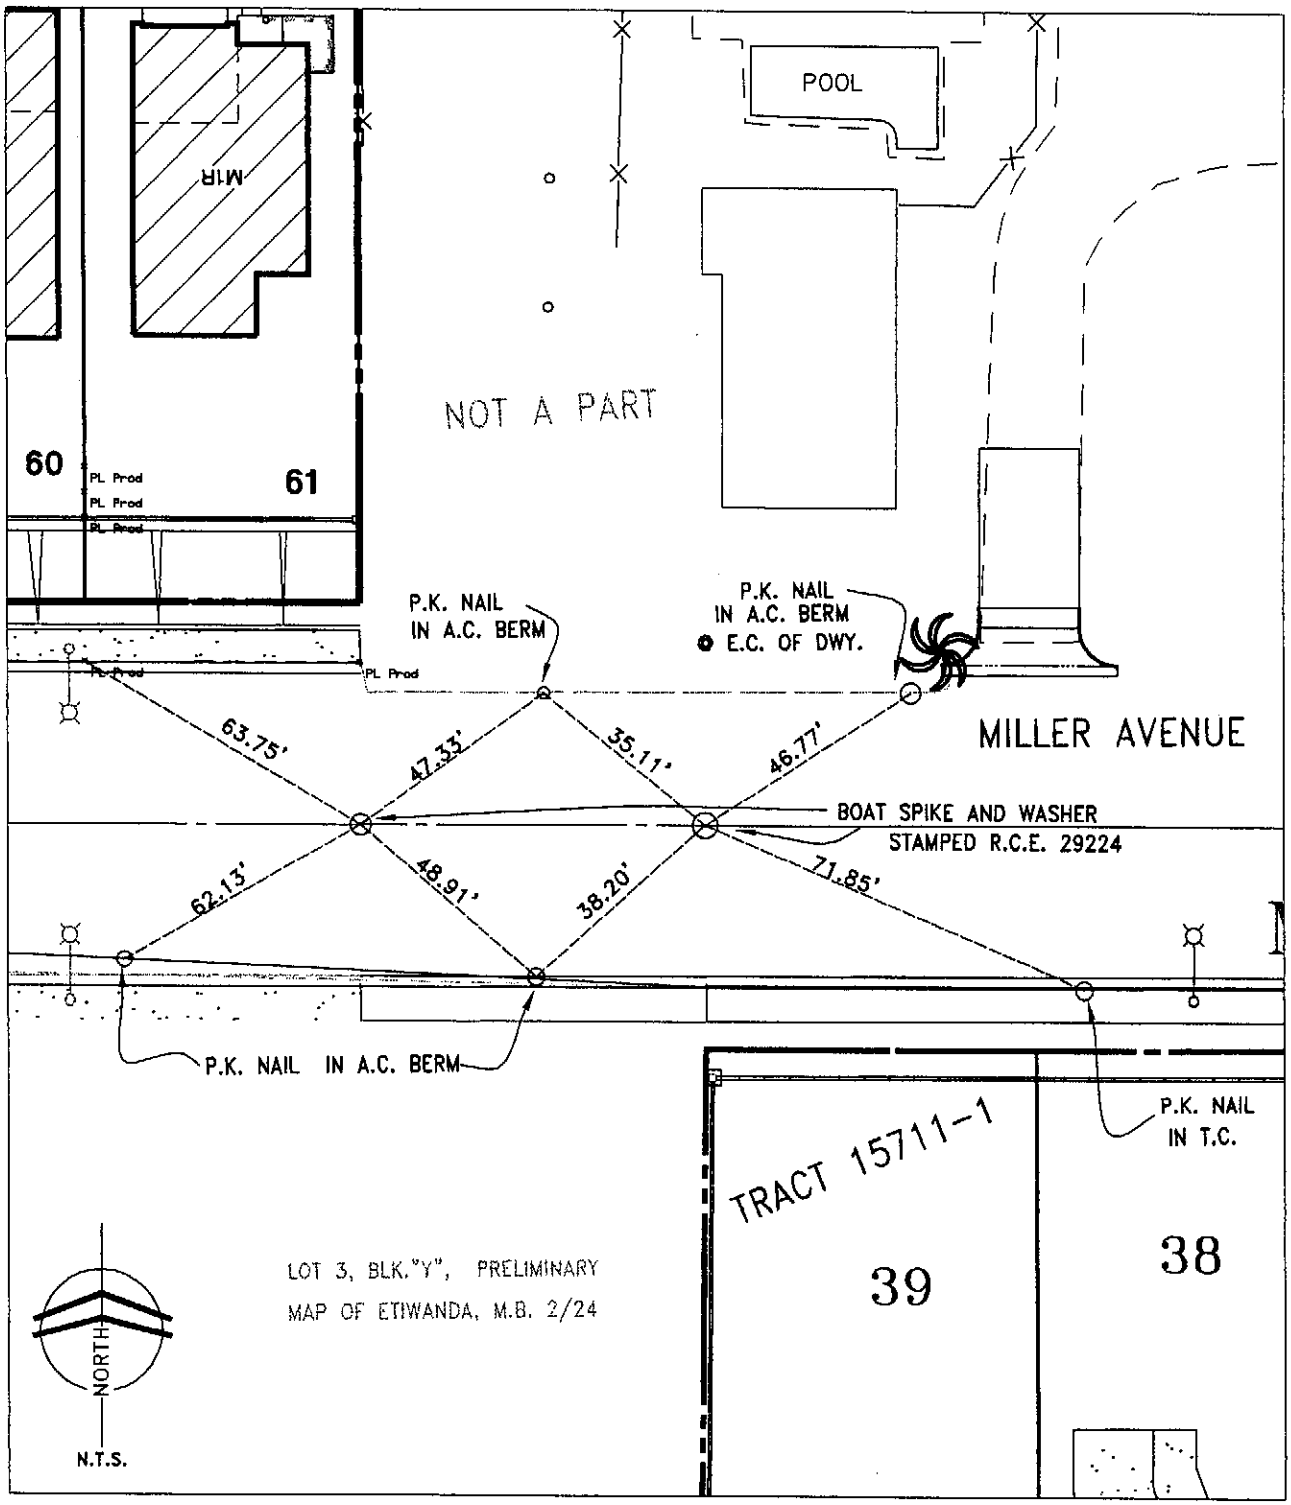

CITY OF RANCHO CUCAMONGA STREET TIES	TRACT 15711-1
Dan Guerra & Associates 10271-B TRADEMARK STREET RANCHO CUCAMONGA, CA 91730 (909) 987-4306 CIVIL ENGINEERS • LAND SURVEYORS	BOAT SPIKE AND WASHER STAMPED R.C.E. 29224 @ PROD OF WEST P.L. NOT A PART PARCEL AND TRACT 15711-0 BOAT SPIKE AND WASHER STAMPED R.C.E. 29224 @ PROD OF WEST P.L. TRACT 15711-1
ENGINEER: DANIEL E. GUERRA	FIELD REVIEW: _____ DATE: _____
R.C.E. No. 29224	TIE BOOK: 24 PAGE: 50

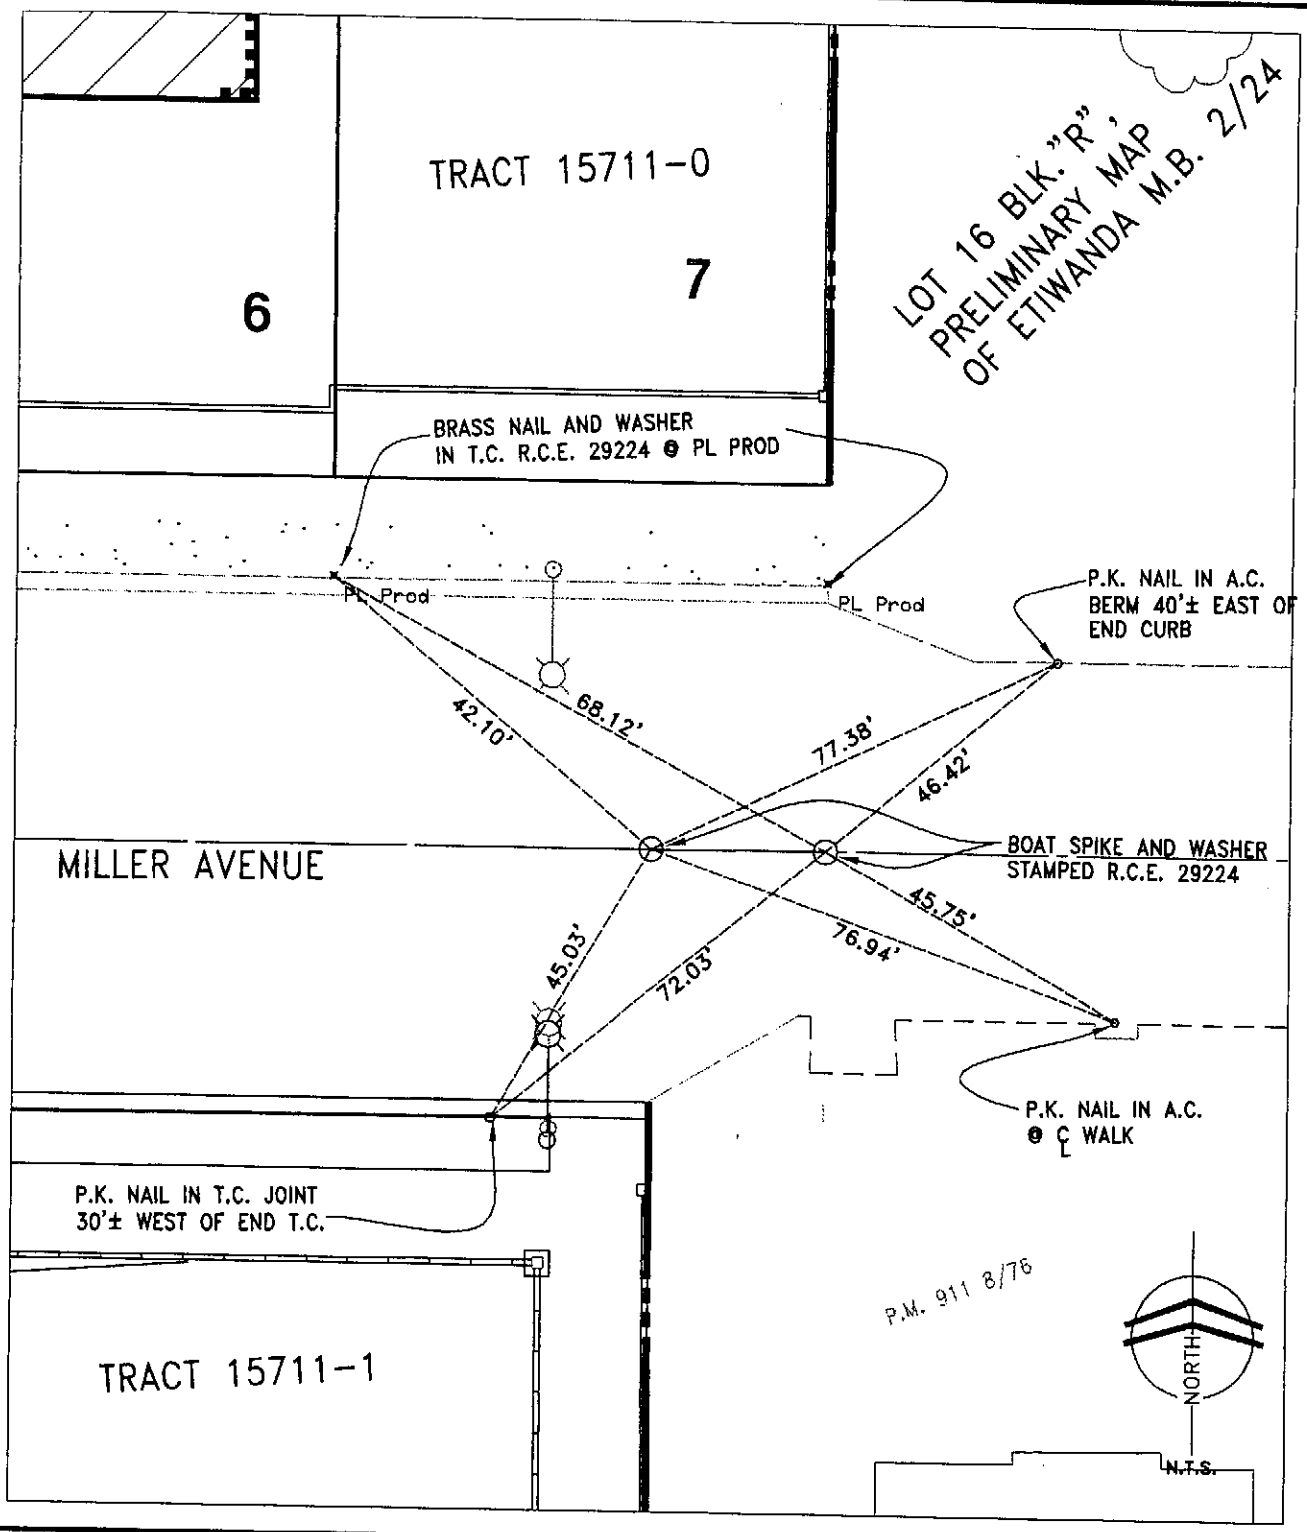

CITY OF RANCHO CUCAMONGA
STREET TIES

Dan Guerra & Associates
10271-B TRADEMARK STREET
RANCHO CUCAMONGA, CA 91730
(909) 987-4306
CIVIL ENGINEERS • LAND SURVEYORS

ENGINEER: DANIEL E. GUERRA

R.C.E. No. 29224

TRACT 15711-1

BOAT SPIKE AND WASHER STAMPED R.C.E. 29224 @ PROD OF EAST P.L. TRACT 15711-1

BOAT SPIKE AND WASHER STAMPED R.C.E. 29224 @PROD OF EAST P.L. TRACT 15711-0

FIELD REVIEW: _____ DATE: _____

TIE BOOK: 24 PAGE: 51

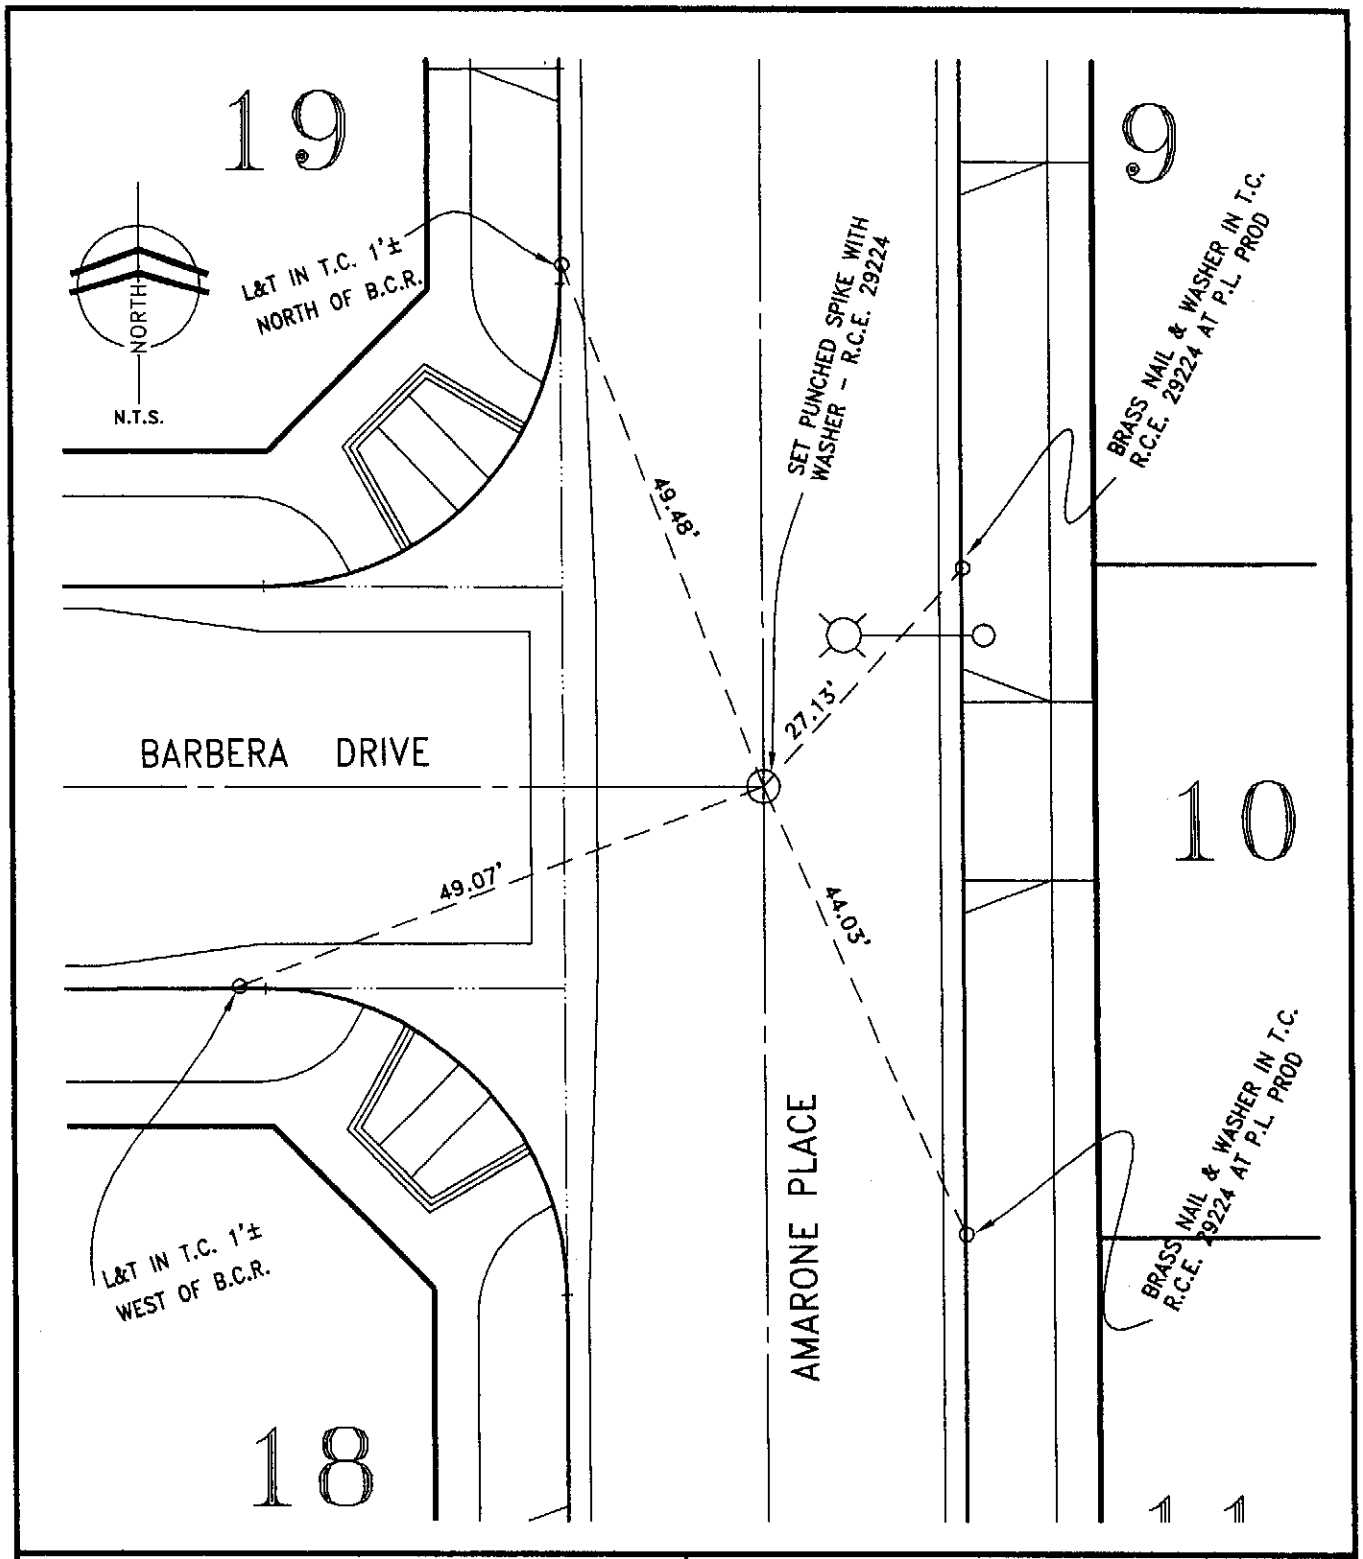

CITY OF RANCHO CUCAMONGA STREET TIES	TRACT NO. 15711-2
Dan Guerra & Associates 10271-B TRADEMARK STREET RANCHO CUCAMONGA, CA 91730 (909) 987-4306 CIVIL ENGINEERS • LAND SURVEYORS	AT INTERSECTION OF AMARONE PLACE AND BARBERA DRIVE
ENGINEER: DANIEL E. GUERRA	FIELD REVIEW: _____ DATE: _____
R.C.E. No. 29224	TIE BOOK: 24 PAGE: 52

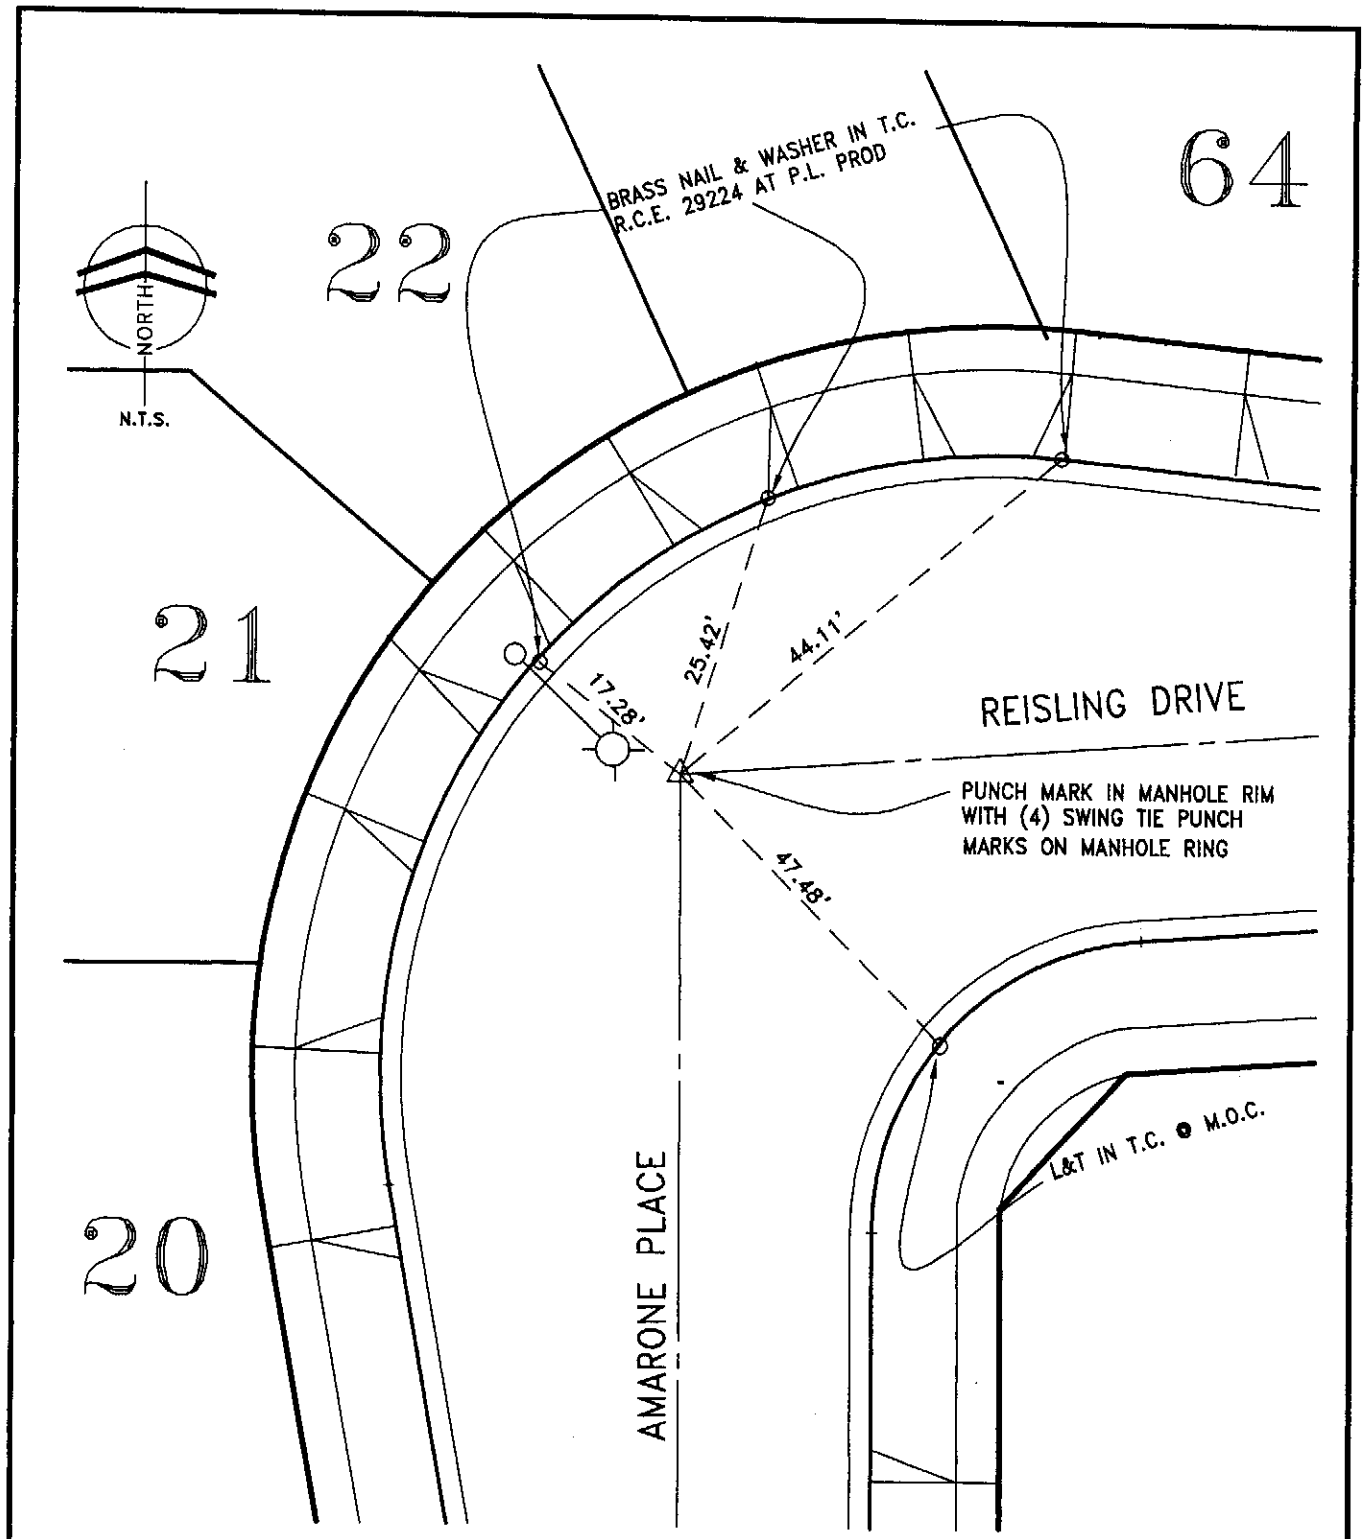

CITY OF RANCHO CUCAMONGA STREET TIES	TRACT NO. 15711-2
Dan Guerra & Associates 10271-B TRADEMARK STREET RANCHO CUCAMONGA, CA 91730 (909) 987-4306 CIVIL ENGINEERS • LAND SURVEYORS	AT INTERSECTION OF REISLING DRIVE AND AMARONE PLACE
ENGINEER: DANIEL E. GUERRA	FIELD REVIEW: _____ DATE: _____
R.C.E. No. 29224	TIE BOOK: 24 PAGE: 53

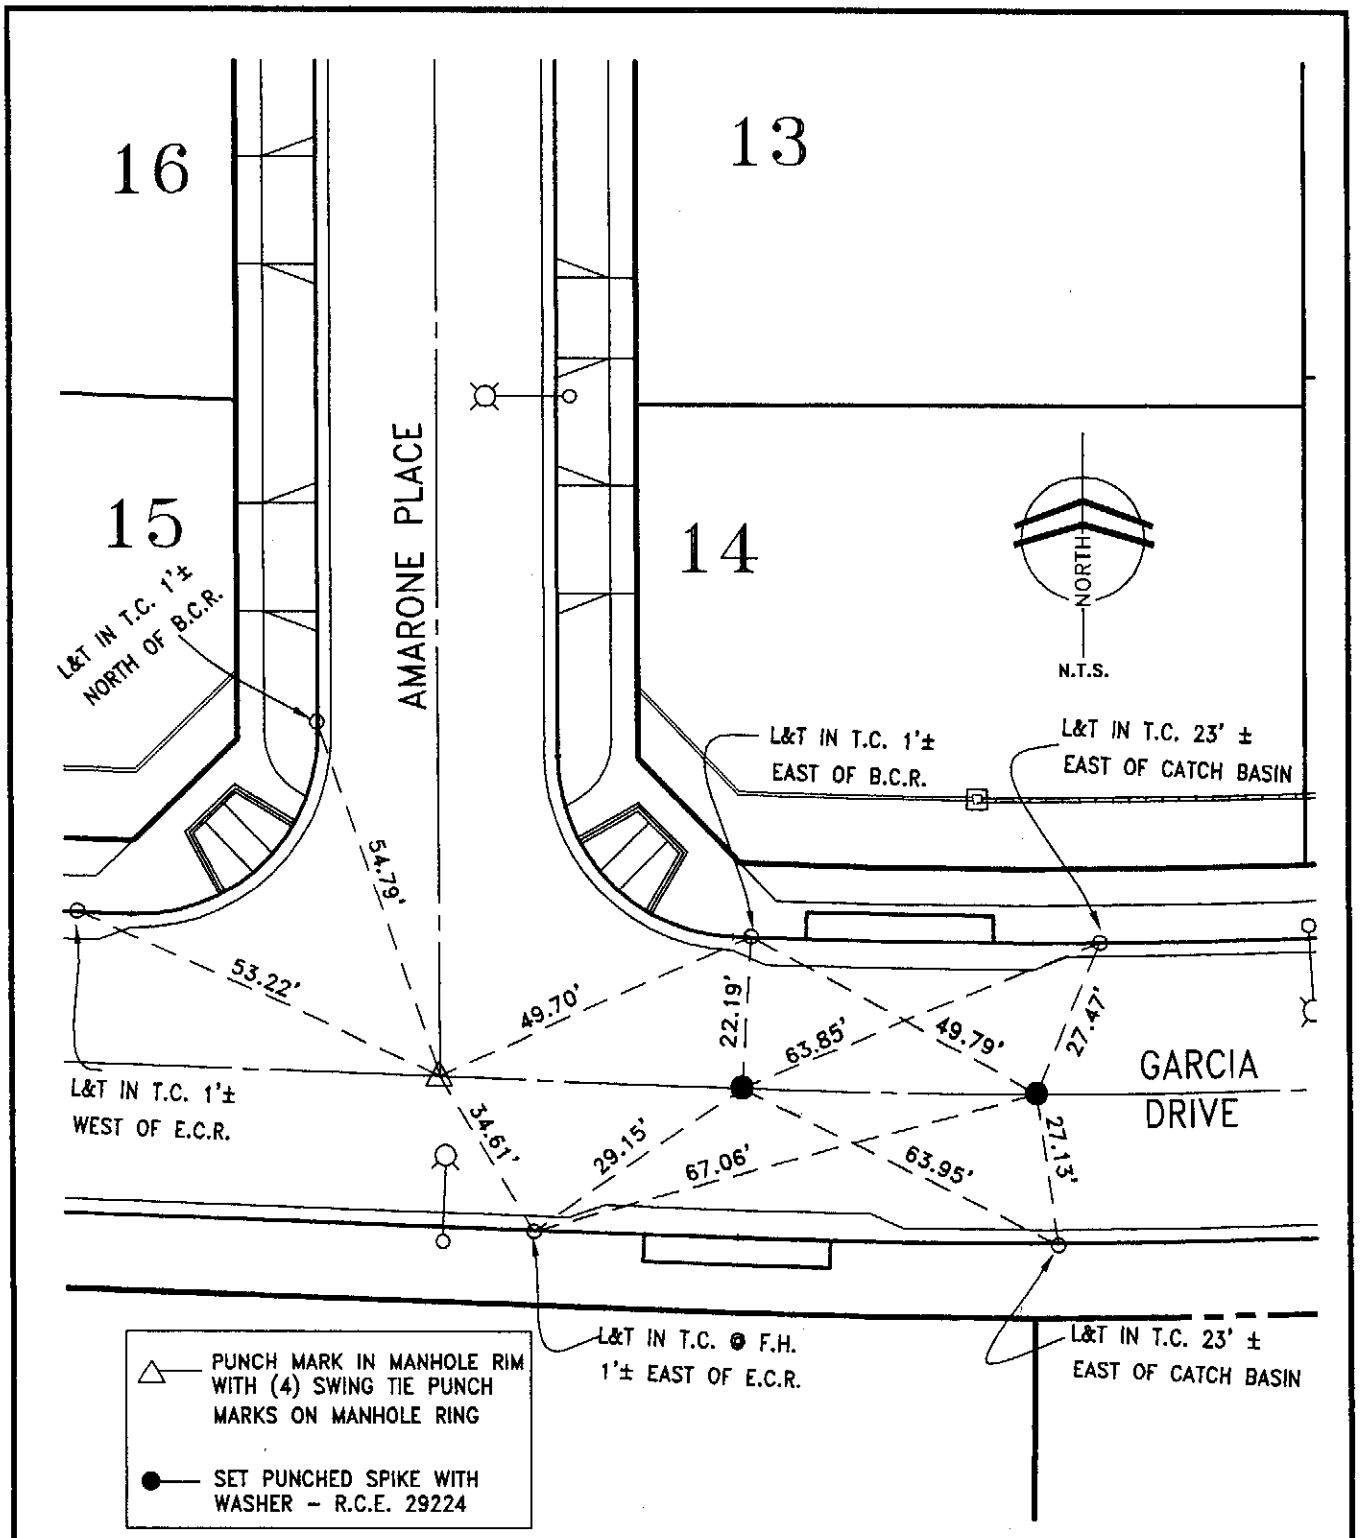

CITY OF RANCHO CUCAMONGA STREET TIES	TRACT NO. 15711-2
Dan Guerra & Associates 10271-B TRADEMARK STREET RANCHO CUCAMONGA, CA 91730 (909) 987-4306 CIVIL ENGINEERS • LAND SURVEYORS	AT INTERSECTION GARCIA DRIVE AND AMARONE PLACE AT B.C. GARCIA DRIVE AT E.C. GARCIA DRIVE
ENGINEER: DANIEL E. GUERRA	FIELD REVIEW: _____ DATE: _____
R.C.E. No. 29224	TIE BOOK: 24 PAGE: 54

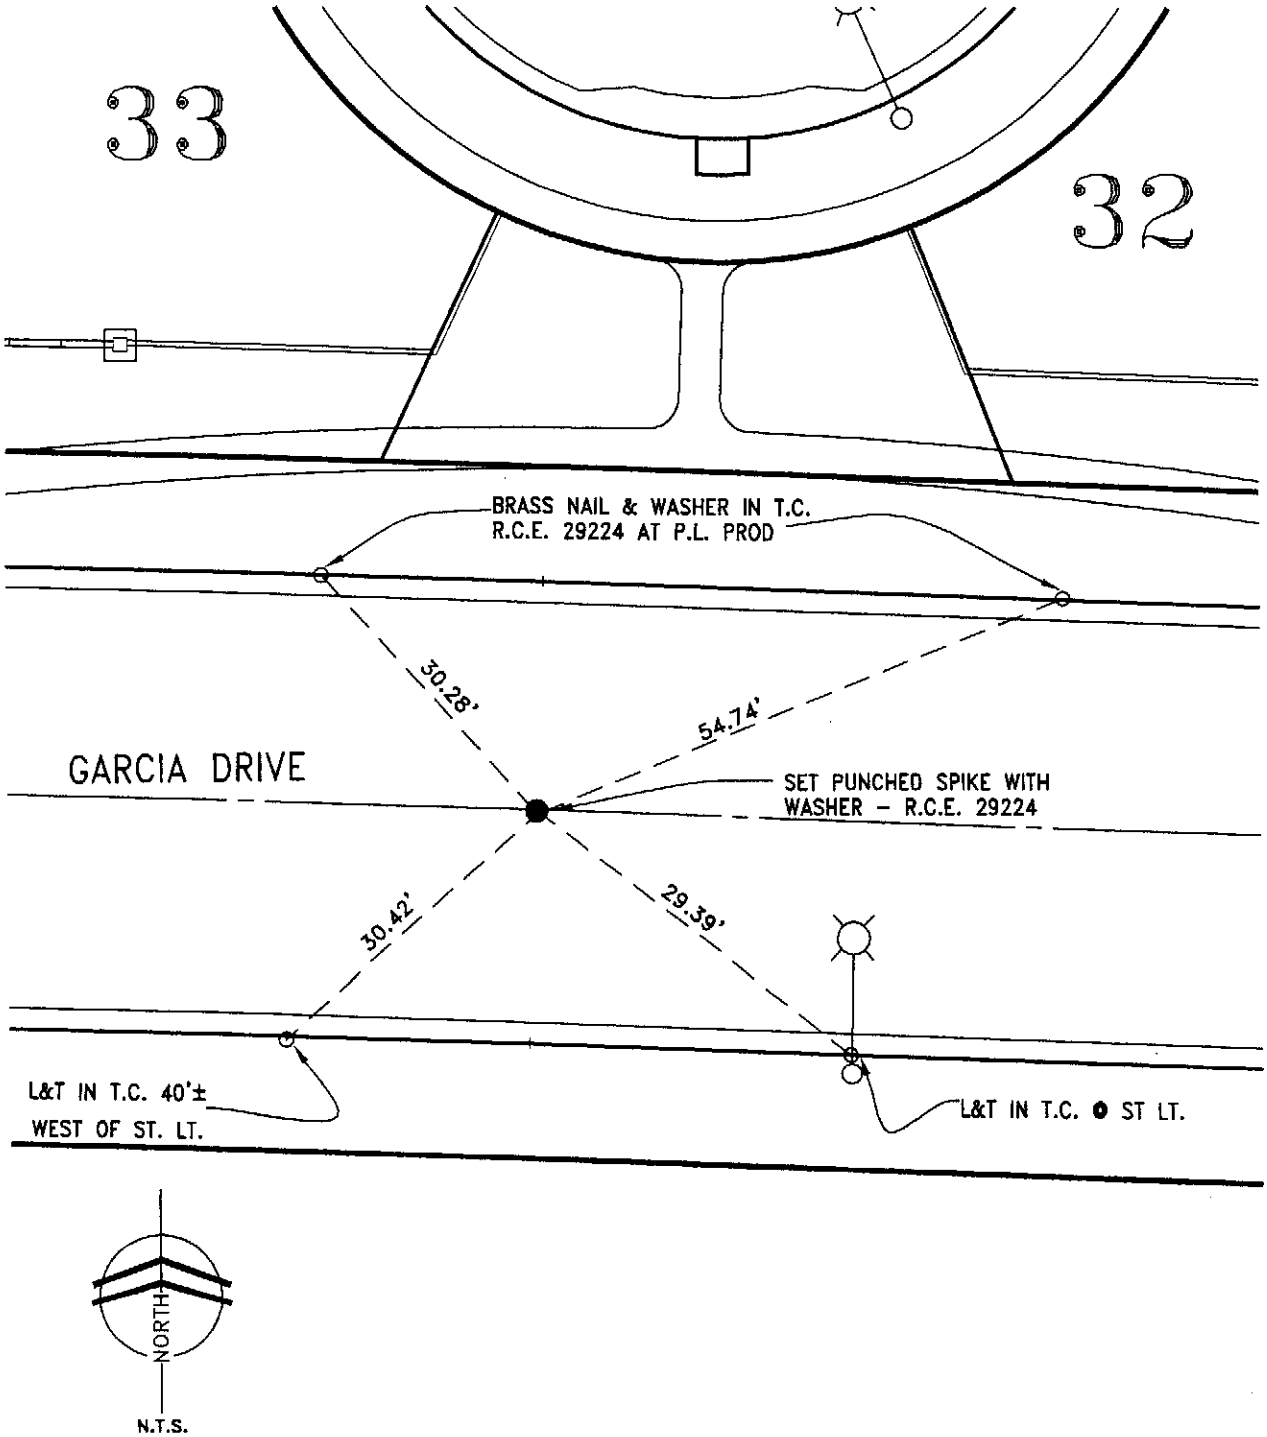

CITY OF RANCHO CUCAMONGA STREET TIES	TRACT NO. 15711-2
Dan Guerra & Associates 10271-B TRADEMARK STREET RANCHO CUCAMONGA, CA 91730 (909) 987-4306 CIVIL ENGINEERS • LAND SURVEYORS	AT E.C. GARCIA DRIVE, SOUTH OF MARGAUX PLACE
ENGINEER: DANIEL E. GUERRA	FIELD REVIEW: _____ DATE: _____
R.C.E. No. 29224	TIE BOOK: 24 PAGE: 55

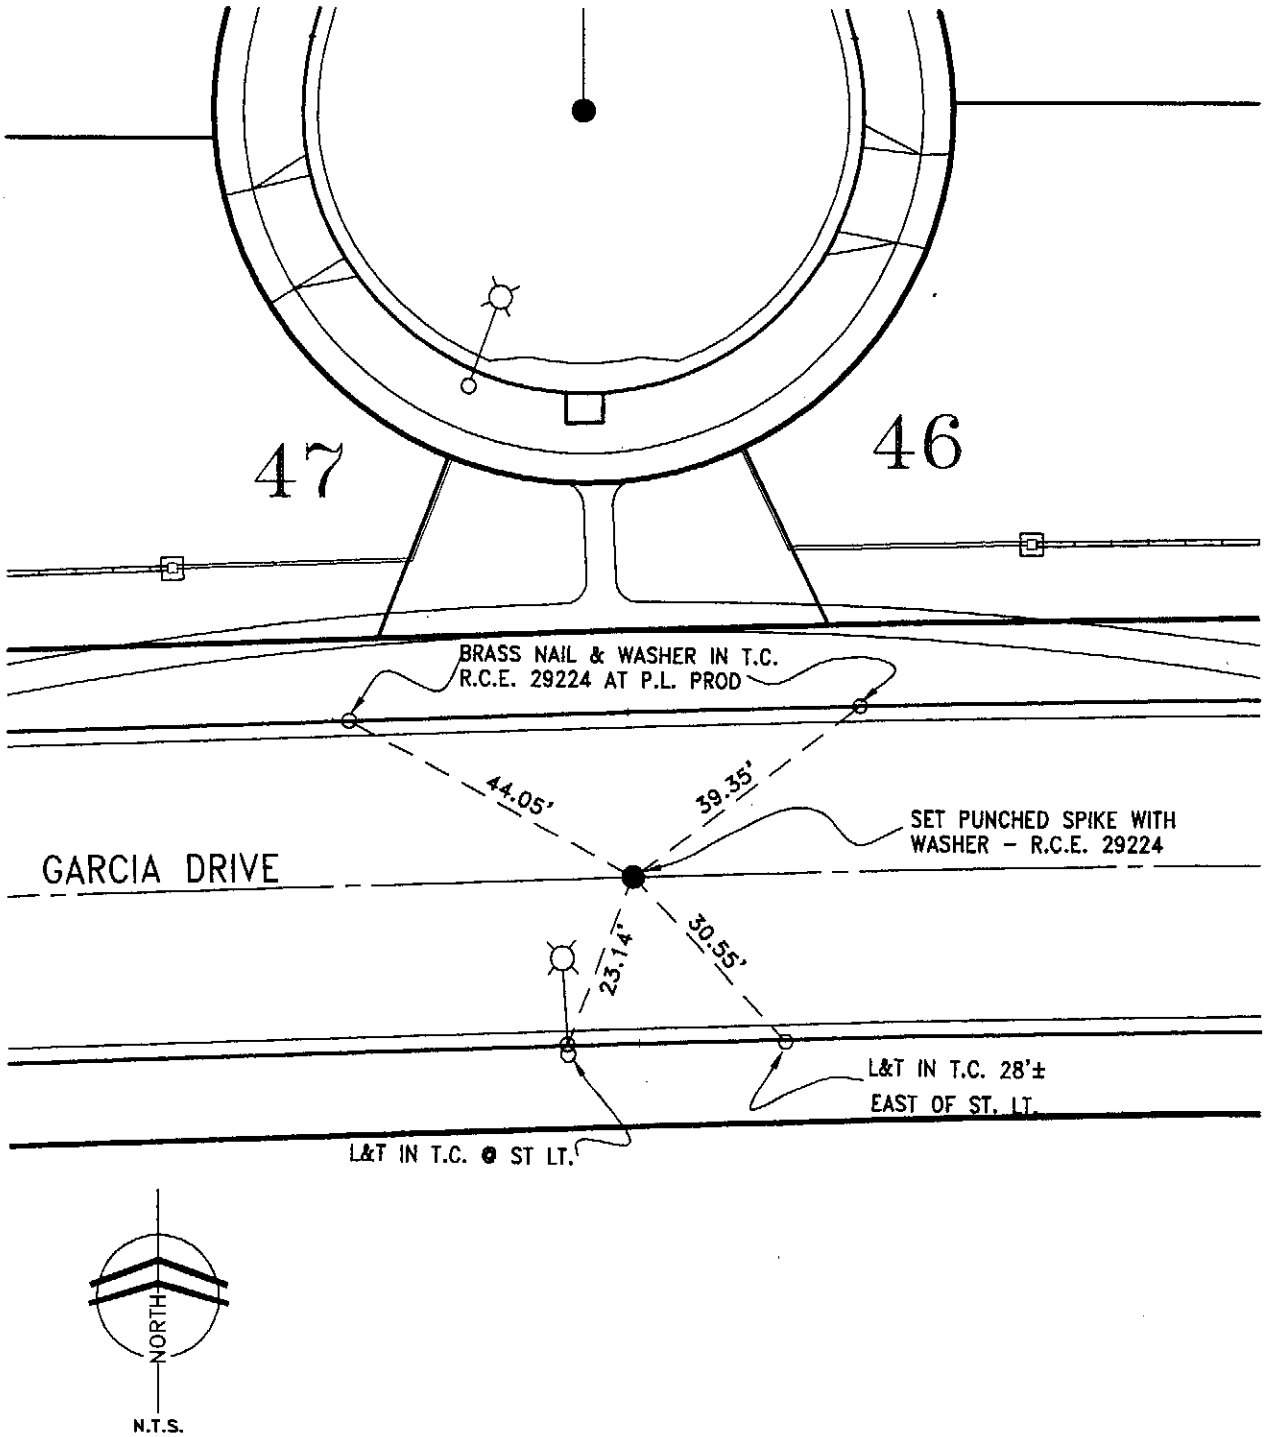

CITY OF RANCHO CUCAMONGA STREET TIES	TRACT NO. 15711-2
Dan Guerra & Associates 10271-B TRADEMARK STREET RANCHO CUCAMONGA, CA 91730 (909) 987-4306 CIVIL ENGINEERS • LAND SURVEYORS	AT B.C. GARCIA DRIVE, SOUTH OF LA TOUR COURT
ENGINEER: DANIEL E. GUERRA	FIELD REVIEW: _____ DATE: _____
R.C.E. No. 29224	TIE BOOK: 24 PAGE: 56

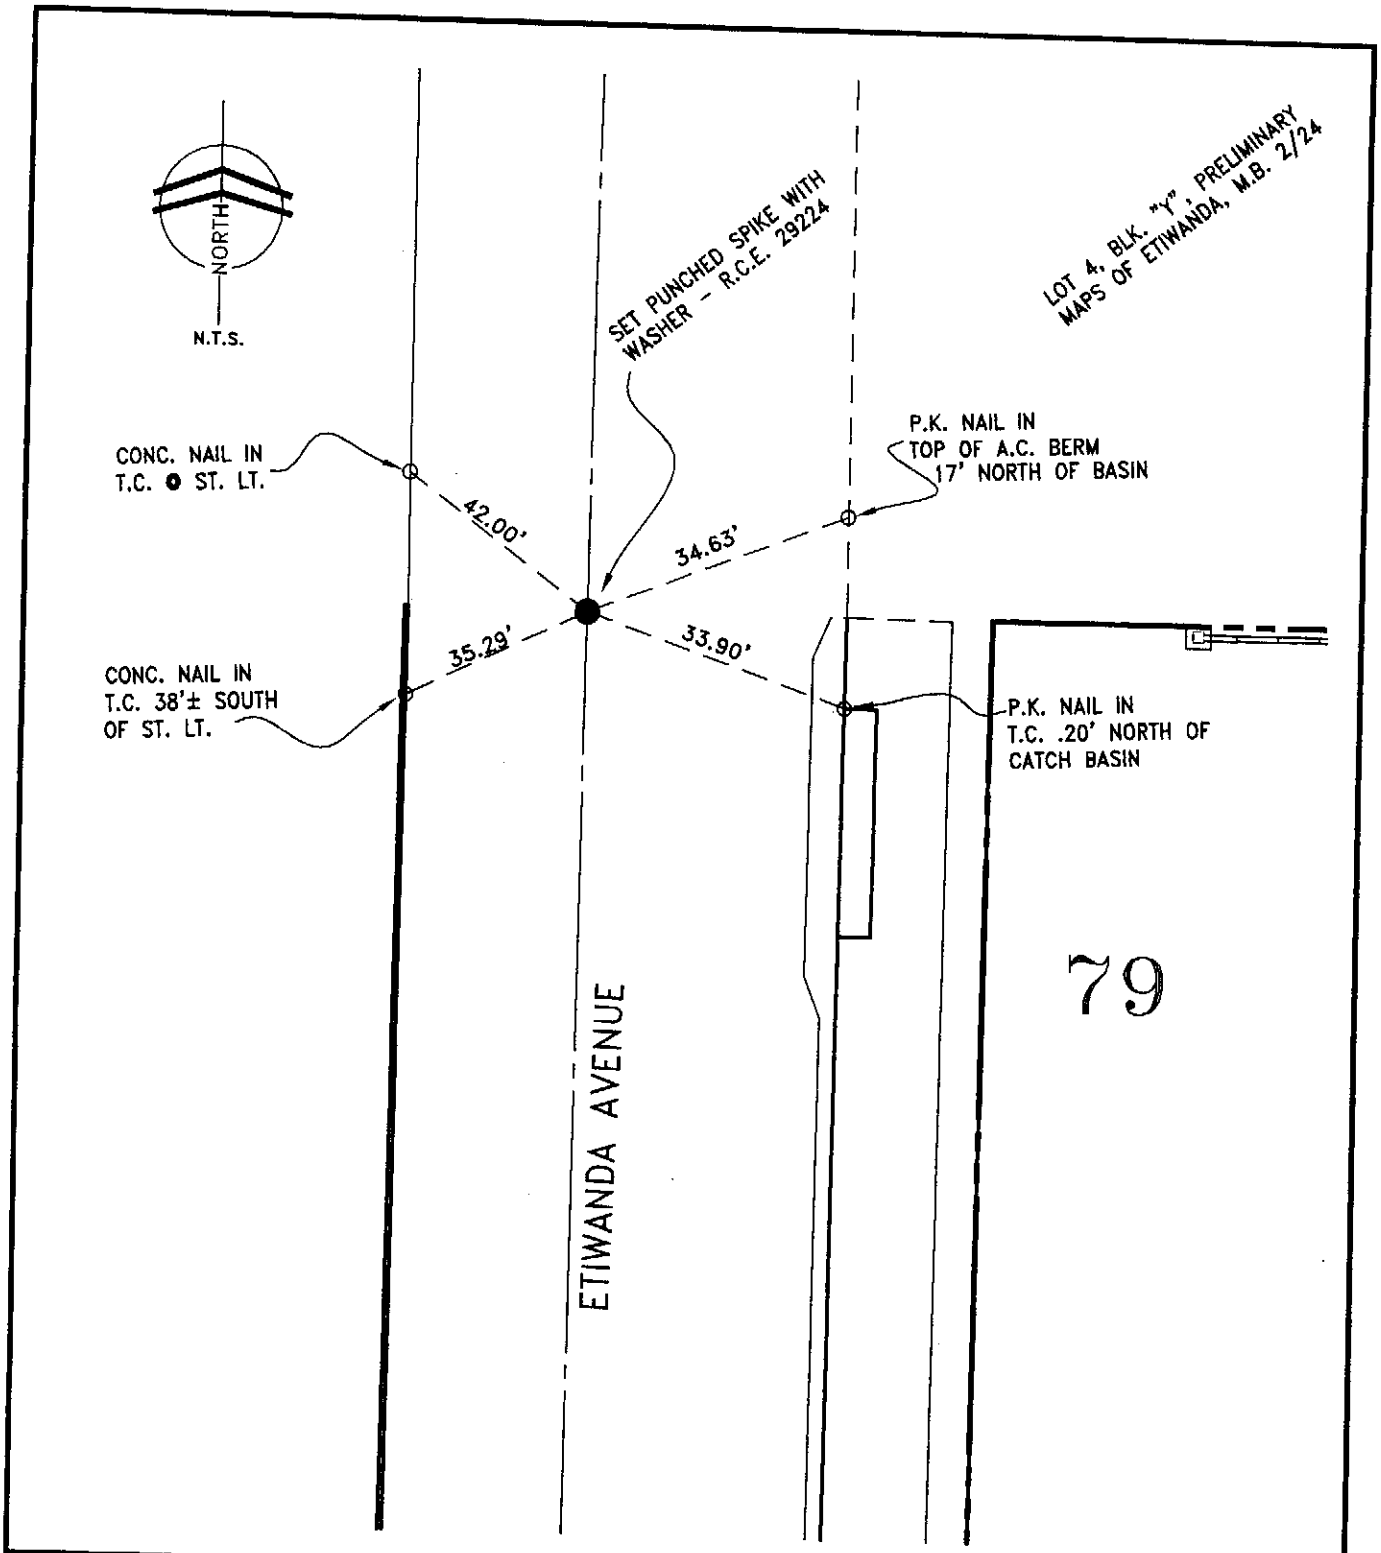

CITY OF RANCHO CUCAMONGA STREET TIES	TRACT NO. 15711-2
Dan Guerra & Associates 10271-B TRADEMARK STREET RANCHO CUCAMONGA, CA 91730 (909) 987-4306 CIVIL ENGINEERS • LAND SURVEYORS	NORTH P.L. TRACT 15711-2 ● CENTERLINE ETIWANDA AVENUE
ENGINEER: DANIEL E. GUERRA	FIELD REVIEW: _____ DATE: _____
R.C.E. No. 29224	TIE BOOK: 24 PAGE: 57

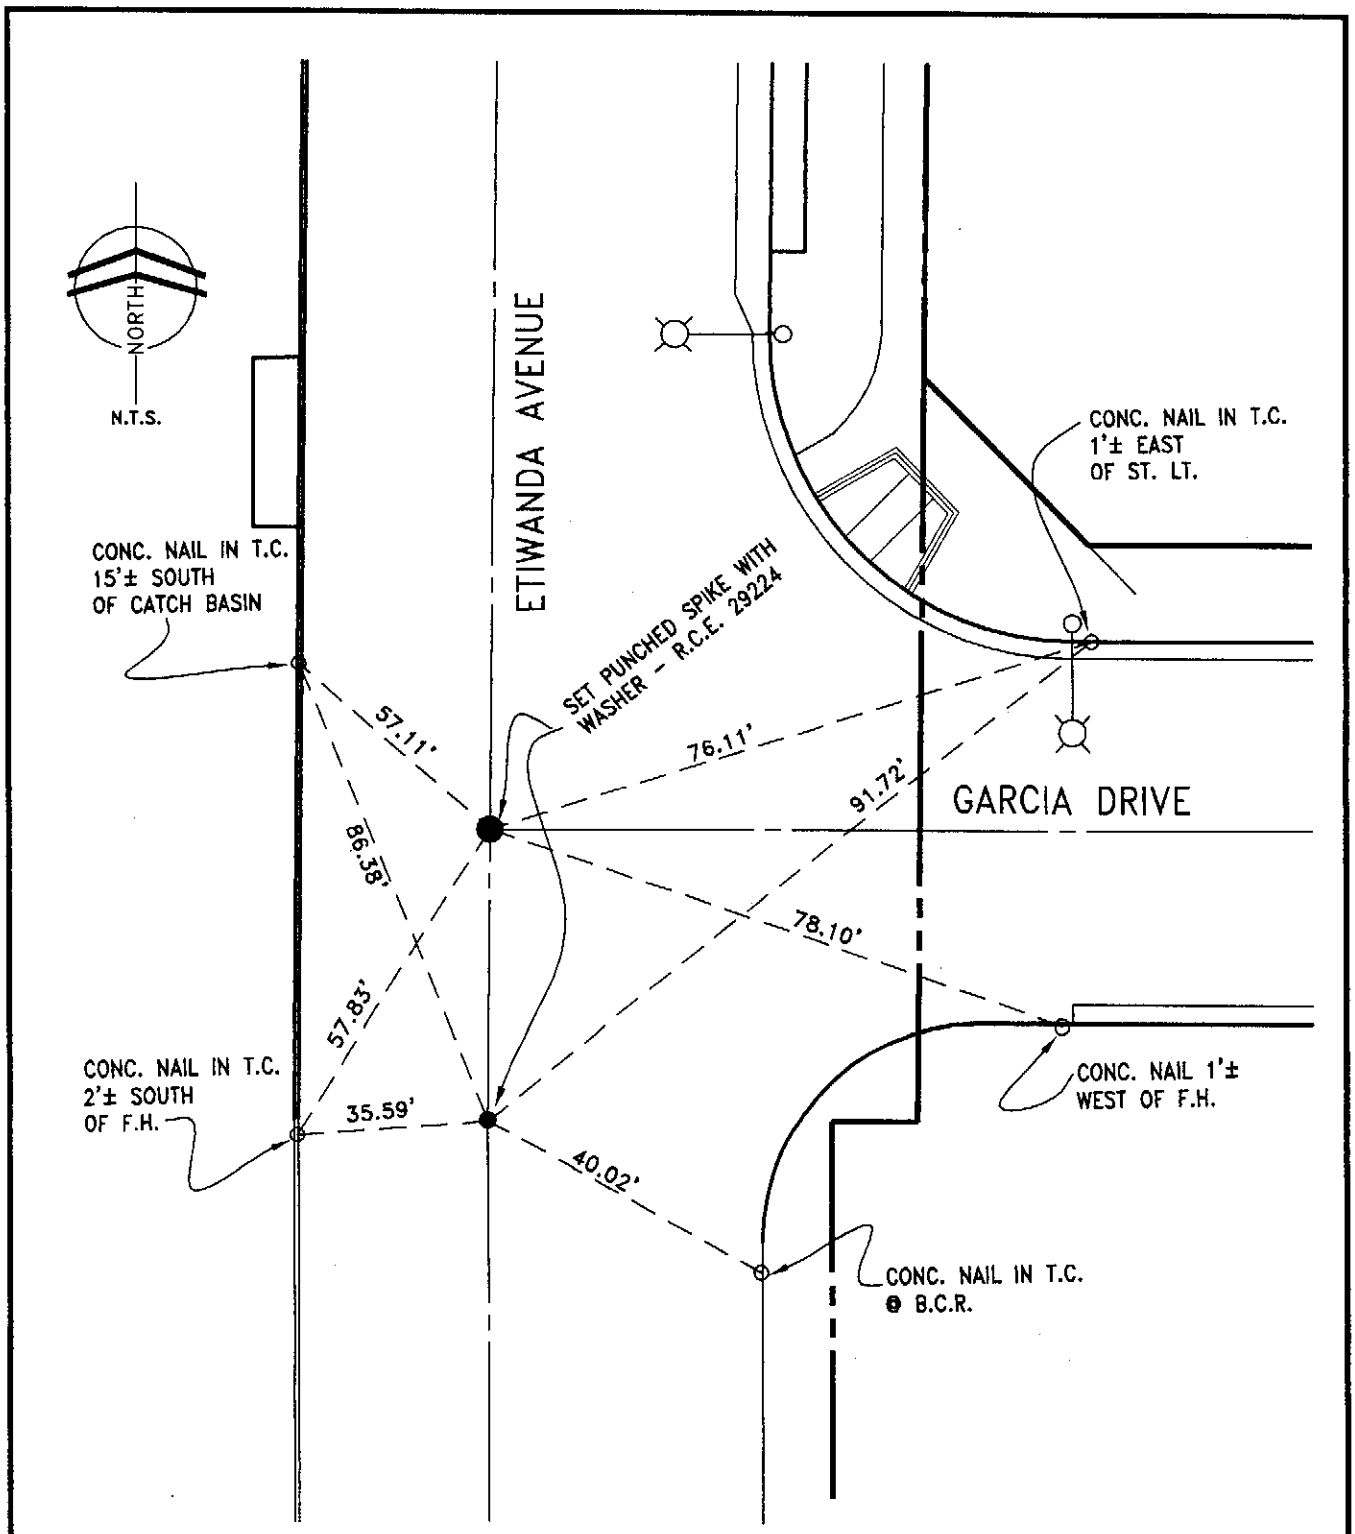

CITY OF RANCHO CUCAMONGA STREET TIES	TRACT NO. 15711-2
Dan Guerra & Associates 10271-B TRADEMARK STREET RANCHO CUCAMONGA, CA 91730 (909) 987-4306 CIVIL ENGINEERS • LAND SURVEYORS	CENTERLINE INTERSECTION ETIWANDA AVENUE AND GARCIA DRIVE
ENGINEER: DANIEL E. GUERRA	FIELD REVIEW: _____ DATE: _____
R.C.E. No. 29224	TIE BOOK: 24 PAGE: 58

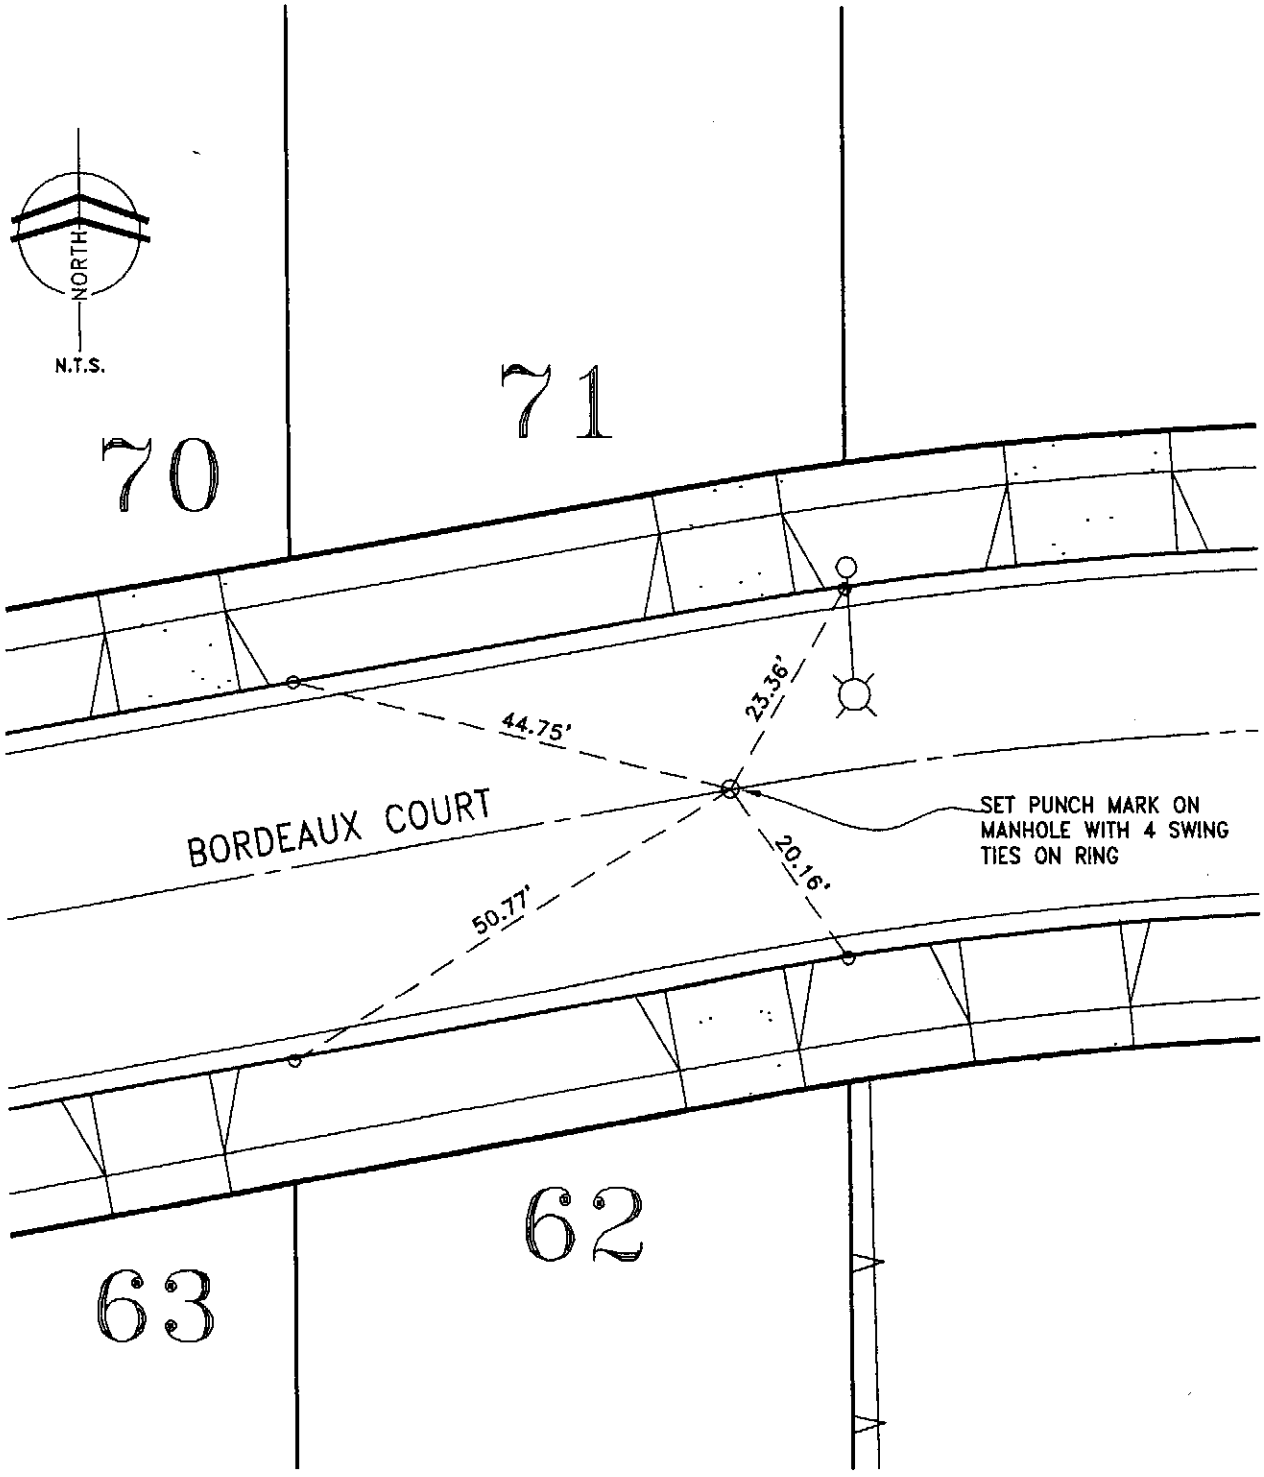

CITY OF RANCHO CUCAMONGA STREET TIES	TRACT NO. 15711-2
Dan Guerra & Associates 10271-B TRADEMARK STREET RANCHO CUCAMONGA, CA 91730 (909) 987-4306 CIVIL ENGINEERS • LAND SURVEYORS	AT B.C. BORDEAUX COURT
ENGINEER: DANIEL E. GUERRA	FIELD REVIEW: _____ DATE: _____
R.C.E. No. 29224	TIE BOOK: 24 PAGE: 59

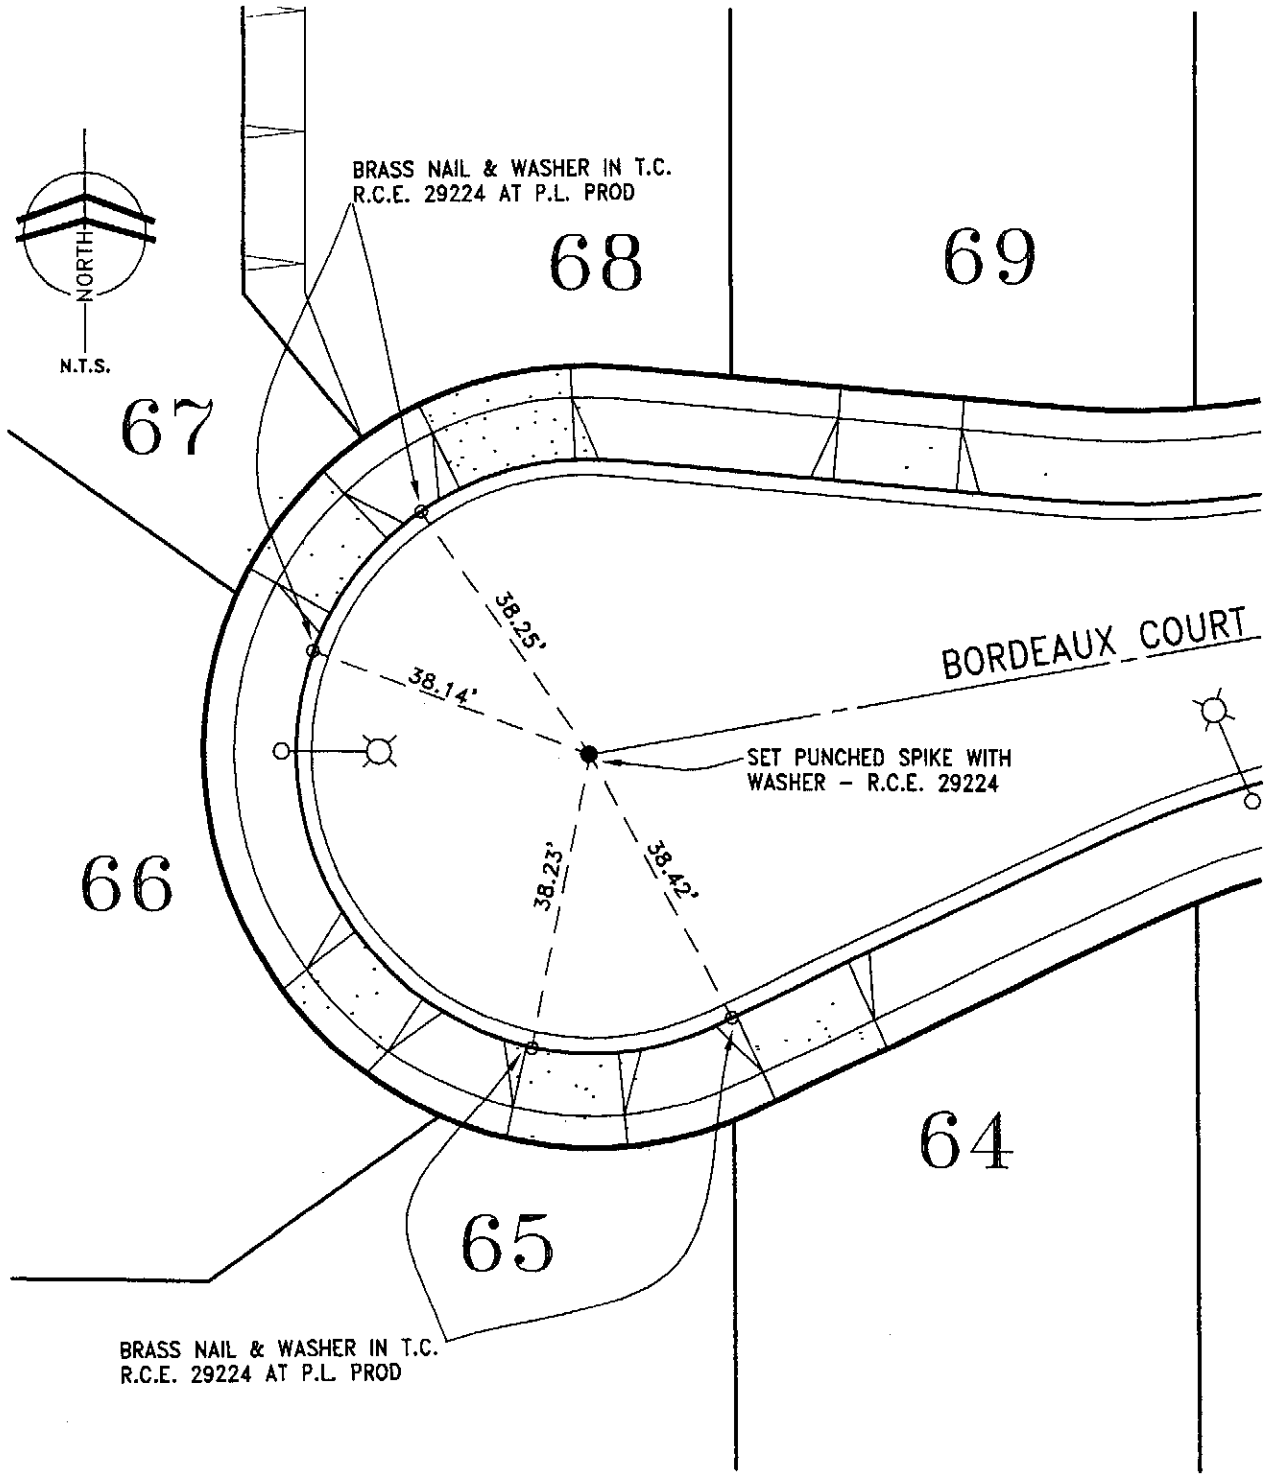

CITY OF RANCHO CUCAMONGA STREET TIES	TRACT NO. 15711-2
Dan Guerra & Associates 10271-B TRADEMARK STREET RANCHO CUCAMONGA, CA 91730 (909) 987-4306 CIVIL ENGINEERS • LAND SURVEYORS	AT CUL-DE-SAC BORDEAUX COURT
ENGINEER: DANIEL E. GUERRA	FIELD REVIEW: _____ DATE: _____
R.C.E. No. 29224	TIE BOOK: 24 PAGE: 60

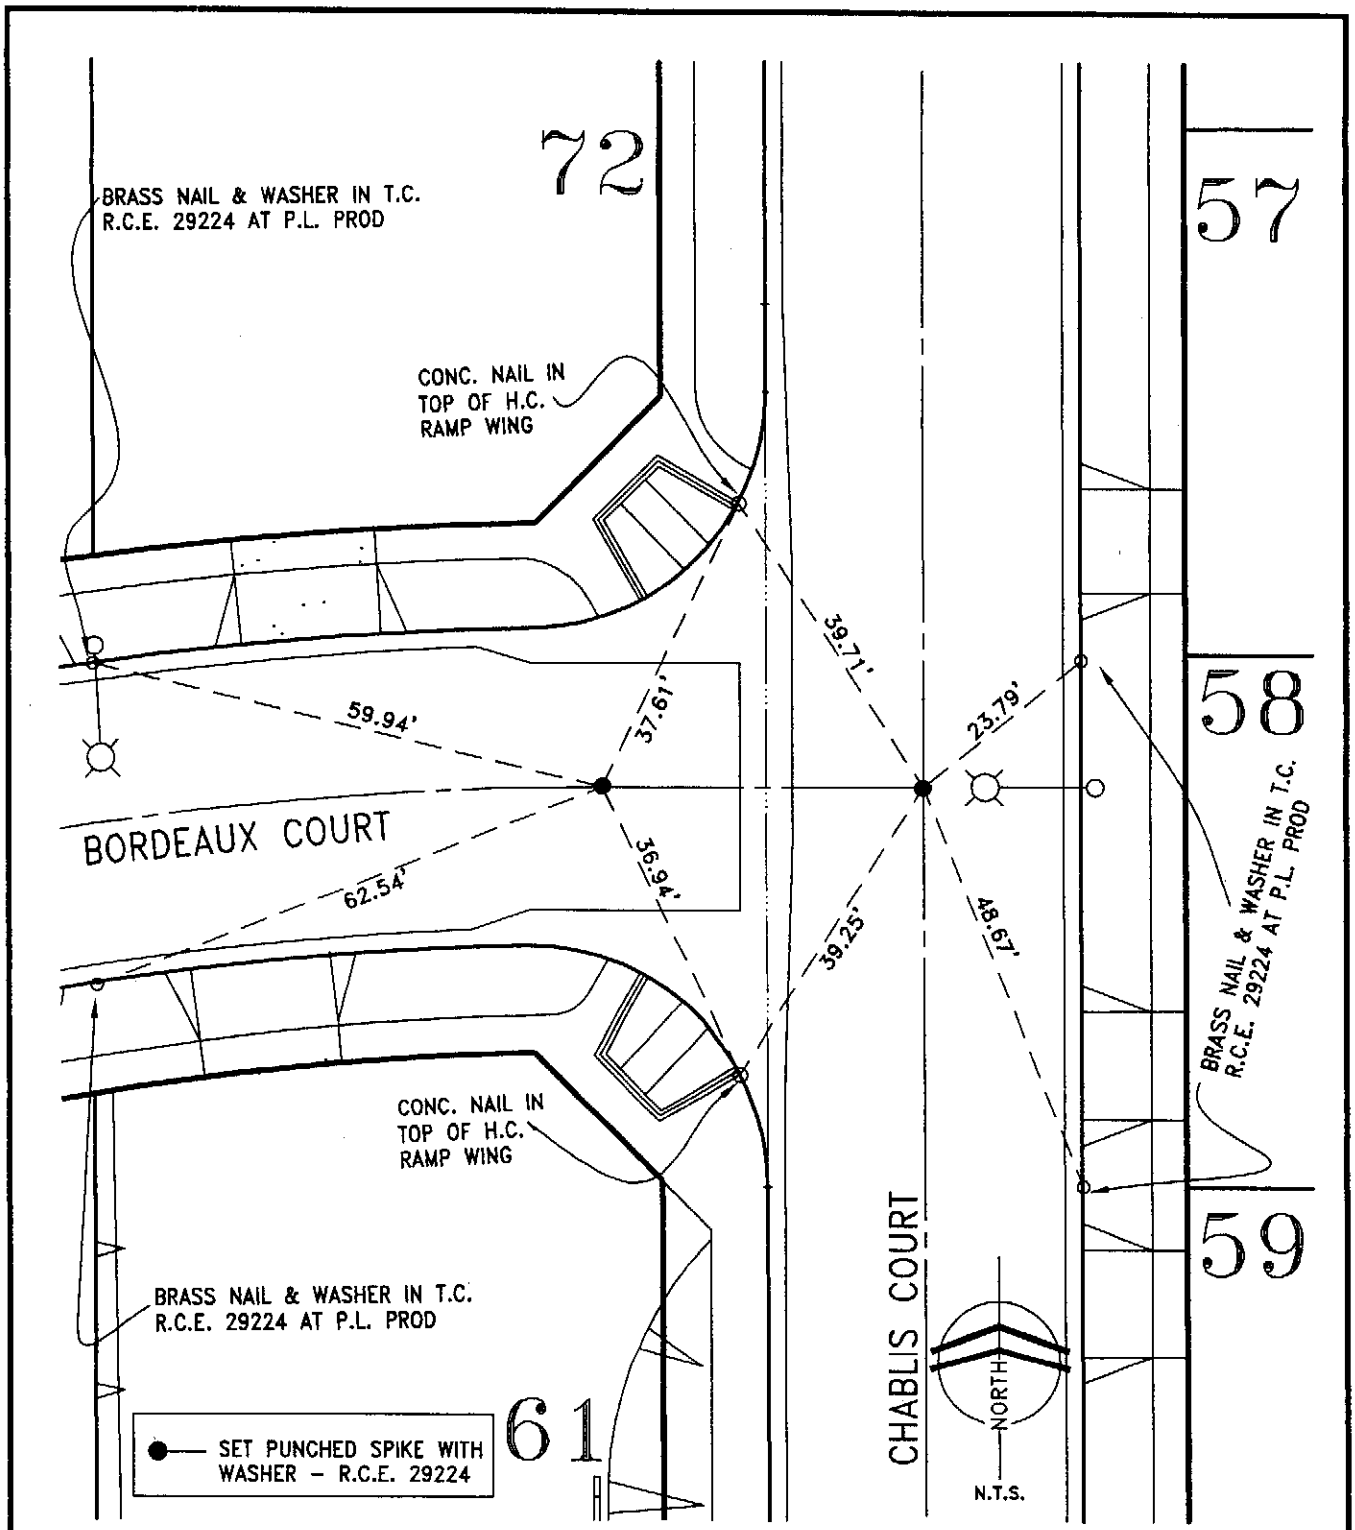

CITY OF RANCHO CUCAMONGA STREET TIES	TRACT NO. 15711-2
Dan Guerra & Associates 10271-B TRADEMARK STREET RANCHO CUCAMONGA, CA 91730 (909) 987-4306 CIVIL ENGINEERS • LAND SURVEYORS	AT INTERSECTION OF CHABLIS PLACE AND BORDEAUX COURT AT E.C. BORDEAUX COURT
ENGINEER: DANIEL E. GUERRA	FIELD REVIEW: _____ DATE: _____
R.C.E. No. 29224	TIE BOOK: 24 PAGE: 61

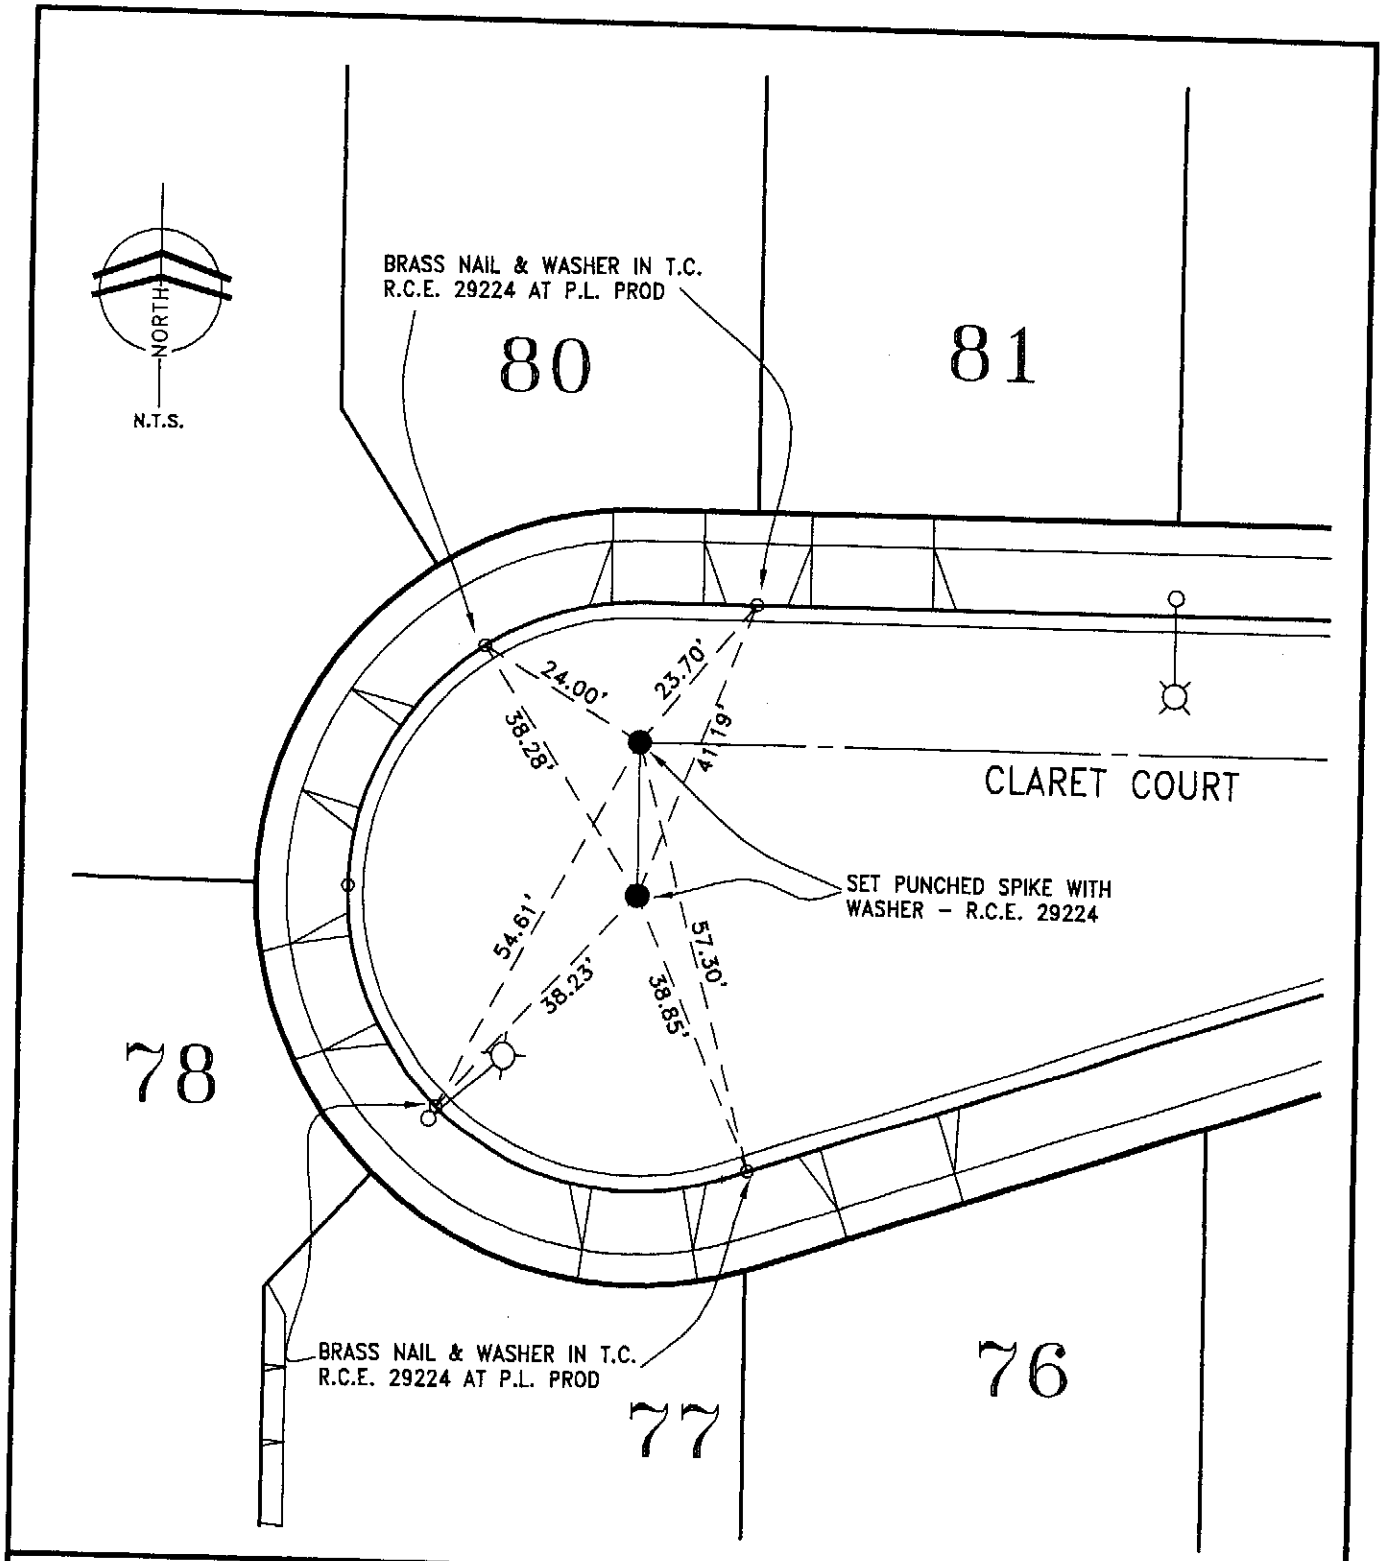

CITY OF RANCHO CUCAMONGA STREET TIES	TRACT NO. 15711-2
Dan Guerra & Associates 10271-B TRADEMARK STREET RANCHO CUCAMONGA, CA 91730 (909) 987-4306 CIVIL ENGINEERS • LAND SURVEYORS	AT CUL-DE-SAC CLARET COURT
ENGINEER: DANIEL E. GUERRA	FIELD REVIEW: _____ DATE: _____
R.C.E. No. 29224	TIE BOOK: 24 PAGE: 62

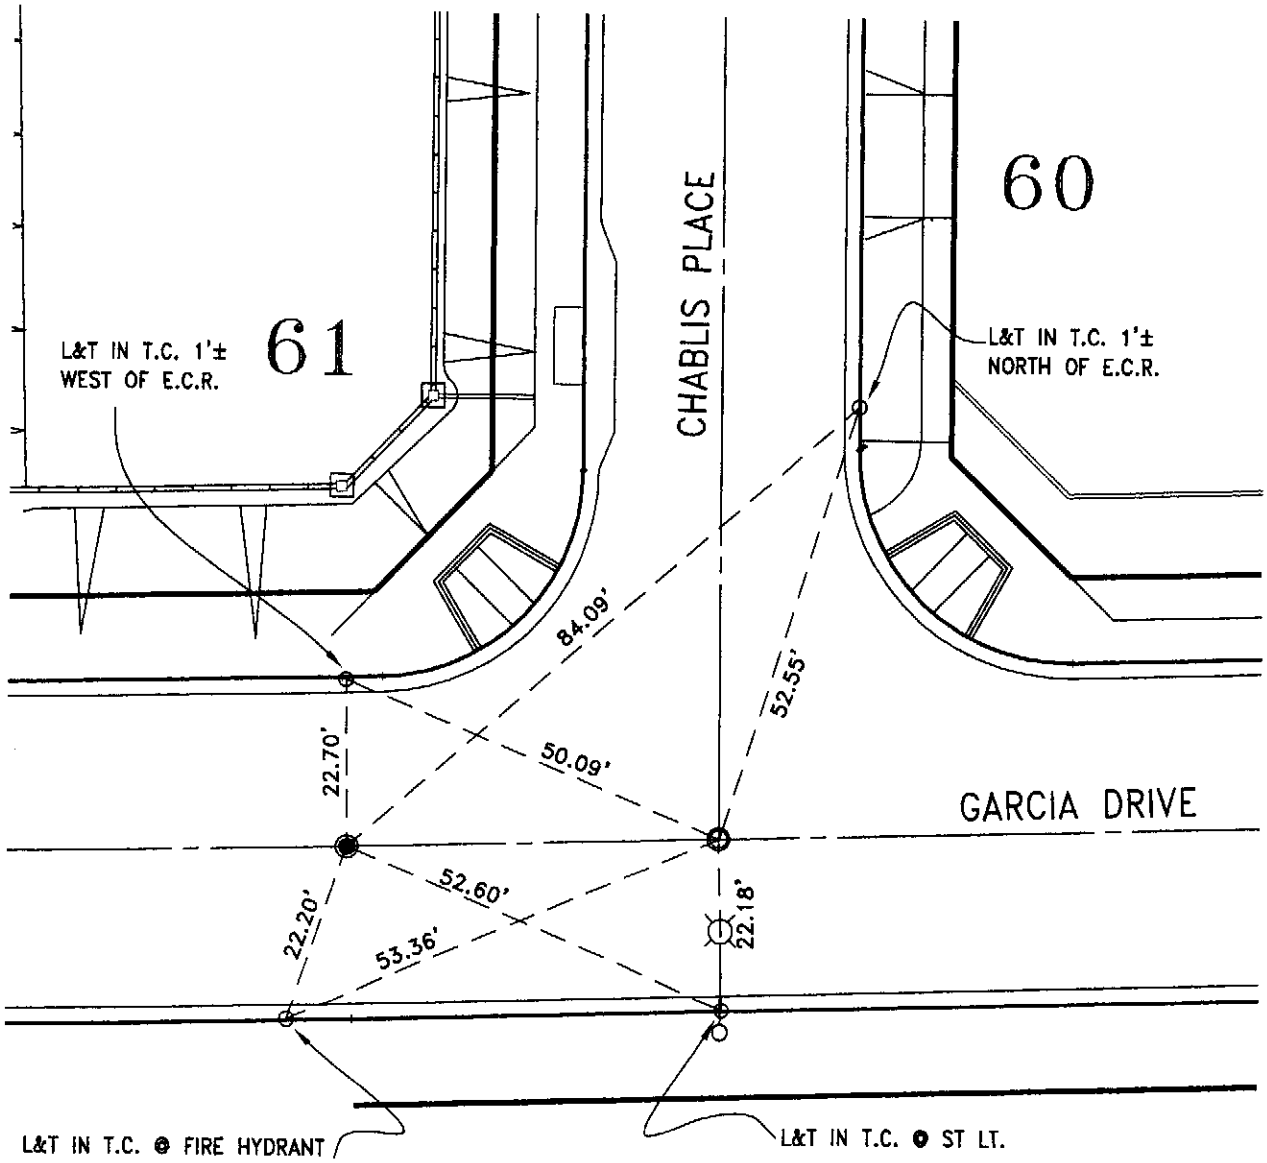

SET PUNCH MARK ON MANHOLE WITH 4 SWING TIES ON RING

SET PUNCHED SPIKE WITH WASHER – R.C.E. 29224

NORTH

N.T.S.

CITY OF RANCHO CUCAMONGA STREET TIES	TRACT 15711-2
Dan Guerra & Associates 10271-B TRADEMARK STREET RANCHO CUCAMONGA, CA 91730 (909) 987-4306 CIVIL ENGINEERS • LAND SURVEYORS	AT THE INTERSECTION OF GARCIA DRIVE AND CHABLIS PLACE AT E.C. ON GARCIA DRIVE
ENGINEER: DANIEL E. GUERRA	FIELD REVIEW: _____ DATE: _____
R.C.E. No. 29224	TIE BOOK: 24 PAGE: 63

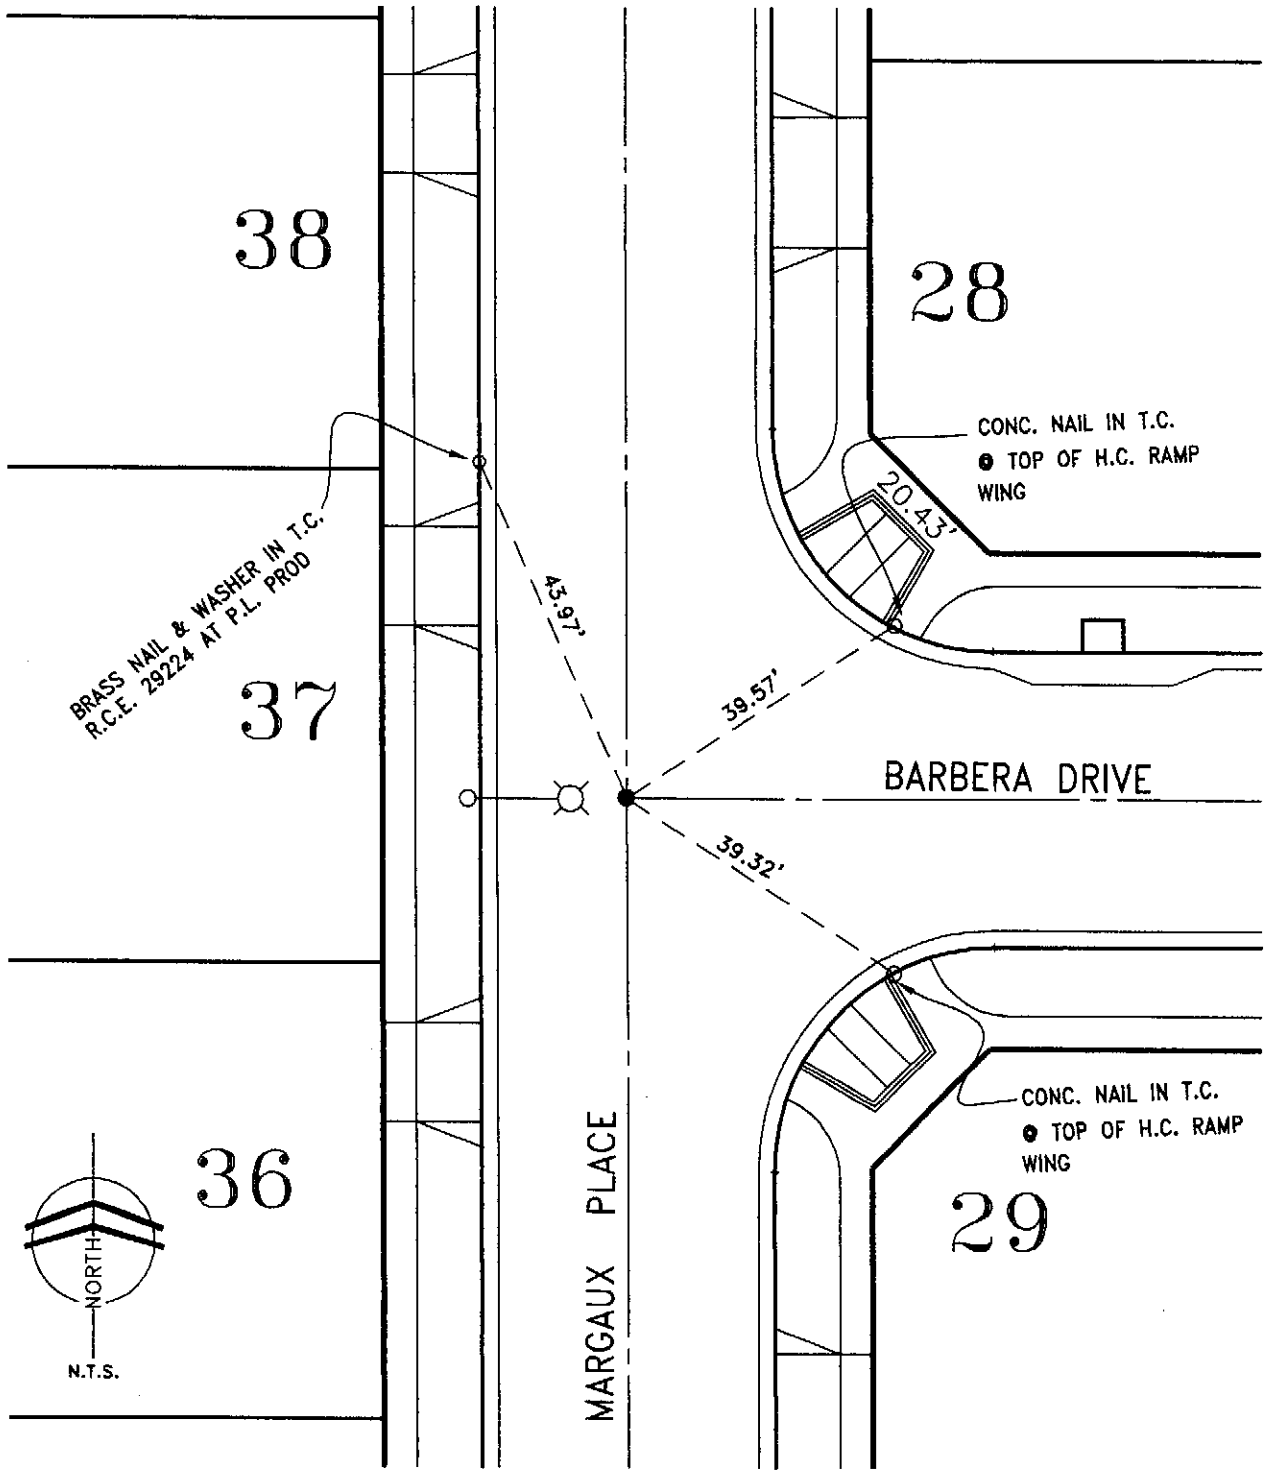

CITY OF RANCHO CUCAMONGA STREET TIES	TRACT NO. 15711-2
Dan Guerra & Associates 10271-B TRADEMARK STREET RANCHO CUCAMONGA, CA 91730 (909) 987-4306 CIVIL ENGINEERS • LAND SURVEYORS	AT INTERSECTION OF BARBERA DRIVE AND MARGAUX PLACE
ENGINEER: DANIEL E. GUERRA	FIELD REVIEW: _____ DATE: _____
R.C.E. No. 29224	TIE BOOK: 24 PAGE: 64

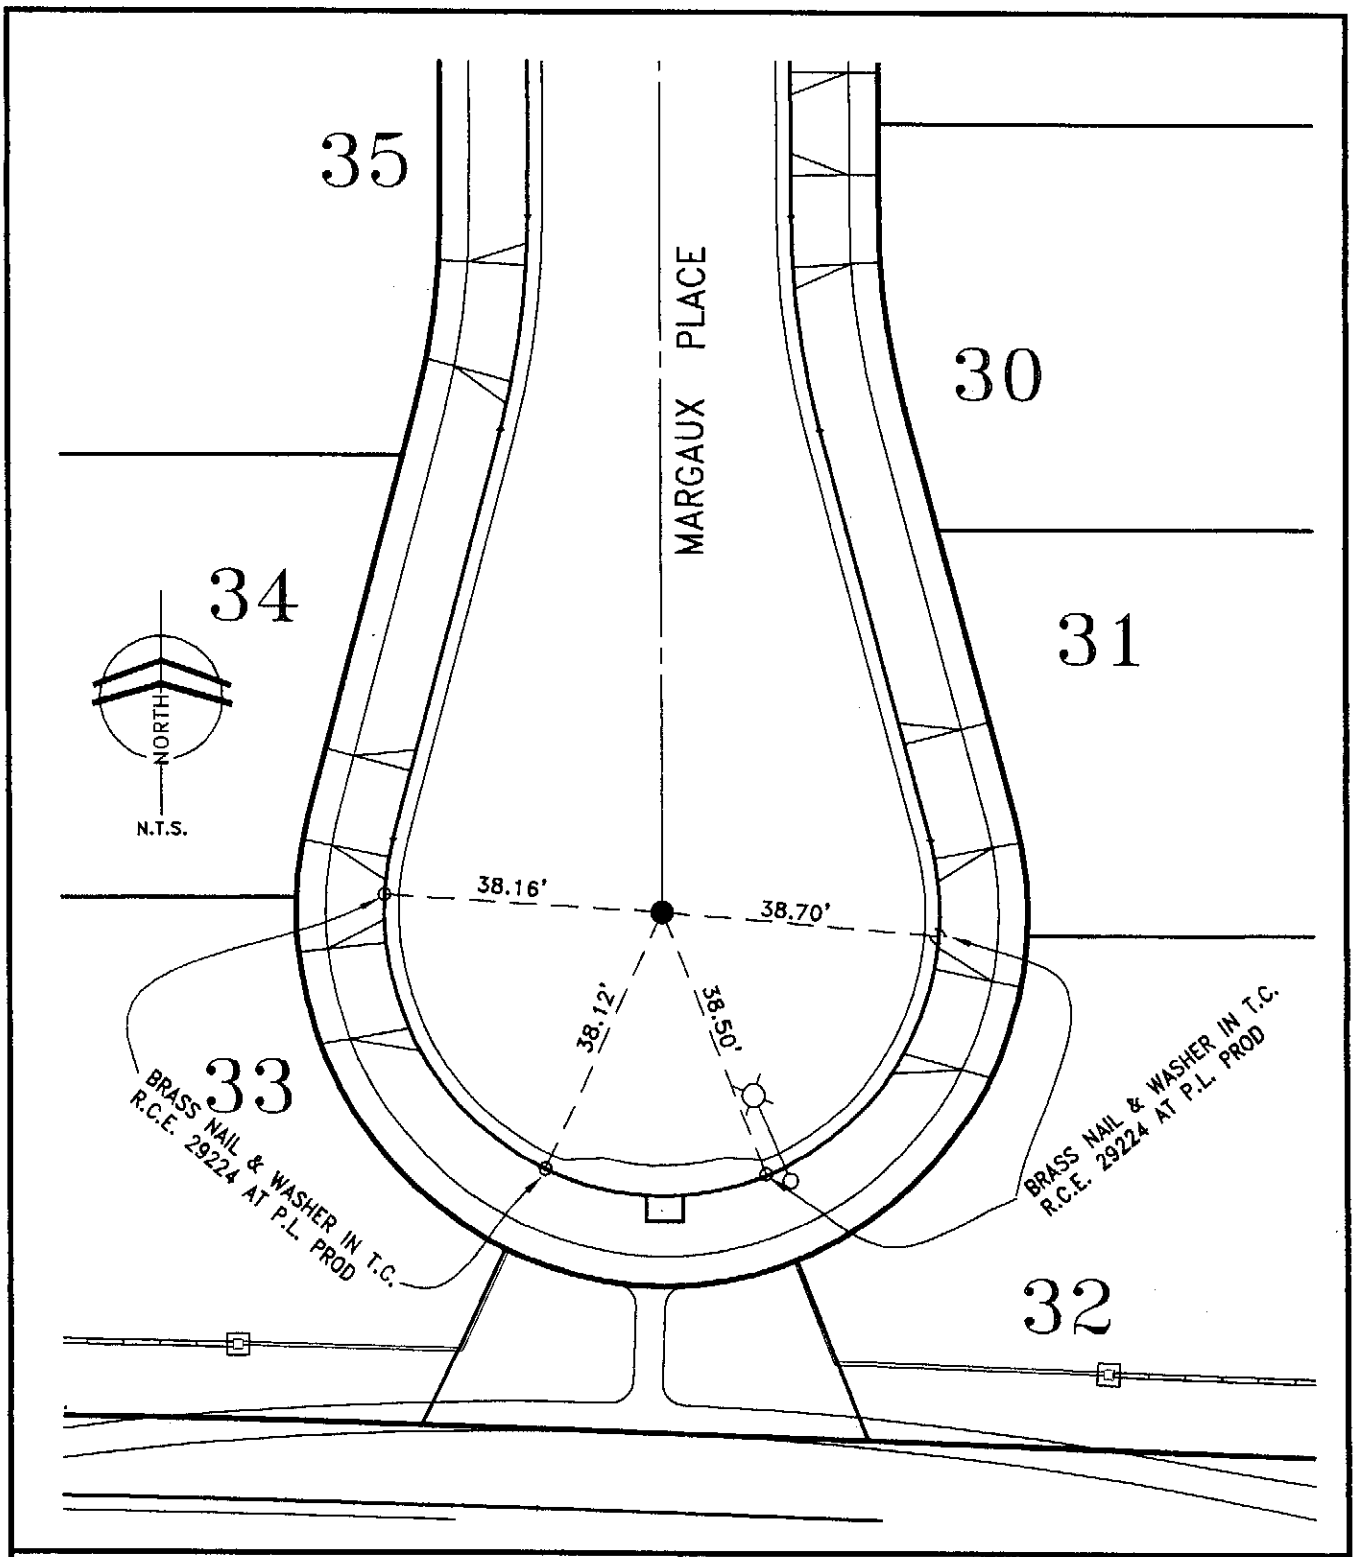

CITY OF RANCHO CUCAMONGA STREET TIES	TRACT NO. 15711-2
Dan Guerra & Associates 10271-B TRADEMARK STREET RANCHO CUCAMONGA, CA 91730 (909) 987-4306 CIVIL ENGINEERS • LAND SURVEYORS	AT CUL-DE-SAC OF MARGAUX PLACE
ENGINEER: DANIEL E. GUERRA	FIELD REVIEW: _____ DATE: _____
R.C.E. No. 29224	TIE BOOK: 24 PAGE: 65

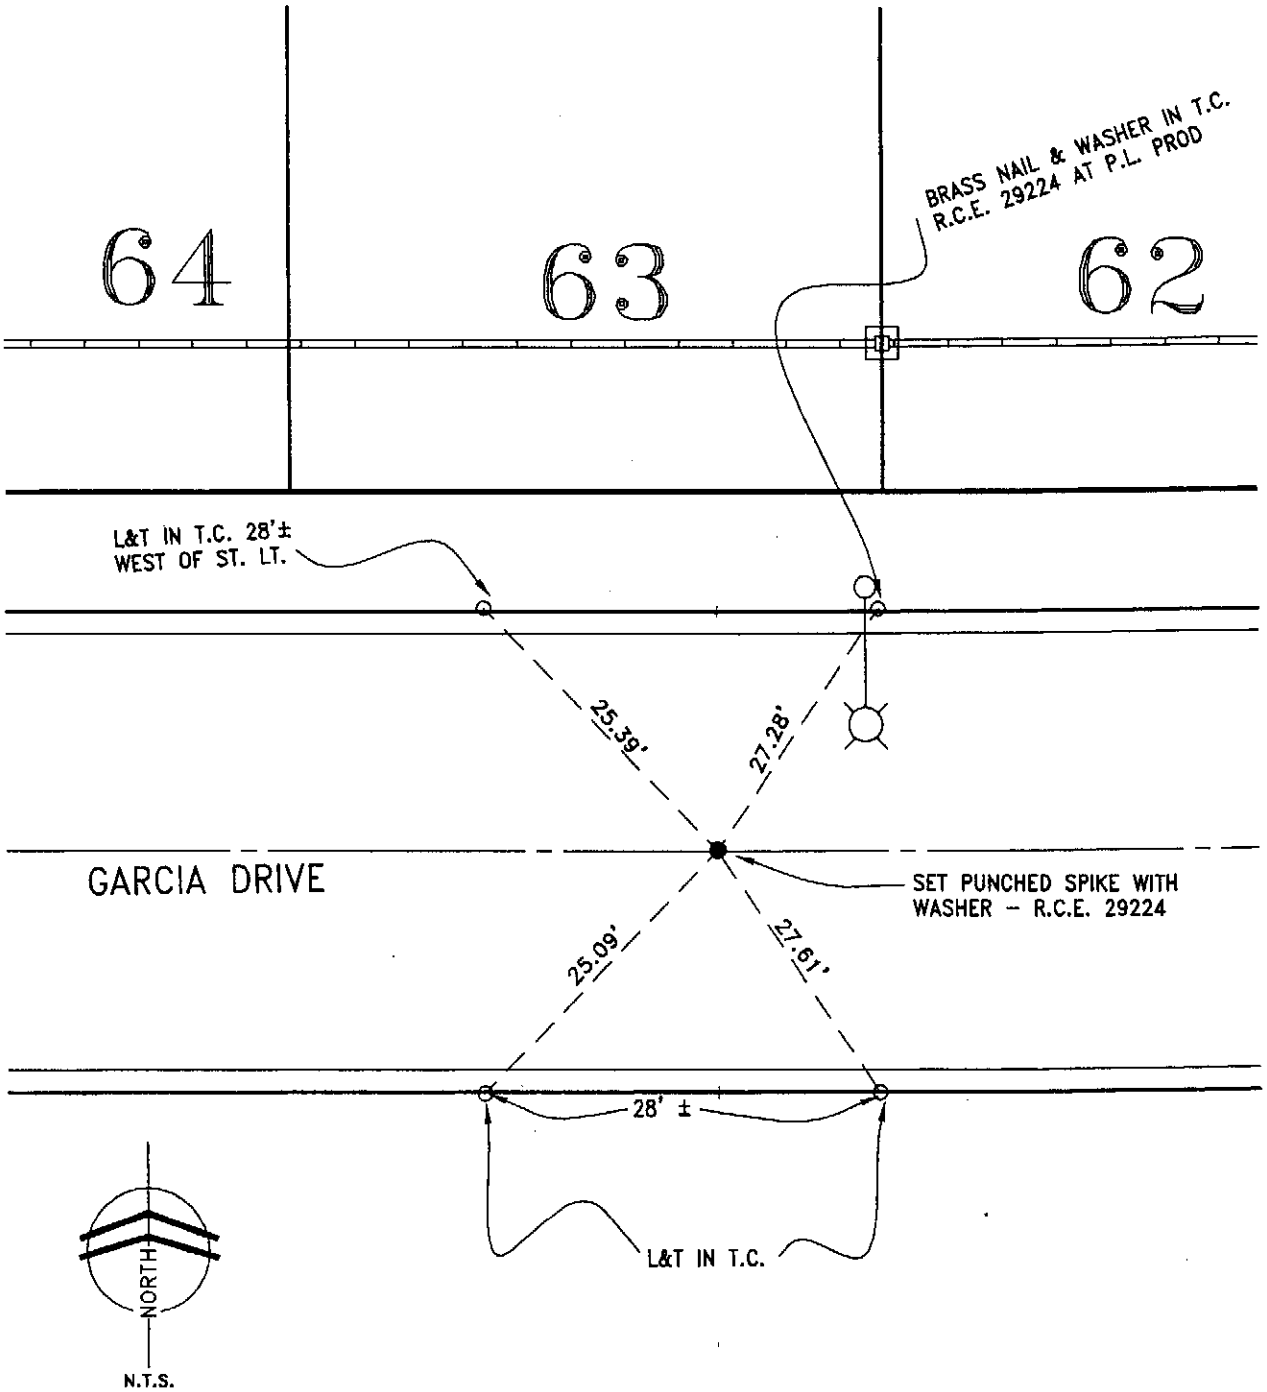

CITY OF RANCHO CUCAMONGA STREET TIES	TRACT 15711-2
Dan Guerra & Associates 10271-B TRADEMARK STREET RANCHO CUCAMONGA, CA 91730 (909) 987-4306 CIVIL ENGINEERS • LAND SURVEYORS	AT B.C. ON GARCIA DRIVE, JUST EAST OF ETIWANDA AVENUE
ENGINEER: DANIEL E. GUERRA	FIELD REVIEW: _____ DATE: _____
R.C.E. No. 29224	TIE BOOK: 24 PAGE: 66

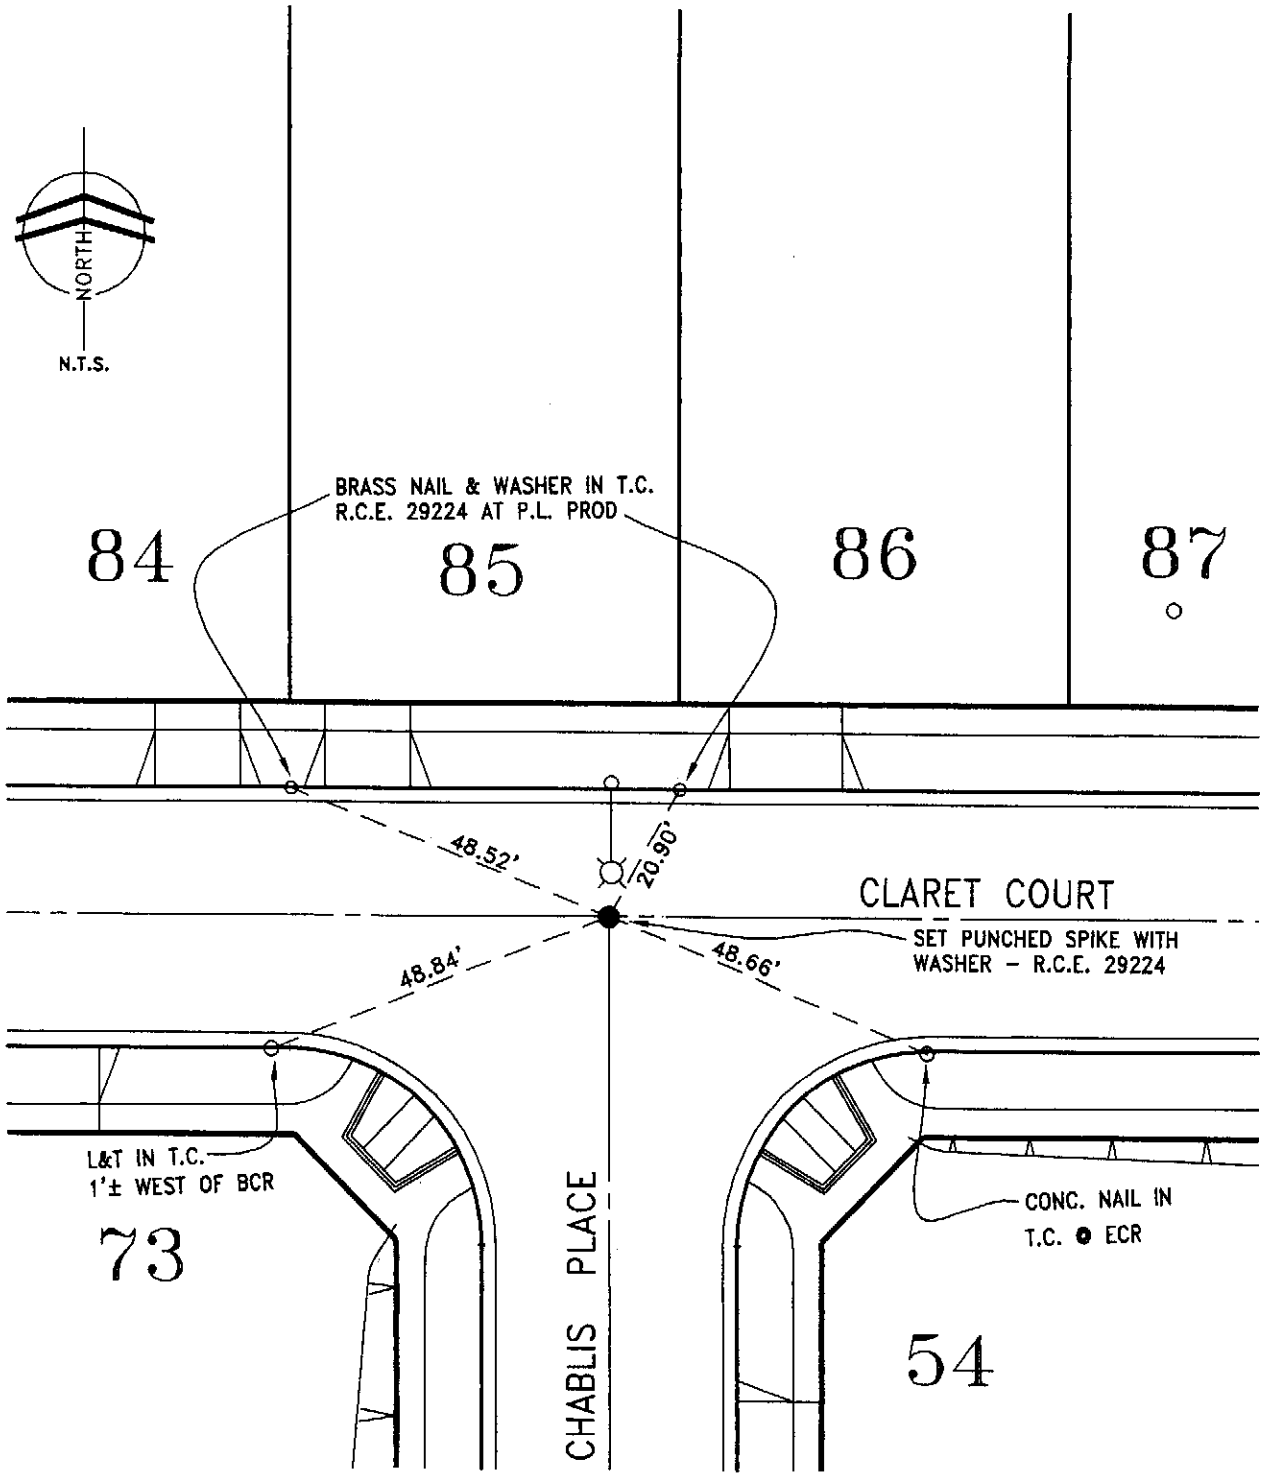

CITY OF RANCHO CUCAMONGA STREET TIES	TRACT NO. 15711-2
Dan Guerra & Associates 10271-B TRADEMARK STREET RANCHO CUCAMONGA, CA 91730 (909) 987-4306 CIVIL ENGINEERS • LAND SURVEYORS	AT INTERSECTION CLARET COURT AND CHABLIS PLACE
ENGINEER: DANIEL E. GUERRA	FIELD REVIEW: _____ DATE: _____
R.C.E. No. 29224	TIE BOOK: 24 PAGE: 67

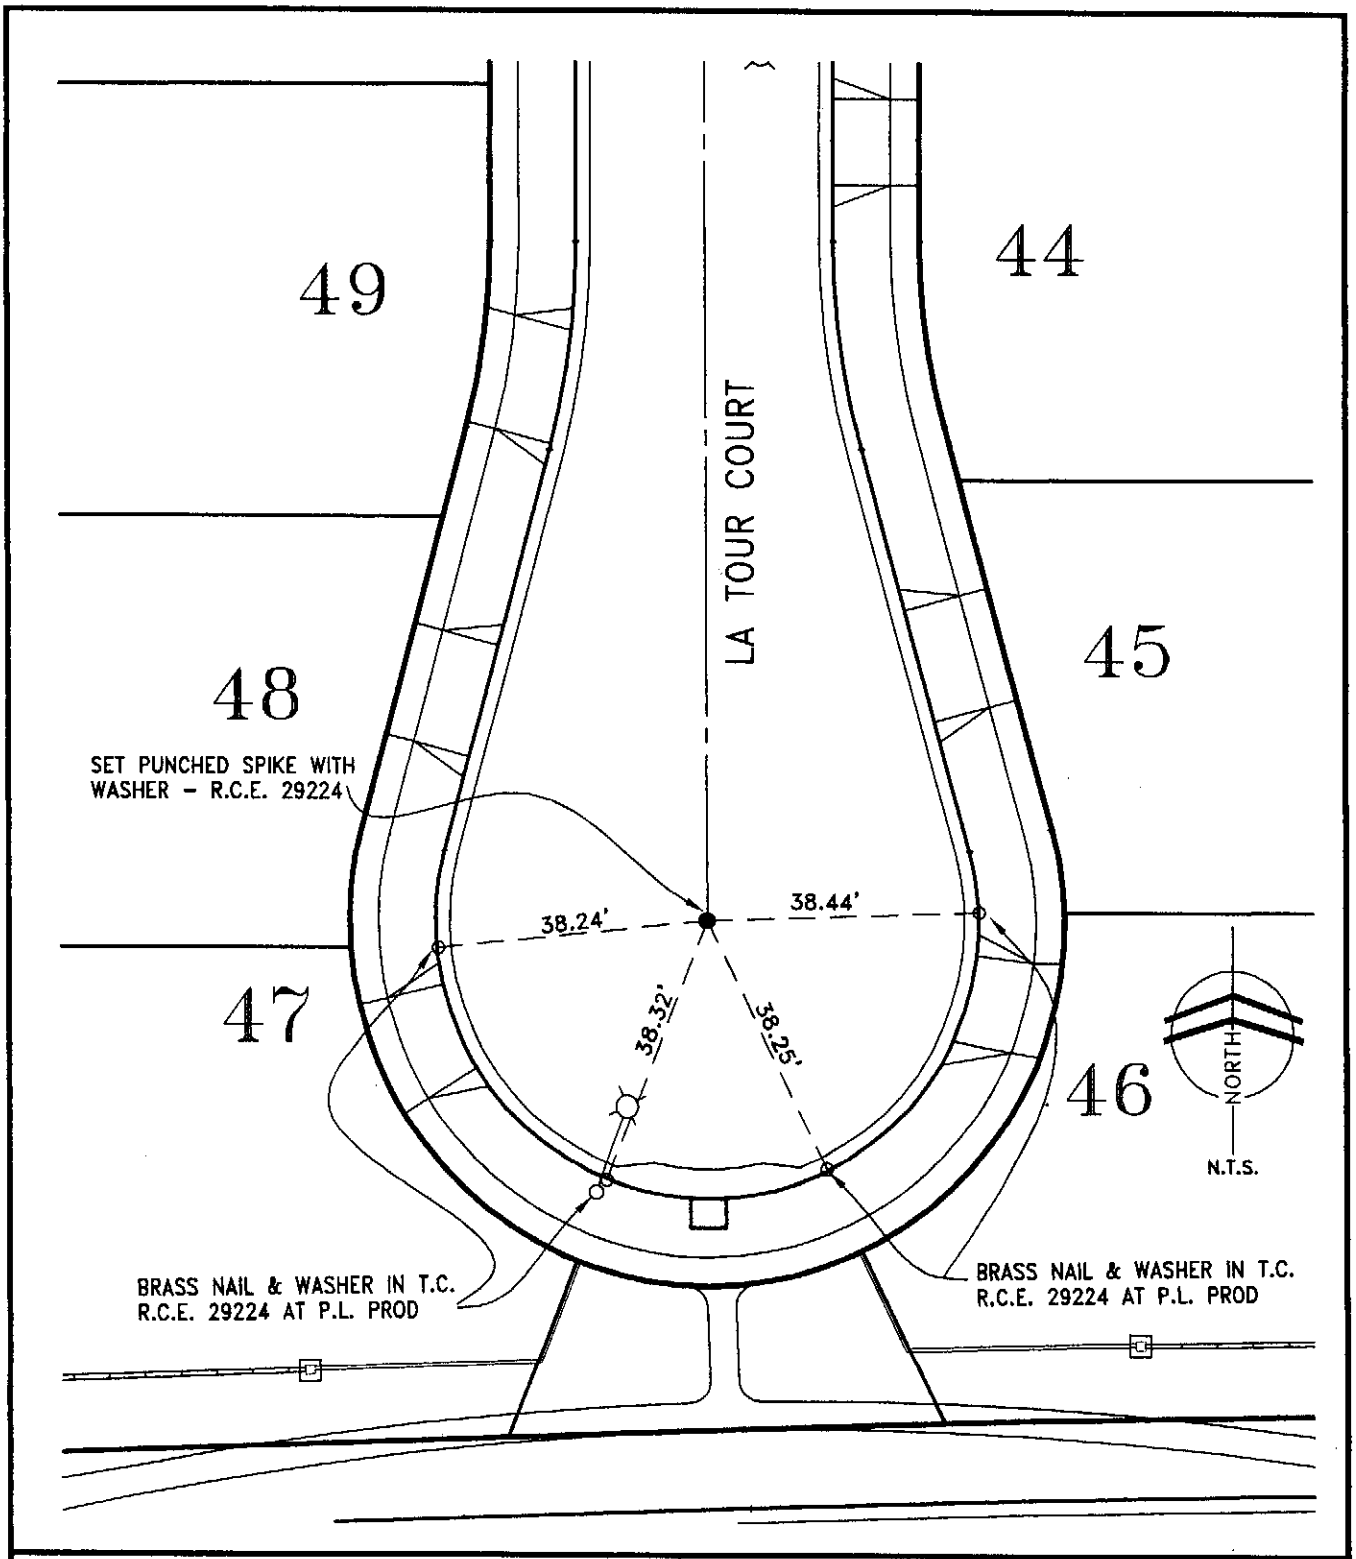

CITY OF RANCHO CUCAMONGA STREET TIES	TRACT NO. 15711-2
Dan Guerra & Associates 10271-B TRADEMARK STREET RANCHO CUCAMONGA, CA 91730 (909) 987-4306 CIVIL ENGINEERS • LAND SURVEYORS	AT CUL-DE-SAC LA TOUR COURT
ENGINEER: DANIEL E. GUERRA	FIELD REVIEW: _____ DATE: _____
R.C.E. No. 29224	TIE BOOK: 24 PAGE: 68

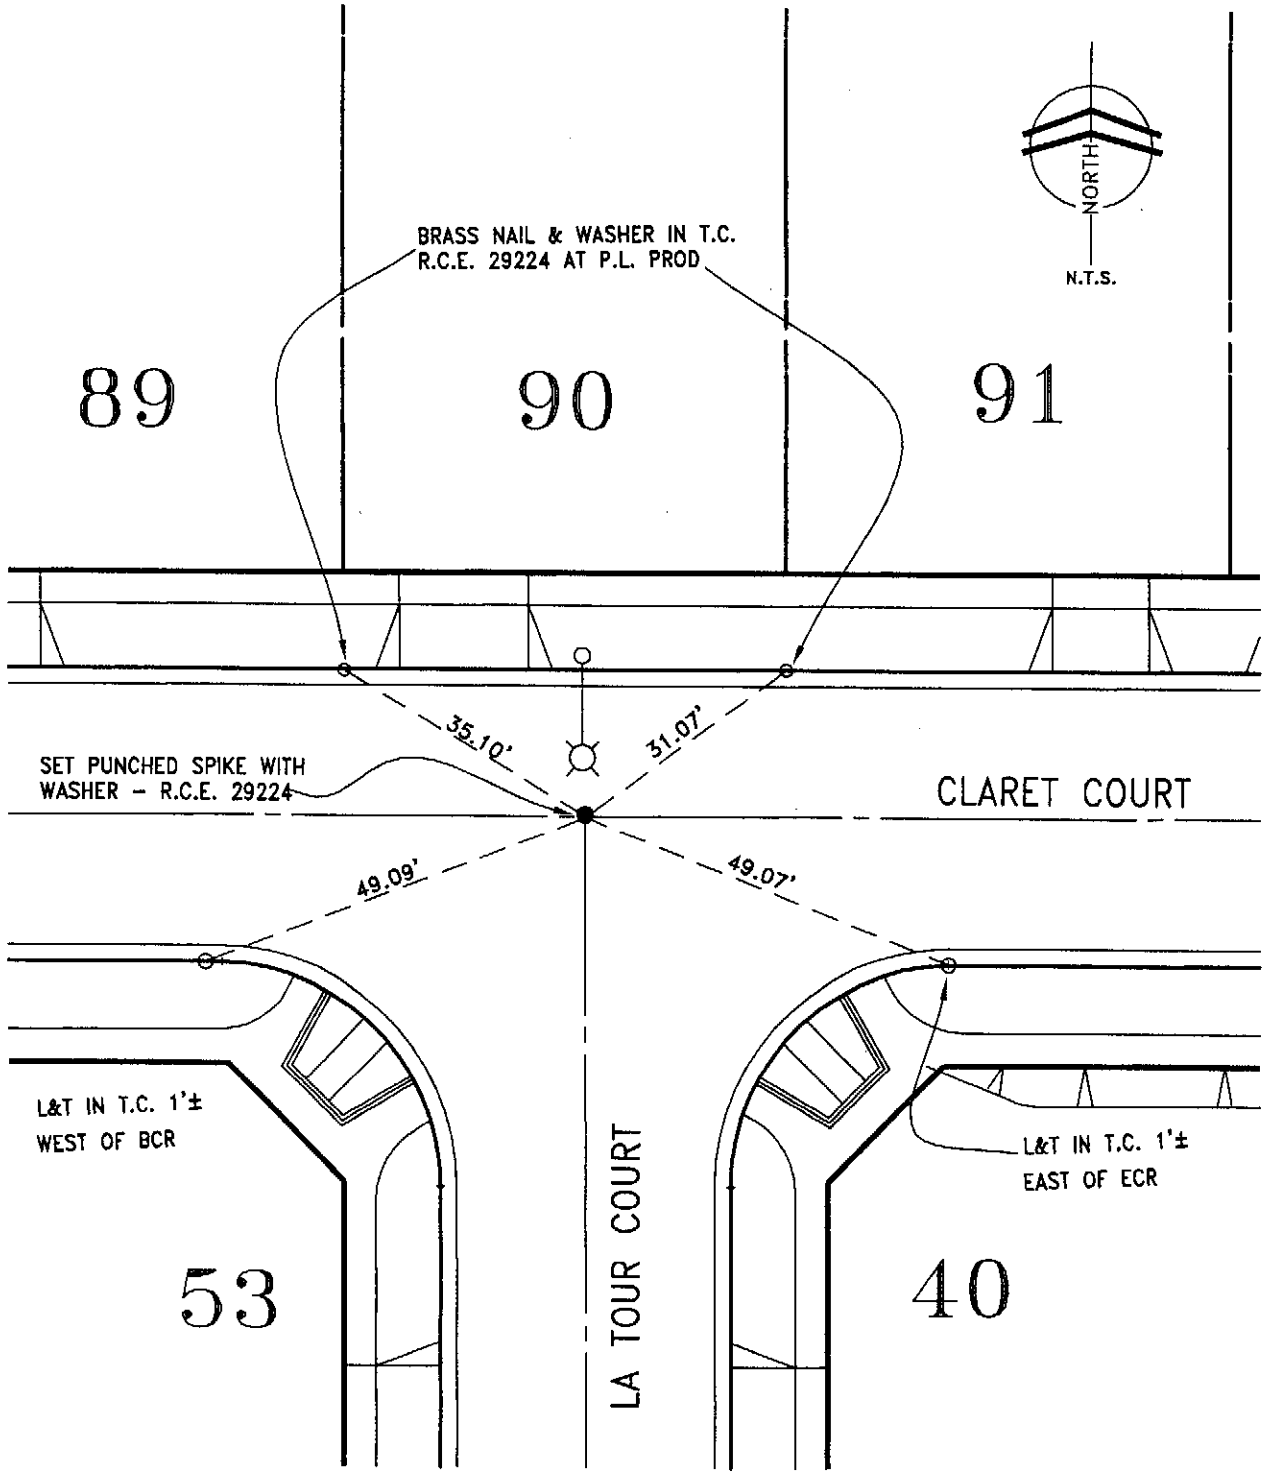

CITY OF RANCHO CUCAMONGA STREET TIES	TRACT NO. 15711-2
Dan Guerra & Associates 10271-B TRADEMARK STREET RANCHO CUCAMONGA, CA 91730 (909) 987-4306 CIVIL ENGINEERS • LAND SURVEYORS	AT INTERSECTION OF CLARET COURT AND LA TOUR COURT
ENGINEER: DANIEL E. GUERRA	FIELD REVIEW: _____ DATE: _____
R.C.E. No. 29224	TIE BOOK: 24 PAGE: 69

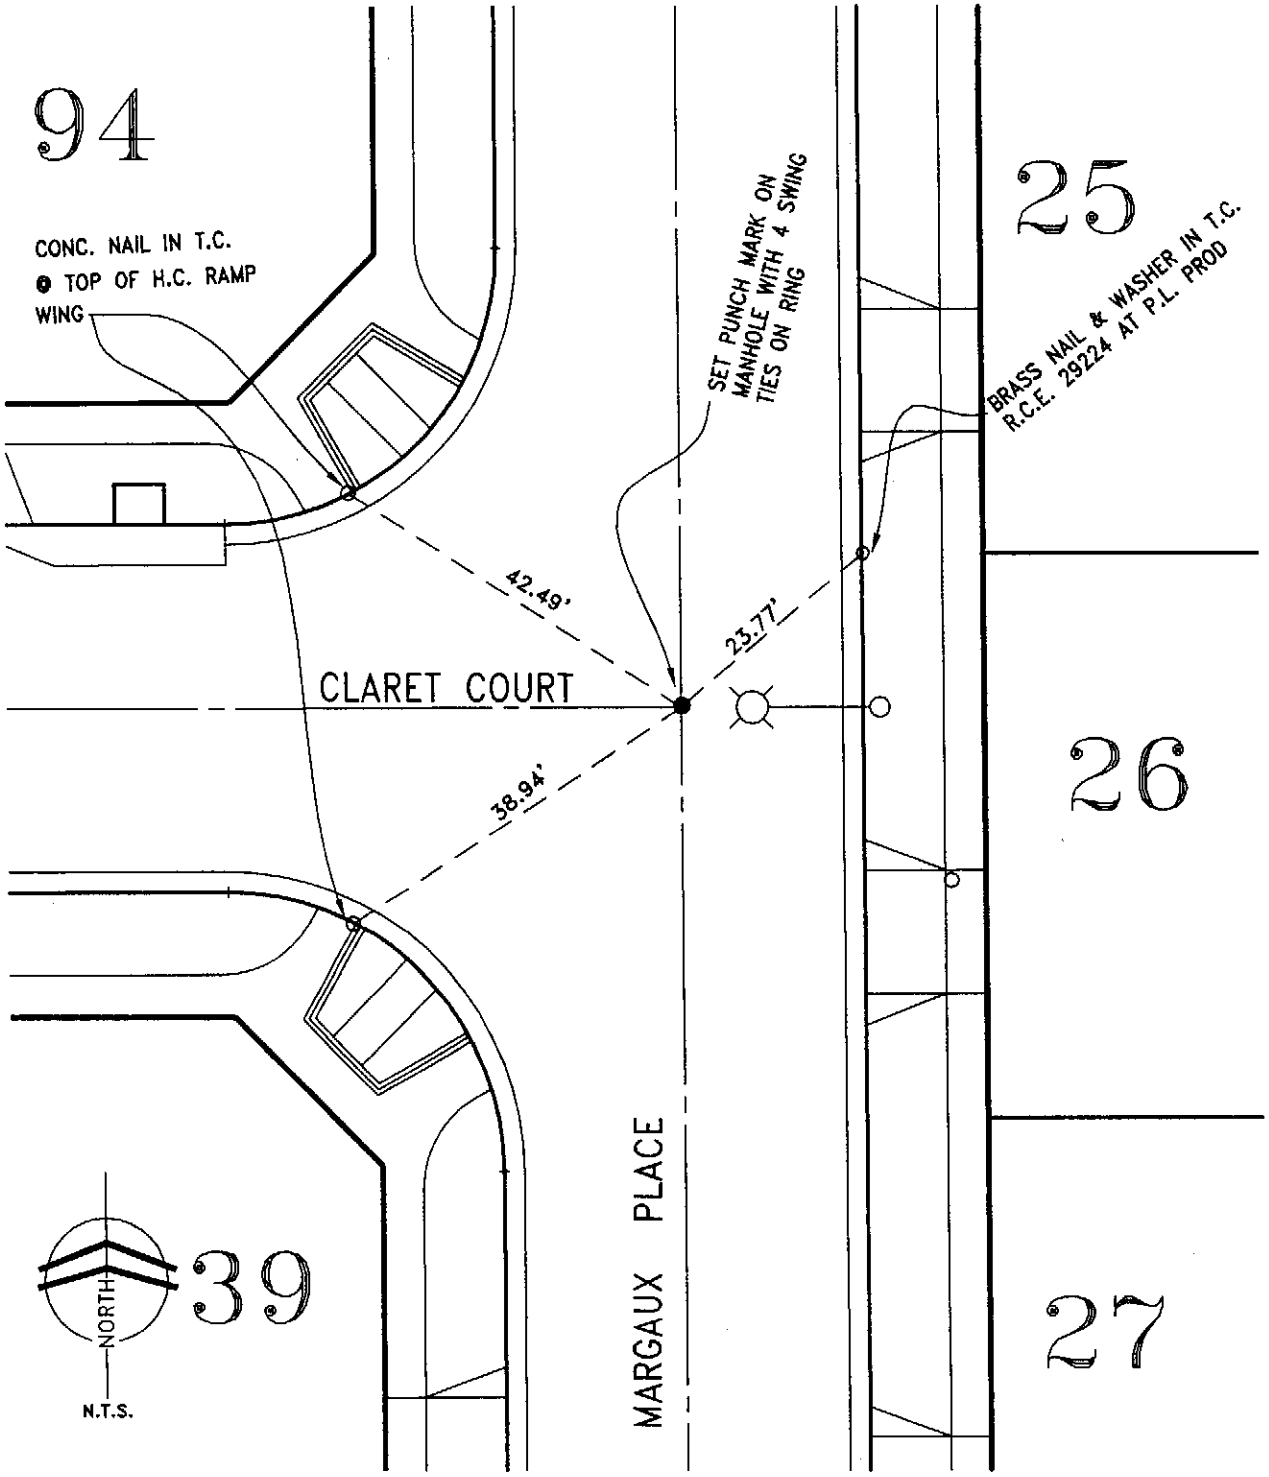

CITY OF RANCHO CUCAMONGA STREET TIES	TRACT 15711-2
Dan Guerra & Associates 10271-B TRADEMARK STREET RANCHO CUCAMONGA, CA 91730 (909) 987-4306 CIVIL ENGINEERS • LAND SURVEYORS	AT INTERSECTION OF MARGAUX PLACE AND CLARET COURT
ENGINEER: DANIEL E. GUERRA	FIELD REVIEW: _____ DATE: _____
R.C.E. No. 29224	TIE BOOK: 24 PAGE: 70

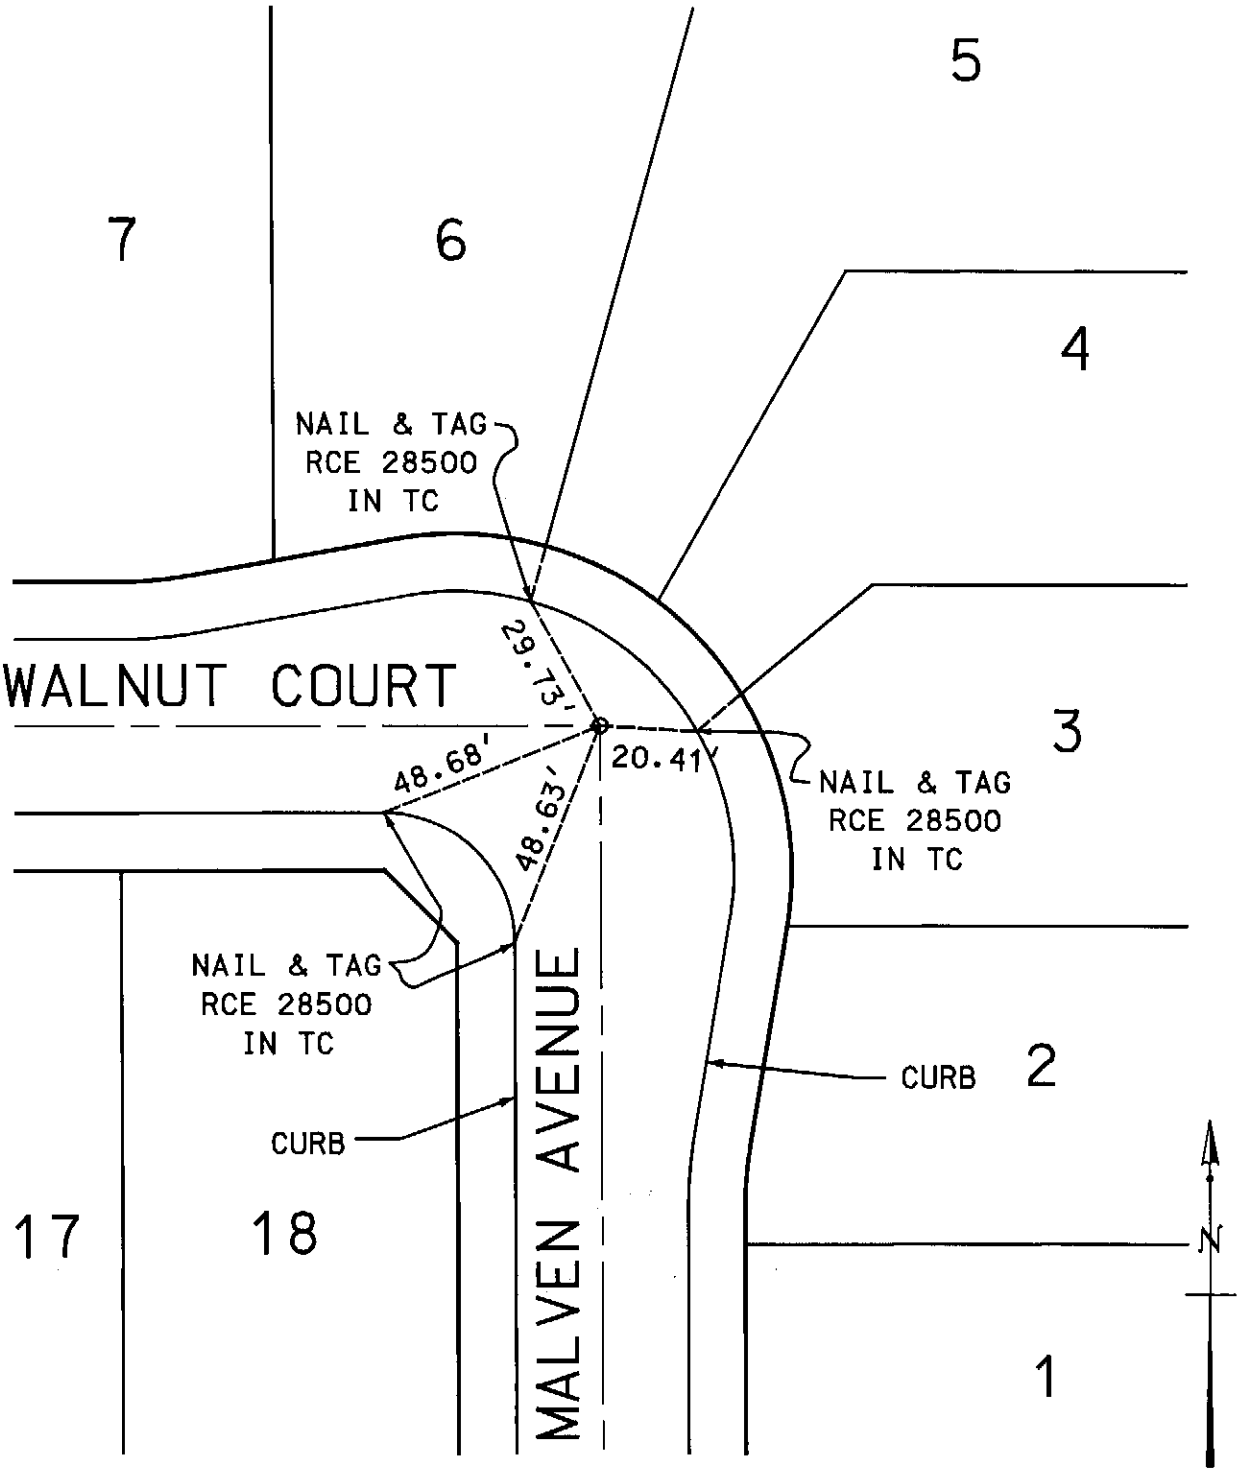

SCALE 1"= 40'

CITY OF RANCHO CUCAMONGA
STREET TIE

TRACT 16344

MALVEN AVENUE &
WALNUT COURT

Goodman & ASSOCIATES
2079 SKY VIEW DRIVE
COLTON, CA 92324
(909) 824-2775

DOUGLAS L. GOODMAN, RCE 28500
EXP. 3/31/2006

FIELD REVIEW _____ DATE _____

TIE BOOK 24 PAGE 71

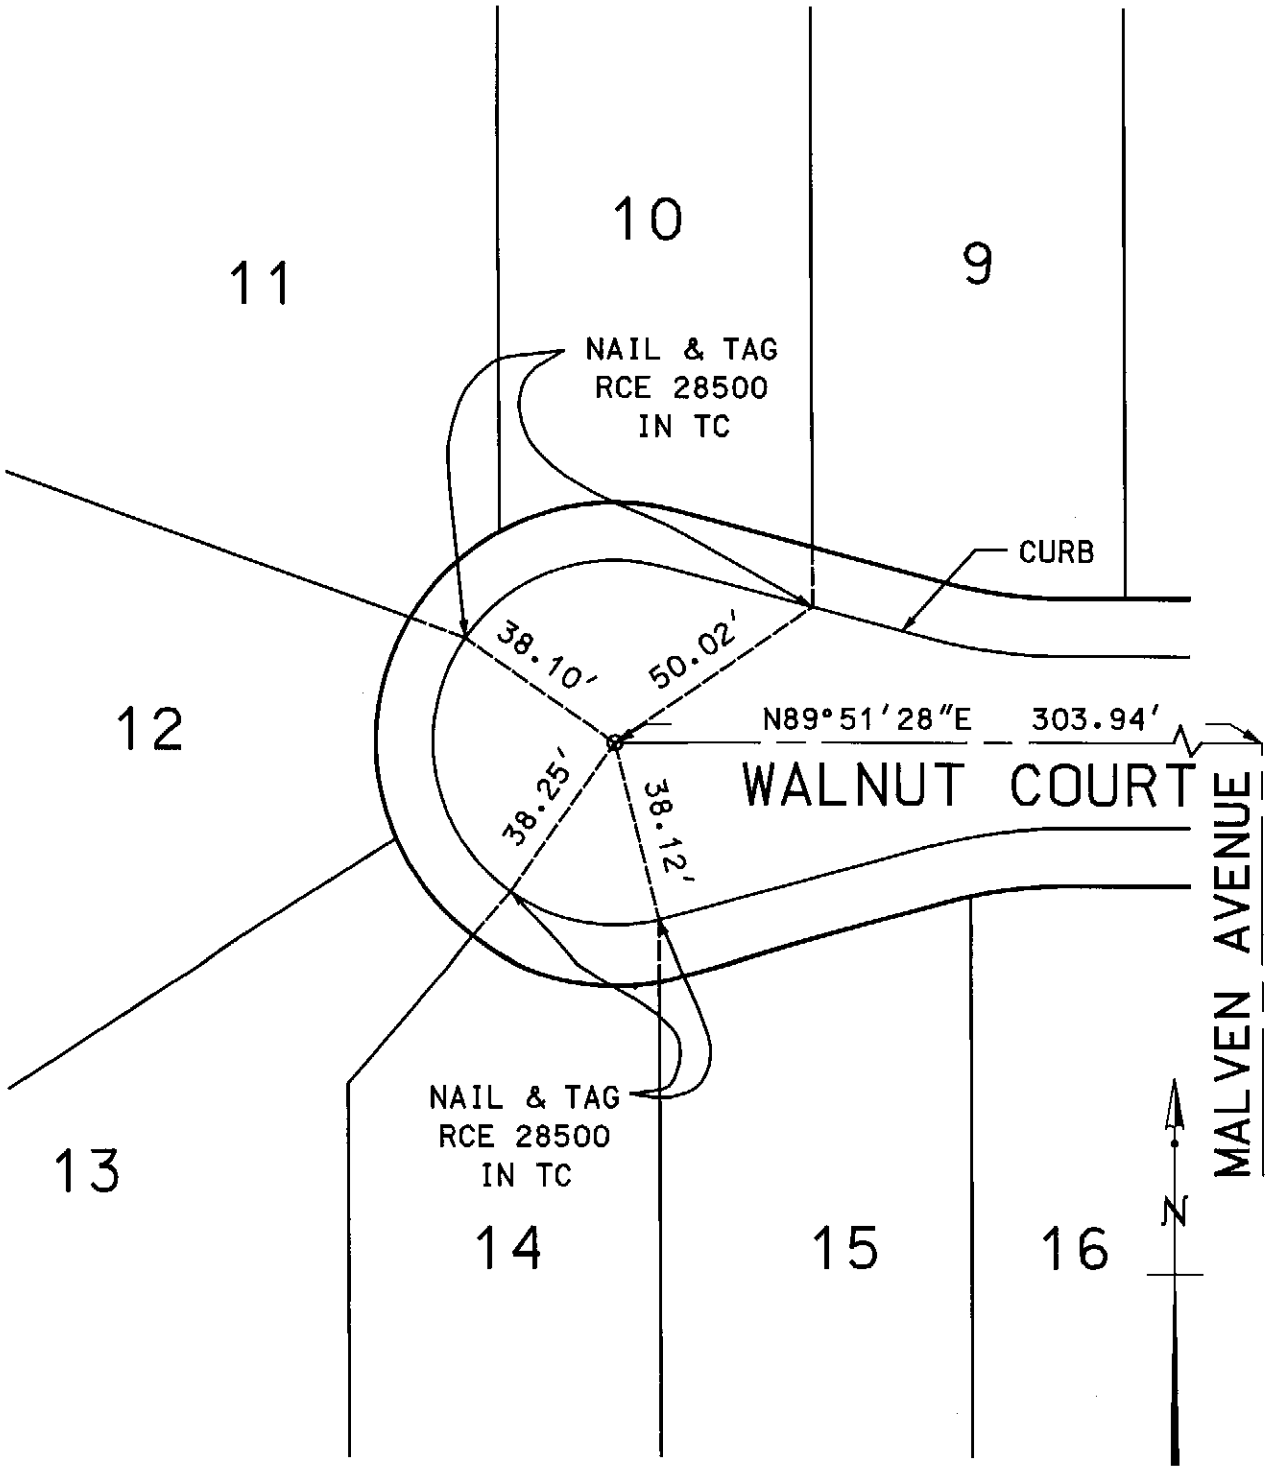

CITY OF RANCHO CUCAMONGA
STREET TIE

TRACT 16344

WALNUT COURT
CUL DE SAC

Goodman & ASSOCIATES
2079 SKY VIEW DRIVE
COLTON, CA 92324
(909) 824-2775

DOUGLAS L. GOODMAN, RCE 28500
EXP. 3/31/2006

FIELD REVIEW _____ DATE _____

TIE BOOK 24 PAGE 72

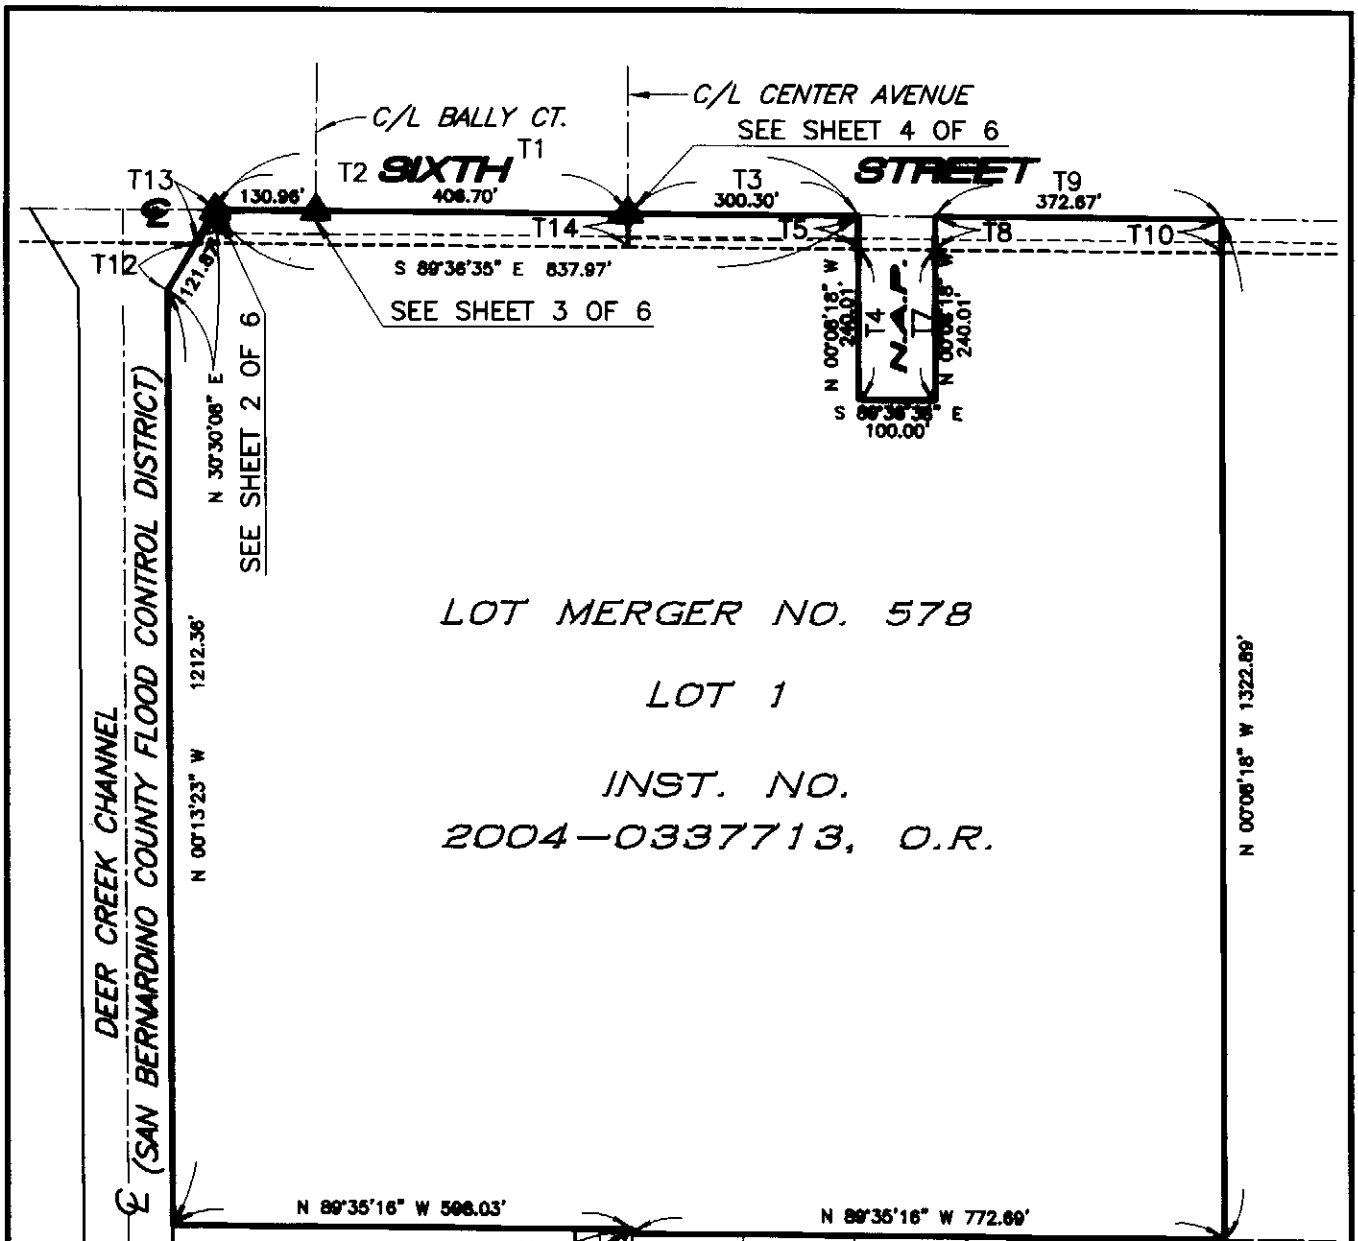

TANGENT TABLE:

NO.	DISTANCE	BEARING
T1	836.99'	N 89°36'38" W
T2	536.69'	N 89°36'38" W
T3	300.01'	N 89°36'38" W
T4	196.01'	N 00°08'18" W
T5	44.00'	N 00°08'18" W
T6	100.00'	N 89°36'38" W
T7	196.01'	N 00°08'18" W
T8	44.00'	N 00°08'18" W
T9	372.67'	N 89°36'38" W
T10	44.00'	N 00°08'18" W
T11	5.00'	N 00°08'18" W
T12	70.80'	N 30°54'08" E
T13	51.07'	N 30°54'08" E
T14	44.00'	N 00°08'18" W

SCALE: 1" = 250'

PROFESSIONAL LAND SURVEYOR
BRIAN L. THIENES
NO. 5750
EXP. 12/31/05
STATE OF CALIFORNIA

Thienes Engineering, Inc.
CIVIL ENGINEERING • LAND SURVEYING
16800 VALLEY VIEW AVENUE
LA MIRADA, CALIFORNIA 90638
PH.(714)521-4811 FAX(714)521-4173

REVISIONS

CITY OF RANCHO CUCAMONGA
PUBLIC WORKS DEPARTMENT

LOT MERGER NO. 578
CENTERLINE TIES

SCALE: 1" = 250'	DATE: 01/13/05	Book 24	Pg. 73	SHEET 1 OF 6

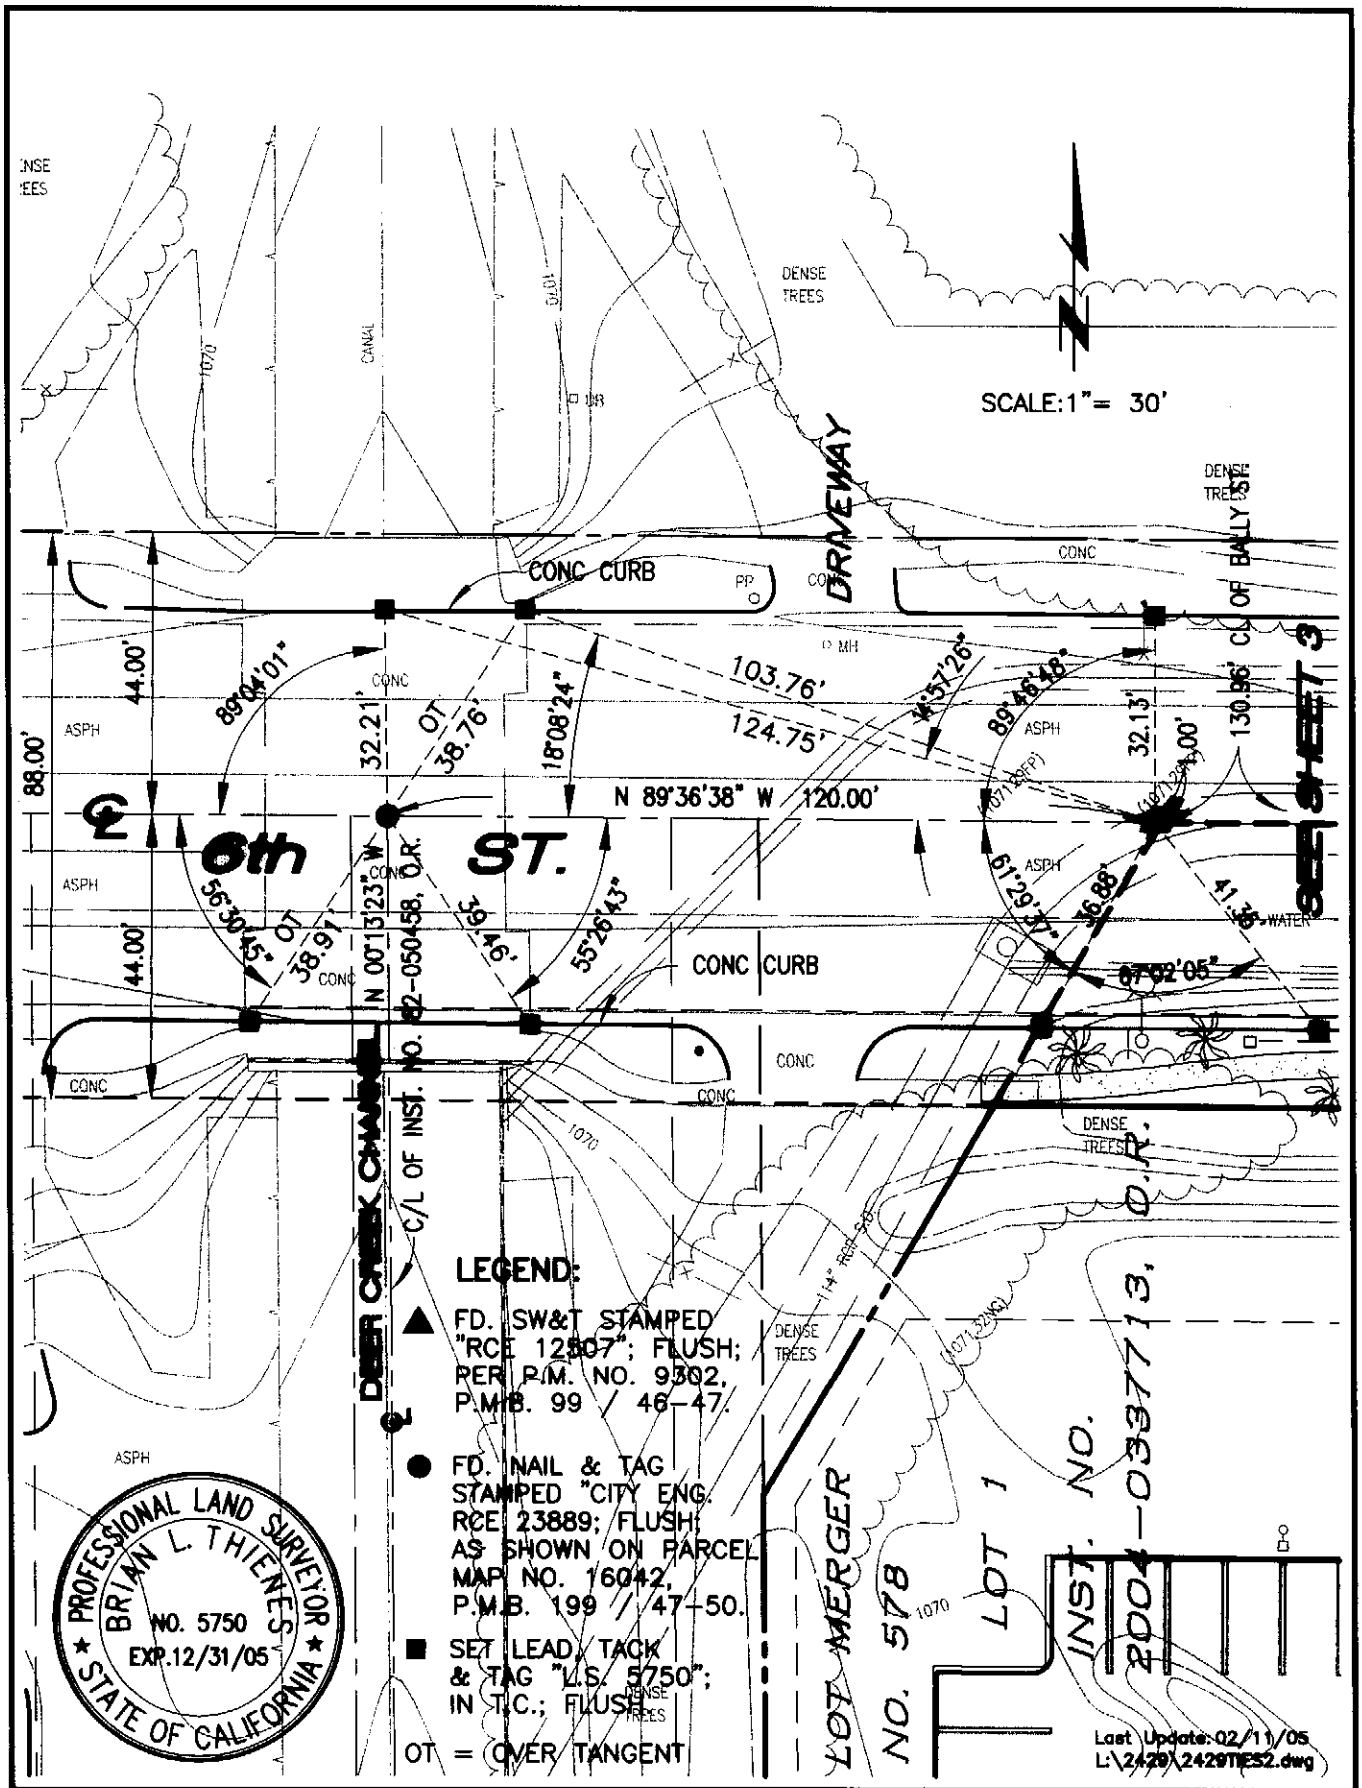

Thienes Engineering, Inc. CIVIL ENGINEERING • LAND SURVEYING 16800 VALLEY VIEW AVENUE LA MIRADA, CALIFORNIA 90638 PH.(714)521-4811 FAX(714)521-4173	REVISIONS	CITY OF RANCHO CUCAMONGA PUBLIC WORKS DEPARTMENT **LOT MERGER NO. 578** CENTERLINE TIES	
SCALE: 1" = 30'	DATE: 01/13/05	Book 24	Page 74	SHEET 2 OF 6

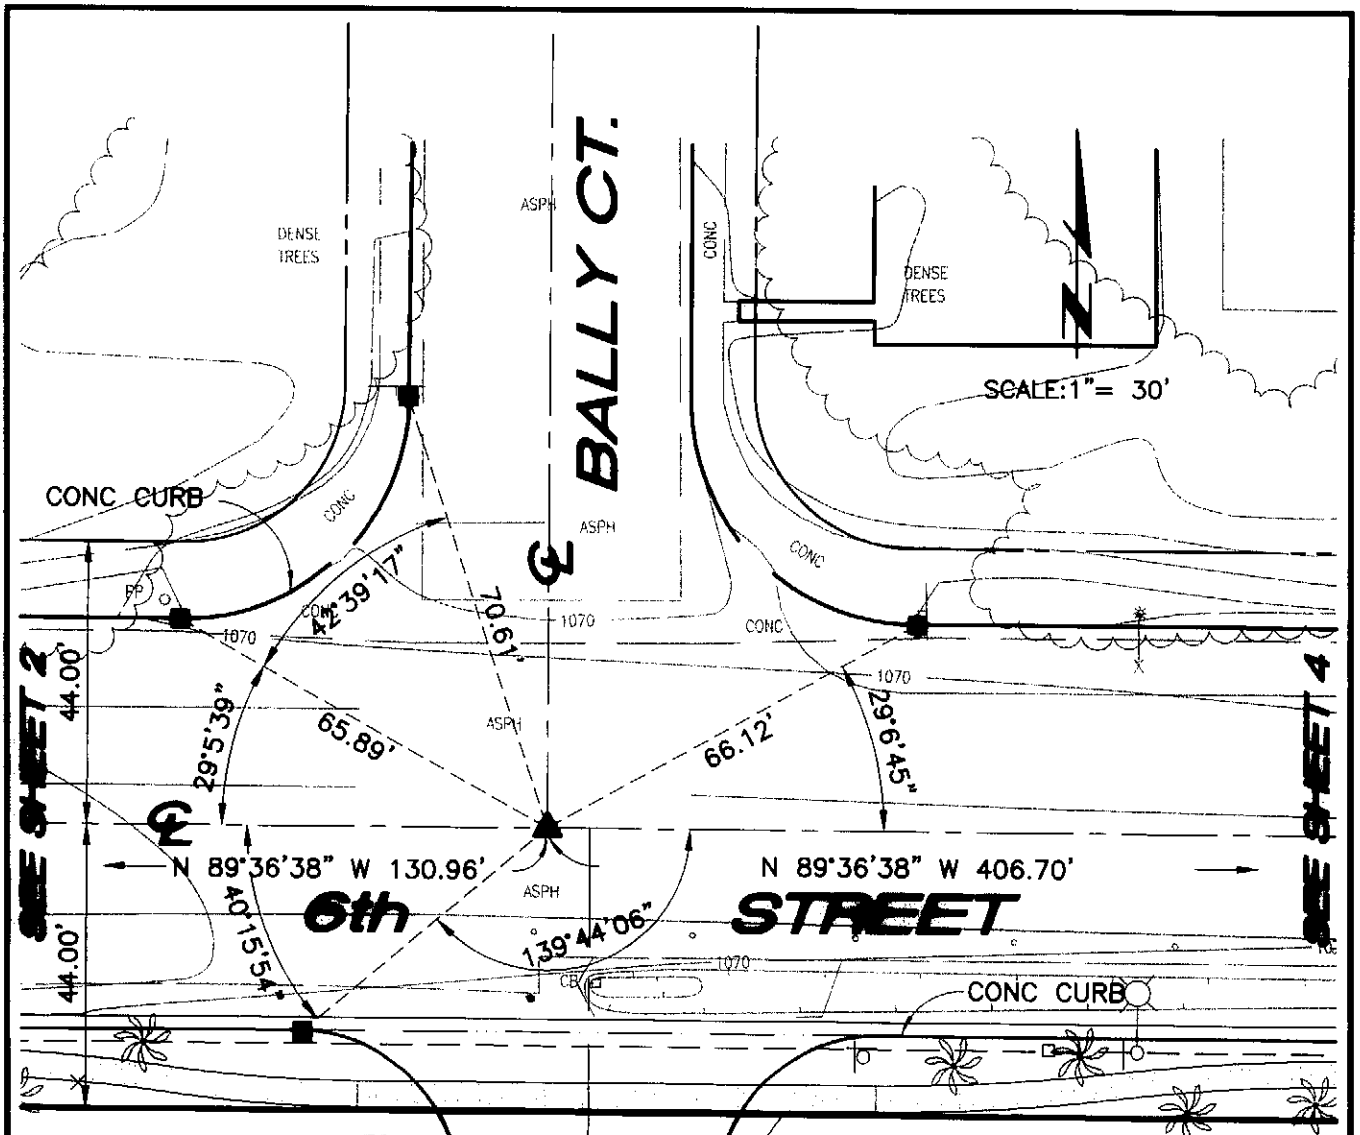

LOT MERGER NO. 578

LOT 1

DRIVEWAY

INST. NO.

2004-0337713, O.R.

LEGEND:

▲ FD. SW&T STAMPED "RCE 12507"; FLUSH; PER P.M. NO. 9302, P.M.B. 99 PG. 46-47. DESTROYED IN CONST. RE-SET SPIKE & WASHER STAMPED "L.S. 5750"; FLUSH; PER CONST. TIES

■ SET LEAD, TACK & TAG "L.S. 5750"; IN T.C.; FLUSH.

PROFESSIONAL LAND SURVEYOR
BRIAN L. THIENES
NO. 5750
EXP.12/31/05
STATE OF CALIFORNIA

Last Update: 02/11/05
L:\2429\2429TIES3.dwg

Thienes Engineering, Inc. CIVIL ENGINEERING • LAND SURVEYING 16800 VALLEY VIEW AVENUE LA MIRADA, CALIFORNIA 90638 PH.(714)521-4811 FAX(714)521-4173	REVISIONS	CITY OF RANCHO CUCAMONGA PUBLIC WORKS DEPARTMENT LOT MERGER NO. 578 CENTERLINE TIES	
SCALE: 1" = 30' DATE: 01/13/05	Book 24	Page 75	SHEET 3 OF 6

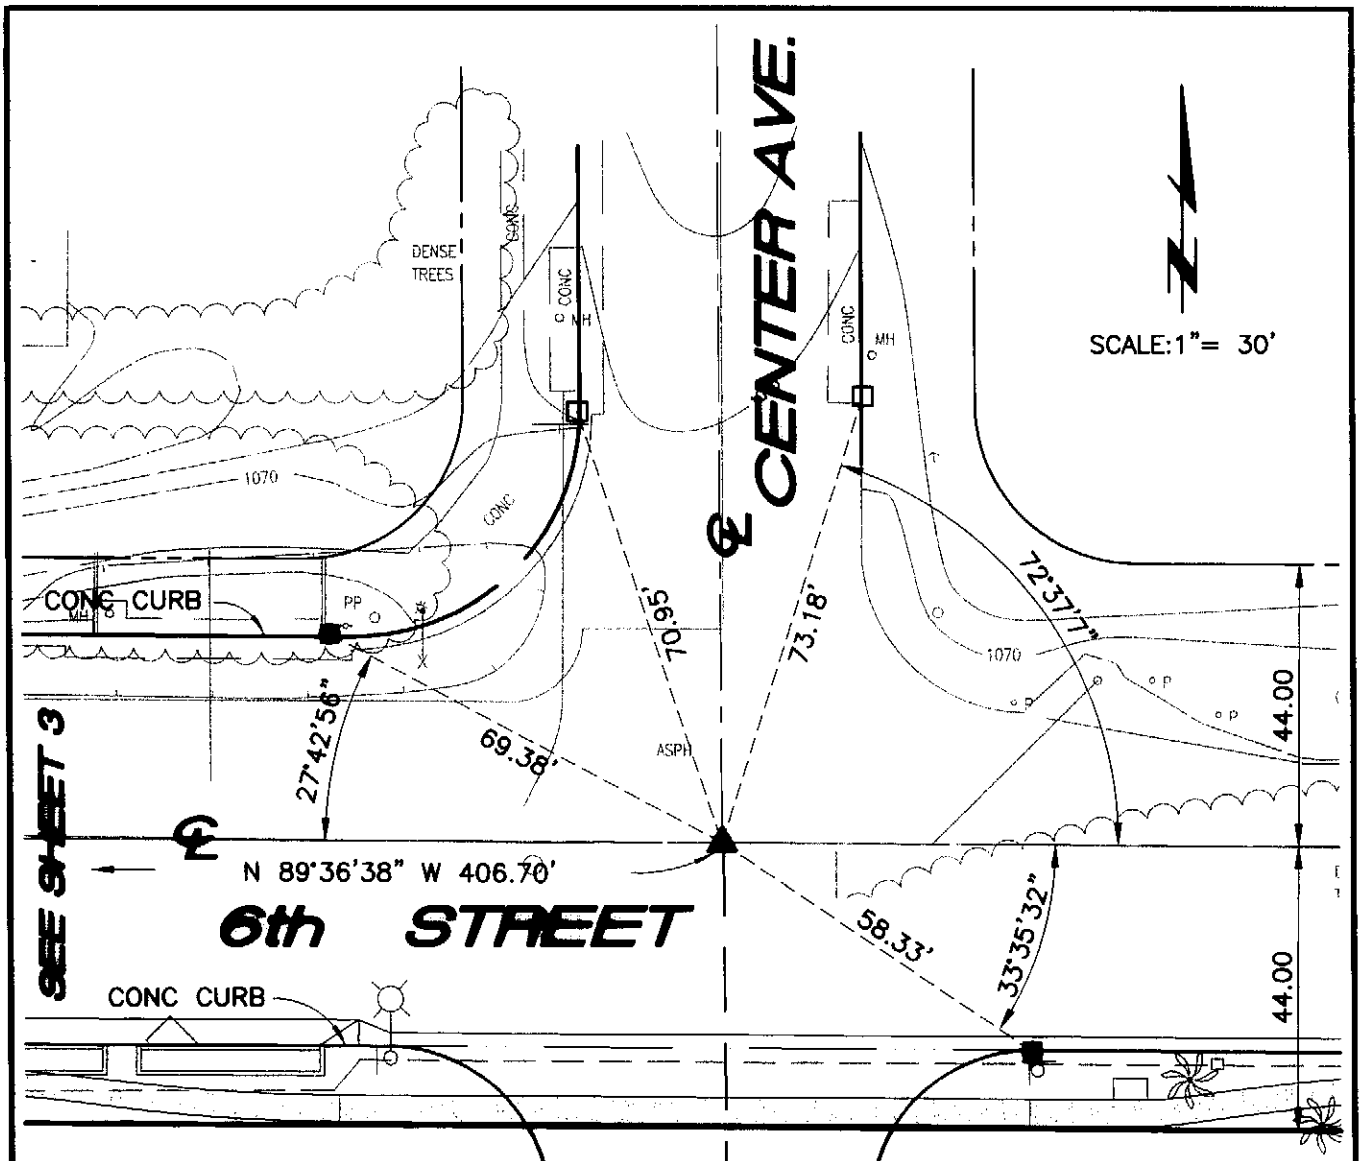

LOT MERGER NO. 578

LOT 1

PROFESSIONAL LAND SURVEYOR
BRIAN L. THIENES
NO. 5750
EXP.12/31/05
STATE OF CALIFORNIA

DRIVEWAY

INST. NO.

2004-0337713, O.R.

LEGEND:

- ▲ FD. 1" IRON PIPE W/IRON ROD; NO TAG; PER P.M. NO. 16042, P.M.B. 199 PG. 47-50.
- ■ SET LEAD, TACK & TAG "L.S. 5750"; IN T.C.; FLUSH.
- □ FD. CONC. NAIL NO TAG IN T.C.; FLUSH.

Last Update: 02/11/05
L:\2429\2429TIES4.dwg

Thienes Engineering, Inc. CIVIL ENGINEERING • LAND SURVEYING 16800 VALLEY VIEW AVENUE LA MIRADA, CALIFORNIA 90638 PH.(714)521-4811 FAX(714)521-4173	REVISIONS	CITY OF RANCHO CUCAMONGA PUBLIC WORKS DEPARTMENT	
		LOT MERGER NO. 578 CENTERLINE TIES	
SCALE: 1" = 30' / DATE: 01/13/05	BOOK 24	PAGE 76	SHEET 4 OF 6

LOT MERGER NO. 578 LOT 1

INST. NO. 2004-0337713, O.R.

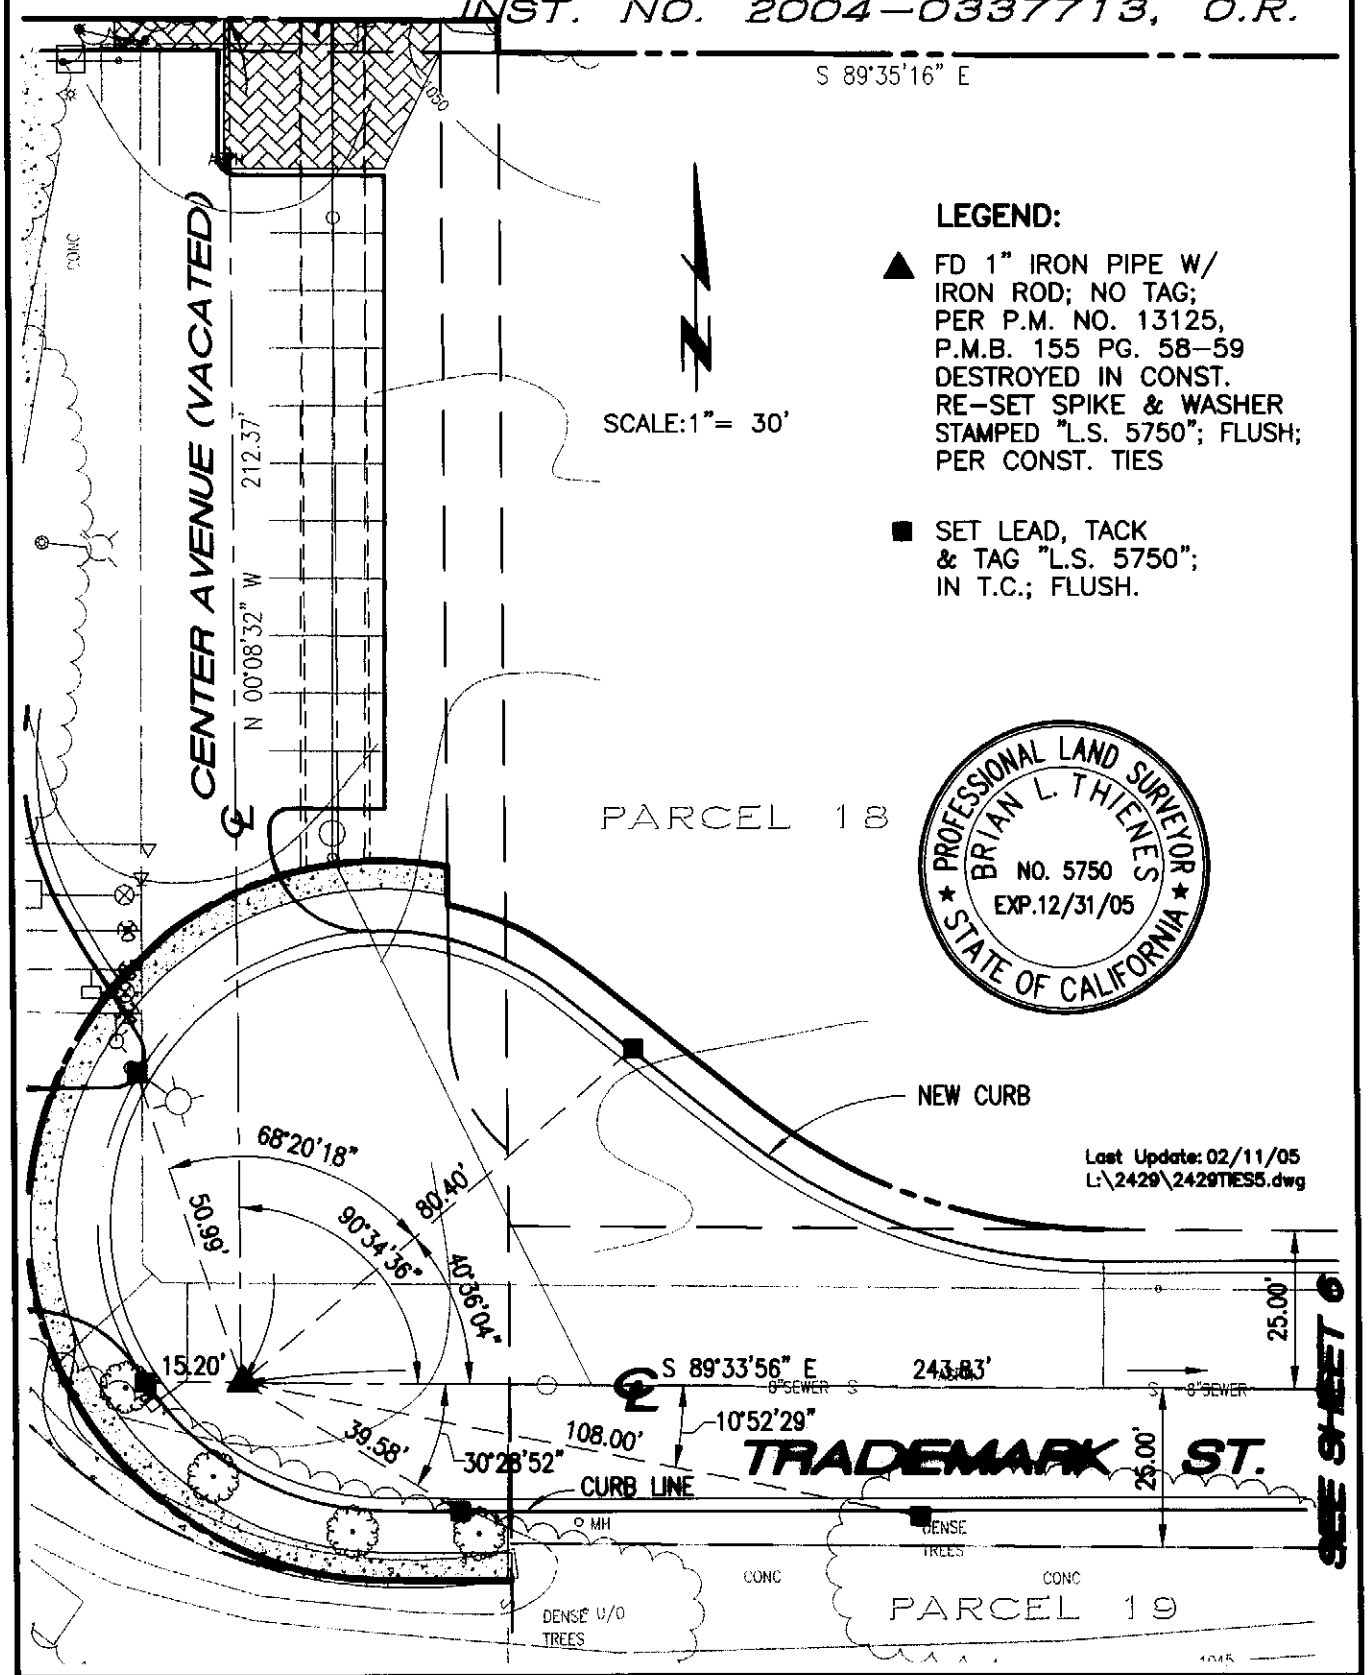

Thienes Engineering, Inc. CIVIL ENGINEERING • LAND SURVEYING 16800 VALLEY VIEW AVENUE LA MIRADA, CALIFORNIA 90638 PH.(714)521-4811 FAX(714)521-4173	REVISIONS	CITY OF RANCHO CUCAMONGA PUBLIC WORKS DEPARTMENT LOT MERGER NO. 578 CENTERLINE TIES	
SCALE: 1" = 30' DATE: 01/13/05	Book 24	Page 77	SHEET 5 OF 6

LOT MERGER NO. 578

LOT 1 INST. NO. 2004-0337713, O.R.

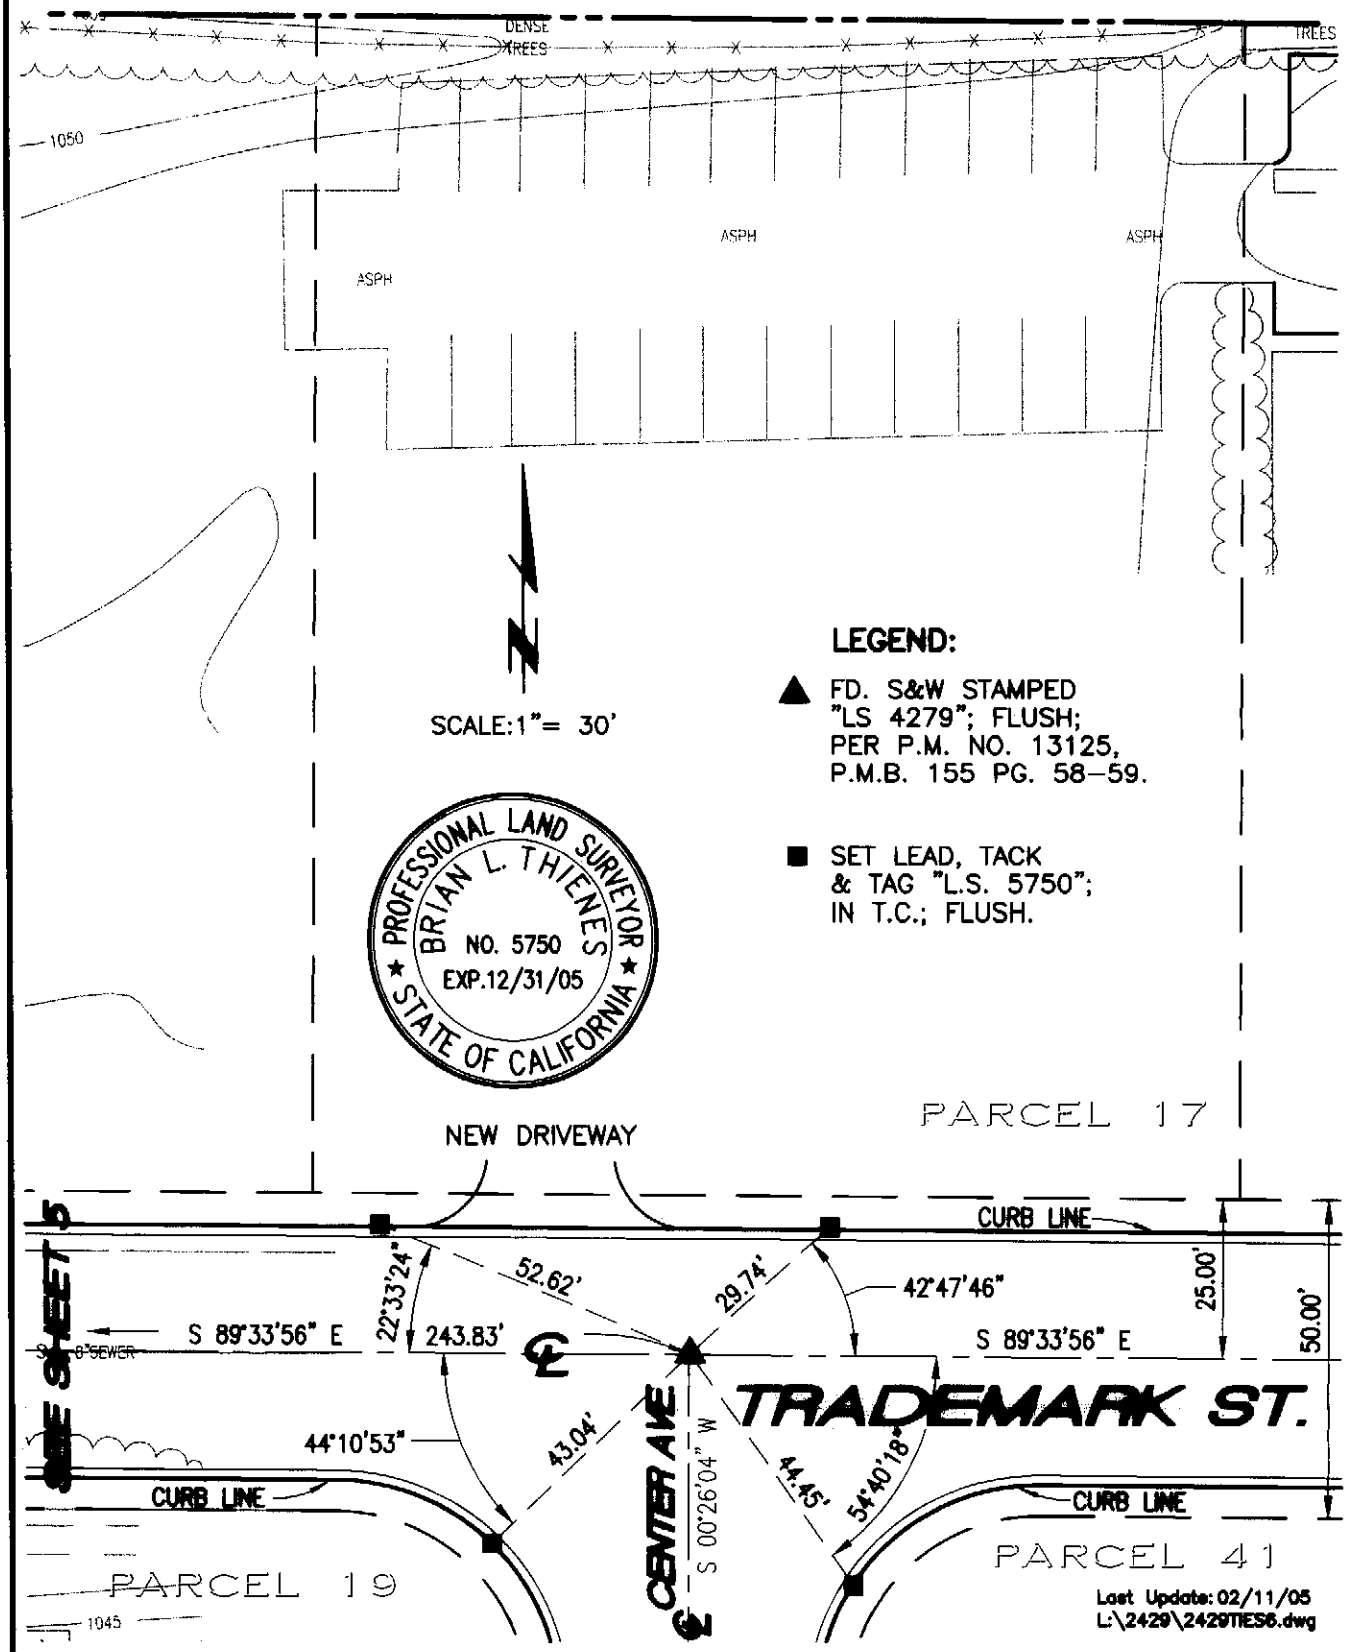

Thienes Engineering, Inc. CIVIL ENGINEERING • LAND SURVEYING 16800 VALLEY VIEW AVENUE LA MIRADA, CALIFORNIA 90638 PH.(714)521-4811 FAX(714)521-4173	REVISIONS	CITY OF RANCHO CUCAMONGA PUBLIC WORKS DEPARTMENT LOT MERGER NO. 578 CENTERLINE TIES	
SCALE: 1" = 30'	DATE: 01/13/05	BOOK 24	PAGE 78	SHEET 6 OF 6

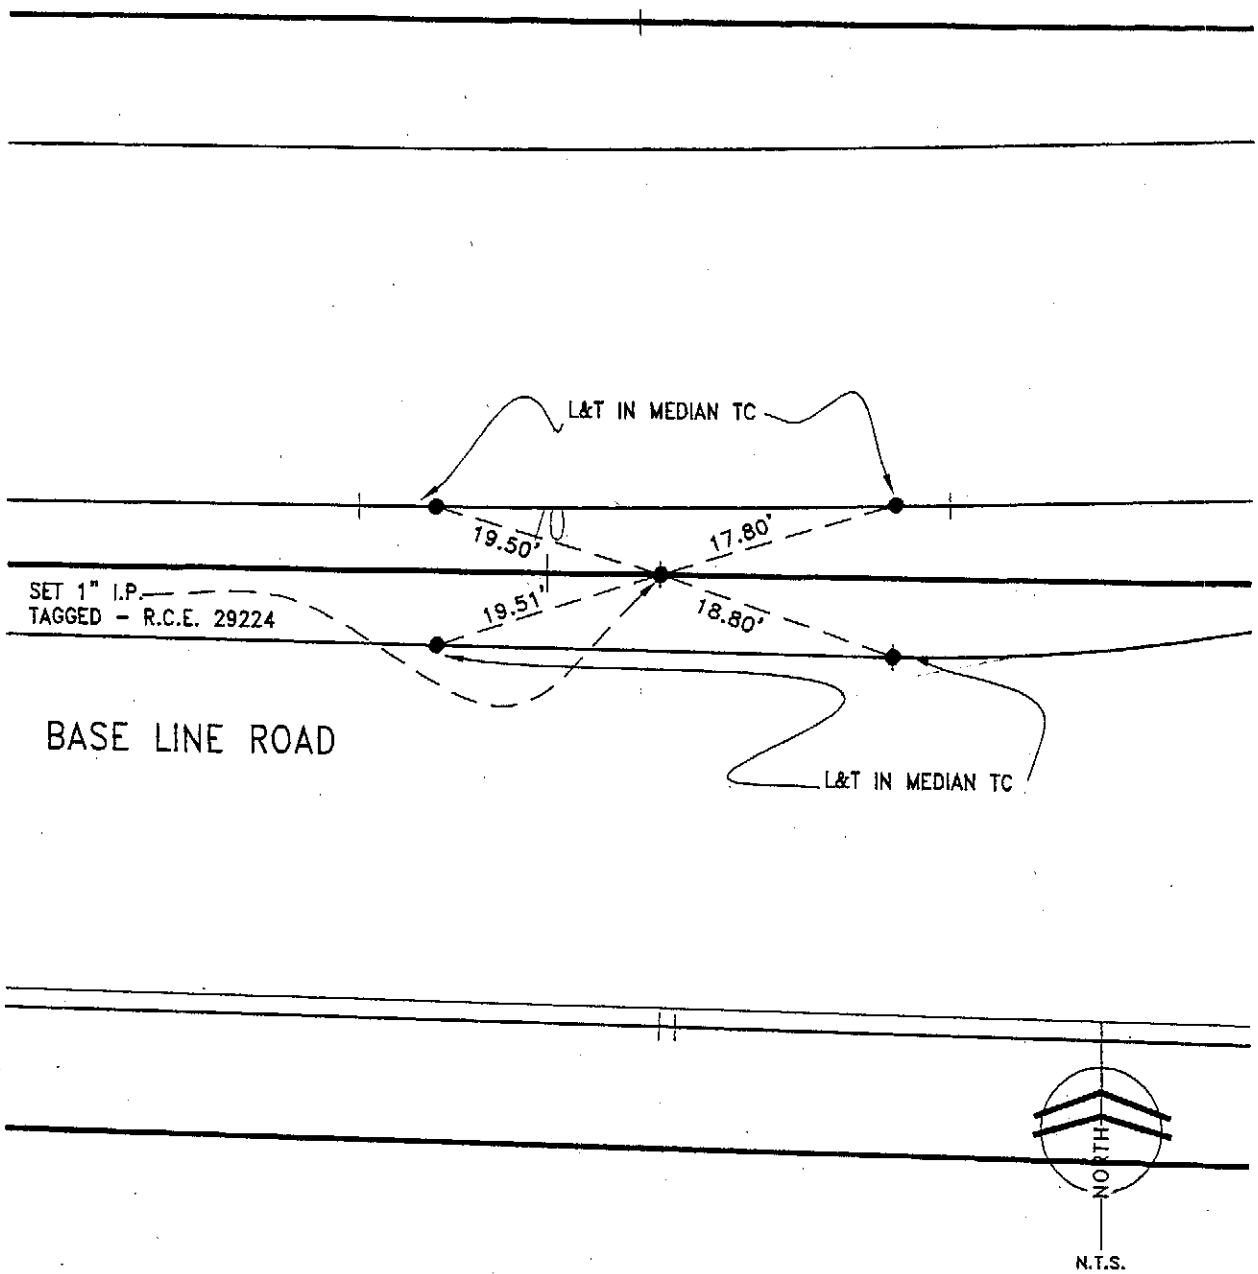

CITY OF RANCHO CUCAMONGA STREET TIES	PM 15641 PMB 192/93-100
Dan Guerra & Associates 10271-B TRADEMARK STREET RANCHO CUCAMONGA, CA 91730 (909) 987-4306 CIVIL ENGINEERS • LAND SURVEYORS	CENTERLINE BASE LINE ROAD 500'± WEST OF INTERSECTION OF BASE LINE AND DAY CREEK
ENGINEER: DANIEL E. GUERRA	FIELD REVIEW: MOS DATE: 2-28-05
R.C.E. No. 29224	TIE BOOK: 24 PAGE: 79

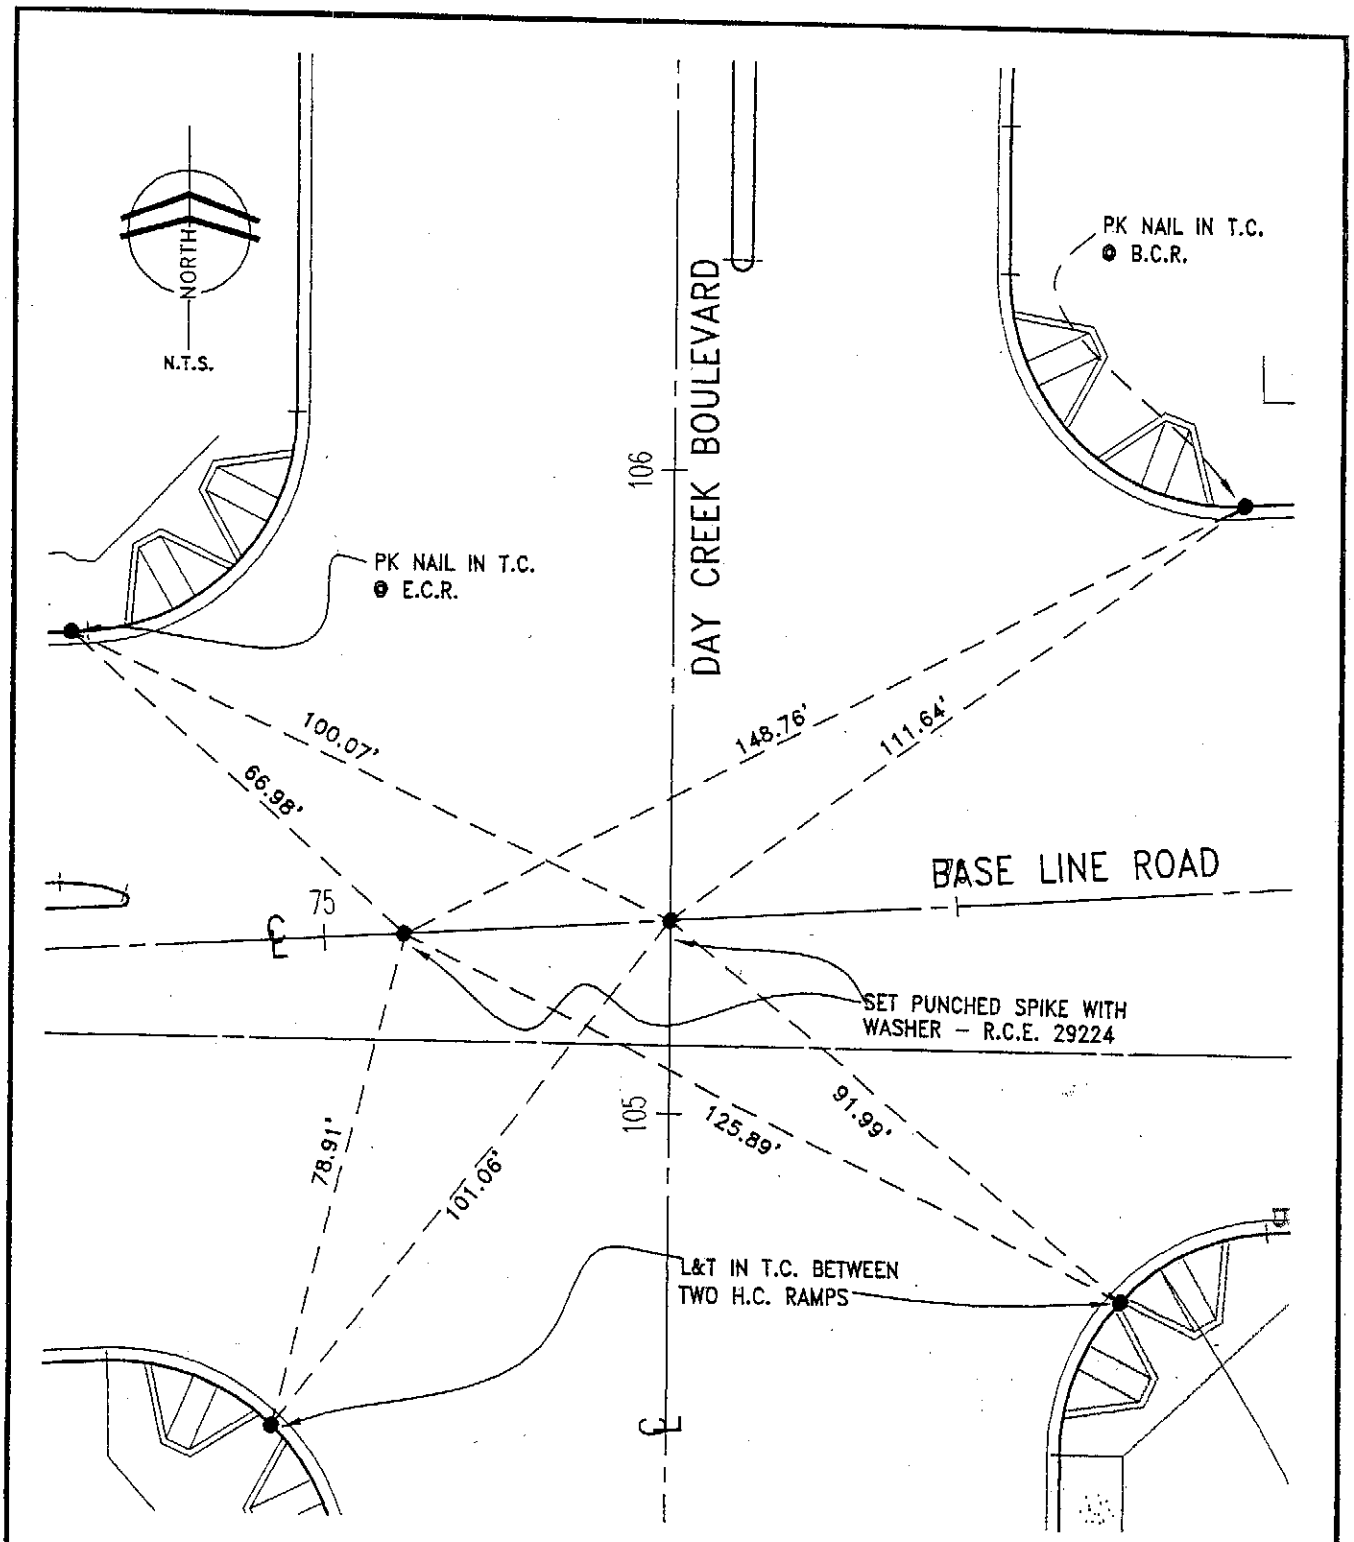

CITY OF RANCHO CUCAMONGA STREET TIES	PM 15641 PMB 192/93-100
Dan Guerra & Associates 10271-B TRADEMARK STREET RANCHO CUCAMONGA, CA 91730 (909) 987-4306 CIVIL ENGINEERS • LAND SURVEYORS	CENTERLINE INTERSECTION DAY CREEK BOULEVARD AND BASE LINE ROAD E.C. @ CENTERLINE BASELINE JUST WEST OF INTERSECTION BASELINE AND DAY CREEK
ENGINEER: DANIEL E. GUERRA	FIELD REVIEW: [illegible] DATE: 2-28-05
R.C.E. No. 29224	TIE BOOK: 24 PAGE: 80

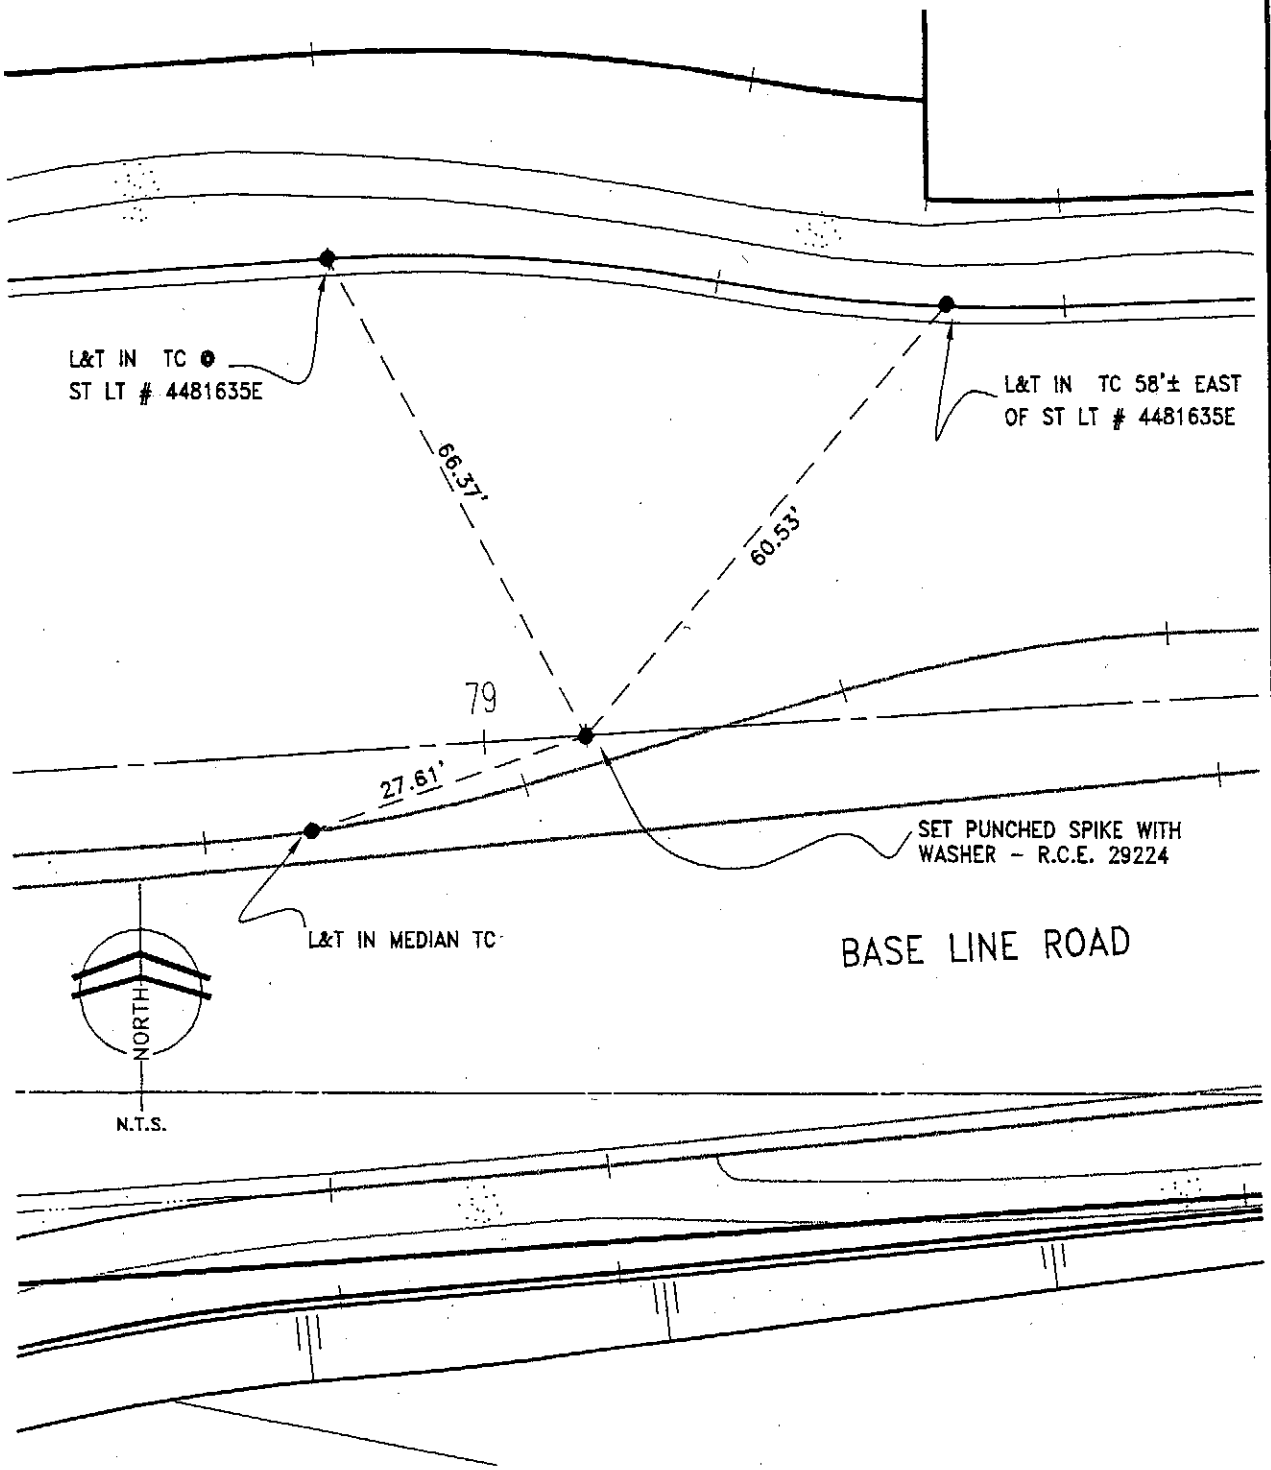

CITY OF RANCHO CUCAMONGA STREET TIES	PM 15641 PMB 192/93-100
Dan Guerra & Associates 10271-B TRADEMARK STREET RANCHO CUCAMONGA, CA 91730 (909) 987-4306 CIVIL ENGINEERS • LAND SURVEYORS	CENTERLINE BASELINE B.C. 400'± EAST OF INTERSECTION DAY CREEK AND BASE LINE ROAD
ENGINEER: DANIEL E. GUERRA	FIELD REVIEW: [illegible] DATE: 2-28-05
R.C.E. No. 29224	TIE BOOK: 24 PAGE: 81

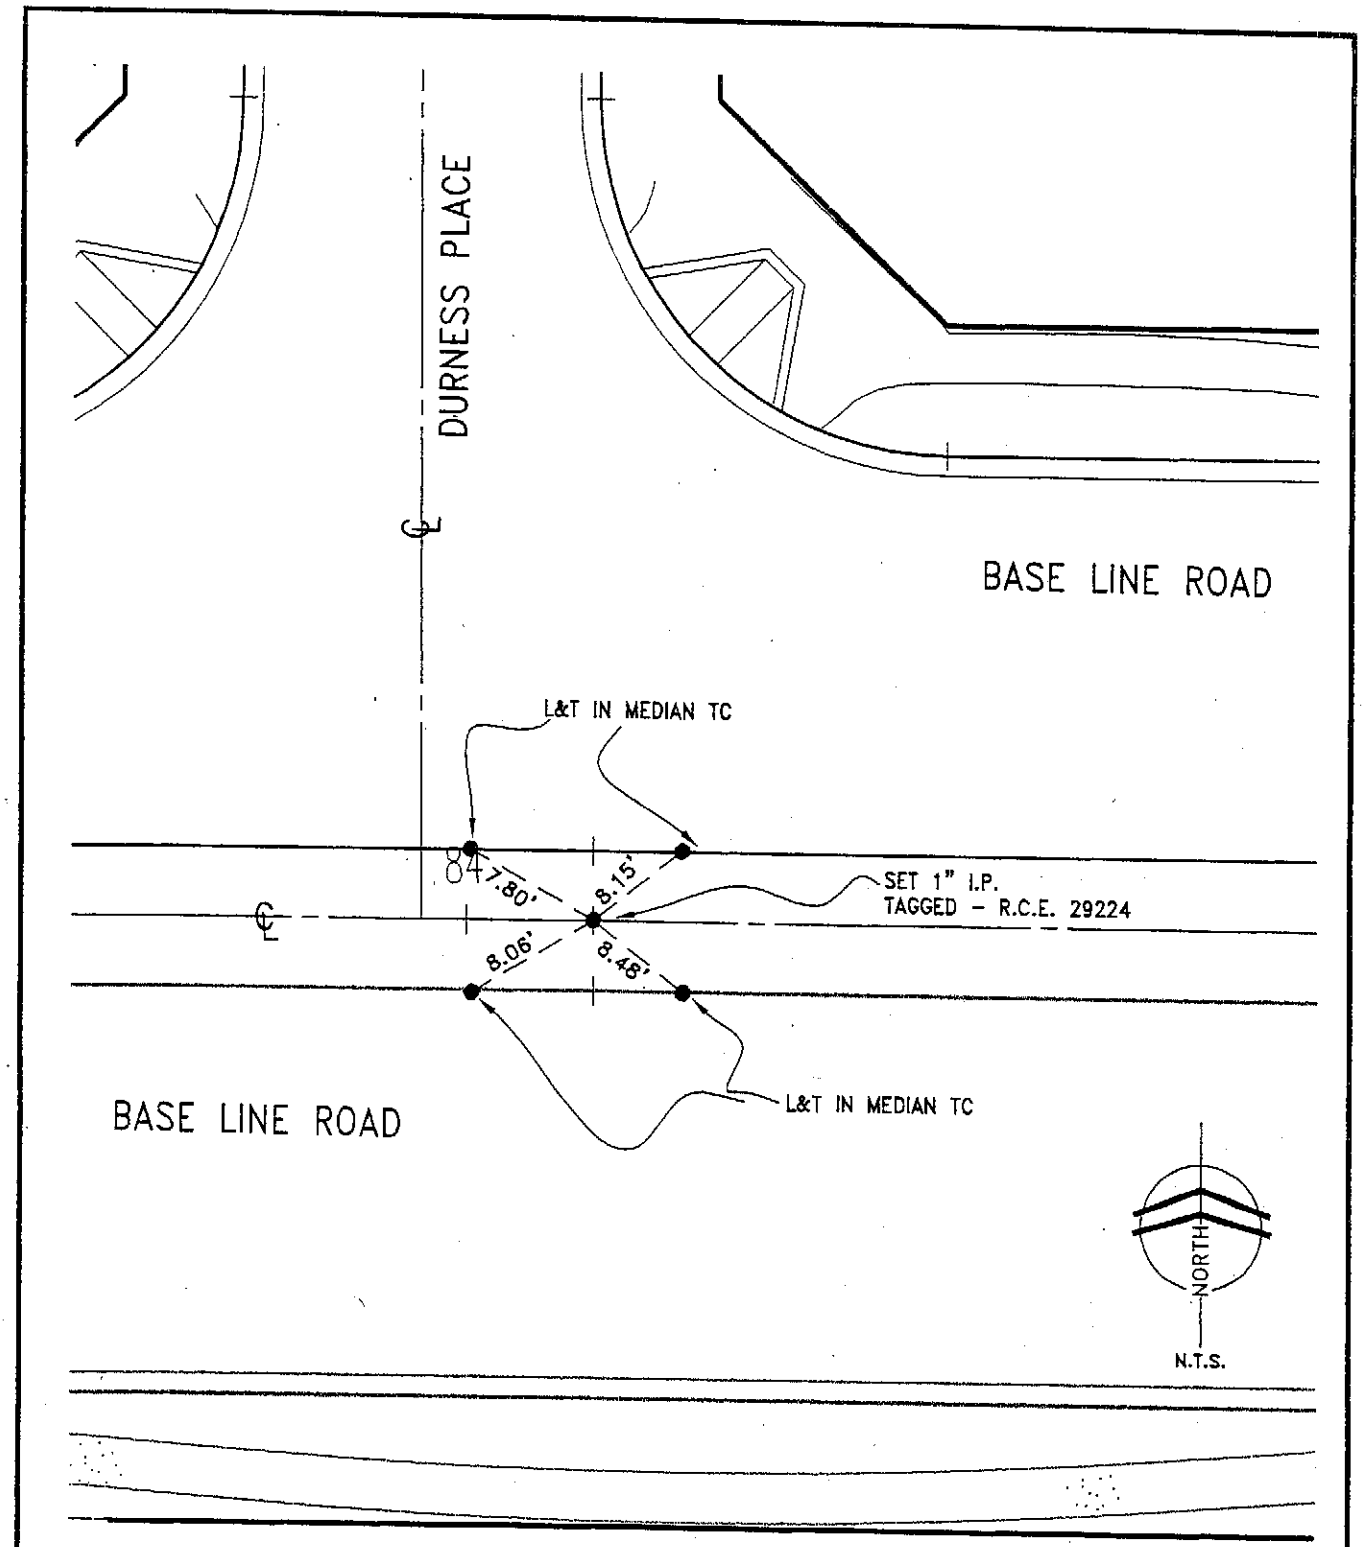

CITY OF RANCHO CUCAMONGA STREET TIES	PM 15641 PMB 192/93-100
Dan Guerra & Associates 10271-B TRADEMARK STREET RANCHO CUCAMONGA, CA 91730 (909) 987-4306 CIVIL ENGINEERS • LAND SURVEYORS	CENTERLINE BASE LINE ROAD E.C. JUST EAST OF DURNESS PLACE
ENGINEER: DANIEL E. GUERRA	FIELD REVIEW: MDL DATE: 7-28-05
R.C.E. No. 29224	TIE BOOK: 24 PAGE: 82

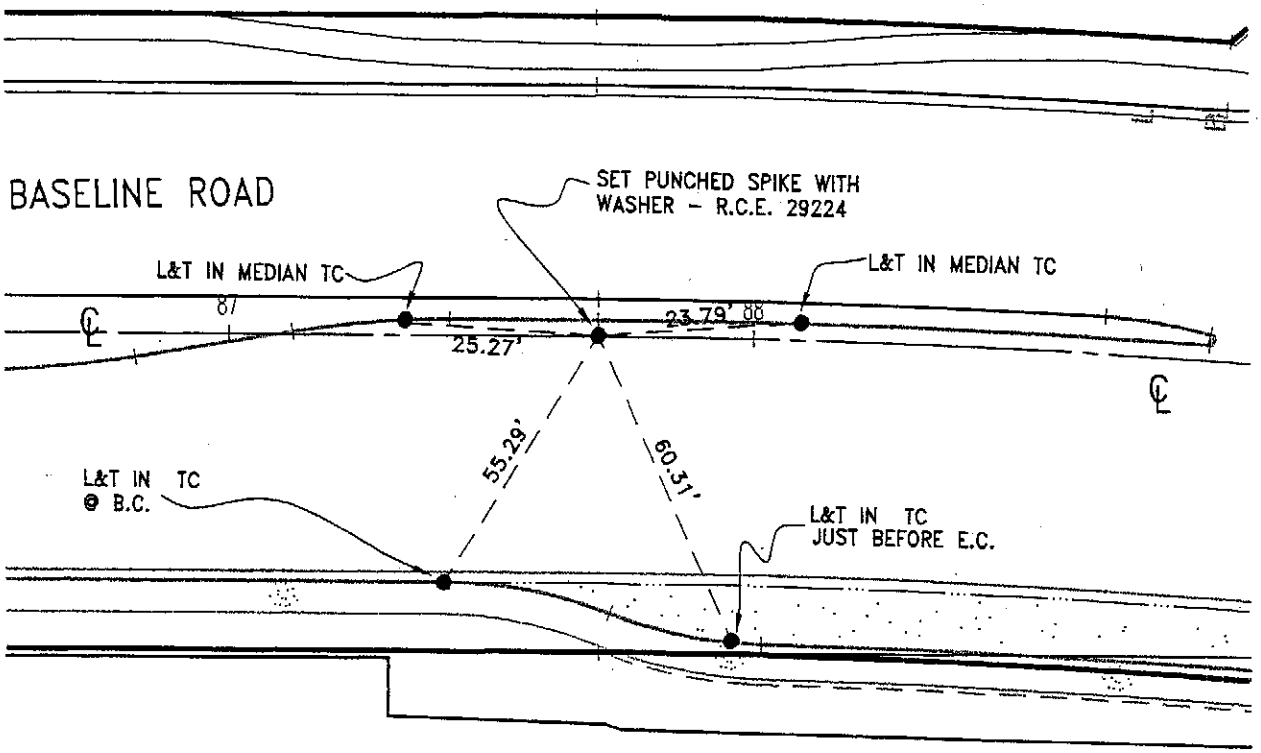

EXISTING WINERY BLDG.

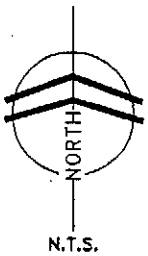

CITY OF RANCHO CUCAMONGA STREET TIES	PM 15641 PMB 192/93-100
Dan Guerra & Associates 10271-B TRADEMARK STREET RANCHO CUCAMONGA, CA 91730 (909) 987-4306 CIVIL ENGINEERS • LAND SURVEYORS	CENTERLINE BASELINE, B.C. JUST WEST OF SAN CARMELA COURT
ENGINEER: DANIEL E. GUERRA	FIELD REVIEW: MDA DATE: 2-28-05
R.C.E. No. 29224	TIE BOOK: 24 PAGE: 83

(5)

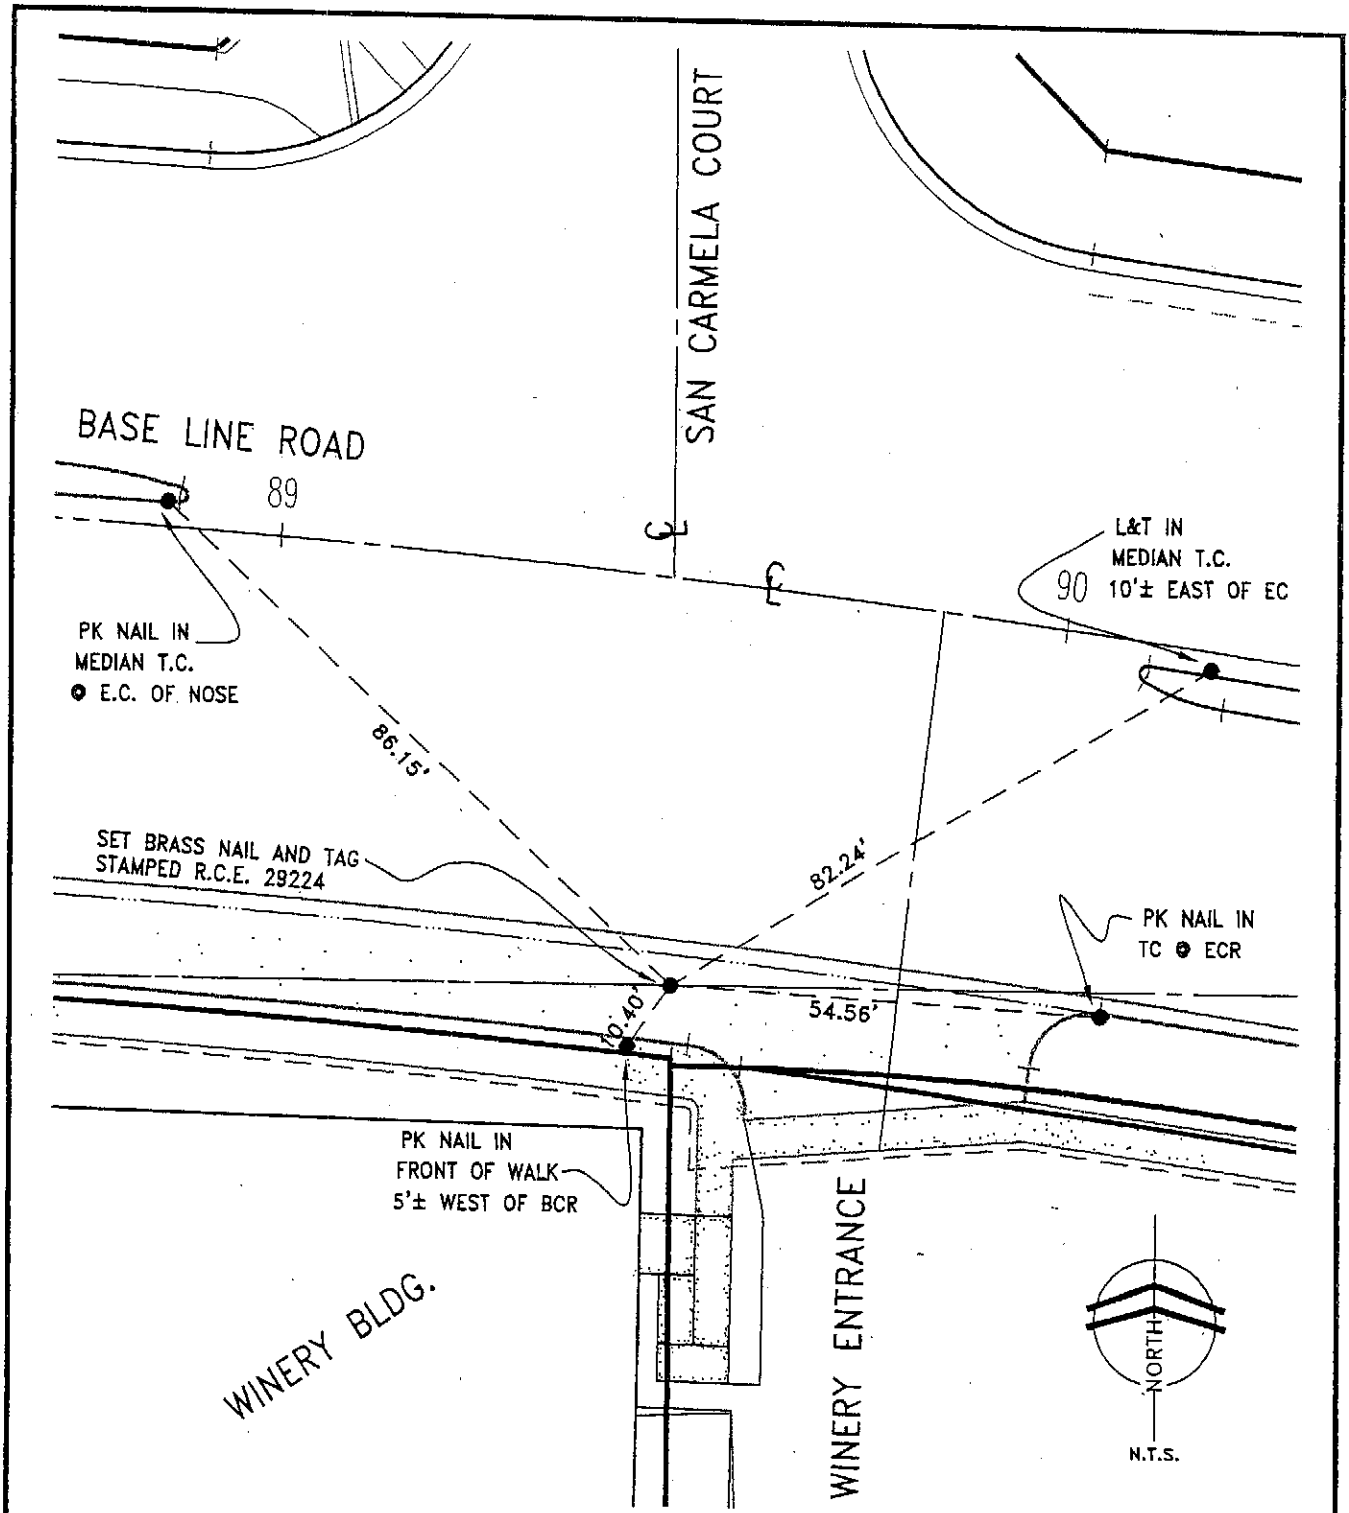

CITY OF RANCHO CUCAMONGA STREET TIES	PM 15641 PMB 192/93-100
Dan Guerra & Associates 10271-B TRADEMARK STREET RANCHO CUCAMONGA, CA 91730 (909) 987-4306 CIVIL ENGINEERS • LAND SURVEYORS	SET BRASS NAIL AND TAG R.C.E. 29224, IN LIEU OF S&W (LS 4693) PER TRACT NO. 15875-1, M.B. 273/77-83.
ENGINEER: DANIEL E. GUERRA	FIELD REVIEW: [signature] DATE: 2-28-05
R.C.E. No. 29224	TIE BOOK: 24 PAGE: 84

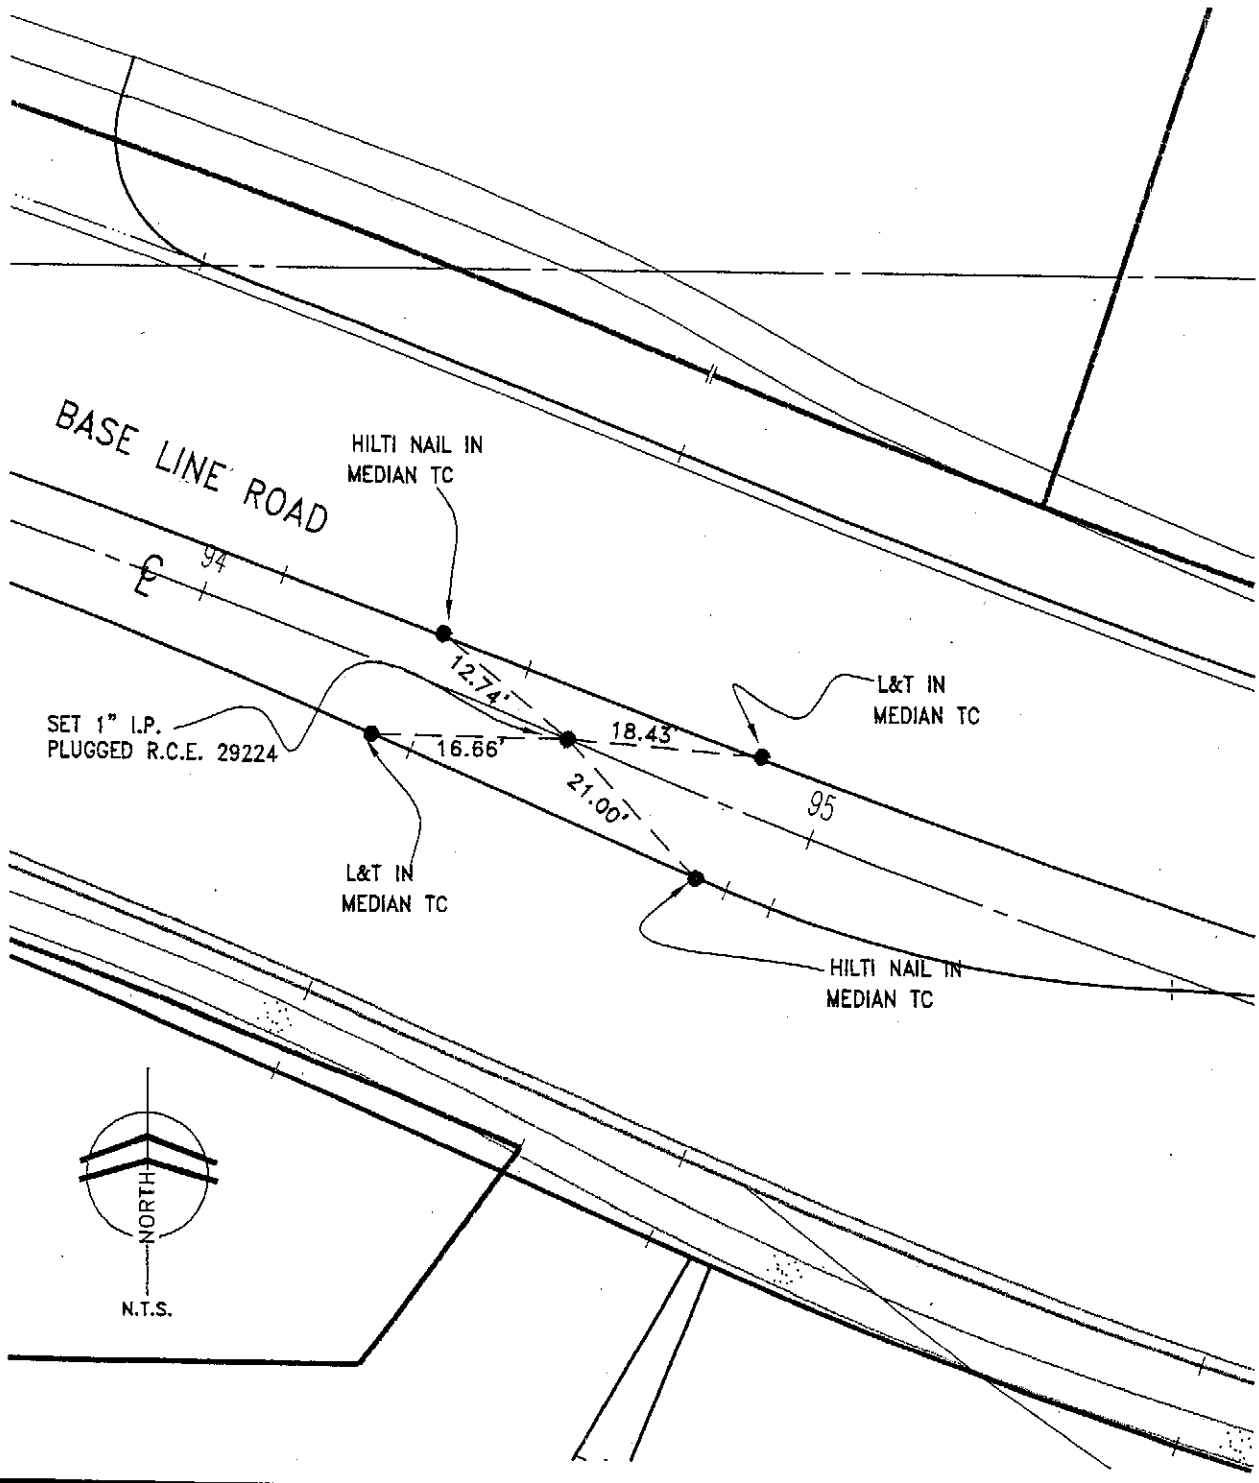

CITY OF RANCHO CUCAMONGA STREET TIES	PM 15641 PMB 192/93-100
Dan Guerra & Associates 10271-B TRADEMARK STREET RANCHO CUCAMONGA, CA 91730 (909) 987-4306 CIVIL ENGINEERS • LAND SURVEYORS	CENTERLINE BASE LINE ROAD, P.R.C. JUST WEST OF VICTORIA PARK LANE
ENGINEER: DANIEL E. GUERRA	FIELD REVIEW: MOA DATE: 2-28-05
R.C.E. No. 29224	TIE BOOK: 24 PAGE: 85

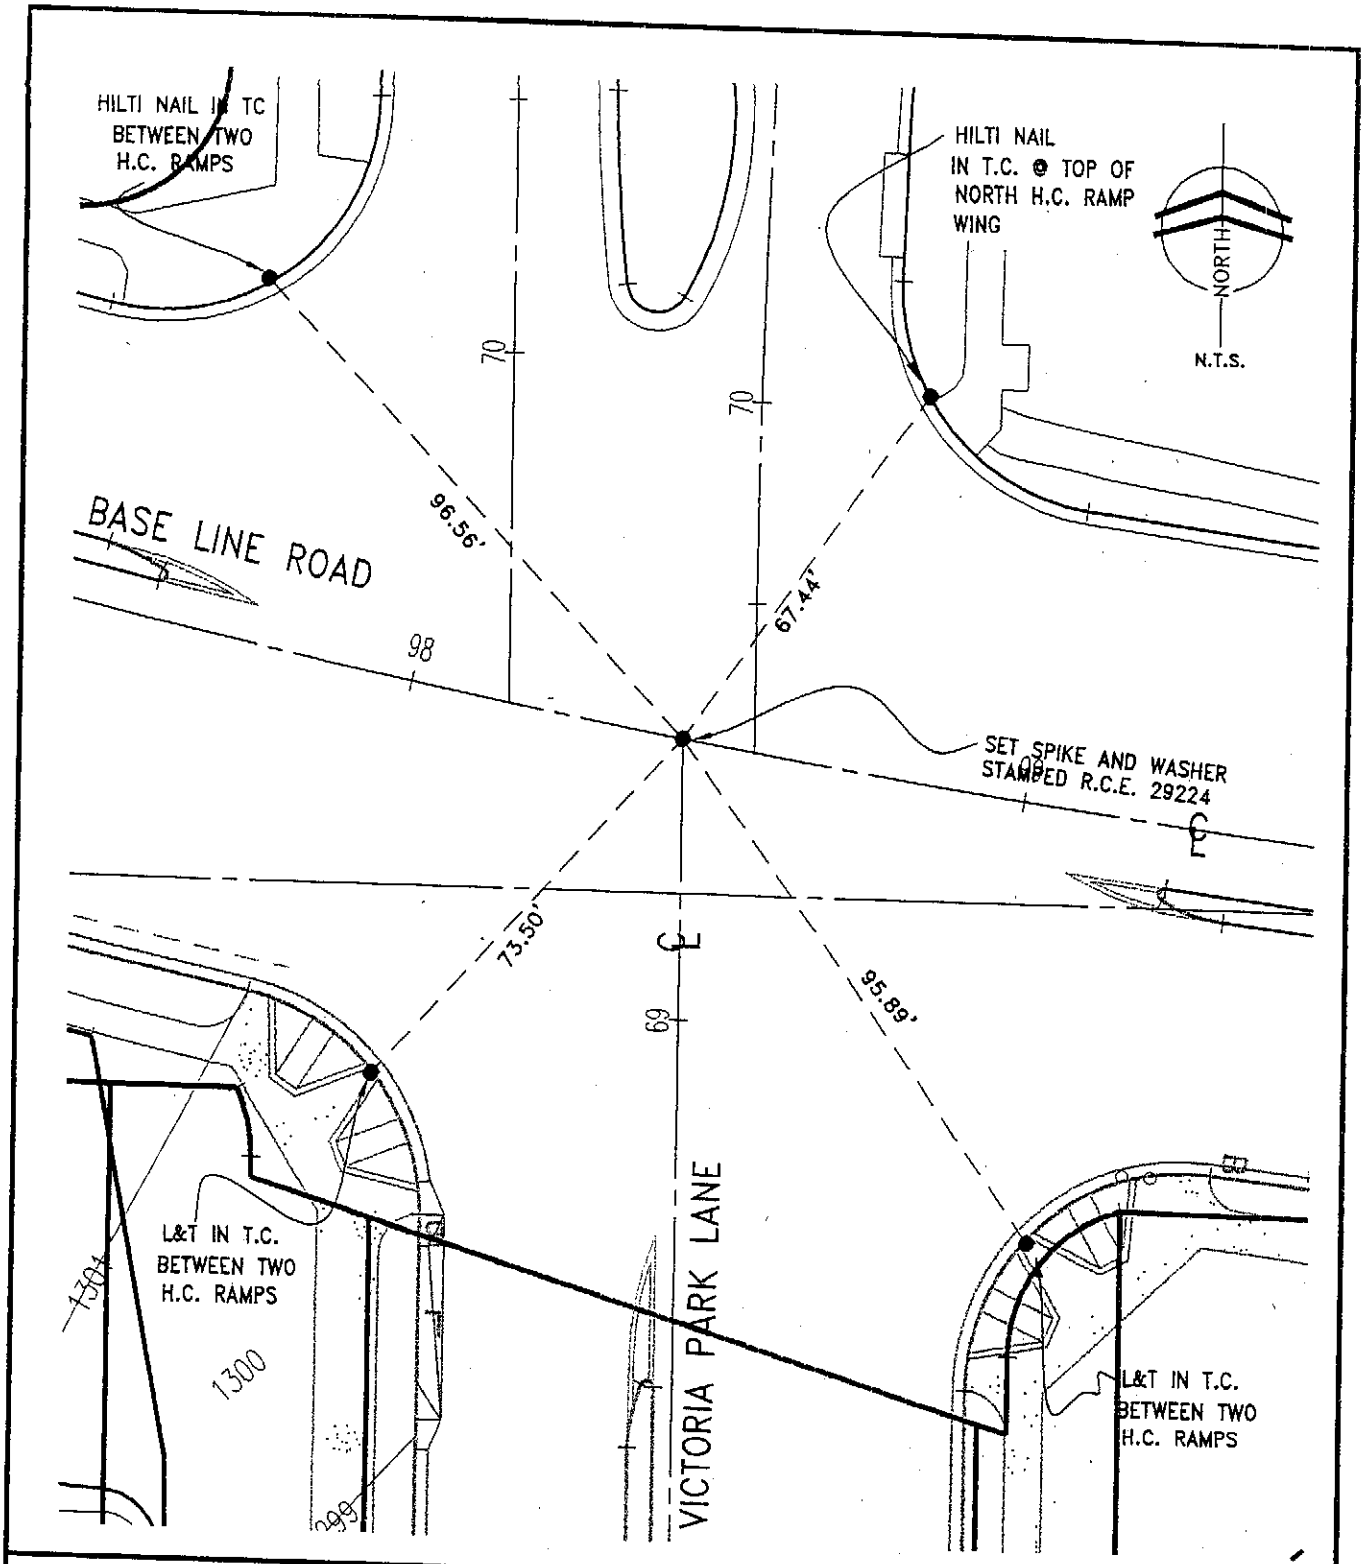

CITY OF RANCHO CUCAMONGA STREET TIES	PM 15641 PMB 192/93-100
Dan Guerra & Associates 10271-B TRADEMARK STREET RANCHO CUCAMONGA, CA 91730 (909) 987-4306 CIVIL ENGINEERS • LAND SURVEYORS	CENTERLINE INTERSECTION VICTORIA PARK LANE AND BASE LINE ROAD
ENGINEER: DANIEL E. GUERRA	FIELD REVIEW: [illegible] DATE: 2-28-05
R.C.E. No. 29224	TIE BOOK: 24 PAGE: 86

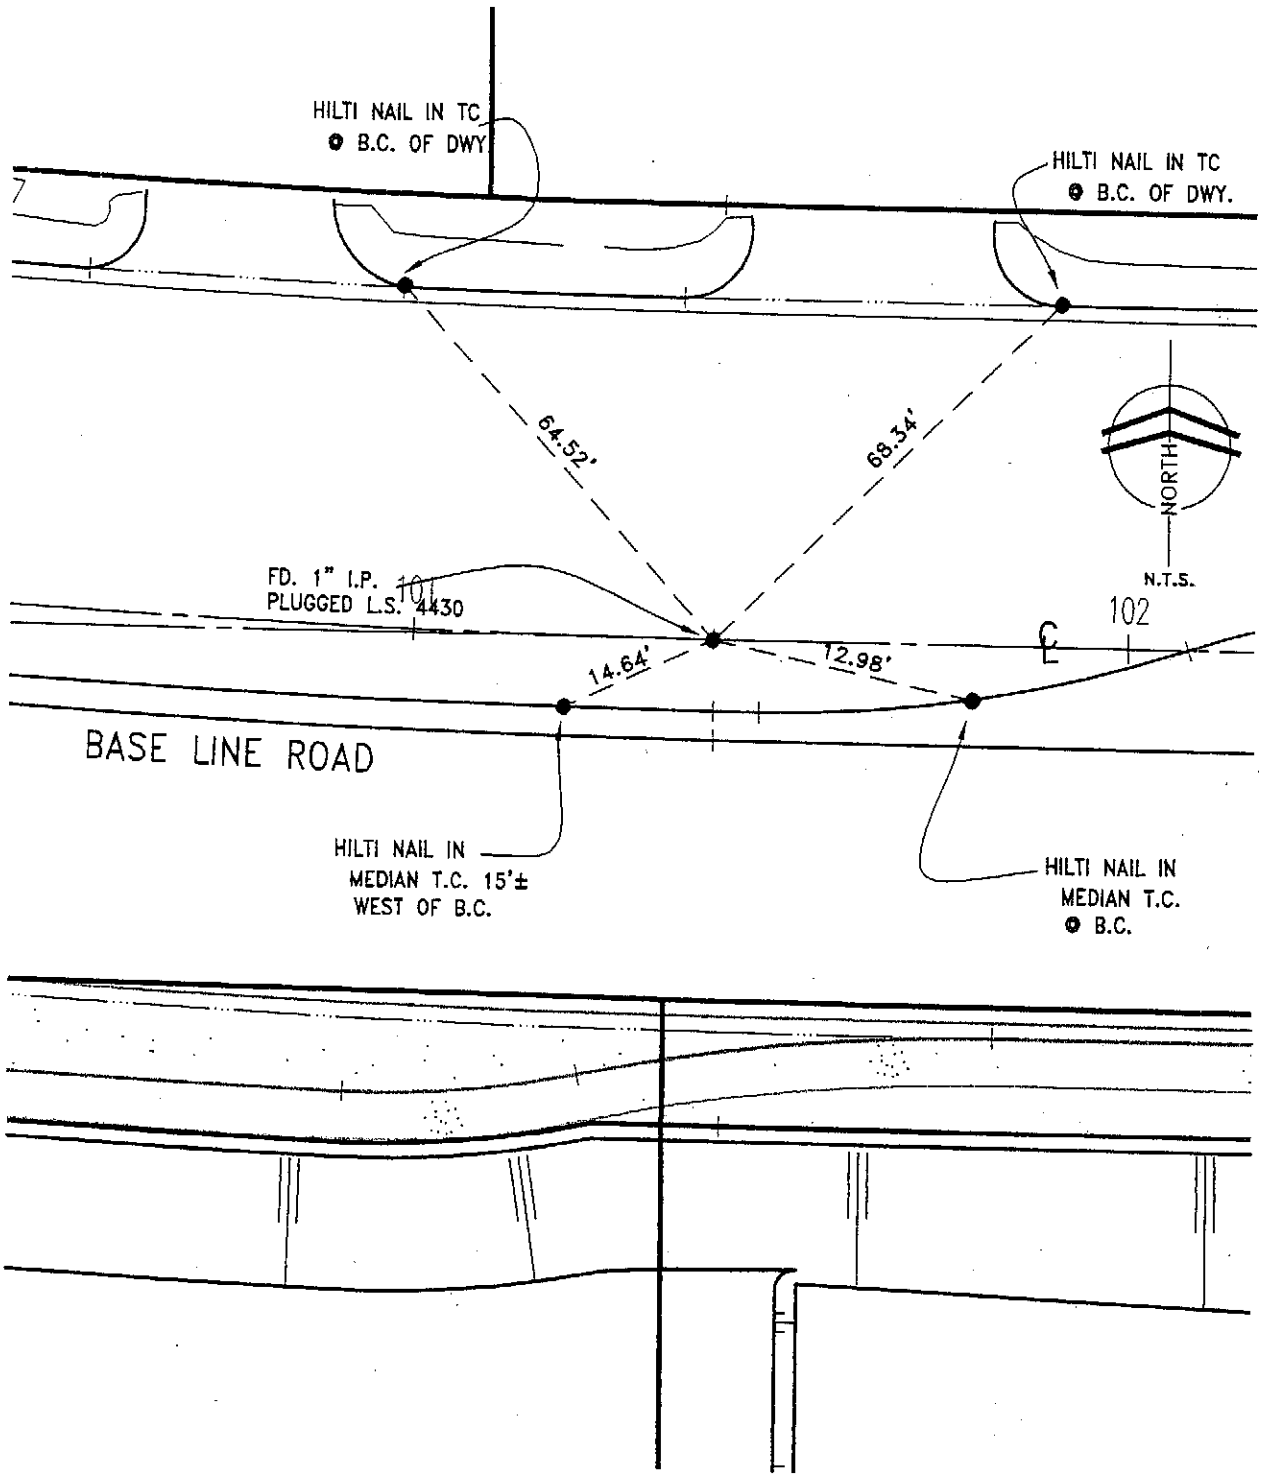

CITY OF RANCHO CUCAMONGA STREET TIES	PM 15641 PMB 192/93-100
Dan Guerra & Associates 10271-B TRADEMARK STREET RANCHO CUCAMONGA, CA 91730 (909) 987-4306 CIVIL ENGINEERS • LAND SURVEYORS	CENTERLINE BASE LINE ROAD JUST EAST OF VICTORIA PARK LANE FD. 1" I.P. (LS 4430), IN LIEU OF 1" I.P. (LS 4030) PER TRACT NO. 15947, M.B. 279/34-35
ENGINEER: DANIEL E. GUERRA	FIELD REVIEW: [illegible] DATE: 2-28-05
R.C.E. No. 29224	TIE BOOK: 24 PAGE: 87

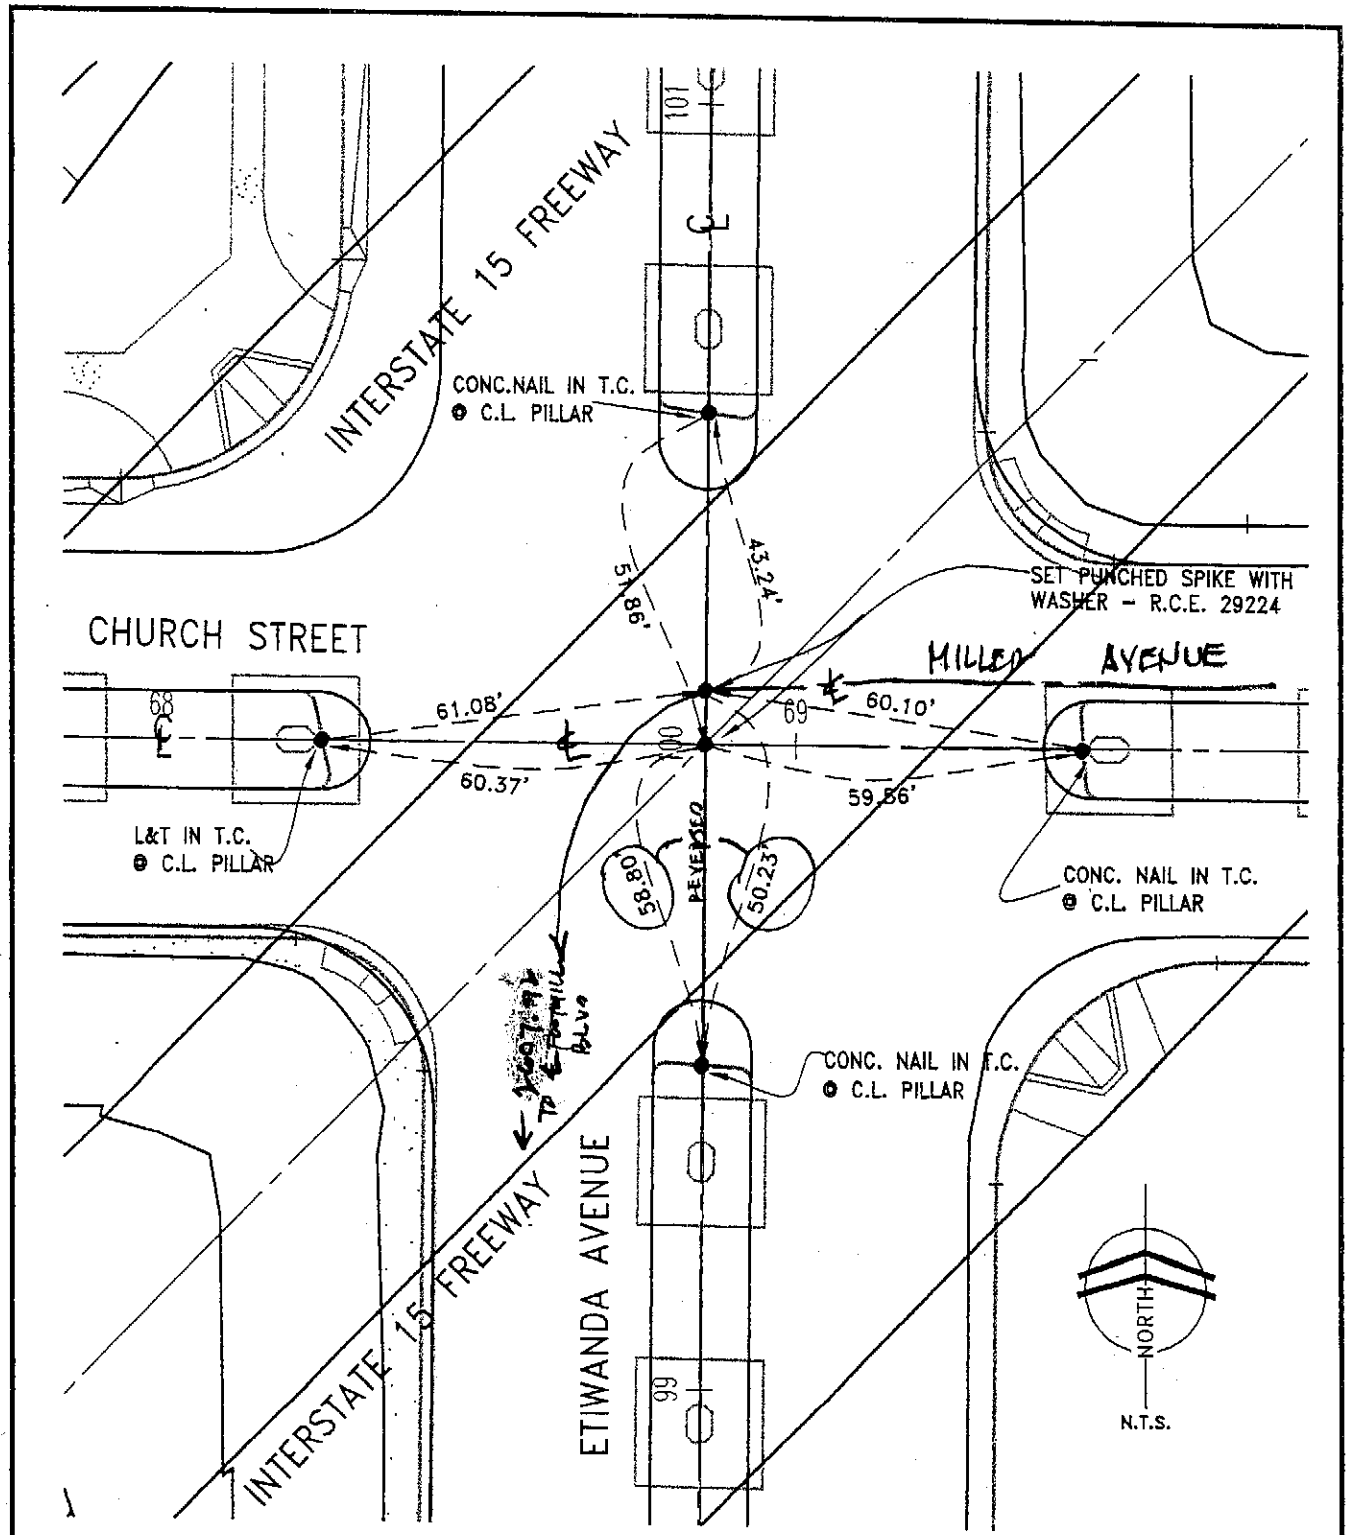

CITY OF RANCHO CUCAMONGA STREET TIES	PM 15641 PMB 192/93-100
Dan Guerra & Associates 10271-B TRADEMARK STREET RANCHO CUCAMONGA, CA 91730 (909) 987-4306 CIVIL ENGINEERS • LAND SURVEYORS	SOUTHERLY MONUMENT CENTERLINE INTERSECTION ETIWANDA AVENUE AND CHURCH STREET NORTHERLY MONUMENT CENTERLINE INTERSECTION MILLER AVENUE AND ETIWANDA AVENUE
ENGINEER: DANIEL E. GUERRA	FIELD REVIEW: MDA DATE: 2-28-05
R.C.E. No. 29224	TIE BOOK: 24 PAGE: 88

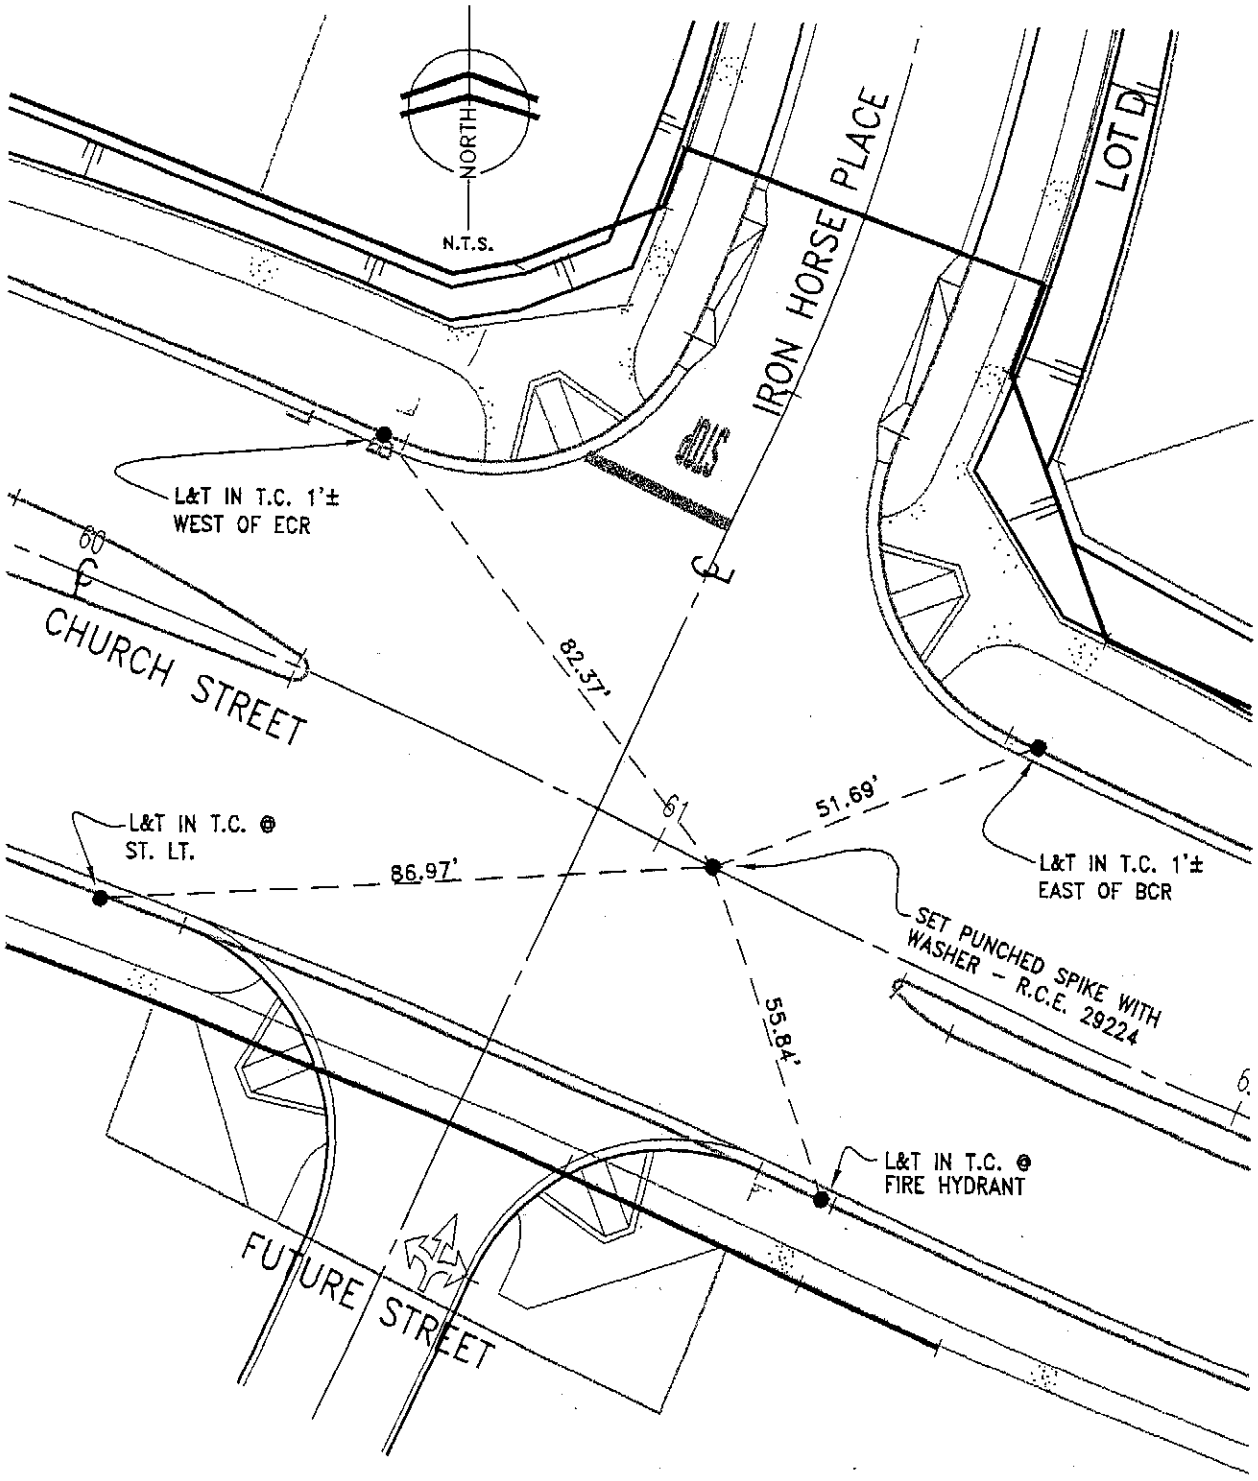

CITY OF RANCHO CUCAMONGA STREET TIES	PM 15641 PMB 192/93-100
Dan Guerra & Associates 10271-B TRADEMARK STREET RANCHO CUCAMONGA, CA 91730 (909) 987-4306 CIVIL ENGINEERS • LAND SURVEYORS	CENTERLINE CHURCH STREET P.R.C. JUST EAST OF CENTERLINE INTERSECTION CHURCH STREET AND IRON HORSE PLACE
ENGINEER: DANIEL E. GUERRA	FIELD REVIEW: MCS DATE: 2-28-05
R.C.E. No. 29224	TIE BOOK: 24 PAGE: 89

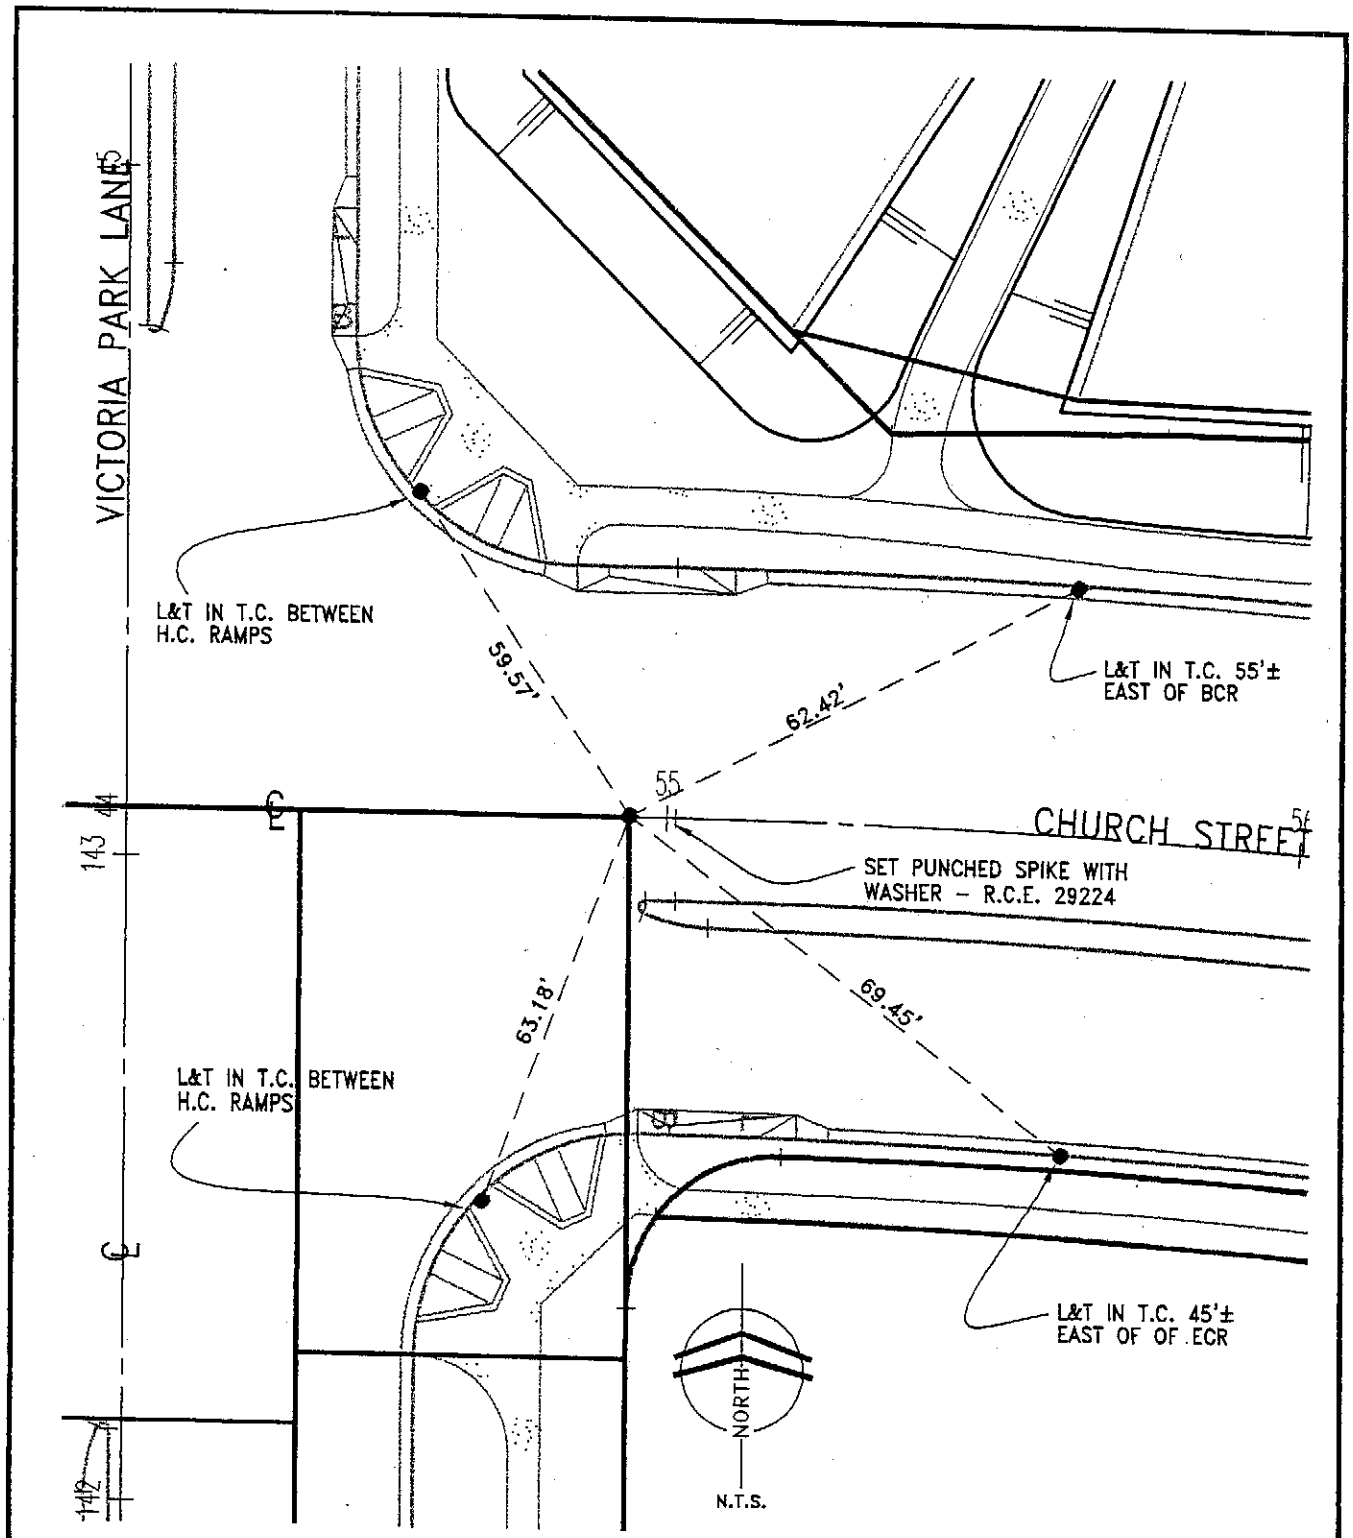

CITY OF RANCHO CUCAMONGA STREET TIES	PM 15641 PMB 192/93-100
Dan Guerra & Associates 10271-B TRADEMARK STREET RANCHO CUCAMONGA, CA 91730 (909) 987-4306 CIVIL ENGINEERS • LAND SURVEYORS	CENTERLINE CHURCH STREET B.C., JUST EAST OF INTERSECTION OF CHURCH STREET AND VICTORIA PARK LANE
ENGINEER: DANIEL E. GUERRA	FIELD REVIEW: MDA DATE: 2-20-05
R.C.E. No. 29224	TIE BOOK: 24 PAGE: 90

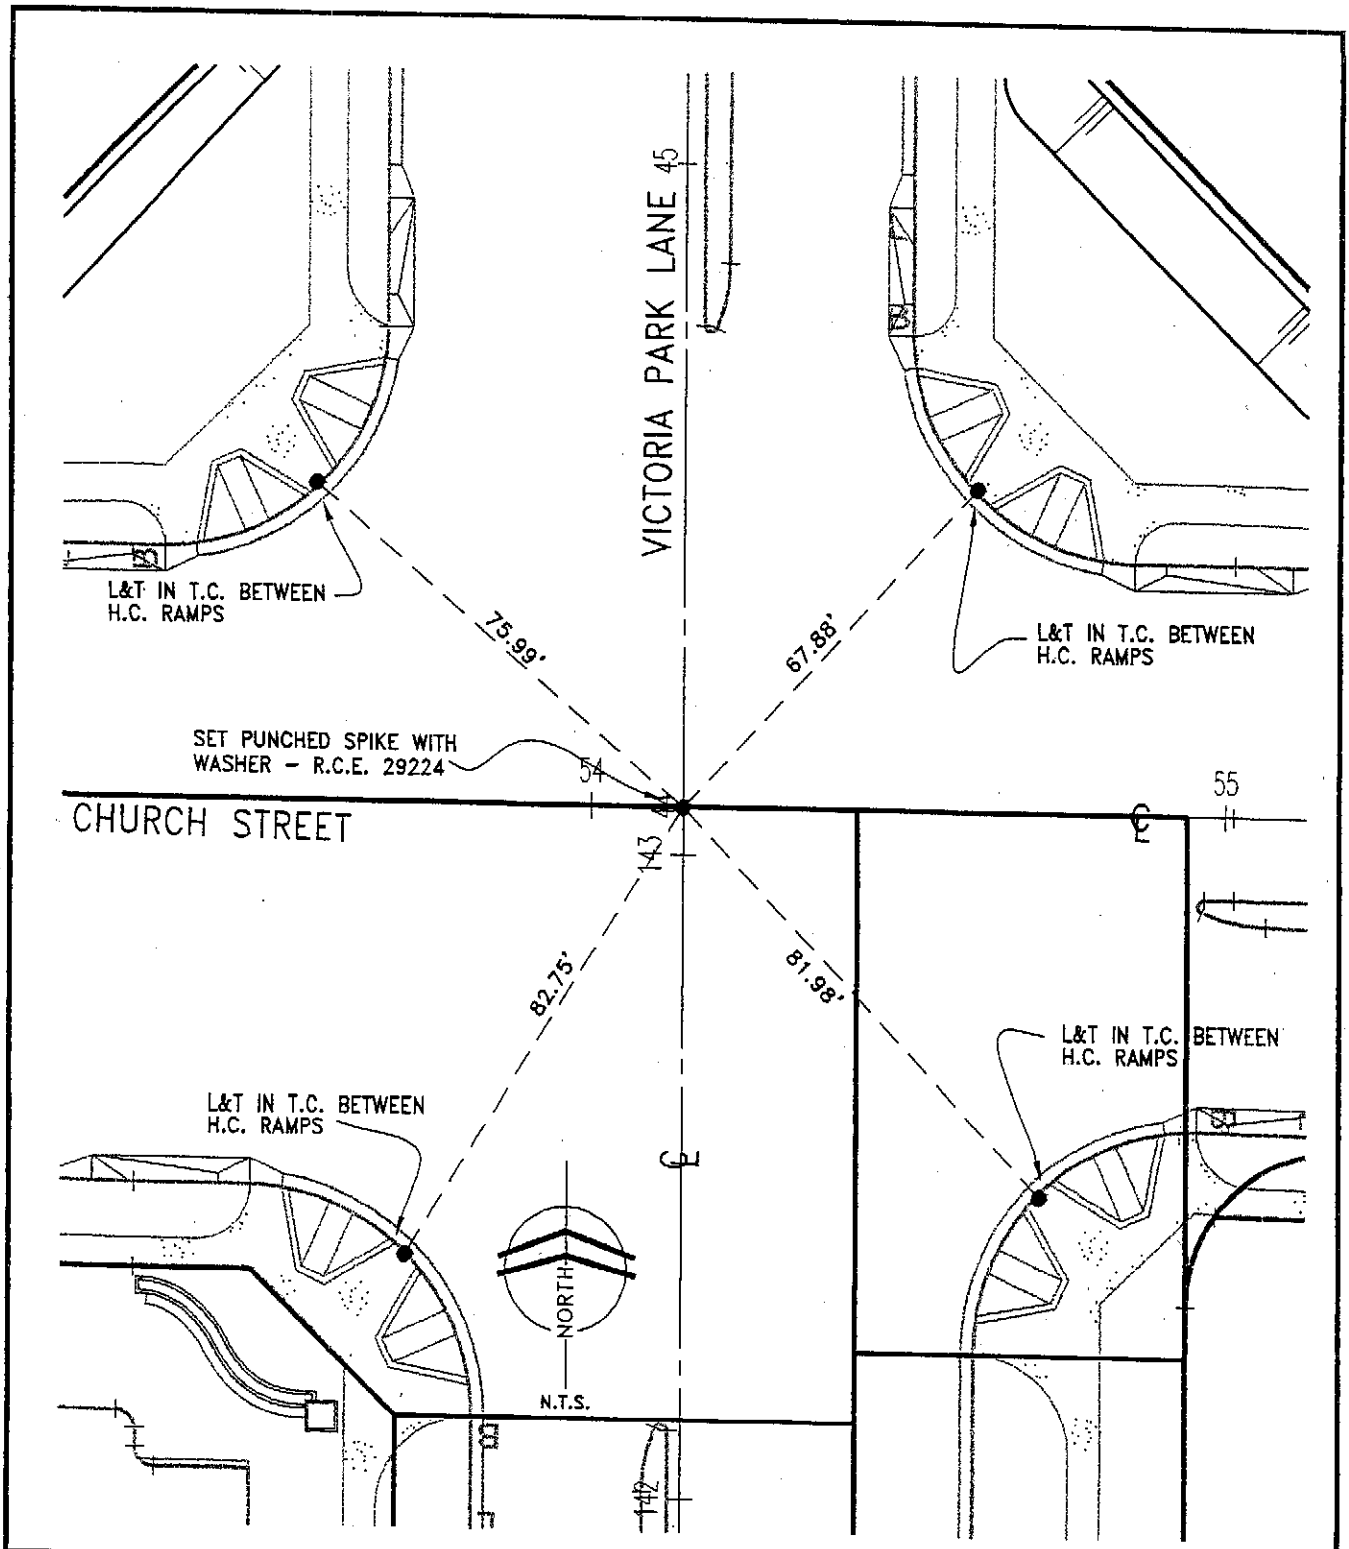

CITY OF RANCHO CUCAMONGA STREET TIES	PM 15641 PMB 192/93-100
Dan Guerra & Associates 10271-B TRADEMARK STREET RANCHO CUCAMONGA, CA 91730 (909) 987-4306 CIVIL ENGINEERS • LAND SURVEYORS	CENTERLINE INTERSECTION CHURCH STREET AND VICTORIA PARK LANE
ENGINEER: DANIEL E. GUERRA	FIELD REVIEW: MDA DATE: 2-28-05
R.C.E. No. 29224	TIE BOOK: 24 PAGE: 91

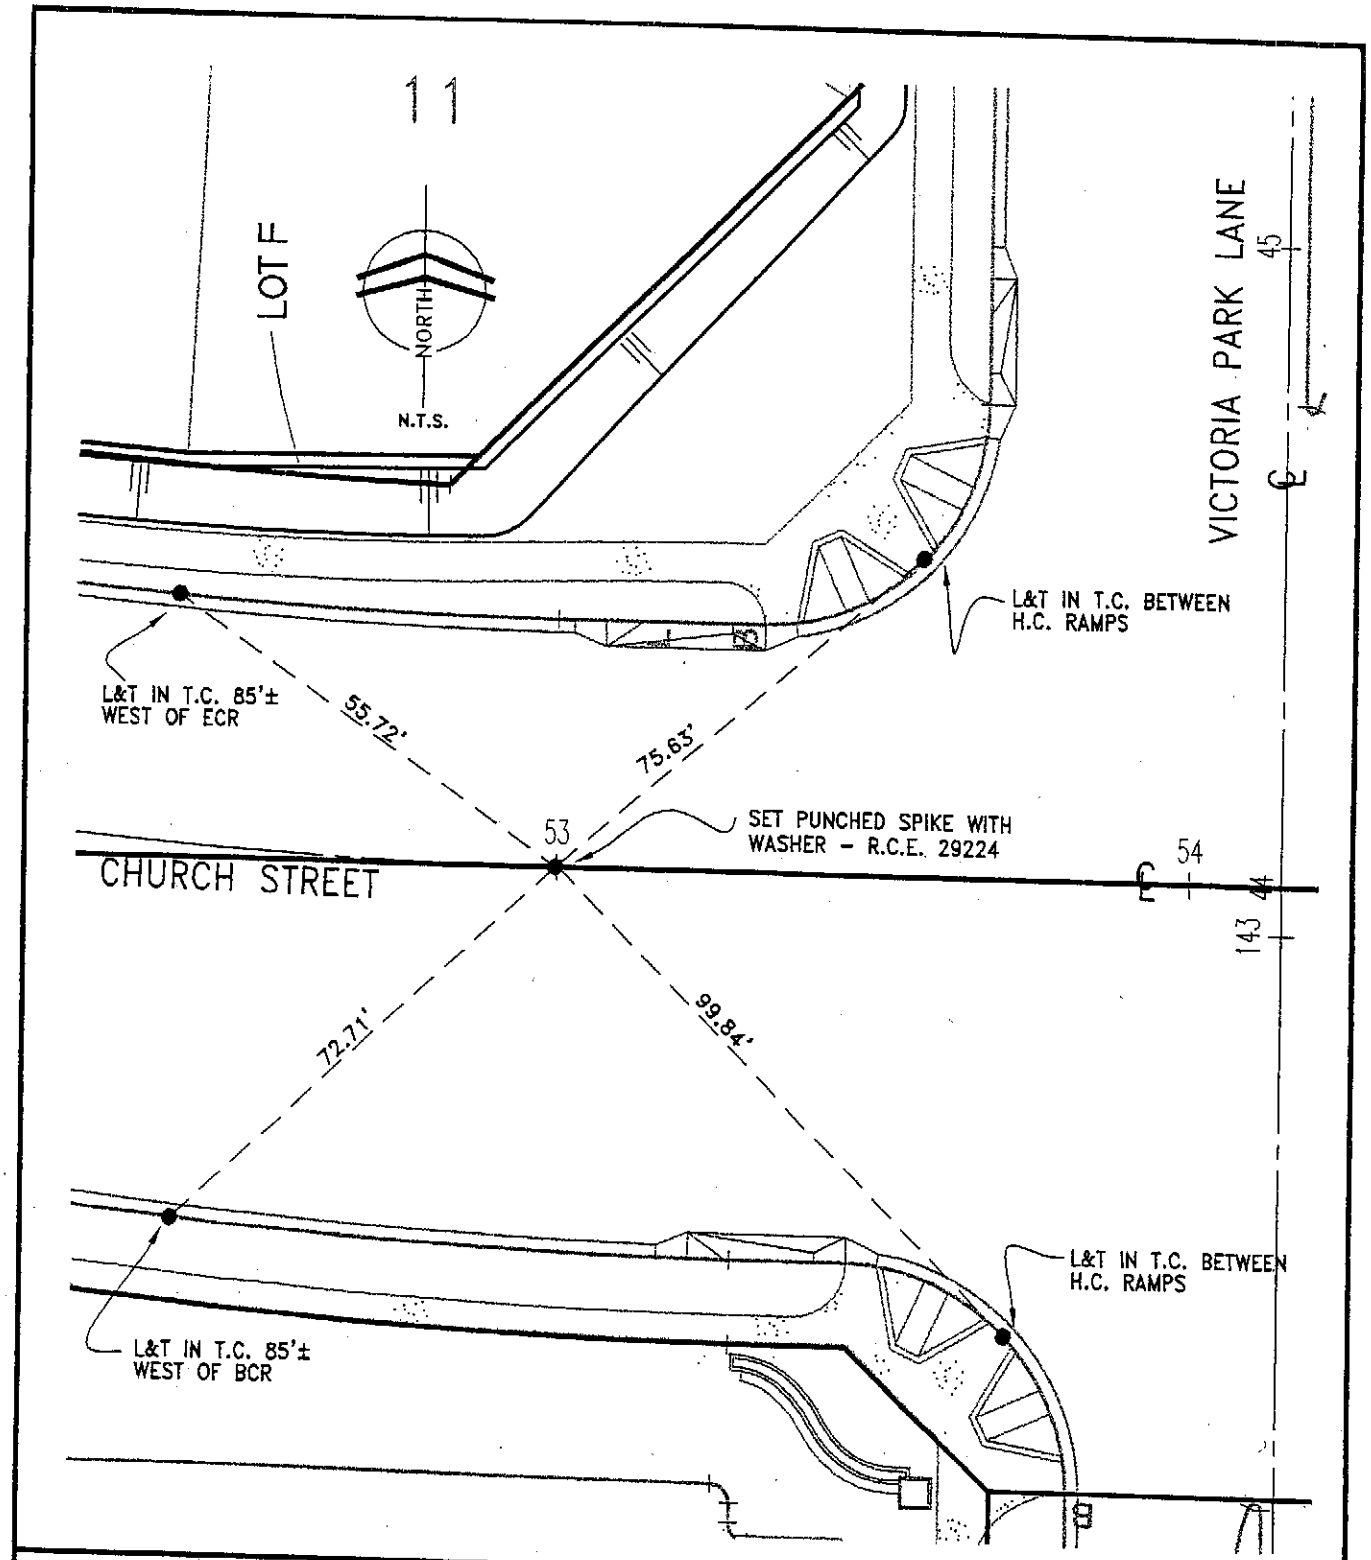

CITY OF RANCHO CUCAMONGA STREET TIES	PM 15641 PMB 192/93-100
Dan Guerra & Associates 10271-B TRADEMARK STREET RANCHO CUCAMONGA, CA 91730 (909) 987-4306 CIVIL ENGINEERS • LAND SURVEYORS	CENTERLINE CHURCH STREET E.C., JUST WEST OF INTERSECTION CHURCH STREET AND VICTORIA PARK LANE
ENGINEER: DANIEL E. GUERRA	FIELD REVIEW: MOA DATE: 2-28-05
R.C.E. No. 29224	TIE BOOK: 24 PAGE: 92

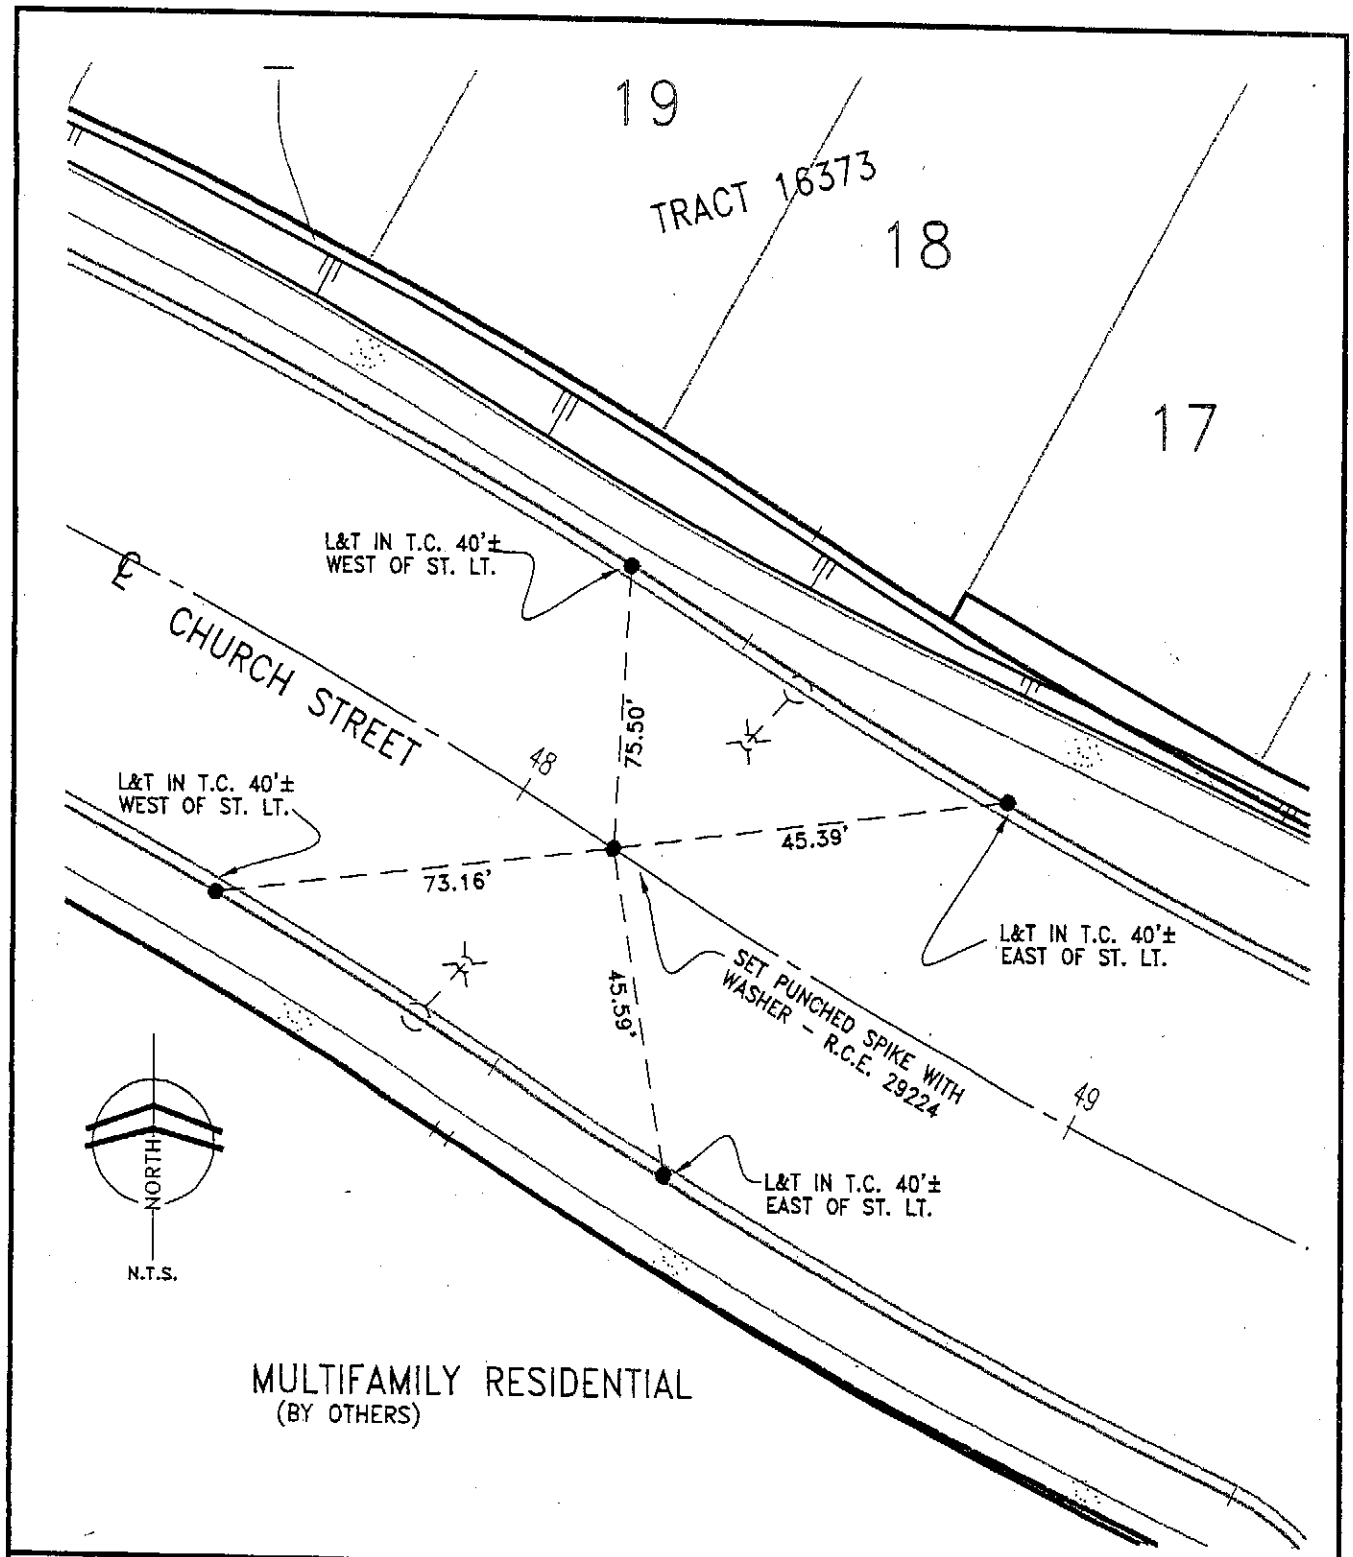

CITY OF RANCHO CUCAMONGA STREET TIES	PM 15641 PMB 192/93-100
Dan Guerra & Associates 10271-B TRADEMARK STREET RANCHO CUCAMONGA, CA 91730 (909) 987-4306 CIVIL ENGINEERS • LAND SURVEYORS	CENTERLINE CHURCH STREET P.R.C., JUST WEST OF INTERSECTION OF CHURCH STREET AND PAVILION GARDENS PLACE
ENGINEER: DANIEL E. GUERRA	FIELD REVIEW: MA DATE: 2-28-05
R.C.E. No. 29224	TIE BOOK: 24 PAGE: 93

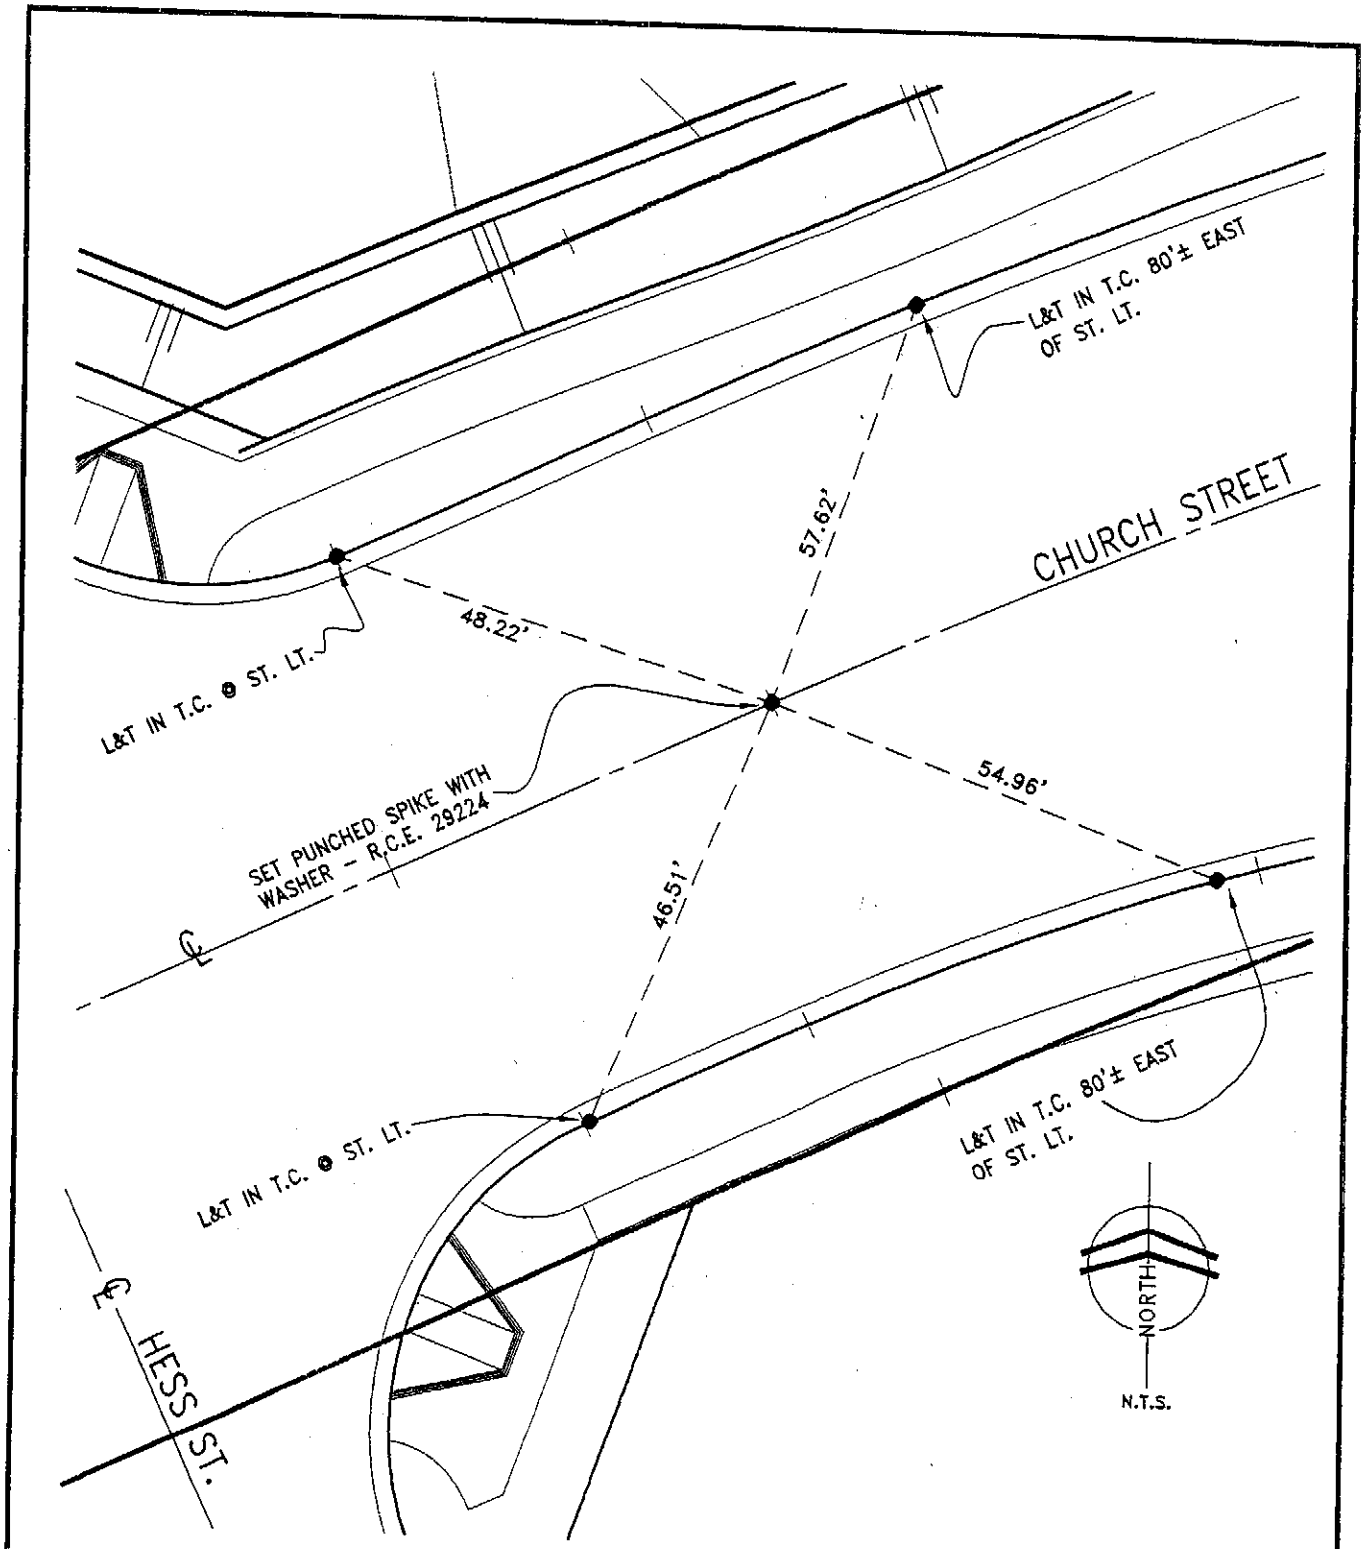

CITY OF RANCHO CUCAMONGA STREET TIES	PM 15641 PMB 192/93-100
Dan Guerra & Associates 10271-B TRADEMARK STREET RANCHO CUCAMONGA, CA 91730 (909) 987-4306 CIVIL ENGINEERS • LAND SURVEYORS	CENTERLINE CHURCH STREET B.C., JUST EAST OF CENTERLINE INTERSECTION CHURCH STREET AND HESS PLACE
ENGINEER: DANIEL E. GUERRA	FIELD REVIEW: MA DATE: 2-28-05
R.C.E. No. 29224	TIE BOOK: 24 PAGE: 97

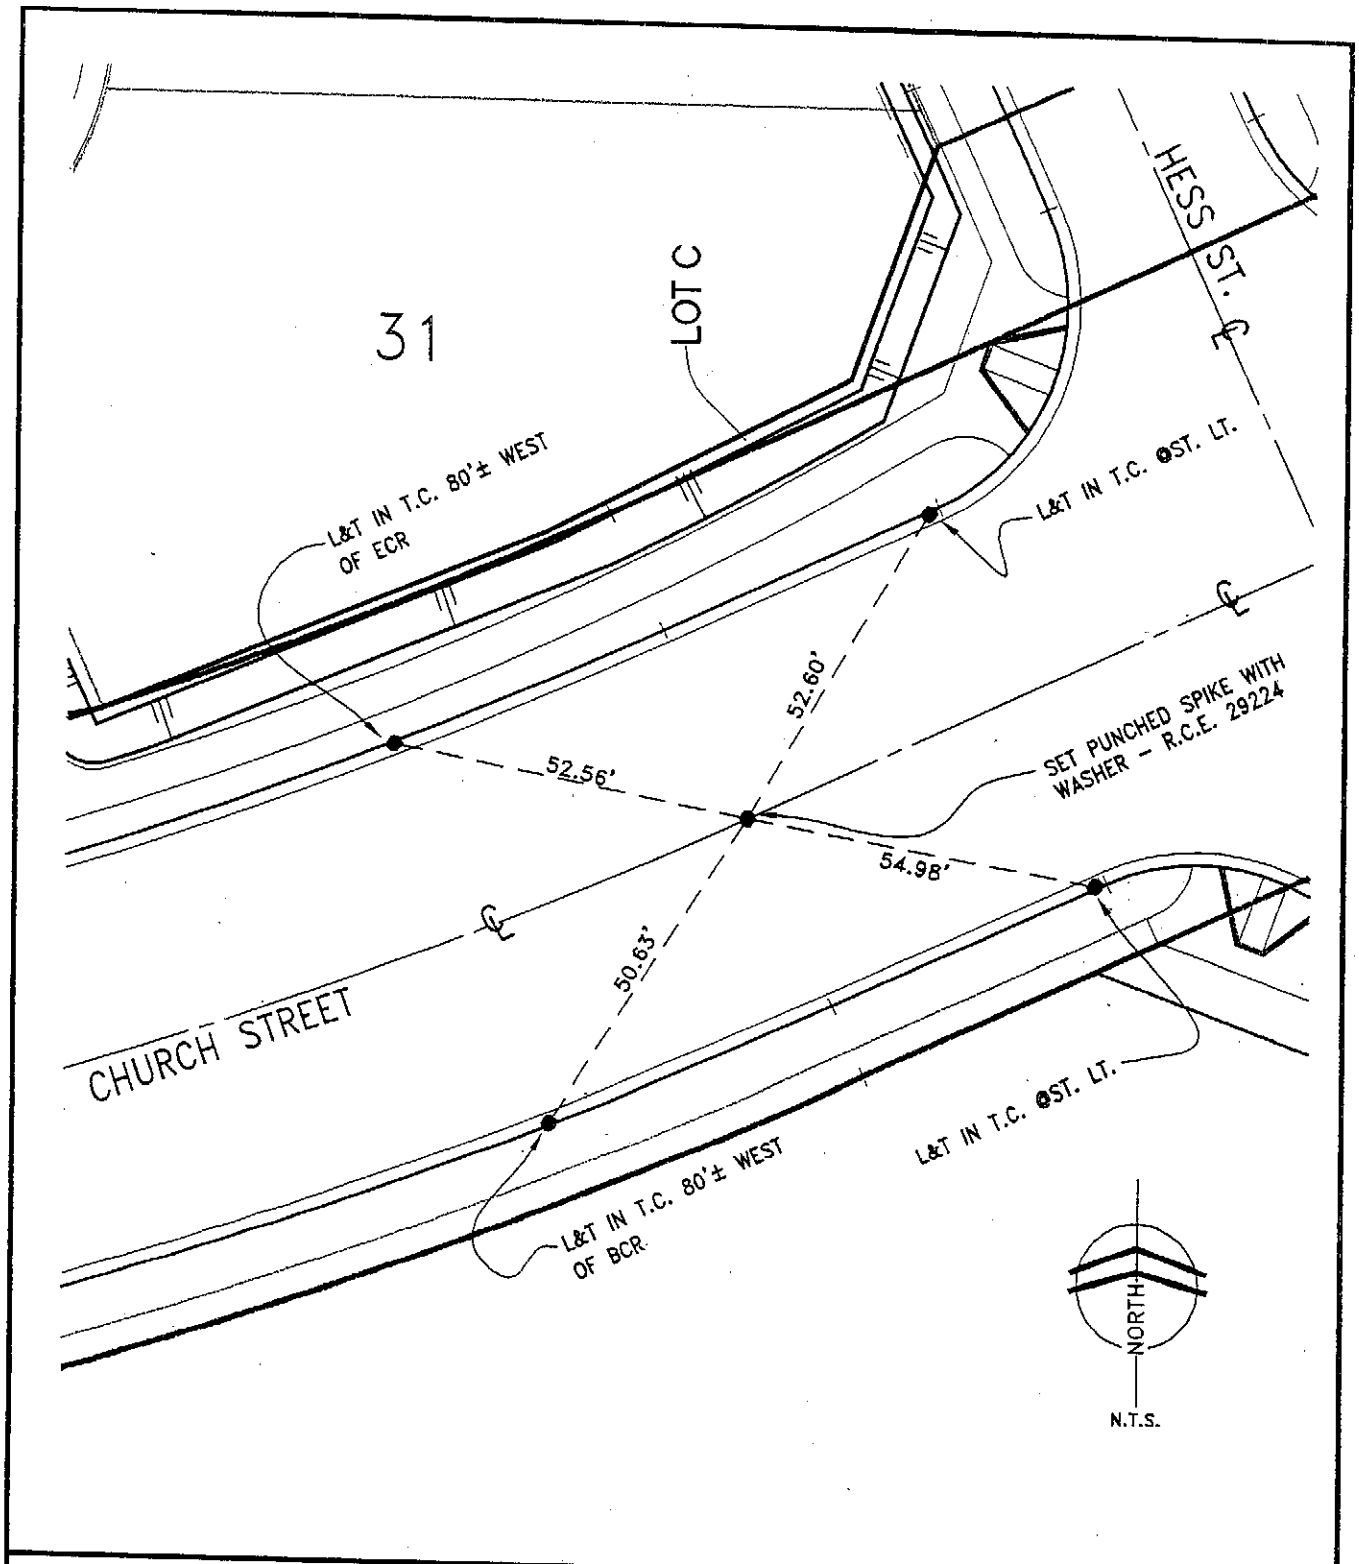

CITY OF RANCHO CUCAMONGA STREET TIES	PM 15641 PMB 192/93-100
Dan Guerra & Associates 10271-B TRADEMARK STREET RANCHO CUCAMONGA, CA 91730 (909) 987-4306 CIVIL ENGINEERS • LAND SURVEYORS	CENTERLINE CHURCH STREET E.C., JUST WEST OF HESS PLACE
ENGINEER: DANIEL E. GUERRA	FIELD REVIEW: MC DATE: 2-28-05
R.C.E. No. 29224	TIE BOOK: 24 PAGE: 98

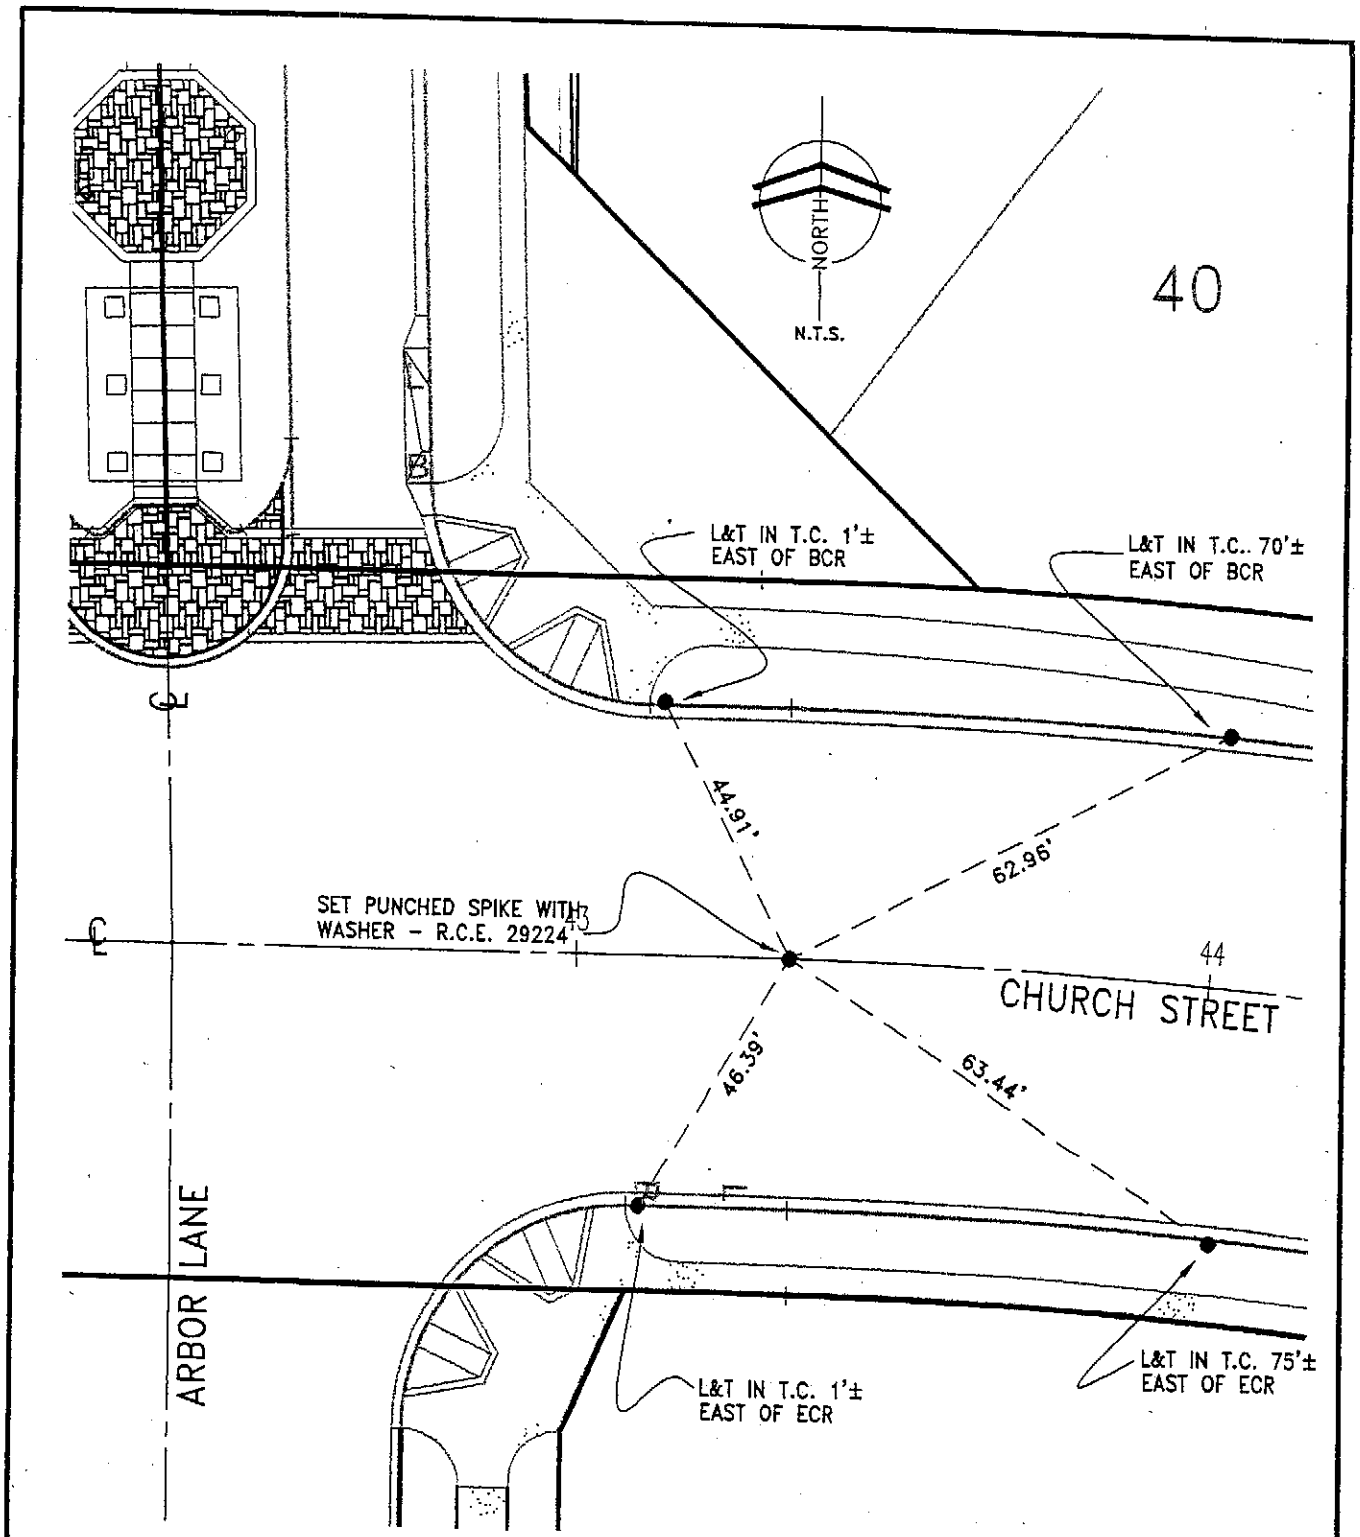

CITY OF RANCHO CUCAMONGA STREET TIES	PM 15641 PMB 192/93-100
Dan Guerra & Associates 10271-B TRADEMARK STREET RANCHO CUCAMONGA, CA 91730 (909) 987-4306 CIVIL ENGINEERS • LAND SURVEYORS	CENTERLINE CHURCH STREET B.C. JUST EAST OF CENTERLINE INTERSECTION CHURCH STREET AND ARBOR LANE
ENGINEER: DANIEL E. GUERRA	FIELD REVIEW: [illegible] DATE: 2-28-05
R.C.E. No. 29224	TIE BOOK: 24 PAGE: 94

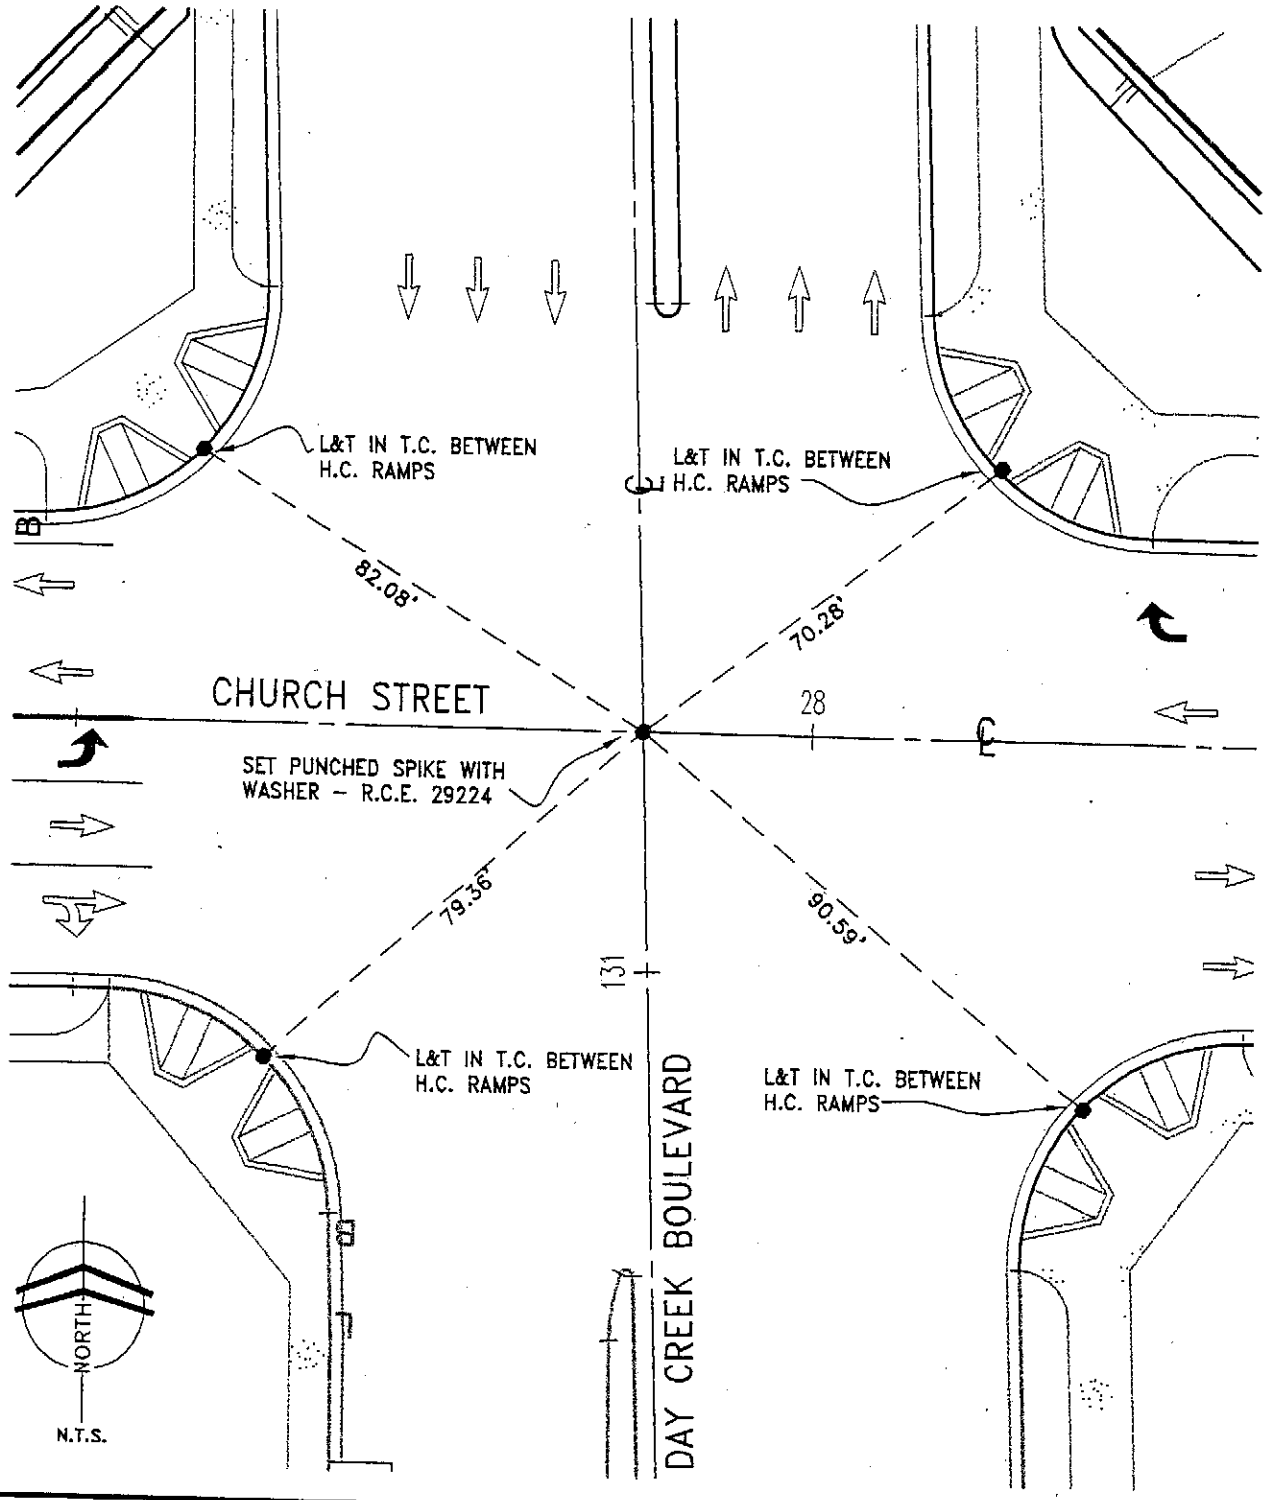

CITY OF RANCHO CUCAMONGA STREET TIES	PM 15641 PMB 192/93-100
Dan Guerra & Associates 10271-B TRADEMARK STREET RANCHO CUCAMONGA, CA 91730 (909) 987-4306 CIVIL ENGINEERS • LAND SURVEYORS	CENTERLINE INTERSECTION CHURCH STREET AND DAY CREEK BOULEVARD
ENGINEER: DANIEL E. GUERRA	FIELD REVIEW: [illegible] DATE: 2-28-05
R.C.E. No. 29224	TIE BOOK: 24 PAGE: 95

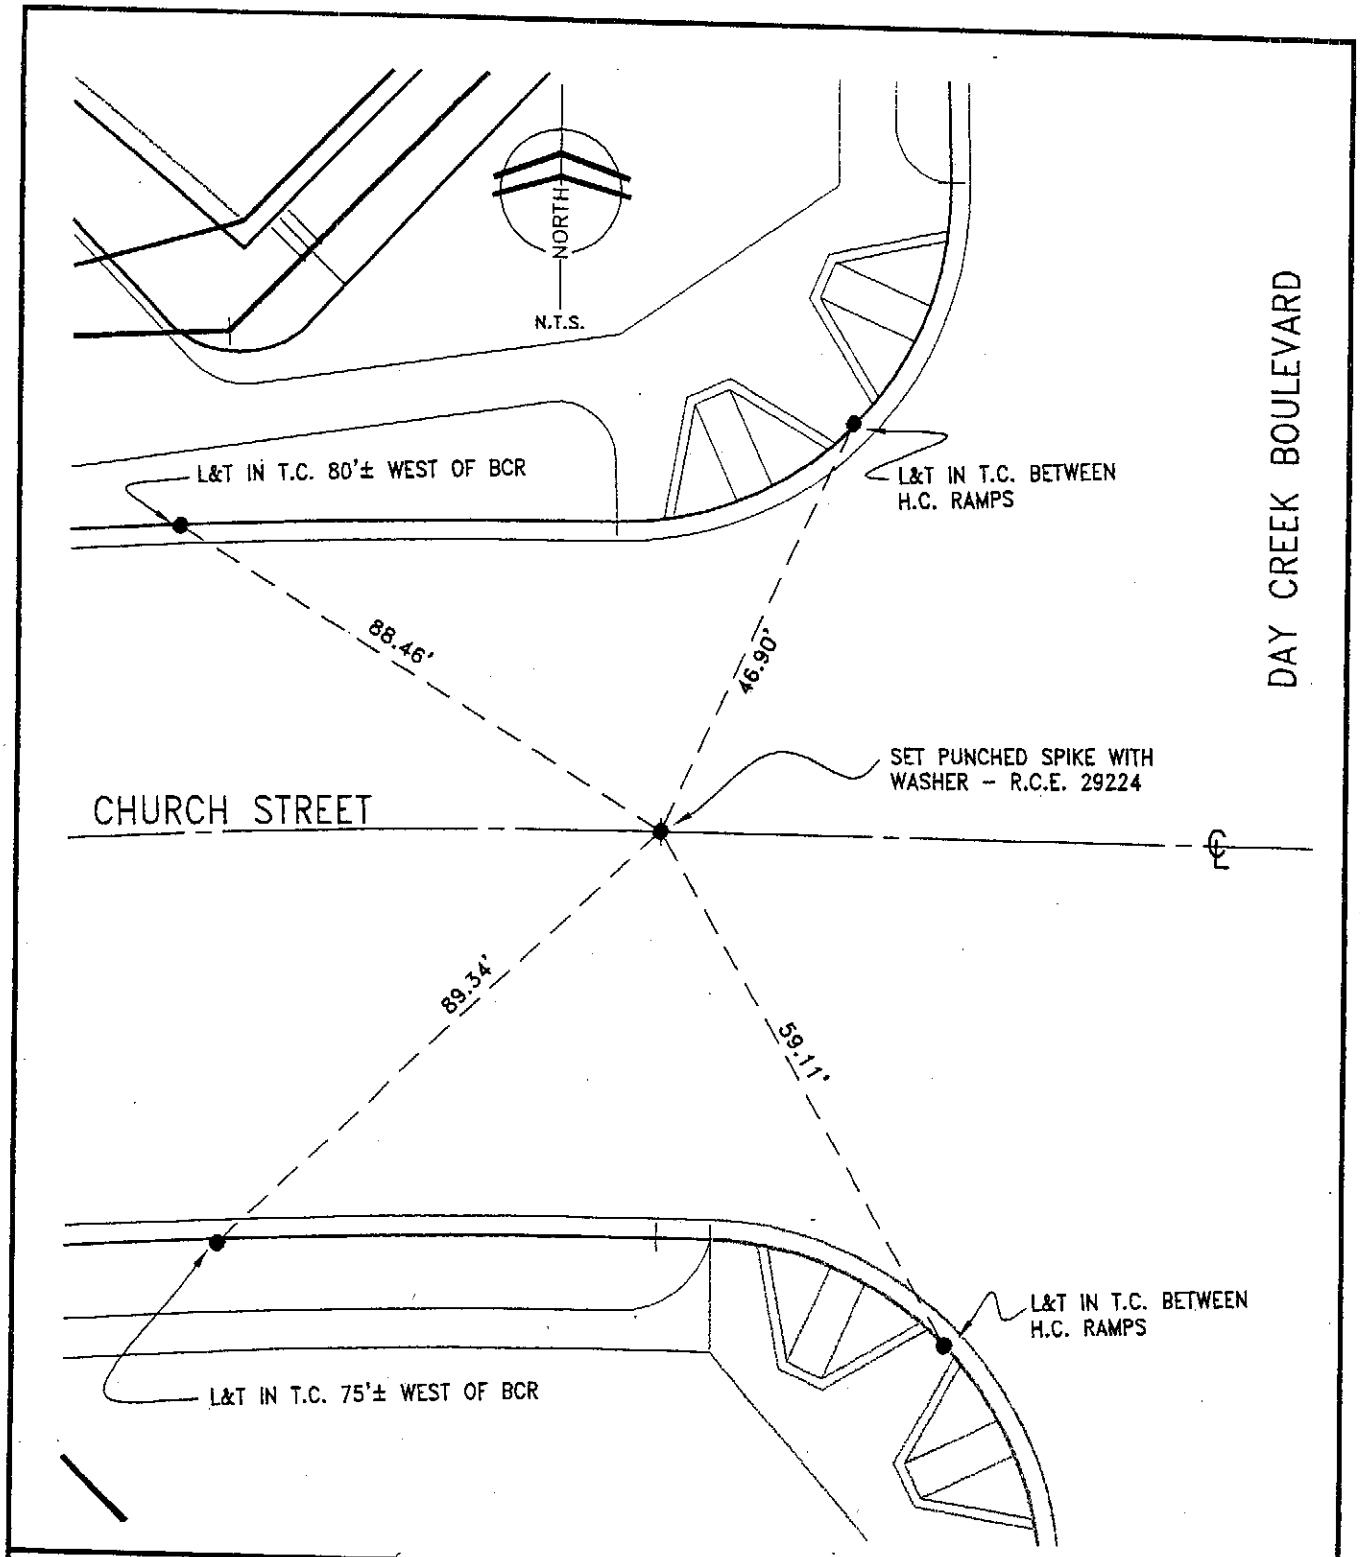

CITY OF RANCHO CUCAMONGA STREET TIES	PM 15641 PMB 192/93-100
Dan Guerra & Associates 10271-B TRADEMARK STREET RANCHO CUCAMONGA, CA 91730 (909) 987-4306 CIVIL ENGINEERS • LAND SURVEYORS	CENTERLINE CHURCH STREET E.C. JUST WEST OF CENTERLINE INTERSECTION CHURCH STREET AND DAY CREEK BOULEVARD
ENGINEER: DANIEL E. GUERRA	FIELD REVIEW: MOS DATE: 2-28-05
R.C.E. No. 29224	TIE BOOK: 24 PAGE: 96

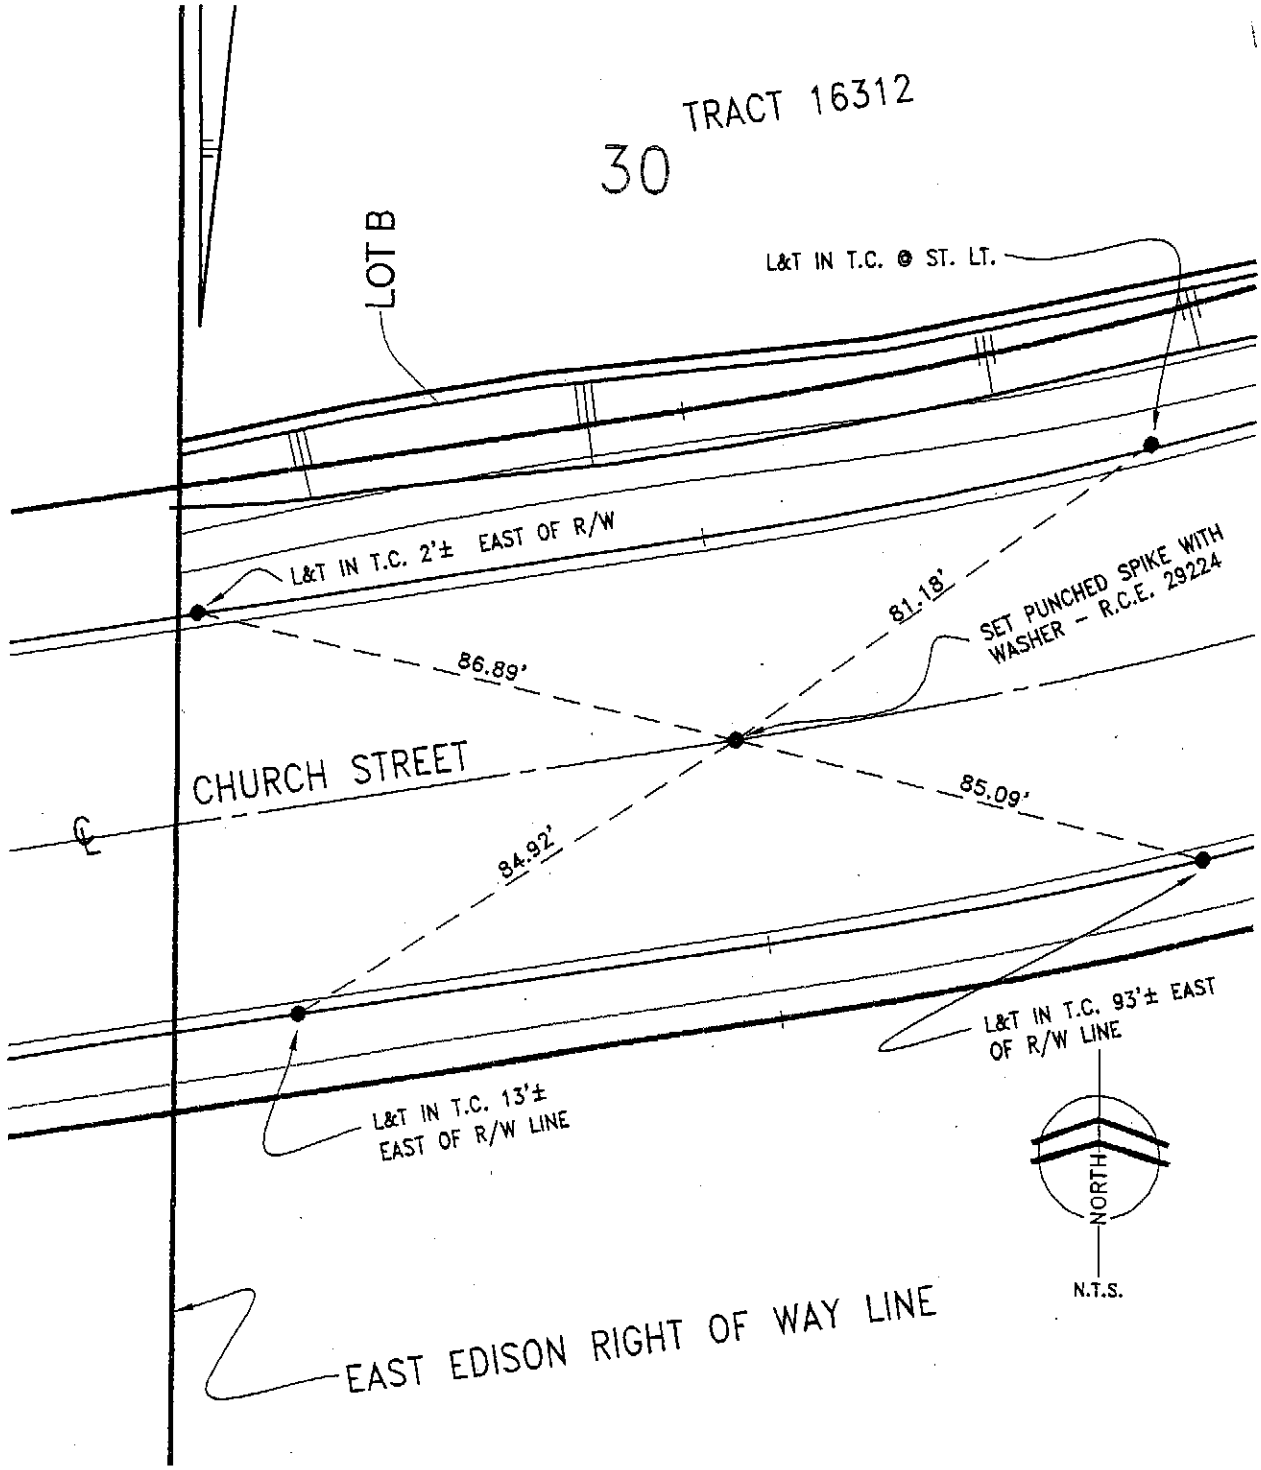

CITY OF RANCHO CUCAMONGA STREET TIES	PM 15641 PMB 192/93-100
Dan Guerra & Associates 10271-B TRADEMARK STREET RANCHO CUCAMONGA, CA 91730 (909) 987-4306 CIVIL ENGINEERS • LAND SURVEYORS	CENTERLINE CHURCH STREET B.C. JUST EAST OF EAST EDISON CORRIDOR RIGHT OF WAY LINE
ENGINEER: DANIEL E. GUERRA	FIELD REVIEW: [signature] DATE: 2-28-05
R.C.E. No. 29224	TIE BOOK: 24 PAGE: 99

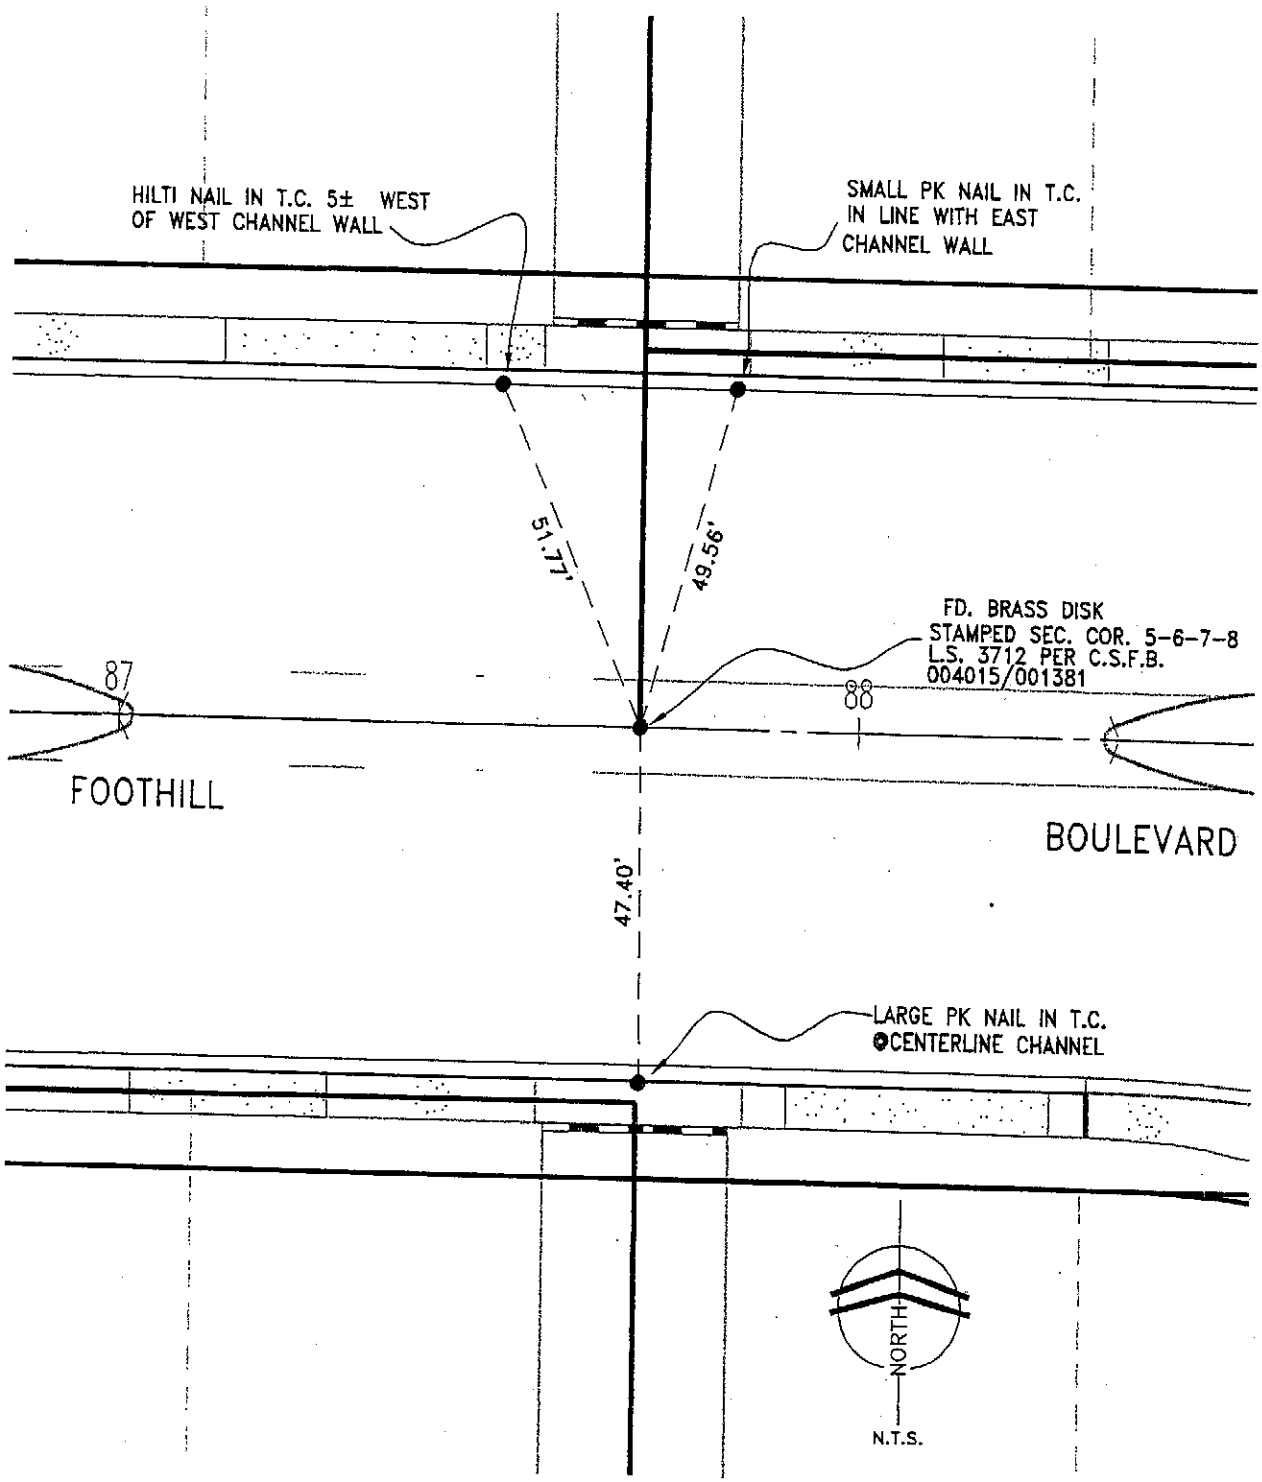

CITY OF RANCHO CUCAMONGA STREET TIES	PM 15641 PMB 192/93-100
Dan Guerra & Associates 10271-B TRADEMARK STREET RANCHO CUCAMONGA, CA 91730 (909) 987-4306 CIVIL ENGINEERS • LAND SURVEYORS	CENTERLINE FOOTHILL BOULEVARD AT CENTERLINE DAY CREEK CHANNEL
ENGINEER: DANIEL E. GUERRA	FIELD REVIEW: MDA DATE: 2-28-05
R.C.E. No. 29224	TIE BOOK: 24 PAGE: 100

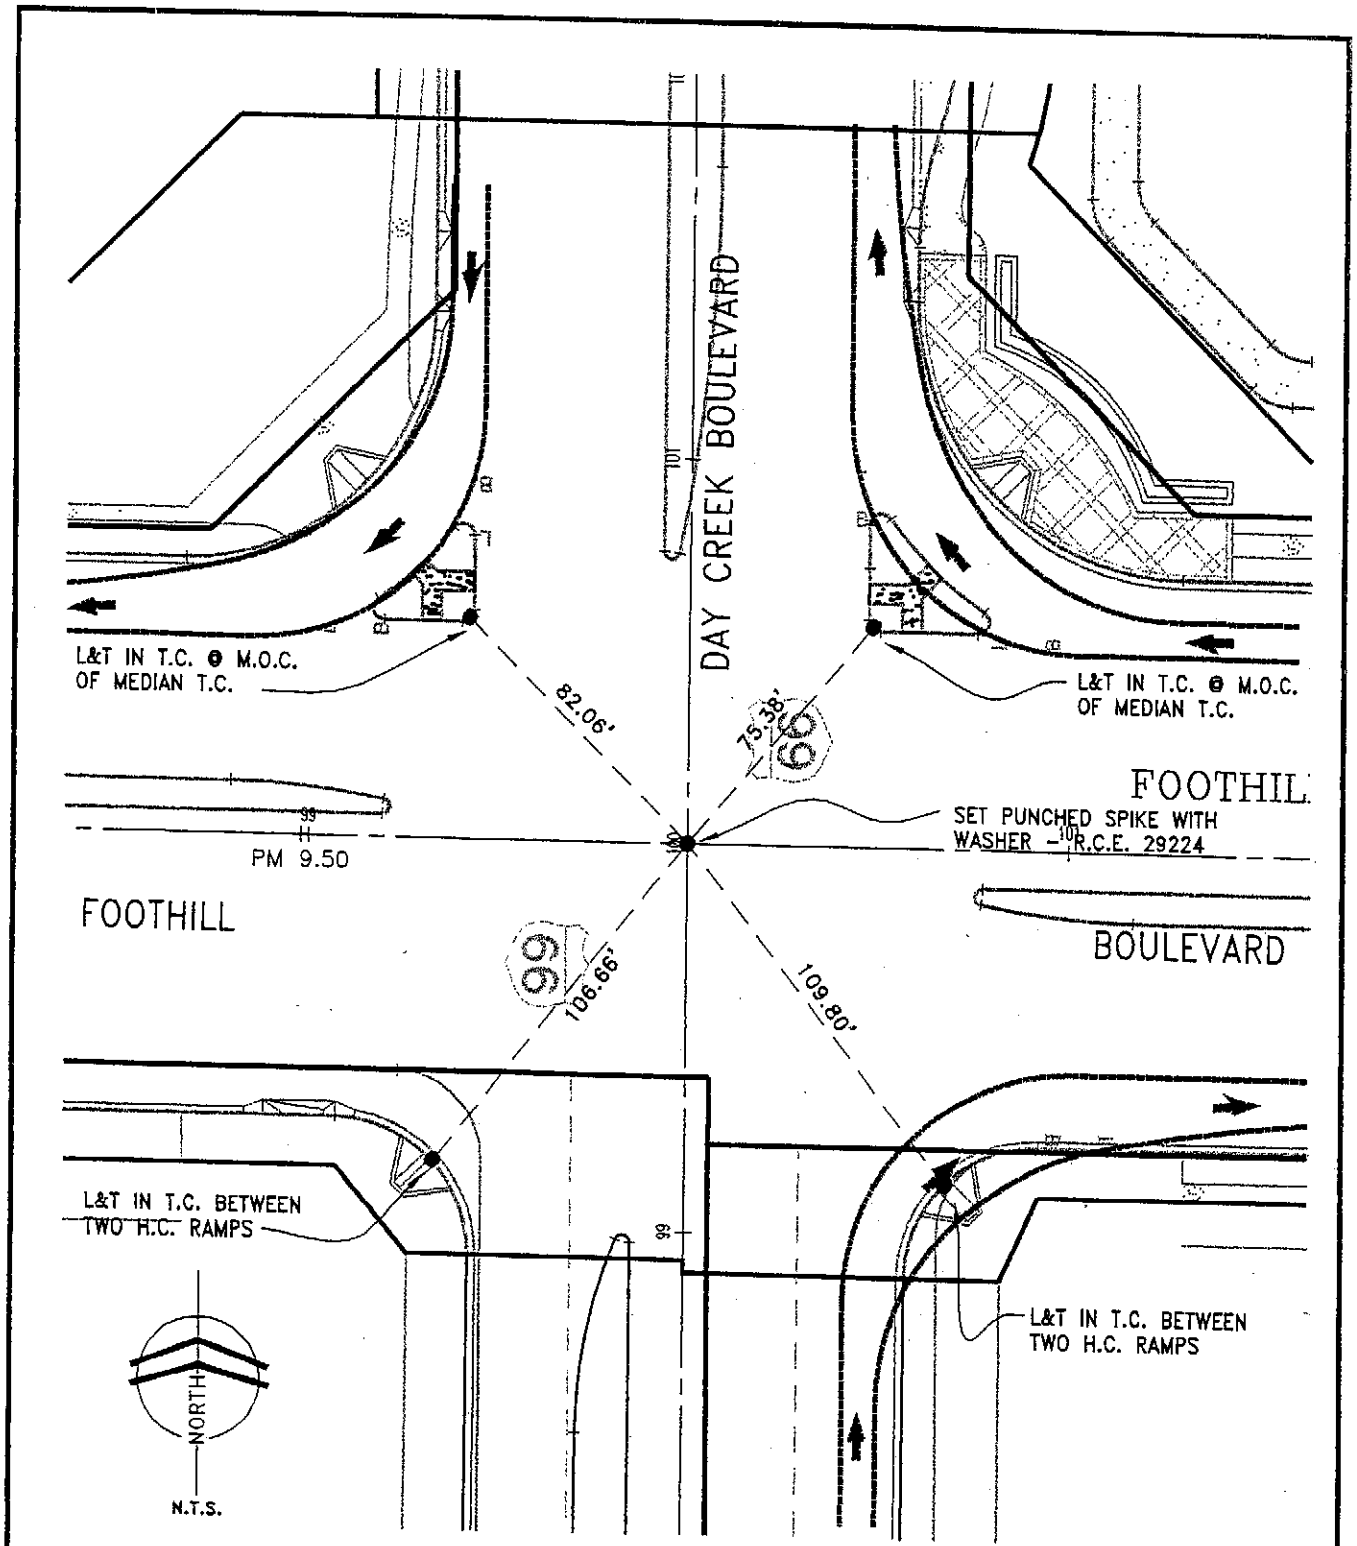

CITY OF RANCHO CUCAMONGA STREET TIES	PM 15641 PMB 192/93-100
Dan Guerra & Associates 10271-B TRADEMARK STREET RANCHO CUCAMONGA, CA 91730 (909) 987-4306 CIVIL ENGINEERS • LAND SURVEYORS	CENTERLINE INTERSECTION FOOTHILL BOULEVARD AND DAY CREEK BOULEVARD
ENGINEER: DANIEL E. GUERRA	FIELD REVIEW: [signature] DATE: 2-28-05
R.C.E. No. 29224	TIE BOOK: 24 PAGE: 101

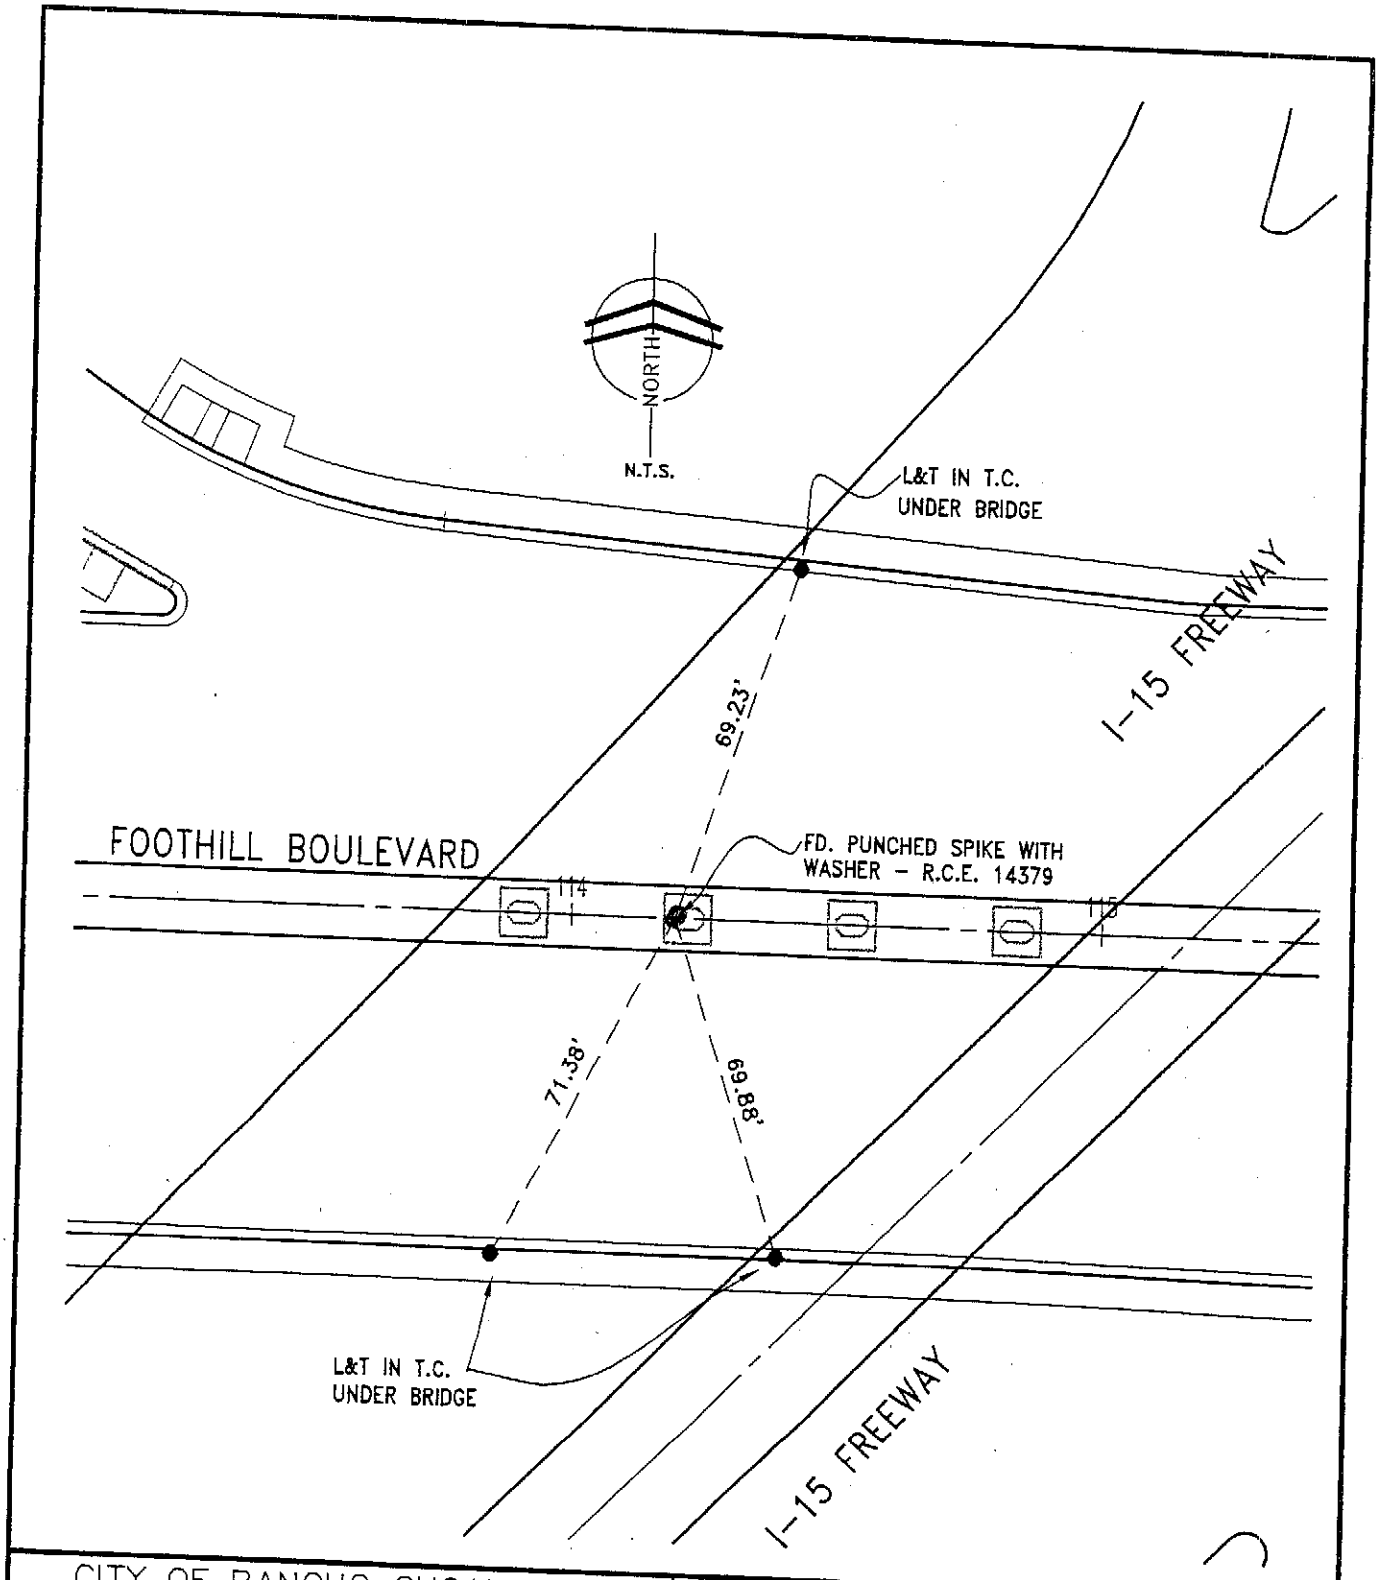

CITY OF RANCHO CUCAMONGA
STREET TIES

PM 15641 PMB 192/93-100

Dan Guerra & Associates
10271-B TRADEMARK STREET
RANCHO CUCAMONGA, CA 91730
(909) 987-4306
CIVIL ENGINEERS • LAND SURVEYORS

FD. S 1/4 COR. SEC., SPIKE AND WASHER R.C.E. 14379 CENTERLINE FOOTHILL BLVD. UNDER I-15 BRIDGE
@ SECOND PILLAR FROM THE WEST

ENGINEER: DANIEL E. GUERRA

R.C.E. No. 29224

FIELD REVIEW: [illegible] DATE: 2-28-05

TIE BOOK: 24 PAGE: 102

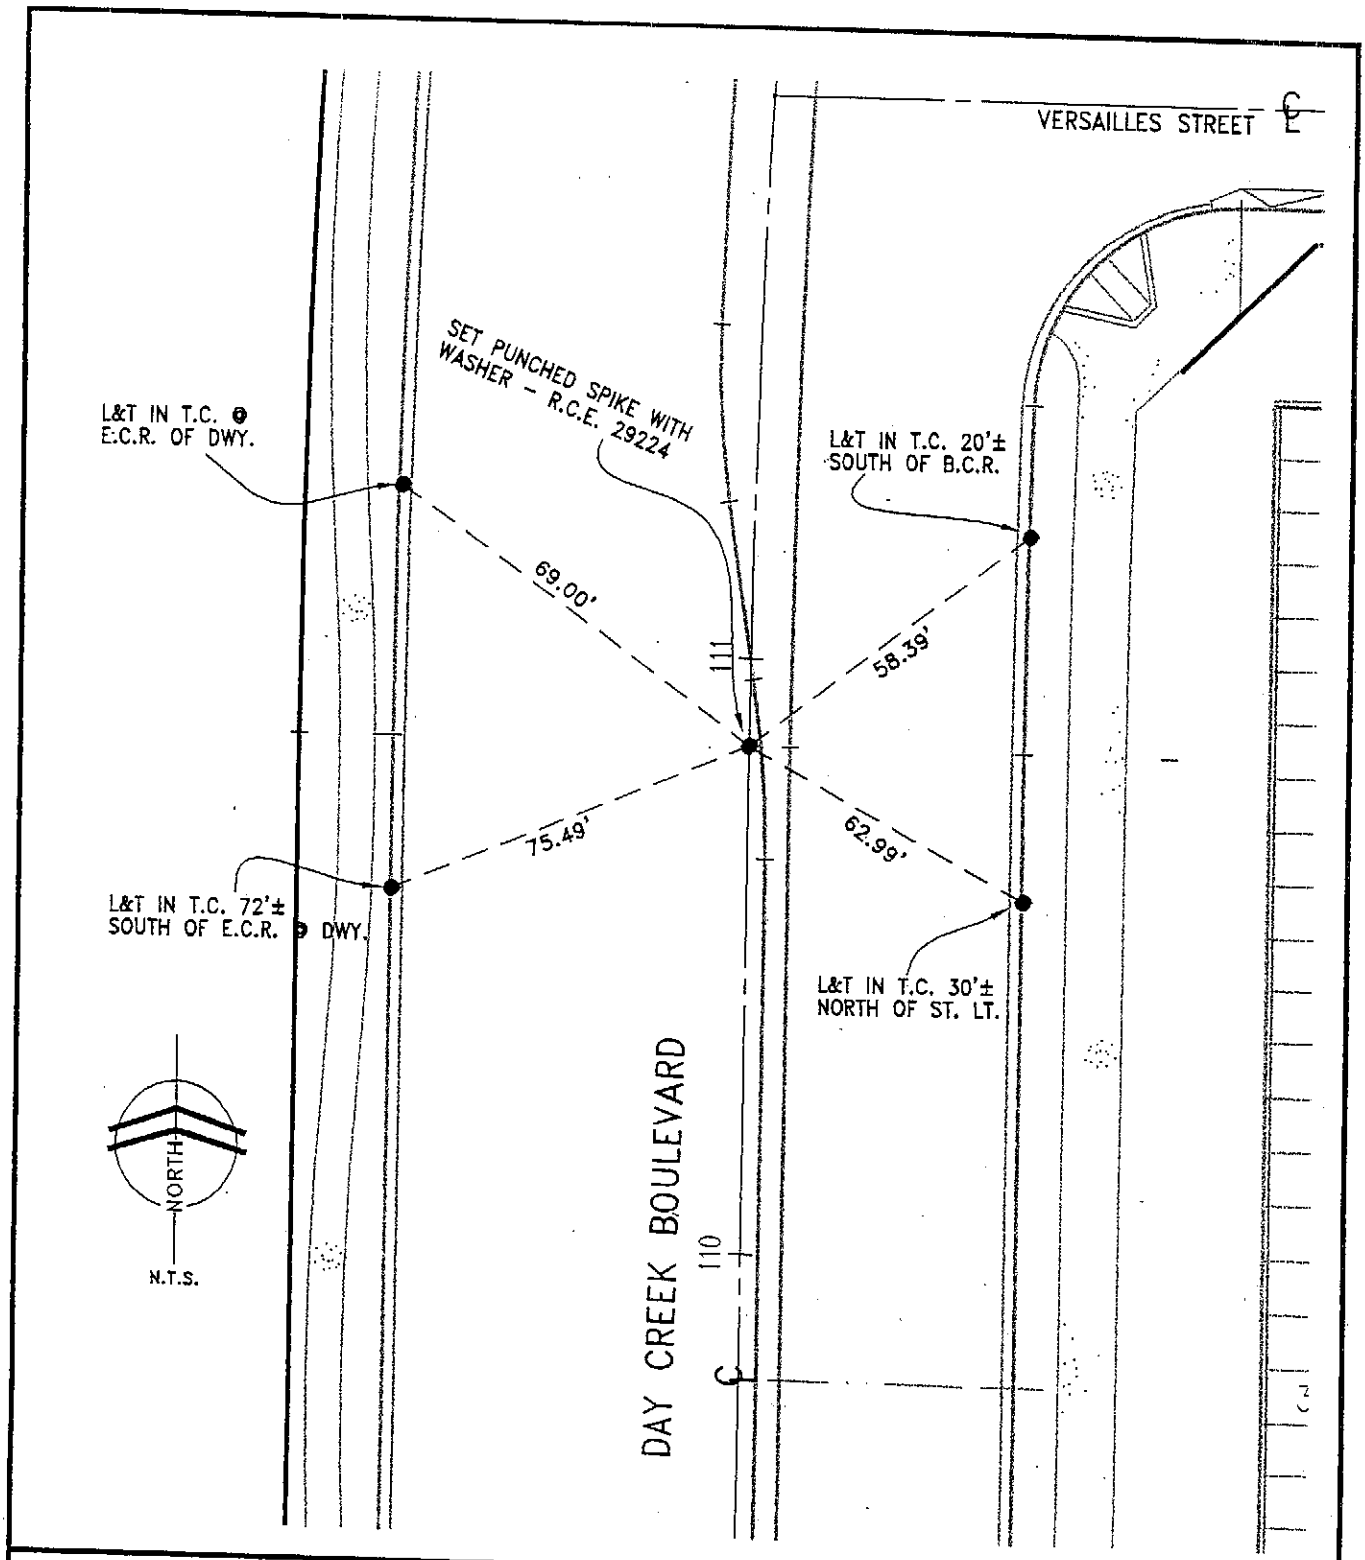

CITY OF RANCHO CUCAMONGA STREET TIES	PM 15641 · PMB 192/93-100
Dan Guerra & Associates 10271-B TRADEMARK STREET RANCHO CUCAMONGA, CA 91730 (909) 987-4306 CIVIL ENGINEERS • LAND SURVEYORS	B.C. CENTERLINE DAY CREEK JUST SOUTH OF VERSAILLES STREET
ENGINEER: DANIEL E. GUERRA	FIELD REVIEW: [signature] DATE: 2-28-05
R.C.E. No. 29224	TIE BOOK: 24 PAGE: 103

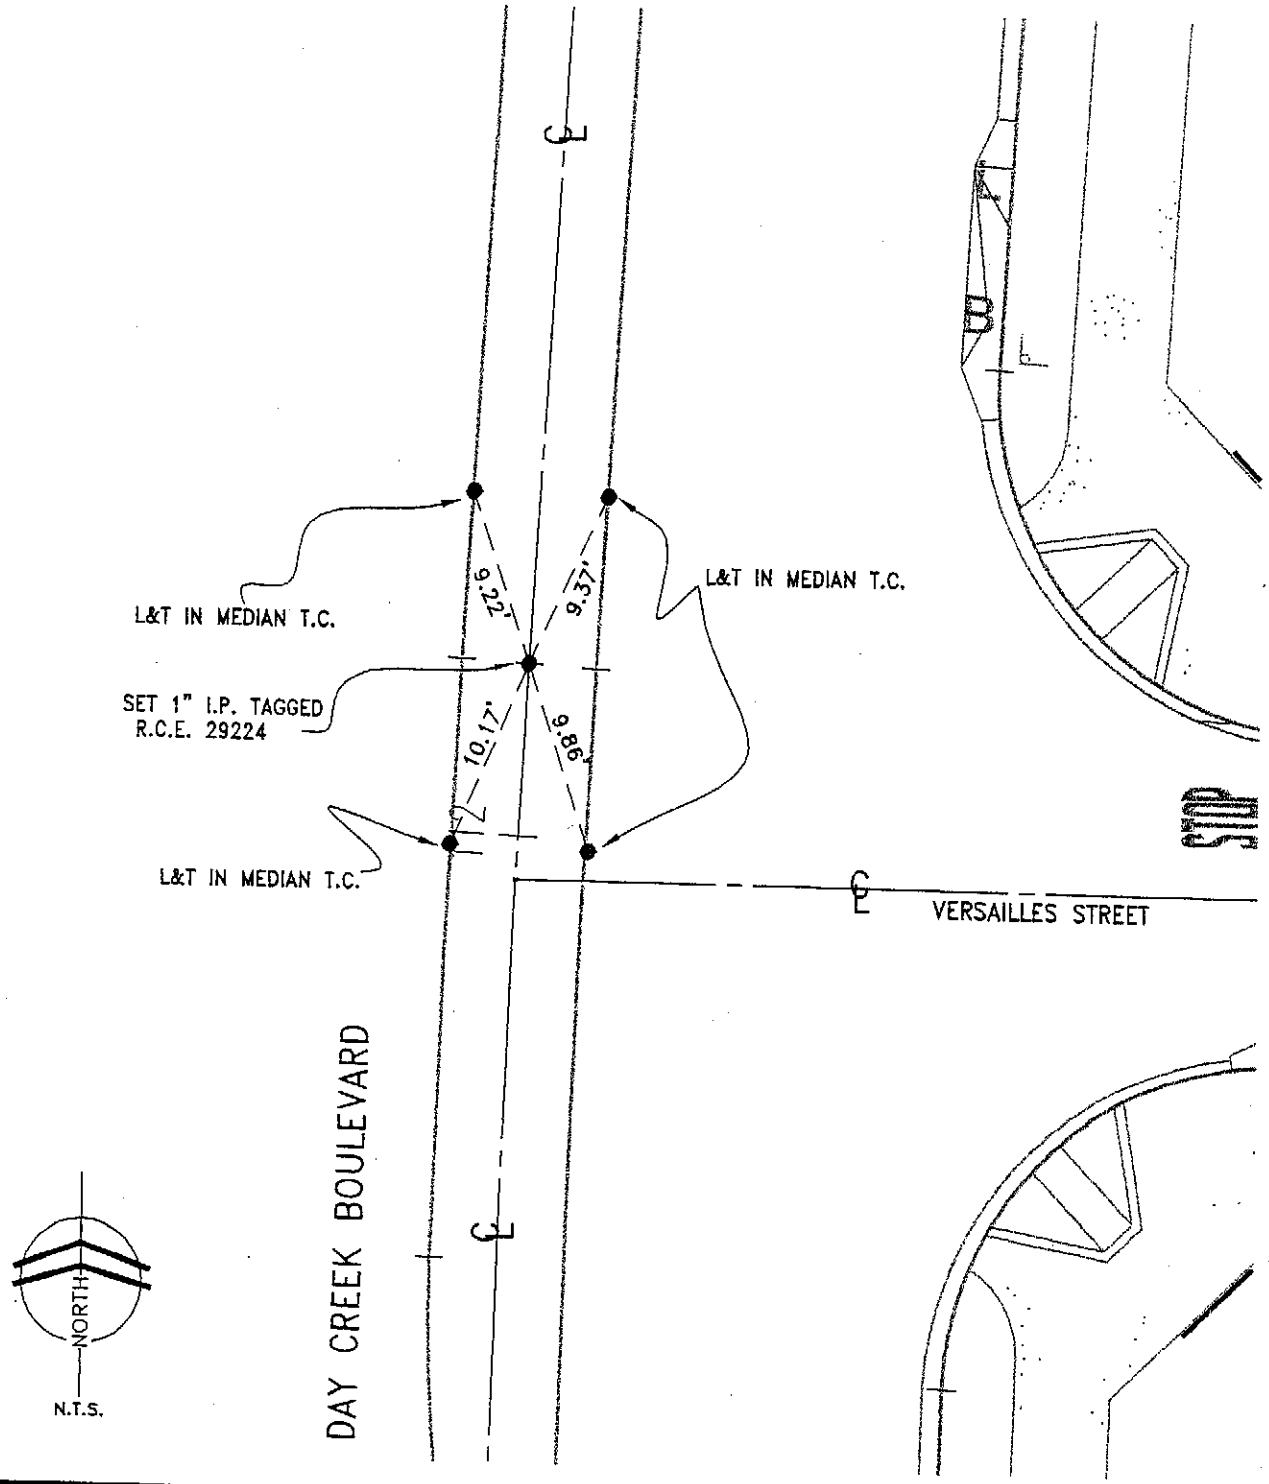

CITY OF RANCHO CUCAMONGA STREET TIES	PM 15641 PMB 192/93-100
Dan Guerra & Associates 10271-B TRADEMARK STREET RANCHO CUCAMONGA, CA 91730 (909) 987-4306 CIVIL ENGINEERS • LAND SURVEYORS	E.C. ⊙ CENTERLINE DAY CREEK JUST NORTH OF VERSAILLES STREET
ENGINEER: DANIEL E. GUERRA	FIELD REVIEW: [signature] DATE: 2-28-05
R.C.E. No. 29224	TIE BOOK: 24 PAGE: 104

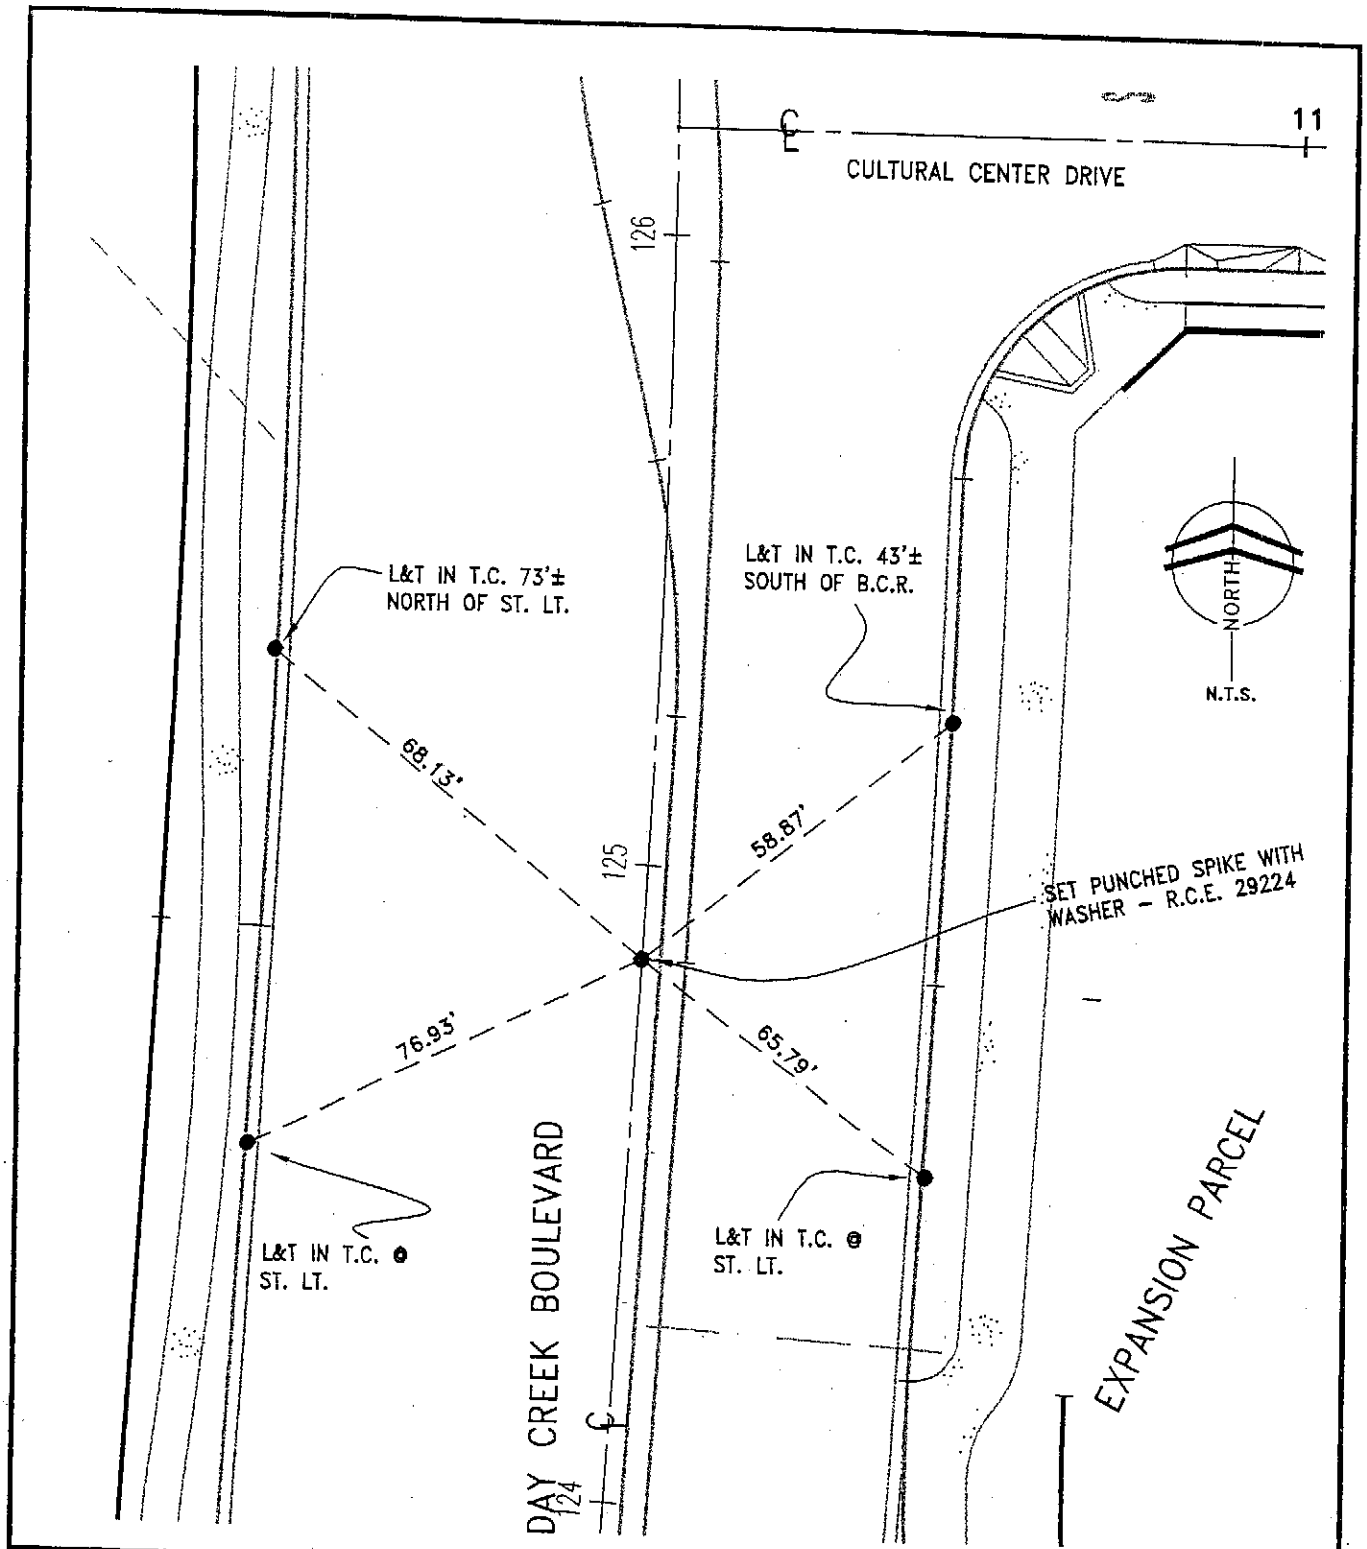

CITY OF RANCHO CUCAMONGA STREET TIES	PM 15641 PMB 192/93-100
Dan Guerra & Associates 10271-B TRADEMARK STREET RANCHO CUCAMONGA, CA 91730 (909) 987-4306 CIVIL ENGINEERS • LAND SURVEYORS	CENTERLINE DAY CREEK BOULEVARD B.C. JUST SOUTH OF CENTERLINE INTERSECTION DAY CREEK AND CULTURAL CENTER DRIVE
ENGINEER: DANIEL E. GUERRA	FIELD REVIEW: [signature] DATE: 2-28-05
R.C.E. No. 29224	TIE BOOK: 24 PAGE: 105

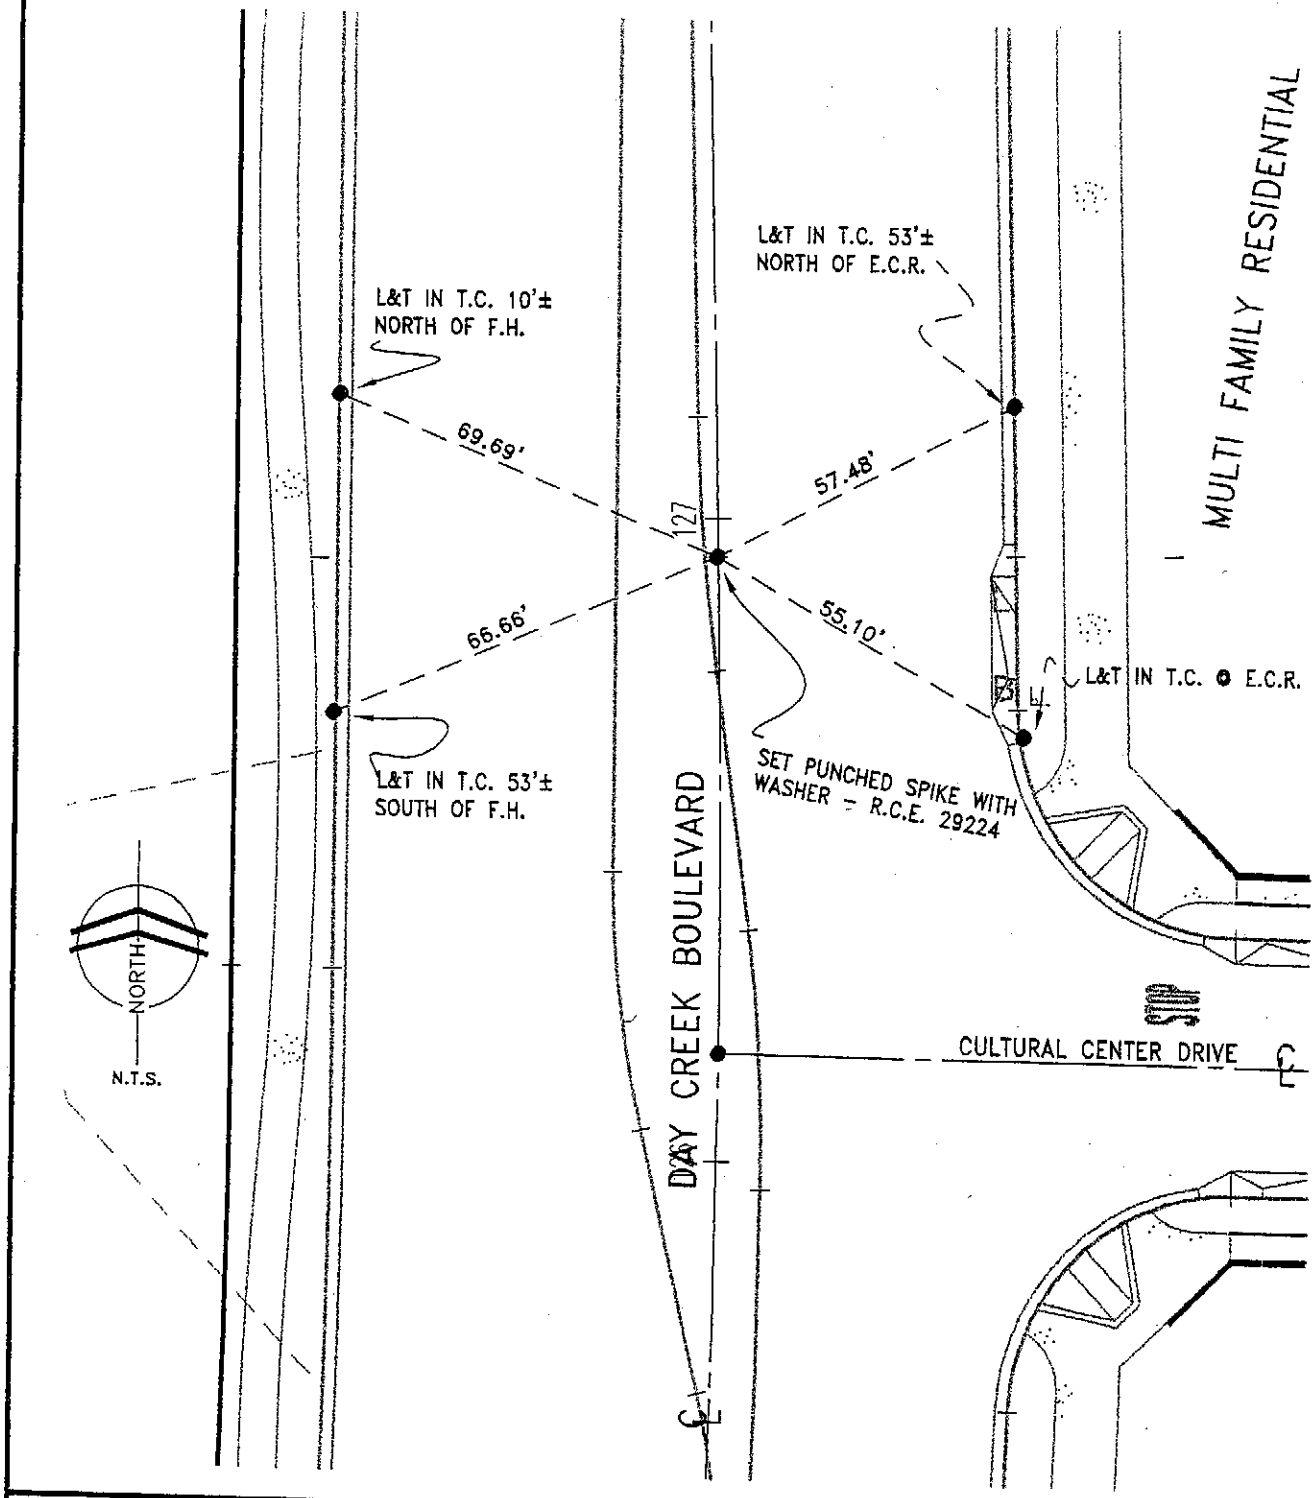

CITY OF RANCHO CUCAMONGA STREET TIES	PM 15641 PMB 192/93-100
Dan Guerra & Associates 10271-B TRADEMARK STREET RANCHO CUCAMONGA, CA 91730 (909) 987-4306 CIVIL ENGINEERS • LAND SURVEYORS	CENTERLINE DAY CREEK BOULEVARD E.C. JUST NORTH OF CULTURAL CENTER DRIVE
ENGINEER: DANIEL E. GUERRA	FIELD REVIEW: [signature] DATE: 2-28-05
R.C.E. No. 29224	TIE BOOK: 24 PAGE: 106

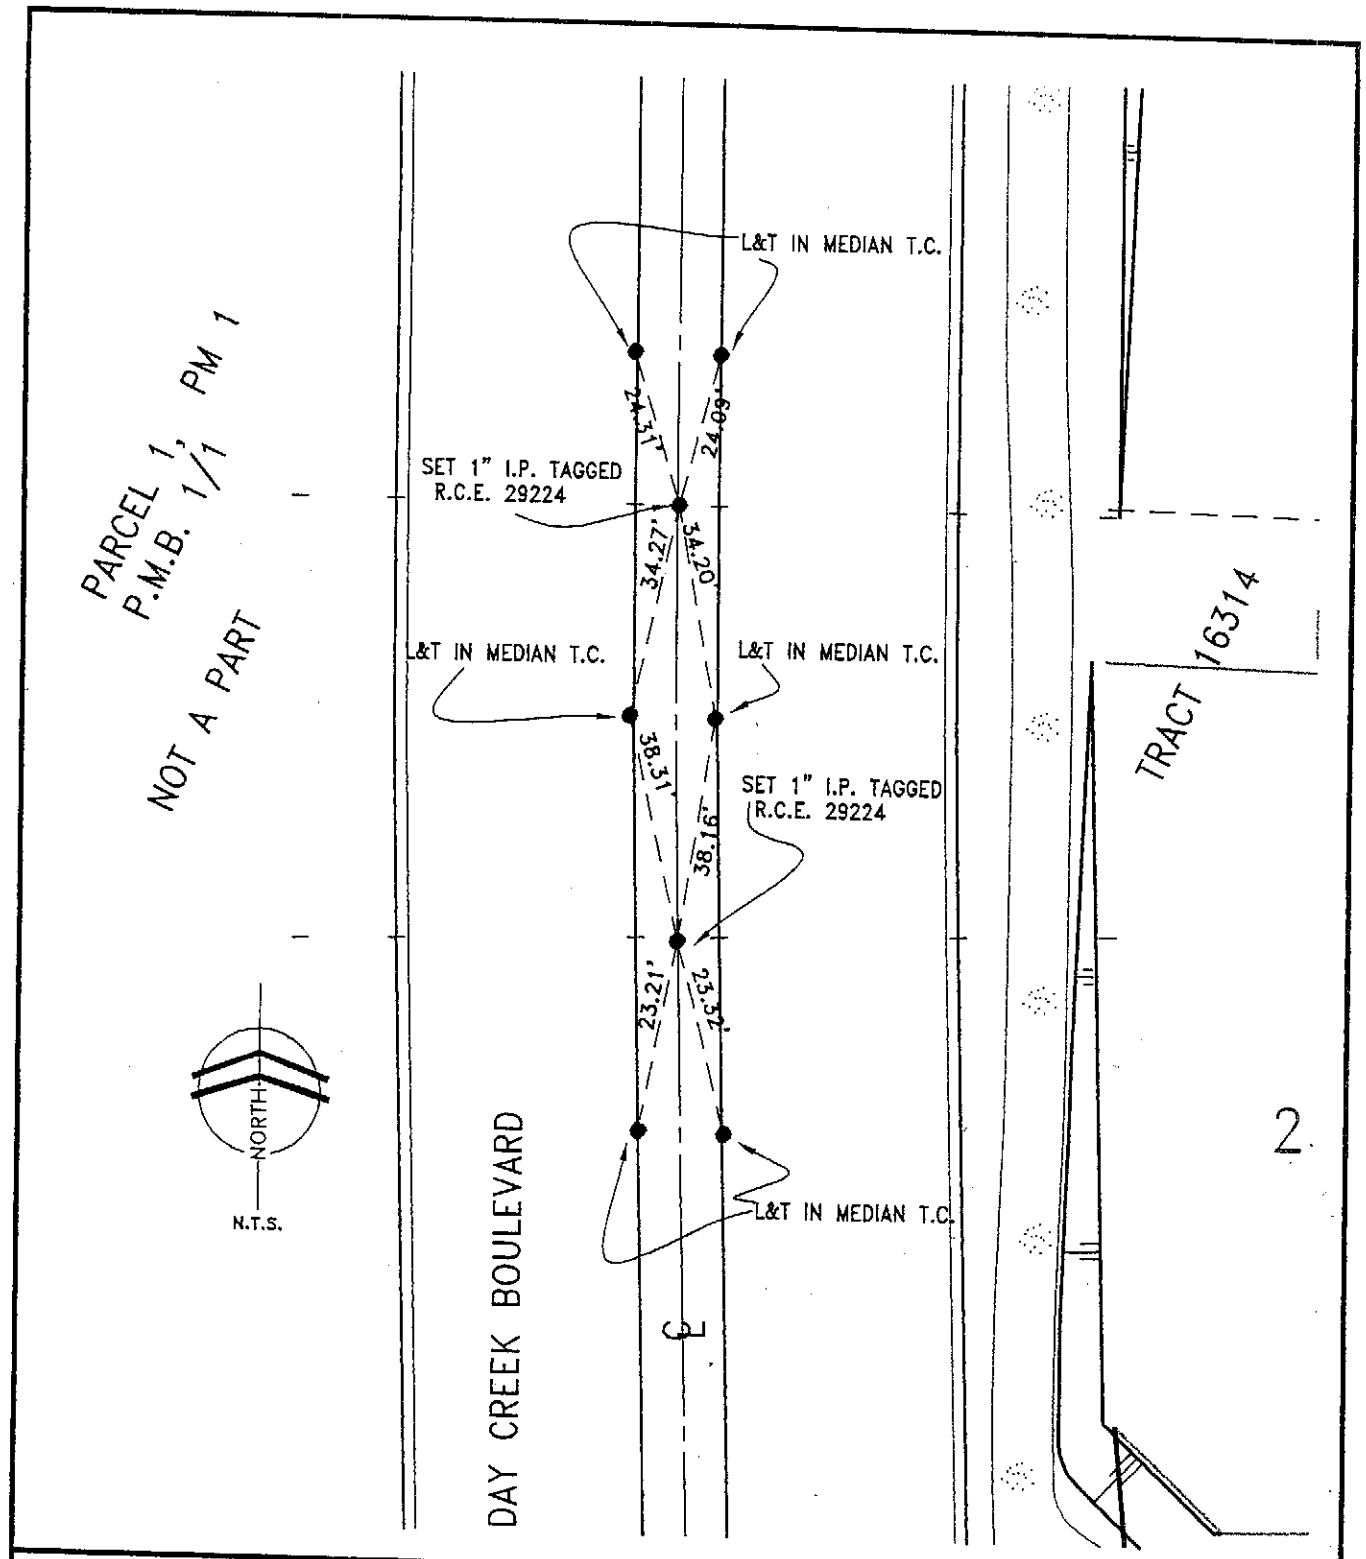

CITY OF RANCHO CUCAMONGA STREET TIES	PM 15641 PMB 192/93-100
Dan Guerra & Associates 10271-B TRADEMARK STREET RANCHO CUCAMONGA, CA 91730 (909) 987-4306 CIVIL ENGINEERS • LAND SURVEYORS	CENTERLINE DAY CREEK BOULEVARD B.C., AND E.C. BETWEEN BASE LINE ROAD AND CHURCH STREET
ENGINEER: DANIEL E. GUERRA	FIELD REVIEW: [illegible] DATE: 2-28-05
R.C.E. No. 29224	TIE BOOK: 24 PAGE: 107

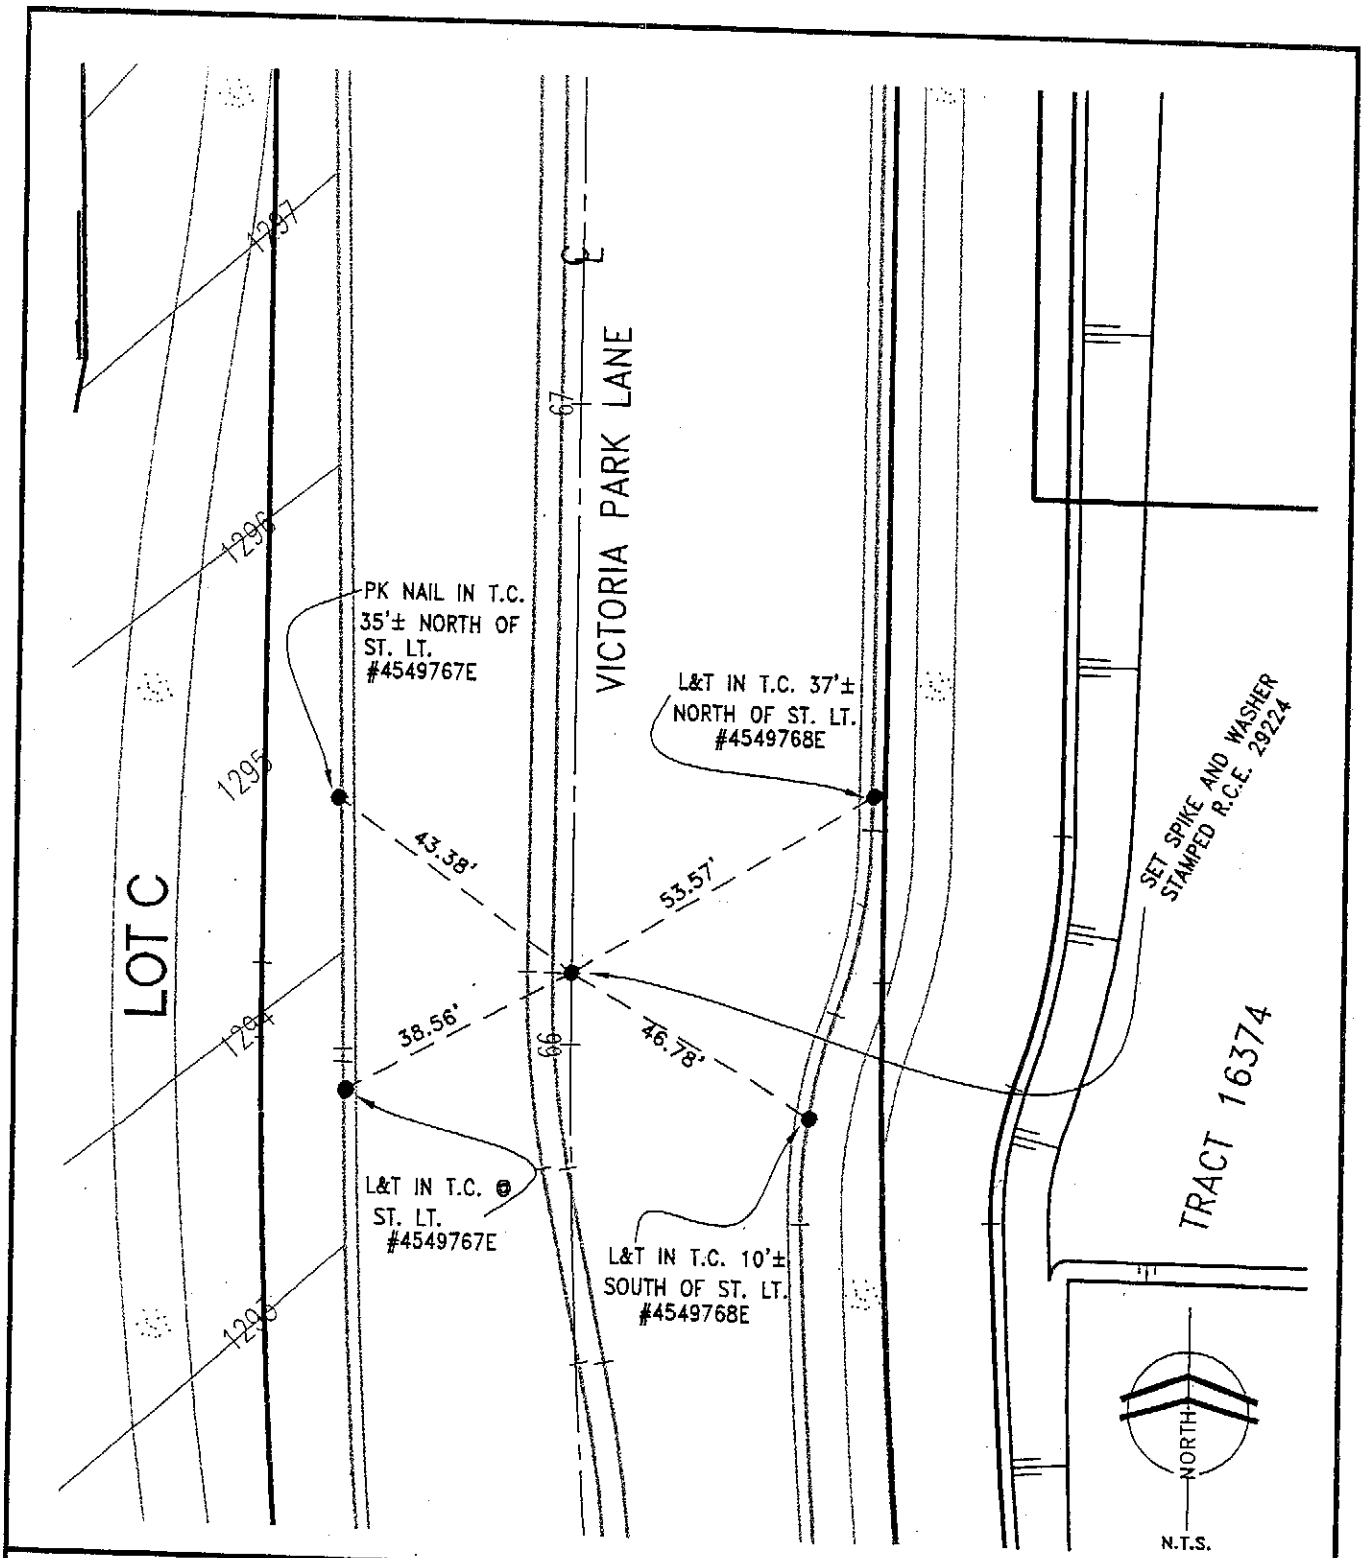

CITY OF RANCHO CUCAMONGA
STREET TIES

PM 15641 PMB 192/93-100

Dan Guerra & Associates
10271-B TRADEMARK STREET
RANCHO CUCAMONGA, CA 91730
(909) 987-4306
CIVIL ENGINEERS • LAND SURVEYORS

CENTERLINE VICTORIA PARK LANE E.C. JUST SOUTH OF BASE LINE ROAD

ENGINEER: DANIEL E. GUERRA

FIELD REVIEW: [illegible] DATE: 2-28-05

R.C.E. No. 29224

TIE BOOK: 24 PAGE: 108

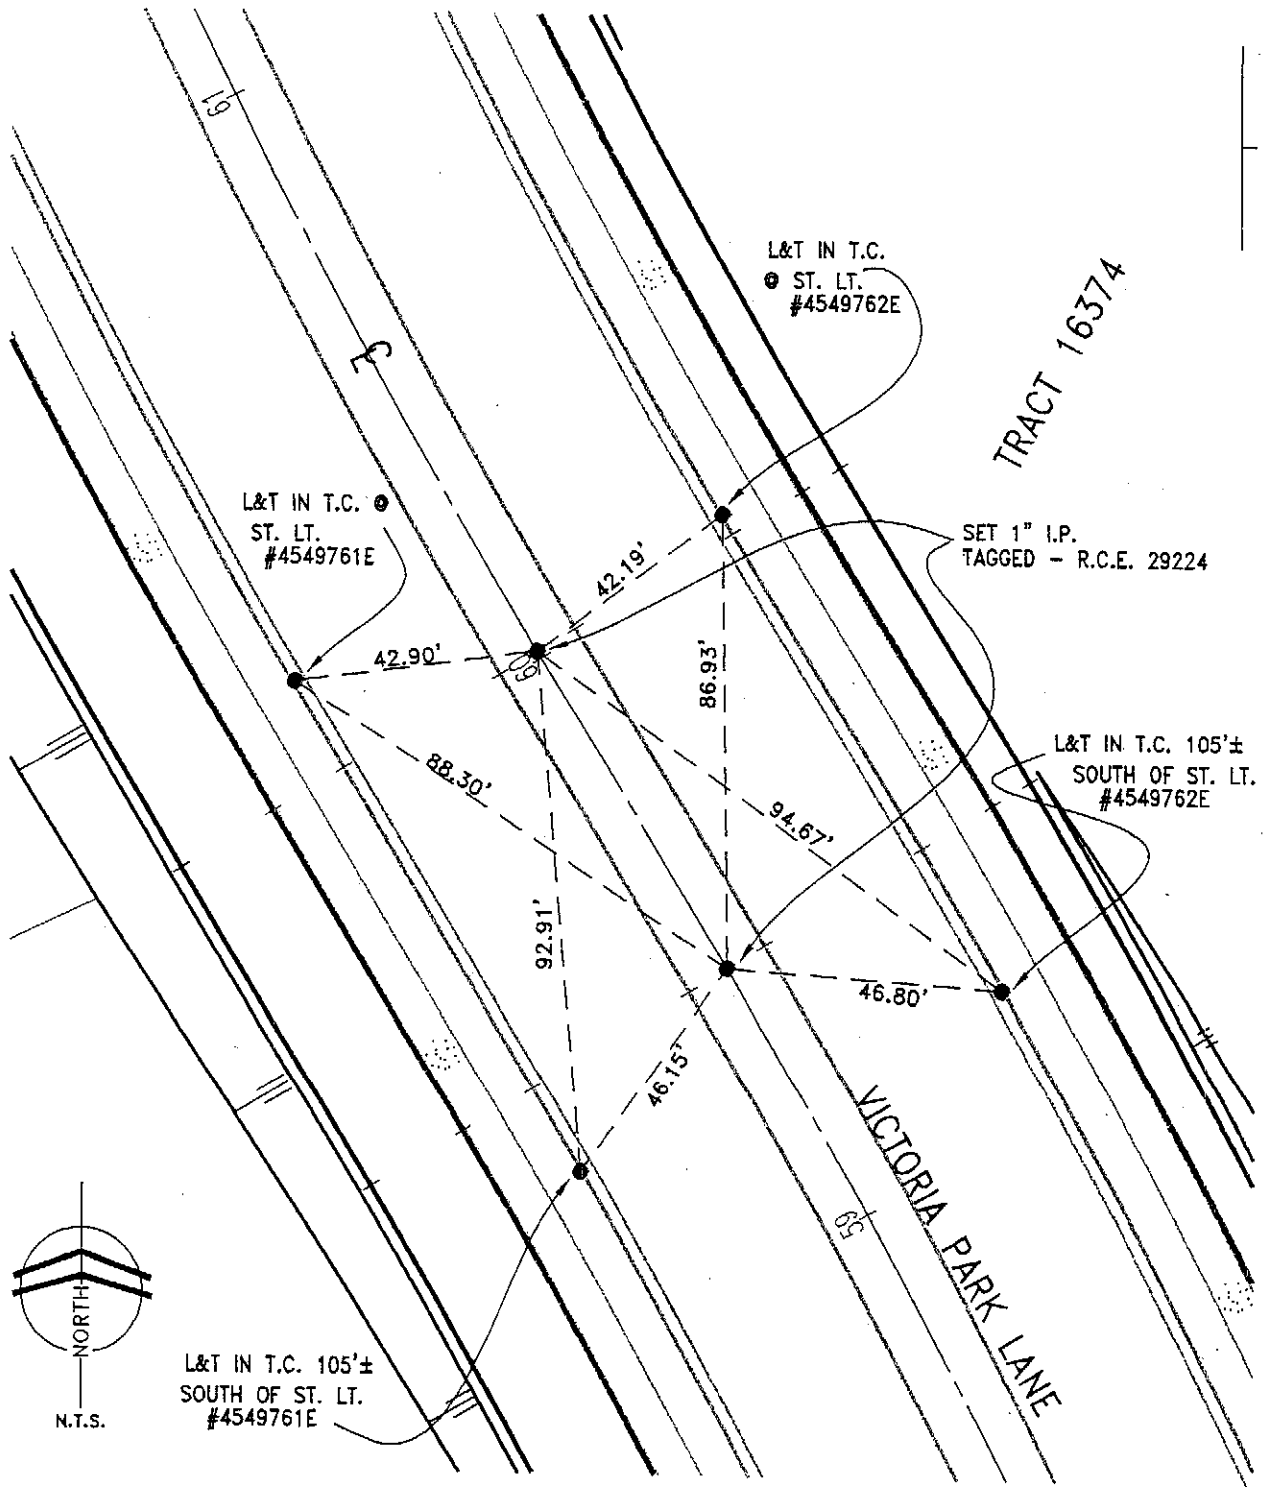

CITY OF RANCHO CUCAMONGA STREET TIES	PM 15641 PMB 192/93-100
Dan Guerra & Associates 10271-B TRADEMARK STREET RANCHO CUCAMONGA, CA 91730 (909) 987-4306 CIVIL ENGINEERS • LAND SURVEYORS	CENTERLINE VICTORIA PARK LANE E.C. AND B.C. 1000'± SOUTH OF BASE LINE ROAD
ENGINEER: DANIEL E. GUERRA	FIELD REVIEW: [illegible] DATE: 2-28-05
R.C.E. No. 29224	TIE BOOK: 24 PAGE: 109

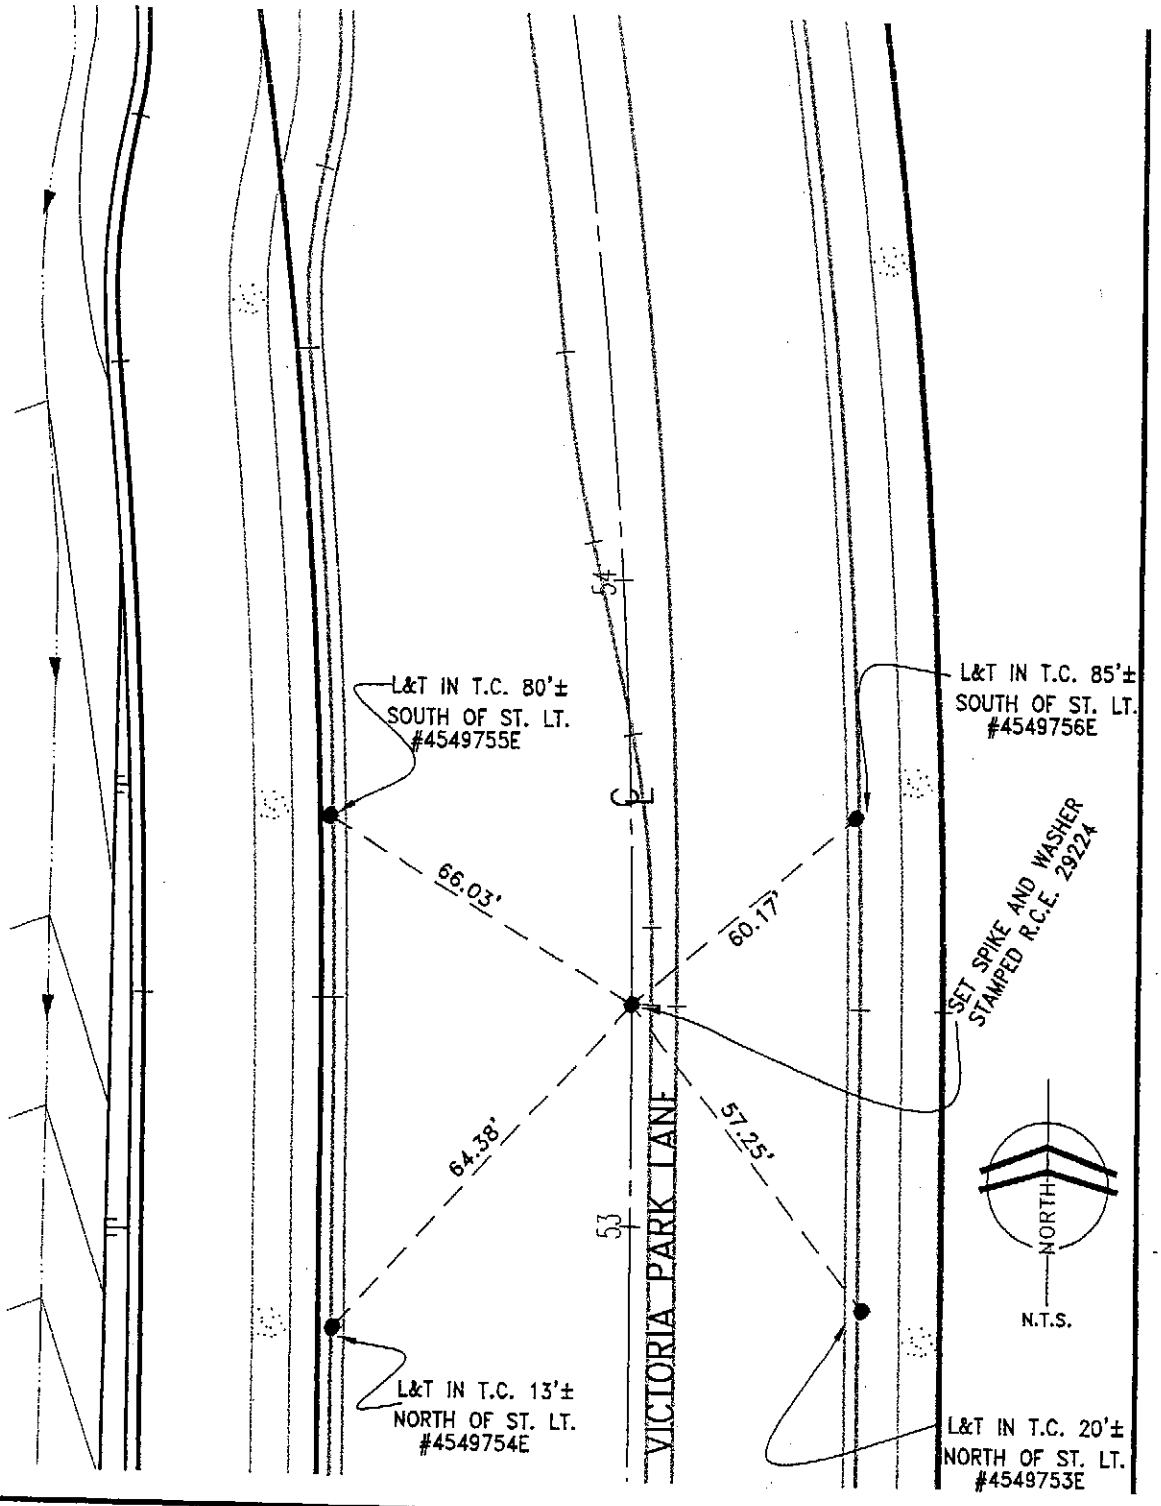

CITY OF RANCHO CUCAMONGA
STREET TIES

PM 15641 PMB 192/93-100

Dan Guerra & Associates
10271-B TRADEMARK STREET
RANCHO CUCAMONGA, CA 91730
(909) 987-4306
CIVIL ENGINEERS • LAND SURVEYORS

CENTERLINE VICTORIA PARK LANE B.C. 900'± NORTH OF CHURCH STREET

ENGINEER: DANIEL E. GUERRA

FIELD REVIEW: [signature] DATE: 2-28-93

R.C.E. No. 29224

TIE BOOK: 24 PAGE: 110

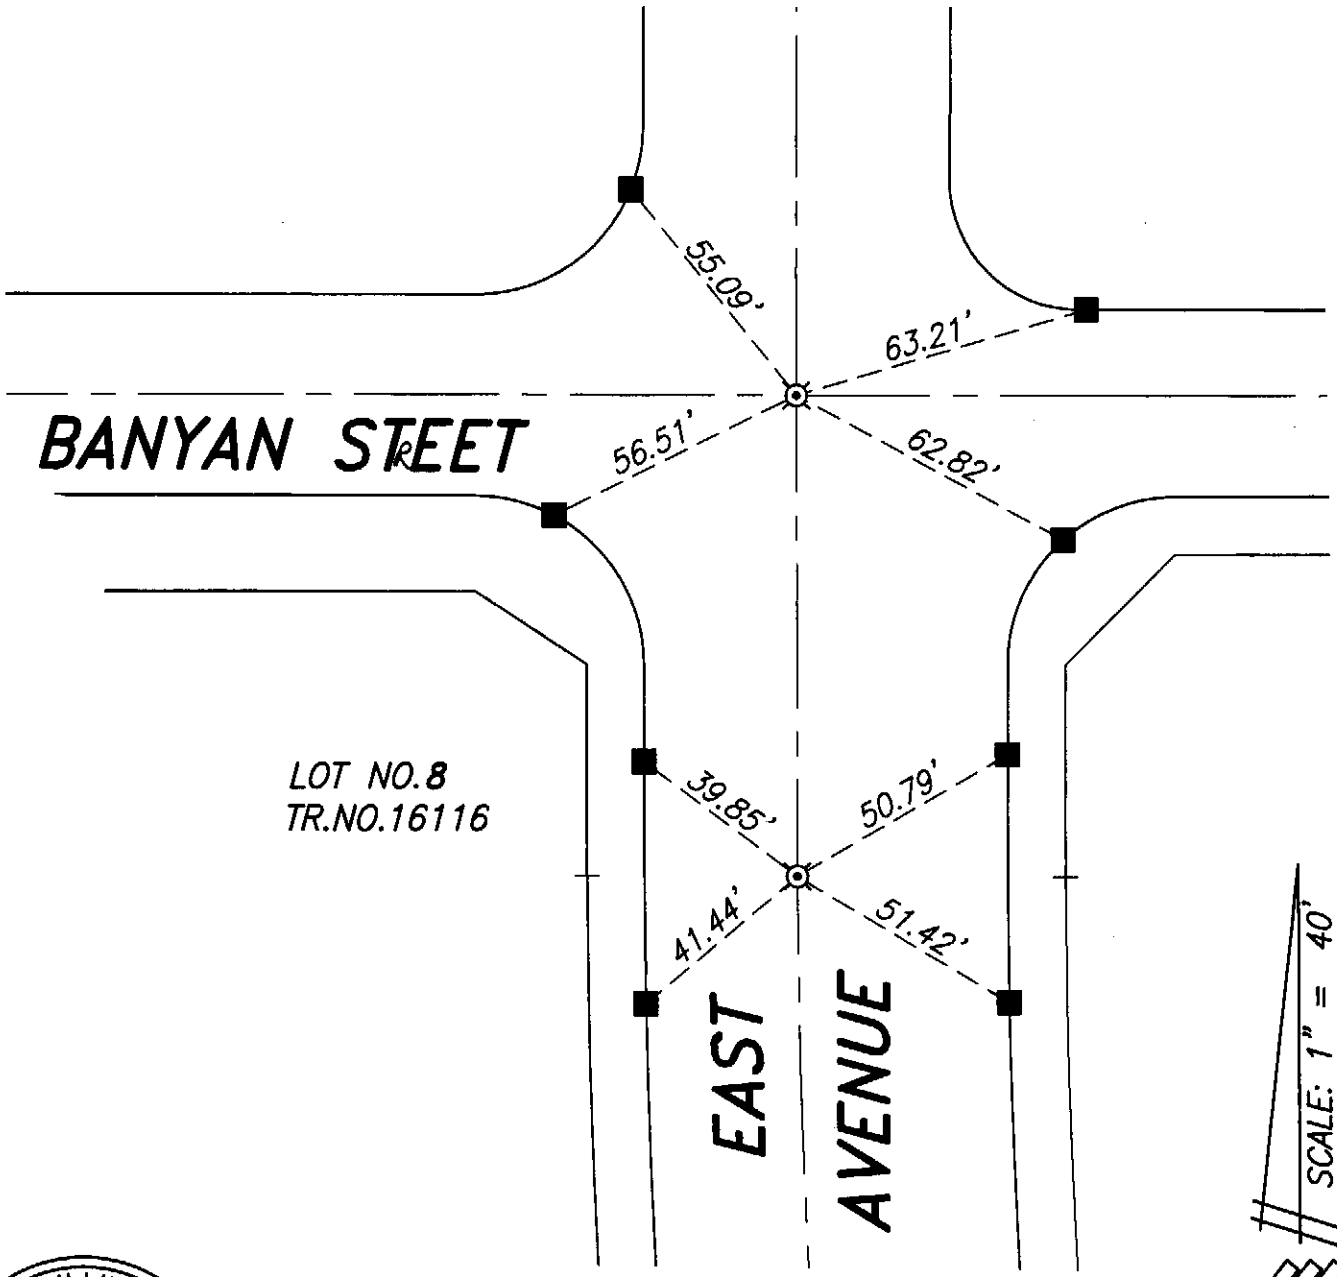

PROFESSIONAL LAND SURVEYOR
WM. ROARO JASSO
No. 4756
Exp: 9-30-2005
STATE OF CALIFORNIA
4/17/05

LEGEND

⊙ 1"IRON PIPE, WITH TAG "LS 4756"

■ LEAD & TACK NO TAG

SHT. 1 OF 20

CITY OF RANCHO CUCAMONGA — STREET TIE	TRACT NO. 16116
MADOLE AND ASSOCIATES, INC. 760-A S. Rochester Avenue Ontario, CA 91761 Phone (909) 937-9151	EAST AVE @ BANYAN
ENGR./L.S. WM. ROARO JASSO	FIELD REVIEW: _____ DATE: _____
ENGR./L.S. No. 4756 EXP.DATE: 09-30-2005	TIE BOOK: 24 PAGE: 111

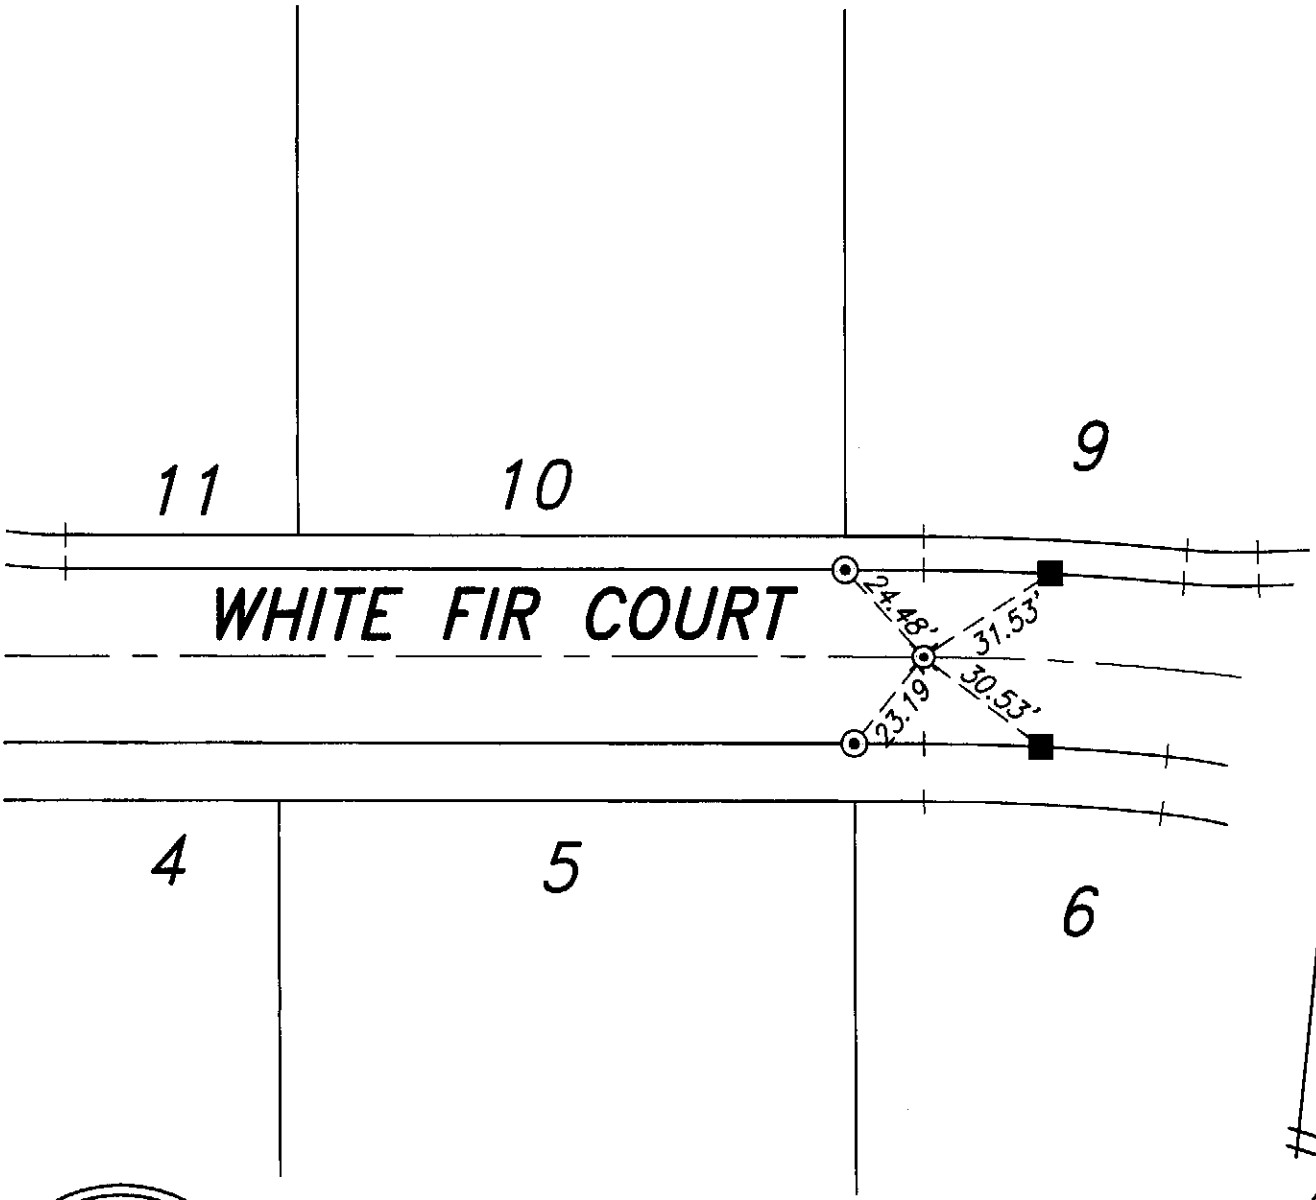

SCALE: 1" = 40'

PROFESSIONAL LAND SURVEYOR
WM. ROARO JASSO
No. 4756
Exp: 9-30-2005
STATE OF CALIFORNIA
4/12/05

LEGEND

- ⊙ NAIL & TAG "LS 4756"
- ⊠ 1" IRON PIPE, WITH TAG "LS 4756"
- ■ LEAD & TACK NO TAG

SHT. 2 OF 20

CITY OF RANCHO CUCAMONGA — STREET TIE	TRACT NO. 16116
MADOLE AND ASSOCIATES, INC. 760-A S. Rochester Avenue Ontario, CA 91761 Phone (909) 937-9151	WHITE FIR CT.
ENGR./L.S. WM. ROARO JASSO	FIELD REVIEW: _____ DATE: _____
ENGR./L.S. No. 4756 EXP.DATE: 09-30-2005	TIE BOOK: 24 PAGE: 112

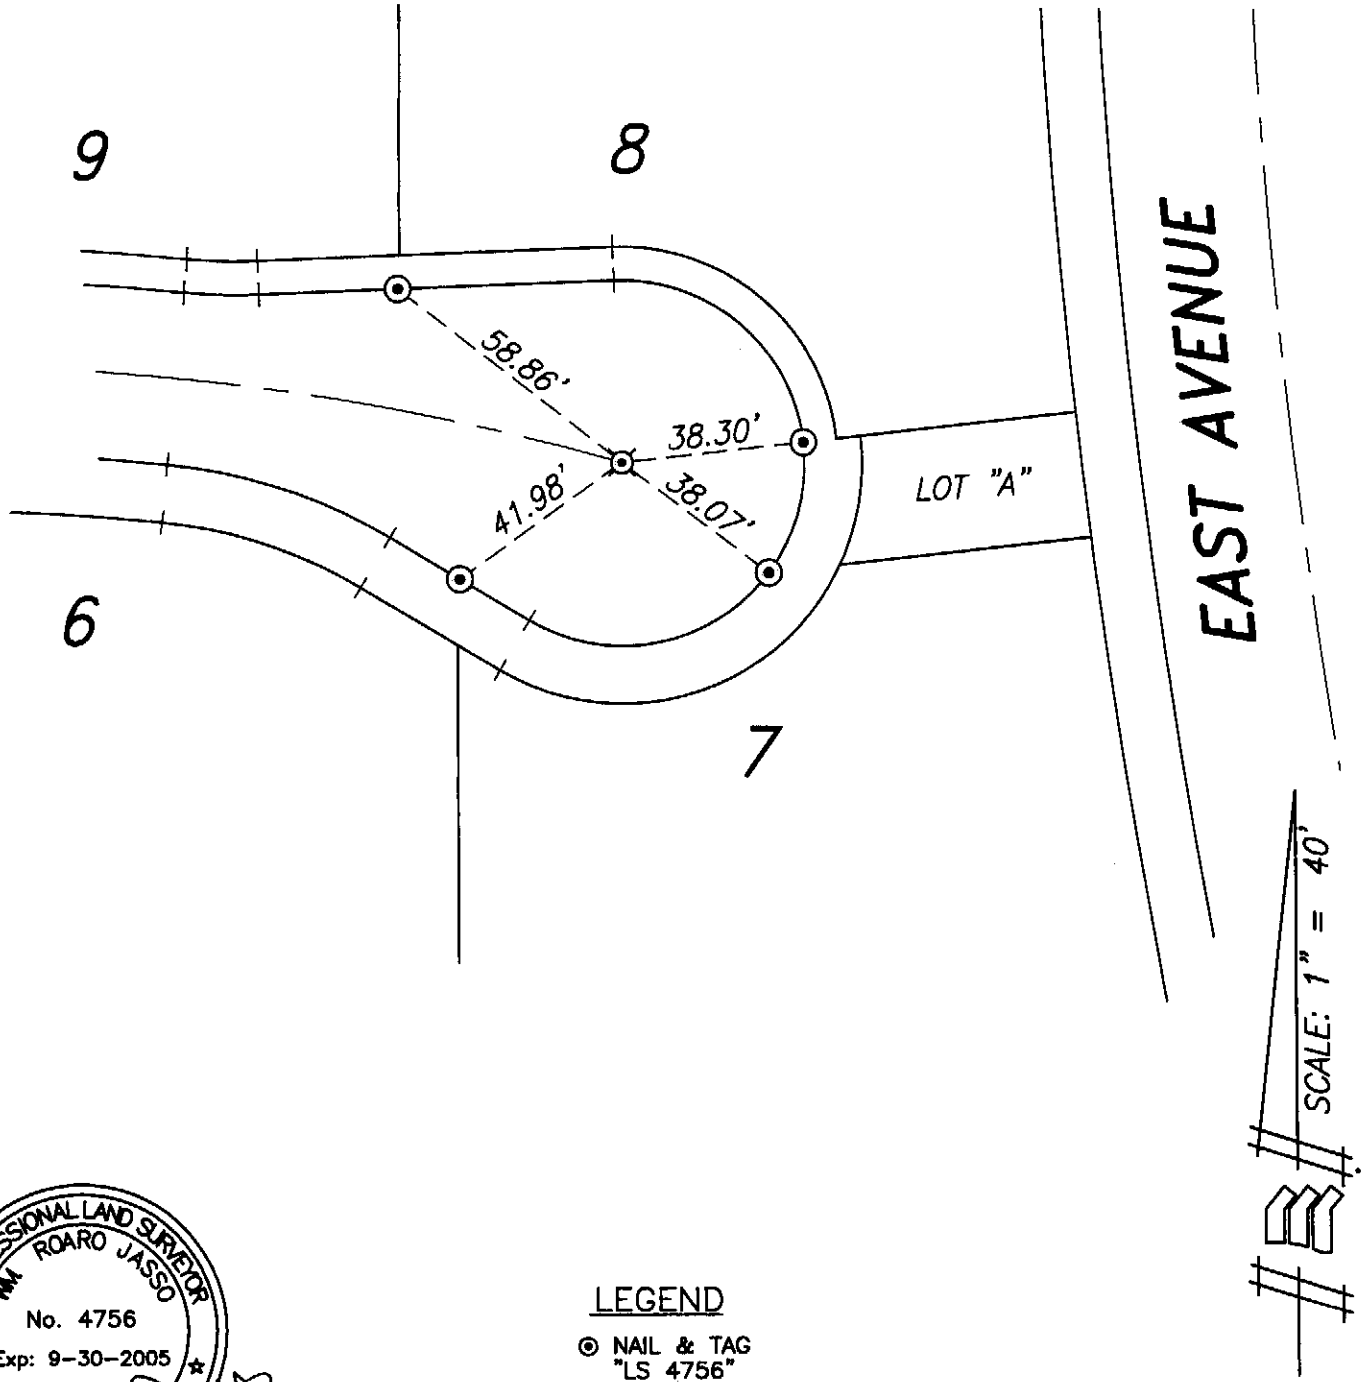

PROFESSIONAL LAND SURVEYOR
WM. ROARO JASSO
No. 4756
Exp: 9-30-2005
STATE OF CALIFORNIA
4/17/05

LEGEND

⊙ NAIL & TAG "LS 4756"

⊠ 1" IRON PIPE, WITH TAG "LS 4756"

SHT. 3 OF 20

CITY OF RANCHO CUCAMONGA — STREET TIE	TRACT NO. 16116
MADOLE AND ASSOCIATES, INC. 760-A S. Rochester Avenue Ontario, CA 91761 Phone (909) 937-9151	WHITE FIR CT.
ENGR./L.S. WM. ROARO JASSO	FIELD REVIEW: _____ DATE: _____
ENGR./L.S. No. 4756 EXP.DATE: 09-30-2005	TIE BOOK: 24 PAGE: 113

LOT NO.7
TR.NO.16116

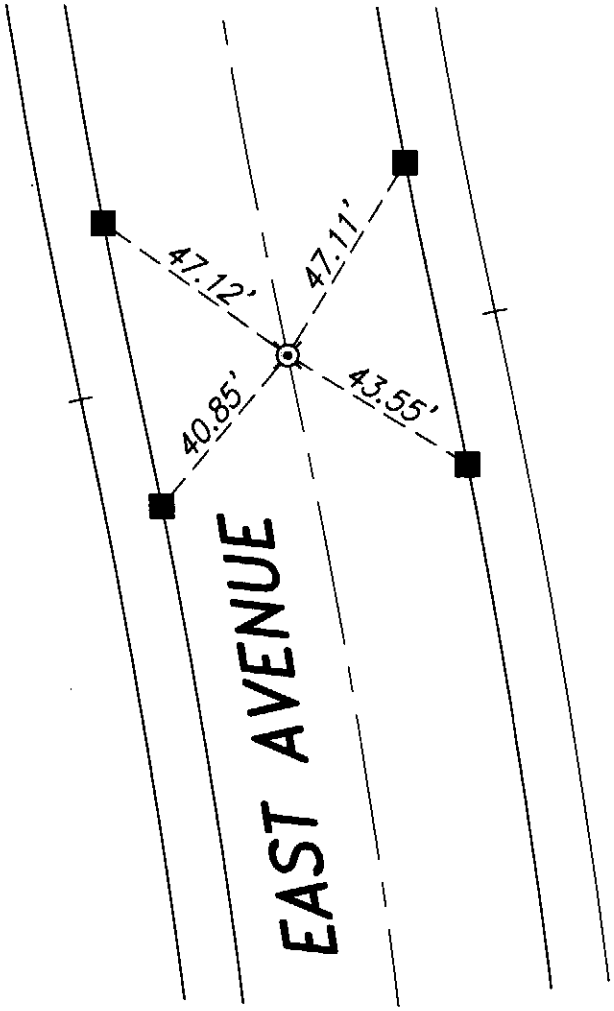

SCALE: 1" = 40'

PROFESSIONAL LAND SURVEYOR
WM. ROARO JASSO
No. 4756
Exp: 9-30-2005
STATE OF CALIFORNIA
4/7/05

LEGEND

- 1"IRON PIPE, WITH TAG "LS 4756"
- LEAD & TACK NO TAG

SHT. 4 OF 20

CITY OF RANCHO CUCAMONGA — STREET TIE	TRACT NO. 16116
MADOLE AND ASSOCIATES, INC. 760-A S. Rochester Avenue Ontario, CA 91761 Phone (909) 937-9151	EAST AVE. S/O BANYAN
ENGR./L.S. WM. ROARO JASSO	FIELD REVIEW: _____ DATE: _____
ENGR./L.S. No. 4756 EXP.DATE: 09-30-2005	TIE BOOK: 24 PAGE: 114

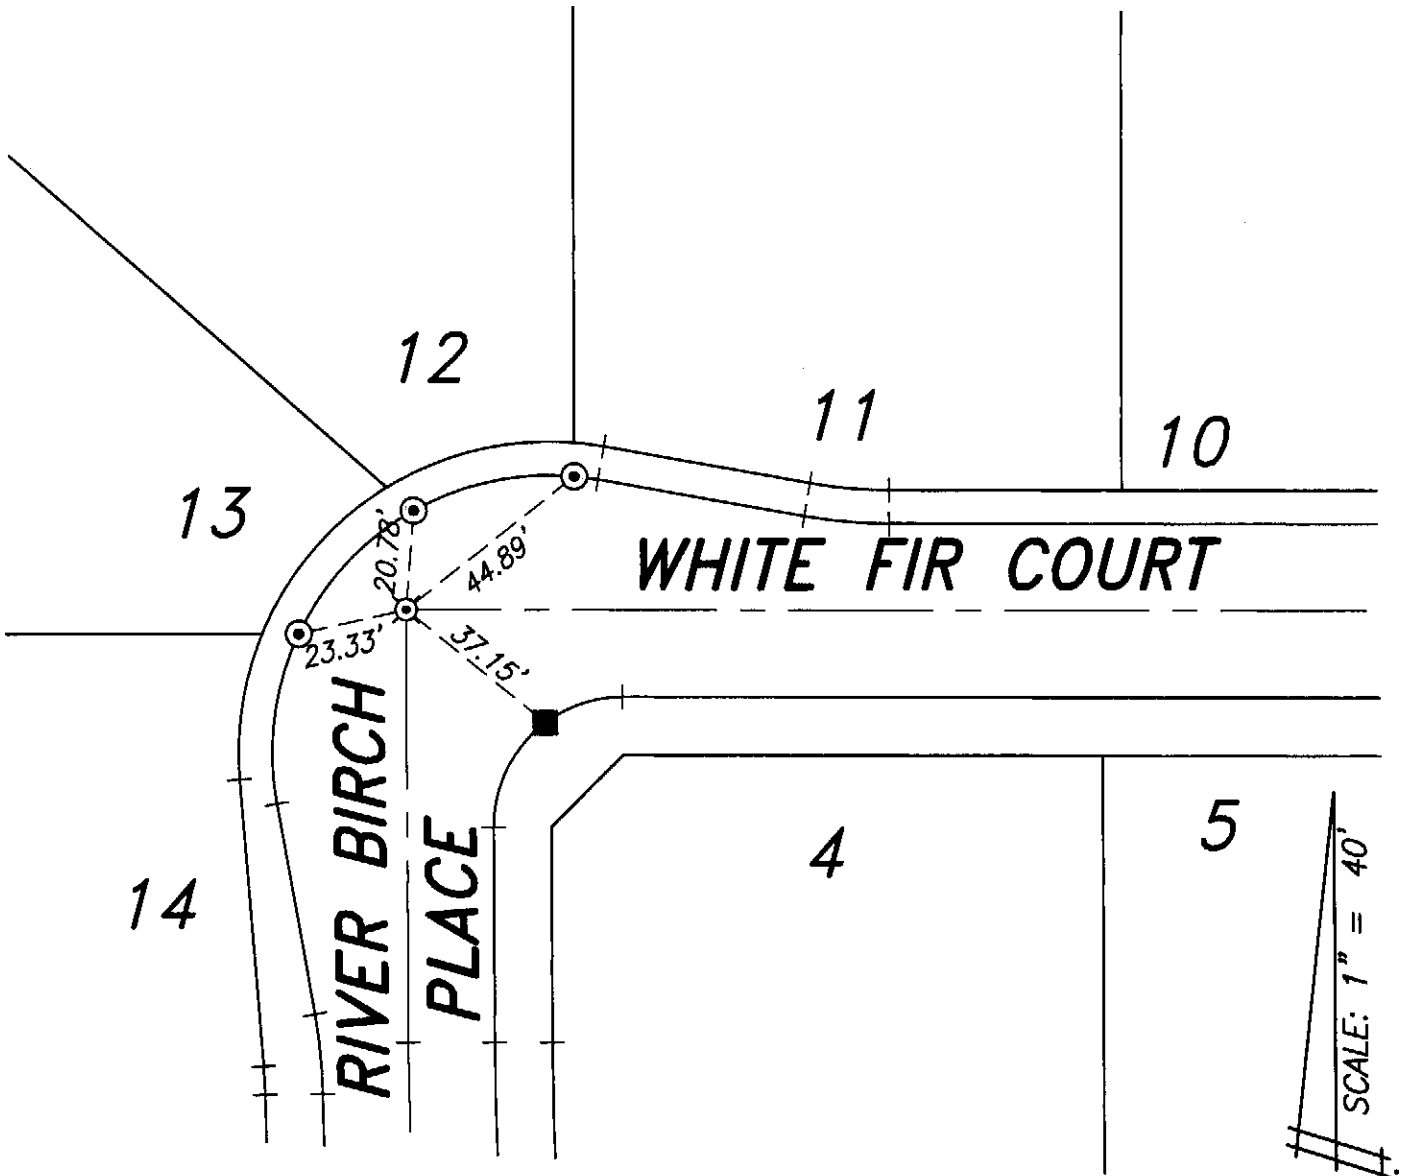

PROFESSIONAL LAND SURVEYOR
WM. ROARO JASSO
No. 4756
Exp: 9-30-2005
STATE OF CALIFORNIA
4/17/05

LEGEND

- ⊙ NAIL & TAG "LS 4756"
- ⊗ 1" IRON PIPE, WITH TAG "LS 4756"
- ■ LEAD & TACK NO TAG

SHT. 5 OF 20

CITY OF RANCHO CUCAMONGA — STREET TIE	TRACT NO. 16116
MADOLE AND ASSOCIATES, INC. 760-A S. Rochester Avenue Ontario, CA 91761 Phone (909) 937-9151	WHITE FIR CT ; RIVER BIRCH PLACE
ENGR./L.S. WM. ROARO JASSO	FIELD REVIEW: _____ DATE: _____
ENGR./L.S. No. 4756 EXP.DATE: 09-30-2005	TIE BOOK: 24 PAGE: 115

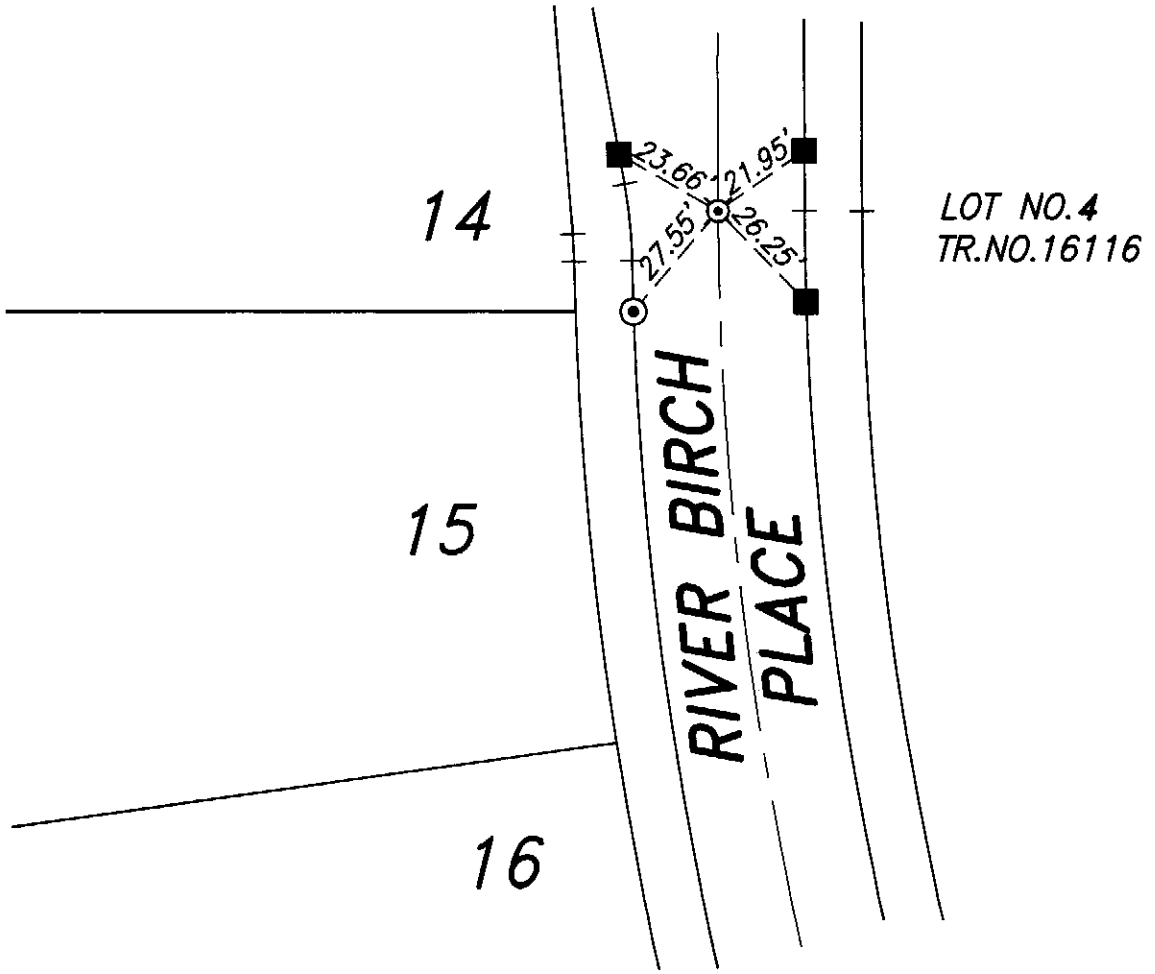

PROFESSIONAL LAND SURVEYOR
WM. ROARO JASSO
No. 4756
Exp: 9-30-2005
STATE OF CALIFORNIA
4/17/05

LEGEND

- ⊙ NAIL & TAG "LS 4756"
- ⊠ 1"IRON PIPE, WITH TAG "LS 4756"
- ■ LEAD & TACK NO TAG

SHT. 6 OF 20

CITY OF RANCHO CUCAMONGA — STREET TIE	TRACT NO. 16116
MADOLE AND ASSOCIATES, INC. 760-A S. Rochester Avenue Ontario, CA 91761 Phone (909) 937-9151	RIVER BIRCH PLACE N/O BLUE GUM
ENGR./L.S. WM. ROARO JASSO	FIELD REVIEW: _____ DATE: _____
ENGR./L.S. No. 4756 EXP.DATE: 09-30-2005	TIE BOOK: 24 PAGE: 116

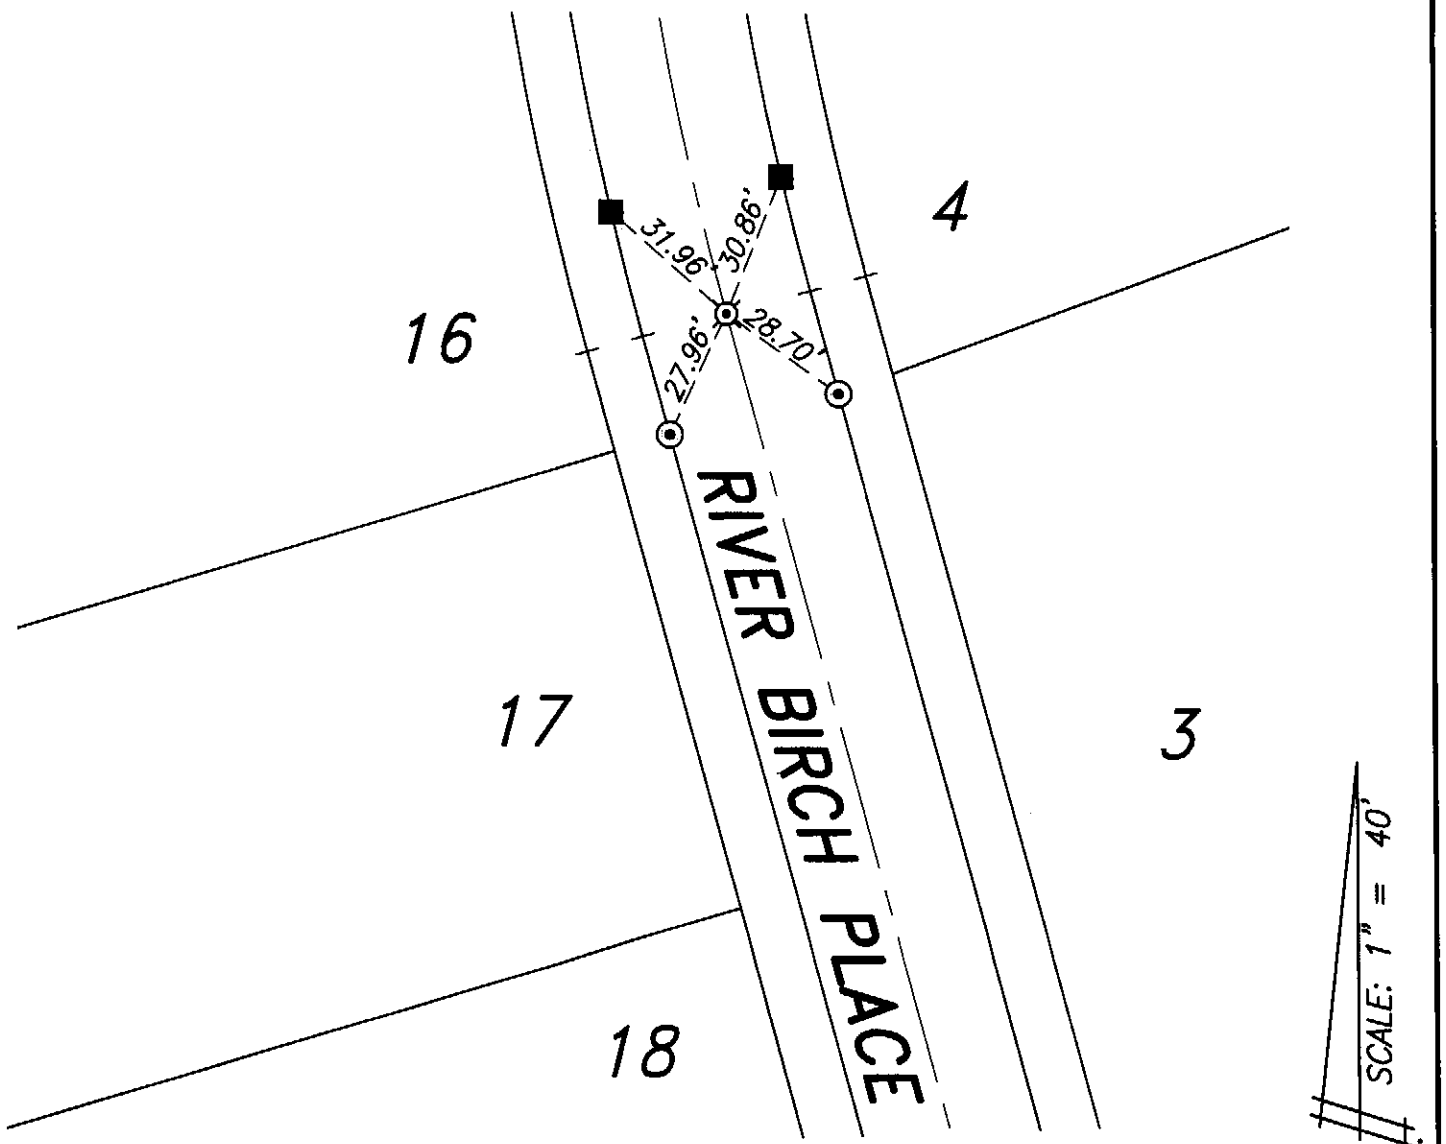

PROFESSIONAL LAND SURVEYOR
WM. ROARO JASSO
No. 4756
Exp: 9-30-2005
STATE OF CALIFORNIA
4/17/05

LEGEND

- ⊙ NAIL & TAG "LS 4756"
- ⊠ 1"IRON PIPE, WITH TAG "LS 4756"
- ■ LEAD & TACK NO TAG

SHT. 7 OF 20

CITY OF RANCHO CUCAMONGA — STREET TIE	TRACT NO. 16116
MADOLE AND ASSOCIATES, INC. 760-A S. Rochester Avenue Ontario, CA 91761 Phone (909) 937-9151	RIVER BIRCH PLACE N/O BLUE GUM
ENGR./L.S. WM. ROARO JASSO	FIELD REVIEW: _____ DATE: _____
ENGR./L.S. No. 4756 EXP.DATE: 09-30-2005	TIE BOOK: 24 PAGE: 117

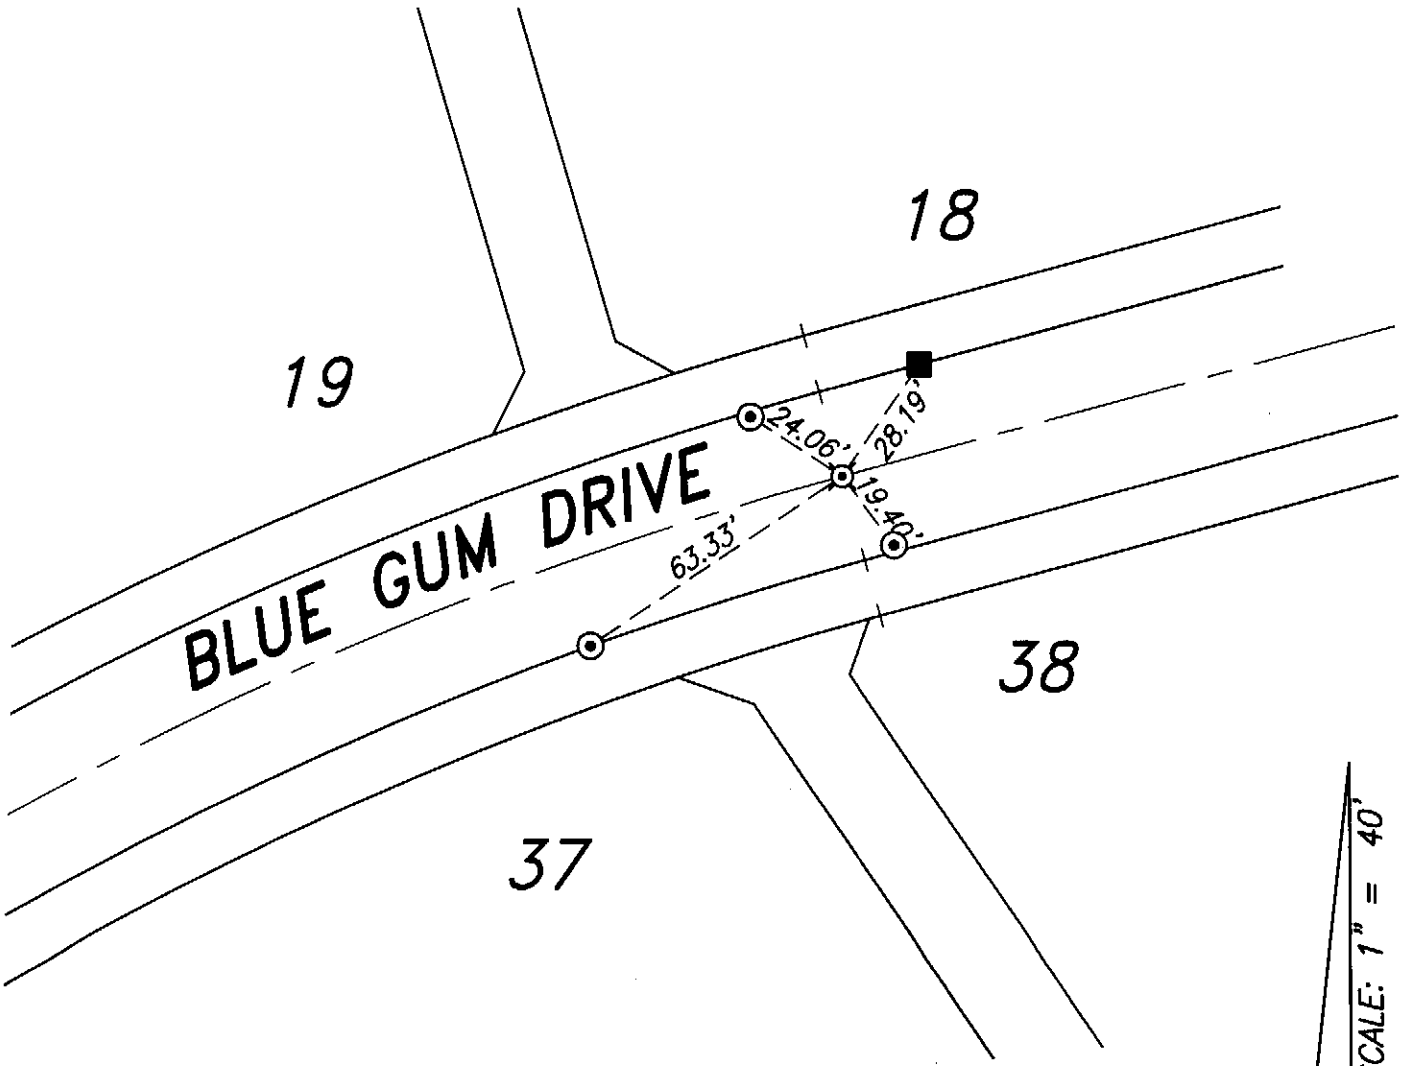

PROFESSIONAL LAND SURVEYOR
WM ROARO JASSO
No. 4756
Exp: 9-30-2005
STATE OF CALIFORNIA
4/17/05

LEGEND

- ⊙ NAIL & TAG "LS 4756"
- ⊠ 1"IRON PIPE, WITH TAG "LS 4756"
- ■ LEAD & TACK NO TAG

SHT. 8 OF 20

CITY OF RANCHO CUCAMONGA — STREET TIE	TRACT NO. 16116
MADOLE AND ASSOCIATES, INC. 760-A S. Rochester Avenue Ontario, CA 91761 Phone (909) 937-9151	BLUE GUM DRIVE
ENGR./L.S. WM. ROARO JASSO	FIELD REVIEW: _____ DATE: _____
ENGR./L.S. No. 4756 EXP.DATE: 09-30-2005	TIE BOOK: 24 PAGE: 118

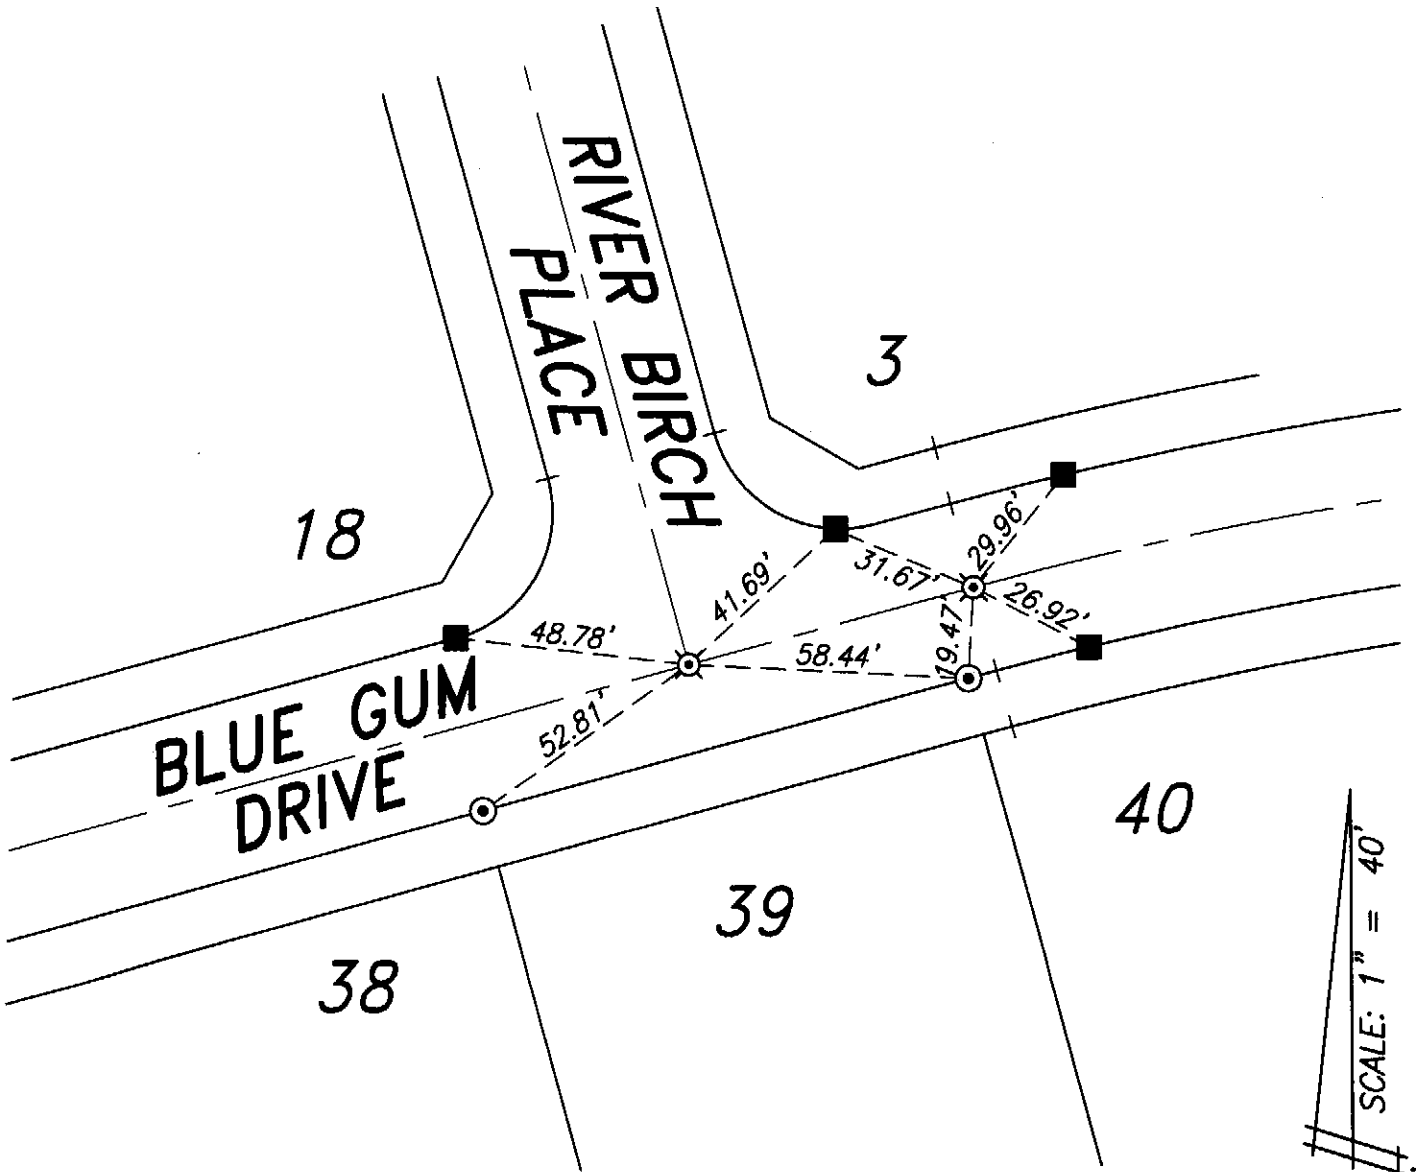

PROFESSIONAL LAND SURVEYOR
WM. ROARO JASSO
No. 4756
Exp: 9-30-2005
STATE OF CALIFORNIA

LEGEND

- ⊙ NAIL & TAG "LS 4756"
- ⊗ 1" IRON PIPE, WITH TAG "LS 4756"
- ■ LEAD & TACK NO TAG

SHT. 9 OF 20

CITY OF RANCHO CUCAMONGA — STREET TIE	TRACT NO. 16116
MADOLE AND ASSOCIATES, INC. 760-A S. Rochester Avenue Ontario, CA 91761 Phone (909) 937-9151	BLUE GUM DRIVE ; RIVER BIRCH PLACE
ENGR./L.S. WM. ROARO JASSO	FIELD REVIEW: _____ DATE: _____
ENGR./L.S. No. 4756 EXP.DATE: 09-30-2005	TIE BOOK: 24 PAGE: 119

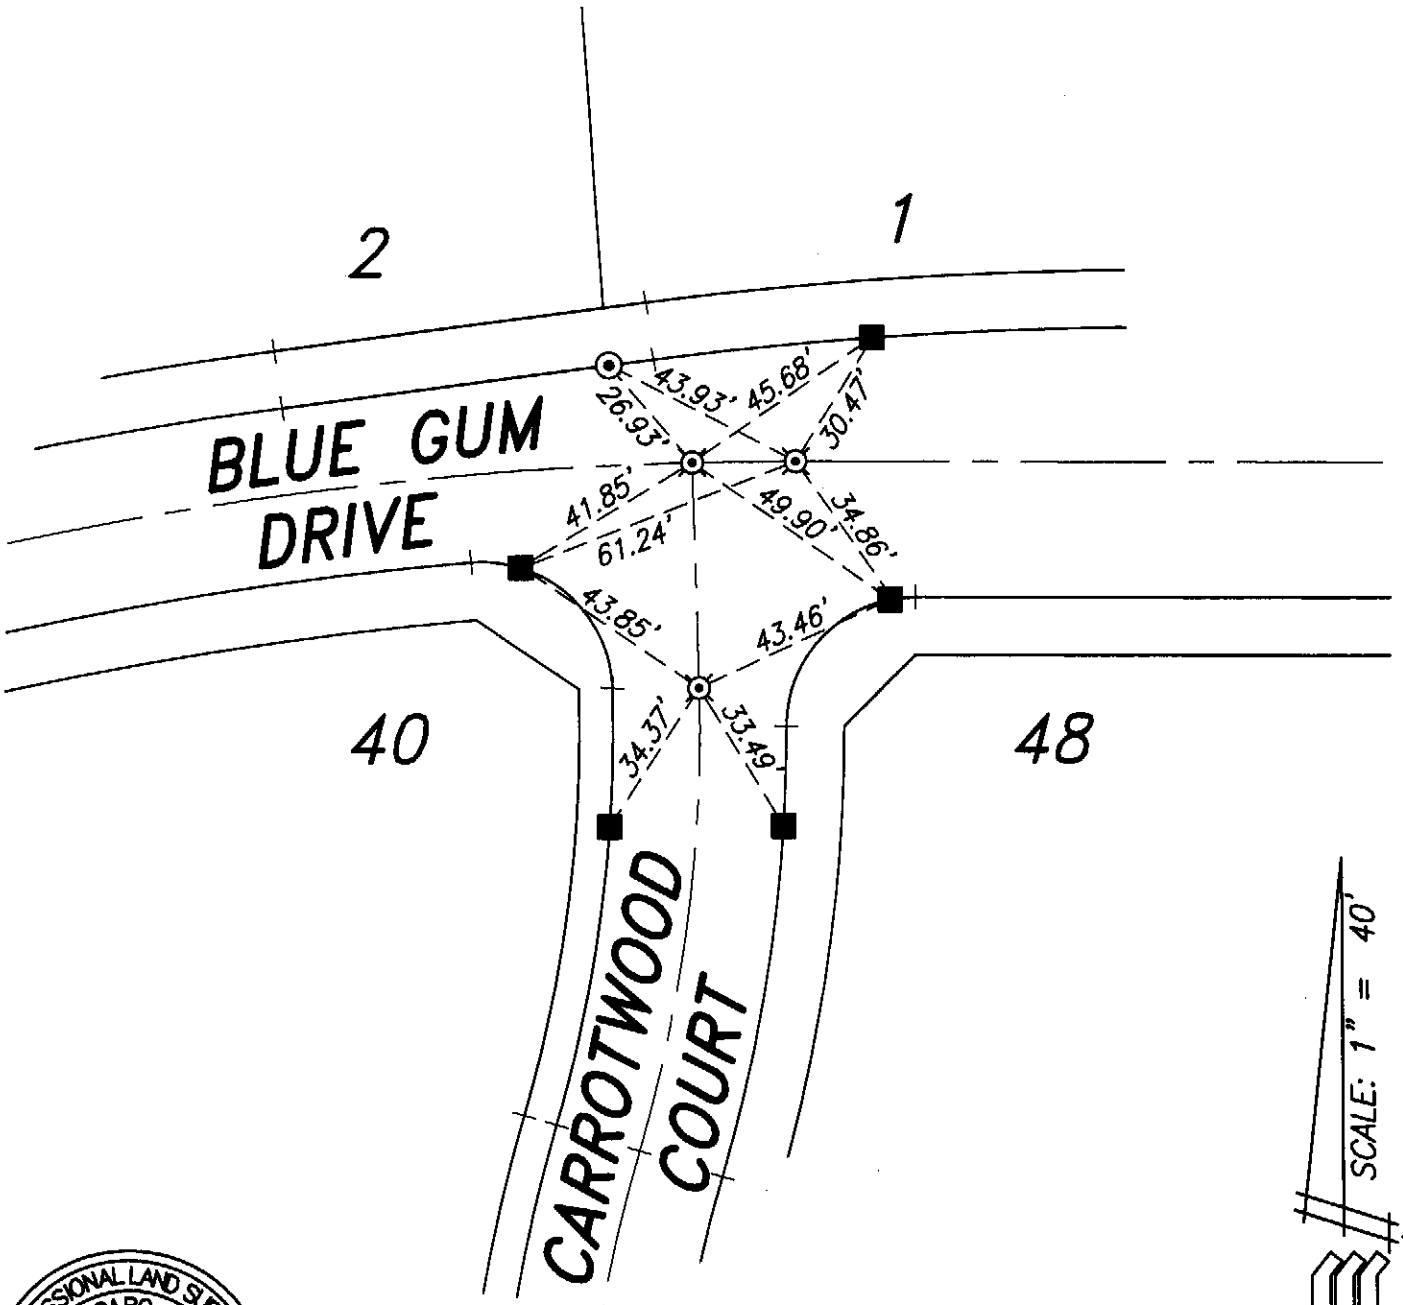

PROFESSIONAL LAND SURVEYOR
WM ROARO JASSO
No. 4756
Exp: 9-30-2005
STATE OF CALIFORNIA
4/17/05

LEGEND

- ⊙ NAIL & TAG "LS 4756"
- ⊗ 1"IRON PIPE, WITH TAG "LS 4756"
- ■ LEAD & TACK NO TAG

SHT. 10 OF 20

CITY OF RANCHO CUCAMONGA — STREET TIE	TRACT NO. 16116
MADOLE AND ASSOCIATES, INC. 760-A S. Rochester Avenue Ontario, CA 91761 Phone (909) 937-9151	BLUE GUM DRIVE & CARROTWOOD CT.
ENGR./L.S. WM. ROARO JASSO	FIELD REVIEW: _____ DATE: _____
ENGR./L.S. No. 4756 EXP.DATE: 09-30-2005	TIE BOOK: 24 PAGE: 120

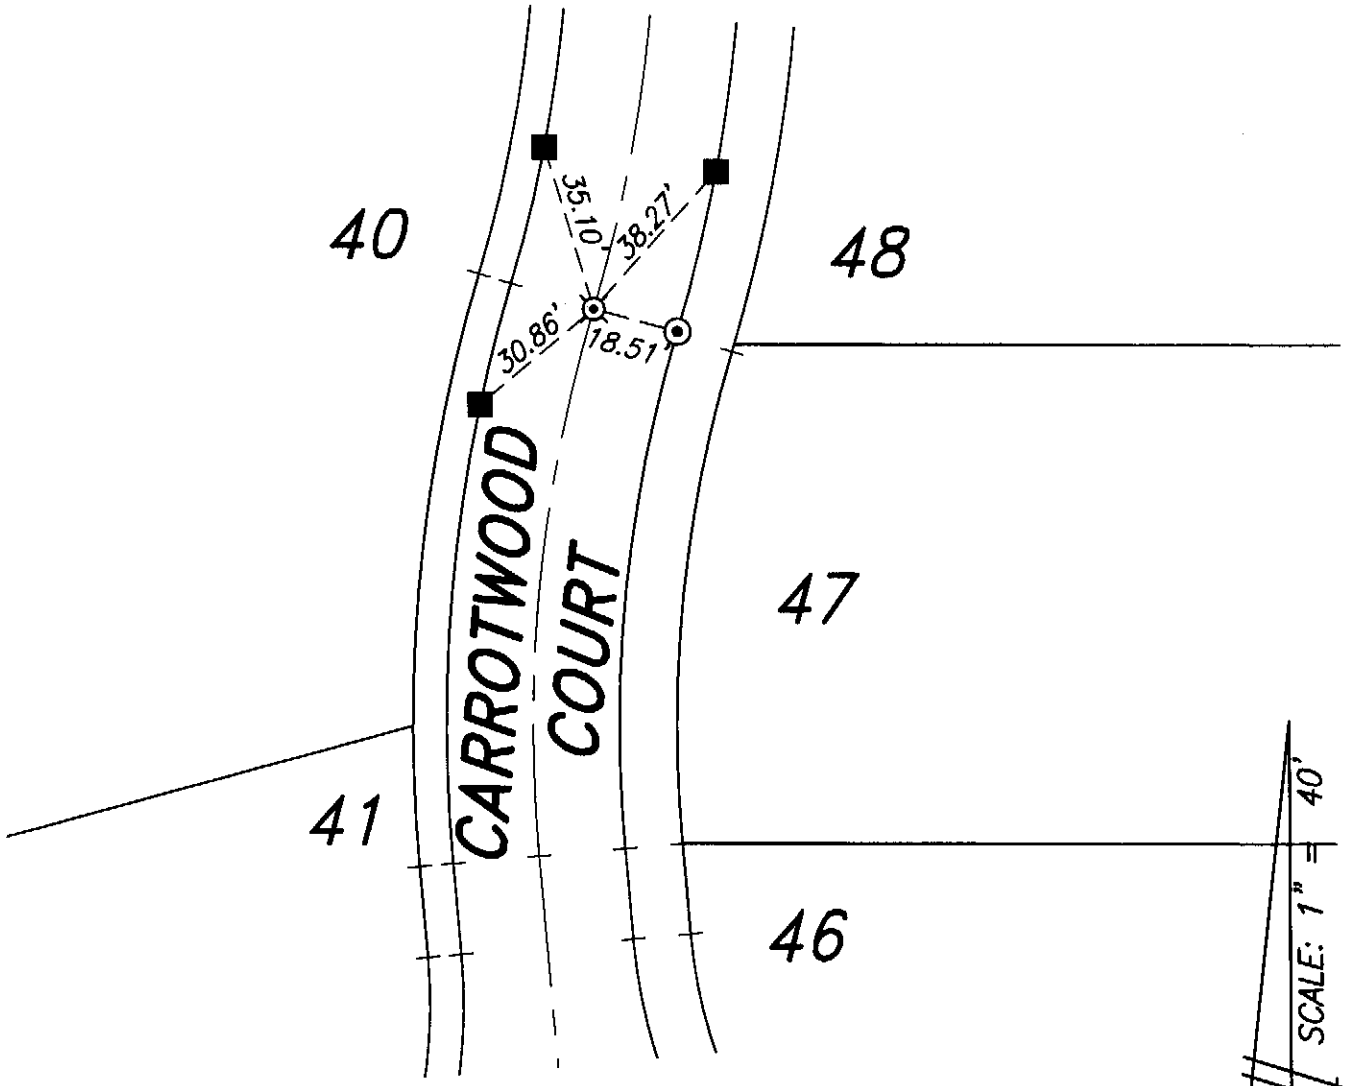

PROFESSIONAL LAND SURVEYOR
WM. ROARO JASSO
No. 4756
Exp: 9-30-2005
STATE OF CALIFORNIA
4/17/05

LEGEND

- ⊙ NAIL & TAG "LS 4756"
- ⊠ 1" IRON PIPE, WITH TAG "LS 4756"
- ■ LEAD & TACK NO TAG

SHT. 11 OF 20

CITY OF RANCHO CUCAMONGA — STREET TIE	TRACT NO. 16116
MADOLE AND ASSOCIATES, INC. 760-A S. Rochester Avenue Ontario, CA 91761 Phone (909) 937-9151	CARROTWOOD CT. S/O BLUE GUM DR.
ENGR./L.S. WM. ROARO JASSO	FIELD REVIEW: _____ DATE: _____
ENGR./L.S. No. 4756 EXP.DATE: 09-30-2005	TIE BOOK: 24 PAGE: 121

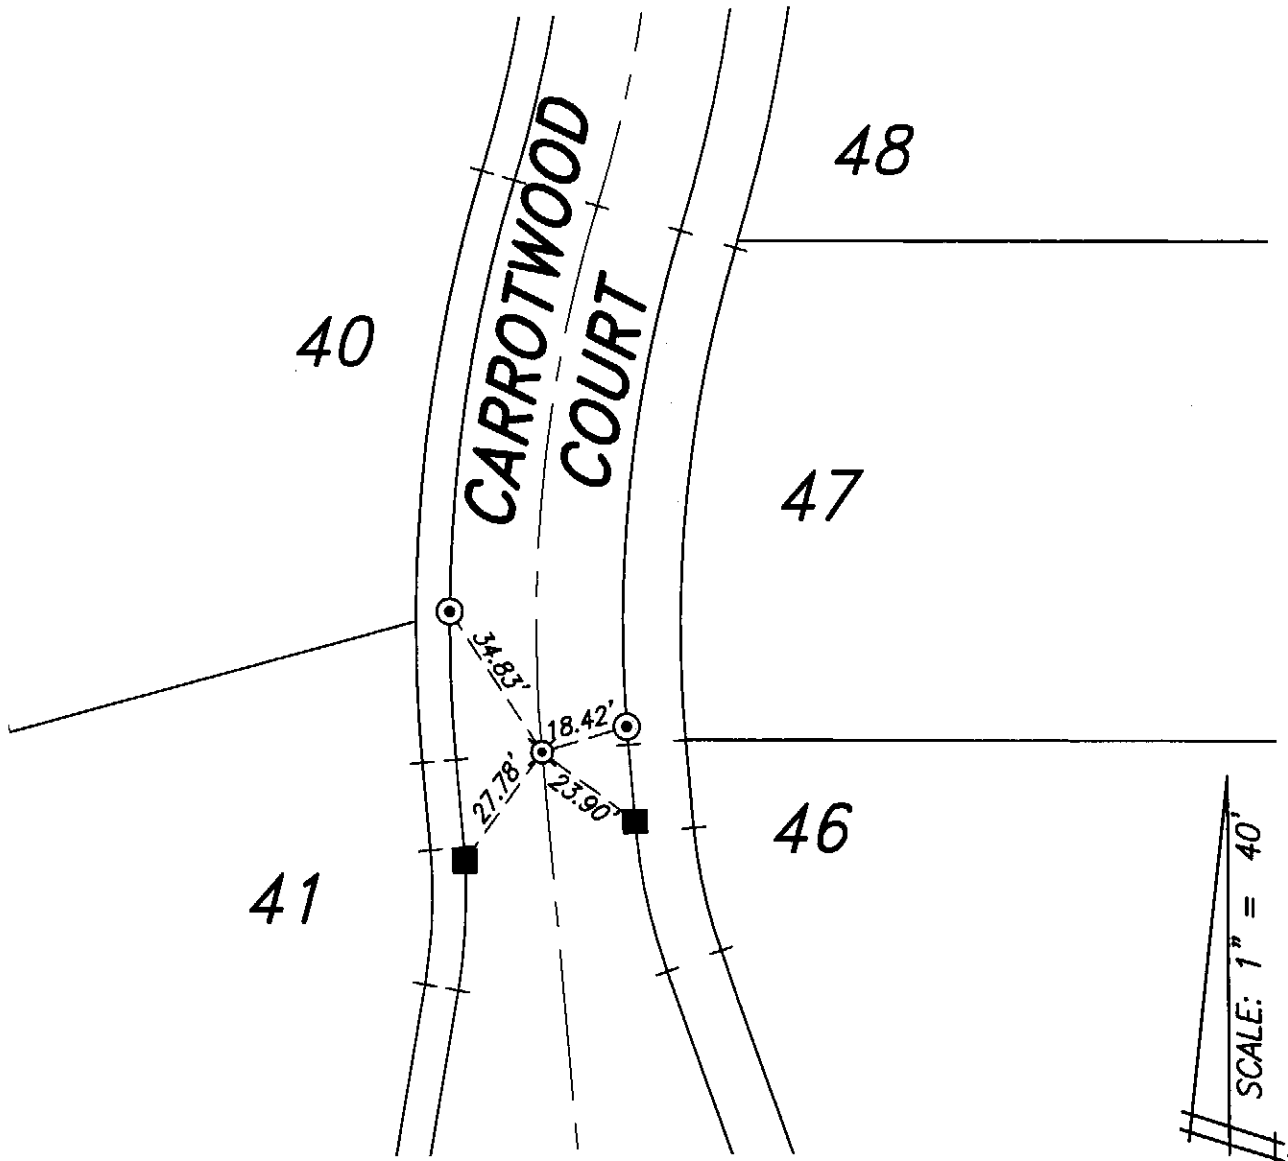

PROFESSIONAL LAND SURVEYOR
WM. ROARO JASSO
No. 4756
Exp: 9-30-2005
STATE OF CALIFORNIA
4/17/05

LEGEND

- NAIL & TAG "LS 4756"
- 1" IRON PIPE, WITH TAG "LS 4756"
- LEAD & TACK NO TAG

SHT. 12 OF 20

CITY OF RANCHO CUCAMONGA — STREET TIE	TRACT NO. 16116
MADOLE AND ASSOCIATES, INC. 760-A S. Rochester Avenue Ontario, CA 91761 Phone (909) 937-9151	CARROTWOOD CT. S/O BLUE GUM
ENGR./L.S. WM. ROARO JASSO	FIELD REVIEW: _____ DATE: _____
ENGR./L.S. No. 4756 EXP.DATE: 09-30-2005	TIE BOOK: 24 PAGE: 122

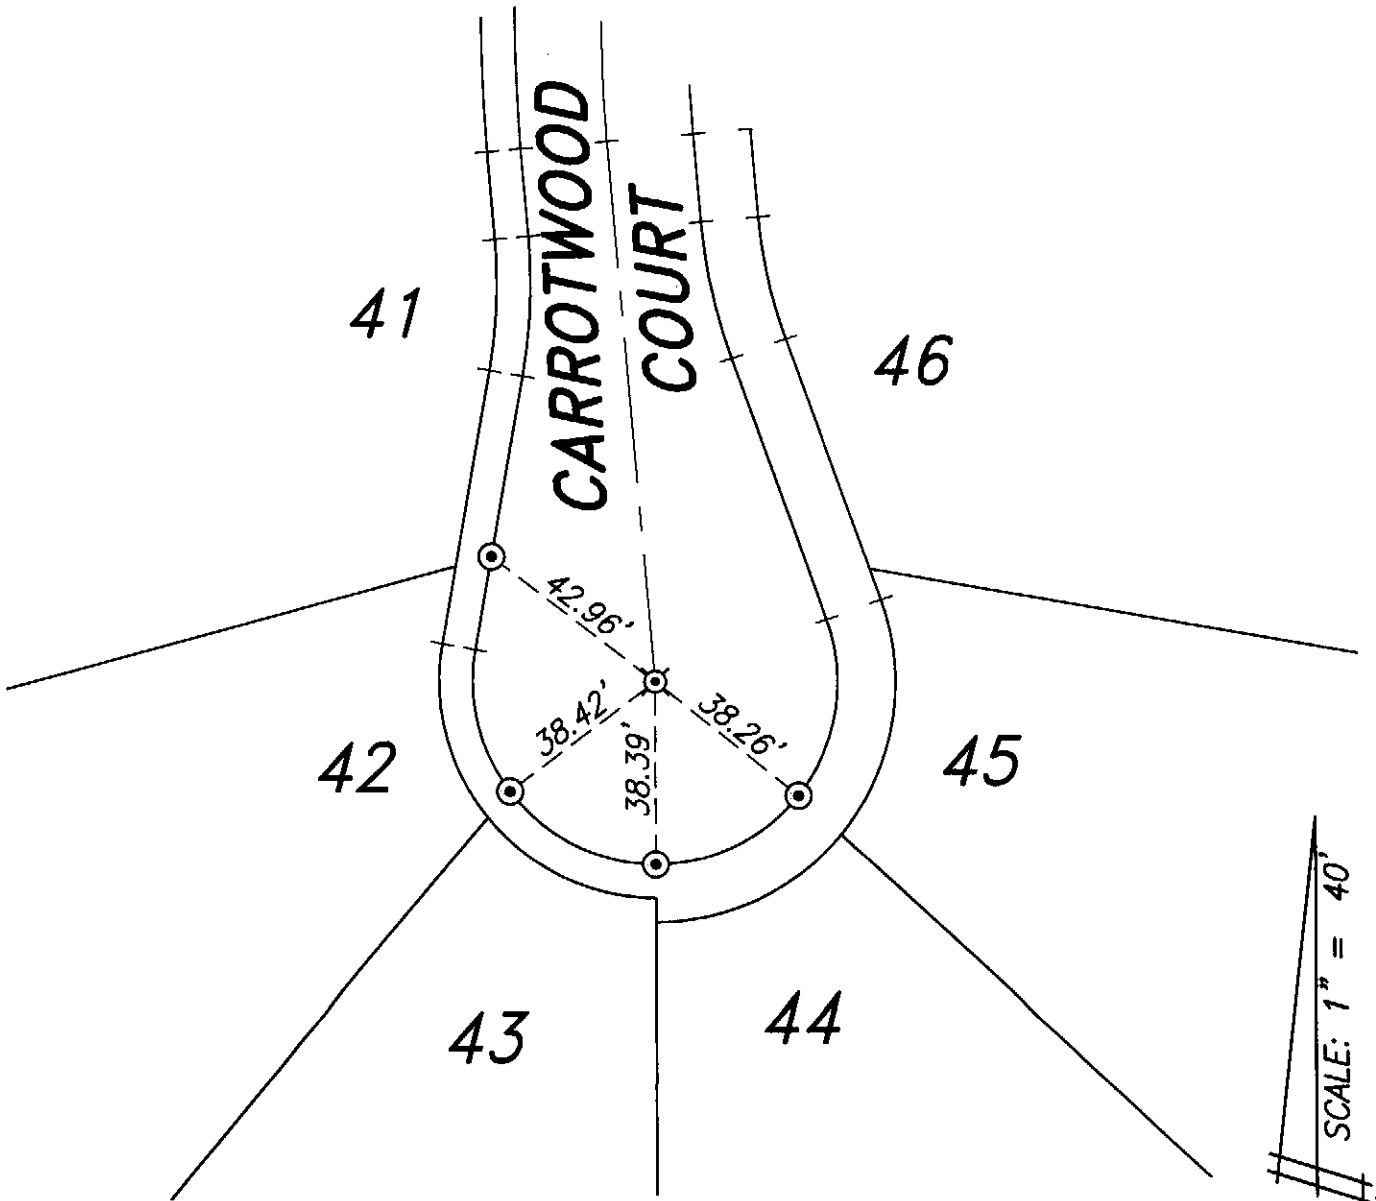

PROFESSIONAL LAND SURVEYOR
WM ROARO JASSO
No. 4756
Exp: 9-30-2005
STATE OF CALIFORNIA
4/17/05

LEGEND
- ⊙ NAIL & TAG "LS 4756"
- ⊠ 1" IRON PIPE, WITH TAG "LS 4756"

SHT. 13 OF 20

CITY OF RANCHO CUCAMONGA — STREET TIE	TRACT NO. 16116
MADOLE AND ASSOCIATES, INC. 760-A S. Rochester Avenue Ontario, CA 91761 Phone (909) 937-9151	CARROTWOOD CT. S/O BLUE GUM DR.
ENGR./L.S. WM. ROARO JASSO	FIELD REVIEW: _____ DATE: _____
ENGR./L.S. No. 4756 EXP.DATE: 09-30-2005	TIE BOOK: 24 PAGE: 123

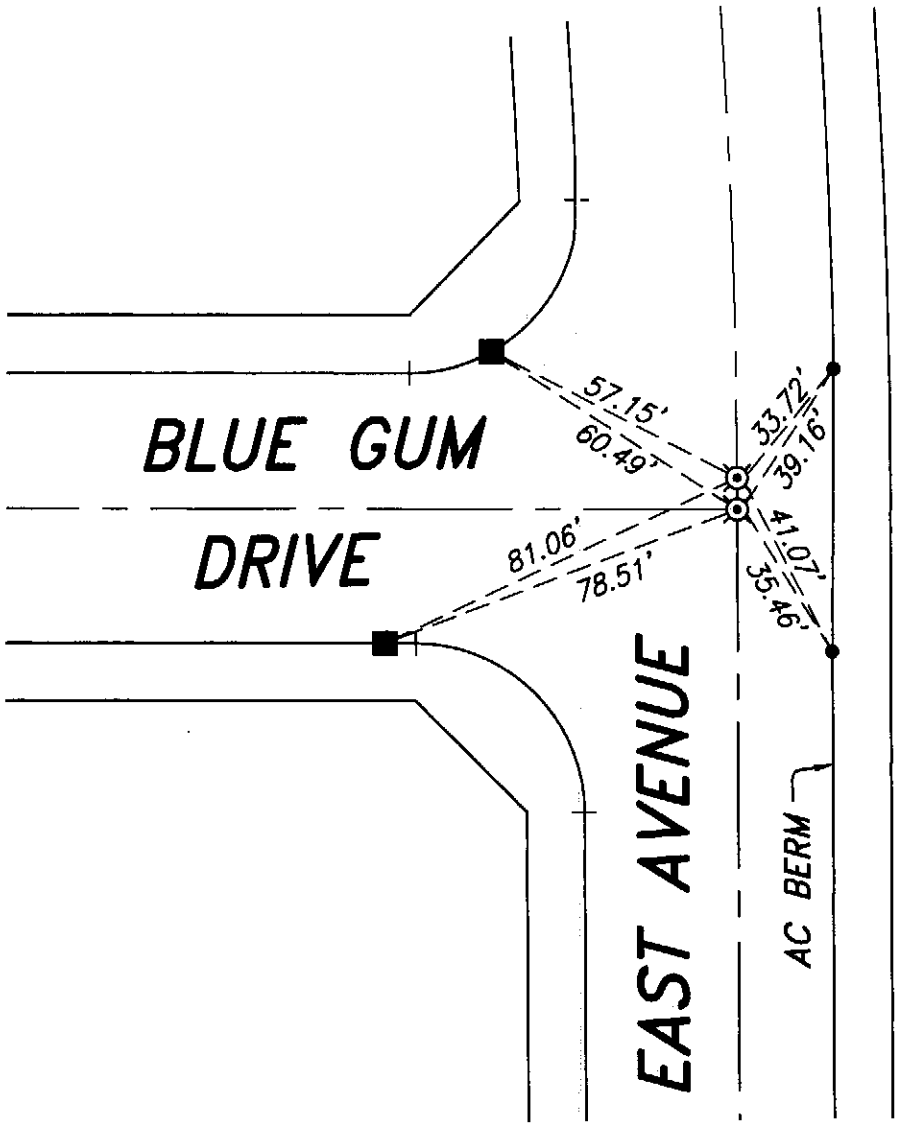

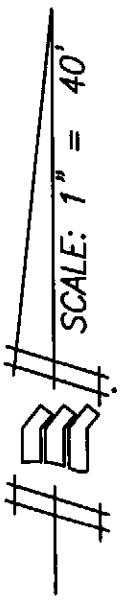

PROFESSIONAL LAND SURVEYOR
WM. ROARO JASSO
No. 4756
Exp: 9-30-2005
STATE OF CALIFORNIA
Wm. Roaro Jasso 4/17/05

LEGEND

- ● PK NAIL, NO TAG
- ⊗ 1"IRON PIPE, WITH TAG "LS 4756"
- ■ LEAD & TACK NO TAG

SHT. 14 OF 20

CITY OF RANCHO CUCAMONGA — STREET TIE	TRACT NO. 16116
MADOLE AND ASSOCIATES, INC. 760-A S. Rochester Avenue Ontario, CA 91761 Phone (909) 937-9151	EAST AVENUE @ BLUE GUM DR.
ENGR./L.S. WM. ROARO JASSO	FIELD REVIEW: _____ DATE: _____
ENGR./L.S. No. 4756 EXP.DATE: 09-30-2005	TIE BOOK: 24 PAGE: 124

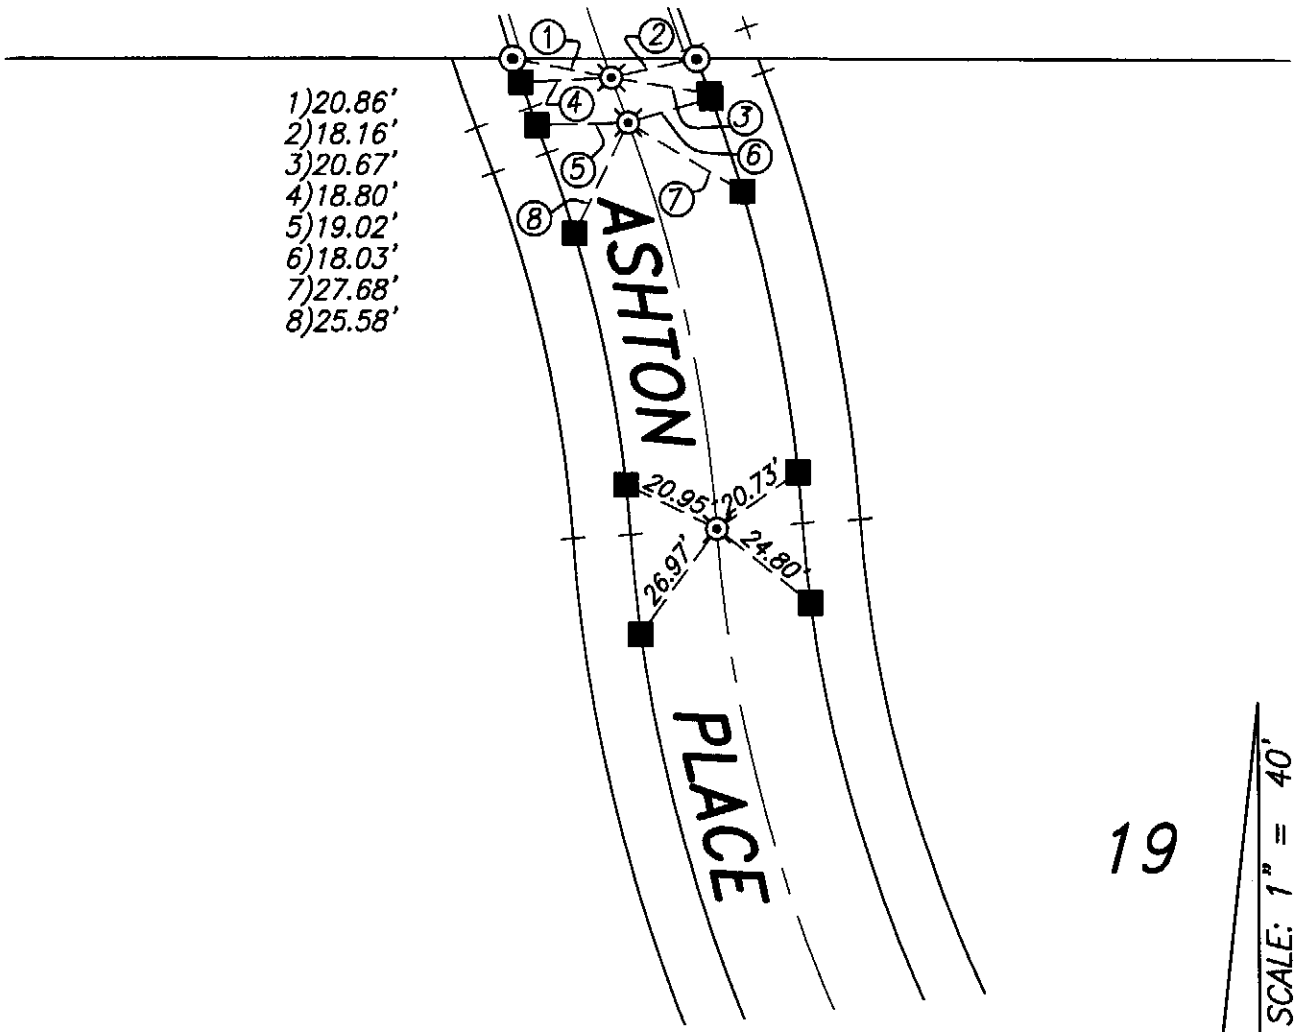

PROFESSIONAL LAND SURVEYOR
WM ROARO JASSO
No. 4756
Exp: 9-30-2005
STATE OF CALIFORNIA
4/17/05

LEGEND

- ⊙ NAIL & TAG "LS 4756"
- ⊠ 1" IRON PIPE, WITH TAG "LS 4756"
- ■ LEAD & TACK NO TAG

SHT. 15 OF 20

CITY OF RANCHO CUCAMONGA — STREET TIE	TRACT NO. 16116
MADOLE AND ASSOCIATES, INC. 760-A S. Rochester Avenue Ontario, CA 91761 Phone (909) 937-9151	N/O TRACT BOUNDRY BLUE GUM DR. ASHTON COURT
ENGR./L.S. WM. ROARO JASSO	FIELD REVIEW: _____ DATE: _____
ENGR./L.S. No. 4756 EXP.DATE: 09-30-2005	TIE BOOK: 24 PAGE: 125

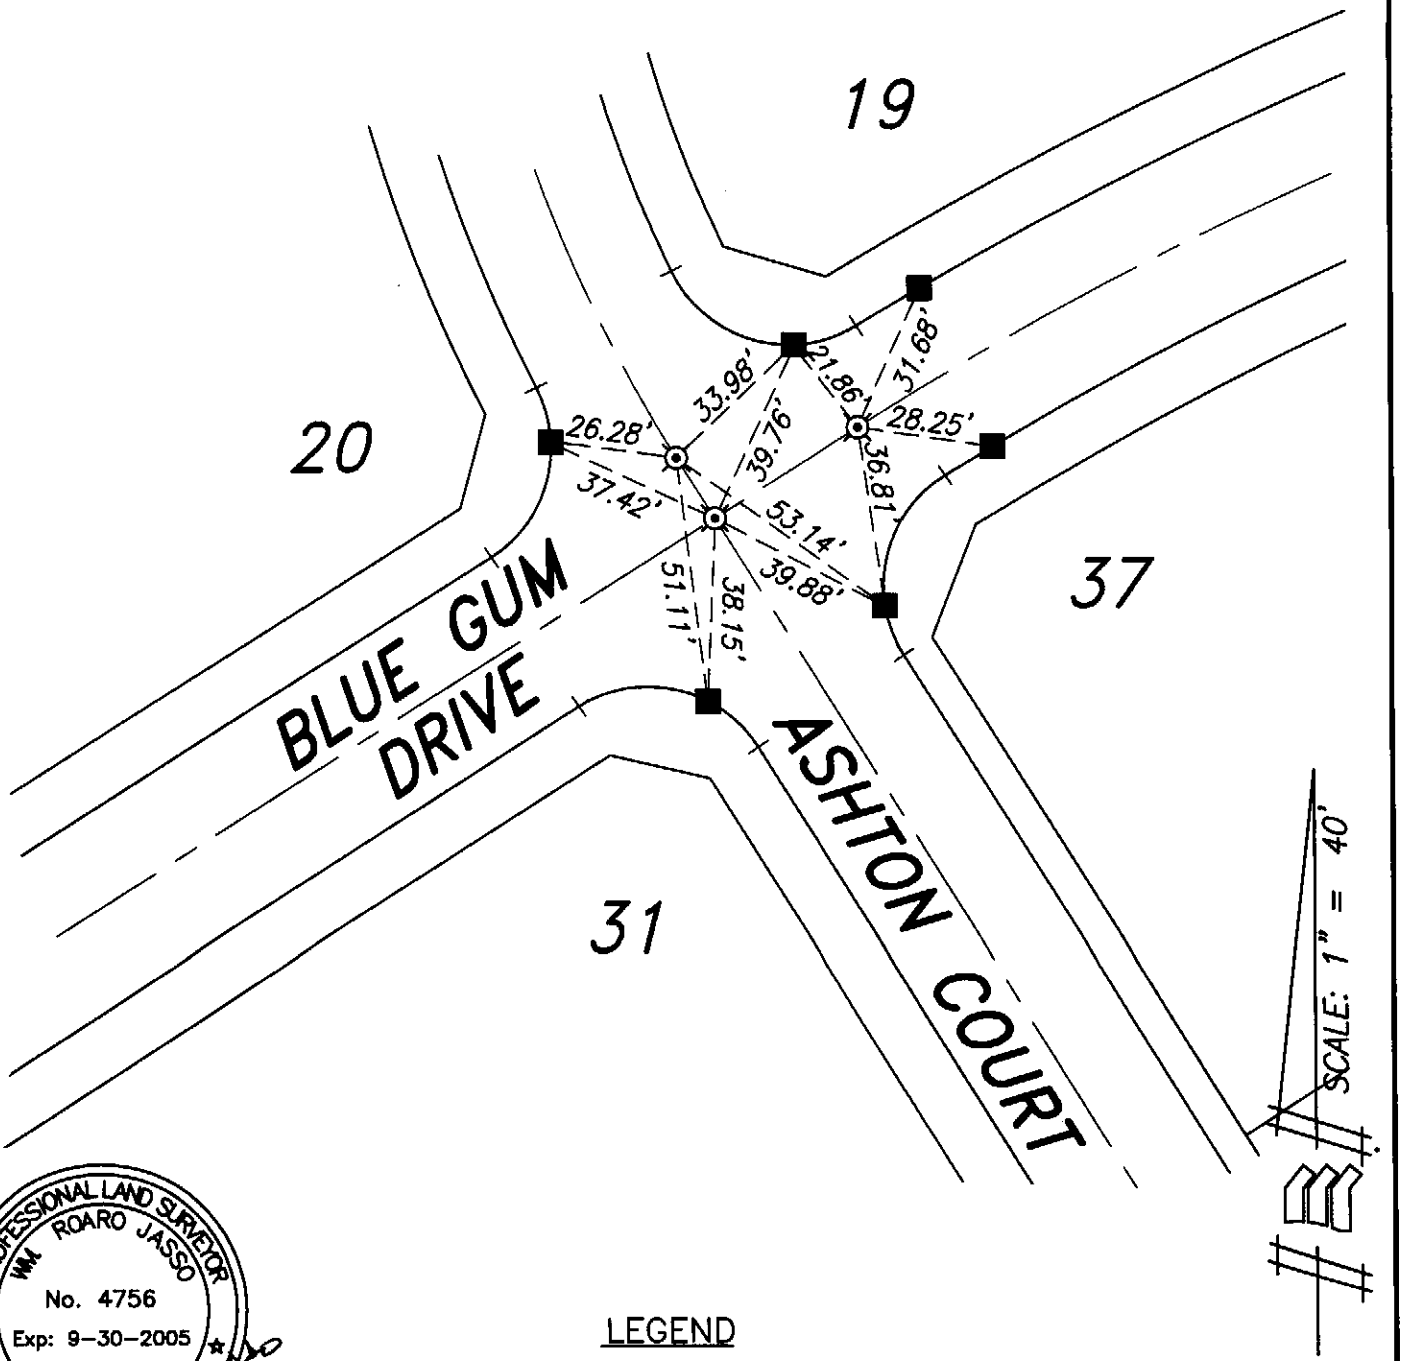

PROFESSIONAL LAND SURVEYOR
WM. ROARO JASSO
No. 4756
Exp: 9-30-2005
STATE OF CALIFORNIA
4/17/05

LEGEND

⊙ 1" IRON PIPE, WITH TAG "LS 4756"

■ LEAD & TACK NO TAG

SHT. 16 OF 20

CITY OF RANCHO CUCAMONGA — STREET TIE	TRACT NO. 16116
MADOLE AND ASSOCIATES, INC. 760-A S. Rochester Avenue Ontario, CA 91761 Phone (909) 937-9151	BLUE GUM DRIVE Ⓐ ASHTON CT.
ENGR./L.S. WM. ROARO JASSO	FIELD REVIEW: _____ DATE: _____
ENGR./L.S. No. 4756 EXP.DATE: 09-30-2005	TIE BOOK: 24 PAGE: 126

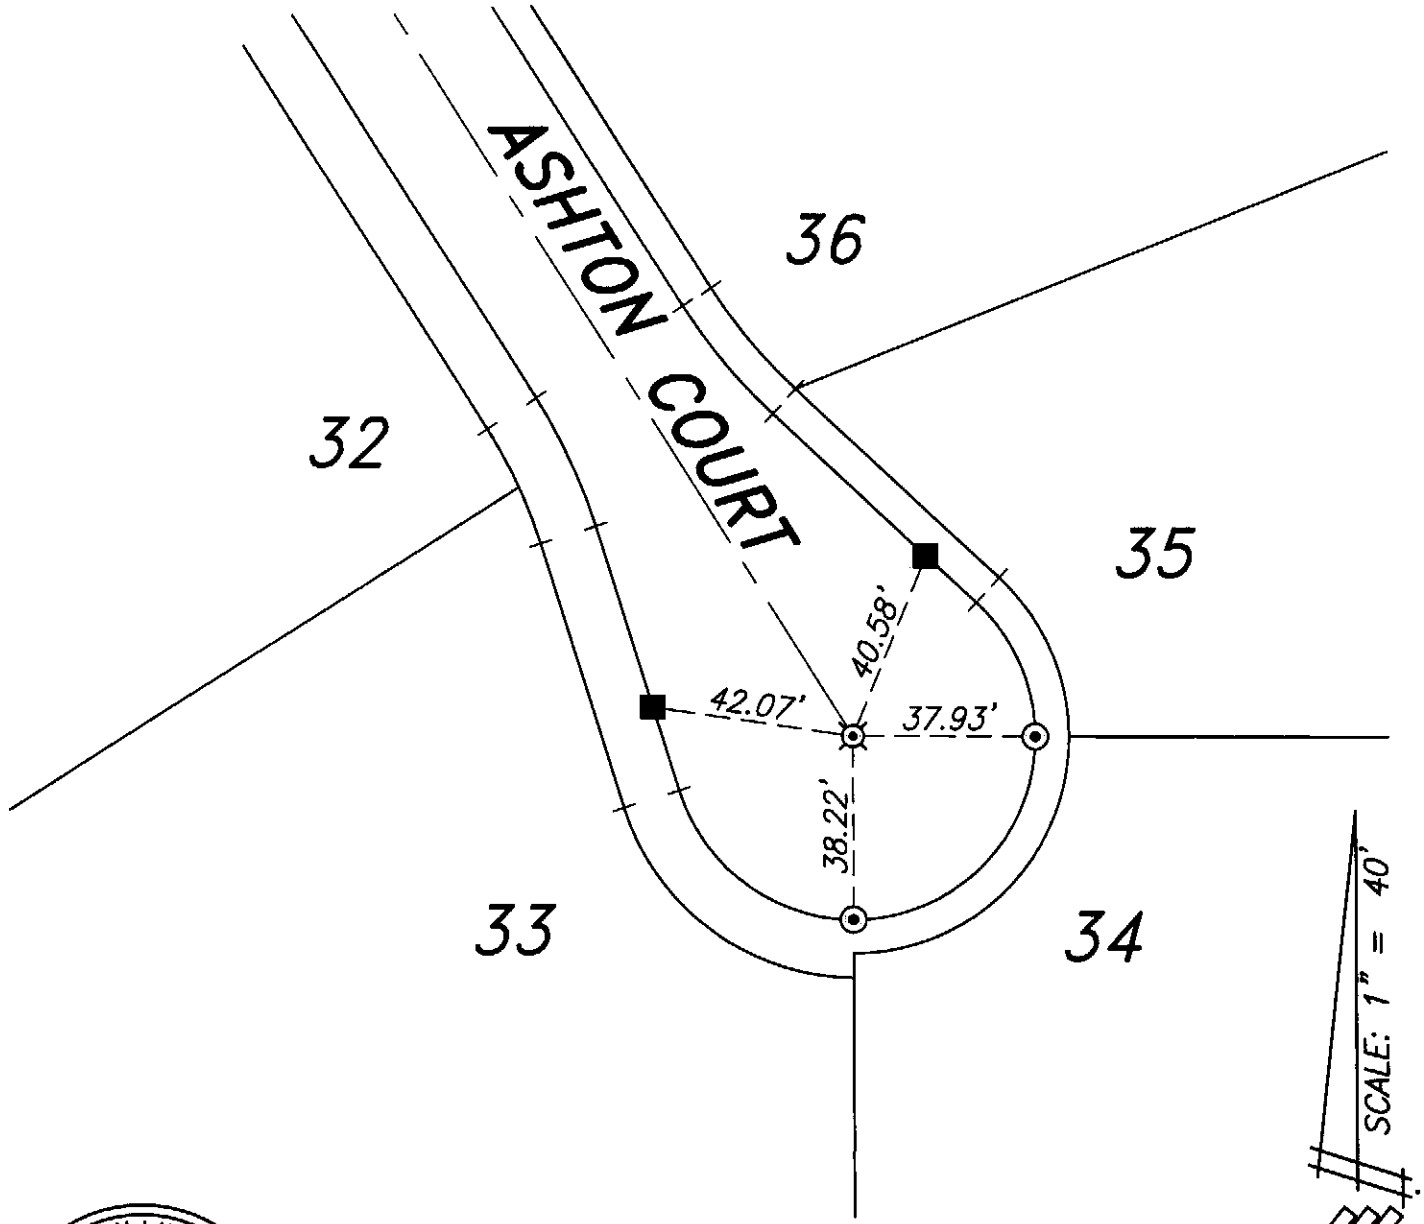

PROFESSIONAL LAND SURVEYOR
WM. ROARO JASSO
No. 4756
Exp: 9-30-2005
STATE OF CALIFORNIA
4/17/05

LEGEND

- ⊙ NAIL & TAG "LS 4756"
- ⊗ 1" IRON PIPE, WITH TAG "LS 4756"
- ■ LEAD & TACK NO TAG

SHT. 17 OF 20

CITY OF RANCHO CUCAMONGA — STREET TIE	TRACT NO. 16116
MADOLE AND ASSOCIATES, INC. 760-A S. Rochester Avenue Ontario, CA 91761 Phone (909) 937-9151	ASHTON COURT S/O BLUE GUM DR.
ENGR./L.S. WM. ROARO JASSO	FIELD REVIEW: _____ DATE: _____
ENGR./L.S. No. 4756 EXP.DATE: 09-30-2005	TIE BOOK: 24 PAGE: 127

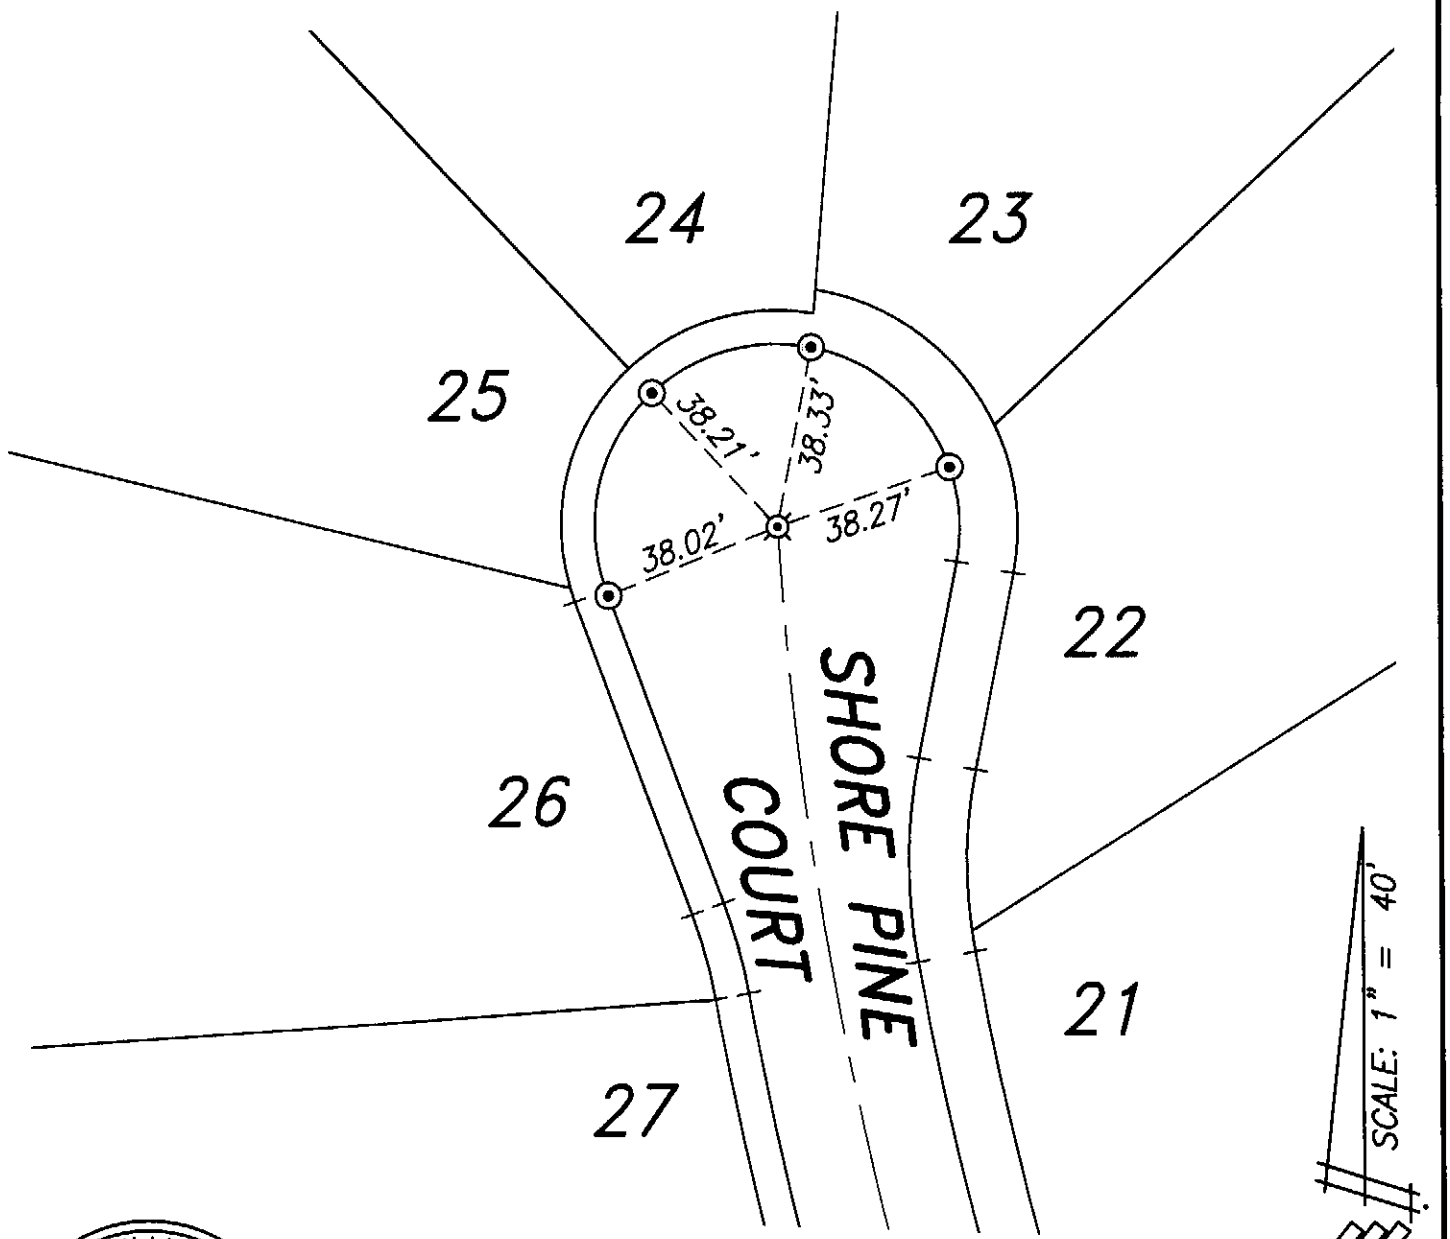

PROFESSIONAL LAND SURVEYOR
WM ROARO JASSO
No. 4756
Exp: 9-30-2005
STATE OF CALIFORNIA
4/17/05

LEGEND

- ⊙ NAIL & TAG "LS 4756"
- ⊠ 1"IRON PIPE, WITH TAG "LS 4756"

SHT. 18 OF 20

CITY OF RANCHO CUCAMONGA — STREET TIE	TRACT NO. 16116
MADOLE AND ASSOCIATES, INC. 760-A S. Rochester Avenue Ontario, CA 91761 Phone (909) 937-9151	SHORE PINE CT. N/o BLUE GUM CT.
ENGR./L.S. WM. ROARO JASSO	FIELD REVIEW: _____ DATE: _____
ENGR./L.S. No. 4756 EXP.DATE: 09-30-2005	TIE BOOK: 24 PAGE: 128

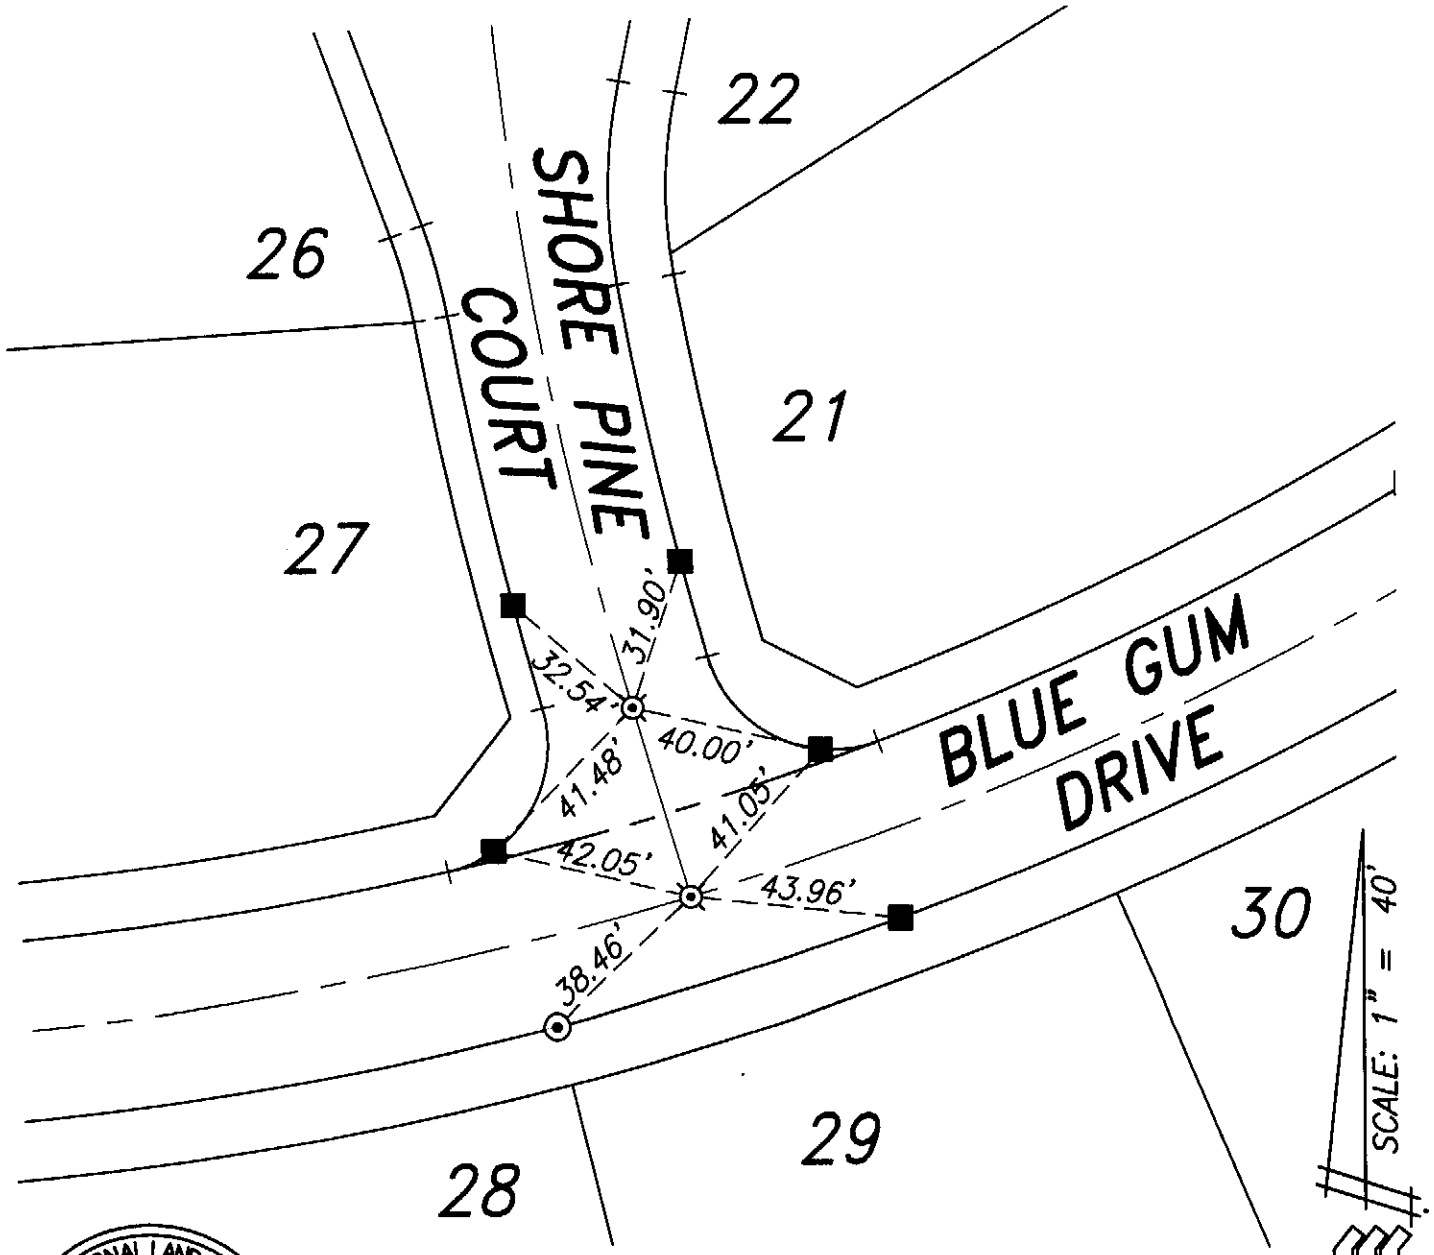

PROFESSIONAL LAND SURVEYOR
WM. ROARO JASSO
No. 4756
Exp: 9-30-2005
STATE OF CALIFORNIA
4/17/05

LEGEND

- NAIL & TAG "LS 4756"
- 1" IRON PIPE, WITH TAG "LS 4756"
- LEAD & TACK NO TAG

SHT. 19 OF 20

CITY OF RANCHO CUCAMONGA — STREET TIE	TRACT NO. 16116
MADOLE AND ASSOCIATES, INC. 760-A S. Rochester Avenue Ontario, CA 91761 Phone (909) 937-9151	BLUE GUM DRIVE @ SHORE PINE CT.
ENGR./L.S. WM. ROARO JASSO	FIELD REVIEW: _____ DATE: _____
ENGR./L.S. No. 4756 EXP.DATE: 09-30-2005	TIE BOOK: 24 PAGE: 129

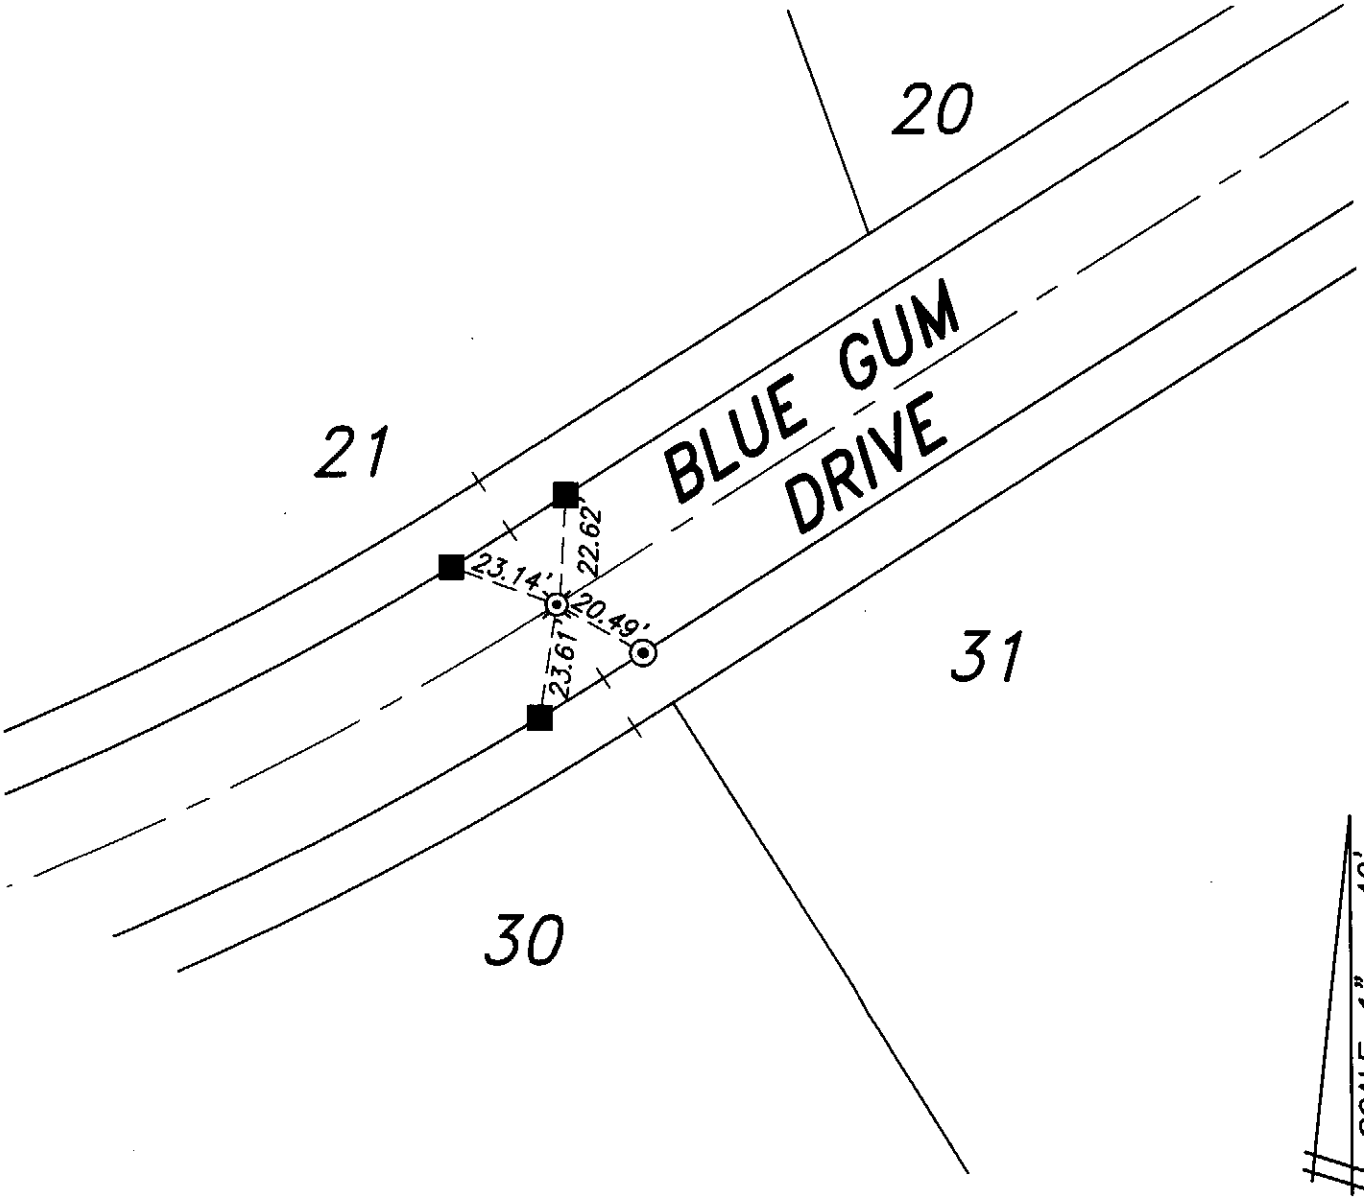

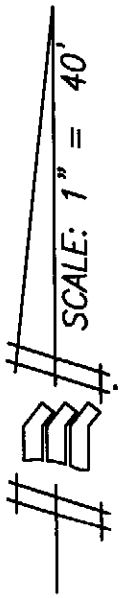

PROFESSIONAL LAND SURVEYOR
WM. ROARO JASSO
No. 4756
Exp: 9-30-2005
STATE OF CALIFORNIA

LEGEND

- ⊙ NAIL & TAG "LS 4756"
- ⊠ 1"IRON PIPE, WITH TAG "LS 4756"
- ■ LEAD & TACK NO TAG

SHT. 20 OF 20

CITY OF RANCHO CUCAMONGA — STREET TIE	TRACT NO. 16116
MADOLE AND ASSOCIATES, INC. 760-A S. Rochester Avenue Ontario, CA 91761 Phone (909) 937-9151	BLUE GUM DR. E/O SHORE PINE CT.
ENGR./L.S. WM. ROARO JASSO	FIELD REVIEW: _____ DATE: _____
ENGR./L.S. No. 4756 EXP.DATE: 09-30-2005	TIE BOOK: 24 PAGE: 130

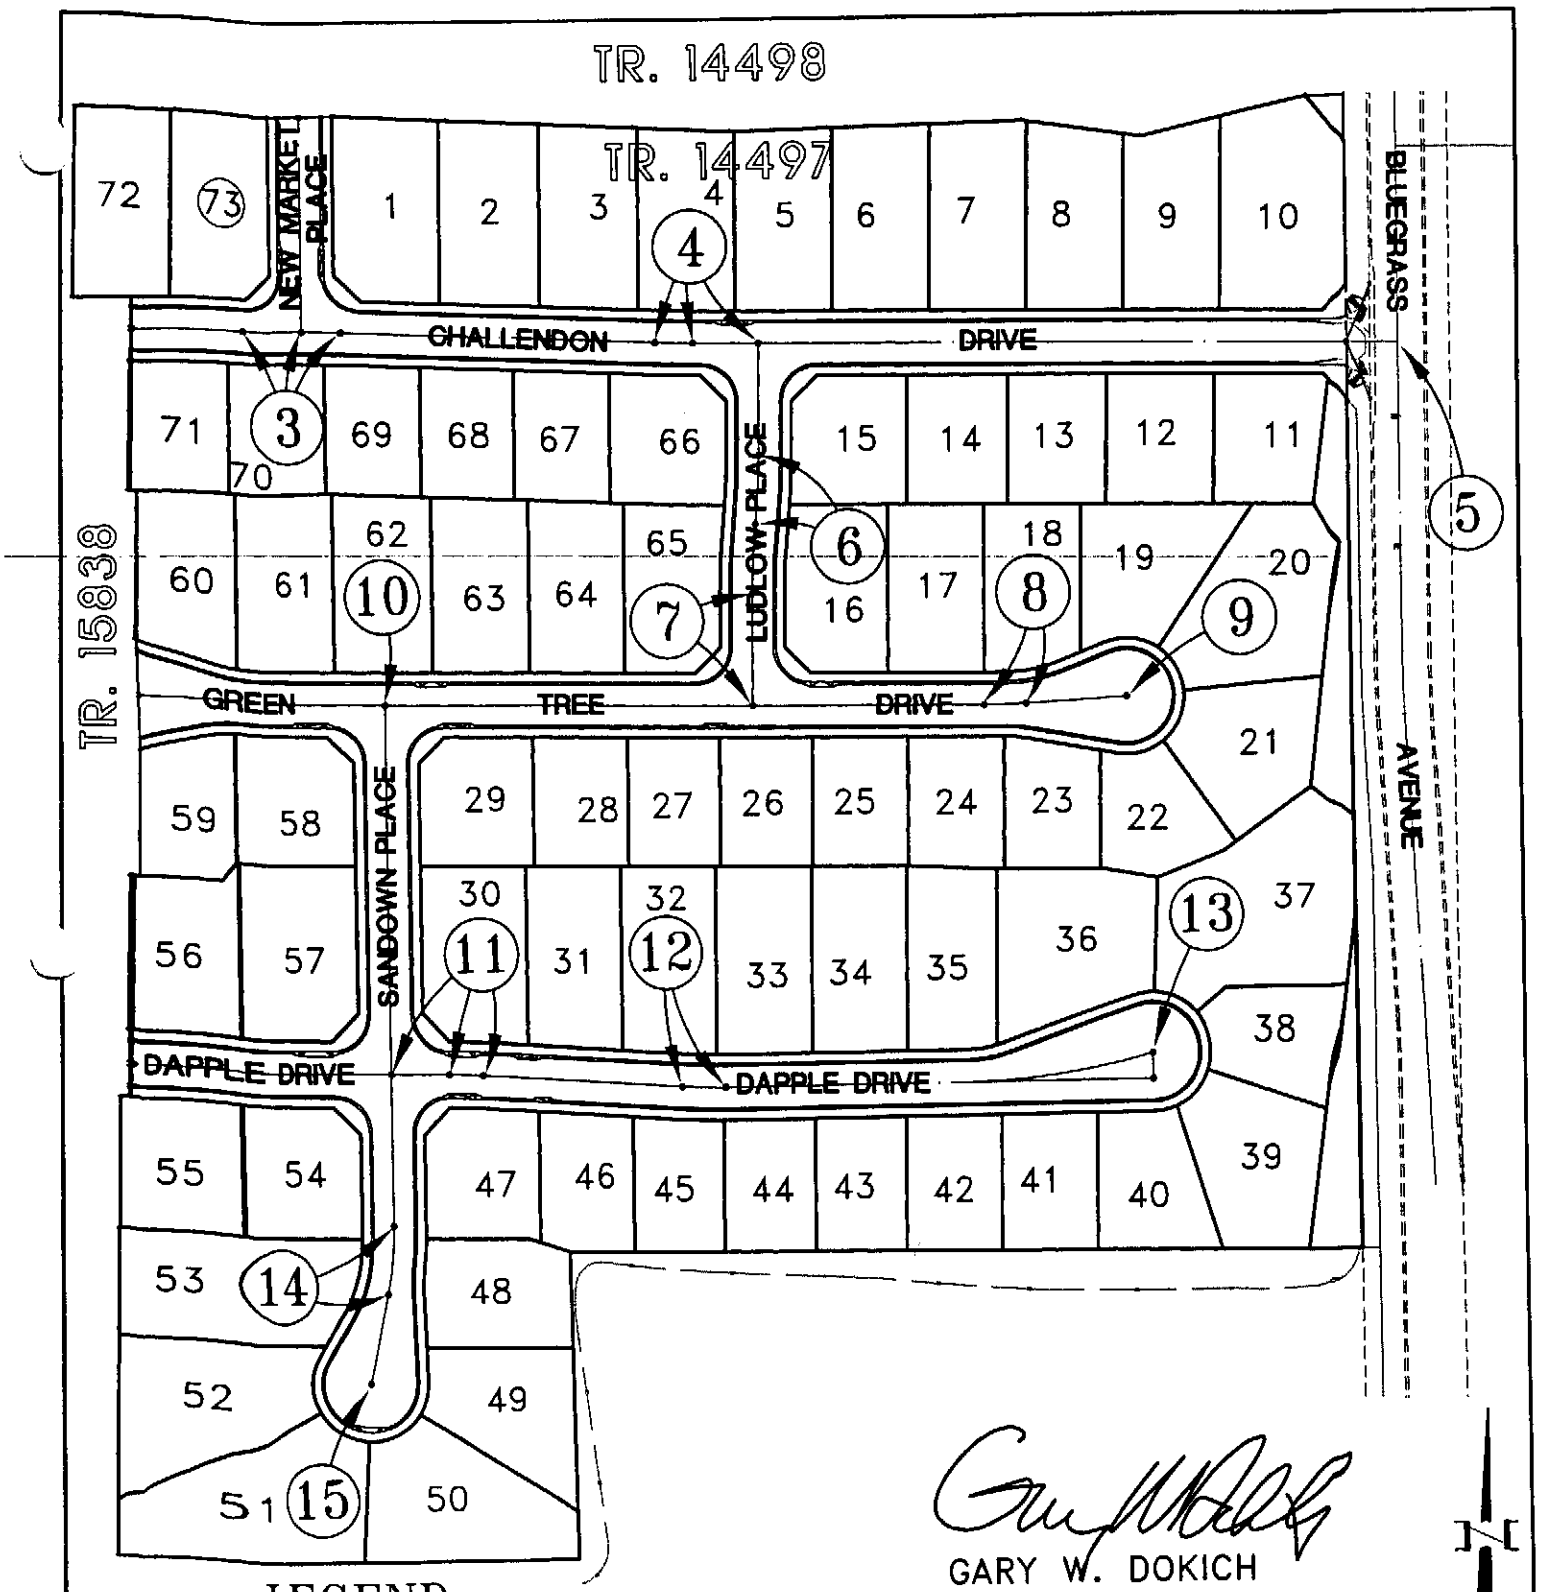

GARY W. DOKICH
L.S. 4693 EXP. 9-30-05

LEGEND :

(4) DENOTES SHEET NUMBERS

TIE BOOK 24 PAGE 131


PUBLIC WORKS DEPARTMENT

MDS CONSULTING
PLANNERS ENGINEERS SURVEYORS
MOSSE DOKICH SCHULTZ
17320 Redhill Ave. Suite 350 Irvine, CA 92614
Voice: 949-251-8821 FAX: 949-251-0516

2 OF 15

CENTERLINE TIES - TRACT NO. 14497

SCALE: 1"=150'

DATE: 6-2-05

I:\centies\1449~7\497-02.dwg 6/01/05

LEGEND :

- INDICATES SPIKE AND WASHER STAMPED "L.S. 4693"
- INDICATES LEAD, TACK AND TAG STAMPED "L.S. 4693" IN TOP OF CURB
- INDICATES LEAD & BRASS TACK IN TOP OF CURB

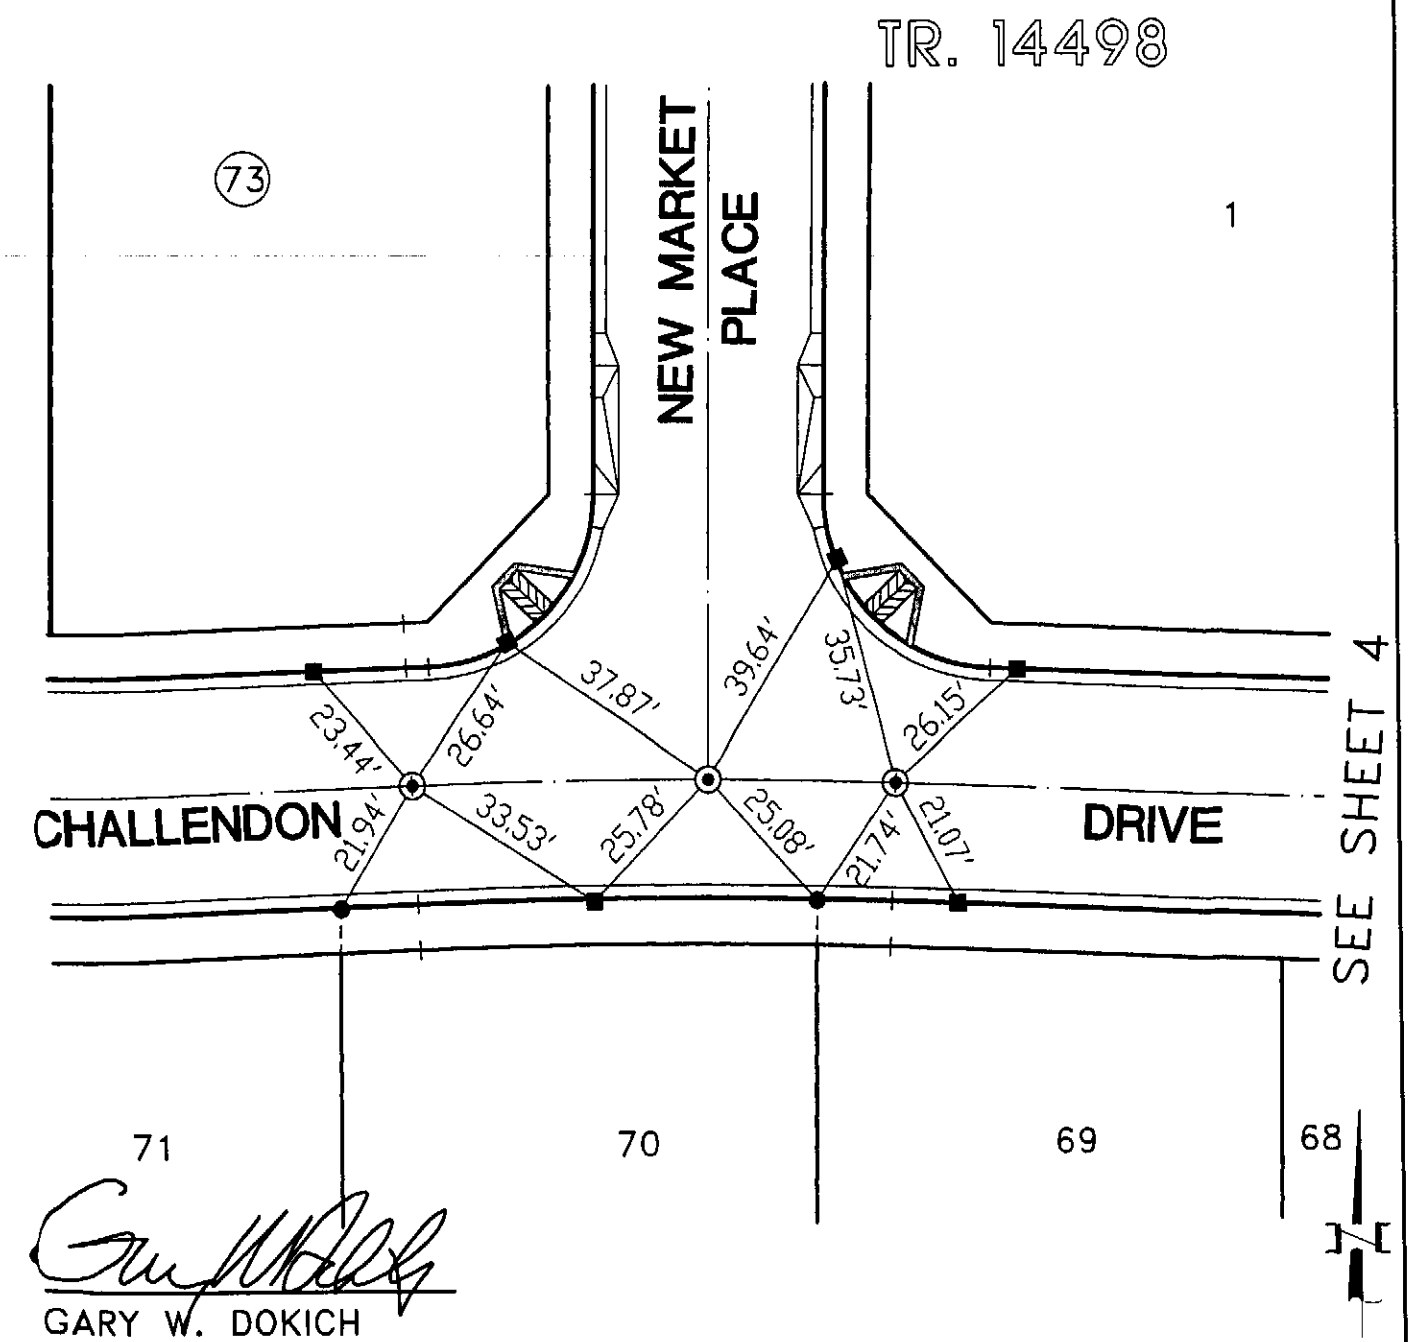

GARY W. DOKICH
L.S. 4693 EXP. 9-30-05

TIE BOOK 24 PAGE 132

CITY OF RANCHO CUCAMONGA
PUBLIC WORKS DEPARTMENT

MDS CONSULTING
MORSE DOKICH SCHULTZ
17320 Redhill Ave. Suite 350 Irvine, CA 92614 Voice: 949-251-8921 FAX: 949-251-0316
PLANNERS ENGINEERS SURVEYORS

3 OF 15

CENTERLINE TIES - TRACT NO. 14497

SCALE: 1"=30'

DATE: 6-2-05

I:\centies\14497\497-03.dwg 6/01/05

LEGEND :

- ⊙ INDICATES SPIKE AND WASHER STAMPED "L.S. 4693"
- ● INDICATES LEAD, TACK AND TAG STAMPED "L.S. 4693" IN TOP OF CURB
- ■ INDICATES LEAD & BRASS TACK IN TOP OF CURB

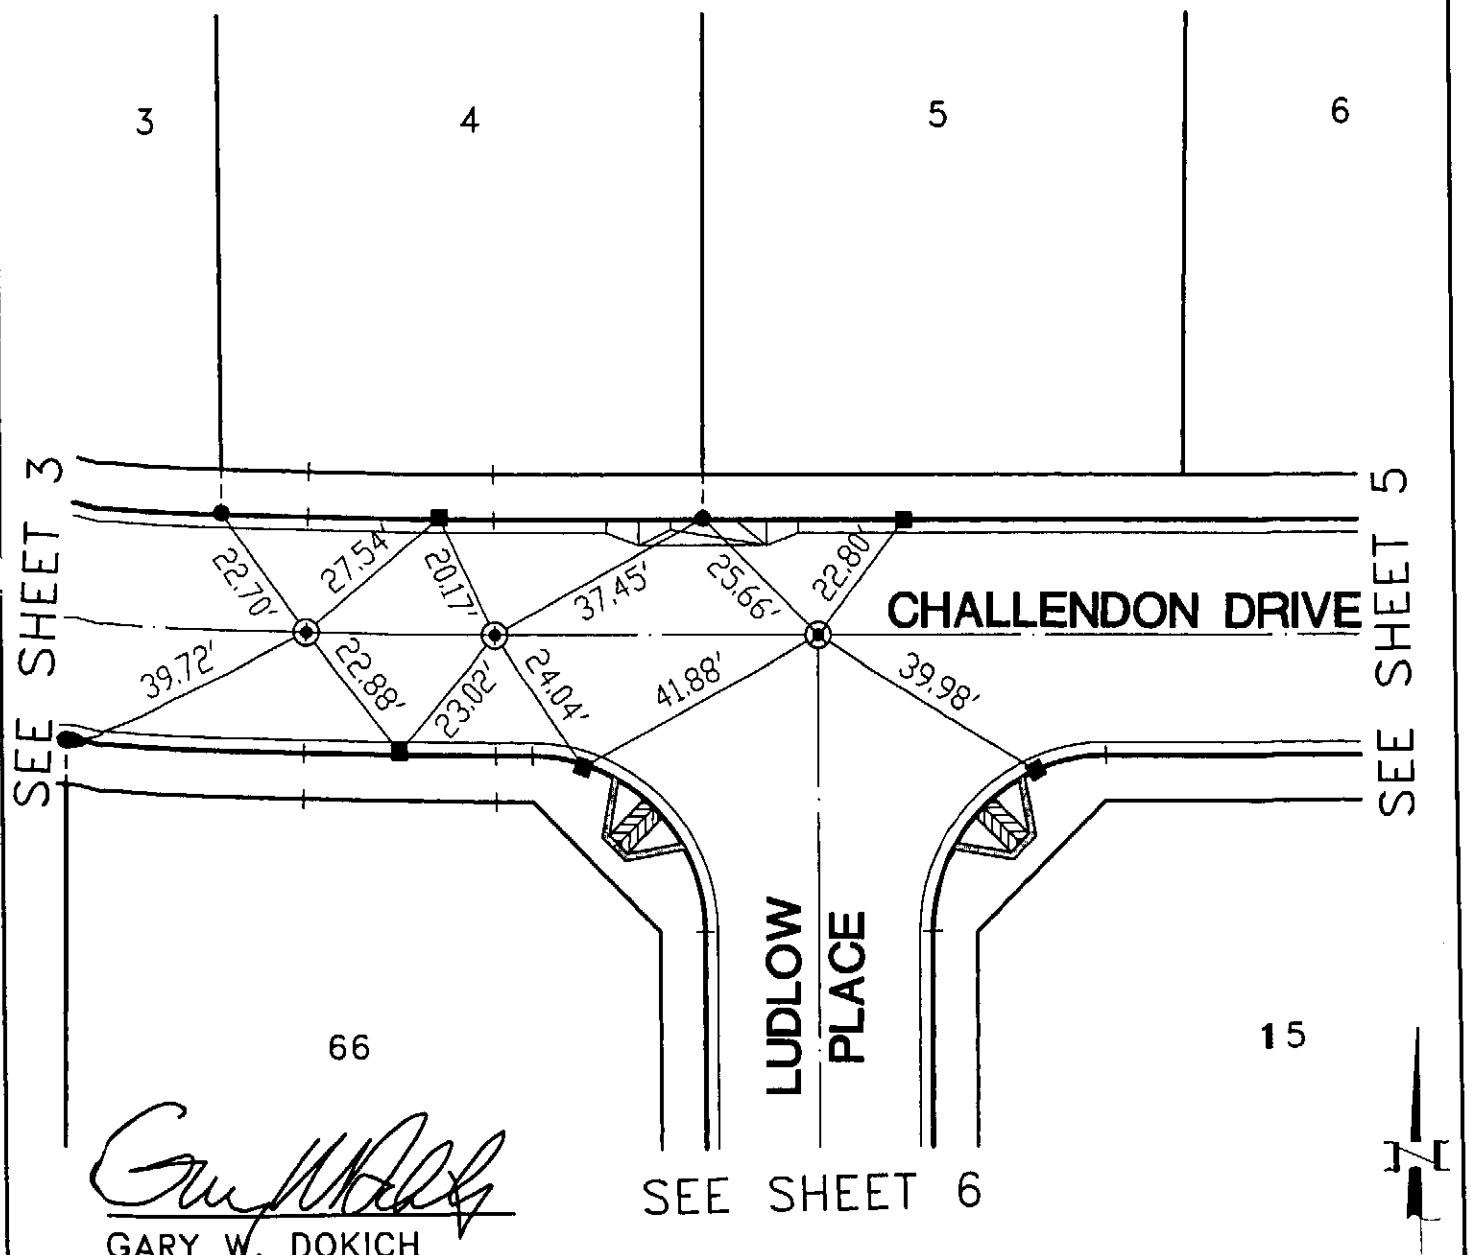

GARY W. DOKICH
L.S. 4693 EXP. 9-30-05

TIE BOOK 24 PAGE 133

CITY OF RANCHO CUCAMONGA
PUBLIC WORKS DEPARTMENT

MDS CONSULTING
HORST DOKICH SCHULTZ
17320 Redhill Ave. Suite 350 Irvine, CA 92614 Voice: 949-251-8821 FAX: 949-251-0516
PLANNERS ENGINEERS SURVEYORS

4 OF 15

CENTERLINE TIES – TRACT NO. 14497

SCALE: 1"=30'

DATE: 6-2-05

I:\centies\14497\497-04.dwg 6/01/05

LEGEND :

⦿ INDICATES SPIKE AND WASHER STAMPED "L.S. 4693"

■ INDICATES LEAD & BRASS TACK IN TOP OF CURB

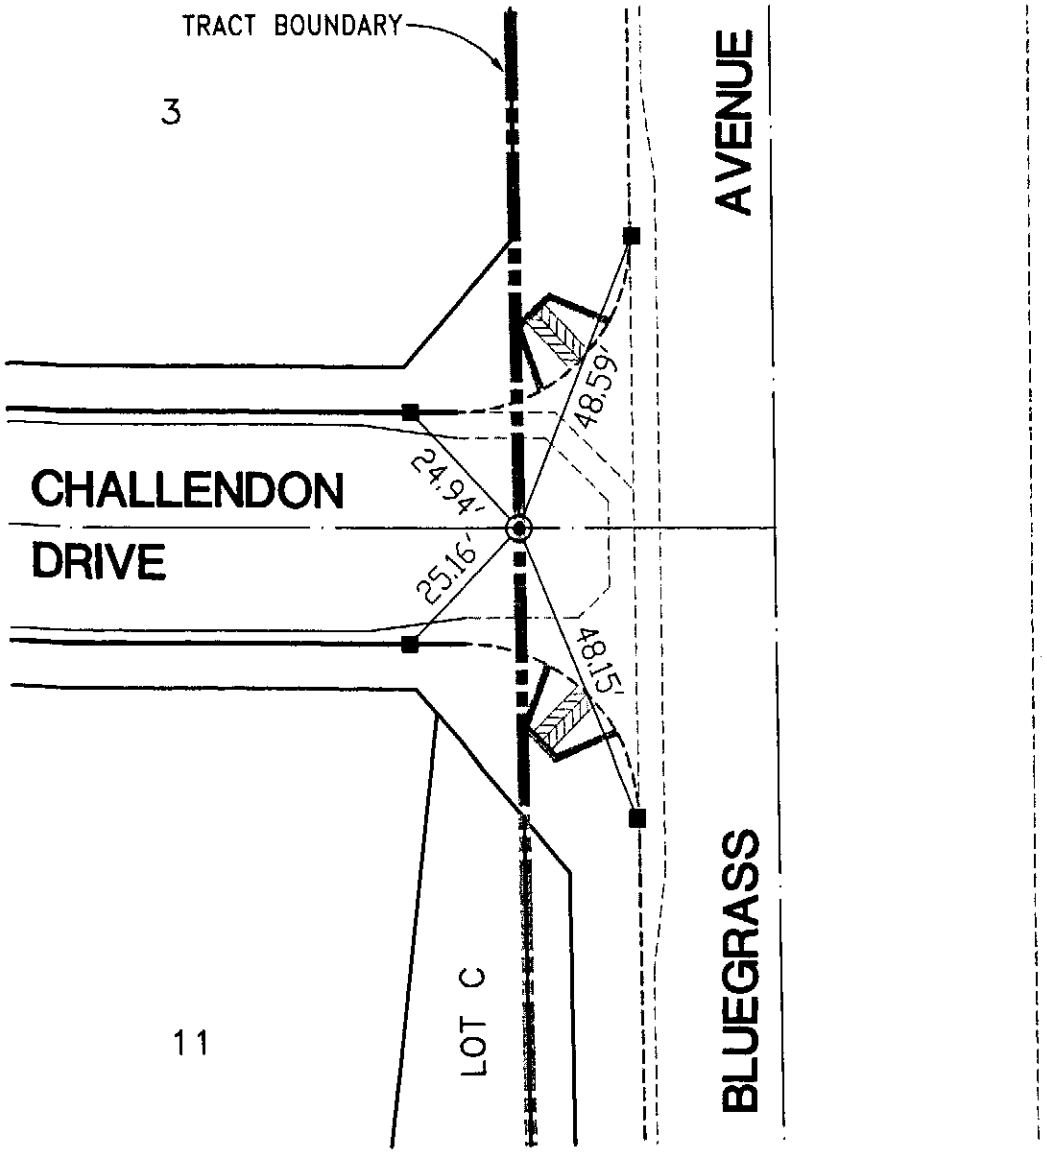

GARY W. DOKICH
L.S. 4693 EXP. 9-30-05

TIE BOOK 24 PAGE 134

CITY OF RANCHO CUCAMONGA
PUBLIC WORKS DEPARTMENT

MDS CONSULTING
MOBEE DOKICH SCHULTZ
17320 Redhill Ave. Suite 350 Irvine, CA 92614 Voice: 949-251-8821 FAX: 949-251-0514
PLANNERS ENGINEERS SURVEYORS

5 OF 15

CENTERLINE TIES - TRACT NO. 14497

SCALE: 1"=30'

DATE: 6-2-05

I:\centies\14497\497-05.dwg 6/01/05

LEGEND :

- ⊙ INDICATES SPIKE AND WASHER STAMPED "L.S. 4693"
- ● INDICATES LEAD, TACK AND TAG STAMPED "L.S. 4693" IN TOP OF CURB
- ■ INDICATES LEAD & BRASS TACK IN TOP OF CURB

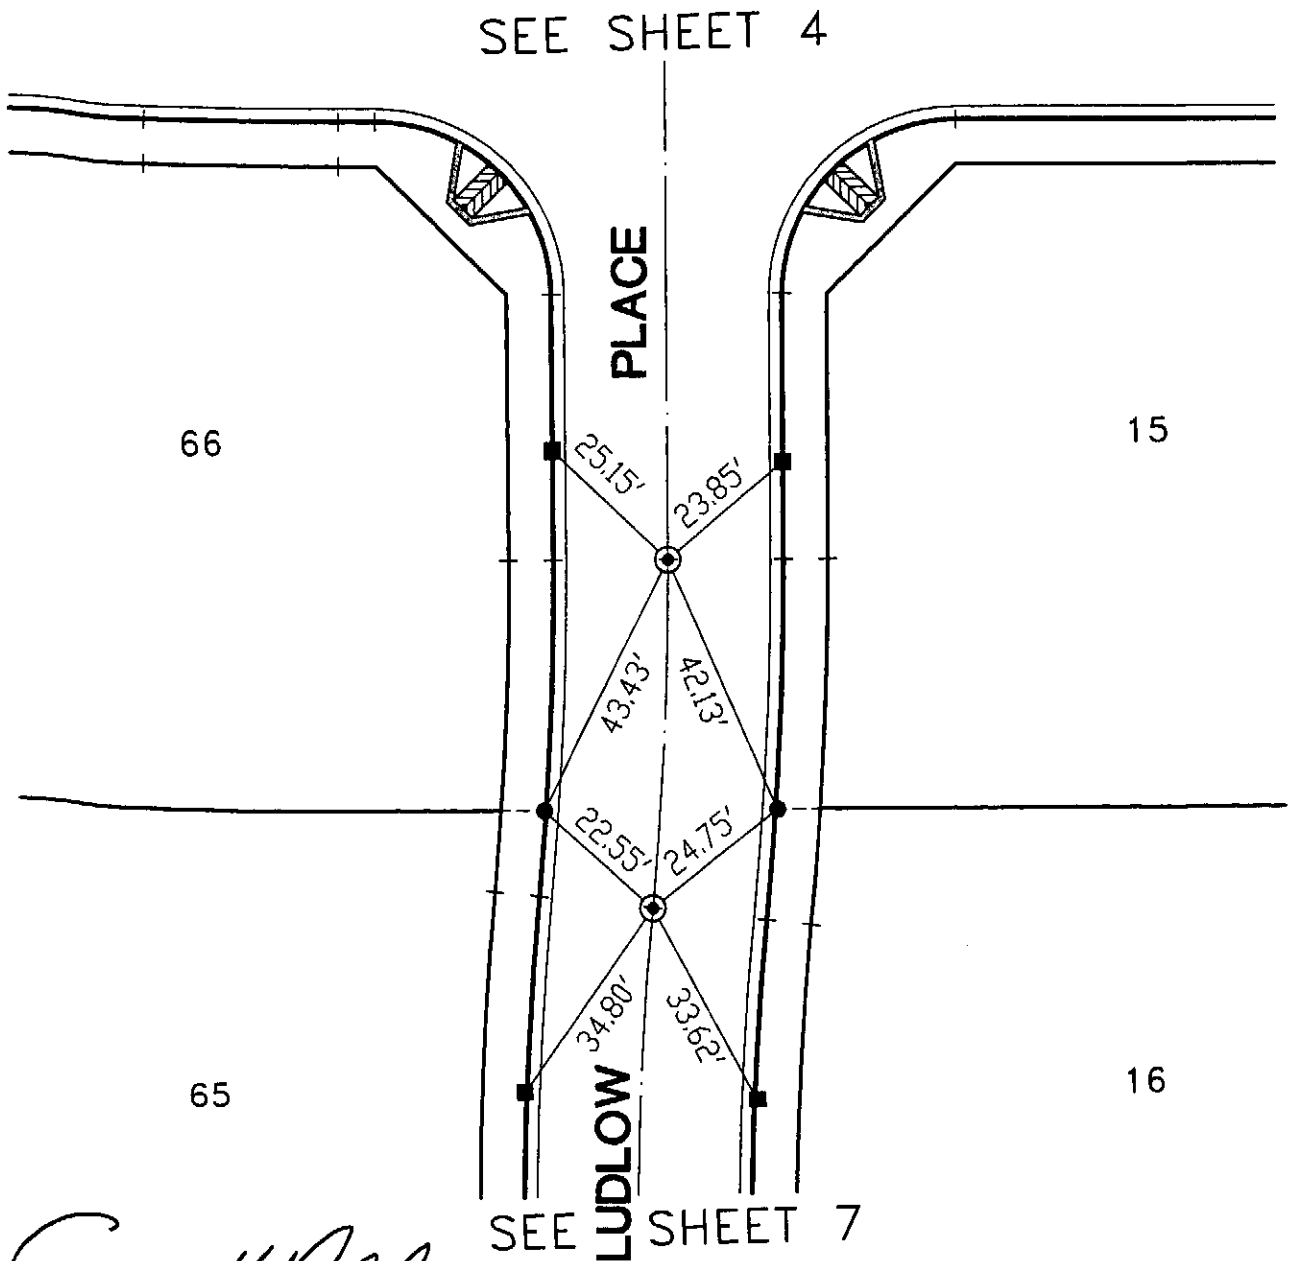

GARY W. DOKICH
L.S. 4693 EXP. 9-30-05

TIE BOOK 24 PAGE 135

CITY OF RANCHO CUCAMONGA
PUBLIC WORKS DEPARTMENT

MDS CONSULTING
MORSE DOKICH SCHULTZ
17320 Redhill Ave. Suite 350 Irvine, CA 92614 Voice: 949-251-8821 FAX: 949-251-0516
PLANNERS ENGINEERS SURVEYORS

6 OF 15

CENTERLINE TIES - TRACT NO. 14497

SCALE: 1"=30'

DATE: 6-2-05

I:\centies\14-497\497-06.dwg 6/01/05

LEGEND :

- ⊙ INDICATES SPIKE AND WASHER STAMPED "L.S. 4693"
- ● INDICATES LEAD, TACK AND TAG STAMPED "L.S. 4693" IN TOP OF CURB
- ■ INDICATES LEAD & BRASS TACK IN TOP OF CURB

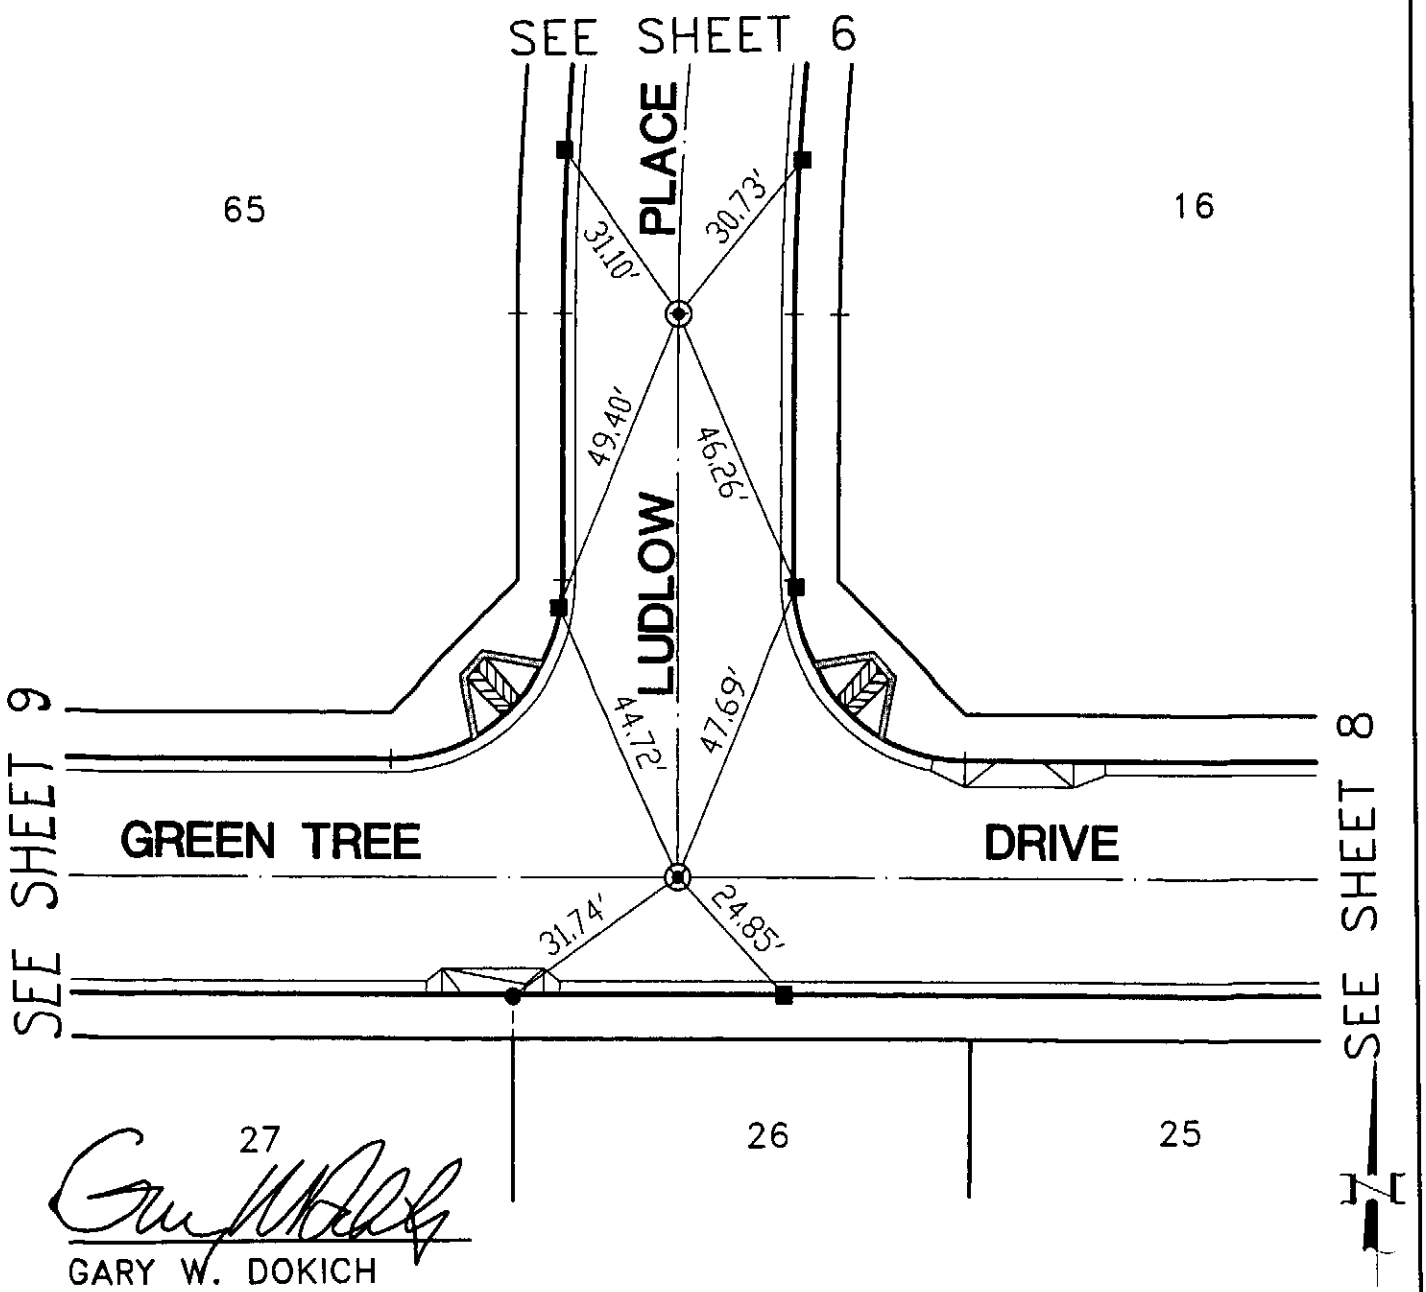

GARY W. DOKICH
L.S. 4693 EXP. 9-30-05

TIE BOOK 24 PAGE 136

CITY OF RANCHO CUCAMONGA
PUBLIC WORKS DEPARTMENT

MDS CONSULTING
MOSS DOKICH SCHULTZ
17320 Redhill Ave. Suite 330 Irvine, CA 92614
Voice: 949-251-8821 FAX: 949-251-0516
PLANNERS ENGINEERS SURVEYORS

7 OF 15

CENTERLINE TIES - TRACT NO. 14497

SCALE: 1"=30'

DATE: 6-2-05

t:\centies\1449~\497-07.dwg 6/03/05

LEGEND :

⊙ INDICATES SPIKE AND WASHER STAMPED "L.S. 4693"

● INDICATES LEAD, TACK AND TAG STAMPED "L.S. 4693" IN TOP OF CURB

■ INDICATES LEAD & BRASS TACK IN TOP OF CURB

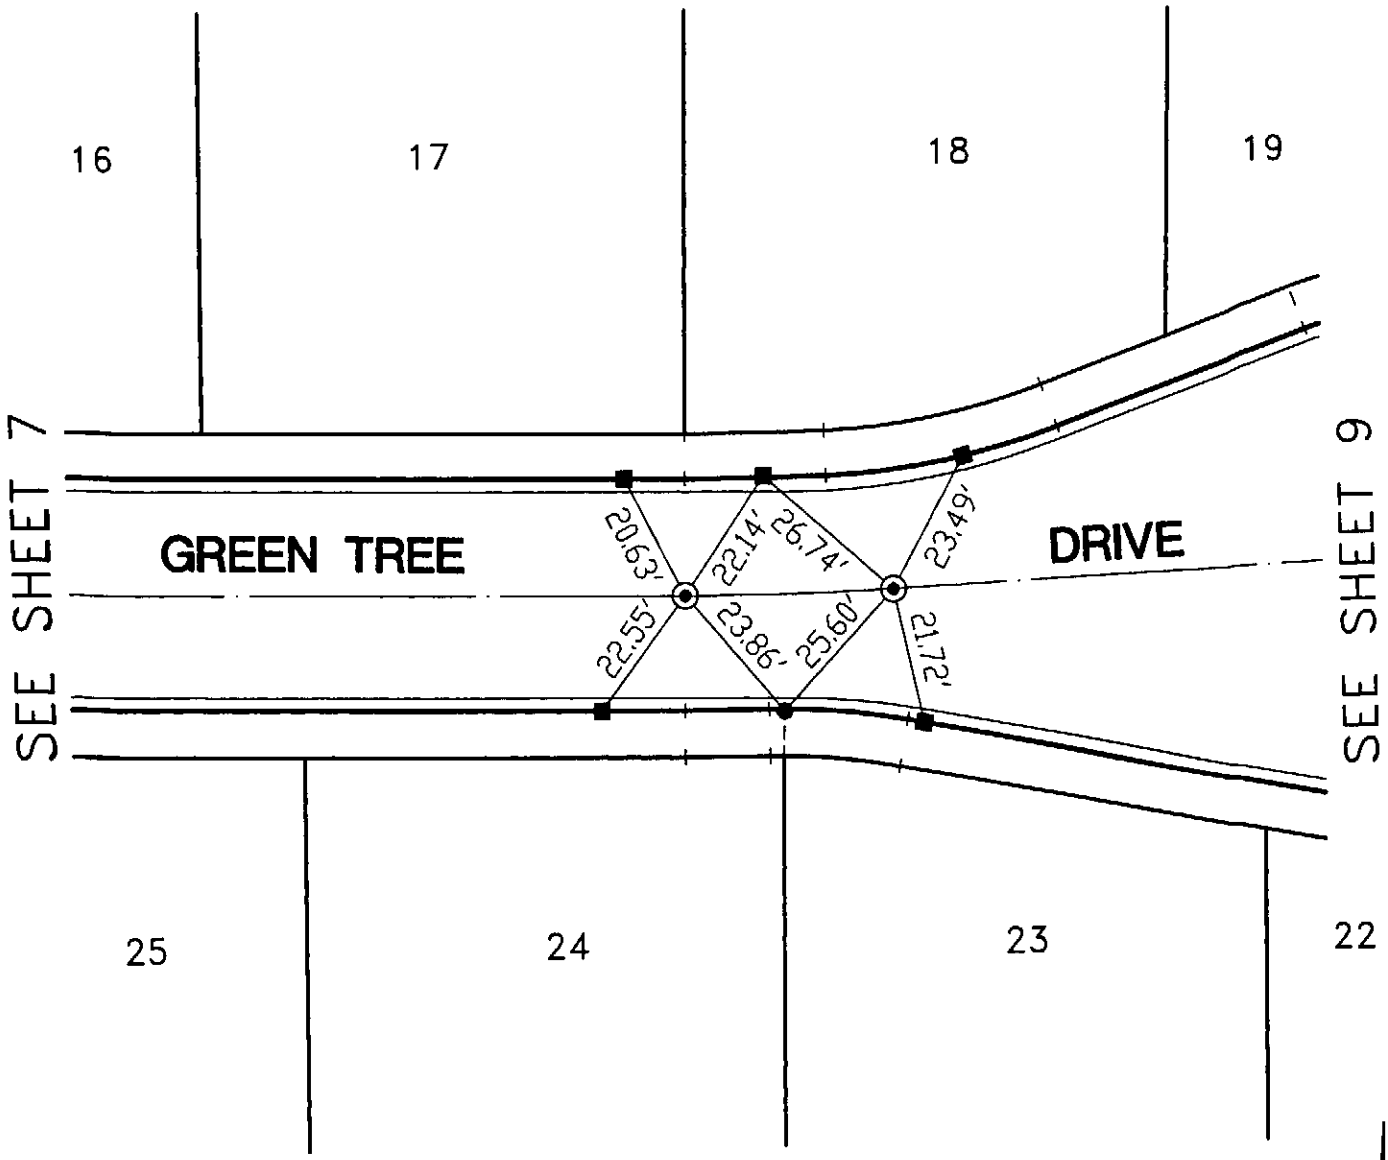

GARY W. DOKICH
L.S. 4693 EXP. 9-30-05

TIE BOOK 24 PAGE 137

CITY OF RANCHO CUCAMONGA
PUBLIC WORKS DEPARTMENT

MDS CONSULTING
MORSE DOKICH SCHULTZ
17320 Redhill Ave. Suite 330 Irvine, CA 92614
Voice: 949-251-8821 FAX: 949-251-0516
PLANNERS ENGINEERS SURVEYORS

8 OF 15

CENTERLINE TIES - TRACT NO. 14497

SCALE: 1"=30'

DATE: 6-2-05

I:\centies\14497\497-08.dwg 6/01/05

LEGEND :

◉ INDICATES SPIKE AND WASHER STAMPED "L.S. 4693"

● INDICATES LEAD, TACK AND TAG STAMPED "L.S. 4693" IN TOP OF CURB

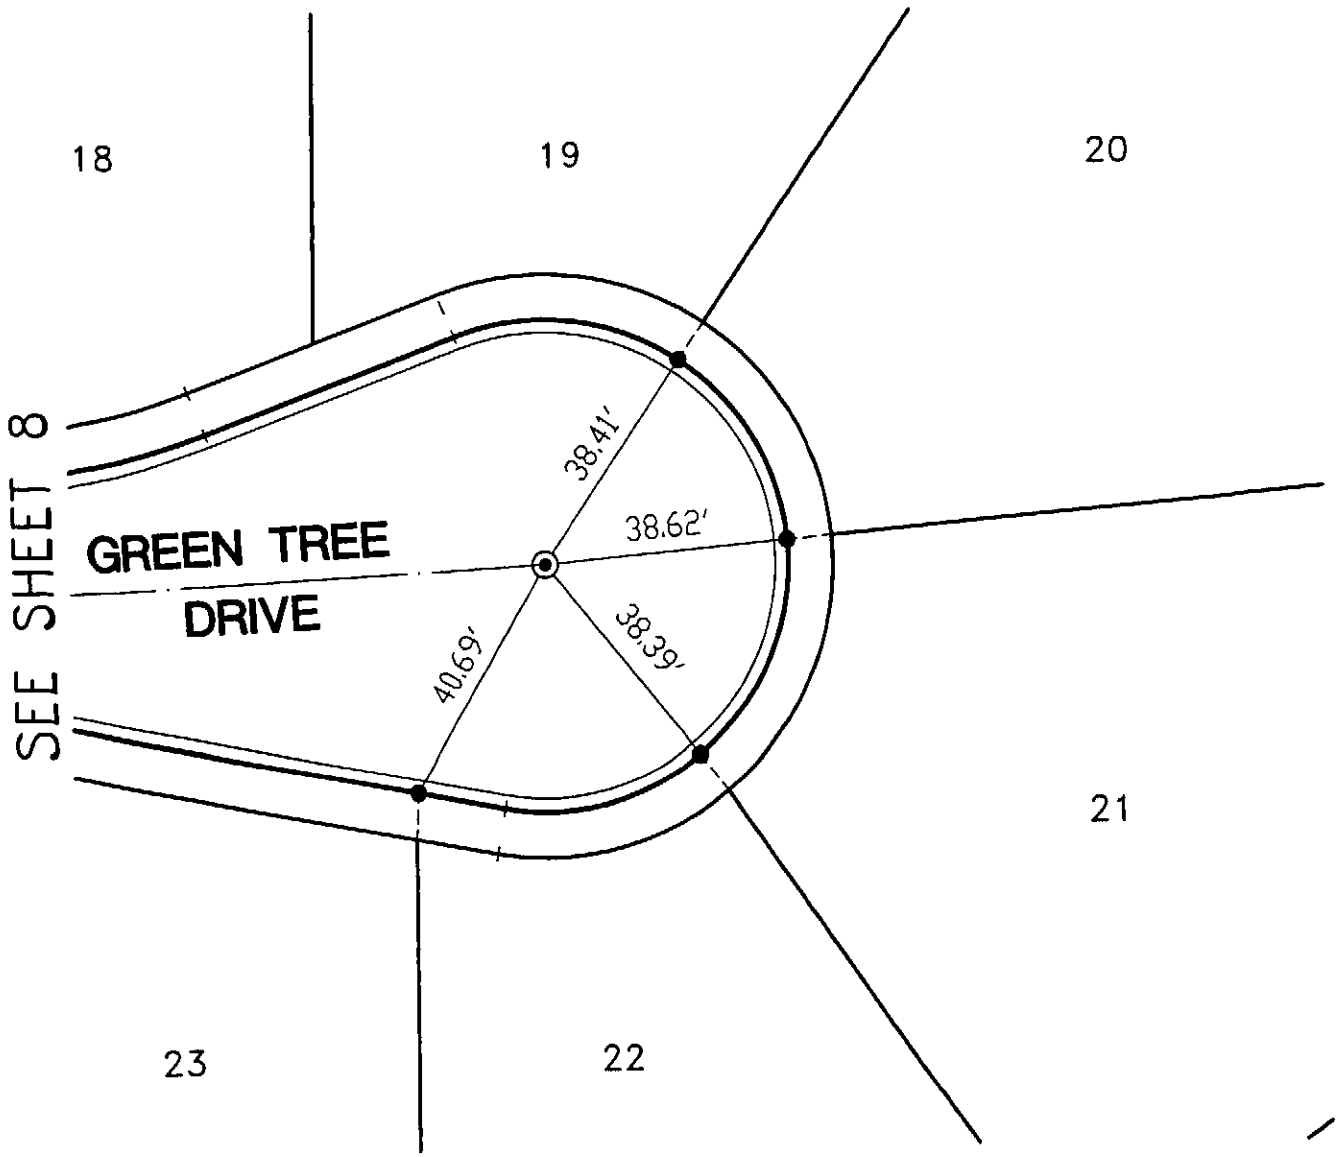

GARY W. DOKICH
L.S. 4693 EXP. 9-30-05

TIE BOOK 24 PAGE 138

CITY OF RANCHO CUCAMONGA
PUBLIC WORKS DEPARTMENT

MDS CONSULTING
MOSER DOKICH SCHULTZ
17320 Redhill Ave. Suite 350 Irvine, CA 92614
Voice: 949-251-0891 FAX: 949-251-0516
PLANNERS ENGINEERS SURVEYORS

9 OF 15

CENTERLINE TIES - TRACT NO. 14497

SCALE: 1"=30'

DATE: 6-2-05

I:\centies\144 97\497-09.dwg 6/01/05

LEGEND :

⊗ INDICATES 4 PUNCH MARKS IN MANHOLE RIM TO REFERENCE P.M. ON LID

■ INDICATES LEAD & BRASS TACK IN TOP OF CURB

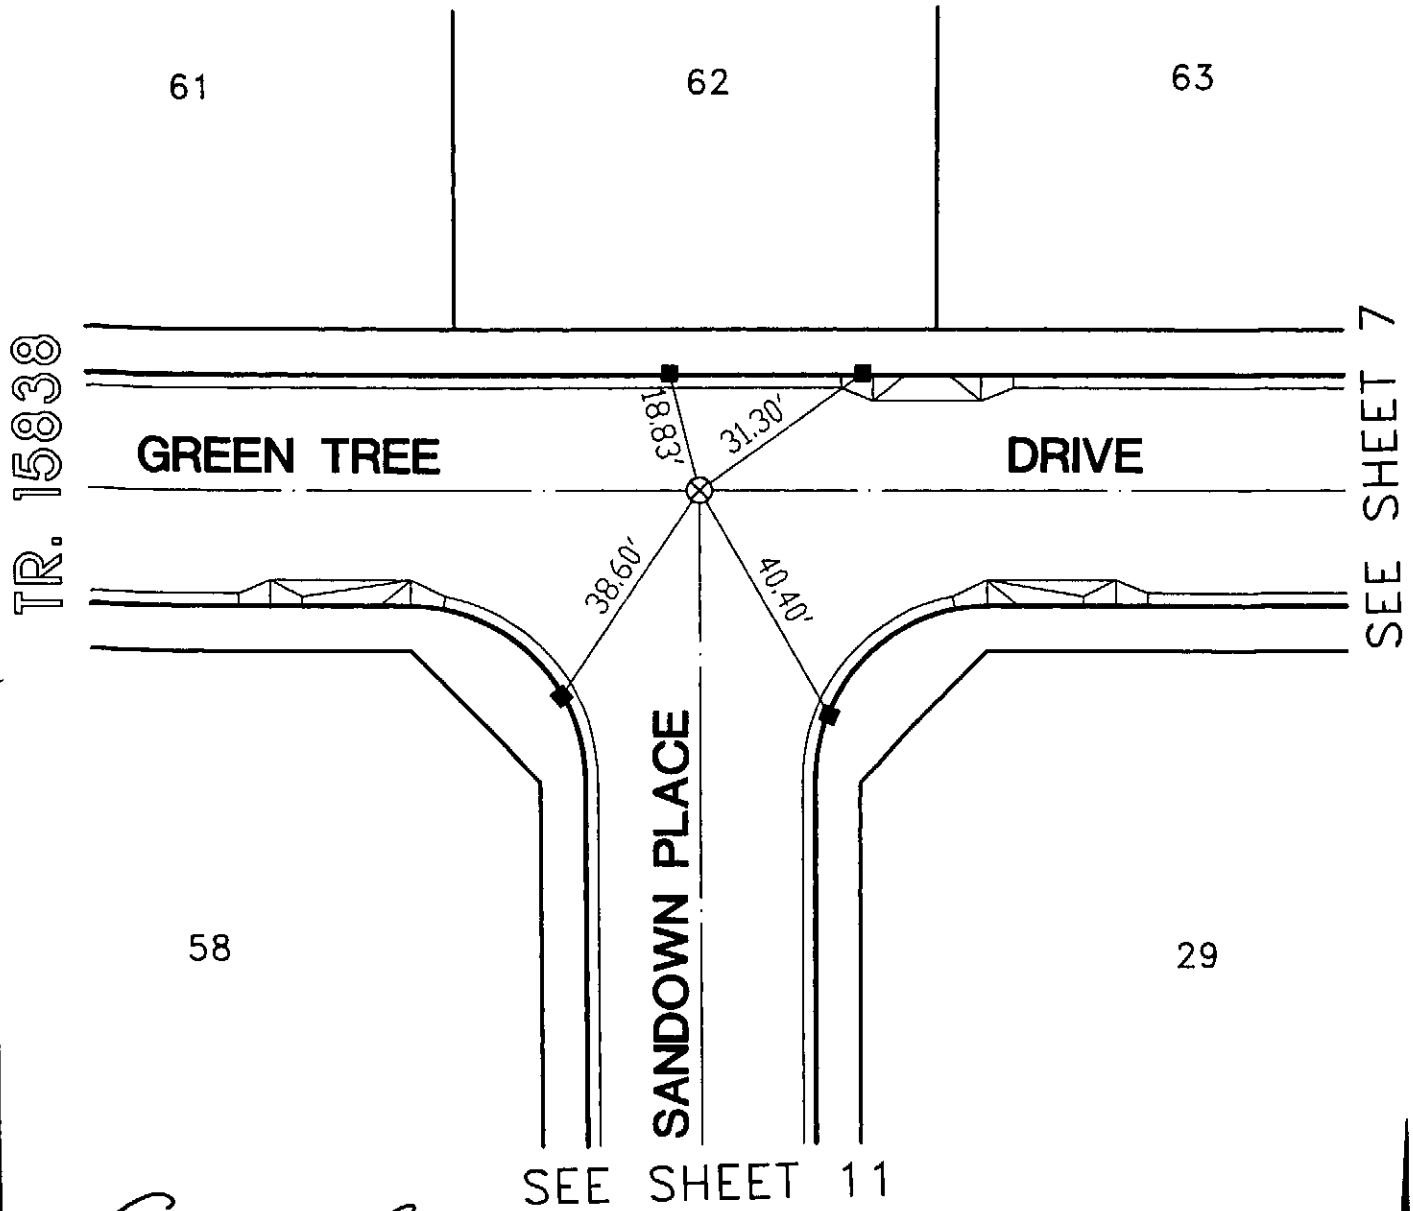

GARY W. DOKICH
L.S. 4693 EXP. 9-30-05

TIE BOOK 24 PAGE 139

CITY OF RANCHO CUCAMONGA
PUBLIC WORKS DEPARTMENT

MDS CONSULTING
MORSE DOKICH SCHULTZE
17320 Redhill Ave., Suite 350, Irvine, CA 92614
Voice: 949-251-8821
FAX: 949-251-0316
PLANNERS ENGINEERS SURVEYORS

10 OF 15

CENTERLINE TIES – TRACT NO. 14497

SCALE: 1"=30'

DATE: 6-2-05

I:\centies\14497\497-10.dwg 6/01/05

LEGEND :

⊗ INDICATES 4 PUNCH MARKS IN MANHOLE RIM TO REFERENCE P.M. ON LID

⦿ INDICATES SPIKE AND WASHER STAMPED "L.S. 4693"

● INDICATES LEAD, TACK AND TAG STAMPED "L.S. 4693" IN TOP OF CURB

■ INDICATES LEAD & BRASS TACK IN TOP OF CURB

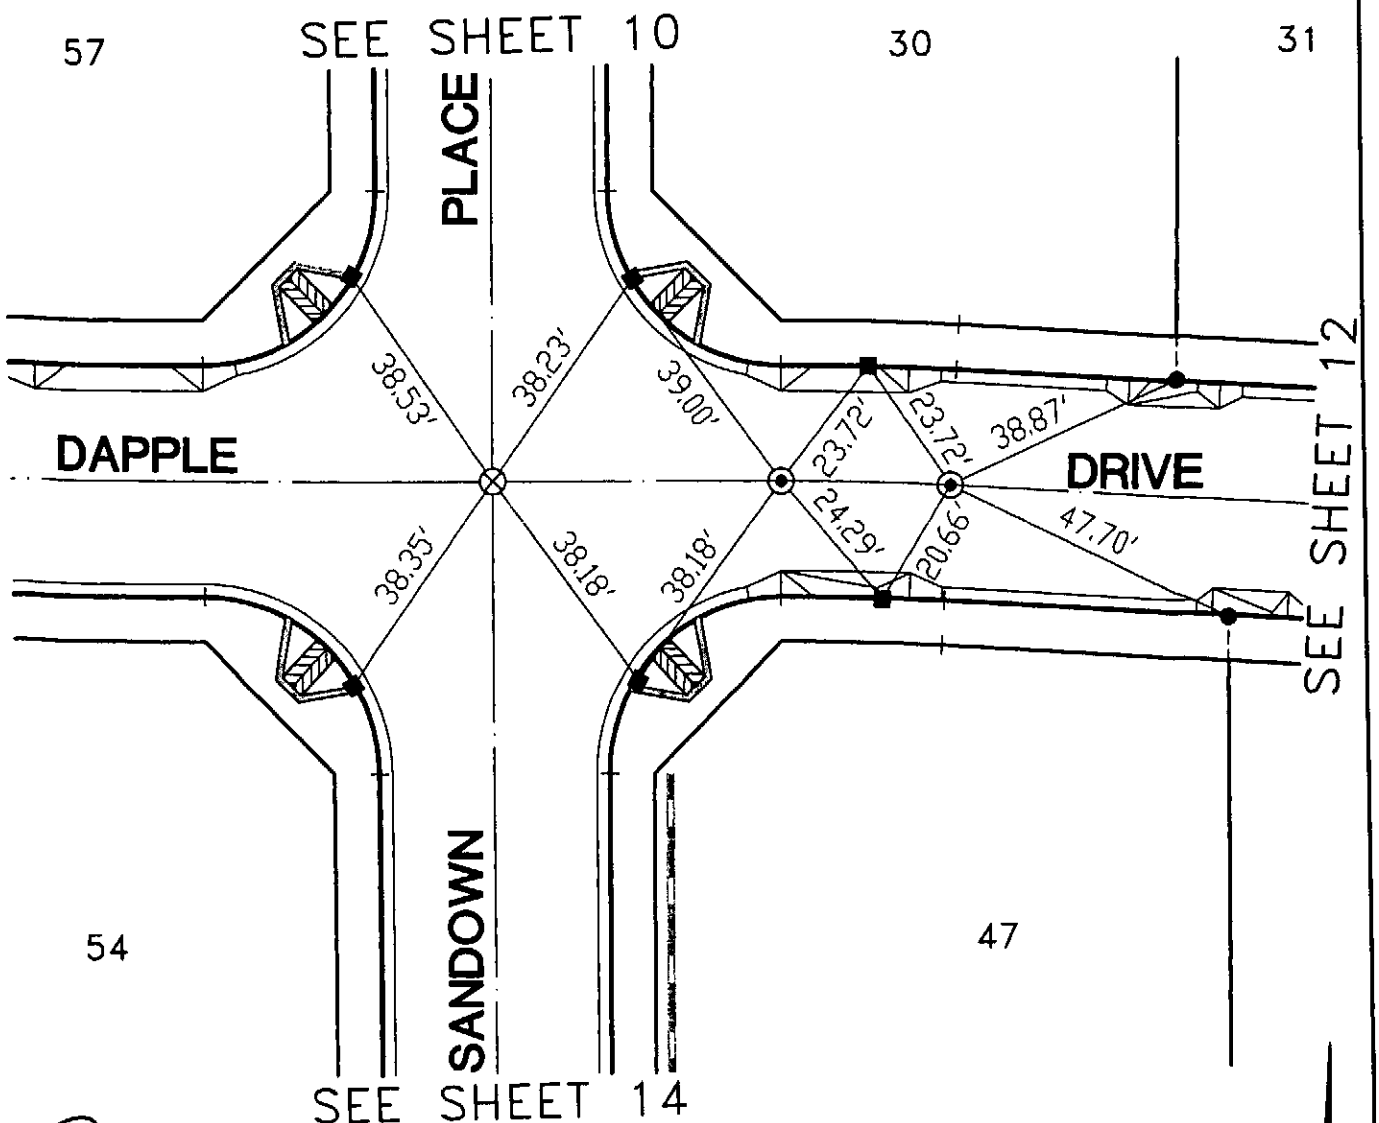

GARY W. DOKICH
L.S. 4693 EXP. 9-30-05

TIE BOOK 24 PAGE 140

CITY OF RANCHO CUCAMONGA
PUBLIC WORKS DEPARTMENT

MDS CONSULTING
MORSE DOKICH SCHULTZ
17320 Redhill Ave. Suite 350 Irvine, CA 92614
Voice: 949-251-0831 FAX: 949-251-0816
PLANNERS ENGINEERS SURVEYORS

11 OF 15

CENTERLINE TIES - TRACT NO. 14497

SCALE: 1"=30'

DATE: 6-2-05

I:\centies\14497\497-11.dwg 6/01/05

LEGEND :

⊙ INDICATES SPIKE AND WASHER STAMPED "L.S. 4693"

■ INDICATES LEAD & BRASS TACK IN TOP OF CURB

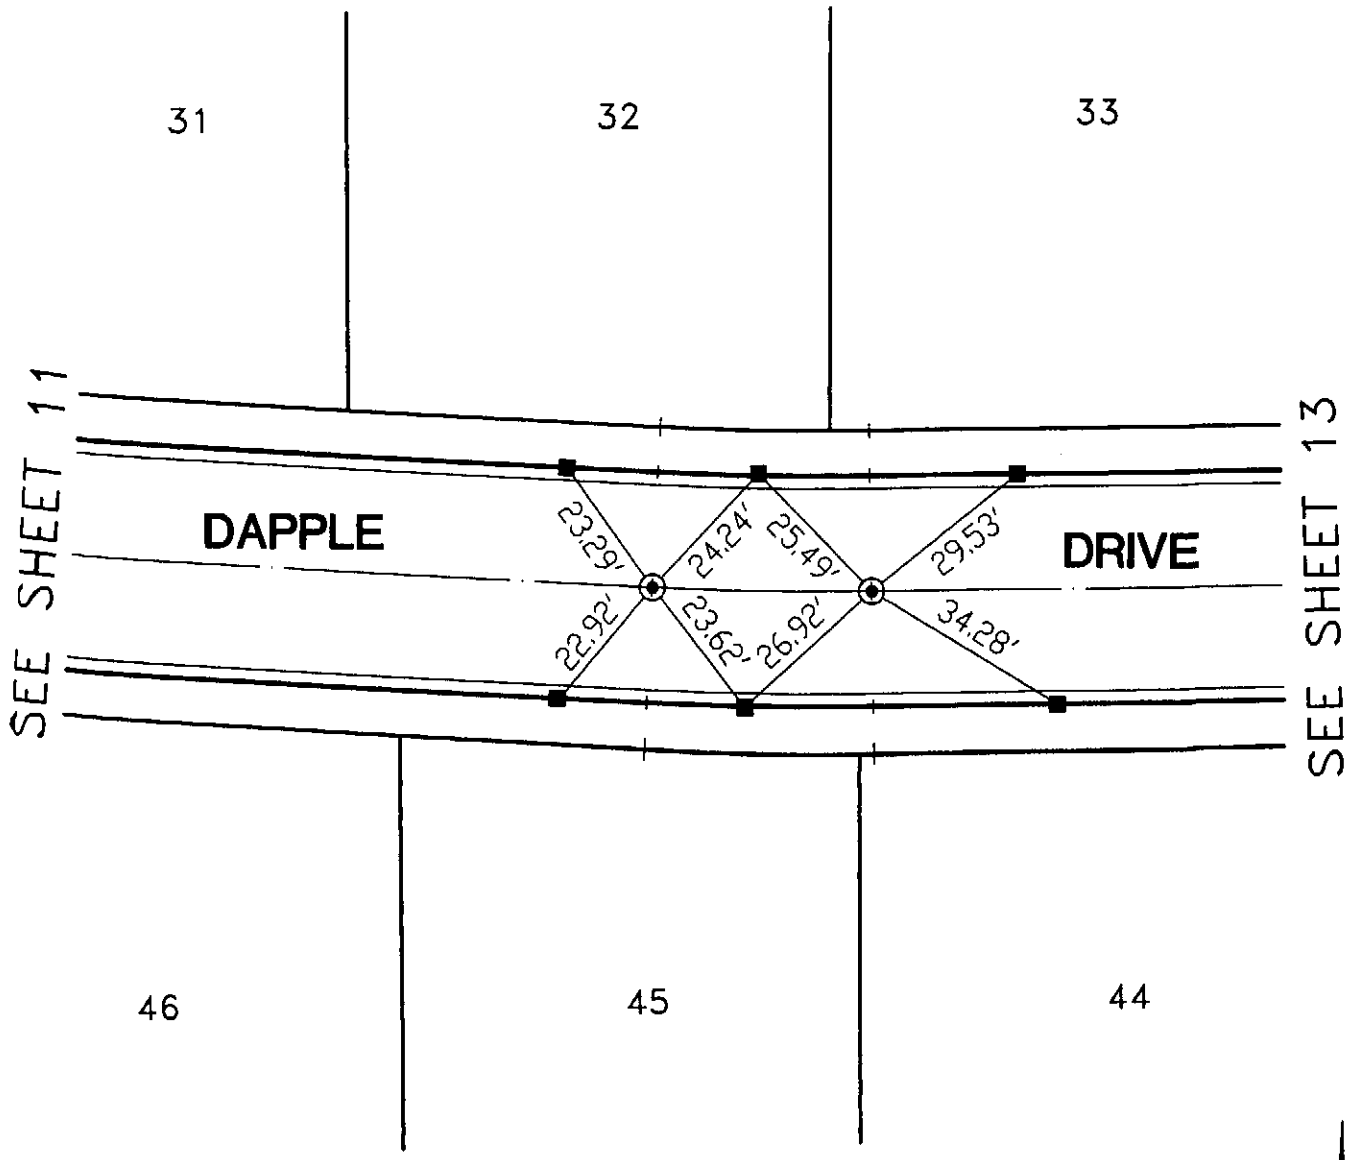

GARY W. DOKICH
L.S. 4693 EXP. 9-30-05

TIE BOOK 24 PAGE 141

CITY OF RANCHO CUCAMONGA
PUBLIC WORKS DEPARTMENT

MDS CONSULTING
MOSER DOKICH SCHULTZ
17320 Redhill Ave. Suite 350 Irvine, CA 92614
Voice: 949-251-8821 FAX: 949-251-0916
PLANNERS ENGINEERS SURVEYORS

12 OF 15

CENTERLINE TIES – TRACT NO. 14497

SCALE: 1"=30'

DATE: 6-2-05

I:\centies\1449#7\497-12.dwg 6/01/05

LEGEND :

- ⊙ INDICATES SPIKE AND WASHER STAMPED "L.S. 4693"
- ● INDICATES LEAD, TACK AND TAG STAMPED "L.S. 4693" IN TOP OF CURB
- ■ INDICATES LEAD & BRASS TACK IN TOP OF CURB

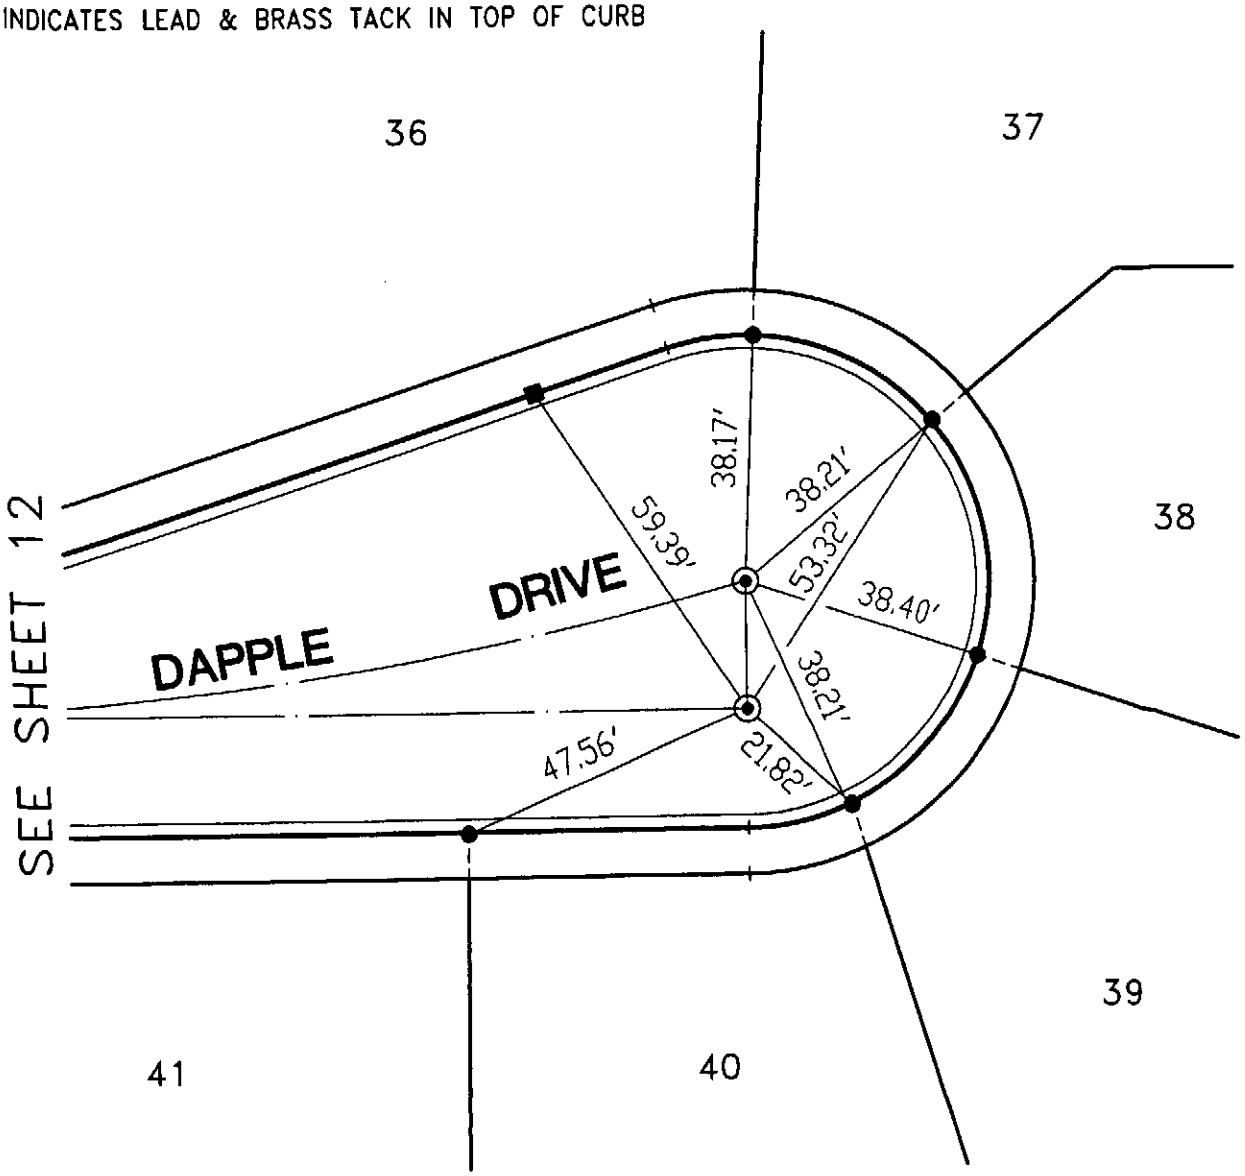

GARY W. DOKICH
L.S. 4693 EXP. 9-30-05

TIE BOOK 24 PAGE 142

CITY OF RANCHO CUCAMONGA
PUBLIC WORKS DEPARTMENT

MDS CONSULTING
MOSSE DOKICH SCHULTZ
17320 Redhill Ave. Suite 350 Irvine, CA 92614
Voice: 949-251-8821 FAX: 949-251-0616
PLANNERS ENGINEERS SURVEYORS

13 OF 15

CENTERLINE TIES – TRACT NO. 14497

SCALE: 1"=30'

DATE: 6-2-05

I:\centies\14497\497-13.dwg 6/01/05

LEGEND :

- ⊙ INDICATES SPIKE AND WASHER STAMPED "L.S. 4693"
- ● INDICATES LEAD, TACK AND TAG STAMPED "L.S. 4693" IN TOP OF CURB
- ■ INDICATES LEAD & BRASS TACK IN TOP OF CURB

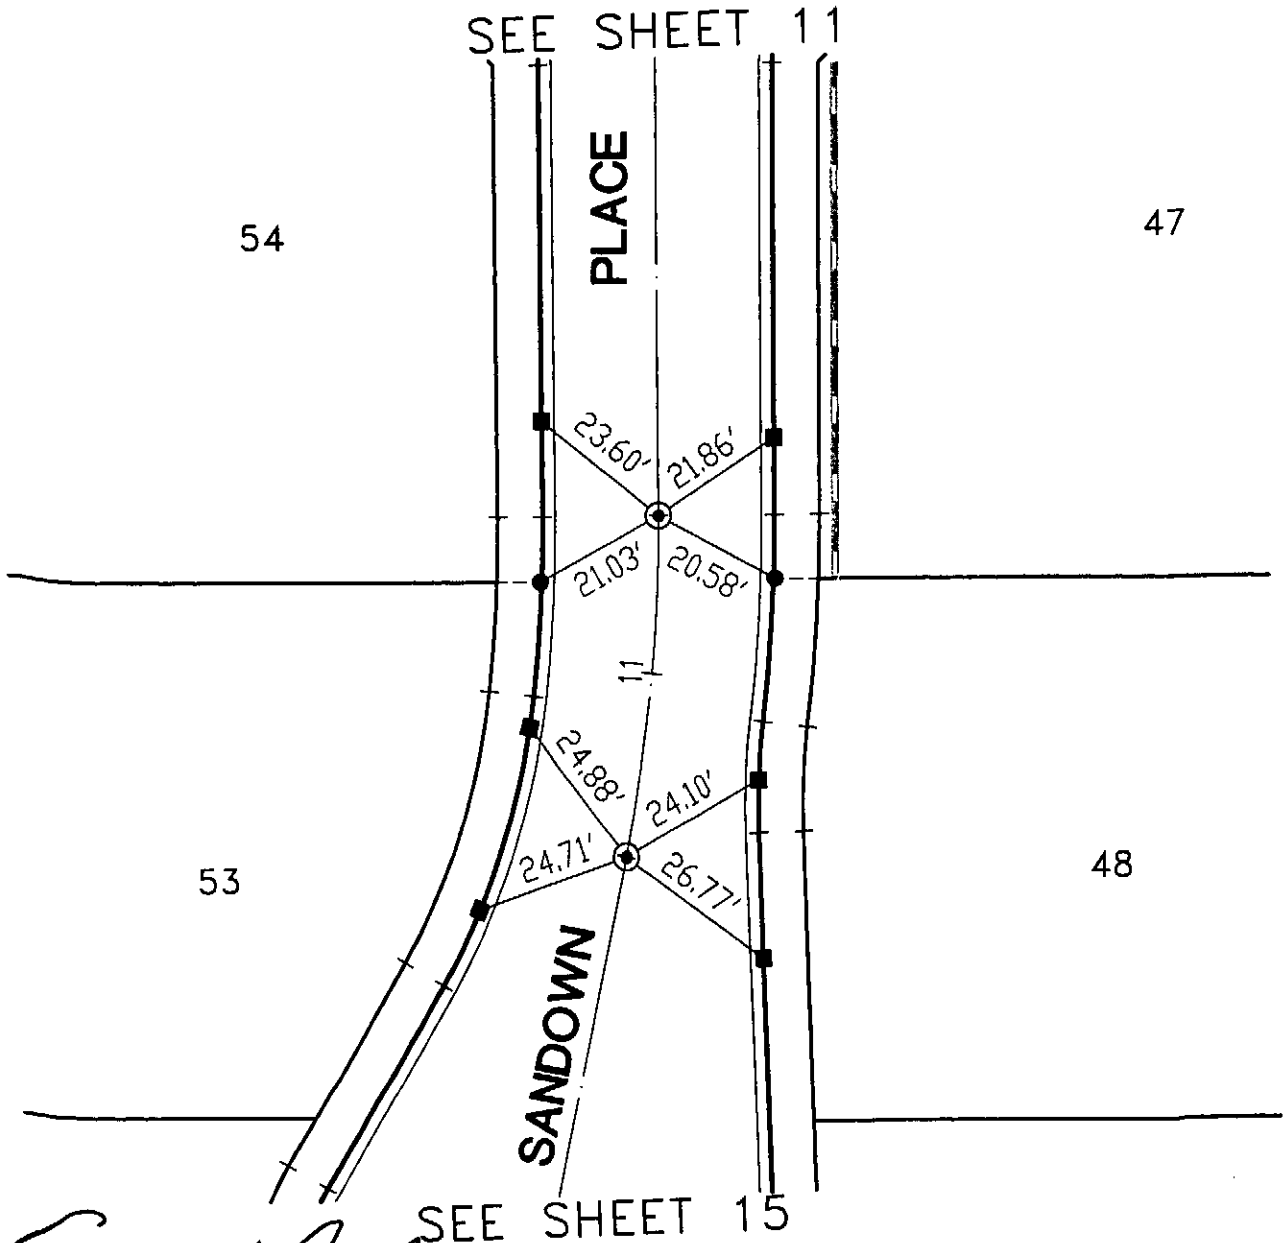

GARY W. DOKICH
L.S. 4693 EXP. 9-30-05

TIE BOOK 24 PAGE 143

CITY OF RANCHO CUCAMONGA
PUBLIC WORKS DEPARTMENT

MDS CONSULTING
MOSSE DOKICH SCHULTZ
17320 Redhill Ave. Suite 350 Irvine, CA 92614
Voice: 949-251-0021 FAX: 949-251-0518
PLANNERS ENGINEERS SURVEYORS

14 OF 15

CENTERLINE TIES - TRACT NO. 14497

SCALE: 1"=30'

DATE: 6-2-05

I:\centies\14497\497-14.dwg 6/01/05

LEGEND :

⊙ INDICATES SPIKE AND WASHER STAMPED "L.S. 4693"

● INDICATES LEAD, TACK AND TAG STAMPED "L.S. 4693" IN TOP OF CURB

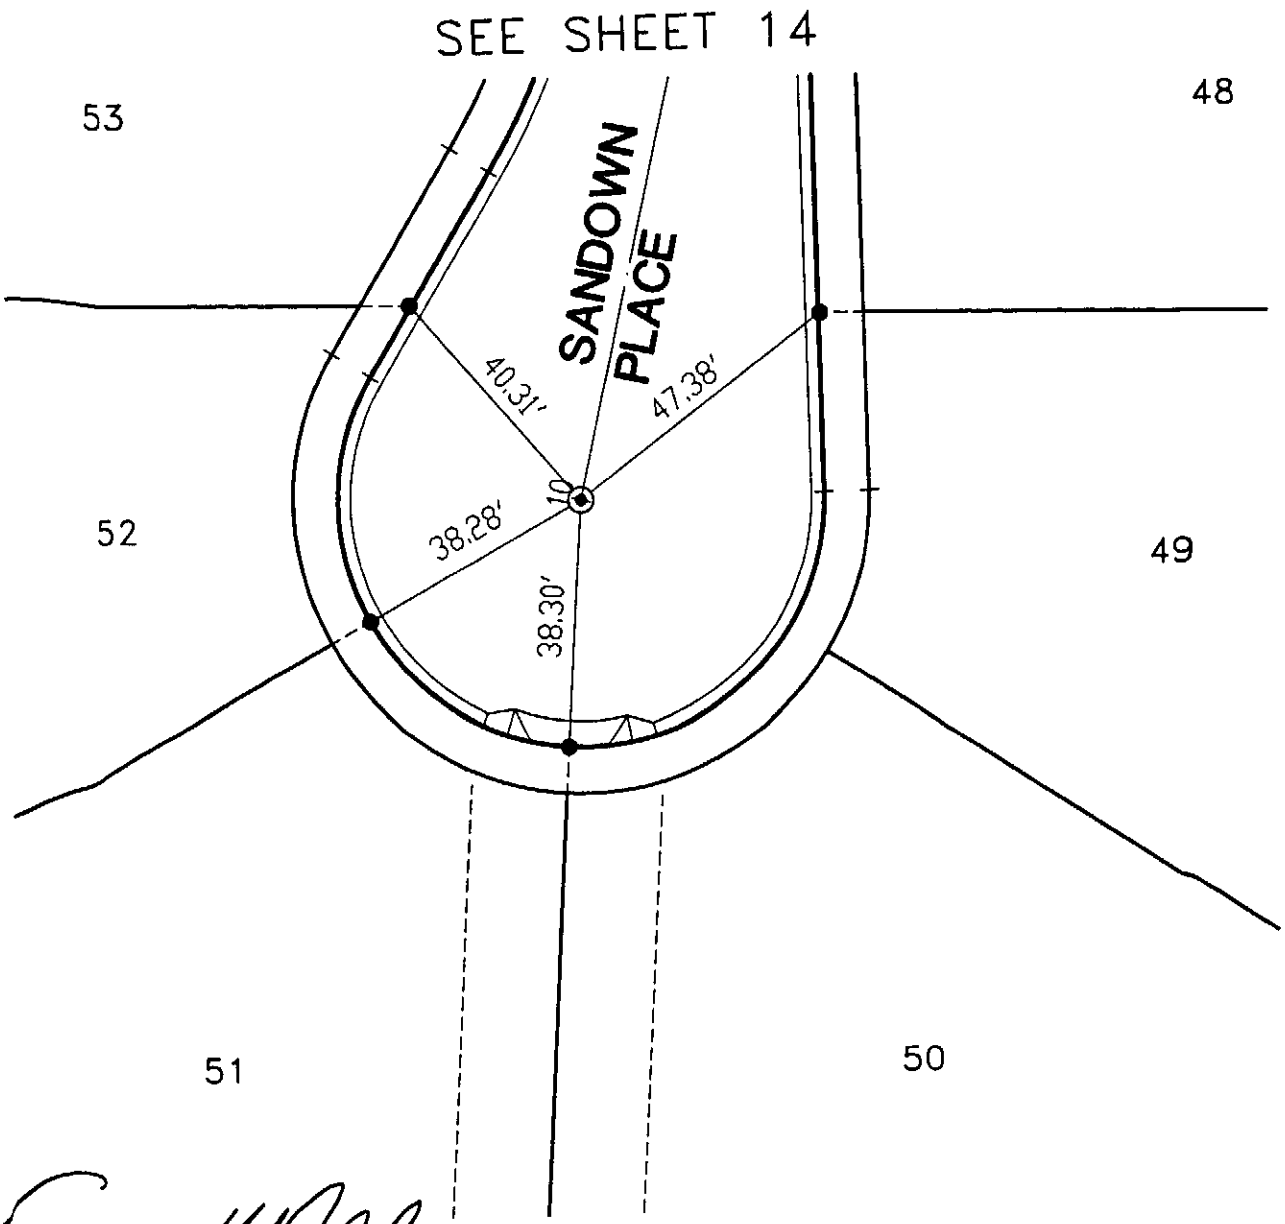

GARY W. DOKICH
L.S. 4693 EXP. 9-30-05

TIE BOOK 24 PAGE 144

CITY OF RANCHO CUCAMONGA
PUBLIC WORKS DEPARTMENT

MDS CONSULTING
MORSE DOKICH SCHULTZ
17320 Redhill Ave. Suite 350 Irvine, CA 92614
Voice: 949-251-8871 FAX: 949-251-0516
PLANNERS ENGINEERS SURVEYORS

15 OF 15

CENTERLINE TIES – TRACT NO. 14497

SCALE: 1"=30'

DATE: 6-2-05

I:\centies\1449[redacted]7\497-15.dwg 6/01/05

CENTERLINE TIES

TRACT NO. 14498

GARY W. DOKICH
L.S. 4693 EXP. 9-30-05

CITY OF RANCHO CUCAMONGA
PUBLIC WORKS DEPARTMENT

MDS CONSULTING
MORSE DOKICH SCHULTZ
17320 Redhill Ave. Suite 350 Irvine, CA 92614
Voice: 949-251-8821
FAX: 949-251-0316
PLANNERS ENGINEERS SURVEYORS

CENTERLINE TIES – TRACT NO. 14498

DATE: 6-2-05

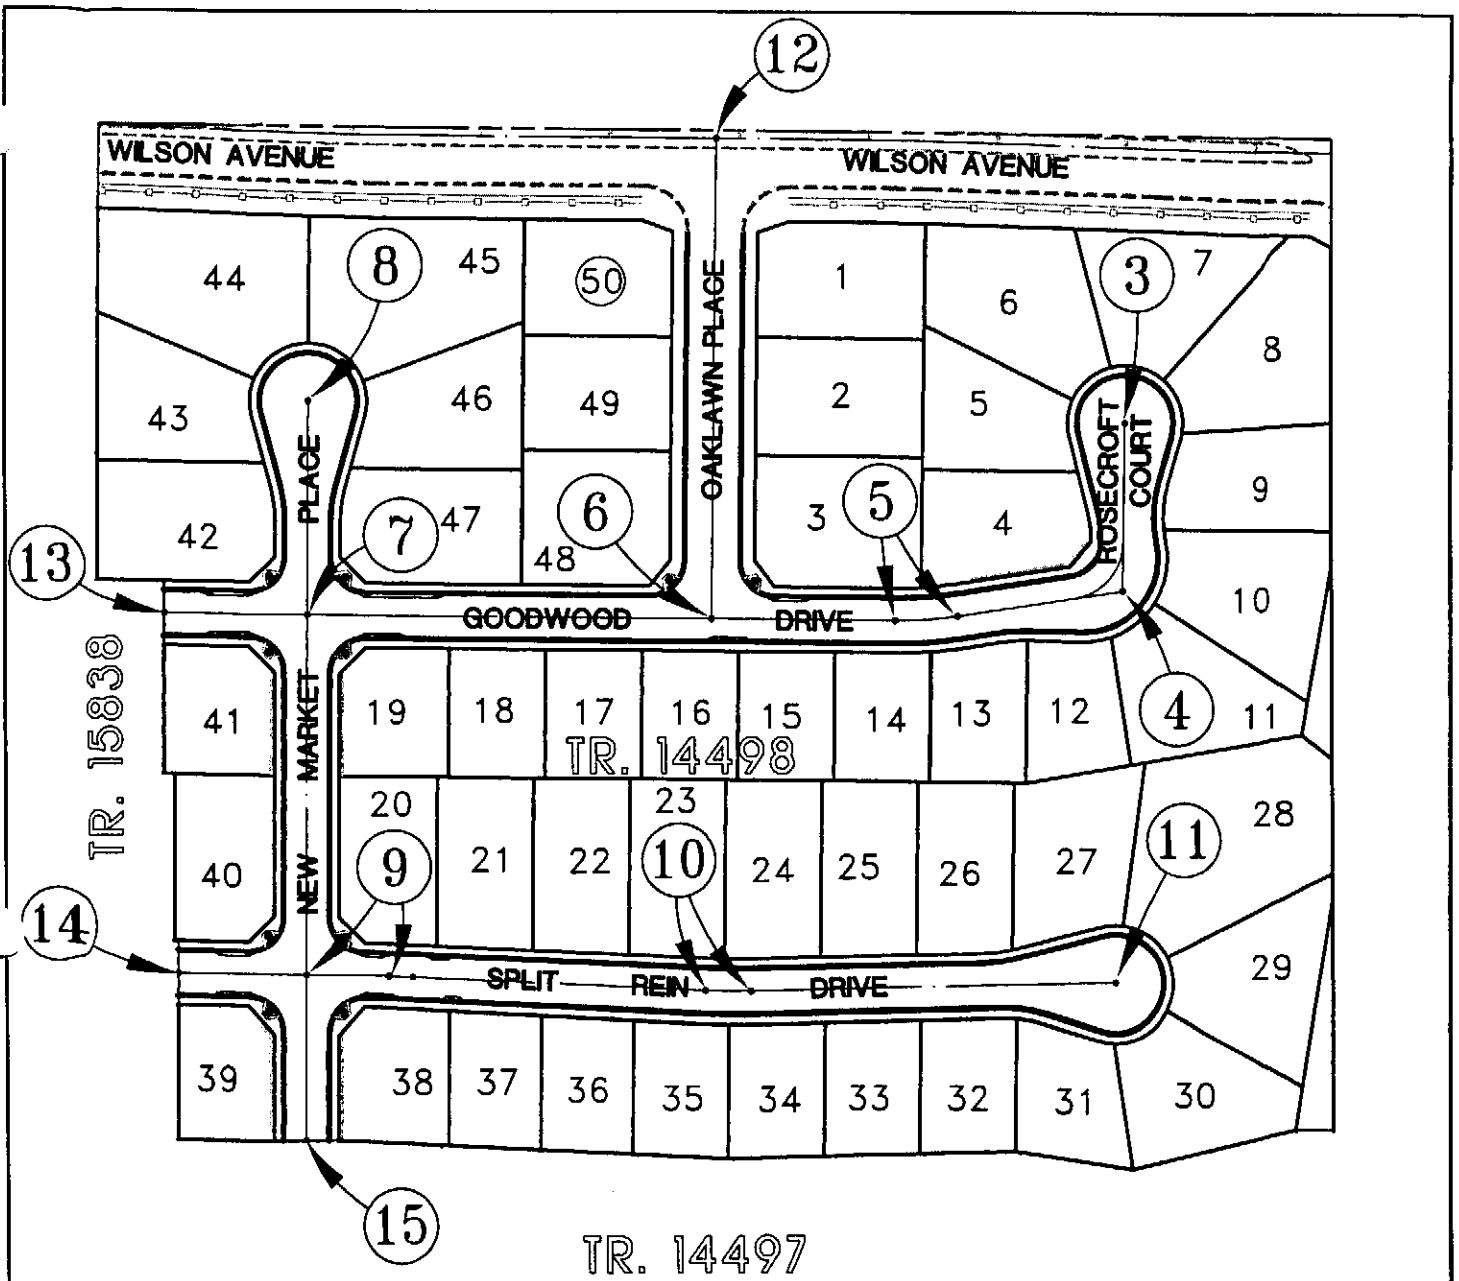

LEGEND :

(4) DENOTES SHEET NUMBERS

GARY W. DOKICH
L.S. 4693 EXP. 9-30-05

TIE BOOK 24 PAGE 145

PUBLIC WORKS DEPARTMENT

MDS CONSULTING
MOREE DOKICH SCHULTZ
17320 Redhill Ave, Suite 350
Irvine, CA 92614
Voice: 949-251-8821
FAX: 949-251-0316
PLANNERS ENGINEERS SURVEYORS

2 OF 15

CENTERLINE TIES - TRACT NO. 14498

SCALE: 1"=150'

DATE: 6-2-05

I:\centies\14498\498-02.dwg 6/01/05

LEGEND :

⊙ INDICATES SPIKE AND WASHER STAMPED "L.S. 4693"

● INDICATES LEAD, TACK AND TAG STAMPED "L.S. 4693" IN TOP OF CURB

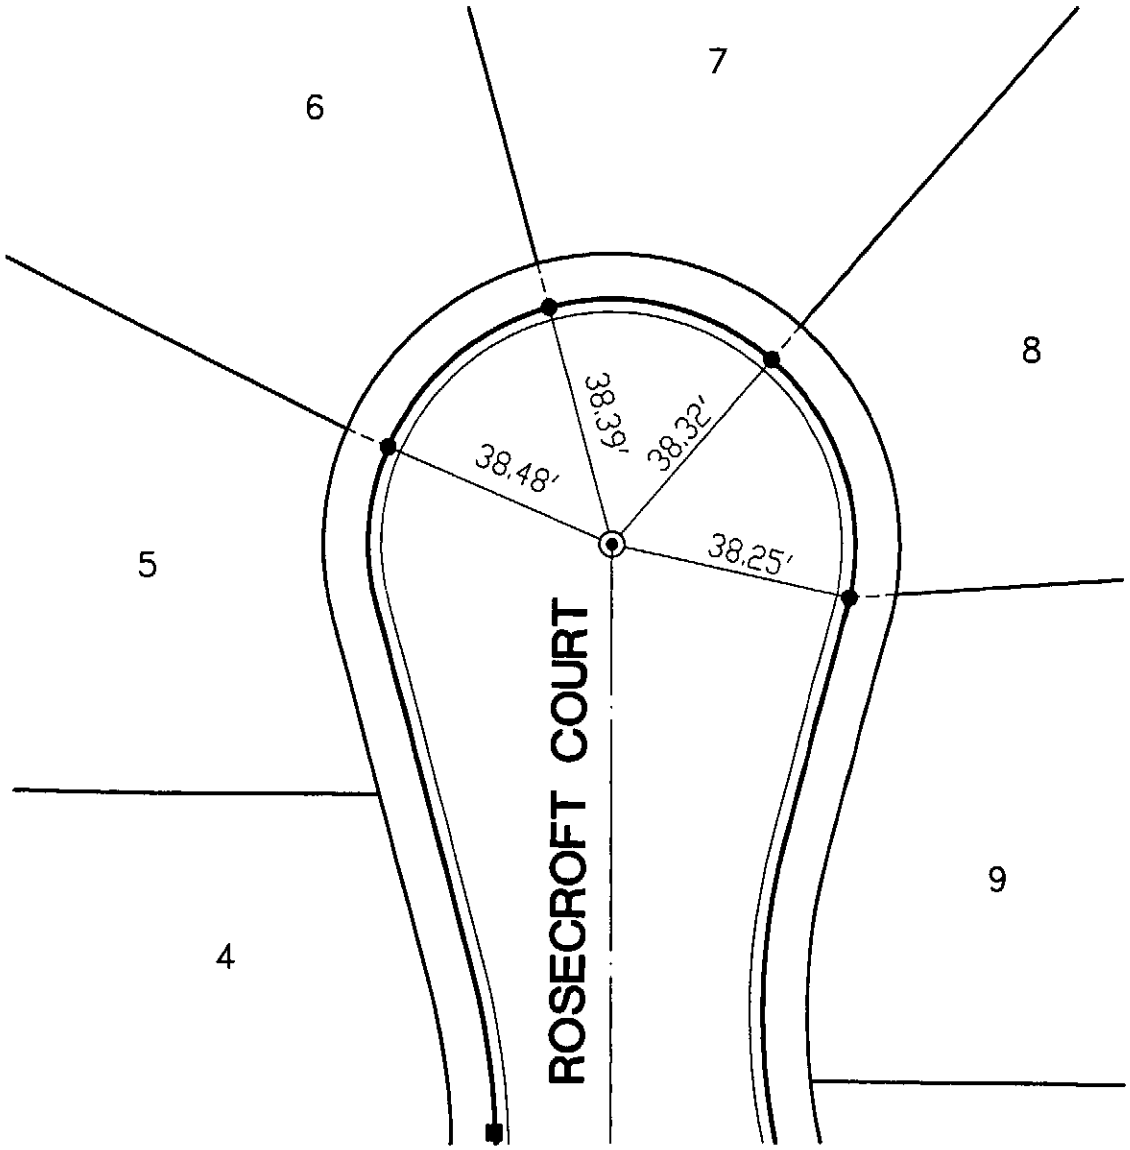

SEE SHEET 4

GARY W. DOKICH
L.S. 4693 EXP. 9-30-05

TIE BOOK 24 PAGE 146

CITY OF RANCHO CUCAMONGA
PUBLIC WORKS DEPARTMENT

MDS CONSULTING
PLANNERS ENGINEERS SURVEYORS
MOESE DOKICH SCHULTZ
17320 Redhill Ave. Suite 330 Irvine, CA 92614
Voice: 949-251-8821
FAX: 949-251-0516

CENTERLINE TIES - TRACT NO. 14498

SCALE: 1"=30'

DATE: 6-2-05

I:\centies\14498\498-03.dwg 6/01/05

LEGEND :

⊗ INDICATES 4 PUNCH MARKS IN MANHOLE RIM TO REFERENCE P.M. ON LID

● INDICATES LEAD, TACK AND TAG STAMPED "L.S. 4693" IN TOP OF CURB

■ INDICATES LEAD & BRASS TACK IN TOP OF CURB

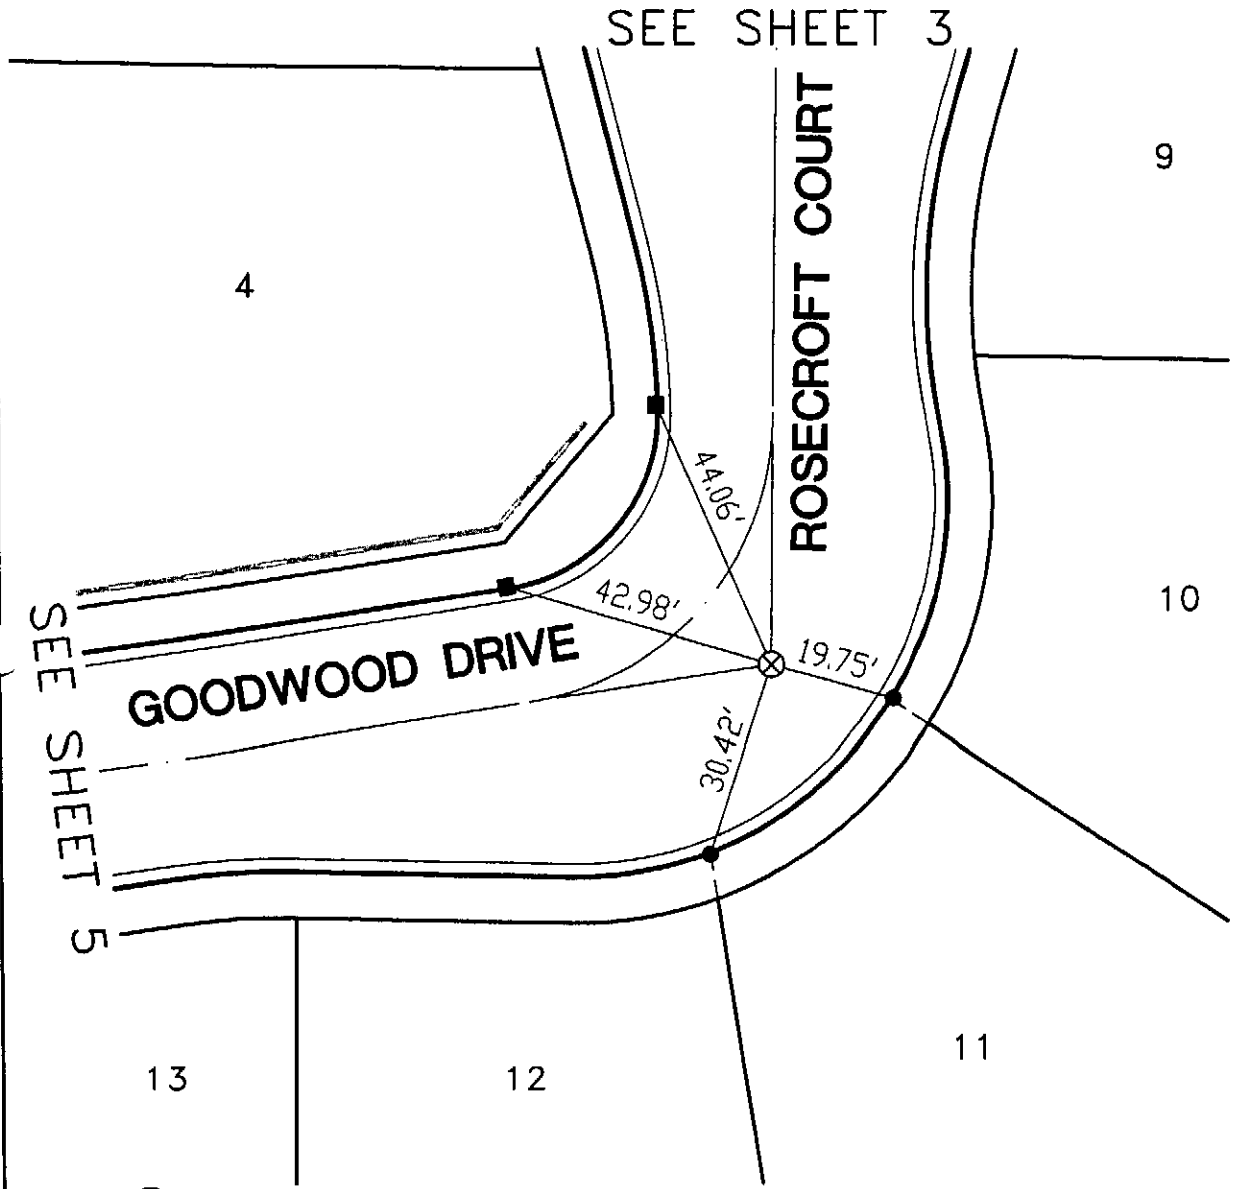

GARY W. DOKICH
L.S. 4693 EXP. 9-30-05

TIE BOOK 24 PAGE 147

CITY OF RANCHO CUCAMONGA
PUBLIC WORKS DEPARTMENT

MDS CONSULTING
MOSER DOKICH SCHULTZ
17320 Redhill Ave. Suite 350 Irvine, CA 92614 Voice: 949-251-8821 FAX: 949-251-0516
PLANNERS ENGINEERS SURVEYORS

4 OF 15

CENTERLINE TIES – TRACT NO. 14498

SCALE: 1"=30'

DATE: 6-2-05

f:\centies\14498\498-04.dwg 6/01/05

LEGEND :

- ⊙ INDICATES SPIKE AND WASHER STAMPED "L.S. 4693"
- ● INDICATES LEAD, TACK AND TAG STAMPED "L.S. 4693" IN TOP OF CURB
- ■ INDICATES LEAD & BRASS TACK IN TOP OF CURB

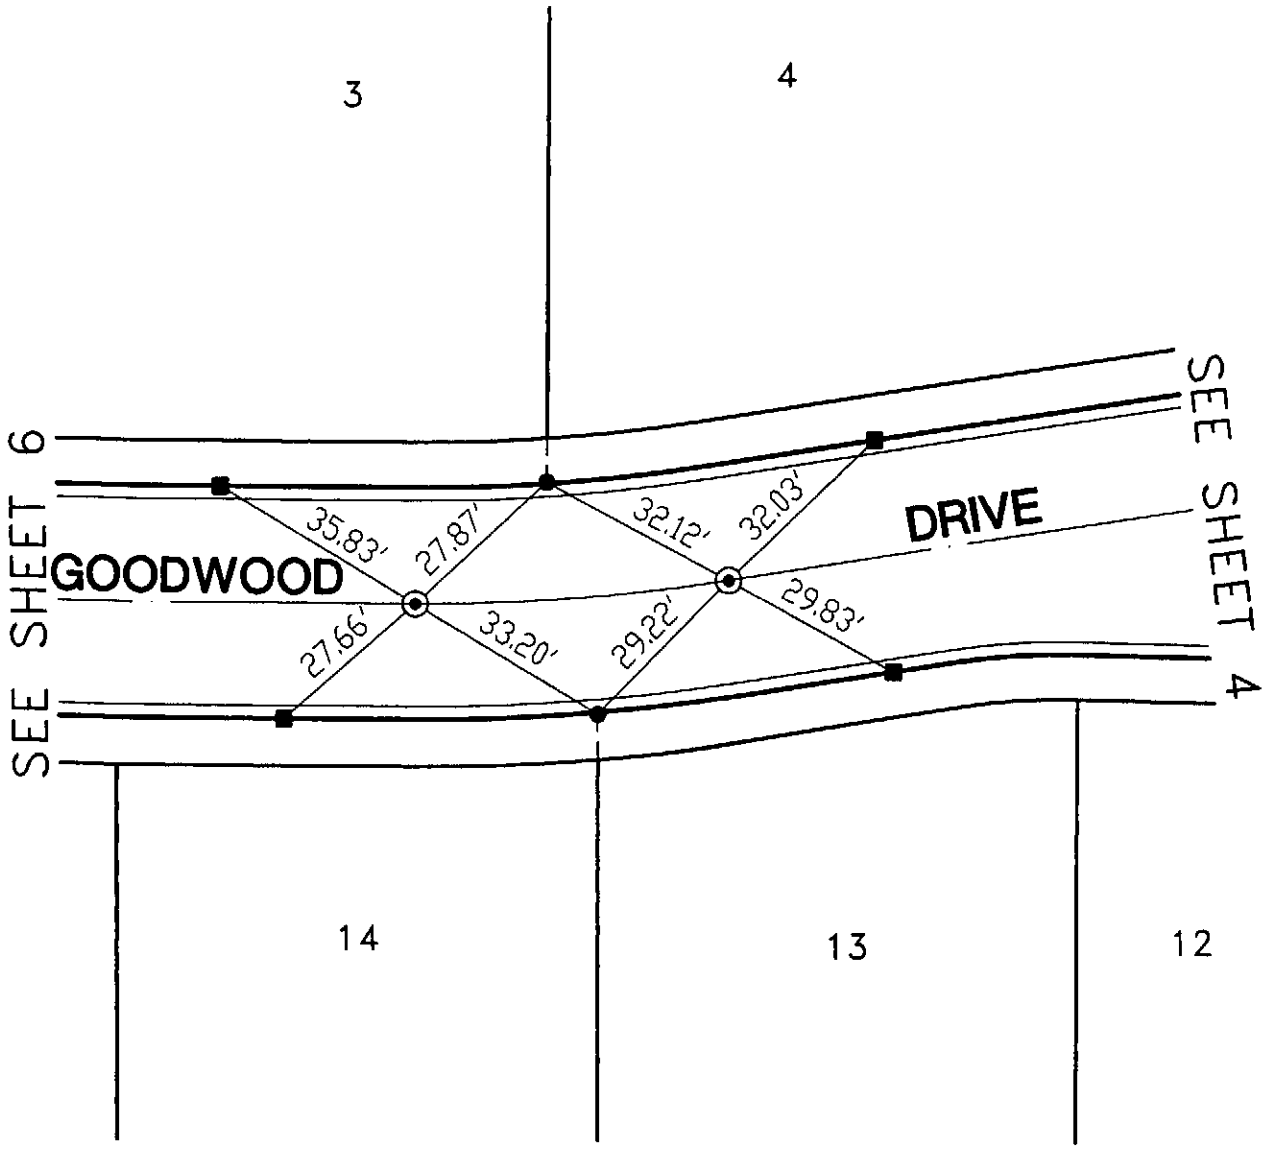

GARY W. DOKICH
L.S. 4693 EXP. 9-30-05

TIE BOOK 24 PAGE 148

CITY OF RANCHO CUCAMONGA
PUBLIC WORKS DEPARTMENT

MDS CONSULTING
MOSER DOKICH SCHULTZ
17320 Redhill Ave. Suite 350 Irvine, CA 92614 Voice: 949-251-8821 FAX: 949-251-0516
PLANNERS ENGINEERS SURVEYORS

5 OF 15

CENTERLINE TIES – TRACT NO. 14498

SCALE: 1"=30'

DATE: 6-2-05

I:\centies\14498\498-05.dwg 6/01/05

LEGEND :

⊗ INDICATES 4 PUNCH MARKS IN MANHOLE RIM TO REFERENCE P.M. ON LID

● INDICATES LEAD, TACK AND TAG STAMPED "L.S. 4693" IN TOP OF CURB

■ INDICATES LEAD & BRASS TACK IN TOP OF CURB

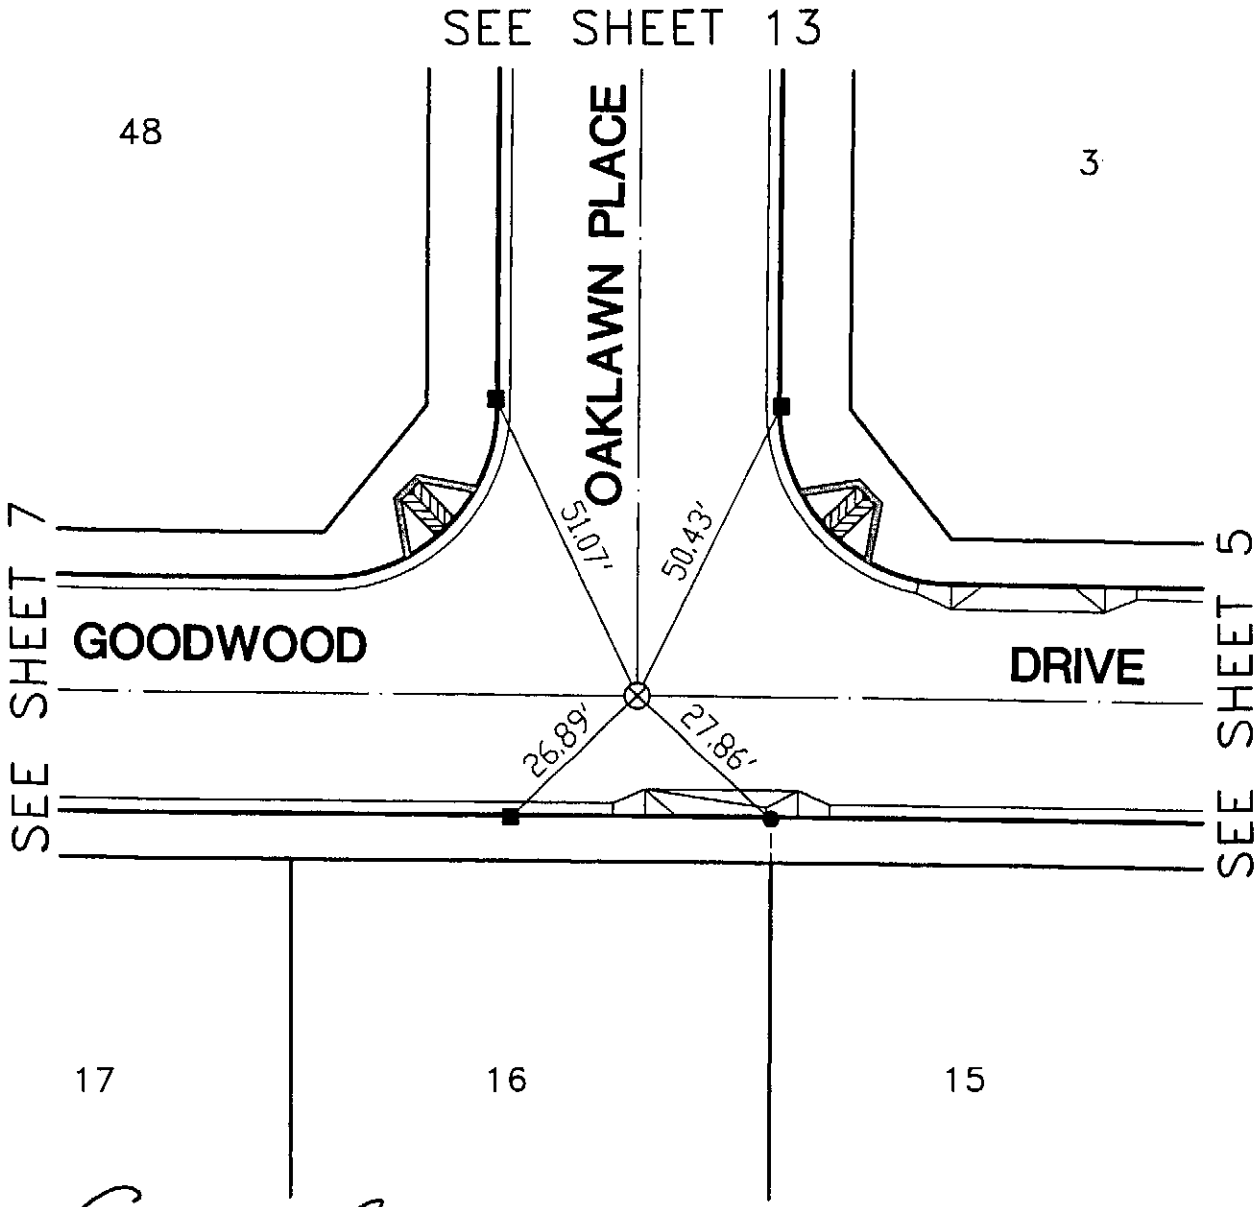

GARY W. DOKICH
L.S. 4693 EXP. 9-30-05

TIE BOOK 24 PAGE 149

CITY OF RANCHO CUCAMONGA
PUBLIC WORKS DEPARTMENT

MDS CONSULTING
MOSSE DOKICH SCHULTZ
17320 Redhill Ave. Suite 350 Irvine, CA 92614 Voice: 949-251-8821 FAX: 949-251-0516
PLANNERS ENGINEERS SURVEYORS

6 OF 15

CENTERLINE TIES - TRACT NO. 14498

SCALE: 1"=30'

DATE: 6-2-05

I:\centies\14498\498-06.dwg 6/01/05

LEGEND :

⊗ INDICATES 4 PUNCH MARKS IN MANHOLE RIM TO REFERENCE P.M. ON LID

■ INDICATES LEAD & BRASS TACK IN TOP OF CURB

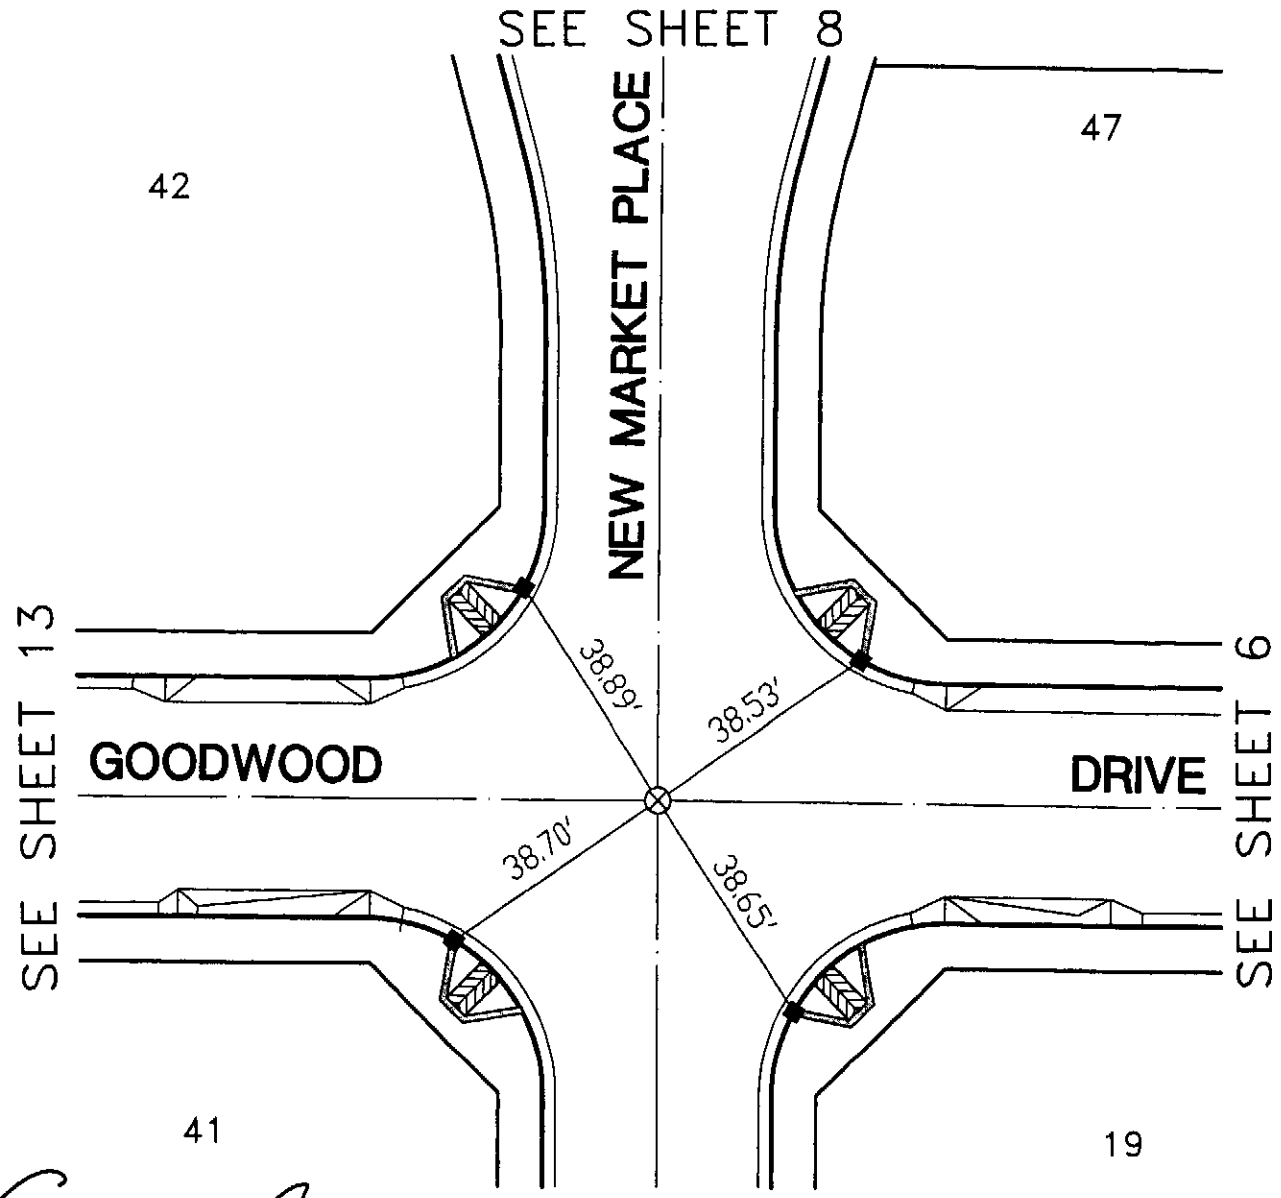

GARY W. DOKICH
L.S. 4693 EXP. 9-30-05

TIE BOOK 24 PAGE 150

CITY OF RANCHO CUCAMONGA
PUBLIC WORKS DEPARTMENT

MDS CONSULTING
PLANNERS ENGINEERS SURVEYORS

7 OF 15

CENTERLINE TIES – TRACT NO. 14498

SCALE: 1"=30'

DATE: 6-2-05

I:\centies\14498\498-07.dwg 6/01/05

LEGEND :

⊙ INDICATES SPIKE AND WASHER STAMPED "L.S. 4693"

● INDICATES LEAD, TACK AND TAG STAMPED "L.S. 4693" IN TOP OF CURB

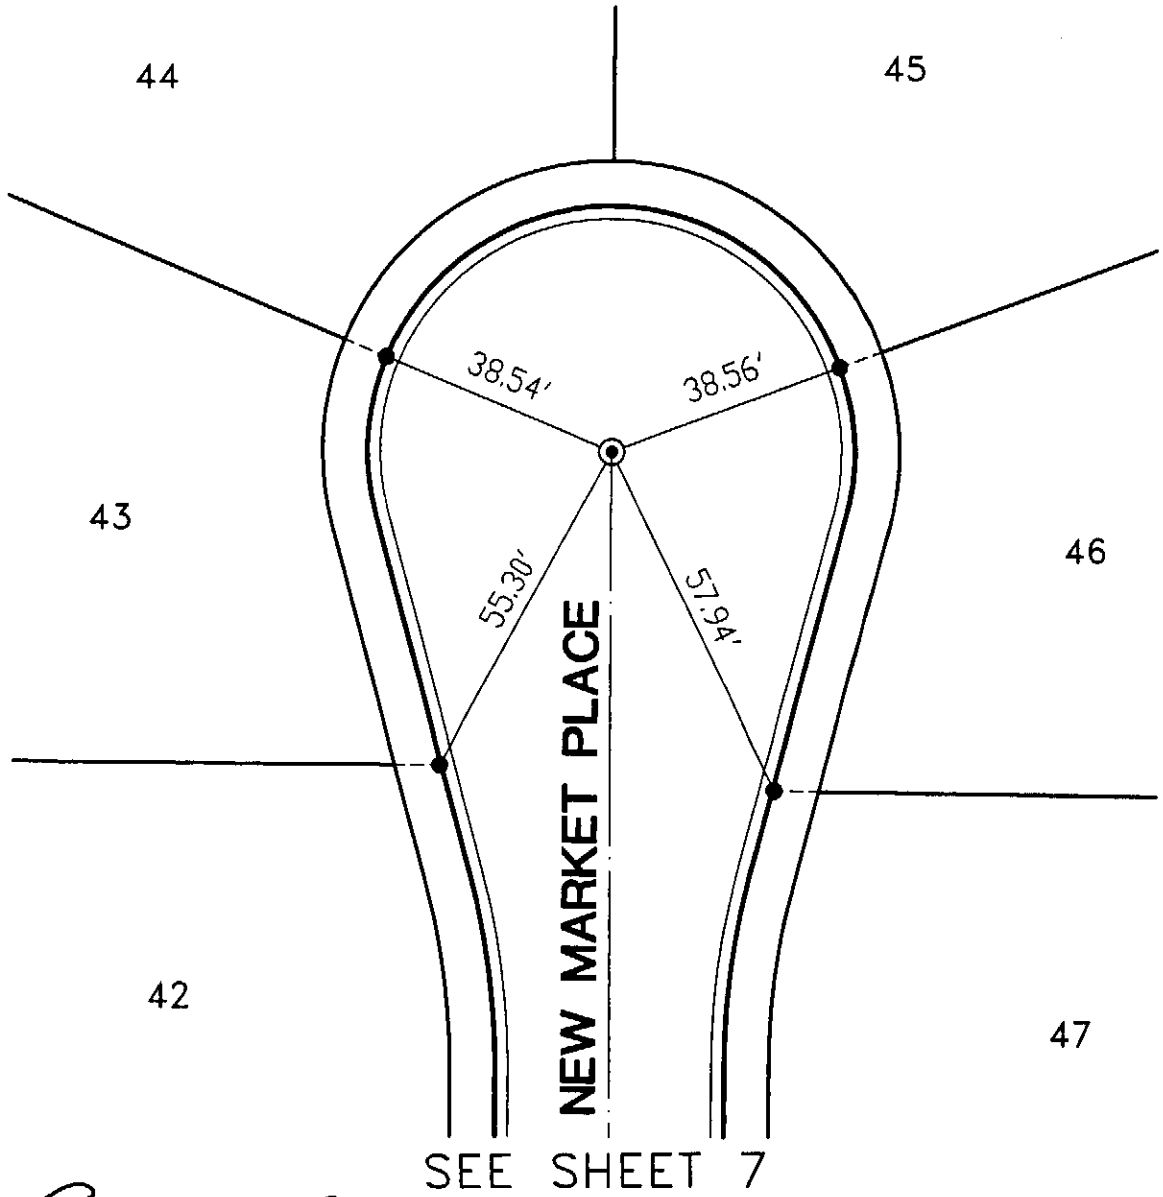

GARY W. DOKICH
L.S. 4693 EXP. 9-30-05

TIE BOOK 24 PAGE 151

CITY OF RANCHO CUCAMONGA
PUBLIC WORKS DEPARTMENT

MDS CONSULTING
MOREE DOKICH SCHULTZ
17320 Redhill Ave., Suite 350
Irvine, CA 92614
Voice: 949-251-8821
FAX: 949-251-0516
PLANNERS ENGINEERS SURVEYORS

8 OF 15

CENTERLINE TIES – TRACT NO. 14498

SCALE: 1"=30'

DATE: 6-2-05

I:\centies\14498\498-08.dwg 6/01/05

LEGEND :

⊗ INDICATES 4 PUNCH MARKS IN MANHOLE RIM TO REFERENCE P.M. ON LID

⊙ INDICATES SPIKE AND WASHER STAMPED "L.S. 4693"

■ INDICATES LEAD & BRASS TACK IN TOP OF CURB

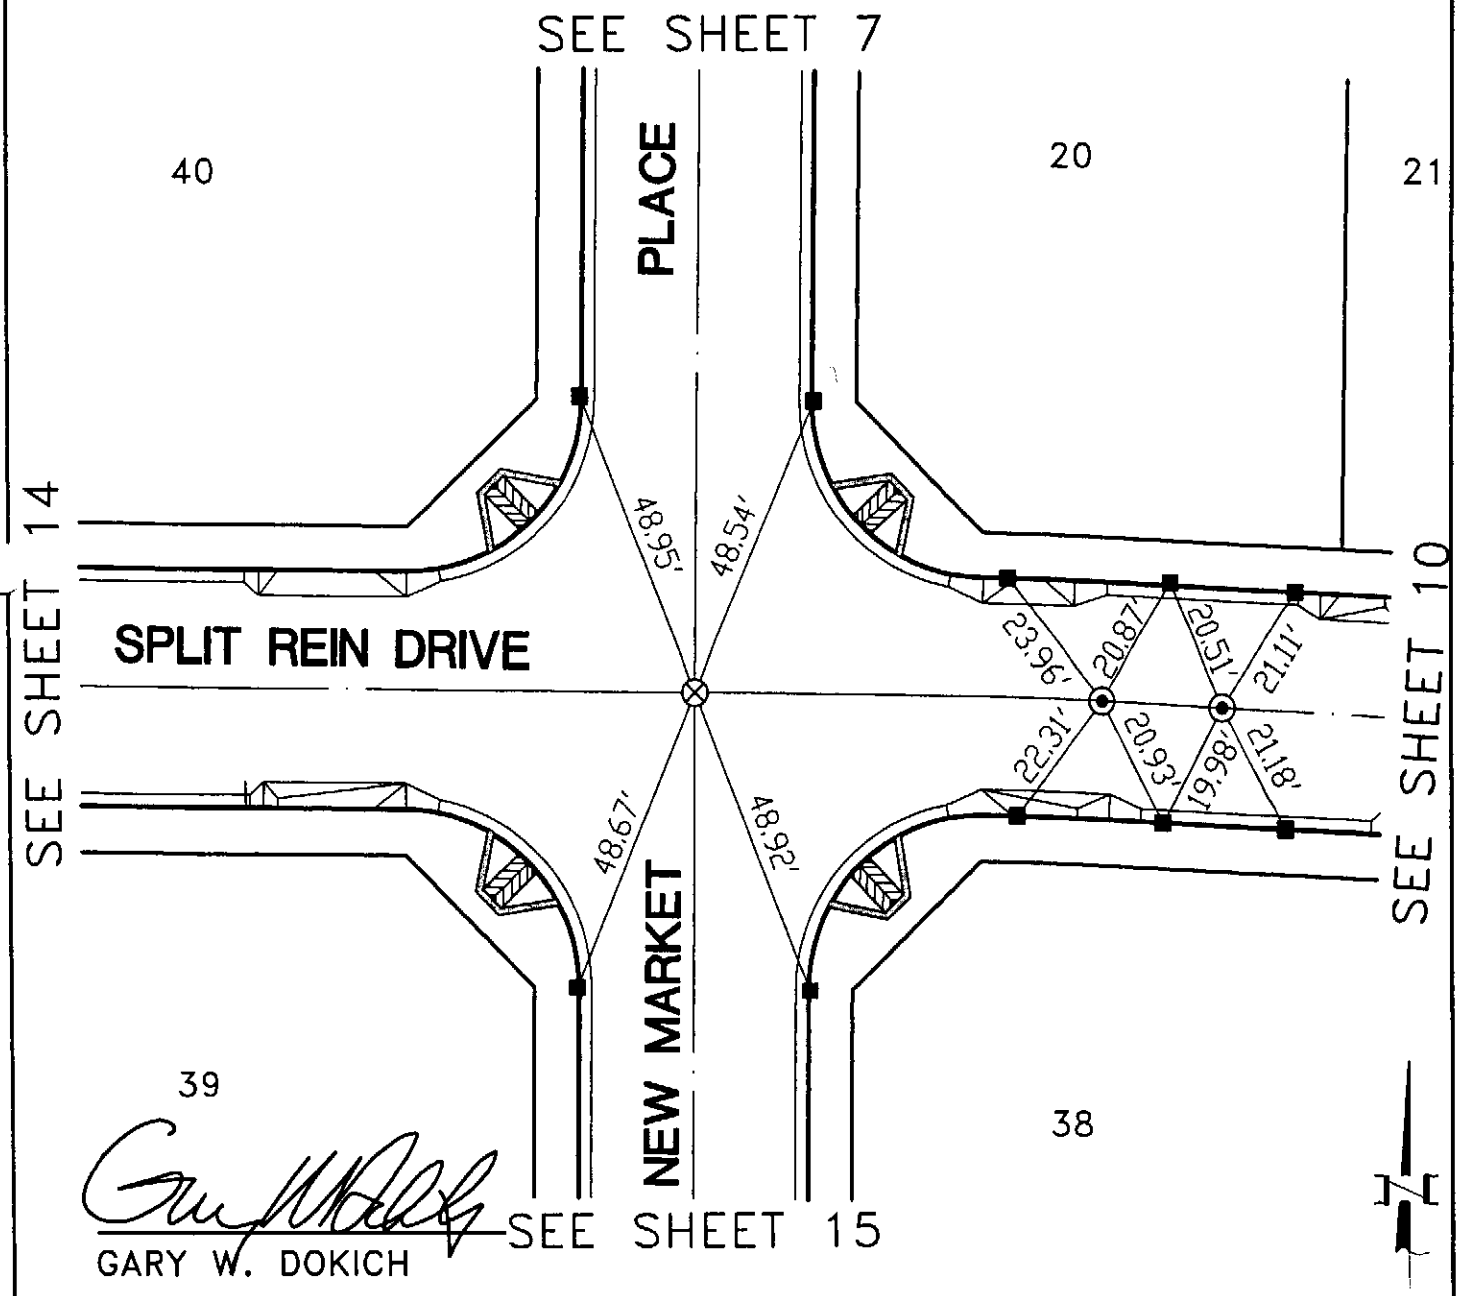

GARY W. DOKICH
L.S. 4693 EXP. 9-30-05

TIE BOOK 24 PAGE 152

CITY OF RANCHO CUCAMONGA

PUBLIC WORKS DEPARTMENT

MDS CONSULTING
MORSE DOKICH SCHULTZ
17320 Redhill Ave. Suite 350 Irvine, CA 92614
Voice: 949-251-8821 FAX: 949-251-0316
PLANNERS ENGINEERS SURVEYORS

9 OF 15

CENTERLINE TIES - TRACT NO. 14498

SCALE: 1"=30'

DATE: 6-2-05

I:\centies\14498\498-09.dwg 6/01/05

LEGEND :

- ⊙ INDICATES SPIKE AND WASHER STAMPED "L.S. 4693"
- ● INDICATES LEAD, TACK AND TAG STAMPED "L.S. 4693" IN TOP OF CURB
- ■ INDICATES LEAD & BRASS TACK IN TOP OF CURB

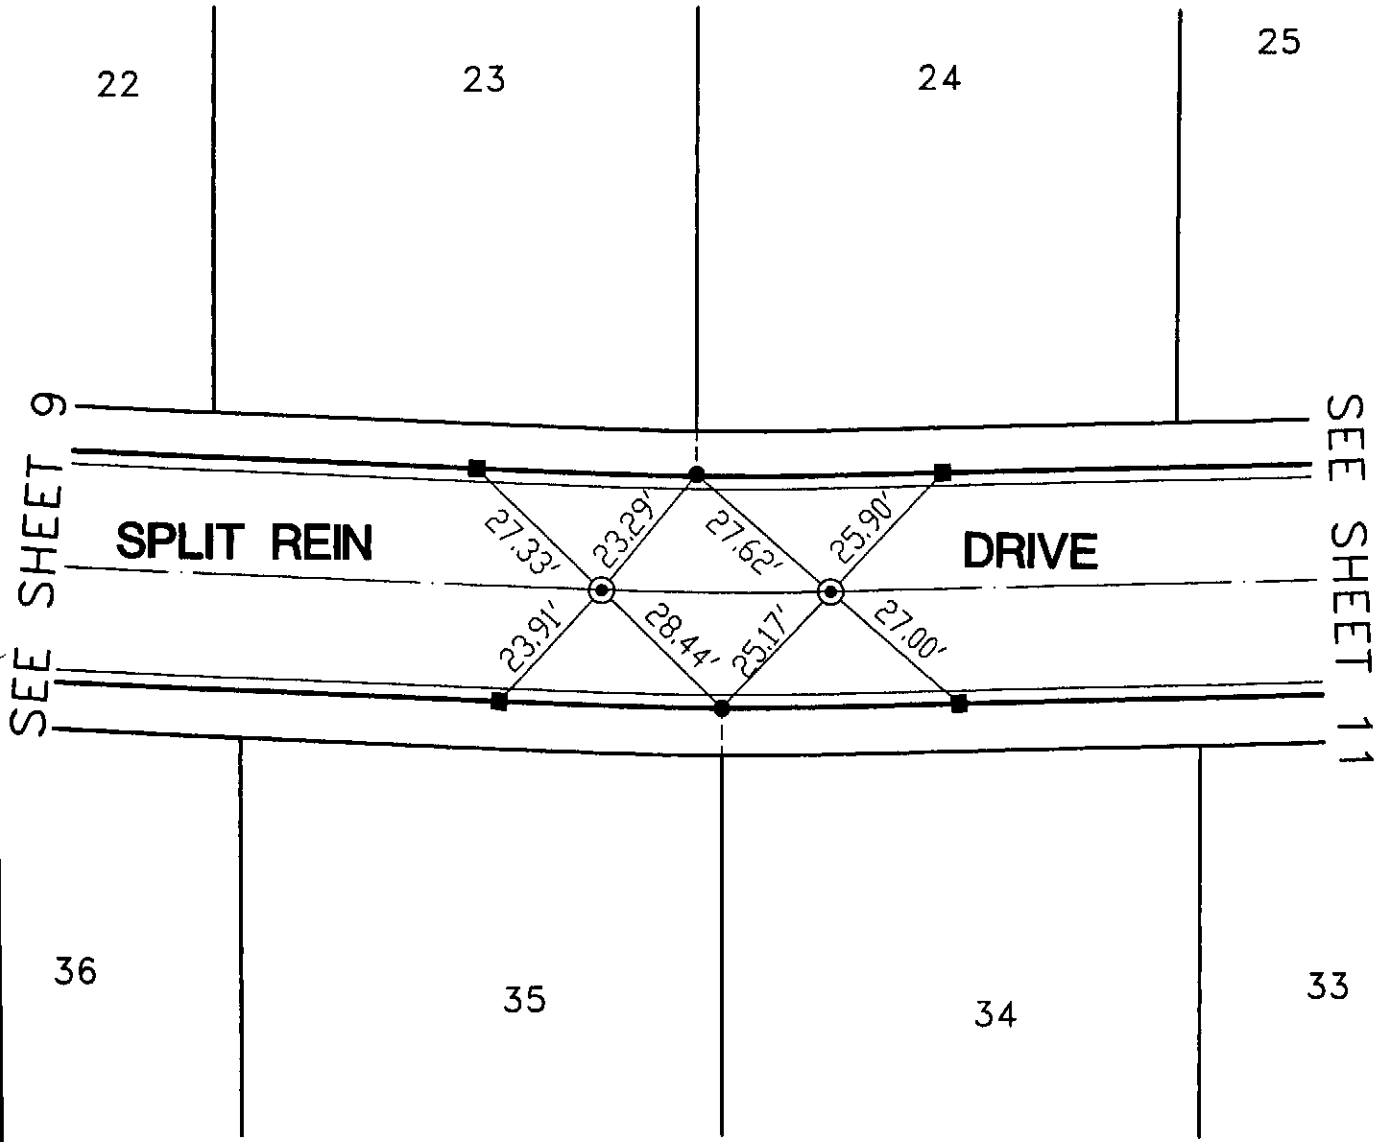

GARY W. DOKICH
L.S. 4693 EXP. 9-30-05

TIE BOOK 24 PAGE 153

CITY OF RANCHO CUCAMONGA
PUBLIC WORKS DEPARTMENT

MDS CONSULTING
MORSE DOKICH SCHULTZ
17320 Redhill Ave. Suite 350 Irvine, CA 92614
Voice: 949-251-8821 FAX: 949-251-0516
PLANNERS ENGINEERS SURVEYORS

10 OF 15

CENTERLINE TIES - TRACT NO. 14498

SCALE: 1"=30'

DATE: 6-2-05

t:\centies\14498\498-10.dwg 6/01/05

LEGEND :

⊙ INDICATES SPIKE AND WASHER STAMPED "L.S. 4693"

● INDICATES LEAD, TACK AND TAG STAMPED "L.S. 4693" IN TOP OF CURB

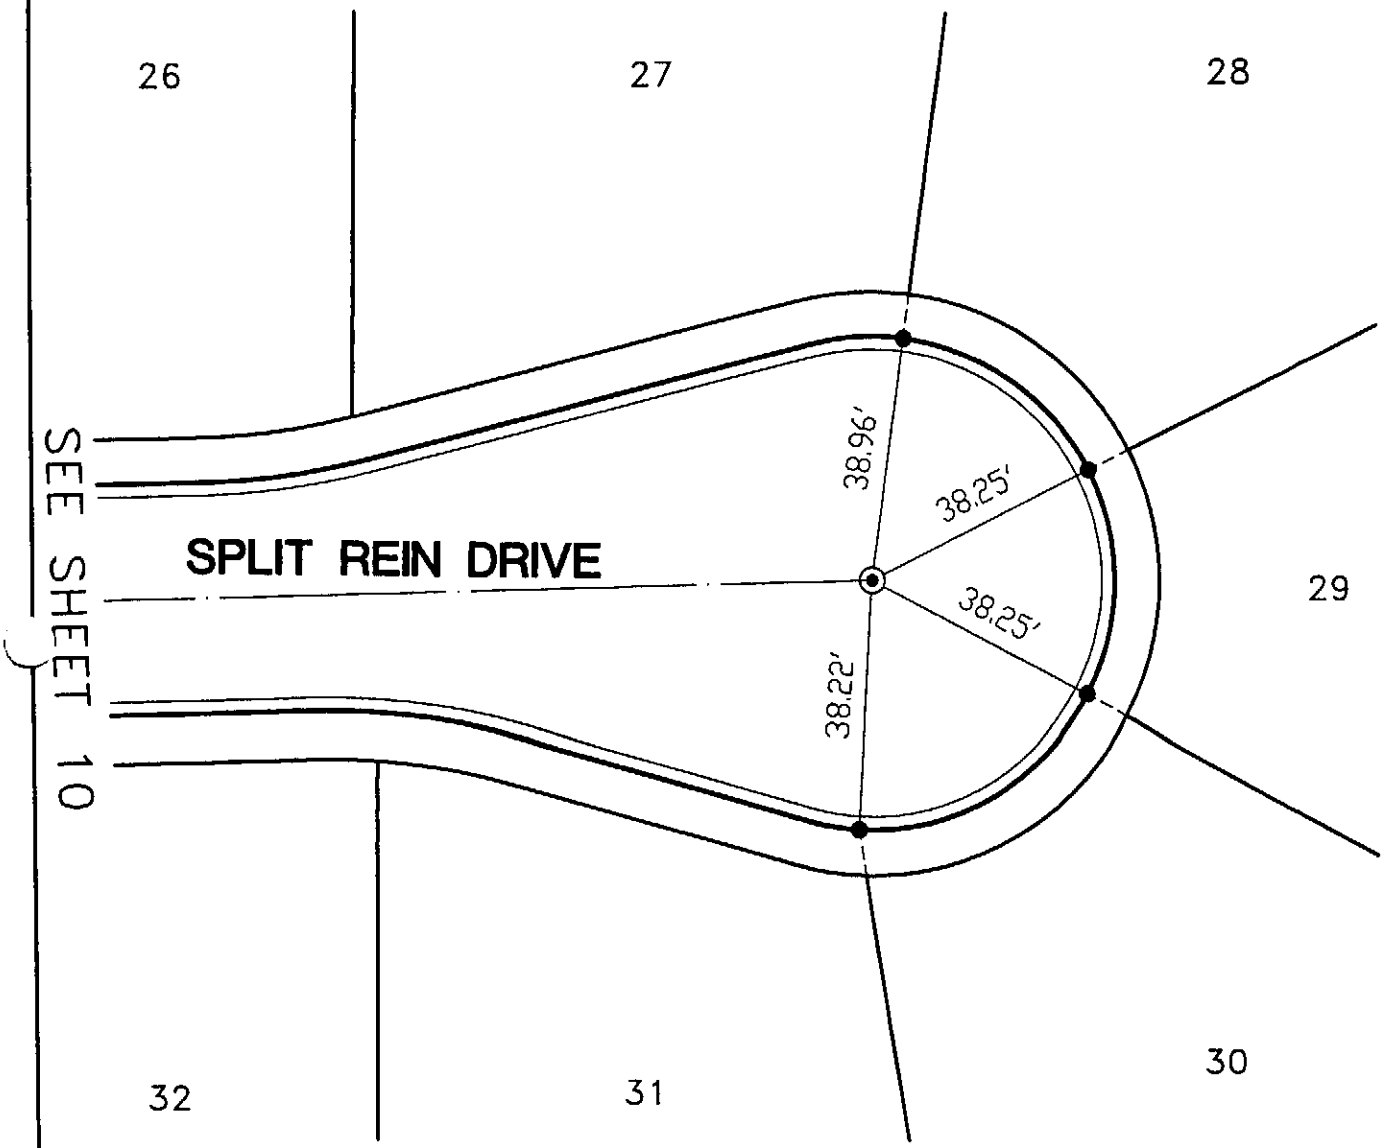

GARY W. DOKICH
L.S. 4693 EXP. 9-30-05

TIE BOOK 24 PAGE 154

CITY OF RANCHO CUCAMONGA
PUBLIC WORKS DEPARTMENT

MDS CONSULTING
MOSES DOKICH SCHULTZ
17320 Redhill Ave. Suite 350 Irvine, CA 92614 Voice: 949-251-8831 FAX: 949-251-0516
PLANNERS ENGINEERS SURVEYORS

11 OF 15

CENTERLINE TIES – TRACT NO. 14498

SCALE: 1"=30'

DATE: 6-2-05

I:\centies\14498\498-11.dwg 6/01/05

LEGEND :

● INDICATES 1" I.P W/PLASTIC PLUG

■ INDICATES LEAD & BRASS TACK IN TOP OF CURB

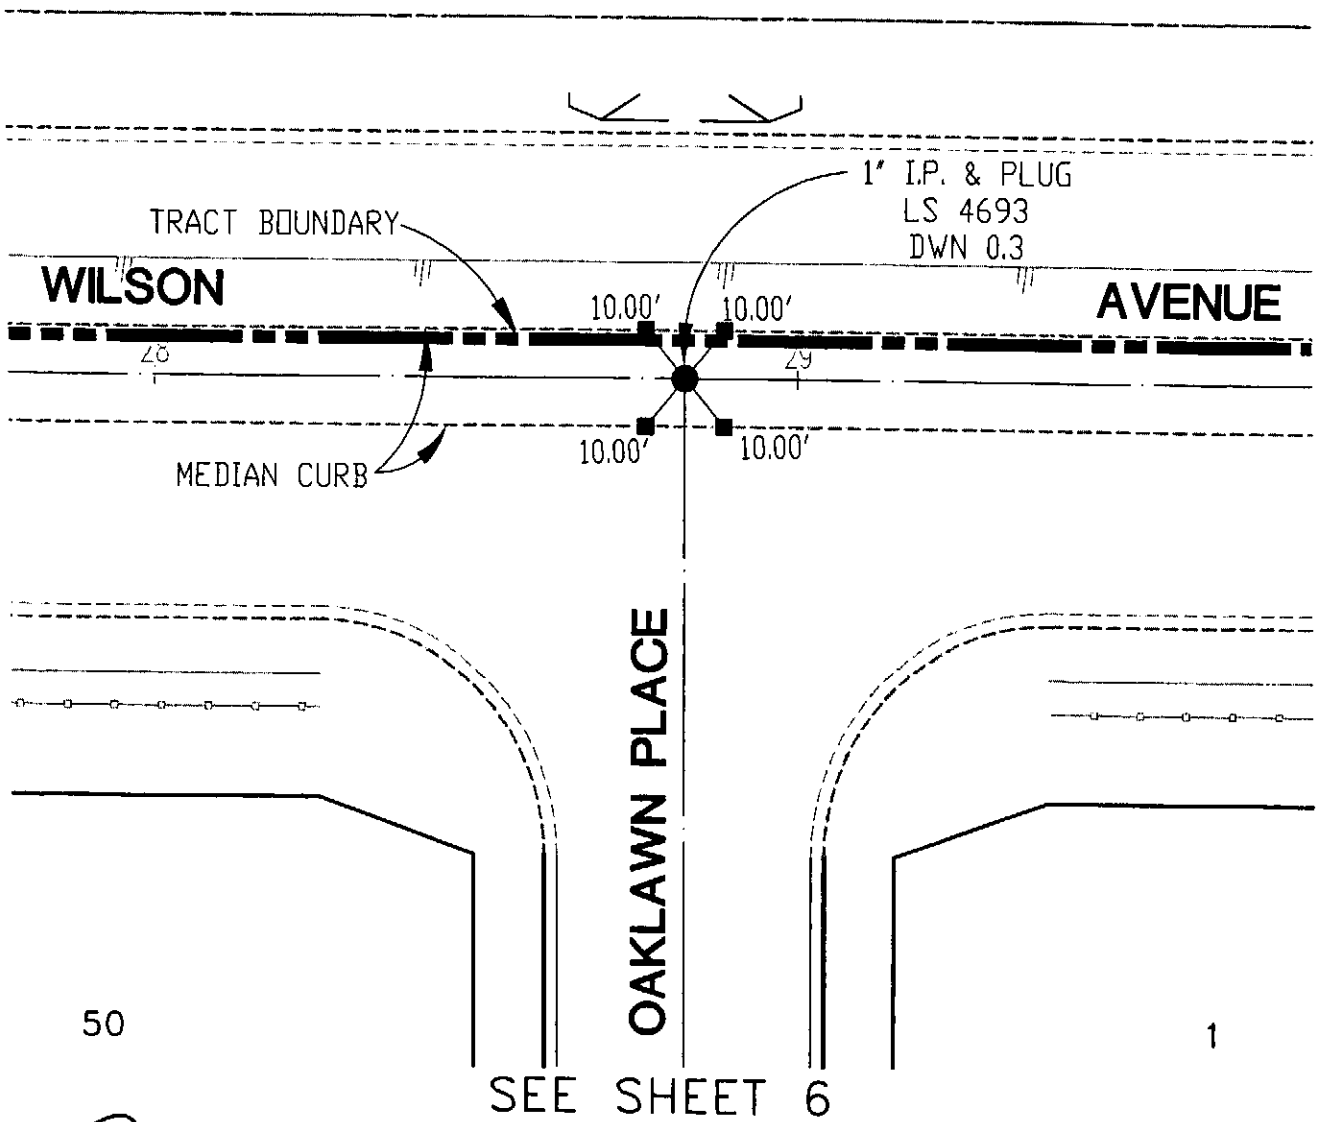

GARY W. DOKICH
L.S. 4693 EXP. 9-30-05

TIE BOOK 24 PAGE 155

CITY OF RANCHO CUCAMONGA
PUBLIC WORKS DEPARTMENT

MDS CONSULTING
MOREE DOKICH SCHULTZ
17320 Redhill Ave. Suite 350 Irvine, CA 92614 Voice: 949-251-8821 FAX: 949-251-0816
PLANNERS ENGINEERS SURVEYORS

12 OF 15

CENTERLINE TIES – TRACT NO. 14498

SCALE: 1"=30'

DATE: 6-2-05

I:\centies\14498\498-12.dwg 6/01/05

LEGEND :

⊙ INDICATES SPIKE AND WASHER STAMPED "L.S. 4693"

■ INDICATES LEAD & BRASS TACK IN TOP OF CURB

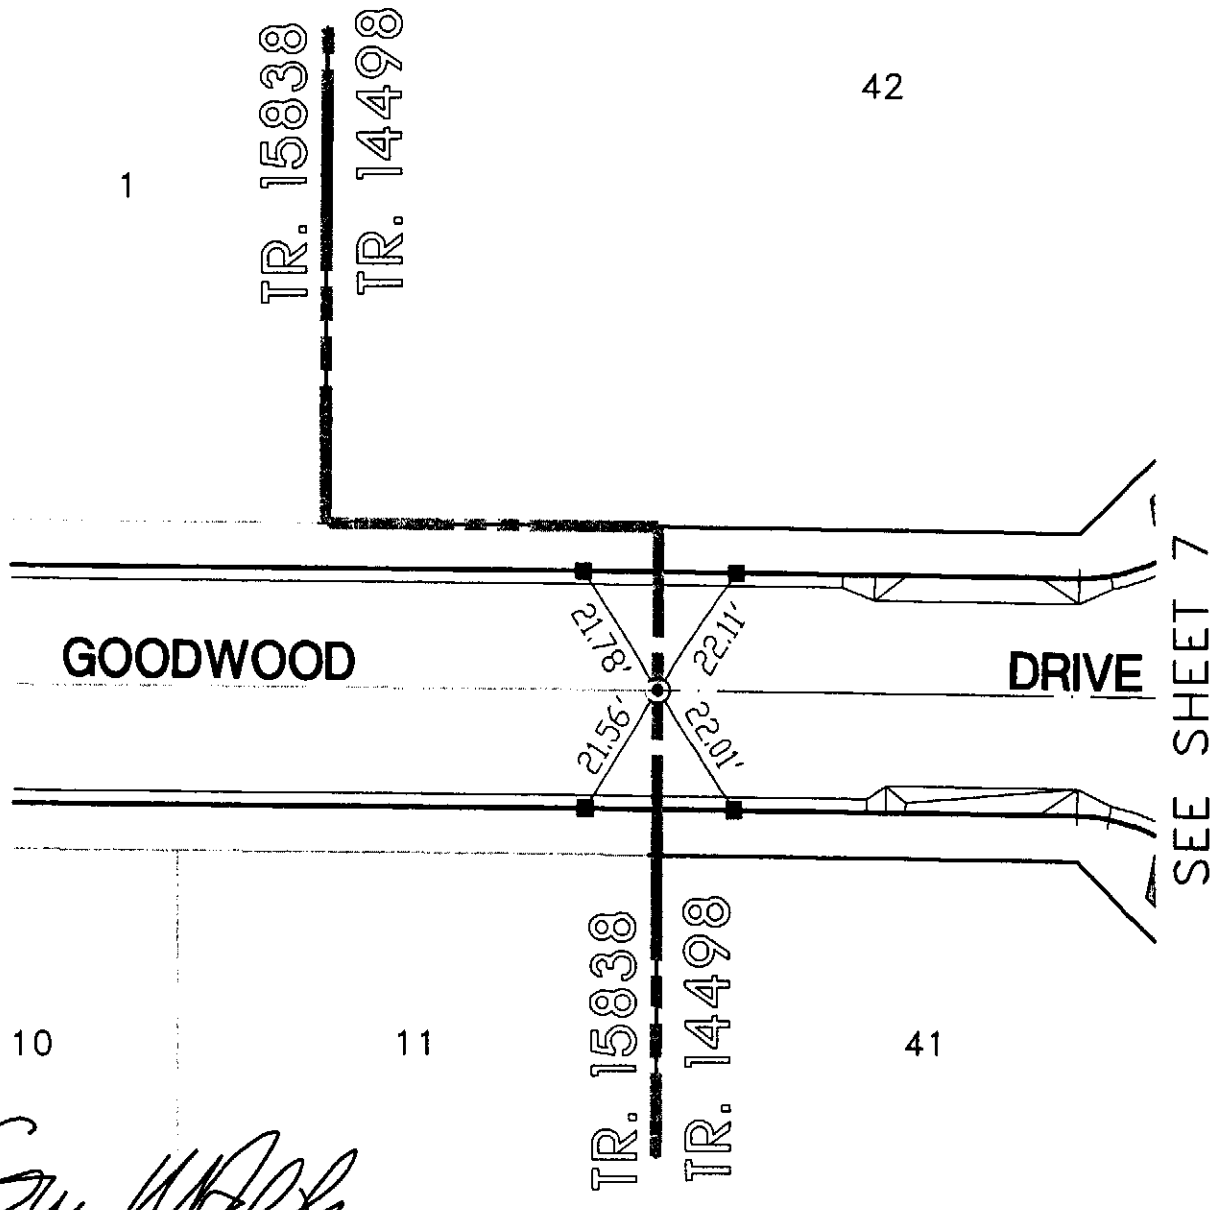

GARY W. DOKICH
L.S. 4693 EXP. 9-30-05

TIE BOOK 24 PAGE 156

CITY OF RANCHO CUCAMONGA
PUBLIC WORKS DEPARTMENT

MDS CONSULTING
MOSSE DOKICH SCHULTZ
17320 Redhill Ave., Suite 350
Irvine, CA 92614
Voice: 949-251-8821
FAX: 949-251-0514
PLANNERS ENGINEERS SURVEYORS

13 OF 15

CENTERLINE TIES – TRACT NO. 14498

SCALE: 1"=30'

DATE: 6-2-05

I:\centies\14498\498-13.dwg 6/01/05

LEGEND :

◉ INDICATES SPIKE AND WASHER STAMPED "L.S. 4693"

■ INDICATES LEAD & BRASS TACK IN TOP OF CURB

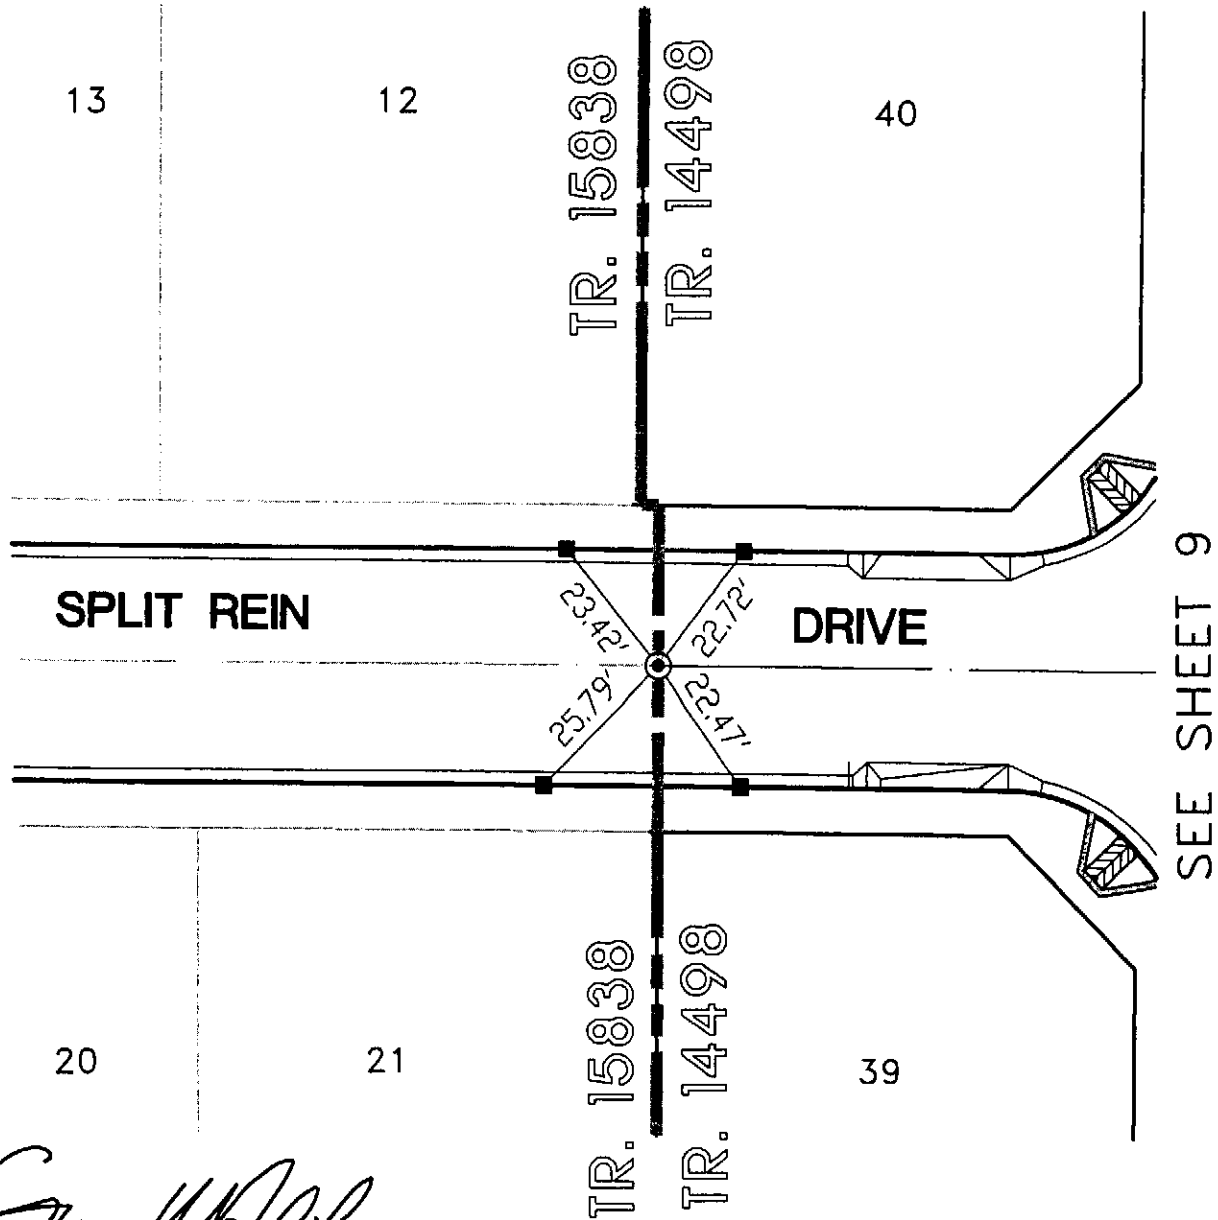

GARY W. DOKICH
L.S. 4693 EXP. 9-30-05

TIE BOOK 24 PAGE 157

CITY OF RANCHO CUCAMONGA
PUBLIC WORKS DEPARTMENT

MDS CONSULTING
MORSE DOKICH SCHULTZ
17330 Redhill Ave. Suite 350 Irvine, CA 92614 Voice: 949-251-8821 FAX: 949-251-0516
PLANNERS ENGINEERS SURVEYORS

14 OF 15

CENTERLINE TIES – TRACT NO. 14498

SCALE: 1"=30'

DATE: 6-2-05

I:\centies\14498\498-14.dwg 6/01/05

LEGEND :

⊙ INDICATES SPIKE AND WASHER STAMPED "L.S. 4693"

■ INDICATES LEAD & BRASS TACK IN TOP OF CURB

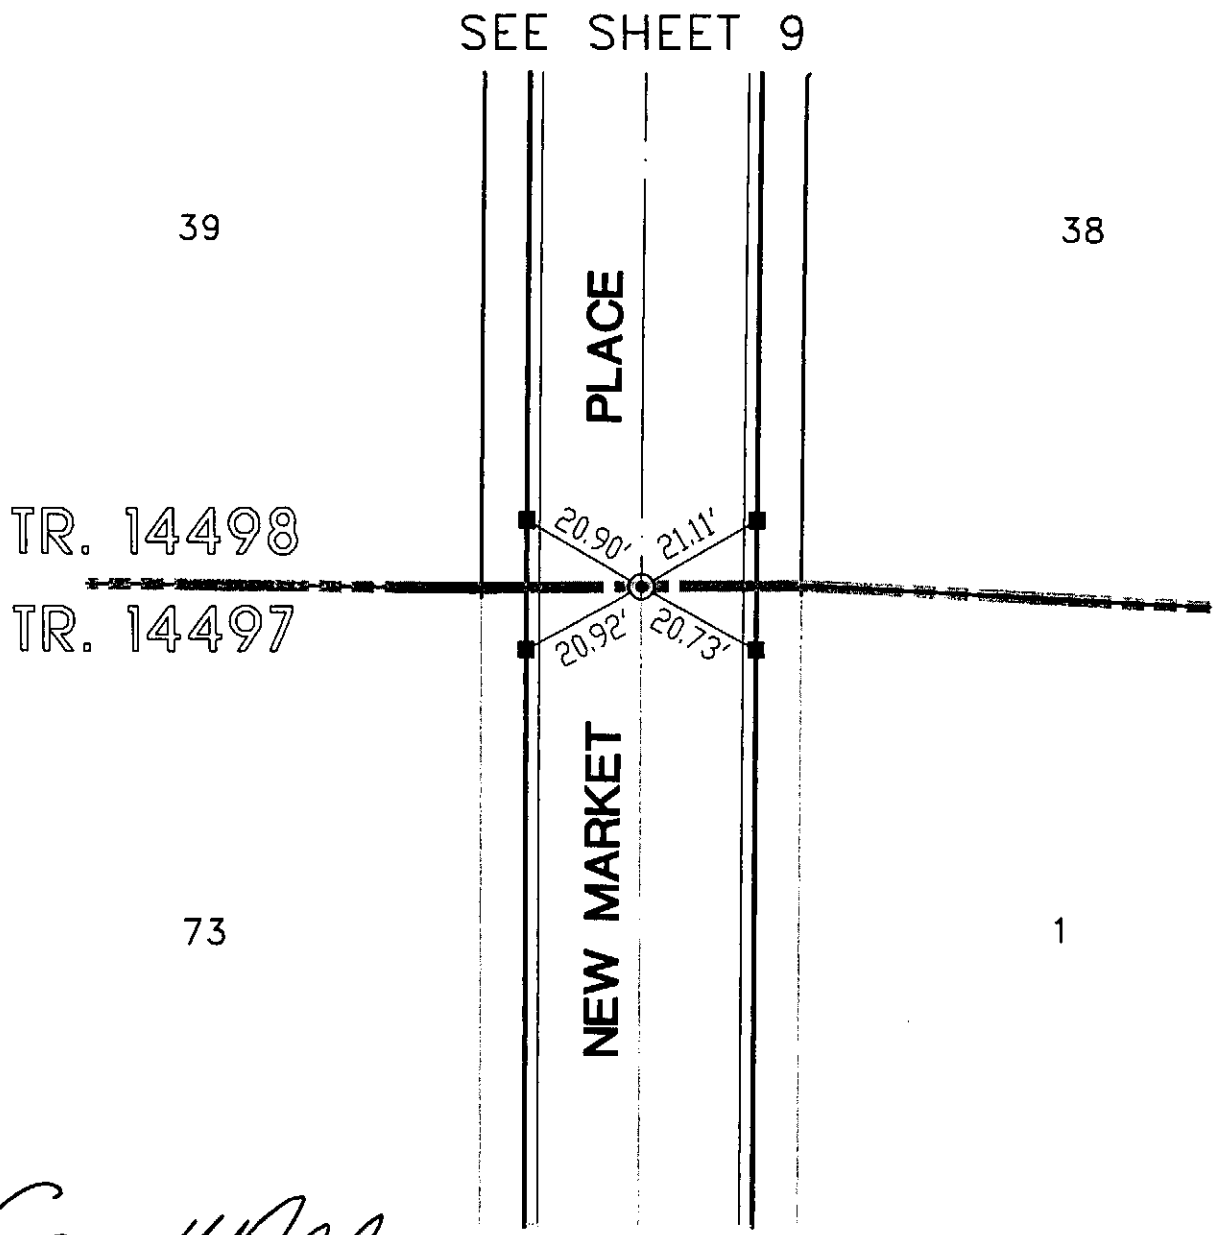

GARY W. DOKICH
L.S. 4693 EXP. 9-30-05

TIE BOOK 24 PAGE 158

CITY OF RANCHO CUCAMONGA
PUBLIC WORKS DEPARTMENT

MDS CONSULTING
MOESS DOKICH SCHULTZ
17320 Redhill Ave. Suite 350 Irvine, CA 92614 Voice: 949-251-8821 FAX: 949-251-0516
PLANNERS ENGINEERS SURVEYORS

15 OF 15

CENTERLINE TIES – TRACT NO. 14498

SCALE: 1"=30'

DATE: 6-2-05

I:\centies\14498\498-15.dwg 6/01/05

CENTERLINE TIES

TRACT NO. 15838

GARY W. DOKICH
L.S. 4693 EXP. 9-30-05

CITY OF RANCHO CUCAMONGA
PUBLIC WORKS DEPARTMENT

MDS CONSULTING
MOSES DOKICH SCHULTZ
17320 Redhill Ave.
Suite 350
Irvine, CA 92614
Voice: 949-251-8821
FAX: 949-251-0916
PLANNERS ENGINEERS SURVEYORS

CENTERLINE TIES – TRACT NO. 15838

DATE: 6-1-05

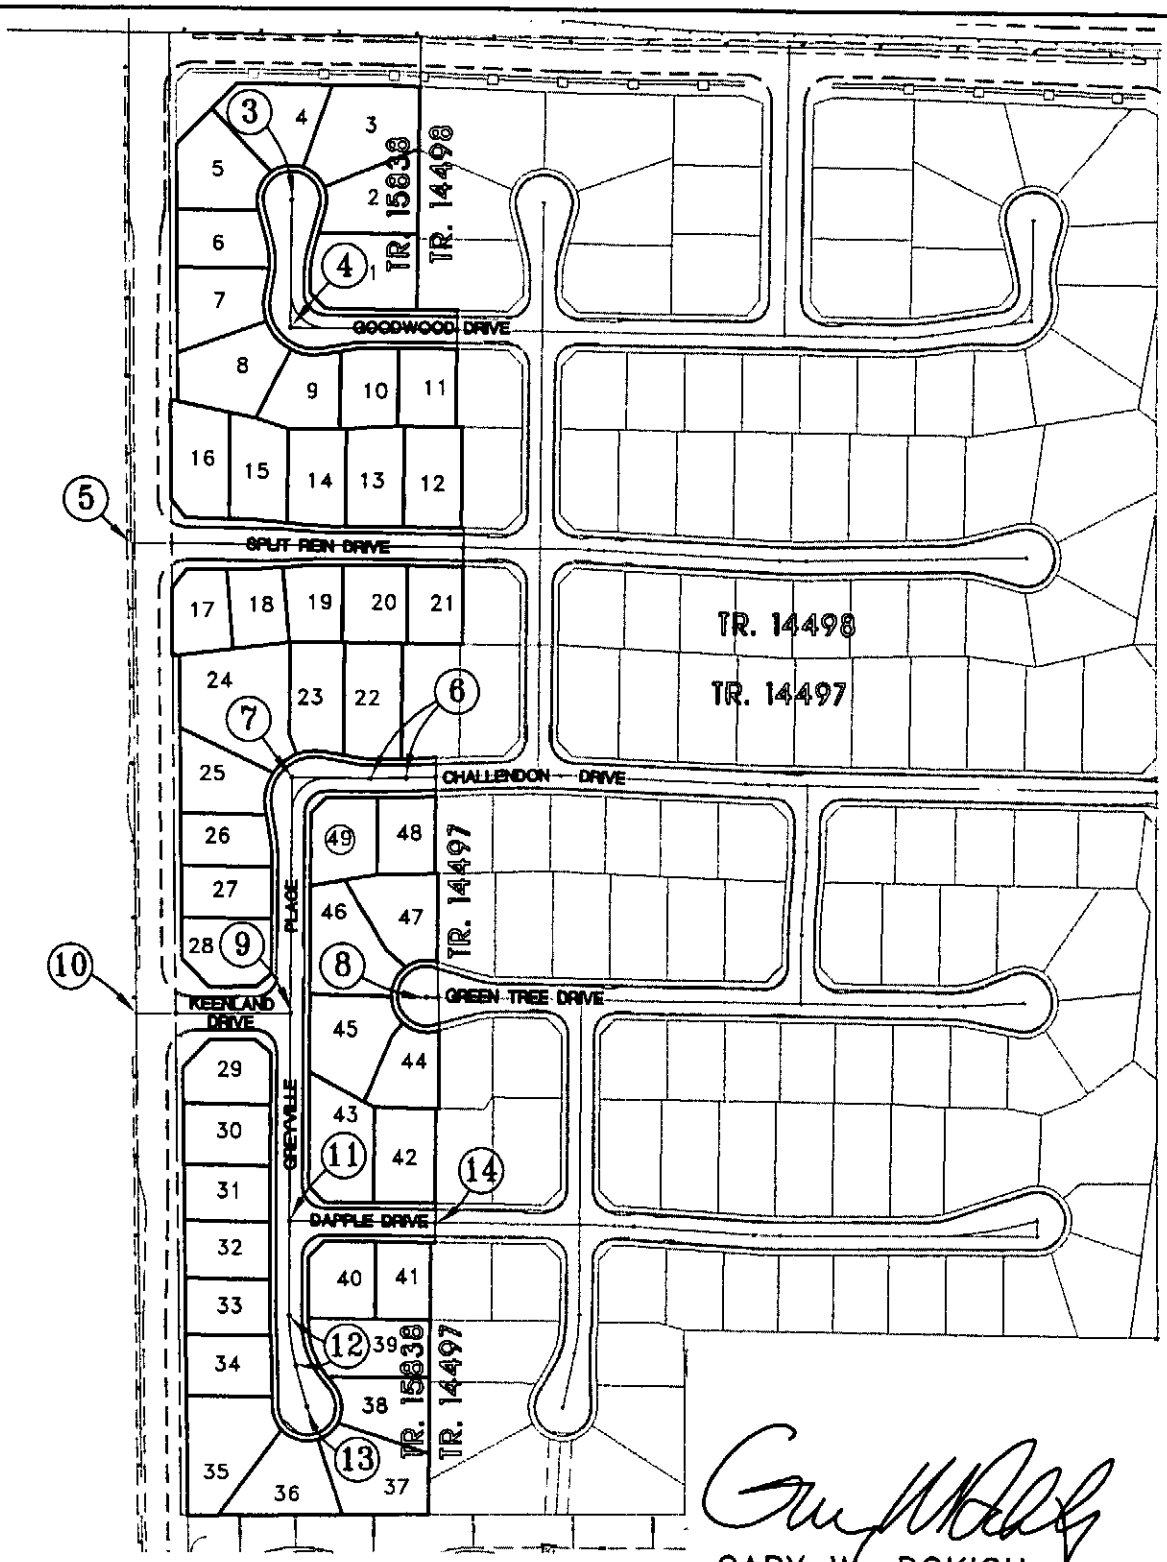

GARY W. DOKICH
L.S. 4693 EXP. 9-30-05

N

LEGEND :

(4) DENOTES SHEET NUMBERS

TIE BOOK 24 PAGE 159


PUBLIC WORKS DEPARTMENT

MDS CONSULTING
MORSE DOKICH SCHULTZ
17320 Redhill Ave. Suite 350 Irvine, CA 92614 Voice: 949-251-8821 FAX: 949-251-0316
PLANNERS ENGINEERS SURVEYORS

2 OF 14

CENTERLINE TIES – TRACT NO. 15838

SCALE: 1"=150'

DATE: 6-1-05

I:\centies\15838\838-02.dwg 6/01/05

LEGEND :

⊙ INDICATES SPIKE AND WASHER STAMPED "L.S. 4693"

● INDICATES LEAD, TACK AND TAG STAMPED "L.S. 4693" IN TOP OF CURB

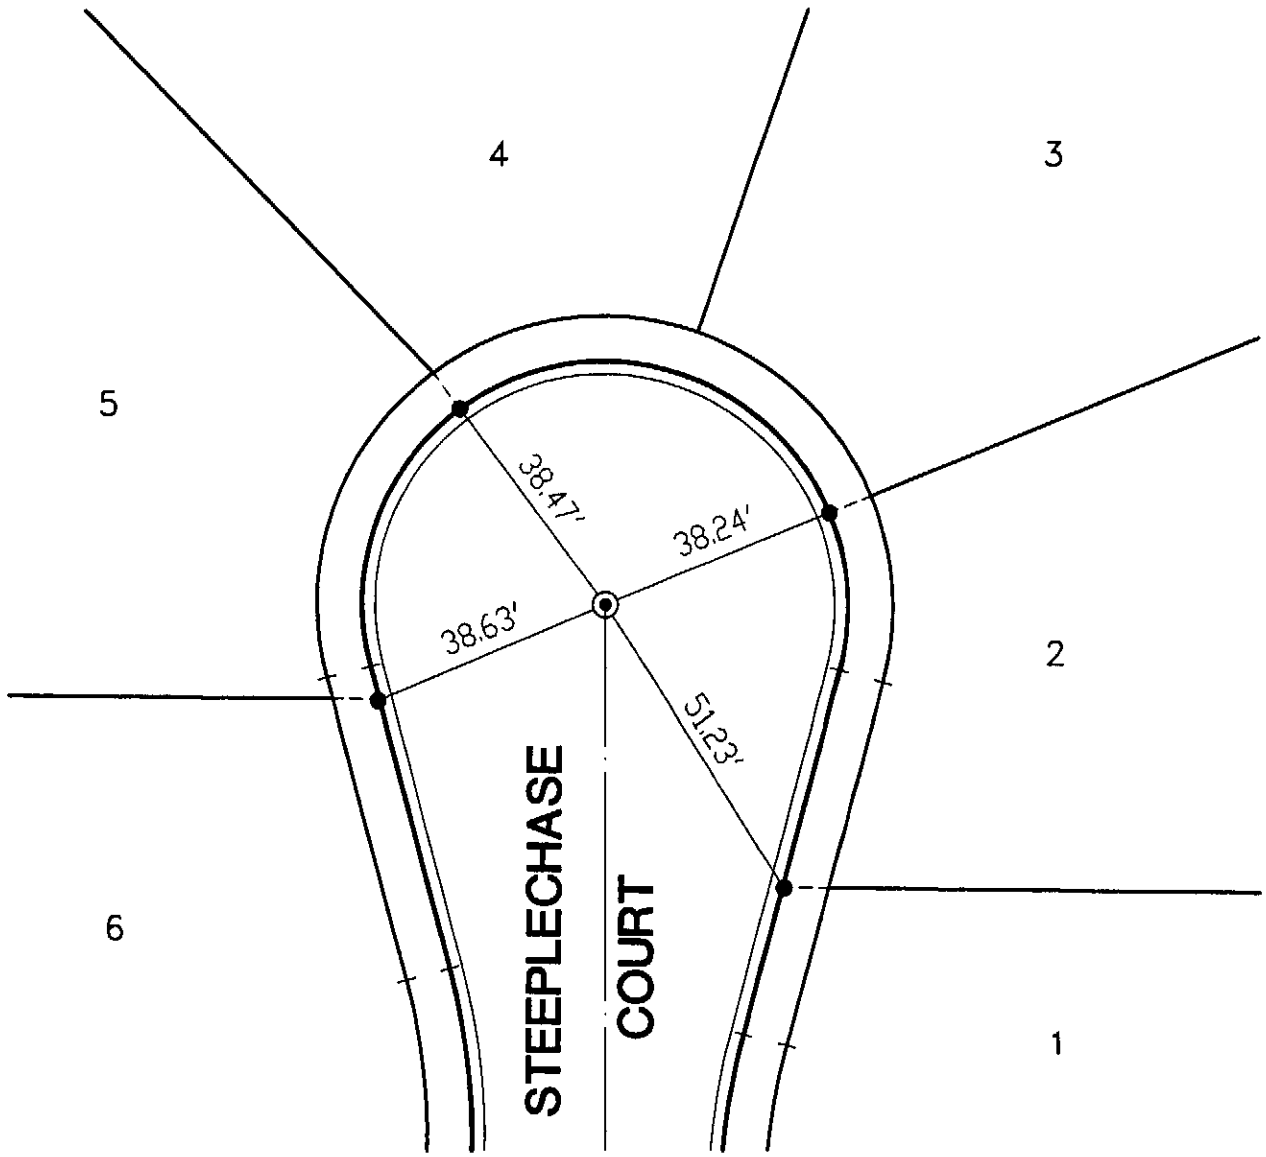

SEE SHEET 4

GARY W. DOKICH
L.S. 4693 EXP. 9-30-05

TIE BOOK 24 PAGE 160

CITY OF RANCHO CUCAMONGA
PUBLIC WORKS DEPARTMENT

MDS CONSULTING
MORSE DOKICH SCHULTZ
17320 Redhill Ave., Suite 350, Irvine, CA 92614
Voice: 949-251-8821
FAX: 949-251-0516
PLANNERS ENGINEERS SURVEYORS

CENTERLINE TIES – TRACT NO. 15838

SCALE: 1"=30'

DATE: 6-1-05

f:\centies\15838\838-03.dwg 6/01/05

LEGEND :

⊗ INDICATES 4 PUNCH MARKS IN MANHOLE RIM TO REFERENCE P.M. ON LID

● INDICATES LEAD, TACK AND TAG STAMPED "L.S. 4693" IN TOP OF CURB

■ INDICATES LEAD & BRASS TACK IN TOP OF CURB

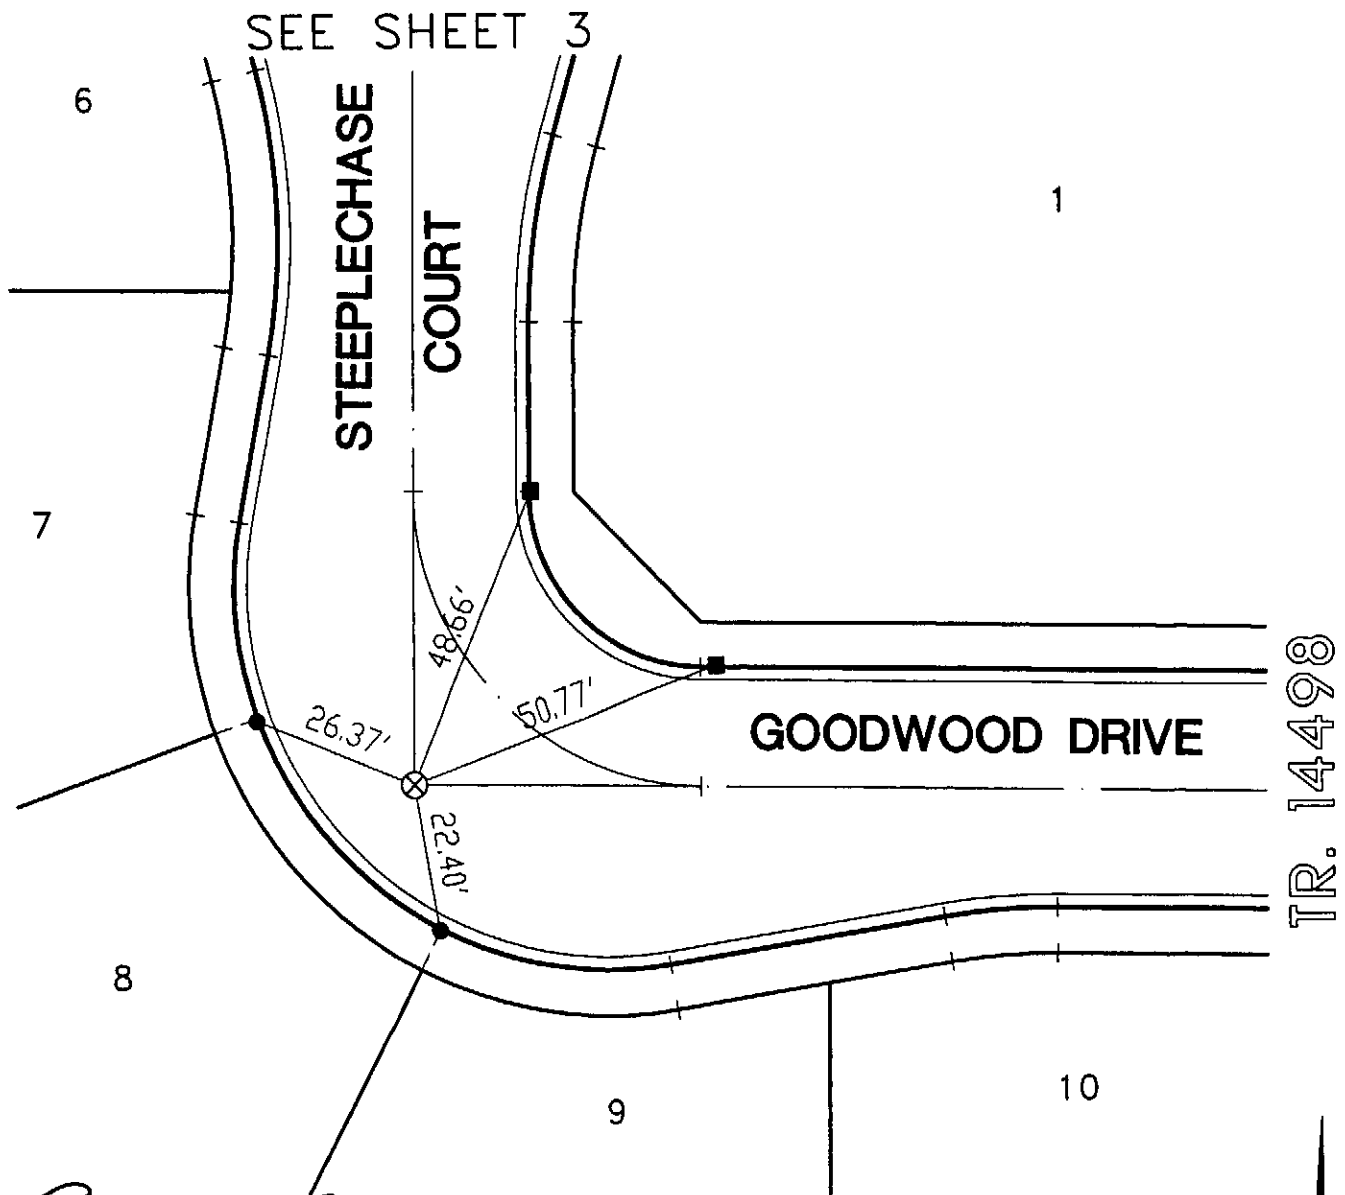

GARY W. DOKICH
L.S. 4693 EXP. 9-30-05

TIE BOOK 24 PAGE 161

CITY OF RANCHO CUCAMONGA
PUBLIC WORKS DEPARTMENT

MDS CONSULTING
MOSS DOKICH SCHULTZ
17320 Redhill Ave. Suite 350 Irvine, CA 92614
Voice: 949-251-8821 FAX: 949-251-0516
PLANNERS ENGINEERS SURVEYORS

CENTERLINE TIES - TRACT NO. 15838

SCALE: 1"=30'

DATE: 6-1-05

I:\centies\15838\838-04.dwg 6/01/05

LEGEND :

⊙ INDICATES SPIKE AND WASHER STAMPED "L.S. 4693"

■ INDICATES LEAD & BRASS TACK IN TOP OF CURB

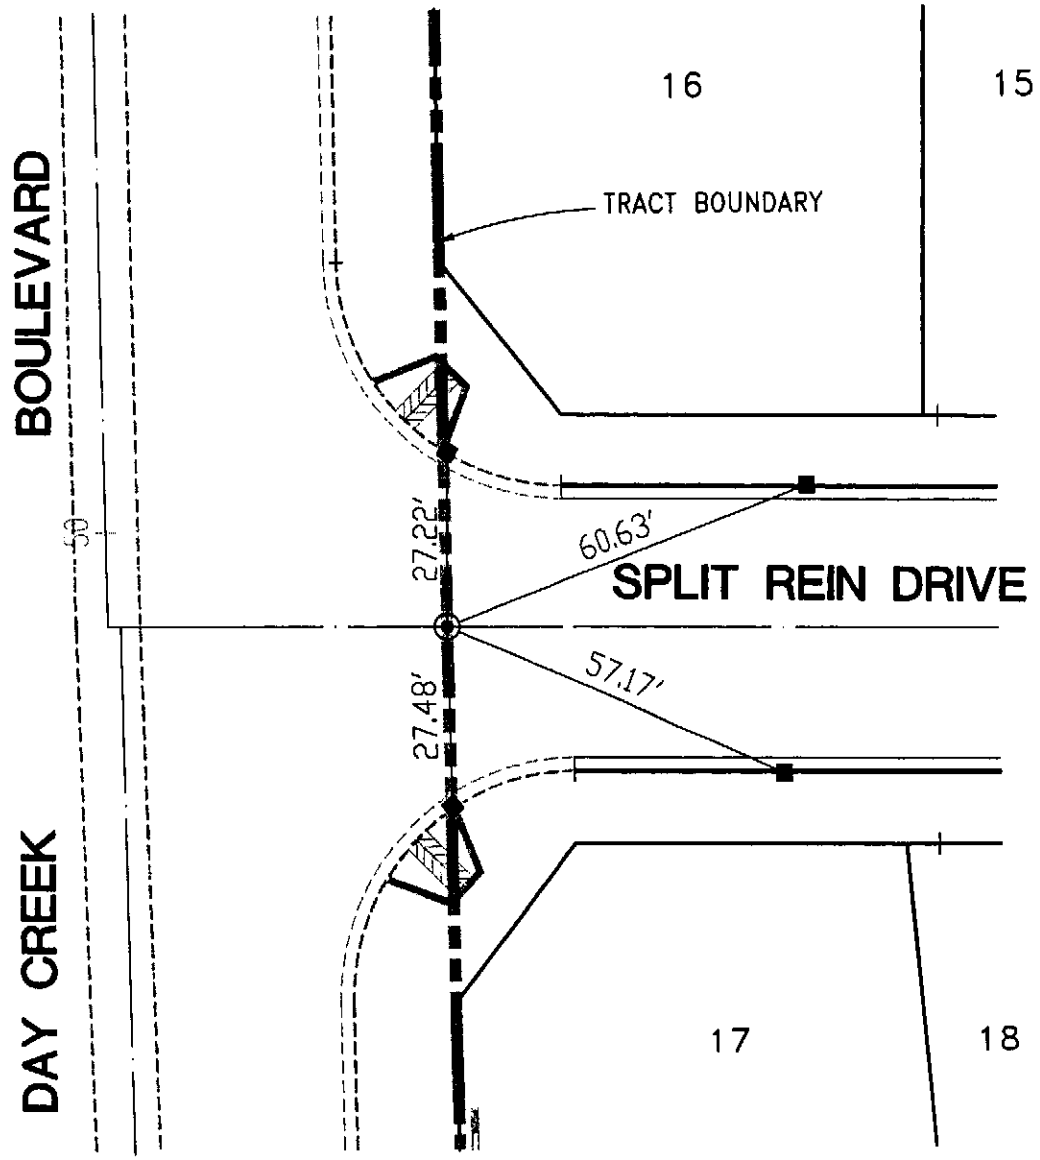

GARY W. DOKICH
L.S. 4693 EXP. 9-30-05

TIE BOOK 24 PAGE 162

CITY OF RANCHO CUCAMONGA
PUBLIC WORKS DEPARTMENT

MDS CONSULTING
MOESS DOKICH SCHULTZ
17320 Redhill Ave. Suite 350 Irvine, CA 92614
Voice: 949-251-8831 FAX: 949-251-0516
PLANNERS ENGINEERS SURVEYORS

5 OF 14

CENTERLINE TIES – TRACT NO. 15838

SCALE: 1"=30'

DATE: 6-1-05

I:\centies\15838\838-05.dwg 6/01/05

LEGEND :

- ⊙ INDICATES SPIKE AND WASHER STAMPED "L.S. 4693"
- ● INDICATES LEAD, TACK AND TAG STAMPED "L.S. 4693" IN TOP OF CURB
- ■ INDICATES LEAD & BRASS TACK IN TOP OF CURB

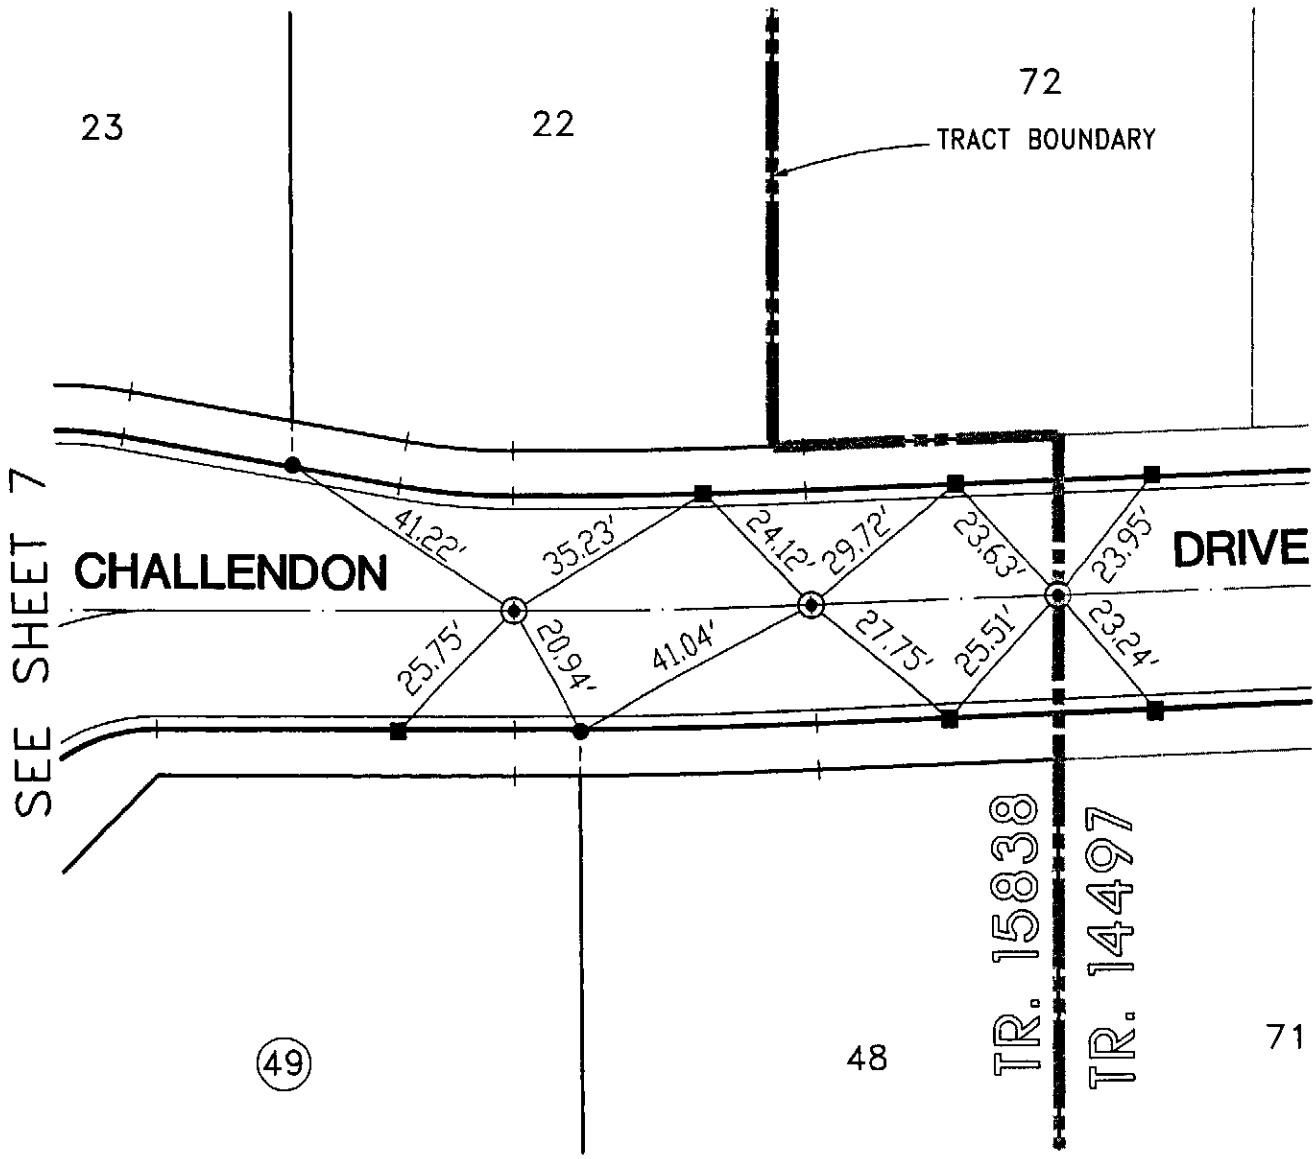

GARY W. DOKICH
L.S. 4693 EXP. 9-30-05

TIE BOOK 24 PAGE 163

CITY OF RANCHO CUCAMONGA
PUBLIC WORKS DEPARTMENT

MDS CONSULTING
MORSE DOKICH SCHULTZ
17320 Redhill Ave. Suite 330 Irvine, CA 92614 Voice: 949-251-8821 FAX: 949-251-0516
PLANNERS ENGINEERS SURVEYORS

6 OF 14

CENTERLINE TIES – TRACT NO. 15838

SCALE: 1"=30'

DATE: 6-1-05

i:\centies\15838\838-06.dwg 6/01/05

LEGEND :

⊗ INDICATES 4 PUNCH MARKS IN MANHOLE RIM TO REFERENCE P.M. ON LID

● INDICATES LEAD, TACK AND TAG STAMPED "L.S. 4693" IN TOP OF CURB

■ INDICATES LEAD & BRASS TACK IN TOP OF CURB

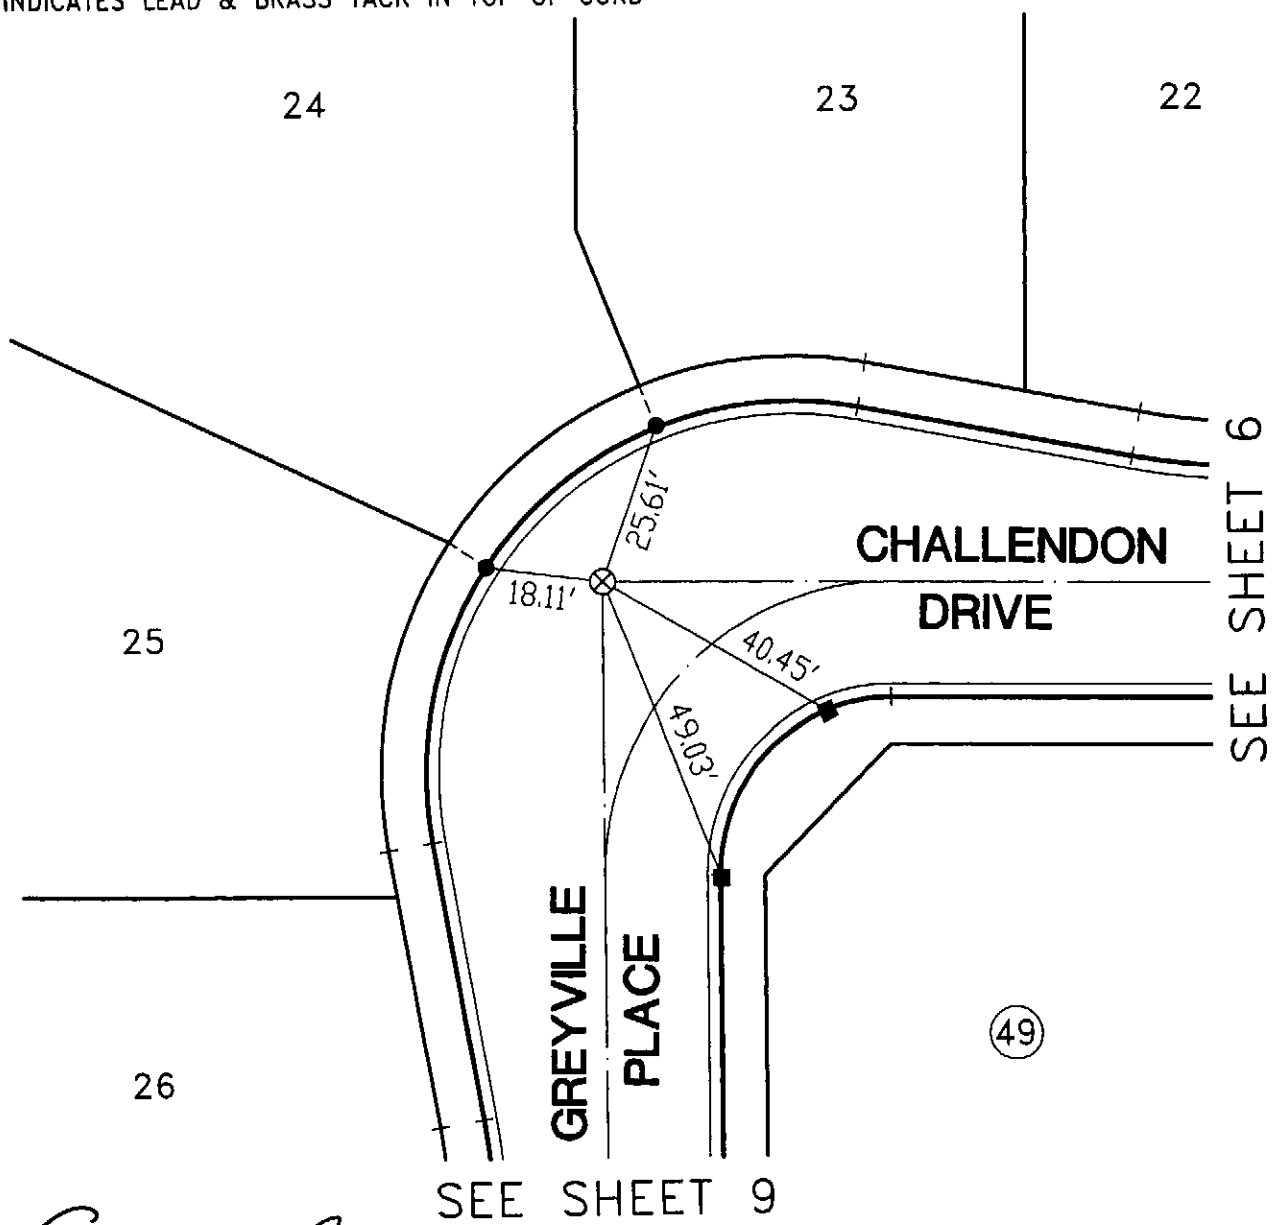

GARY W. DOKICH
L.S. 4693 EXP. 9-30-05

TIE BOOK 24 PAGE 164

CITY OF RANCHO CUCAMONGA
PUBLIC WORKS DEPARTMENT

MDS CONSULTING
MORSE DOKICH SCHULTZ
17320 Redhill Ave. Suite 350 Irvine, CA 92614
Voice: 949-251-8831 FAX: 949-251-0516
PLANNERS ENGINEERS SURVEYORS

7 OF 14

CENTERLINE TIES – TRACT NO. 15838

SCALE: 1"=30'

DATE: 6-1-05

I:\centies\15838\838-07.dwg 6/01/05

LEGEND :

- ⊙ INDICATES SPIKE AND WASHER STAMPED "L.S. 4693"
- ● INDICATES LEAD, TACK AND TAG STAMPED "L.S. 4693" IN TOP OF CURB
- ■ INDICATES LEAD & BRASS TACK IN TOP OF CURB

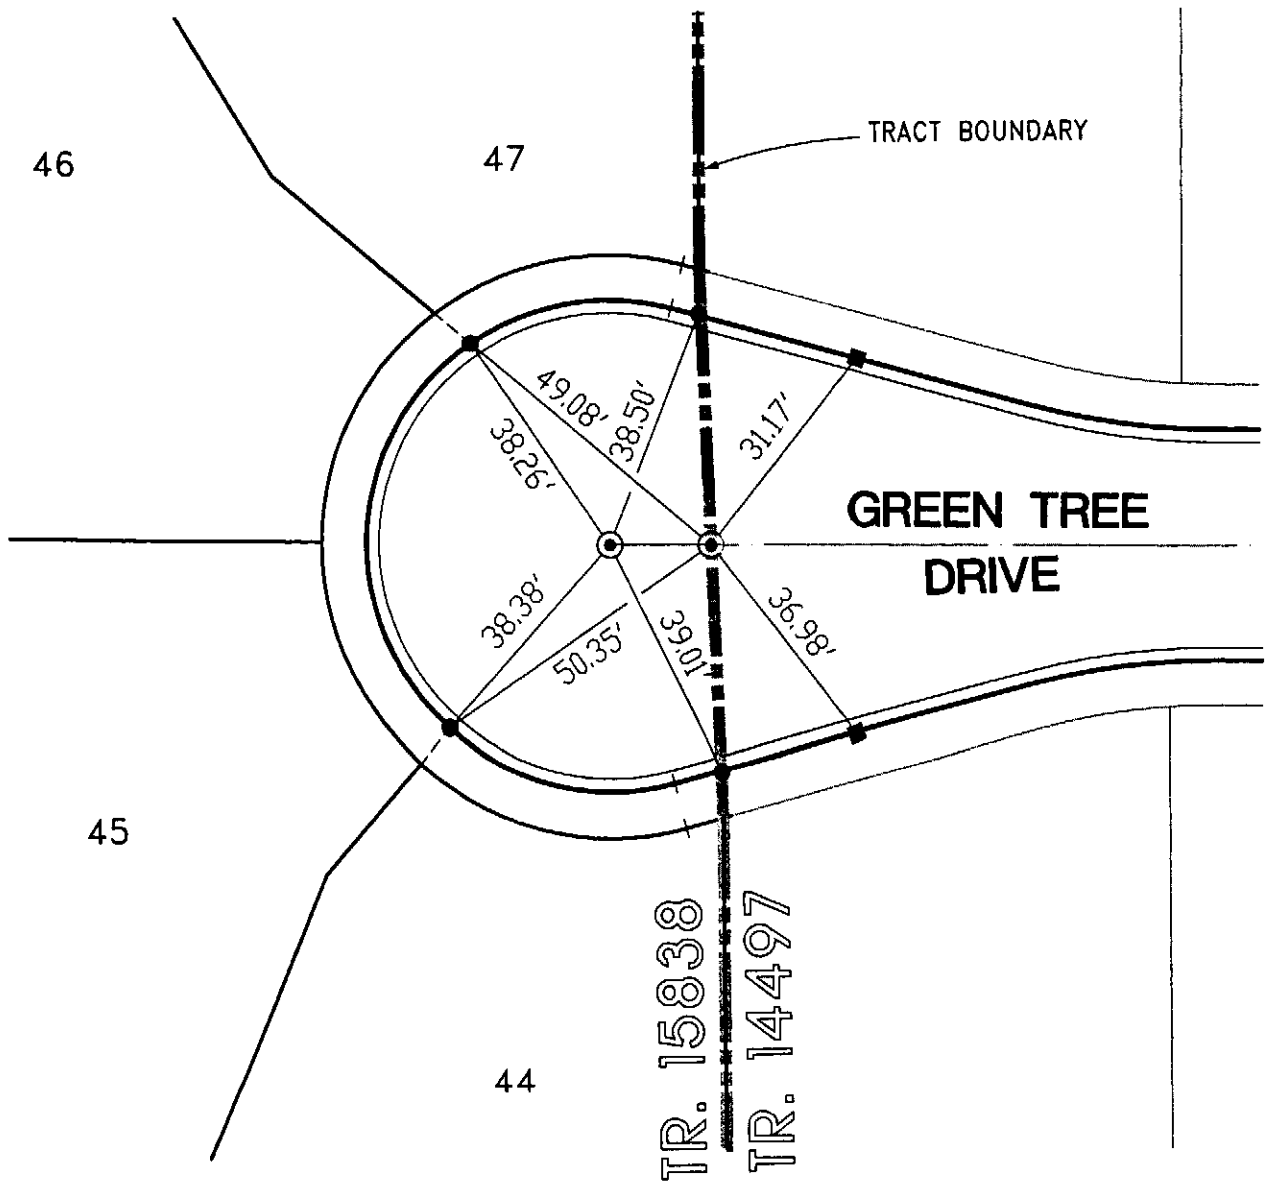

GARY W. DOKICH
L.S. 4693 EXP. 9-30-05

TIE BOOK 24 PAGE 165

CITY OF RANCHO CUCAMONGA
PUBLIC WORKS DEPARTMENT

MDS CONSULTING
MORSE DOKICH SCHMITZ
17320 Redhill Ave. Suite 350 Irvine, CA 92614
Voice: 949-251-8831 FAX: 949-251-0516
PLANNERS ENGINEERS SURVEYORS

8 OF 14

CENTERLINE TIES - TRACT NO. 15838

SCALE: 1"=30'

DATE: 6-1-05

I:\centies\15838\838-08.dwg 6/01/05

LEGEND :

- ⊙ INDICATES SPIKE AND WASHER STAMPED "L.S. 4693"
- ● INDICATES LEAD, TACK AND TAG STAMPED "L.S. 4693" IN TOP OF CURB
- ■ INDICATES LEAD & BRASS TACK IN TOP OF CURB

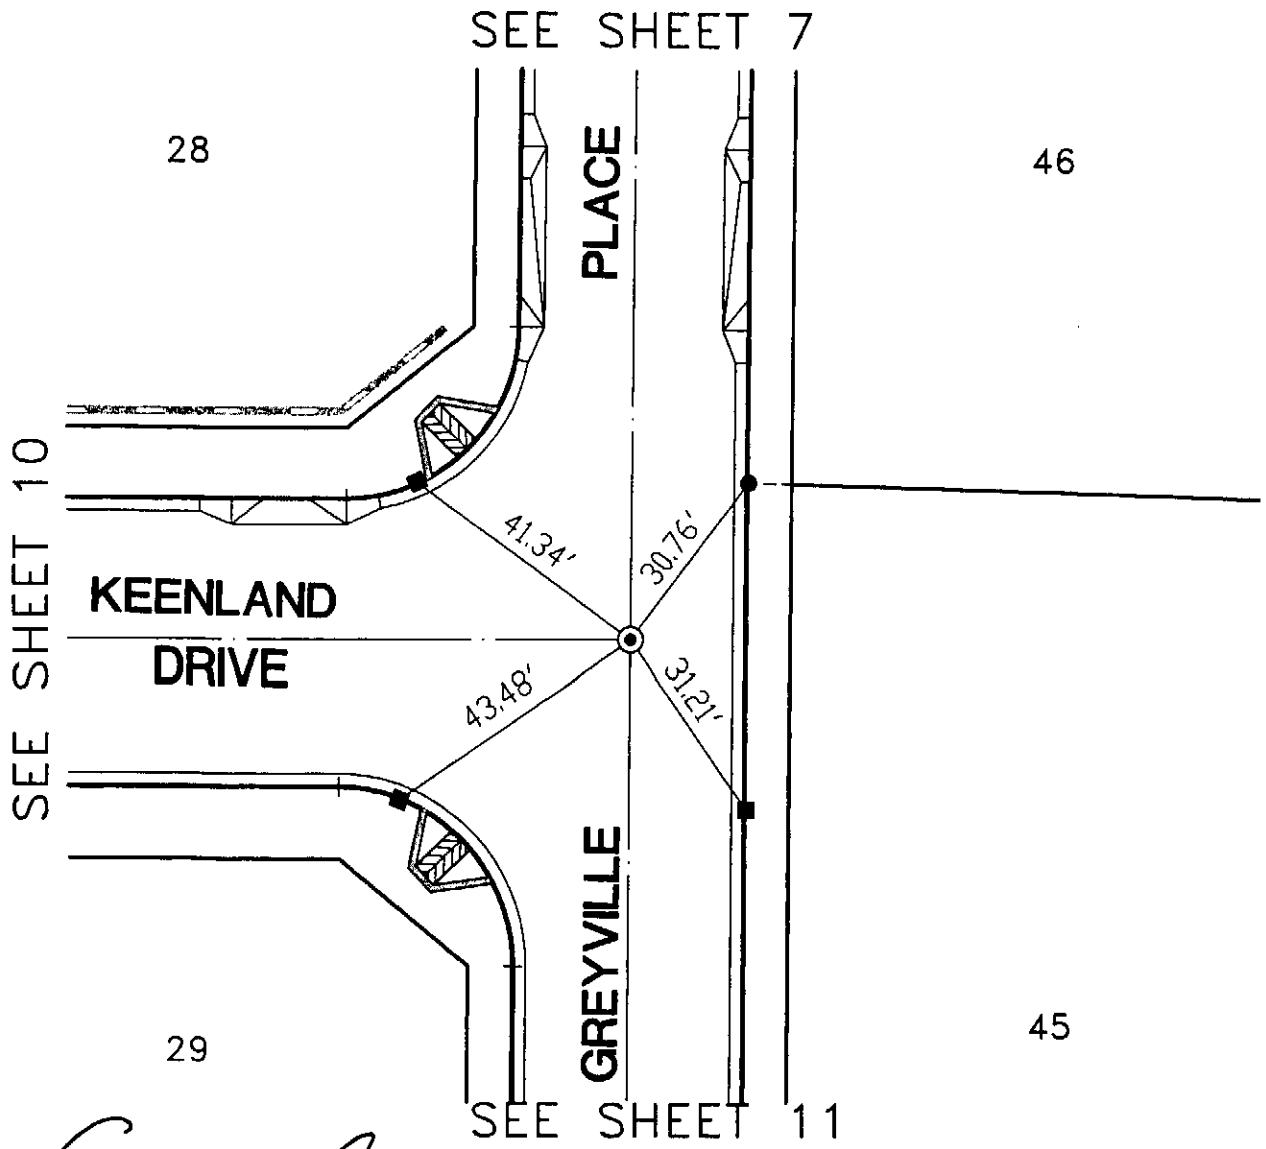

GARY W. DOKICH
L.S. 4693 EXP. 9-30-05

TIE BOOK 24 PAGE 166

CITY OF RANCHO CUCAMONGA
PUBLIC WORKS DEPARTMENT

MDS CONSULTING
MORSE DOKICH SCHULTZ
17320 Redhill Ave. Suite 350 Irvine, CA 92614
Voice: 949-251-8821 FAX: 949-251-0510
PLANNERS ENGINEERS SURVEYORS

9 OF 14

CENTERLINE TIES - TRACT NO. 15838

SCALE: 1"=30'

DATE: 6-1-05

I:\centies\15838\838-09.dwg 6/01/05

LEGEND :

⊙ INDICATES SPIKE AND WASHER STAMPED "L.S. 4693"

■ INDICATES LEAD & BRASS TACK IN TOP OF CURB

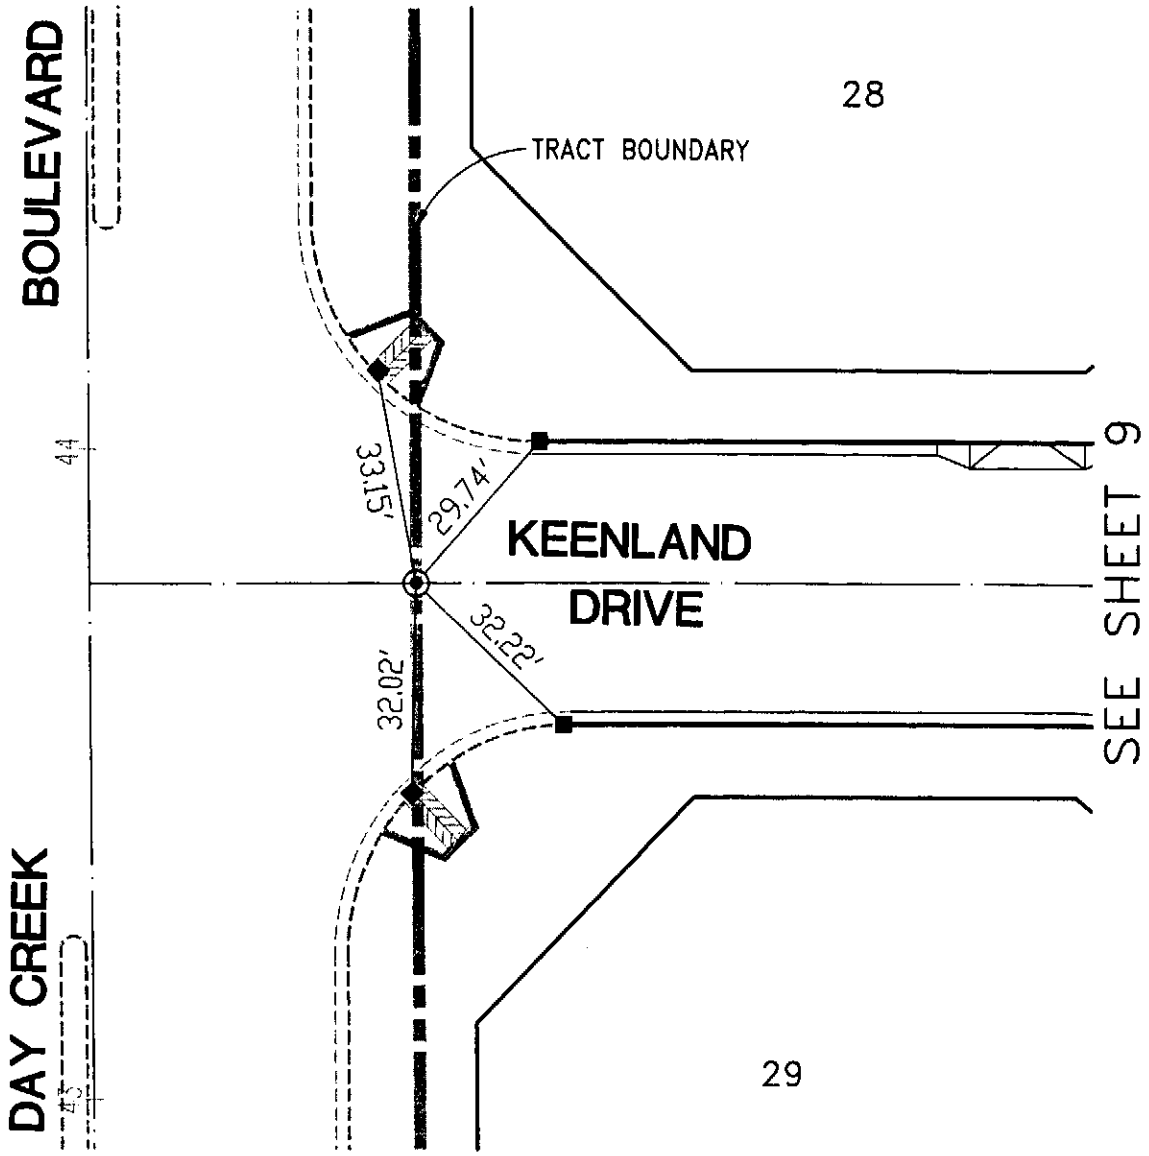

GARY W. DOKICH
L.S. 4693 EXP. 9-30-05

TIE BOOK 24 PAGE 167

CITY OF RANCHO CUCAMONGA
PUBLIC WORKS DEPARTMENT

MDS CONSULTING
MOSS DOKICH SCHULTZ
17320 Redhill Ave. Suite 350 Irvine, CA 92614
Voice: 949-251-8821 FAX: 949-251-0516
PLANNERS ENGINEERS SURVEYORS

10 OF 14

CENTERLINE TIES – TRACT NO. 15838

SCALE: 1"=30'

DATE: 6-1-05

I:\centies\15838\838-10.dwg 6/01/05

LEGEND :

⊗ INDICATES 4 PUNCH MARKS IN MANHOLE RIM TO REFERENCE P.M. ON LID

■ INDICATES LEAD & BRASS TACK IN TOP OF CURB

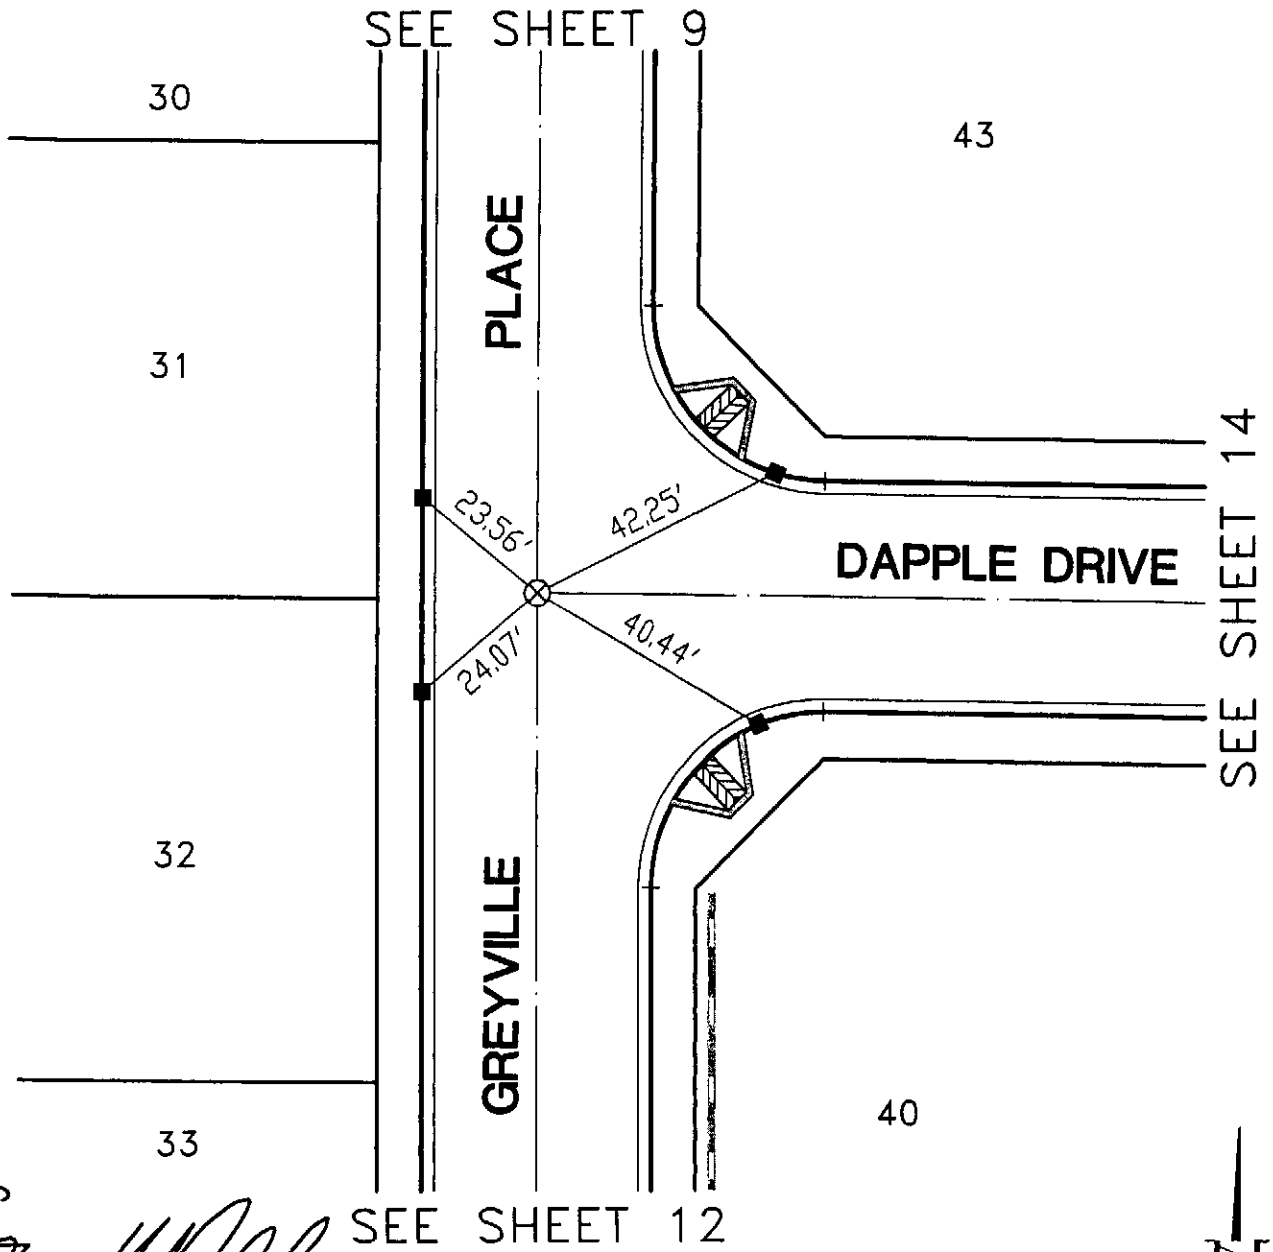

GARY W. DOKICH
L.S. 4693 EXP. 9-30-05

TIE BOOK 24 PAGE 168

CITY OF RANCHO CUCAMONGA
PUBLIC WORKS DEPARTMENT

MDS CONSULTING
MOESS DOKICH SCHULTZ
17320 Redhill Ave. Suite 350 Irvine, CA 92614 Voice: 949-251-8821 FAX: 949-251-0516
PLANNERS ENGINEERS SURVEYORS

11 OF 14

CENTERLINE TIES – TRACT NO. 15838

SCALE: 1"=30'

DATE: 6-1-05

I:\centies\15838\838-11.dwg 6/01/05

LEGEND :

- ⊙ INDICATES SPIKE AND WASHER STAMPED "L.S. 4693"
- ● INDICATES LEAD, TACK AND TAG STAMPED "L.S. 4693" IN TOP OF CURB
- ■ INDICATES LEAD & BRASS TACK IN TOP OF CURB

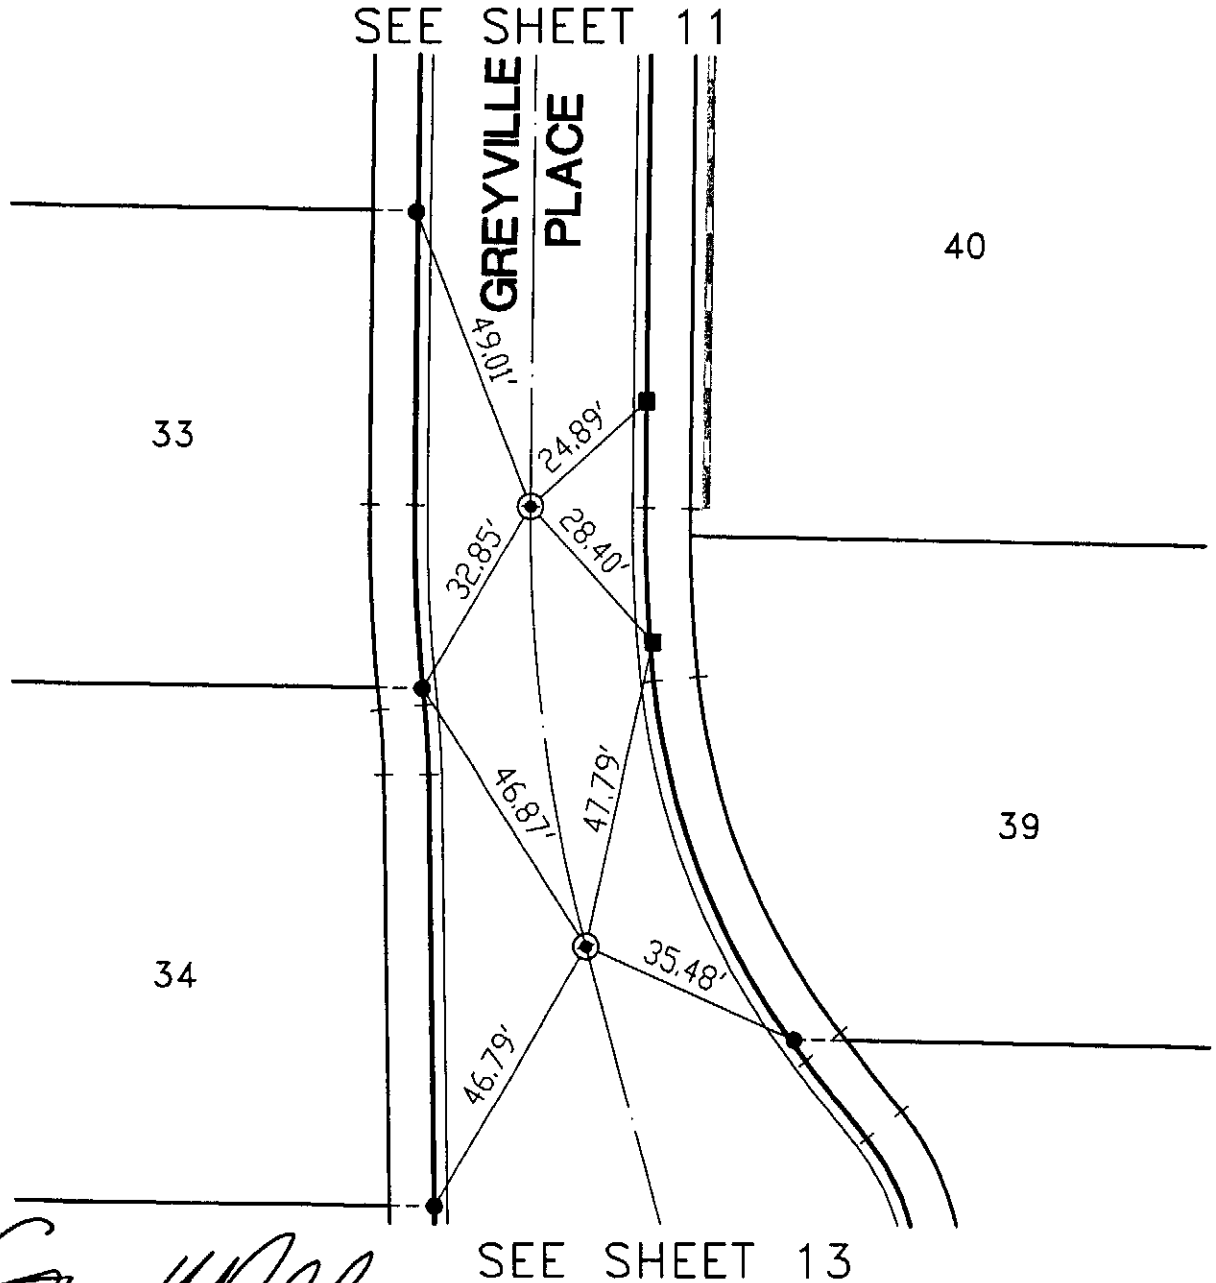

GARY W. DOKICH
L.S. 4693 EXP. 9-30-05

TIE BOOK 24 PAGE 169

CITY OF RANCHO CUCAMONGA
PUBLIC WORKS DEPARTMENT

MDS CONSULTING
MORSE DOKICH SCHULTZ
17320 Redhill Ave. Suite 330 Irvine, CA 92614 Voice: 949-251-8821 FAX: 949-251-0516
PLANNERS ENGINEERS SURVEYORS

12 OF 14

CENTERLINE TIES - TRACT NO. 15838

SCALE: 1"=30'

DATE: 6-1-05

t:\centies\15838\838-12.dwg 6/03/05

LEGEND :

⊙ INDICATES SPIKE AND WASHER STAMPED "L.S. 4693"

● INDICATES LEAD, TACK AND TAG STAMPED "L.S. 4693" IN TOP OF CURB

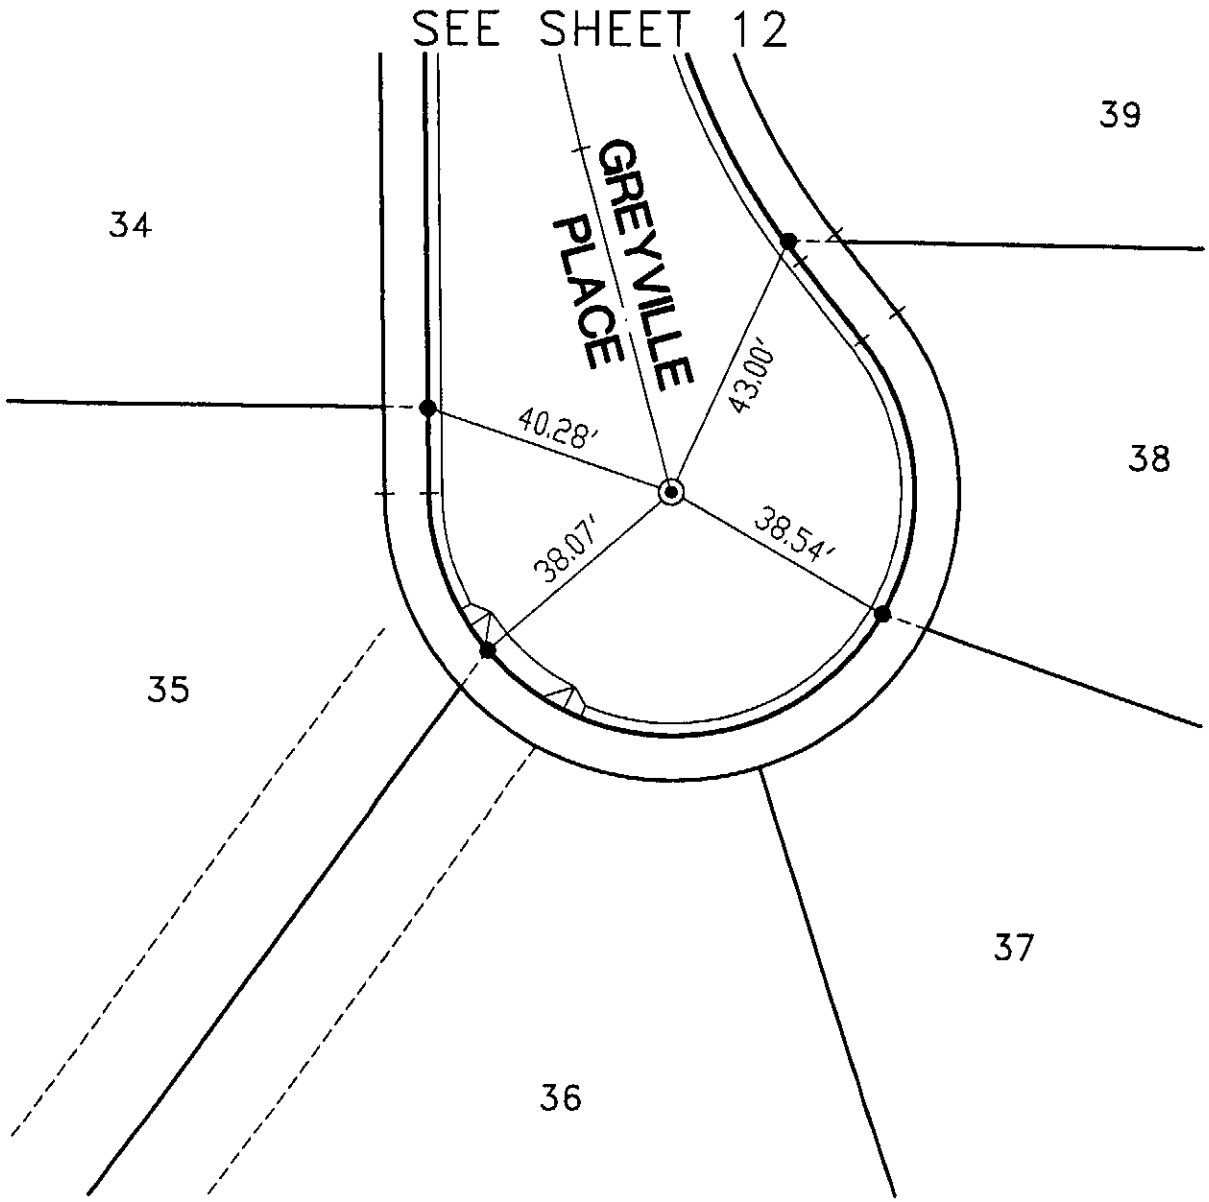

GARY W. DOKICH
L.S. 4693 EXP. 9-30-05

TIE BOOK 24 PAGE 170

CITY OF RANCHO CUCAMONGA
PUBLIC WORKS DEPARTMENT

MDS CONSULTING
MOSES DOKICH SCHULTZ
17320 Redhill Ave. Suite 350 Irvine, CA 92614 Voice: 949-251-0821 FAX: 949-251-0516
PLANNERS ENGINEERS SURVEYORS

13 OF 14

CENTERLINE TIES – TRACT NO. 15838

SCALE: 1"=30'

DATE: 6-1-05

f:\centies\15838\838-13.dwg 6/03/05

LEGEND :

⊙ INDICATES SPIKE AND WASHER STAMPED "L.S. 4693"

■ INDICATES LEAD & BRASS TACK IN TOP OF CURB

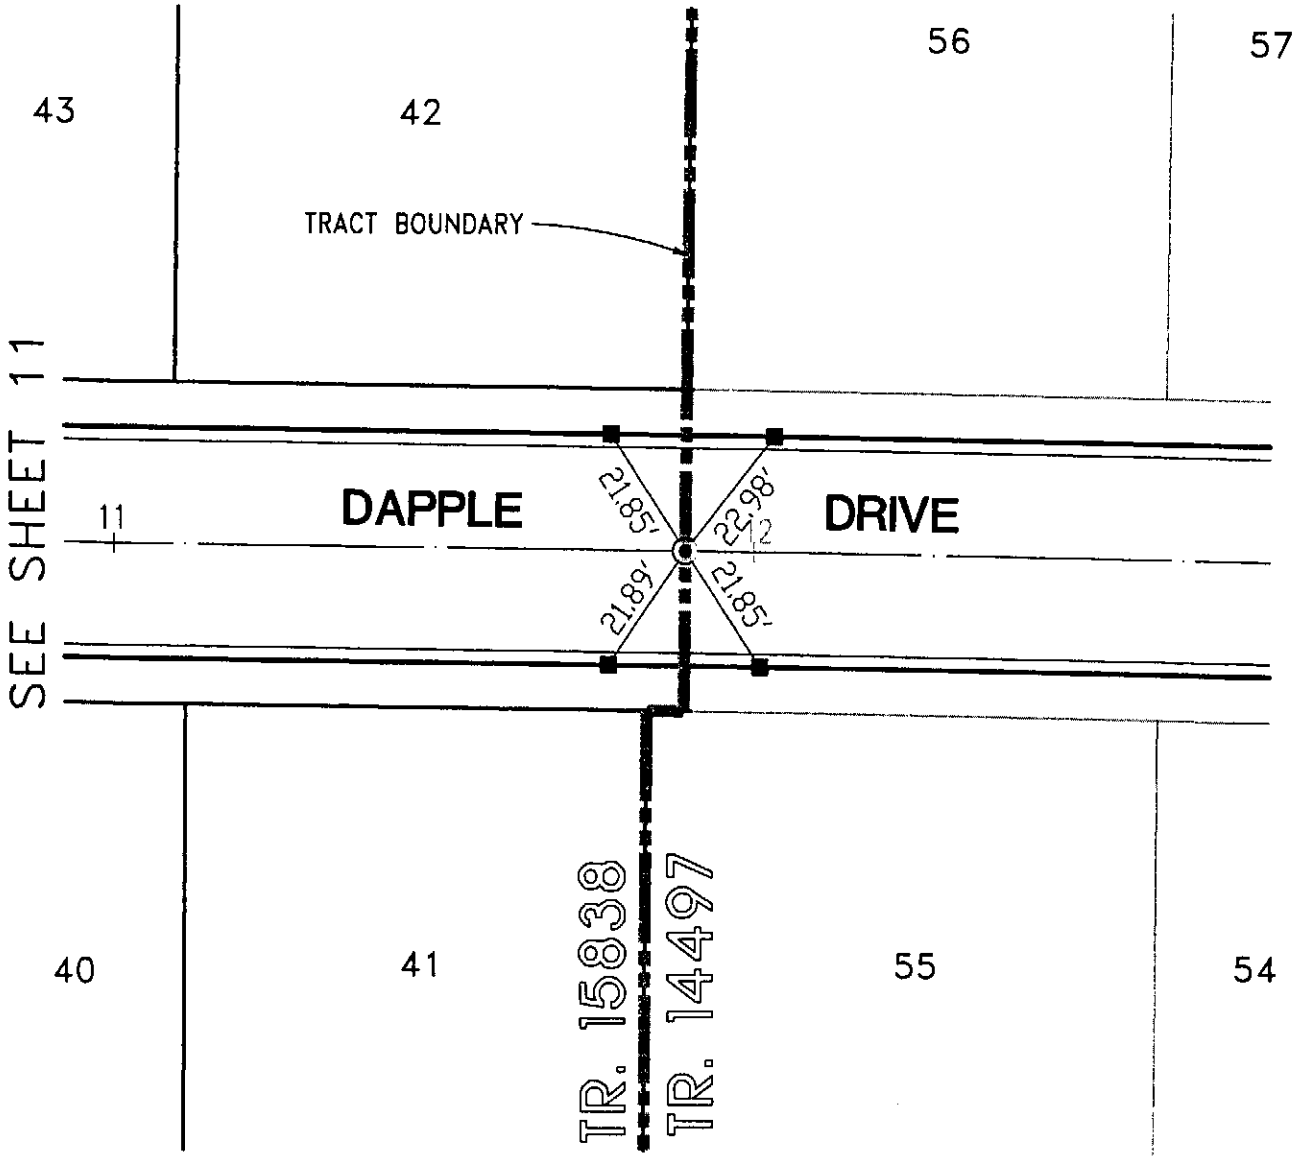

GARY W. DOKICH
L.S. 4693 EXP. 9-30-05

TIE BOOK 24 PAGE 171

CITY OF RANCHO CUCAMONGA
PUBLIC WORKS DEPARTMENT

MDS CONSULTING
MOSEE DOKICH SCHULTZ
17320 Redhill Ave. Suite 350 Irvine, CA 92614
Voice: 949-251-0821 FAX: 949-251-0516
PLANNERS ENGINEERS SURVEYORS

14 OF 14

CENTERLINE TIES - TRACT NO. 15838

SCALE: 1"=30'

DATE: 6-1-05

I:\centies\15838\838-14.dwg 6/01/05

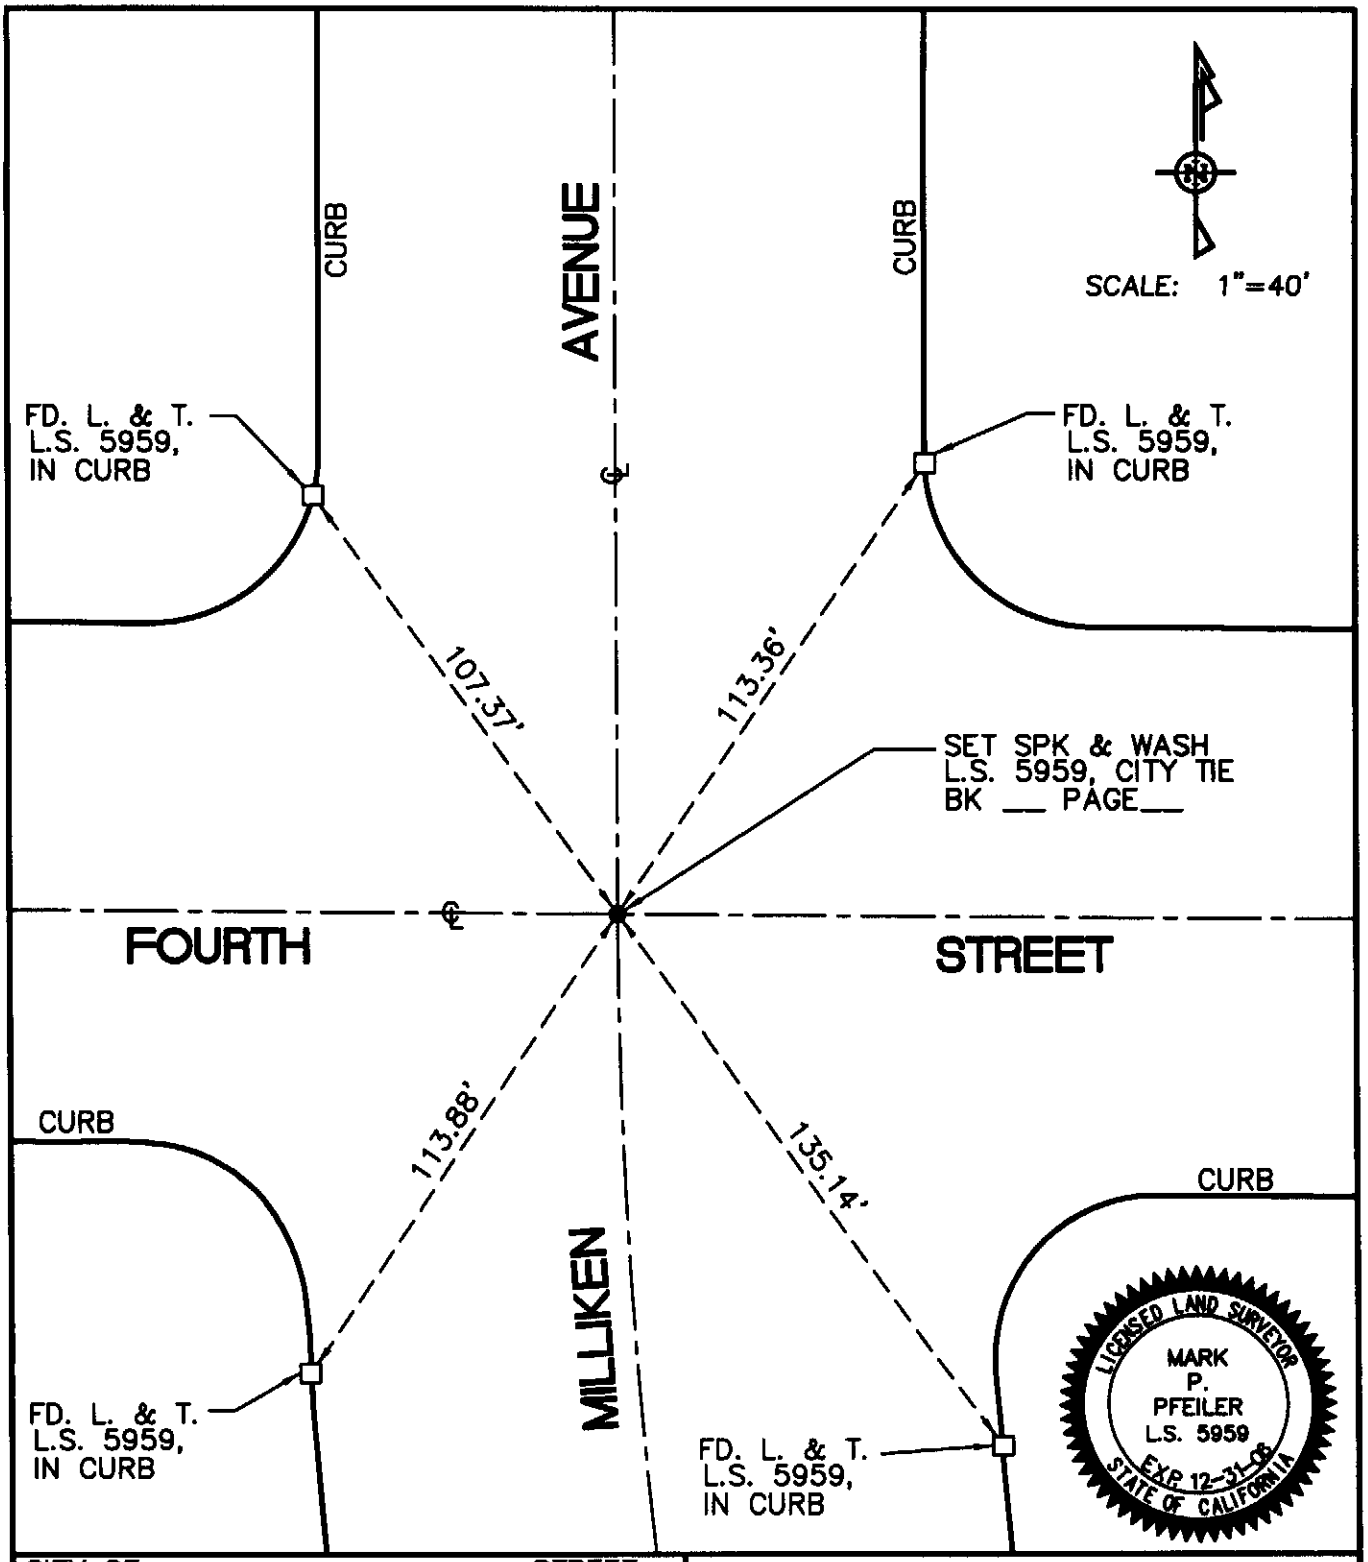

CITY OF RANCHO CUCAMONGA — STREET TIE	**PARCEL MAP NO. 16282**
PFEILER & ASSOCIATES ENGINEERS, INC. 660 N. DIAMOND BAR BLVD. SUITE 100 DIAMOND BAR, CA 91765 (909) 860-5850	**MILLIKEN AVENUE AND FOURTH STREET**
L.S.	FIELD REVIEW_____ DATE_____
L.S. NO. 5959 DATE 12/16/05	TIE BOOK 24 PAGE 172

P:\GAS/EXHIBITS/24016-A/TIES

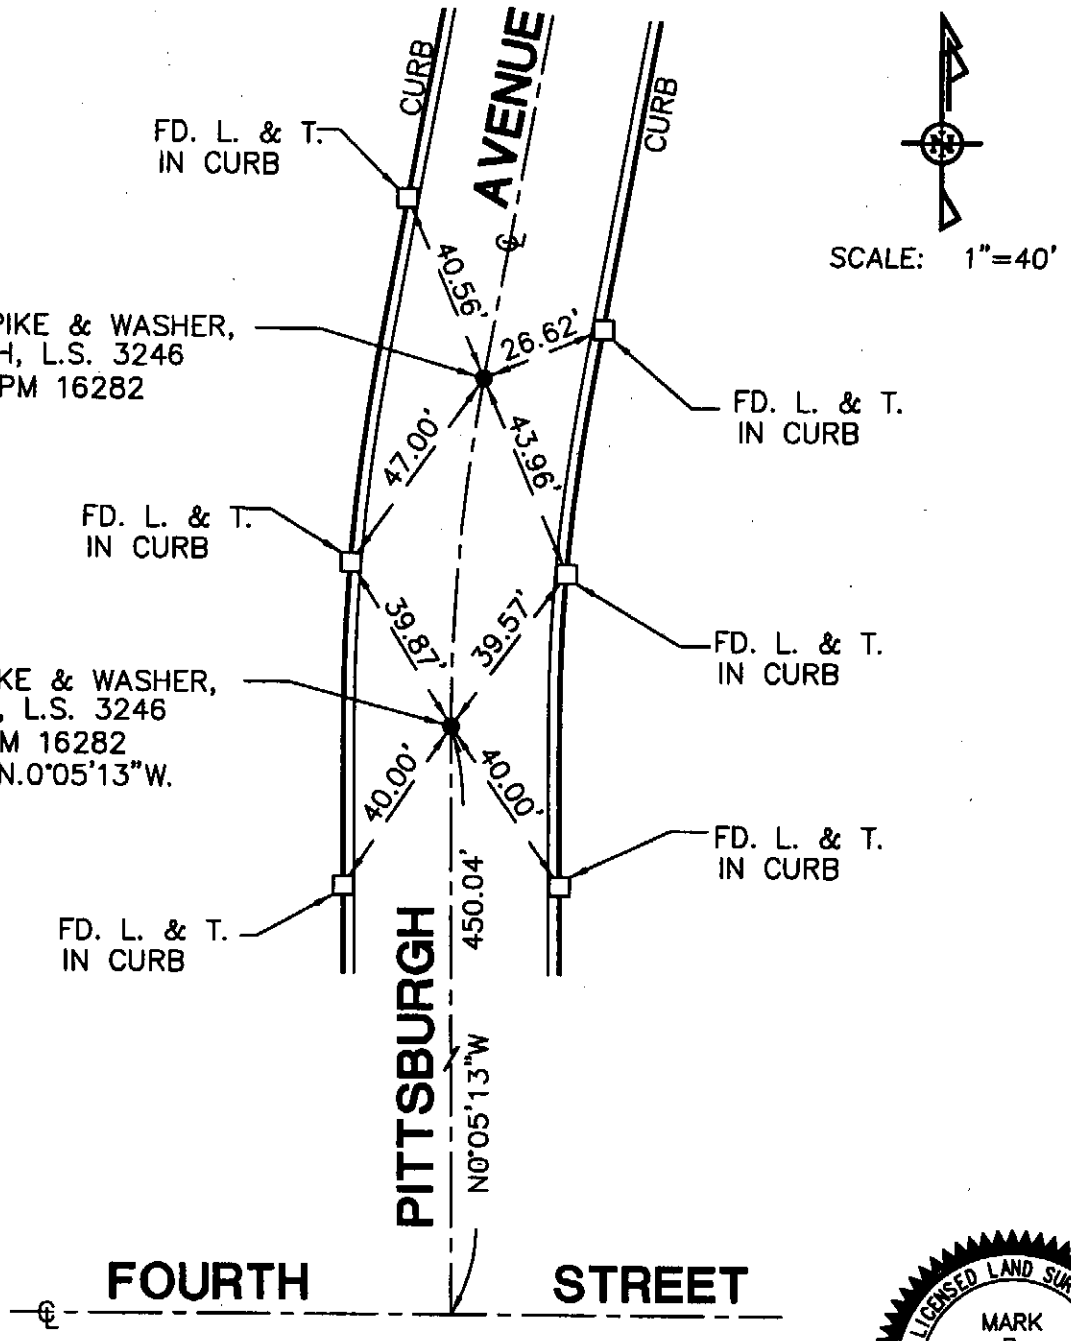

CITY OF RANCHO CUCAMONGA — STREET TIE	**PARCEL MAP NO. 16282**
PFEILER & ASSOCIATES 660 N. DIAMOND BAR BLVD. SUITE 100 DIAMOND BAR, CA 91765 (909) 860-5850	**PITTSBURGH AVENUE NORTH OF FOURTH STREET**
L.S.	FIELD REVIEW _____ DATE _____
L.S. NO. 5959 DATE 7/5/05	TIE BOOK 24 PAGE 173

P:GAS/EXHIBITS/24016-A/TIES

CENTERLINE TIES

TRACT NO. 16432

GARY W. DOKICH
L.S. 4693 EXP. 9-30-05

CITY OF RANCHO CUCAMONGA
PUBLIC WORKS DEPARTMENT

MDS CONSULTING
MOREY DOKICH SCHULTZ
17320 Redhill Ave., Suite 350
Irvine, CA 92614
Voice: 949-251-8821
FAX: 949-251-0816
PLANNERS ENGINEERS SURVEYORS

CENTERLINE TIES – TRACT NO. 16432

DATE: 8-30-05

I:\CENTIES\TR16432\16432-01.dwg 8/29/05

BK 24 PG. 174

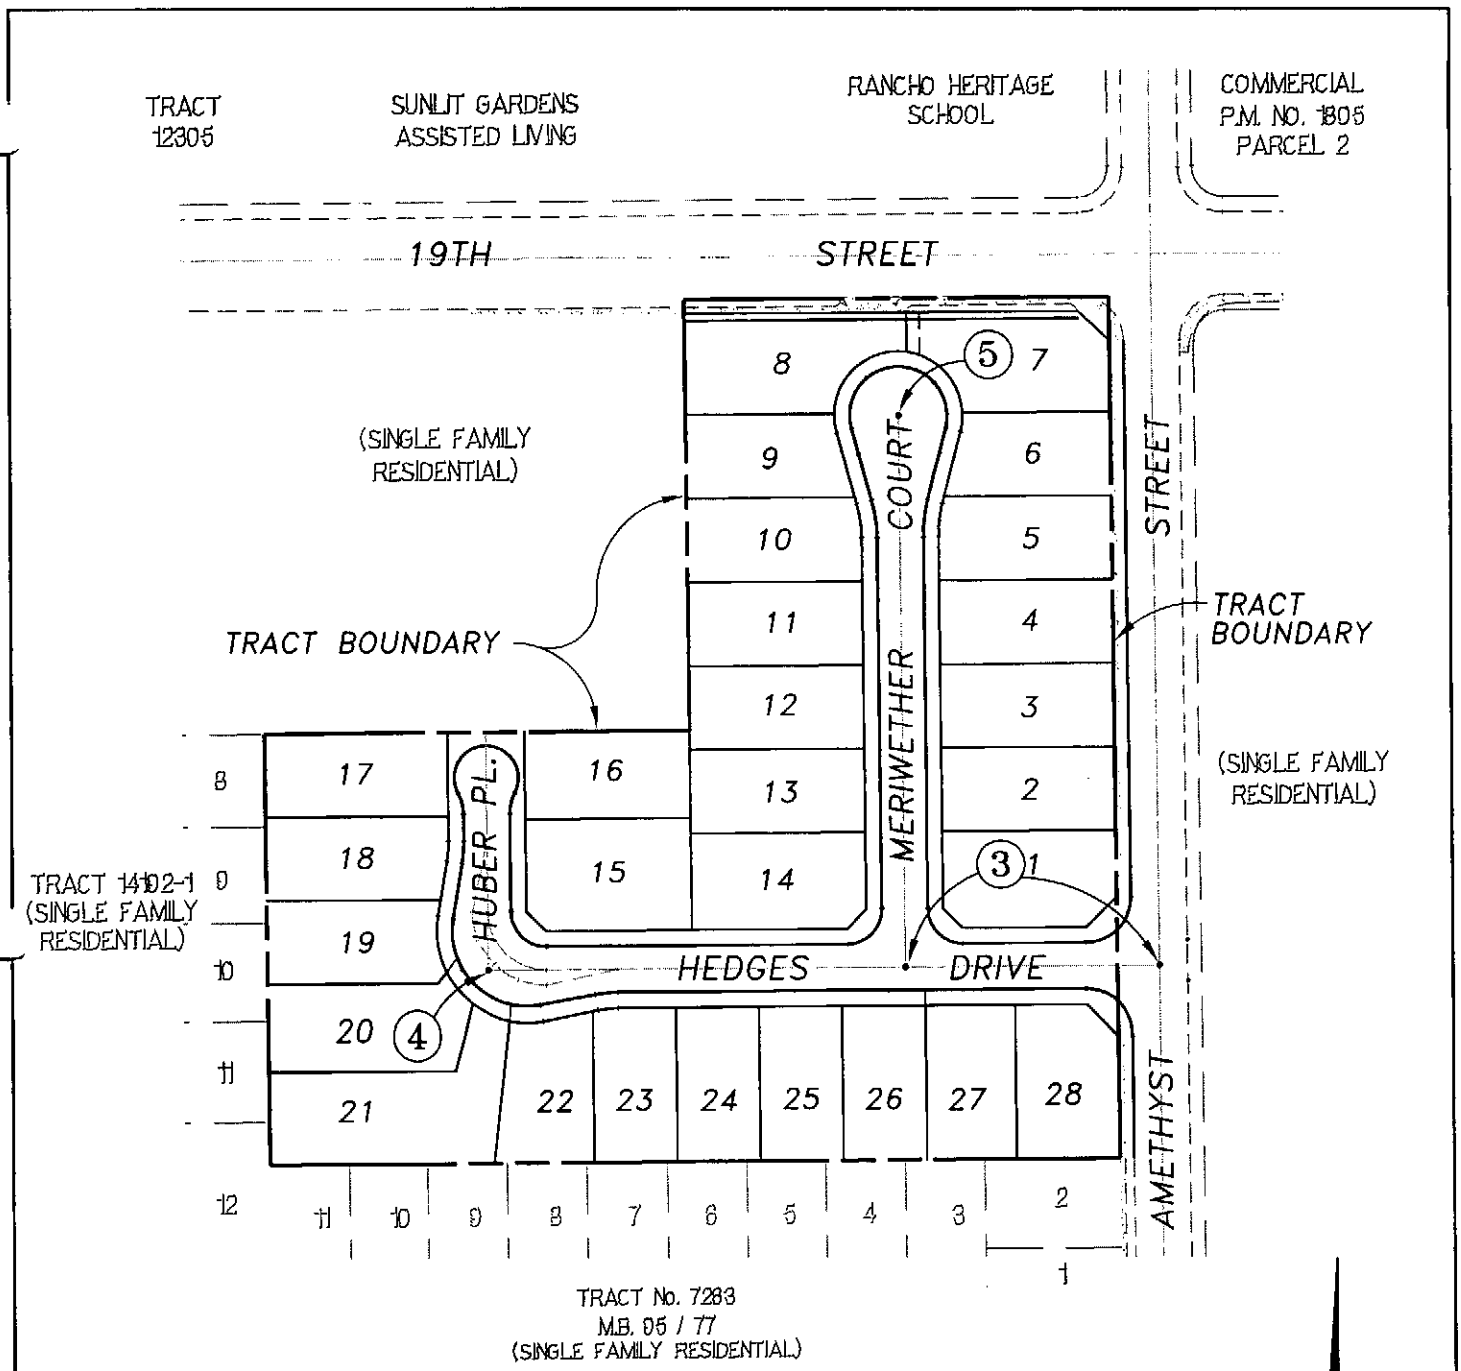

LEGEND :

(1) DENOTES SHEET NUMBERS

GARY W. DOKICH
L.S. 4693 EXP. 9-30-05

TIE BOOK 24 PAGE 175

CITY OF RANCHO CUCAMONGA
PUBLIC WORKS DEPARTMENT

MDS CONSULTING
MORSE DOKICH SCHULTZ
17320 Redhill Ave., Suite 350, Irvine, CA 92614
Voice: 949-251-8821 FAX: 949-251-0616
PLANNERS ENGINEERS SURVEYORS

2 OF 5

CENTERLINE TIES – TRACT NO. 16432

SCALE: 1"=150'

DATE: 8-30-05

I:\CENTIES\TR16432\16432-02.dwg 8/30/05

LEGEND :

- ⊙ INDICATES SPIKE AND WASHER STAMPED "L.S. 4693"
- ■ INDICATES LEAD, TACK AND TAG STAMPED "L.S. 4693" IN TOP OF CURB
- ● INDICATES LEAD AND BRASS TACK IN TOP OF CURB
- ⊗ INDICATES 4 PUNCH MARKS ON MANHOLE RIM TO BE USED AS CROSS-TIE

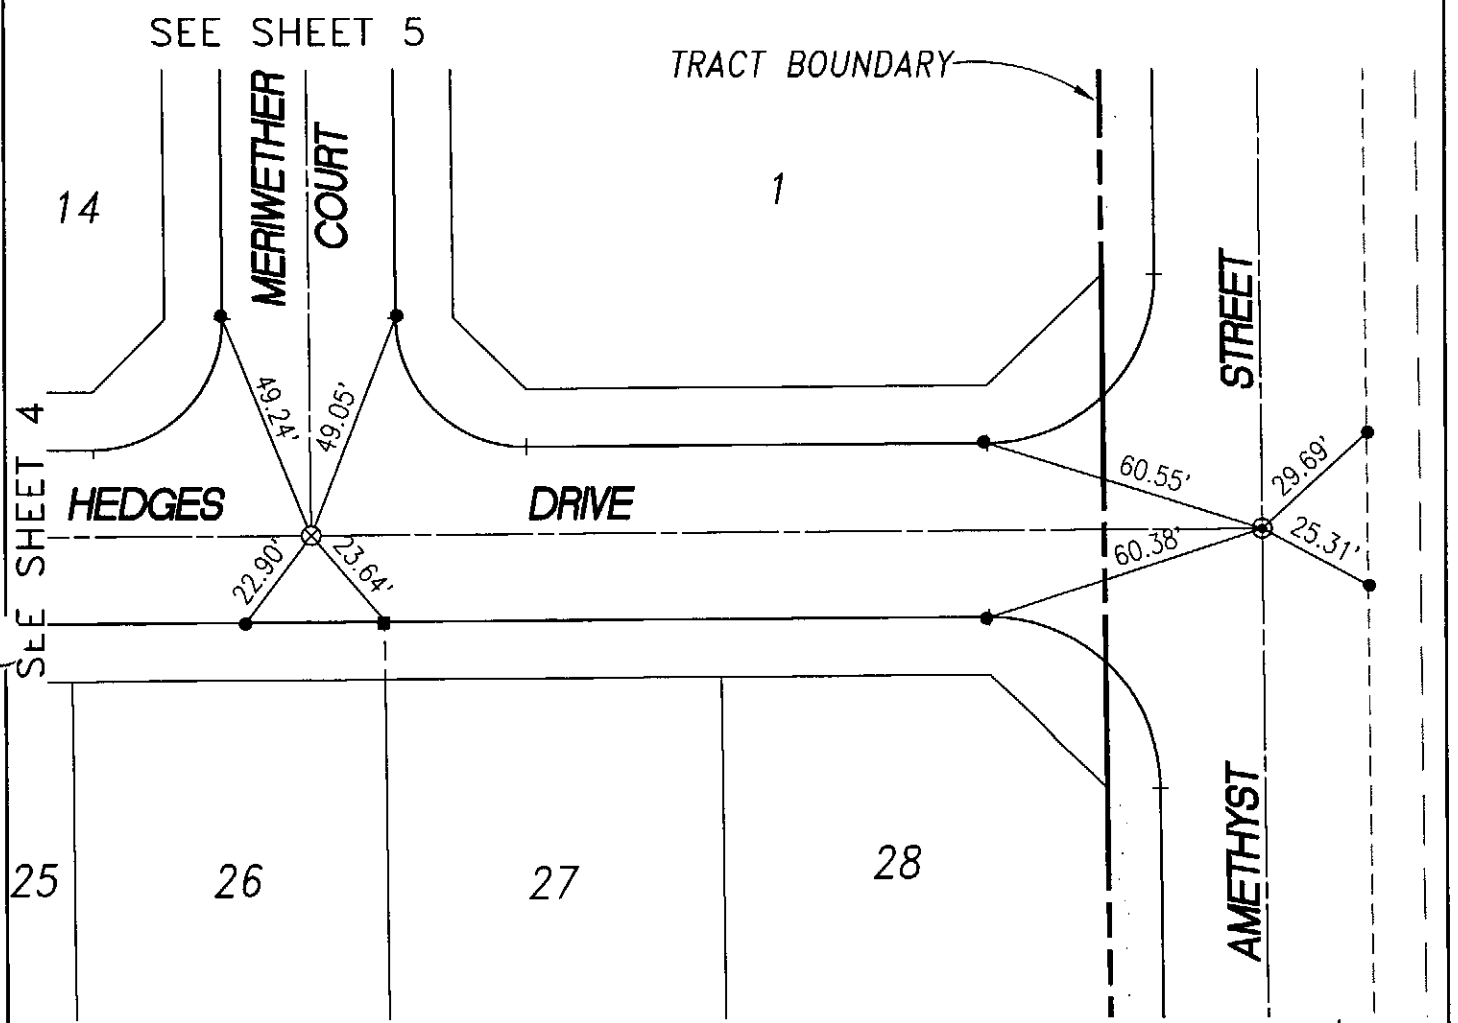

GARY W. DOKICH
L.S. 4693 EXP. 9-30-05

CITY OF RANCHO CUCAMONGA
PUBLIC WORKS DEPARTMENT

MDS CONSULTING
MORSE DOKICH SCHULTZ
17320 Redhill Ave. Suite 350 Irvine, CA 92614
Voice: 949-251-8821 FAX: 949-251-0516
PLANNERS ENGINEERS SURVEYORS

3 OF 5

CENTERLINE TIES – TRACT NO. 16432 | SCALE: 1"=40' | DATE: 08-30-05

I:\CENTIES\TR16432\16432-03.dwg 8/30/05

BK 24 Pg. 176

LEGEND :

- ■ INDICATES LEAD, TACK AND TAG STAMPED "L.S. 4693" IN TOP OF CURB
- ● INDICATES LEAD AND BRASS TACK IN TOP OF CURB
- ⊗ INDICATES 4 PUNCH MARKS ON MANHOLE RIM TO BE USED AS CROSS-TIE

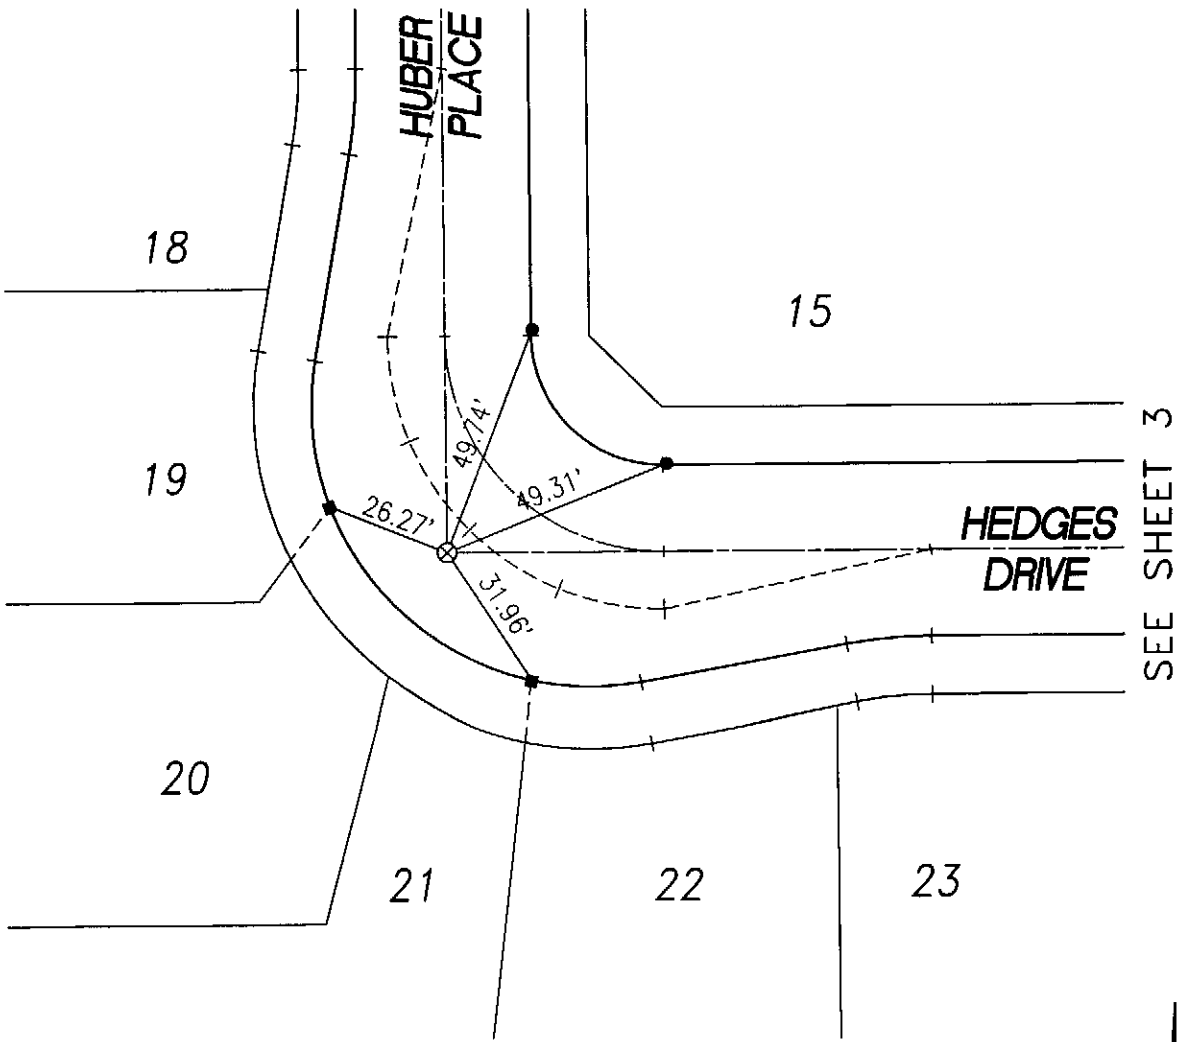

GARY W. DOKICH
L.S. 4693 EXP. 9-30-05

N

CITY OF RANCHO CUCAMONGA
PUBLIC WORKS DEPARTMENT

MDS CONSULTING
MORSE DOKICH SCHULTZ
17320 Redhill Ave. Suite 350 Irvine, CA 92614 Voice: 949-251-8821 FAX: 949-251-0516
PLANNERS ENGINEERS SURVEYORS

CENTERLINE TIES – TRACT NO. 16432 | SCALE: 1"=40' | DATE: 08-30-05

I:\CENTIES\TR16432\16432-04.dwg 8/30/05

LEGEND :

⊙ INDICATES SPIKE AND WASHER STAMPED "L.S. 4693"

● INDICATES LEAD AND BRASS TACK IN TOP OF CURB

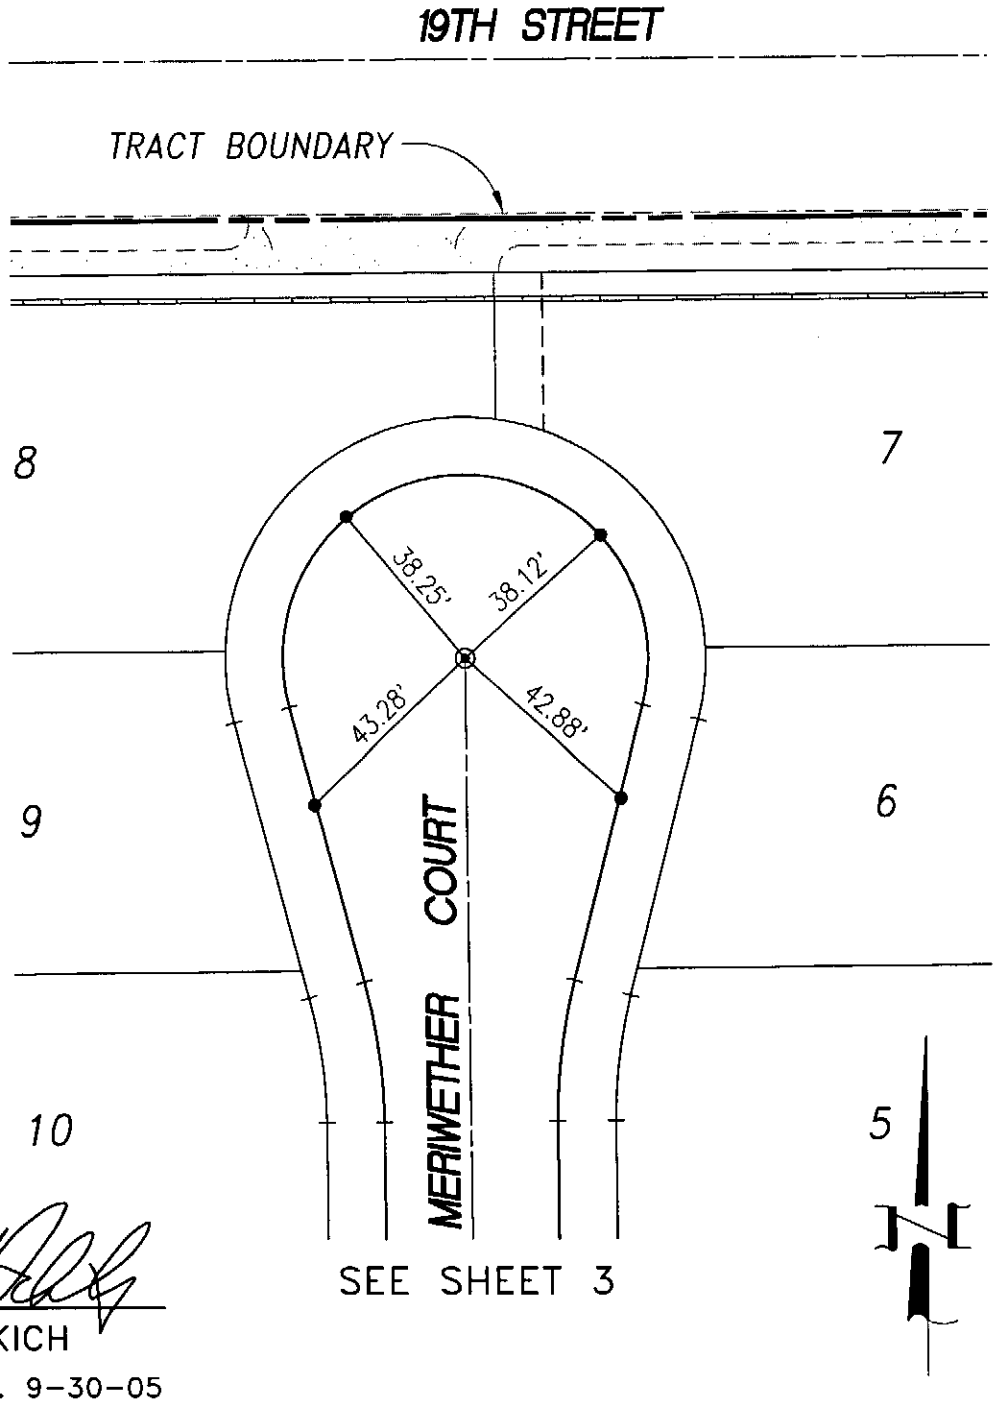

GARY W. DOKICH

L.S. 4693 EXP. 9-30-05

CITY OF RANCHO CUCAMONGA

PUBLIC WORKS DEPARTMENT

MDS CONSULTING

MOSSE DOKICH SCHULTZ

17300 Redhill Ave. Suite 350 Irvine, CA 92614 Voice: 949-251-8821 FAX: 949-251-0516

PLANNERS ENGINEERS SURVEYORS

5 OF 5

CENTERLINE TIES – TRACT NO. 16432

SCALE: 1"=40'

DATE: 08-30-05

I:\CENTIES\TR16432\16432-05.dwg 8/30/05

BK 24 PG. 178

CENTERLINE TIES

TRACT NO. 16545

GARY W. DOKICH
L.S. 4693 EXP. 9-30-05

TIE BOOK 24 PAGE 179

CITY OF RANCHO CUCAMONGA
PUBLIC WORKS DEPARTMENT

MDS CONSULTING
MOREE DOKICH SCHULTZ
17320 Redhill Ave. Suite 350
Irvine, CA 92614
Voice: 949-251-8821
FAX: 949-251-0516
PLANNERS ENGINEERS SURVEYORS

CENTERLINE TIES – TRACT NO. 16545	SCALE: 1"=40'	DATE: 08-26-05

I:\CENTIES\TR16545\16545-01.dwg 8/30/05

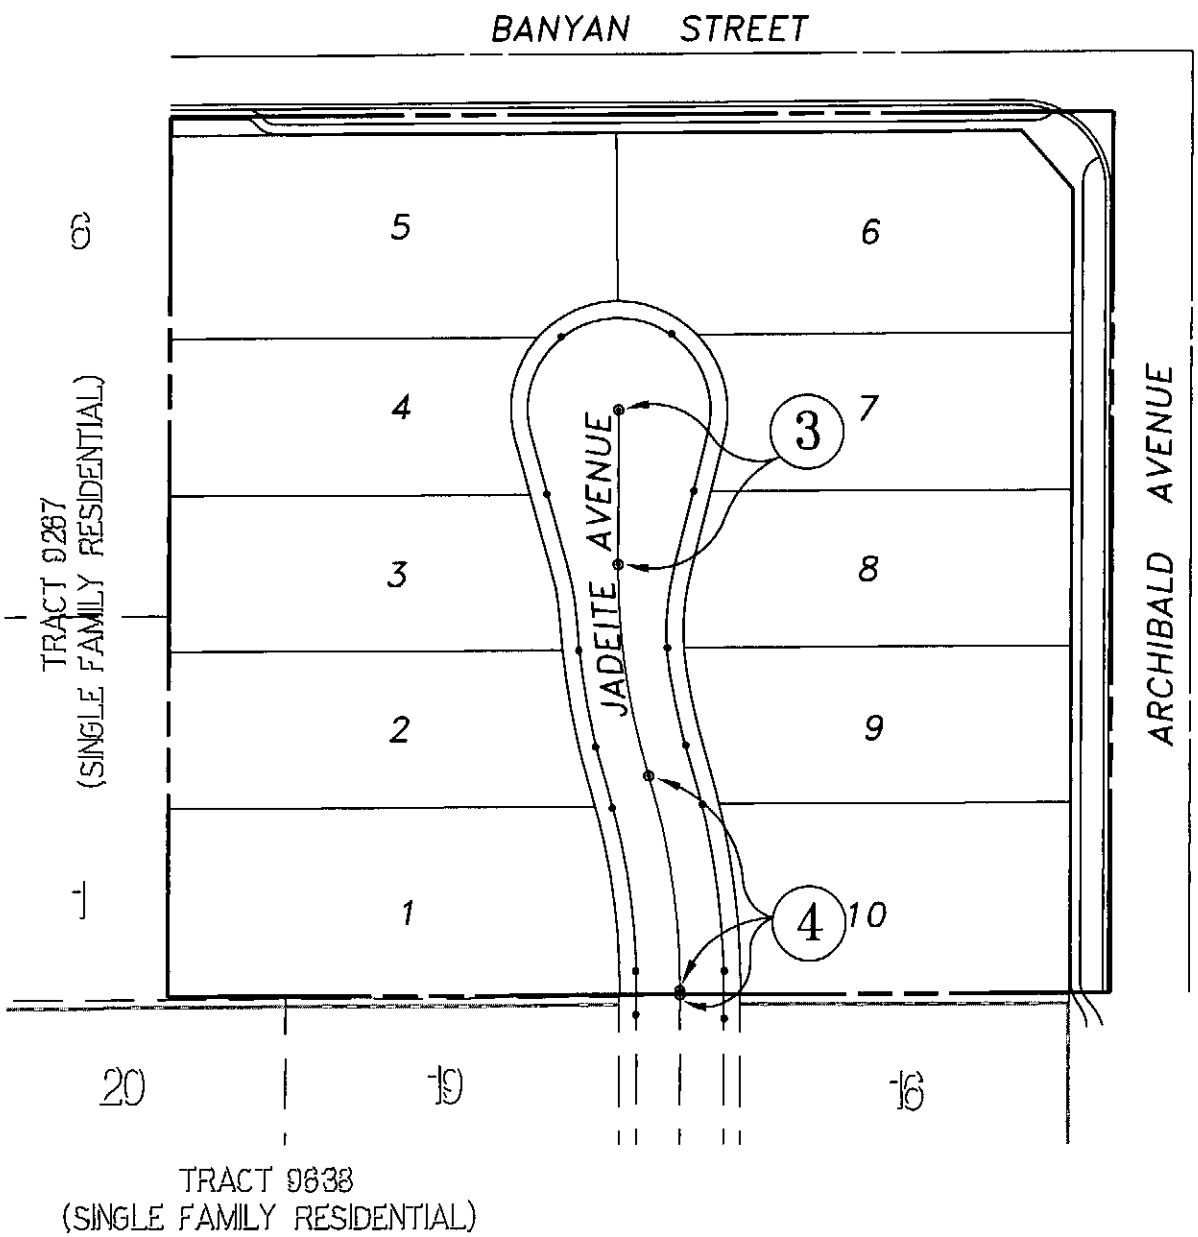

LEGEND :

(1) DENOTES SHEET NUMBERS

GARY W. DOKICH

L.S. 4693 EXP. 9-30-05

TIE BOOK 24 PAGE 180

CITY OF RANCHO CUCAMONGA

PUBLIC WORKS DEPARTMENT

MDS CONSULTING

MOESS DOKICH SCHULTZ

17320 Redhill Ave. Suite 350 Irvine, CA 92614 Voice: 949-251-8821 FAX: 949-251-0516

PLANNERS ENGINEERS SURVEYORS

2 OF 4

CENTERLINE TIES - TRACT NO. 16545

SCALE: 1"=80'

DATE: 08-26-05

I:\CENTIES\TR16545\16545-02.dwg 8/26/05

LEGEND :

⊙ INDICATES SPIKE AND WASHER STAMPED "L.S. 4693"

■ INDICATES LEAD, TACK AND TAG STAMPED "L.S. 4693" IN TOP OF CURB

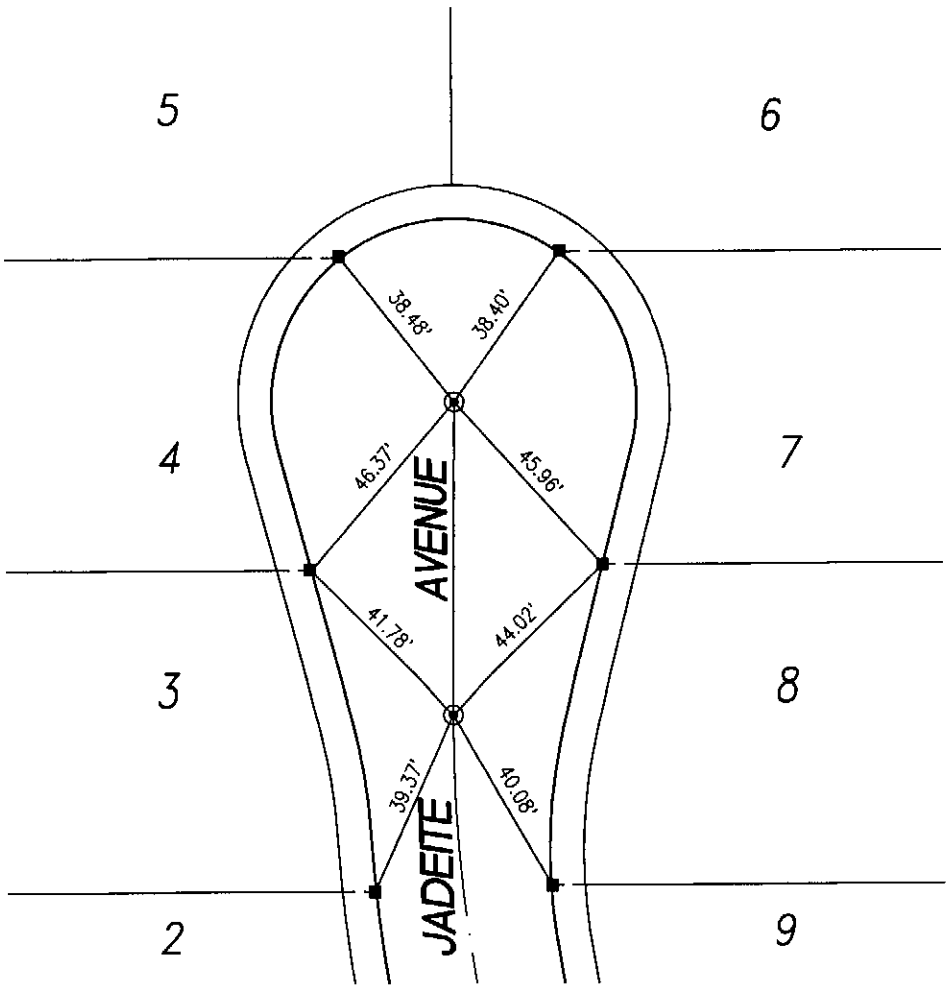

SEE SHEET 4

GARY W. DOKICH
L.S. 4693 EXP. 9-30-05

CITY OF RANCHO CUCAMONGA
PUBLIC WORKS DEPARTMENT

MDS CONSULTING
MOSSI DOKICH SCHULTZ
17320 Redhill Ave. Suite 350 Irvine, CA 92614 Voice: 949-251-8821 FAX: 949-251-0916
PLANNERS ENGINEERS SURVEYORS

3 OF 4

CENTERLINE TIES – TRACT NO. 16545 | SCALE: 1"=40' | DATE: 08-30-05

I:\CENTIES\TR16545\16545-03.dwg 8/30/05

BK 24 Pg. 181

LEGEND :

- ⊙ INDICATES SPIKE AND WASHER STAMPED "L.S. 4693"
- ■ INDICATES LEAD, TACK AND TAG STAMPED "L.S. 4693" IN TOP OF CURB
- ● INDICATES LEAD AND BRASS TACK IN TOP OF CURB

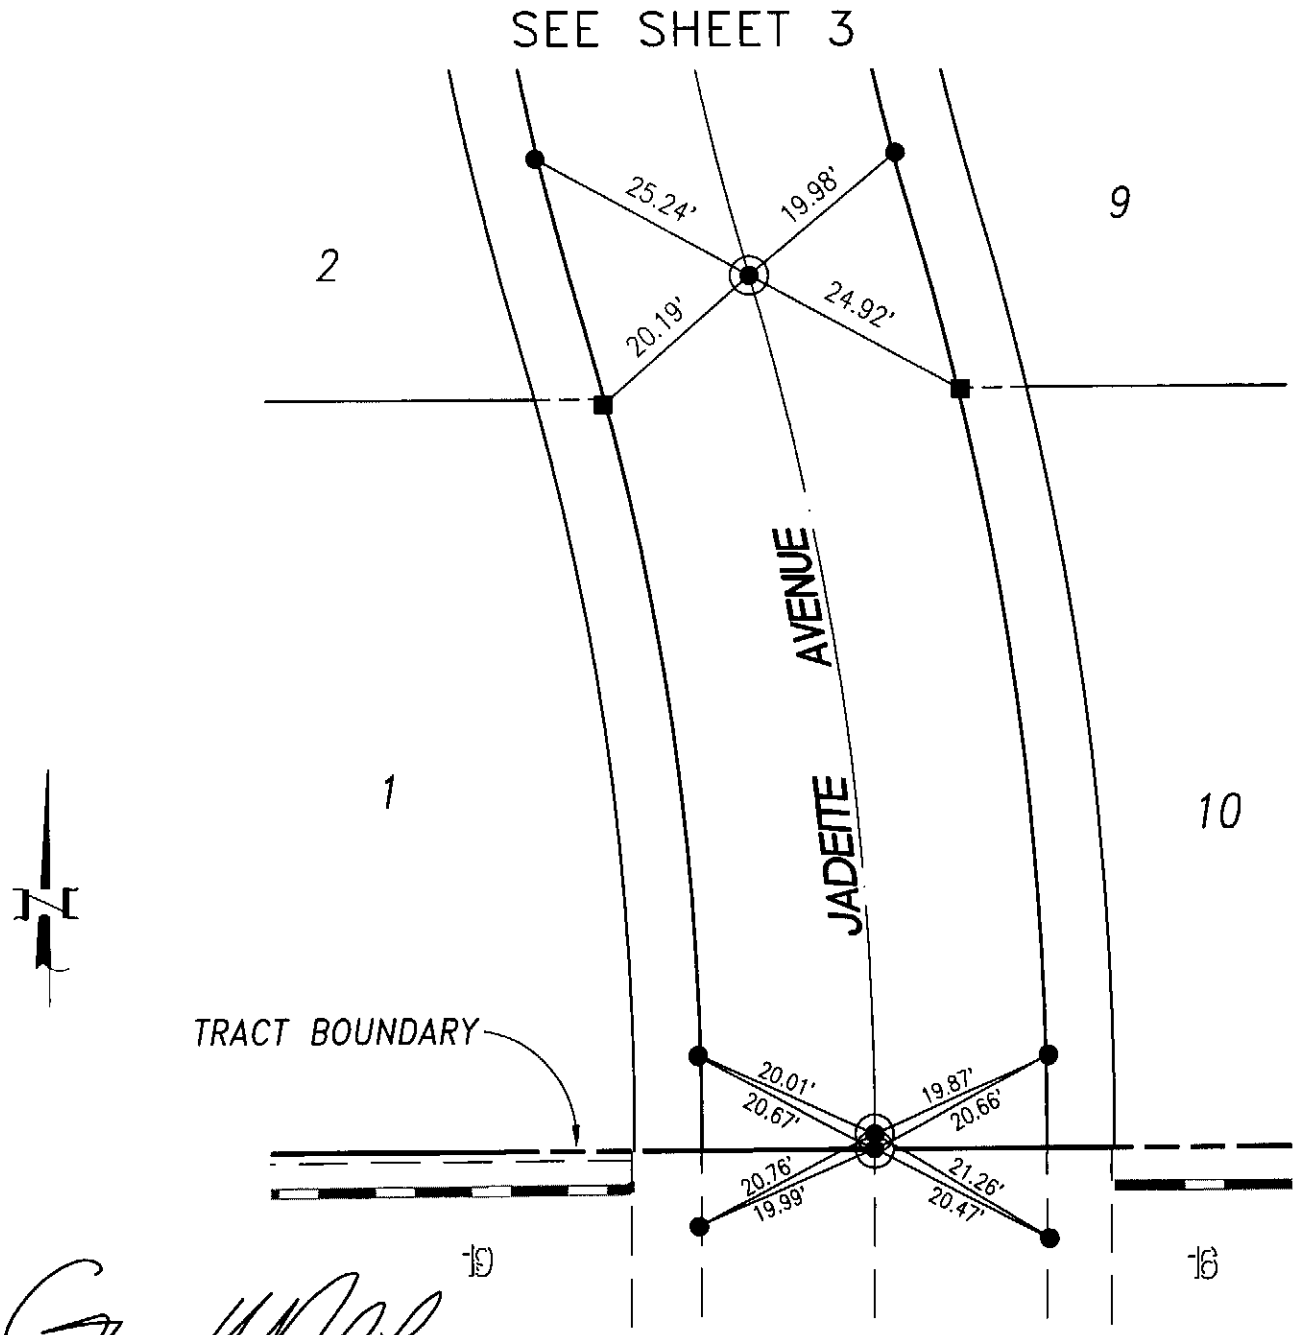

GARY W. DOKICH
L.S. 4693 EXP. 9-30-05

TRACT 9638
(SINGLE FAMILY RESIDENTIAL)

CITY OF RANCHO CUCAMONGA
PUBLIC WORKS DEPARTMENT

MDS CONSULTING
MOSSE DOKICH SCHULTZ
17320 Redhill Ave. Suite 350 Irvine, CA 92614
Voice: 949-251-8821 FAX: 949-251-0514
PLANNERS ENGINEERS SURVEYORS

4 OF 4

CENTERLINE TIES – TRACT NO. 16545 | SCALE: 1"=20' | DATE: 08-26-05

I:\CENTIES\TR16545\16545-04.dwg 8/31/05

BK 24 Pg. 182

CENTERLINE TIES

TRACT NO. 14522

GARY W. DOKICH
L.S. 4693 EXP. 9-30-05

TIE BOOK 24 PAGE 183

CITY OF RANCHO CUCAMONGA
PUBLIC WORKS DEPARTMENT

MDS CONSULTING
MORSE DOKICH SCHULTZ
17320 Redhill Ave.
Suite 350
Irvine, CA 92614
Voice: 949-251-8821
FAX: 949-251-0516
PLANNERS ENGINEERS SURVEYORS

CENTERLINE TIES – TRACT NO. 14522	SCALE: 1"=40'	DATE: 08-25-05

I:\CENTIES\TR14522\14522-01.dwg 8/31/05

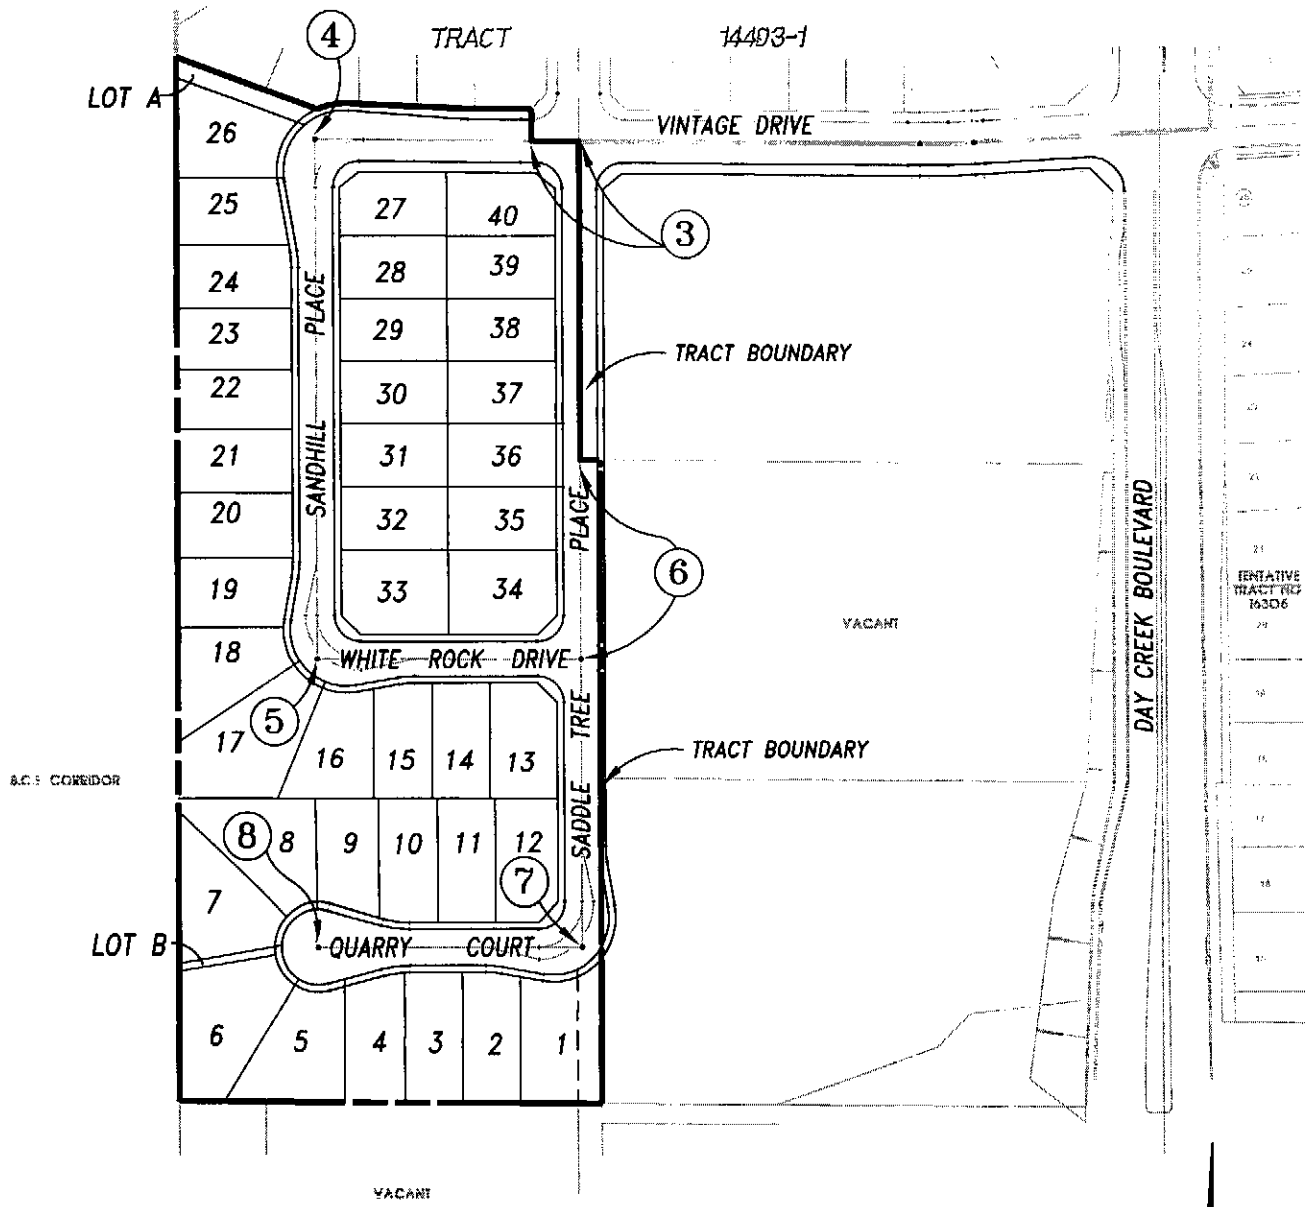

LEGEND :

(1) DENOTES SHEET NUMBERS

GARY W. DOKICH
L.S. 4693 EXP. 9-30-05

TIE BOOK 24 PAGE 184

CITY OF RANCHO CUCAMONGA

PUBLIC WORKS DEPARTMENT

MDS CONSULTING
MOSSE DOKICH SCHULTZ
17520 Redhill Ave. Suite 330 Irvine, CA 92614
Voice: 949-251-8821 FAX: 949-251-0516
PLANNERS ENGINEERS SURVEYORS

2 OF 8

CENTERLINE TIES – TRACT NO. 14522

SCALE: 1"=200'

DATE: 08-25-05

I:\CENTIES\TR14522\14522-02.dwg 8/31/05

LEGEND :

⊙ INDICATES SPIKE AND WASHER STAMPED "L.S. 4693"

● INDICATES LEAD AND BRASS TACK IN TOP OF CURB

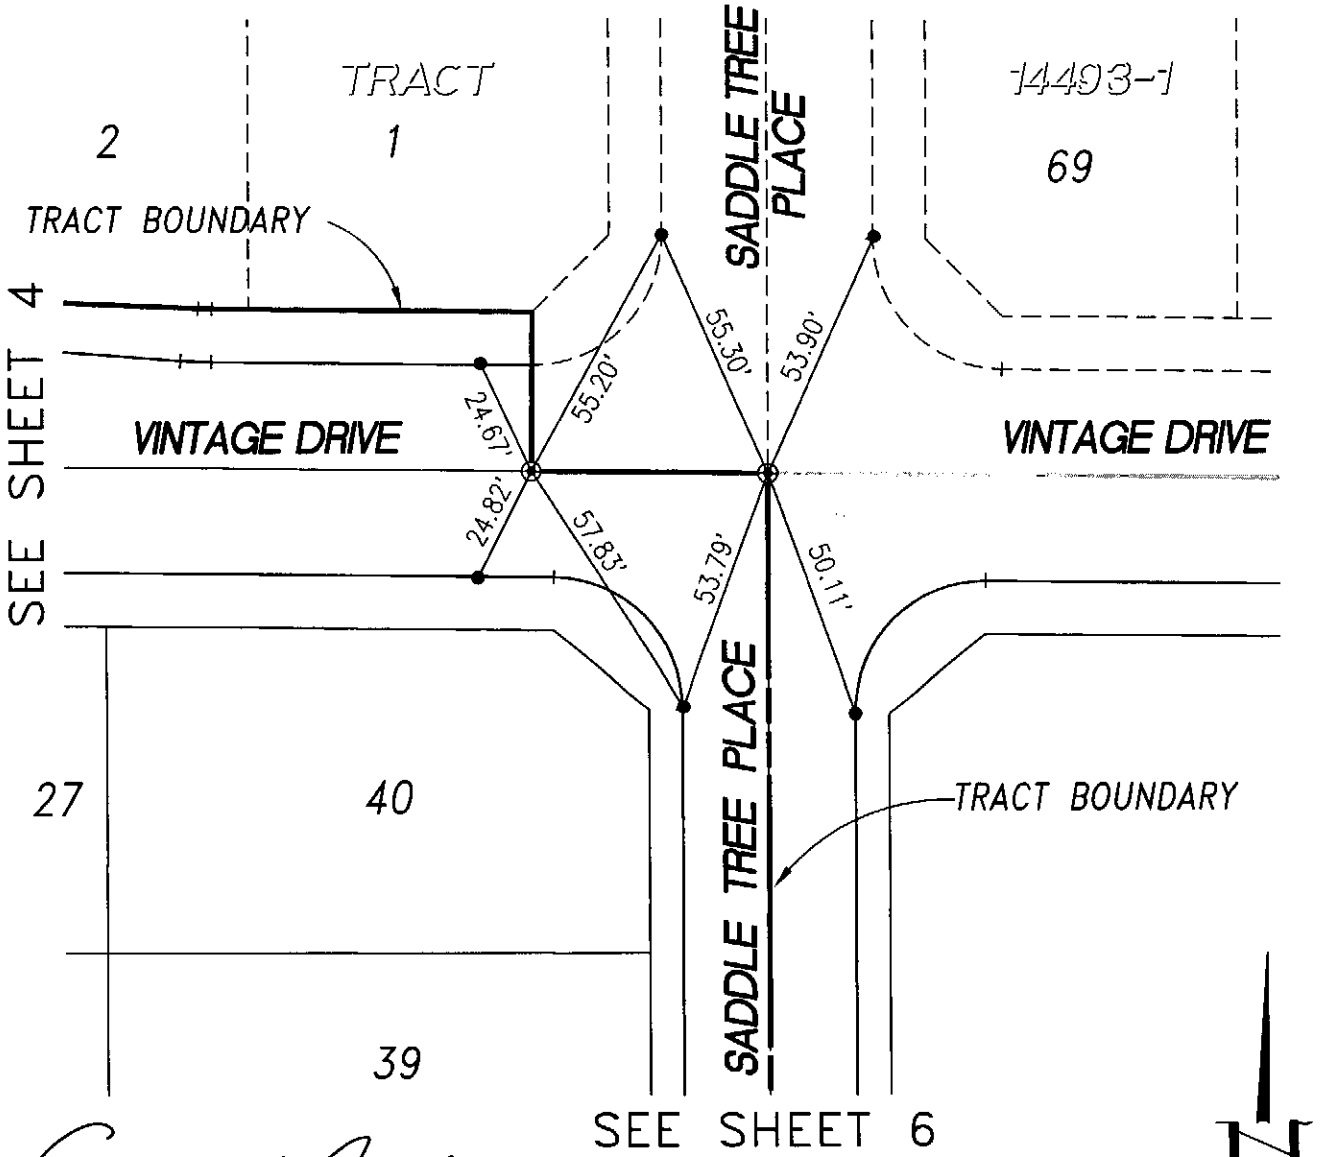

GARY W. DOKICH

L.S. 4693 EXP. 9-30-05

CITY OF RANCHO CUCAMONGA

PUBLIC WORKS DEPARTMENT

MDS CONSULTING

MOREE DOKICH SCHULTZ

17320 Redhill Ave. Suite 350 Irvine, CA 92614 Voice: 949-251-8821 FAX: 949-251-0516

PLANNERS ENGINEERS SURVEYORS

3 OF 8

CENTERLINE TIES – TRACT NO. 14522

SCALE: 1"=40'

DATE: 08-25-05

I:\CENTIES\TR14522\14522-03.dwg 8/31/05

BK 24 PG 185

LEGEND :

- ■ INDICATES LEAD, TACK AND TAG STAMPED "L.S. 4693" IN TOP OF CURB
- ● INDICATES LEAD AND BRASS TACK IN TOP OF CURB
- ⊗ INDICATES 4 PUNCH MARKS ON MANHOLE RIM TO BE USED AS CROSS-TIE

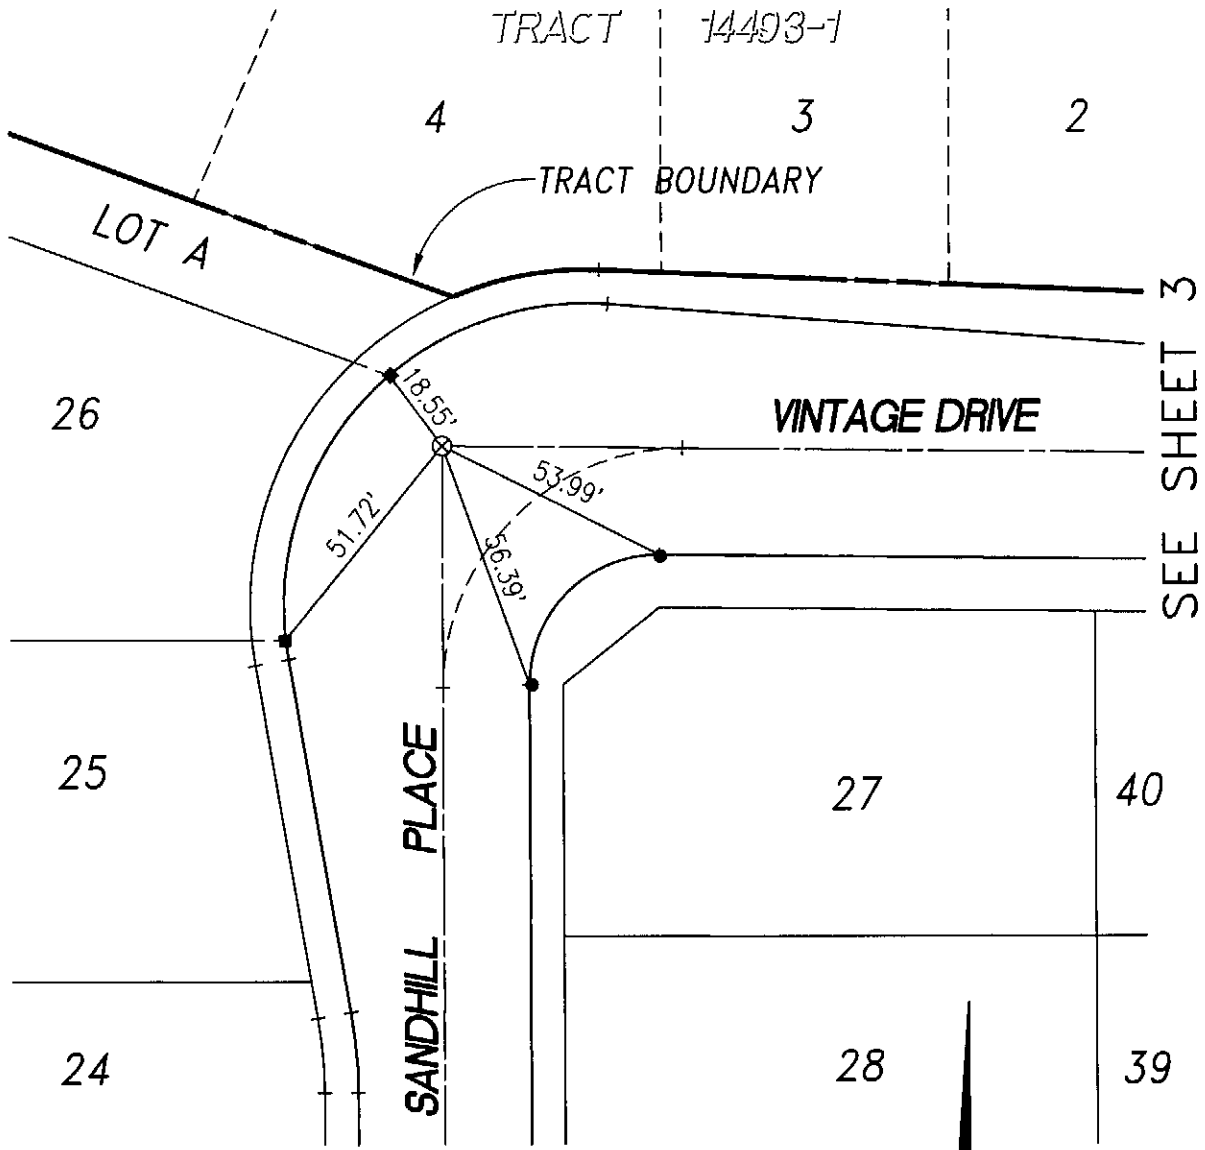

GARY W. DOKICH
L.S. 4693 EXP. 9-30-05

CITY OF RANCHO CUCAMONGA *PUBLIC WORKS DEPARTMENT*	MDS CONSULTING MOSSI DOKICH SCHULTZ 17320 Redhill Ave. Suite 350 Irvine, CA 92614 Voice: 949-251-0821 FAX: 949-251-0816 PLANNERS ENGINEERS SURVEYORS	4 OF 8
CENTERLINE TIES – TRACT NO. 14522	SCALE: 1"=40'	DATE: 08-25-05

t:\CENTIES\TR14522\14522-04.dwg 8/31/05

BK 24 PG 186

LEGEND :

- ■ INDICATES LEAD, TACK AND TAG STAMPED "L.S. 4693" IN TOP OF CURB
- ● INDICATES LEAD AND BRASS TACK IN TOP OF CURB
- ⊗ INDICATES 4 PUNCH MARKS ON MANHOLE RIM TO BE USED AS CROSS-TIE

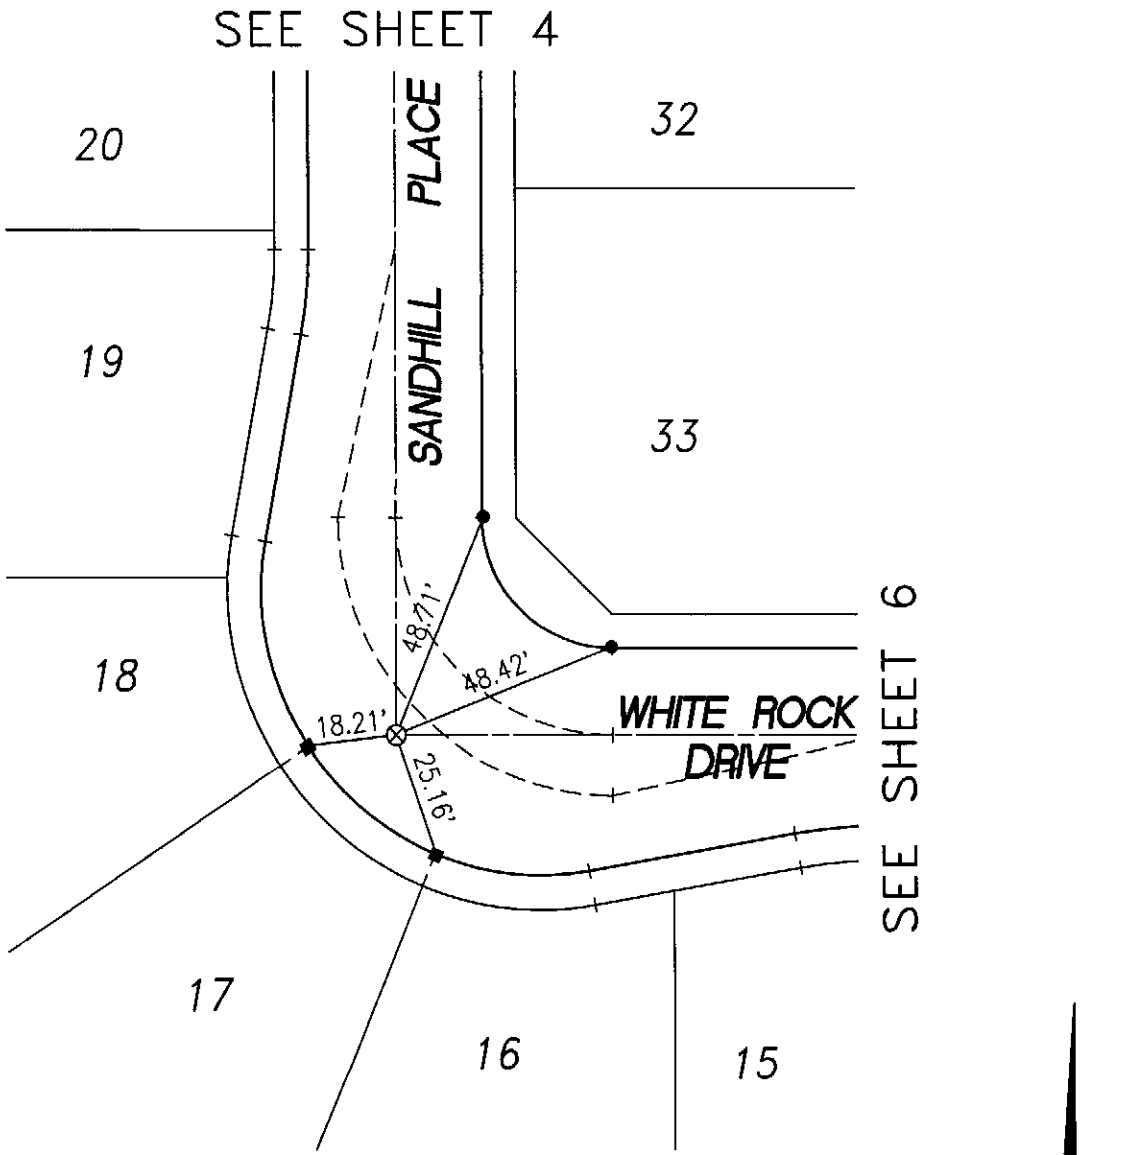

GARY W. DOKICH
L.S. 4693 EXP. 9-30-05

CITY OF RANCHO CUCAMONGA
PUBLIC WORKS DEPARTMENT

MDS CONSULTING
MORSE DOKICH SCHULTZ
17320 Redhill Ave. Suite 350 Irvine, CA 92614
Voice: 949-251-8821 FAX: 949-251-0816
PLANNERS ENGINEERS SURVEYORS

5 OF 8

CENTERLINE TIES - TRACT NO. 14522 | SCALE: 1"=40' | DATE: 08-25-05

E:\CENTIES\TR14522\14522-05.dwg 8/31/05

BK 24 PG 187

LEGEND :

- ⊙ INDICATES SPIKE AND WASHER STAMPED "L.S. 4693"
- ■ INDICATES LEAD, TACK AND TAG STAMPED "L.S. 4693" IN TOP OF CURB
- ● INDICATES LEAD AND BRASS TACK IN TOP OF CURB
- ⊗ INDICATES 4 PUNCH MARKS ON MANHOLE RIM TO BE USED AS CROSS-TIE

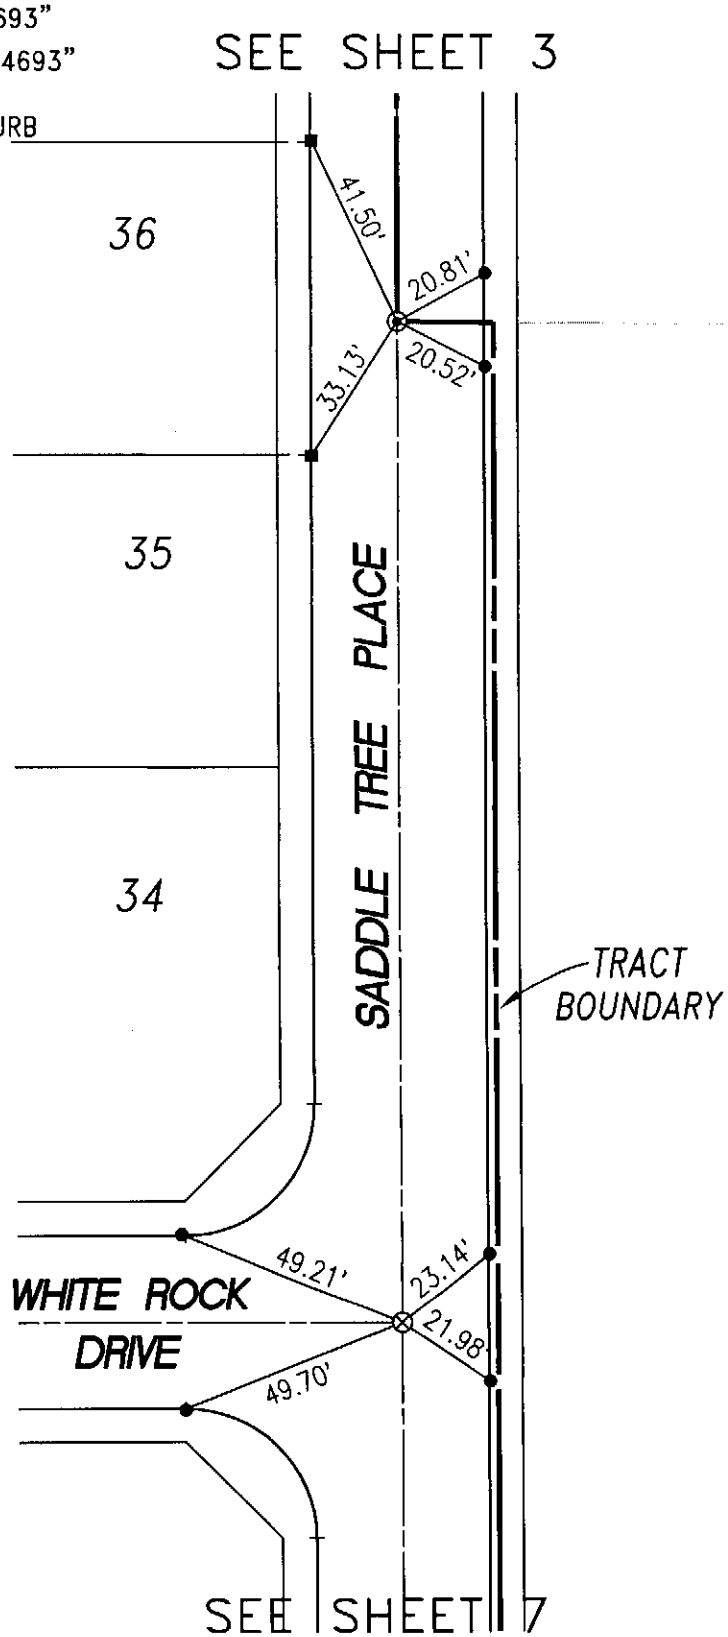

GARY W. DOKICH
L.S. 4693 EXP. 9-30-05

CITY OF RANCHO CUCAMONGA
PUBLIC WORKS DEPARTMENT

MDS CONSULTING
MORSE DOKICH SCHULTZ
17320 Redhill Ave. Suite 350 Irvine, CA 92614
Voice: 949-251-8821 FAX: 949-251-0516
PLANNERS ENGINEERS SURVEYORS

CENTERLINE TIES – TRACT NO. 14522 | SCALE: 1"=40' | DATE: 08-25-05

I:\CENTIES\TR14522\14522-06.dwg 8/31/05

LEGEND :

- ■ INDICATES LEAD, TACK AND TAG STAMPED "L.S. 4693" IN TOP OF CURB
- ● INDICATES LEAD AND BRASS TACK IN TOP OF CURB
- ⊗ INDICATES 4 PUNCH MARKS ON MANHOLE RIM TO BE USED AS CROSS-TIE

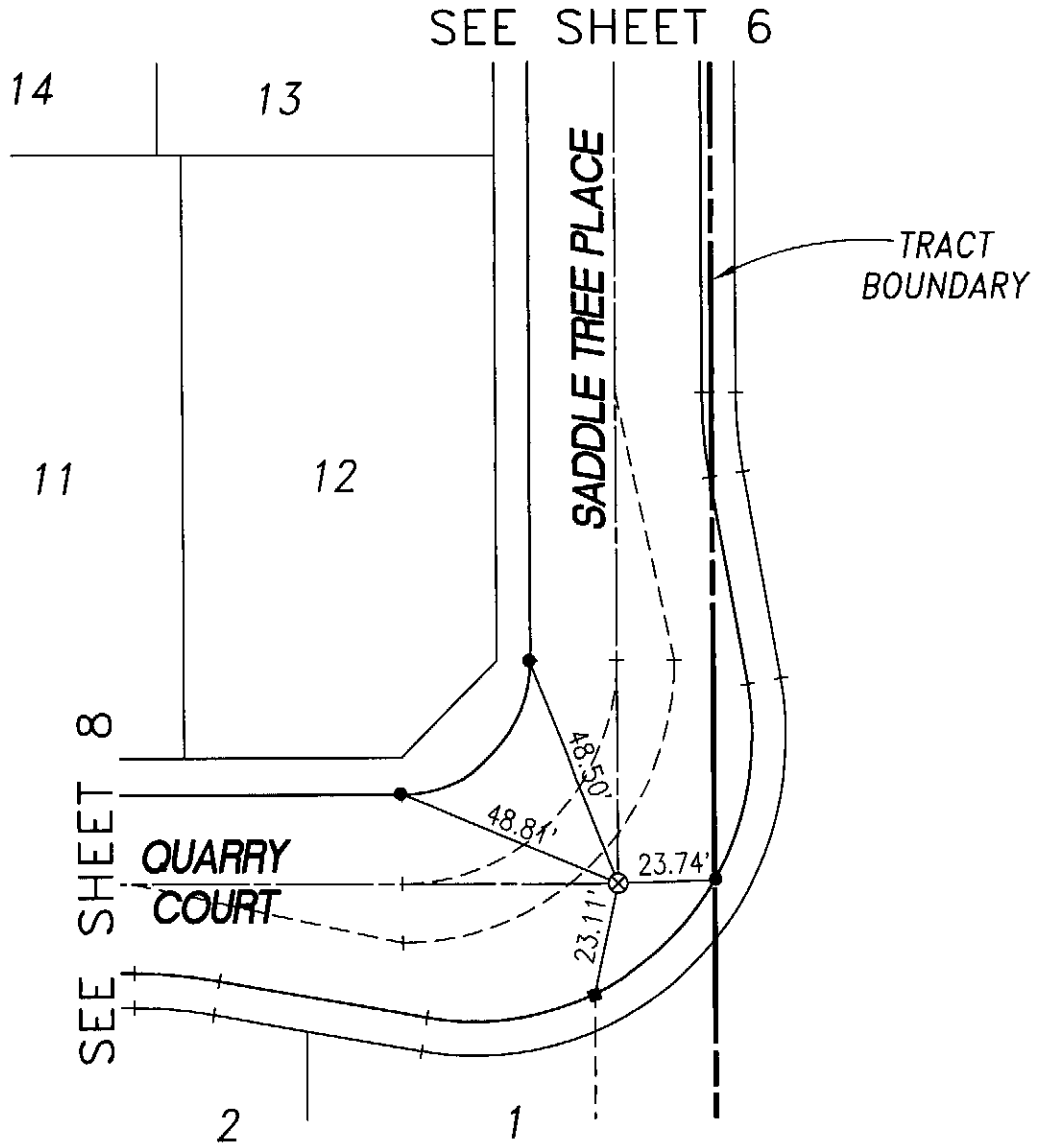

GARY W. DOKICH
L.S. 4693 EXP. 9-30-05

CITY OF RANCHO CUCAMONGA
PUBLIC WORKS DEPARTMENT

MDS CONSULTING
MORSE DOKICH SCHULTZ
17330 Redhill Ave. Suite 350 Irvine, CA 92614 Voice: 949-251-8821 FAX: 949-251-0816
PLANNERS ENGINEERS SURVEYORS

7 OF 8

CENTERLINE TIES – TRACT NO. 14522 | SCALE: 1"=40' | DATE: 08-25-05

I:\CENTIES\TR14522\14522-07.dwg 8/31/05

BK 24 PG 189

LEGEND :

- ⊙ INDICATES SPIKE AND WASHER STAMPED "L.S. 4693"
- ■ INDICATES LEAD, TACK AND TAG STAMPED "L.S. 4693" IN TOP OF CURB
- ● INDICATES LEAD AND BRASS TACK IN TOP OF CURB

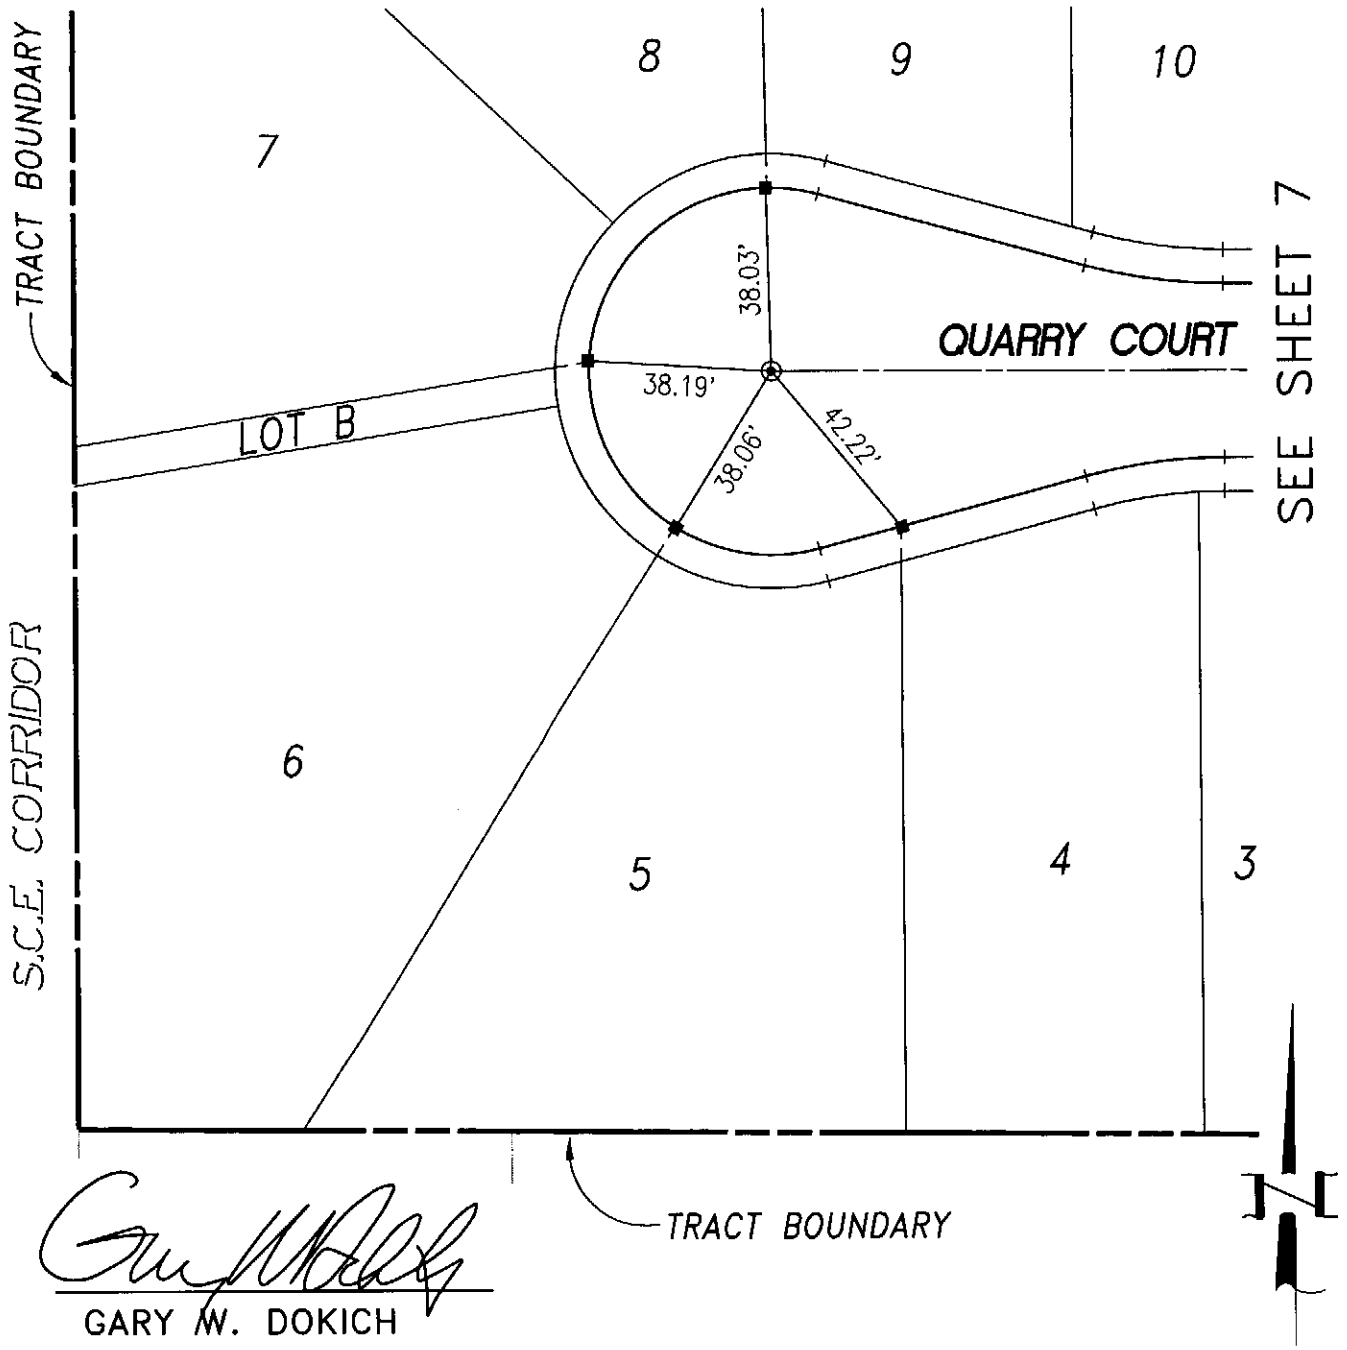

GARY W. DOKICH
L.S. 4693 EXP. 9-30-05

CITY OF RANCHO CUCAMONGA *PUBLIC WORKS DEPARTMENT*	MDS CONSULTING MOREE DOKICH SCHULTZ 17320 Redhill Ave. Suite 350 Irvine, CA 92614 Voice: 949-251-8821 FAX: 949-251-0516 PLANNERS ENGINEERS SURVEYORS	8 OF 8
CENTERLINE TIES – TRACT NO. 14522	SCALE: 1"=40'	DATE: 08-25-05

I:\CENTIES\TR14522\14522-08.dwg 8/31/05

BK 24 190

CENTERLINE TIES

TRACT NO. 16312

GARY W. DOKICH
L.S. 4693 EXP. 9-30-05

TIE BOOK 24 PAGE 191

CITY OF RANCHO CUCAMONGA
PUBLIC WORKS DEPARTMENT

MDS CONSULTING
MOSSI DOKICH SCHULTZ
17320 Redhill Ave.
Suite 350
Irvine, CA 92614
Voice: 949-251-8821
FAX: 949-251-0816
PLANNERS ENGINEERS SURVEYORS

CENTERLINE TIES - TRACT NO. 16312 | SCALE: 1"=40' | DATE: 06-29-05

I:\CENTIES\TR16312\16312-01.dwg 8/22/05

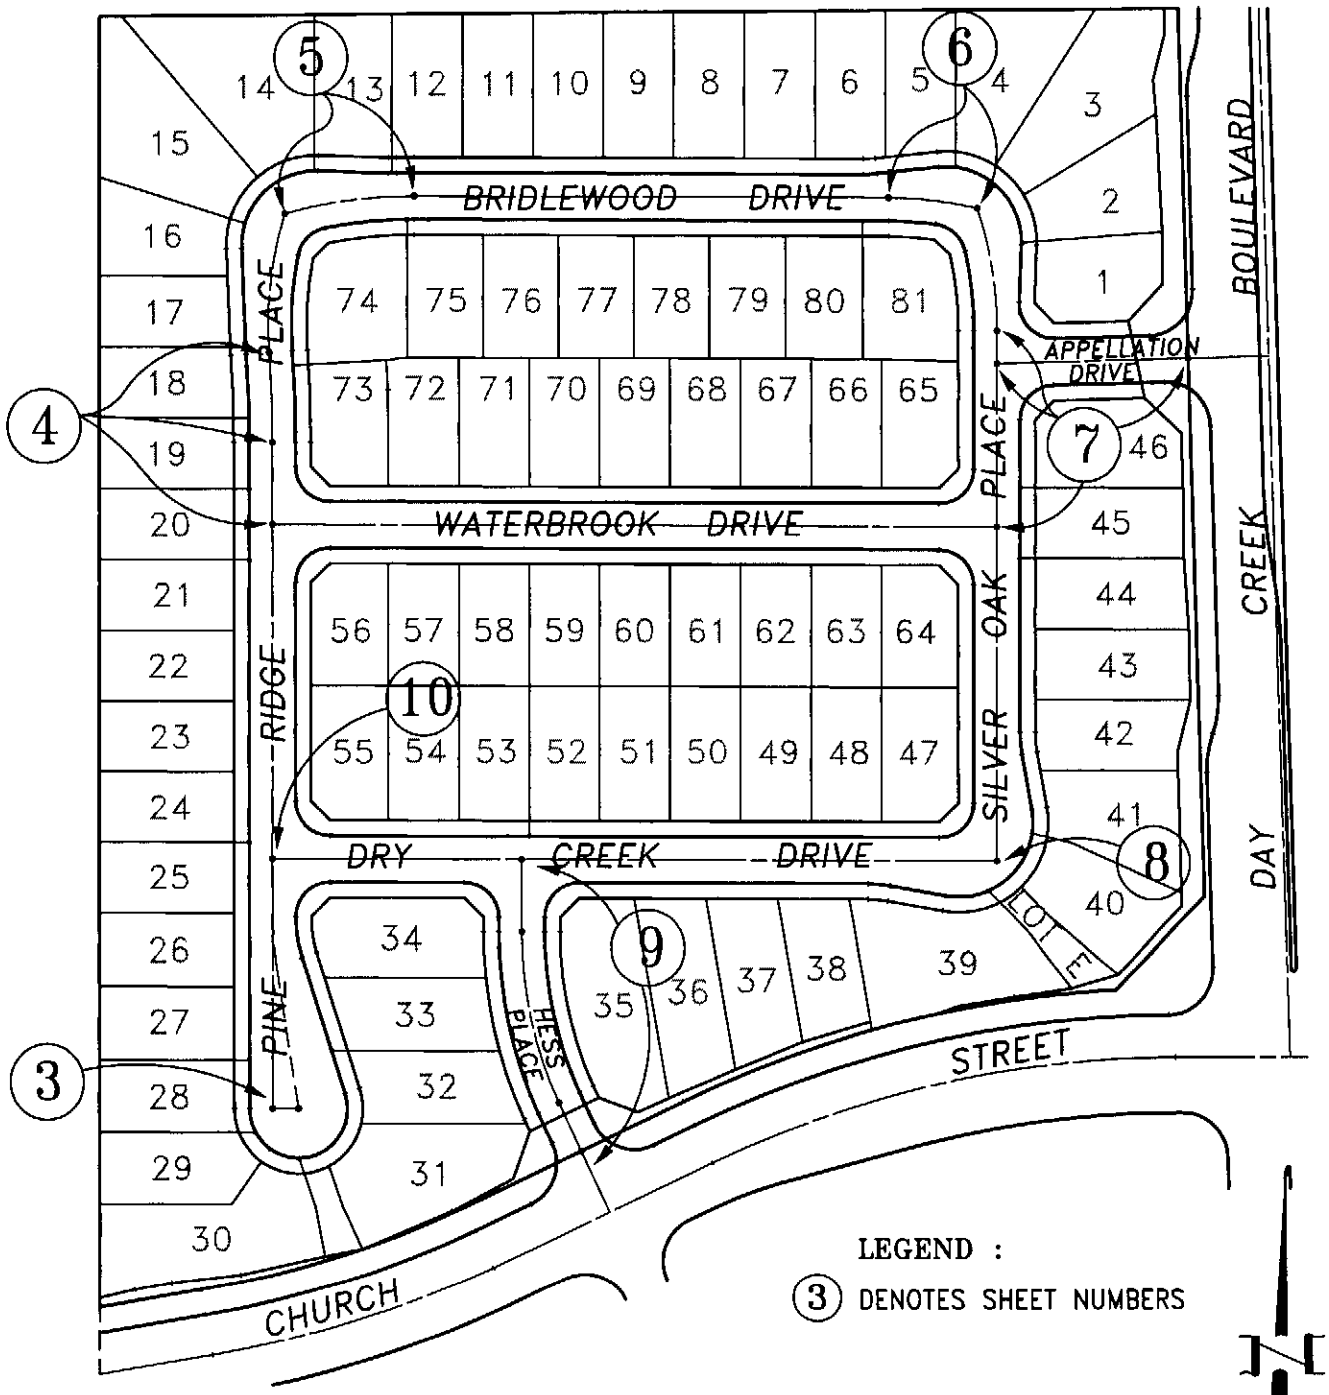

GARY W. DOKICH
L.S. 4693 EXP. 9-30-05

TIE BOOK 24 PAGE 192

CITY OF RANCHO CUCAMONGA
PUBLIC WORKS DEPARTMENT

MDS CONSULTING
PLANNERS ENGINEERS SURVEYORS
MOSSE DOKICH SCHULTZ
17320 Redhill Ave. Suite 350 Irvine, CA 92614
Voice: 949-251-8821 FAX: 949-251-0616

CENTERLINE TIES – TRACT NO. 16312

SCALE: 1"=150'

DATE: 06-29-05

I:\CENTIES\TR16312\16312-02.dwg 8/22/05

LEGEND :

- ⊙ INDICATES SPIKE AND WASHER STAMPED "L.S. 4693"
- ● INDICATES LEAD, TACK AND TAG STAMPED "L.S. 4693" IN TOP OF CURB
- ■ INDICATES LEAD & BRASS TACK IN TOP OF CURB

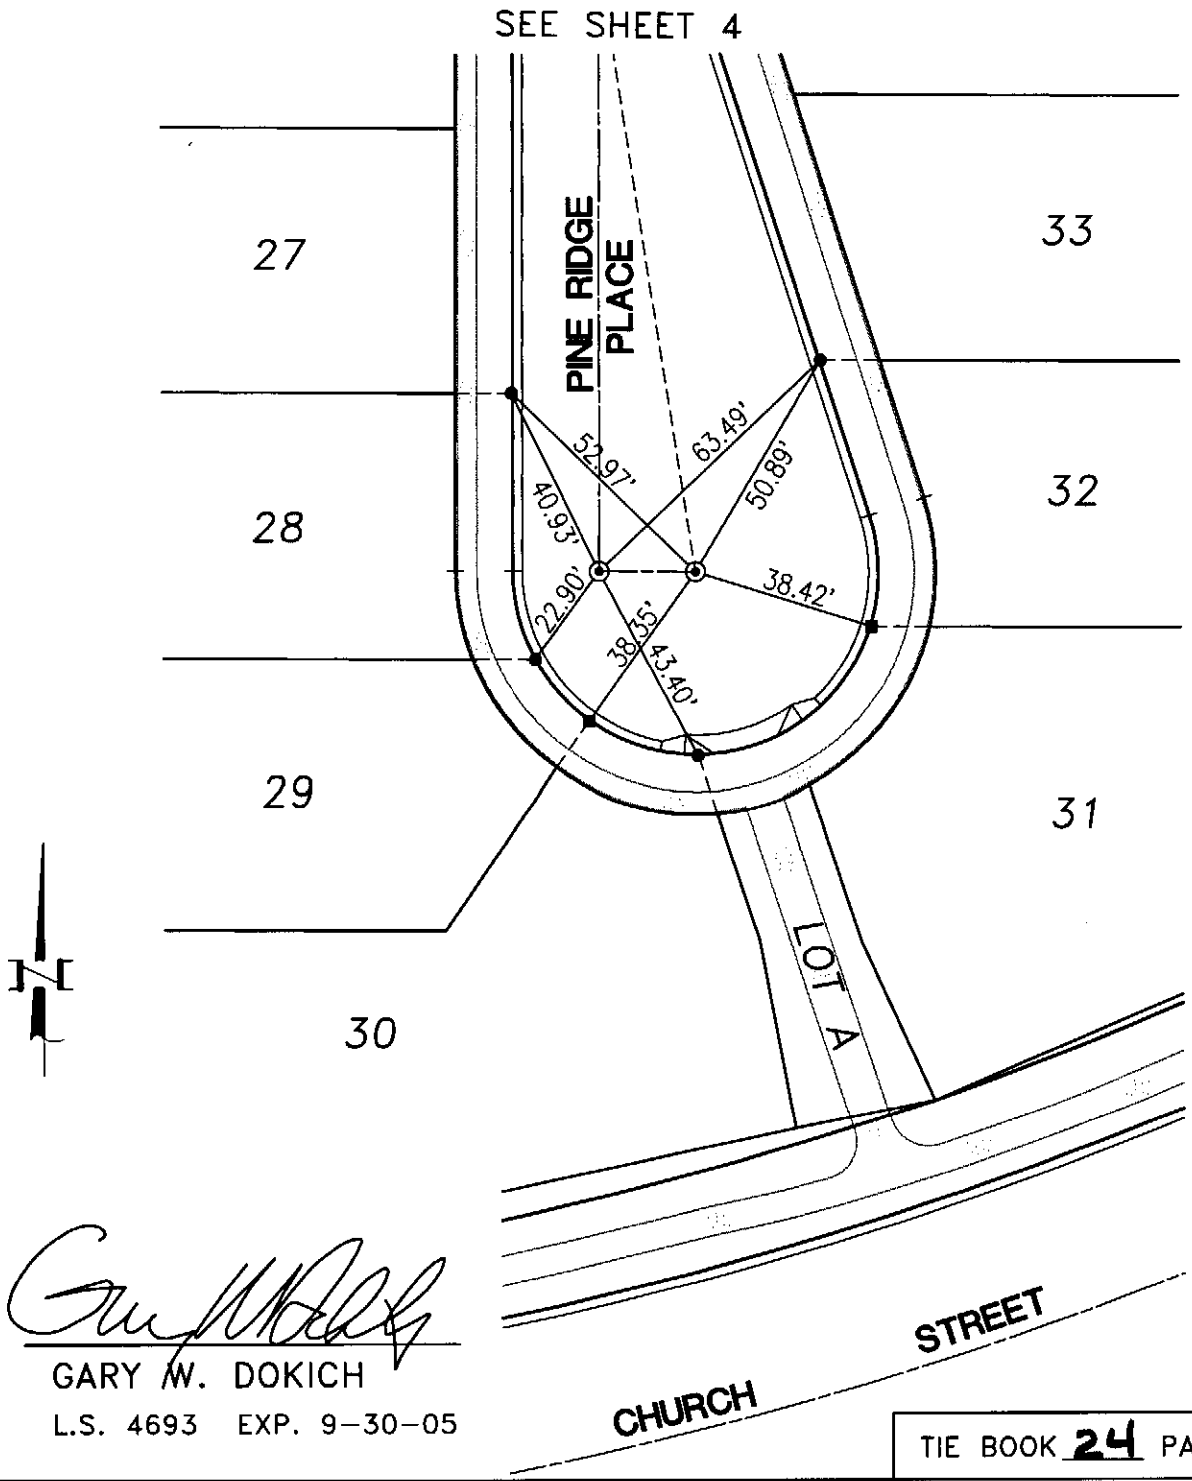

GARY W. DOKICH
L.S. 4693 EXP. 9-30-05

TIE BOOK 24 PAGE 193

CITY OF RANCHO CUCAMONGA
PUBLIC WORKS DEPARTMENT

MDS CONSULTING
PLANNERS ENGINEERS SURVEYORS
MORSE DOKICH SCHULTZ
17320 Redhill Ave. Suite 350 Irvine, CA 92614
Voice: 949-251-8821 FAX: 949-251-0516

3 OF 10

CENTERLINE TIES – TRACT NO. 16312 | SCALE: 1"=40' | DATE: 06-29-05

I:\CENTIES\TR16312\16312-03.dwg 8/22/05

LEGEND :

- ⊙ INDICATES SPIKE AND WASHER STAMPED "L.S. 4693"
- ● INDICATES LEAD, TACK AND TAG STAMPED "L.S. 4693" IN TOP OF CURB
- ■ INDICATES LEAD & BRASS TACK IN TOP OF CURB
- ⊗ INDICATES 4 MARKS ON MANHOLE RIM

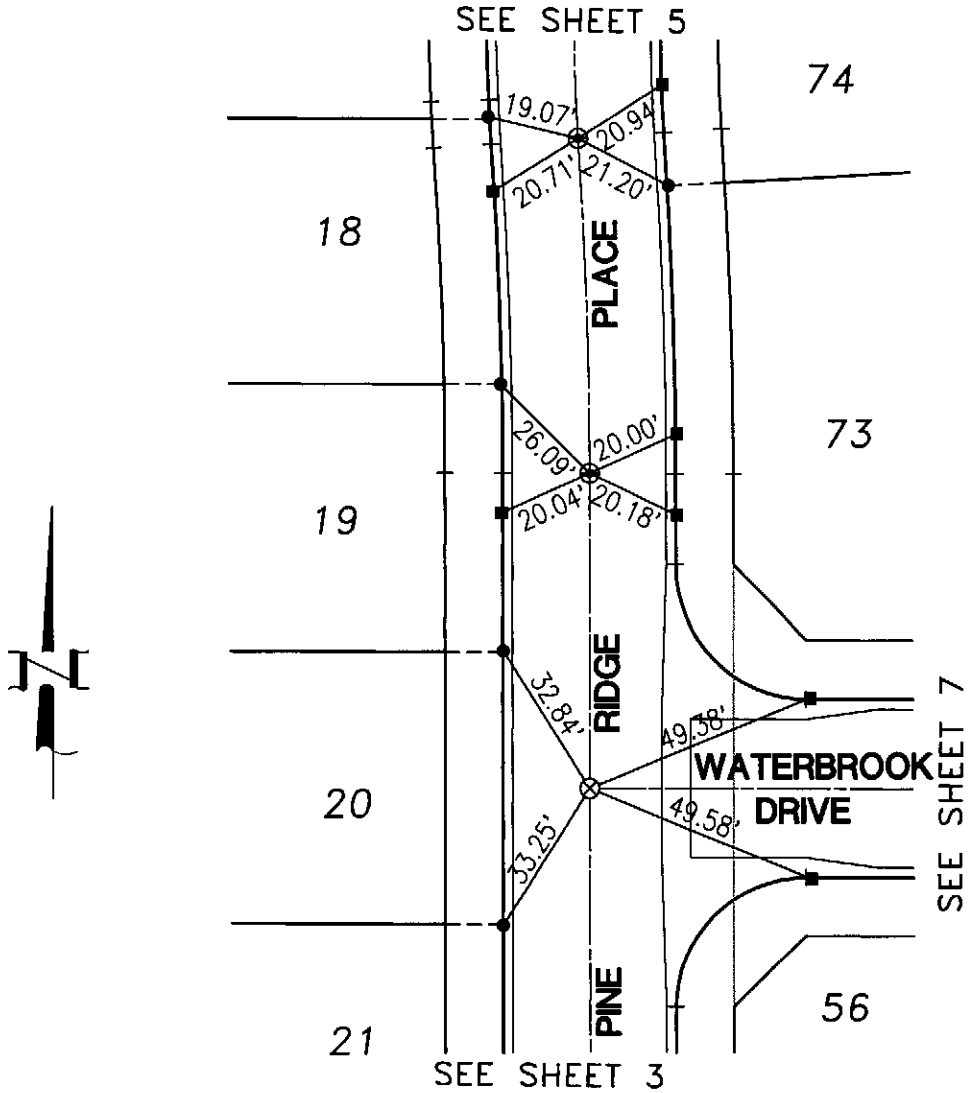

GARY W. DOKICH
L.S. 4693 EXP. 9-30-05

TIE BOOK 24 PAGE 194

CITY OF RANCHO CUCAMONGA
PUBLIC WORKS DEPARTMENT

MDS CONSULTING
PLANNERS ENGINEERS SURVEYORS

4 OF 10

CENTERLINE TIES – TRACT NO. 16312 | SCALE: 1"=30' | DATE: 06-29-05

I:\CENTIES\TR16312\16312-04.DWG 8/22/05

LEGEND :

⊙ INDICATES SPIKE AND WASHER STAMPED "L.S. 4693"

● INDICATES LEAD, TACK AND TAG STAMPED "L.S. 4693" IN TOP OF CURB

■ INDICATES LEAD & BRASS TACK IN TOP OF CURB

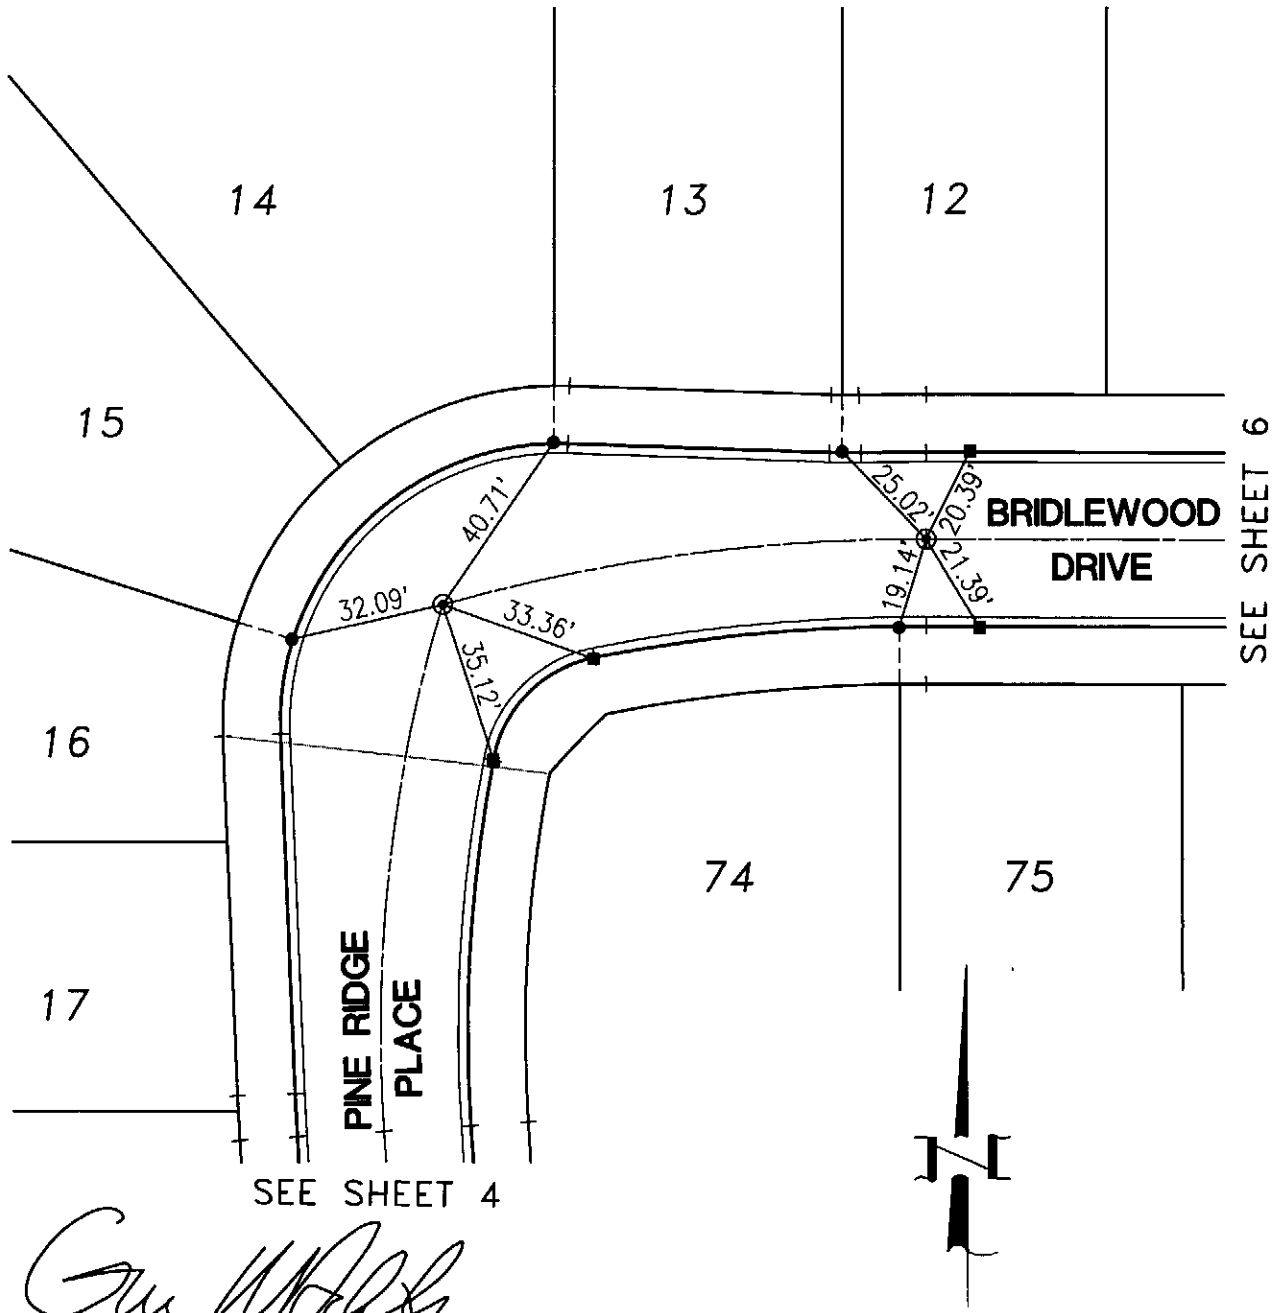

GARY W. DOKICH

L.S. 4693 EXP. 9-30-05

TIE BOOK 24 PAGE 195

CITY OF RANCHO CUCAMONGA

PUBLIC WORKS DEPARTMENT

MDS CONSULTING

PLANNERS ENGINEERS SURVEYORS

MORSE DOKICH SCHULTZ

17320 Redhill Ave. Suite 350 Irvine, CA 92614 Voice: 949-251-8821 FAX: 949-251-0516

5 OF 10

CENTERLINE TIES – TRACT NO. 16312

SCALE: 1"=40'

DATE: 06-29-05

I:\CENTIES\TR16312\16312-05.dwg 8/22/05

LEGEND :

- ⊙ INDICATES SPIKE AND WASHER STAMPED "L.S. 4693"
- ● INDICATES LEAD, TACK AND TAG STAMPED "L.S. 4693" IN TOP OF CURB
- ■ INDICATES LEAD & BRASS TACK IN TOP OF CURB

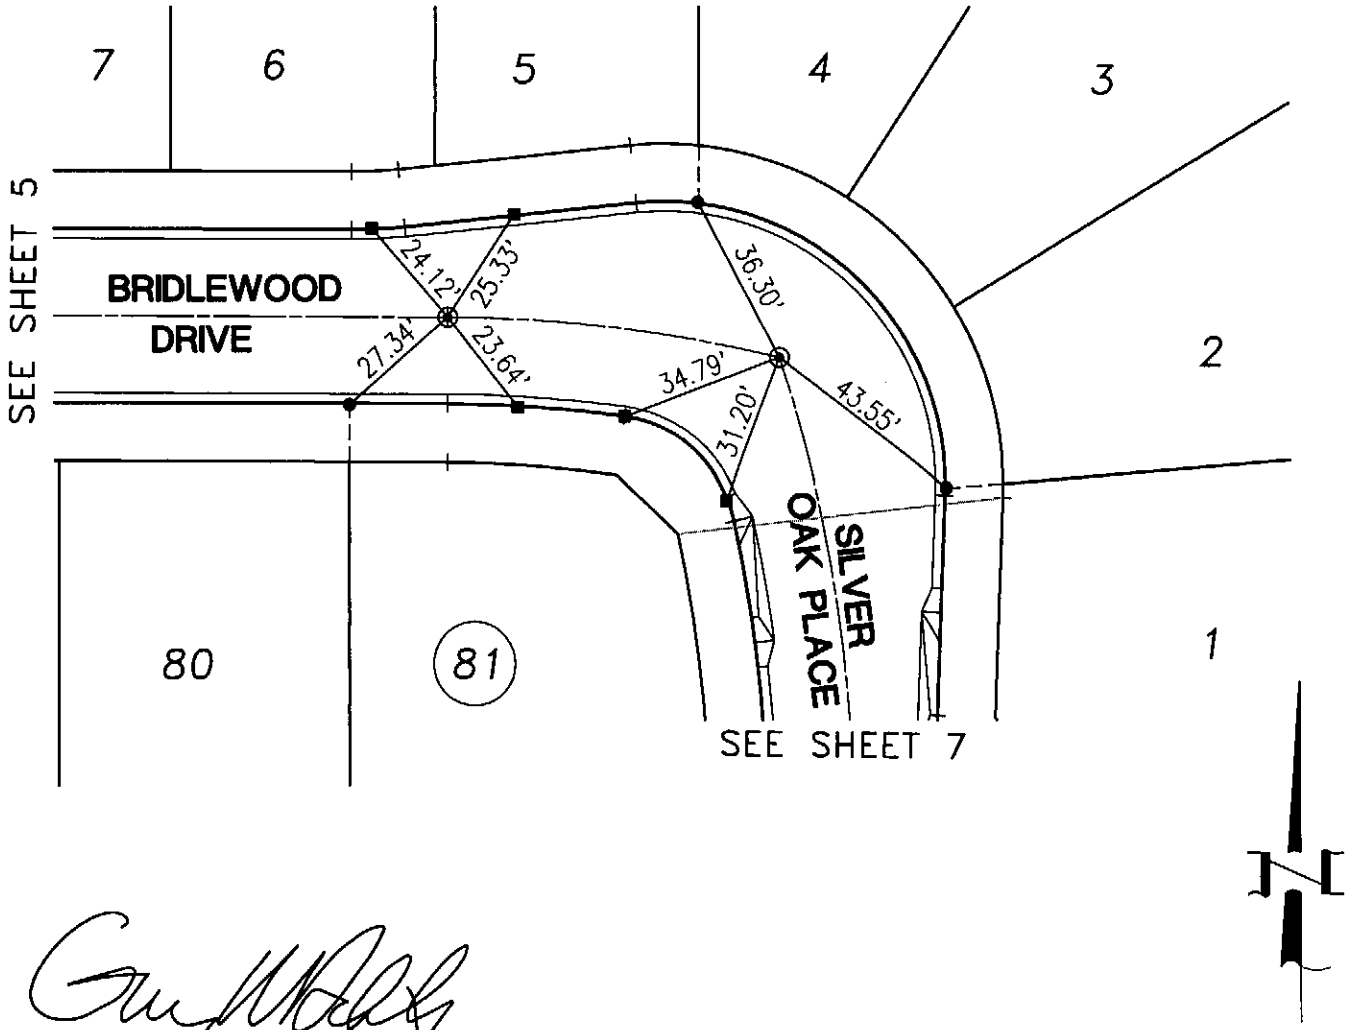

GARY W. DOKICH
L.S. 4693 EXP. 9-30-05

TIE BOOK 24 PAGE 196

CITY OF RANCHO CUCAMONGA
PUBLIC WORKS DEPARTMENT

MDS CONSULTING
MORSE DOKICH SCHULTZ
17320 Redhill Ave. Suite 350 Irvine, CA 92614
Voice: 949-251-8821 FAX: 949-251-0516
PLANNERS ENGINEERS SURVEYORS

6 OF 9

CENTERLINE TIES - TRACT NO. 16312 | SCALE: 1"=40' | DATE: 06-29-05

I:\CENTIES\TR16312\16312-06.dwg 8/22/05

LEGEND :

- ⊙ INDICATES SPIKE AND WASHER STAMPED "L.S. 4693"
- ● INDICATES LEAD, TACK AND TAG STAMPED "L.S. 4693" IN TOP OF CURB
- ■ INDICATES LEAD & BRASS TACK IN TOP OF CURB
- ⊗ INDICATES 4 MARKS ON MANHOLE RIM

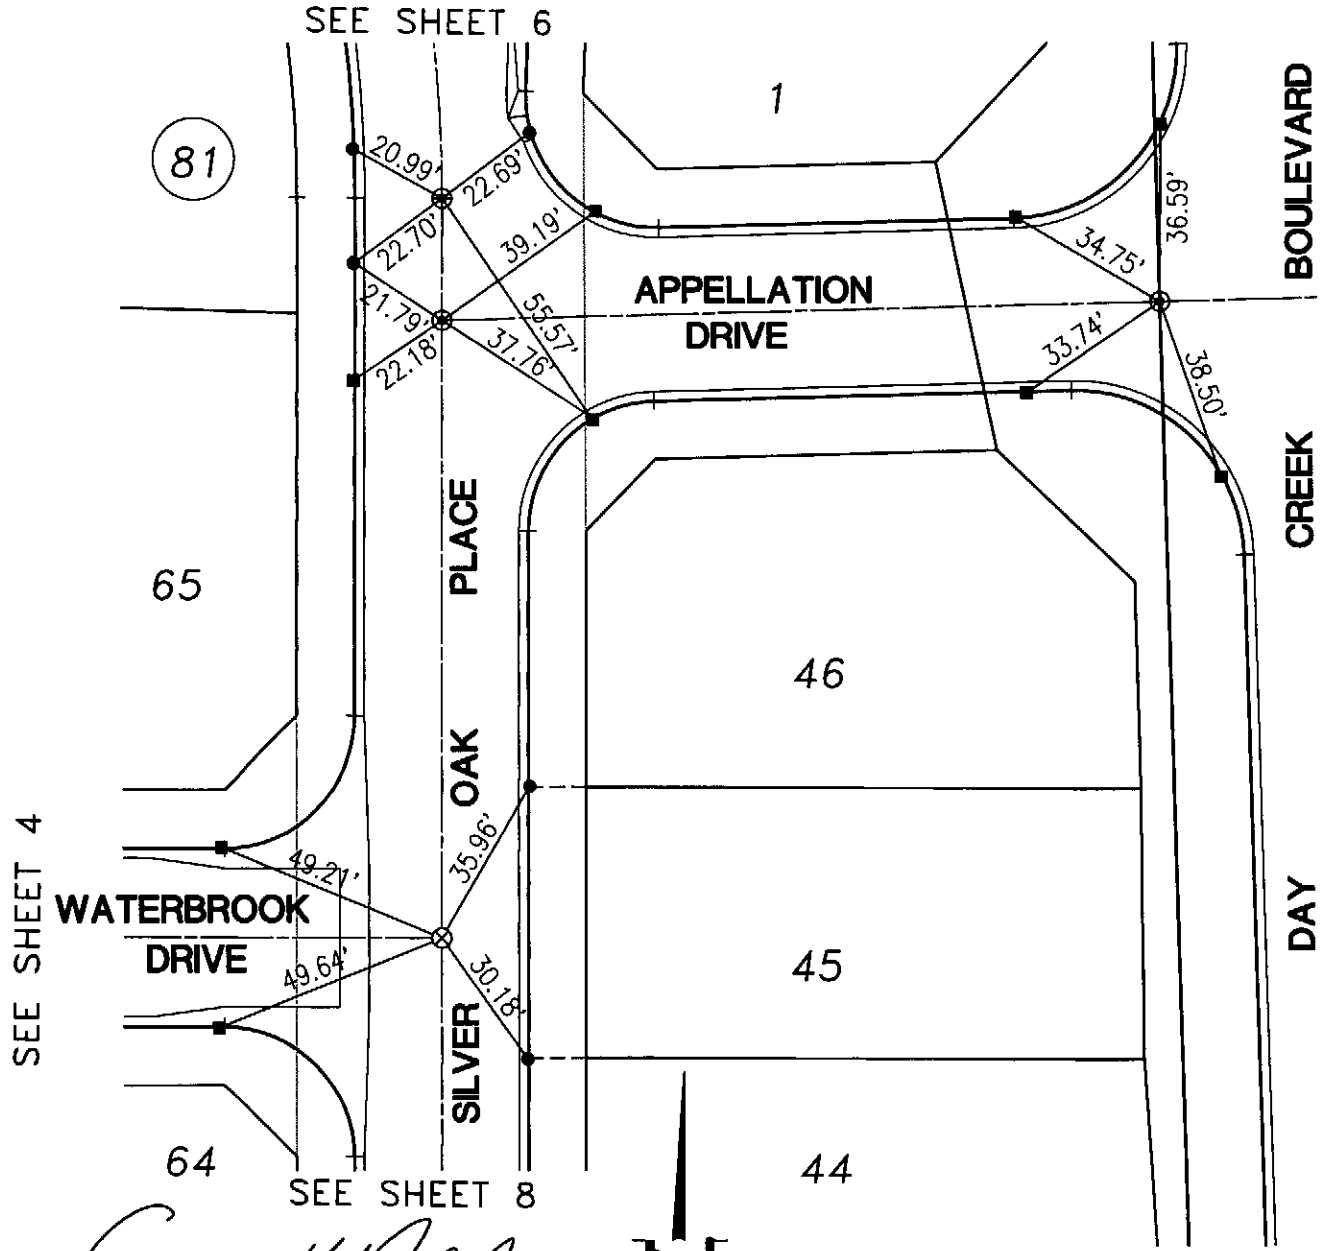

GARY W. DOKICH
L.S. 4693 EXP. 9-30-05

TIE BOOK 24 PAGE 197

CITY OF RANCHO CUCAMONGA
PUBLIC WORKS DEPARTMENT

MDS CONSULTING
MOSER DOKICH SCHULTZ
17320 Redhill Ave. Suite 350 Irvine, CA 92614
Voice: 949-251-8821 FAX: 949-251-0516
PLANNERS ENGINEERS SURVEYORS

7 OF 10

CENTERLINE TIES – TRACT NO. 16312 | SCALE: 1"=40' | DATE: 06-29-05

I:\CENTIES\TR16312\16312-07.dwg 8/22/05

LEGEND :

- ⊙ INDICATES SPIKE AND WASHER STAMPED "L.S. 4693"
- ● INDICATES LEAD, TACK AND TAG STAMPED "L.S. 4693" IN TOP OF CURB
- ■ INDICATES LEAD & BRASS TACK IN TOP OF CURB

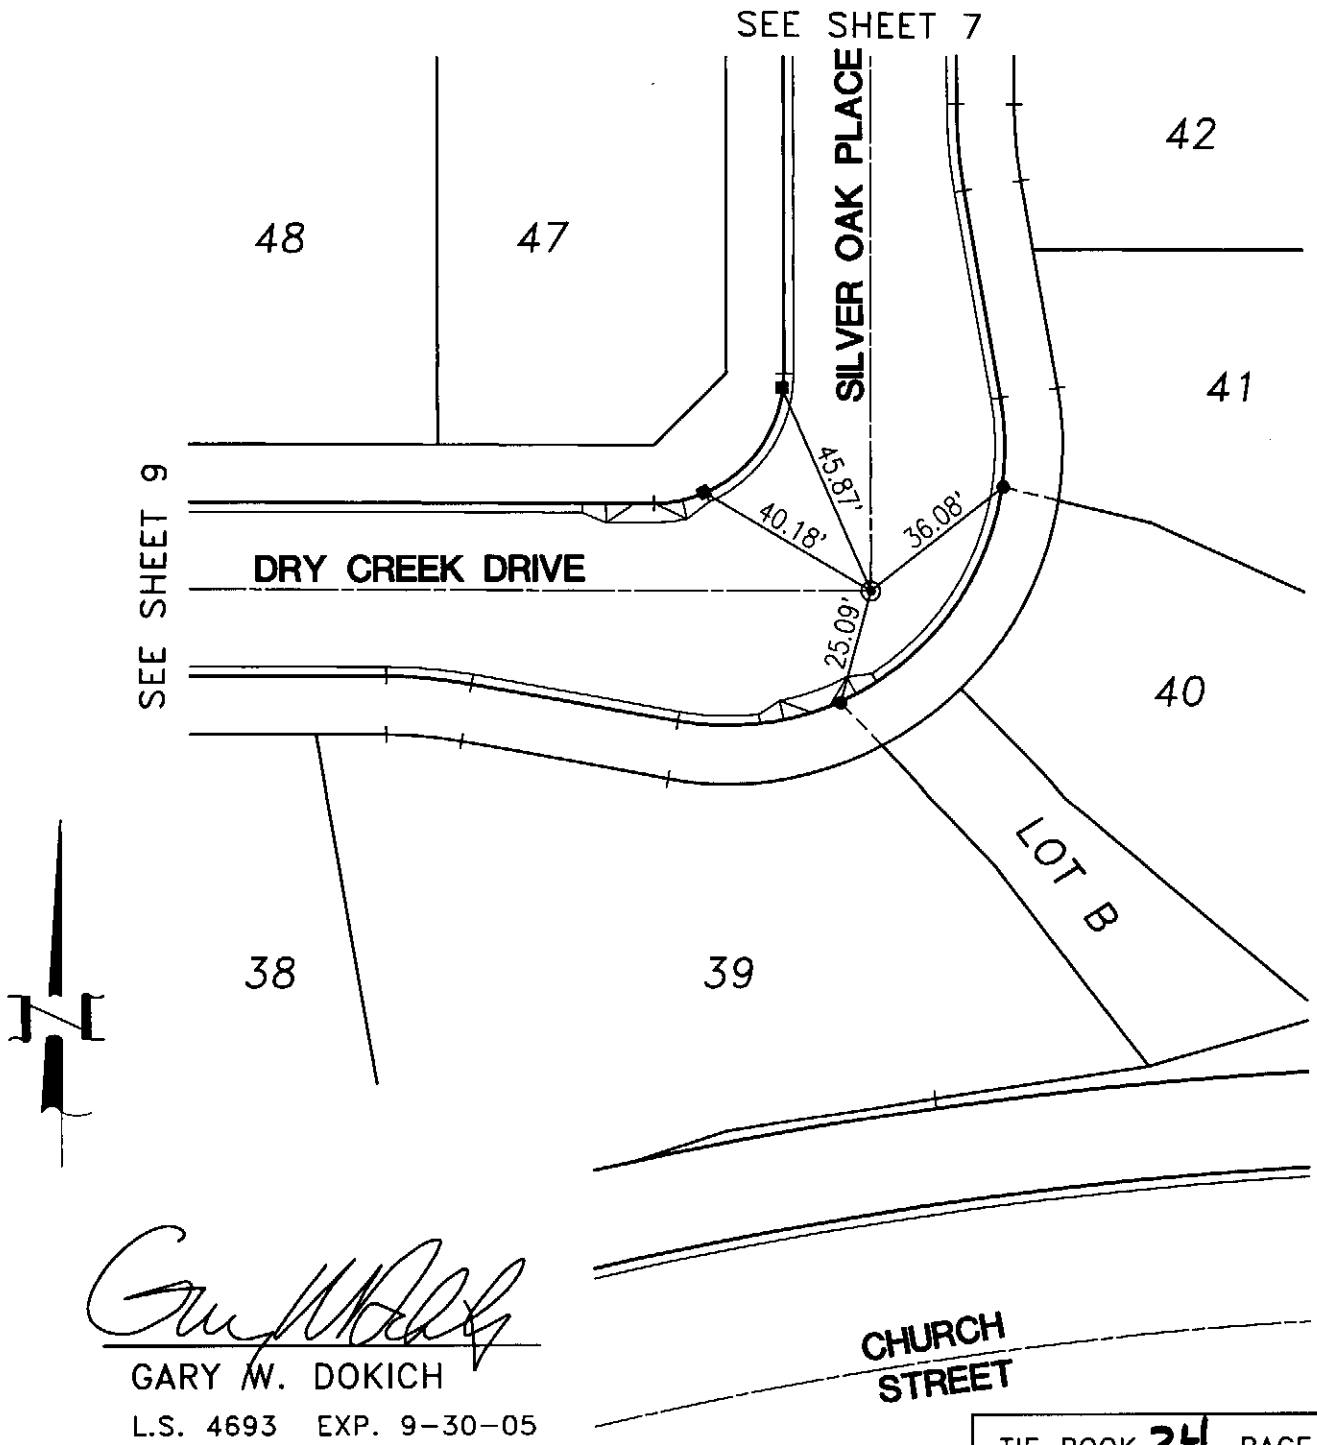

GARY W. DOKICH
L.S. 4693 EXP. 9-30-05

TIE BOOK 24 PAGE 198

CITY OF RANCHO CUCAMONGA
PUBLIC WORKS DEPARTMENT

MDS CONSULTING
MORSE DOKICH SCHULTZ
17320 Redhill Ave. Suite 350 Irvine, CA 92614
Voice: 949-251-0821 FAX: 949-251-0516
PLANNERS ENGINEERS SURVEYORS

8 OF 10

CENTERLINE TIES – TRACT NO. 16312 | SCALE: 1"=40' | DATE: 06-29-05

I:\CENTIES\TR16312\16312-08.dwg 8/22/05

LEGEND :

- ⊙ INDICATES SPIKE AND WASHER STAMPED "L.S. 4693"
- ● INDICATES LEAD, TACK AND TAG STAMPED "L.S. 4693" IN TOP OF CURB
- ■ INDICATES LEAD & BRASS TACK IN TOP OF CURB
- ⊗ INDICATES 4 MARKS ON MANHOLE RIM

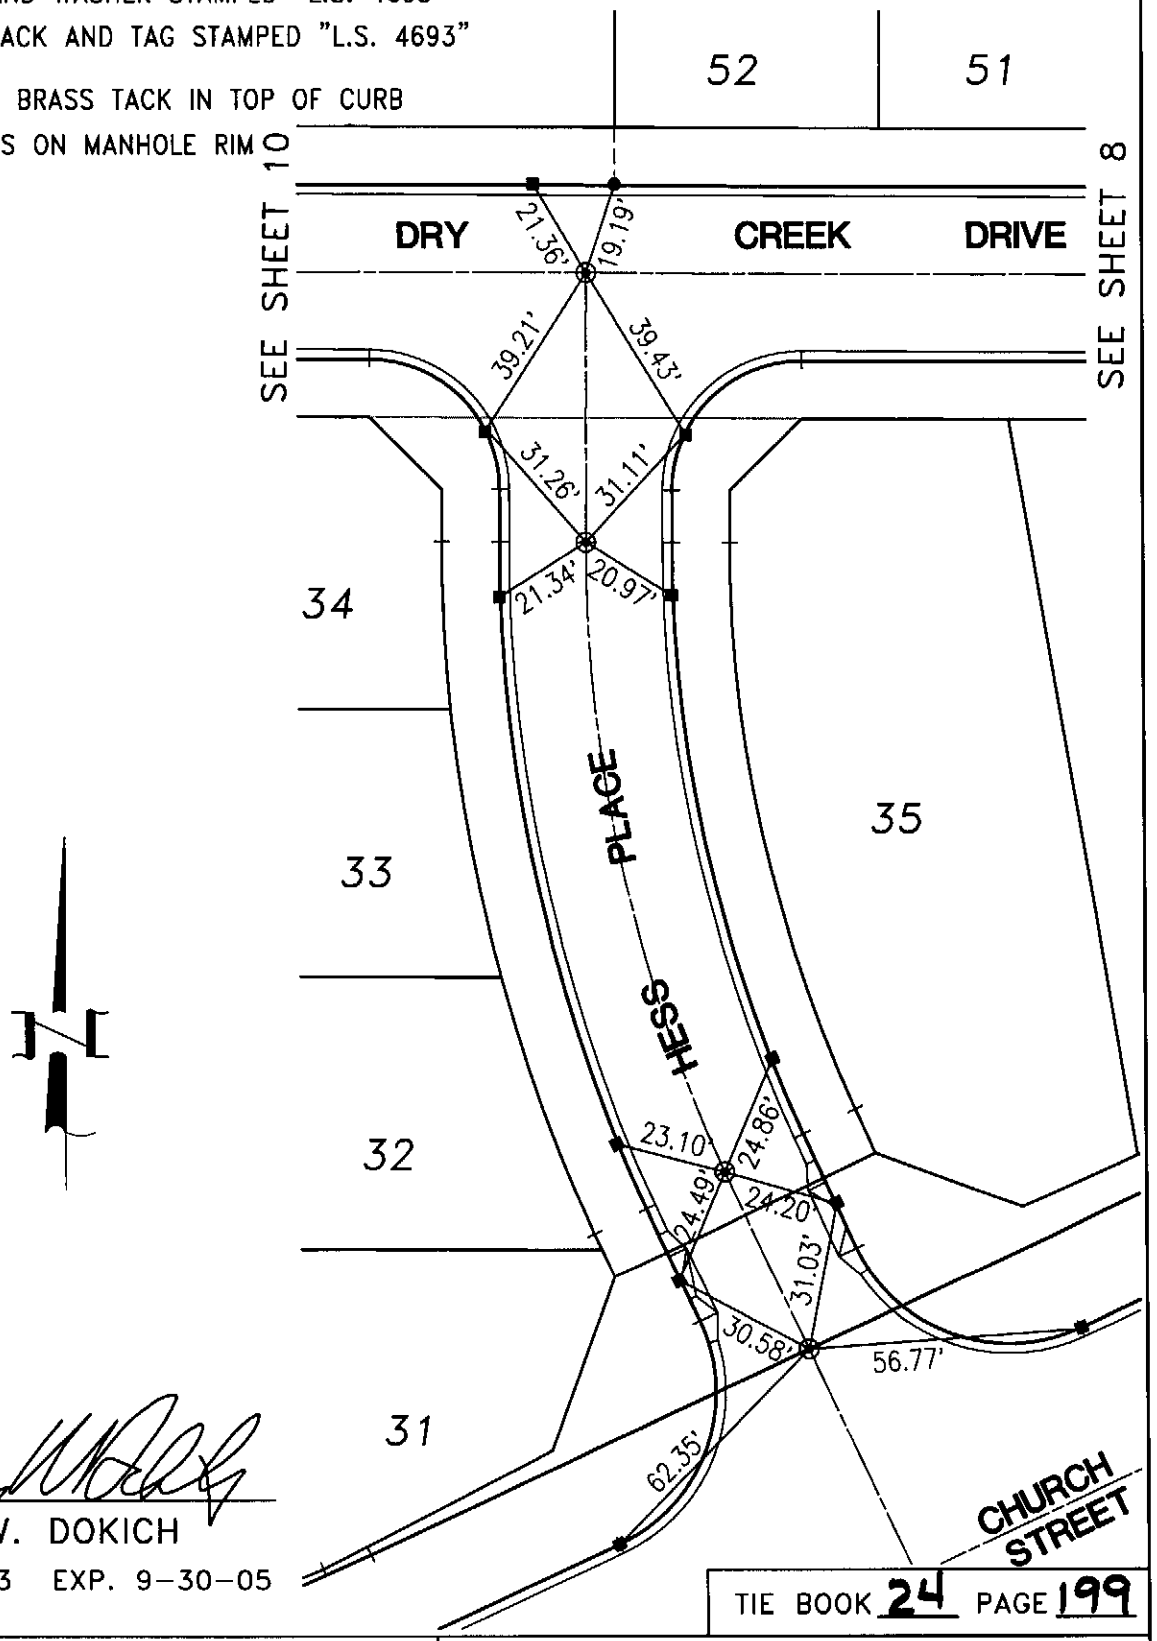

GARY W. DOKICH
L.S. 4693 EXP. 9-30-05

TIE BOOK 24 PAGE 199

CITY OF RANCHO CUCAMONGA
PUBLIC WORKS DEPARTMENT

MDS CONSULTING
MOSSE DOKICH SCHULTZ
17320 Redhill Ave. Suite 350 Irvine, CA 92614
Voice: 949-251-8821 FAX: 949-251-0814
PLANNERS ENGINEERS SURVEYORS

9 OF 10

CENTERLINE TIES – TRACT NO. 16312 | SCALE: 1"=40' | DATE: 06-29-05

I:\CENTIES\TR16312\16312-09.dwg 8/22/05

LEGEND :

- ⊙ INDICATES SPIKE AND WASHER STAMPED "L.S. 4693"
- ● INDICATES LEAD, TACK AND TAG STAMPED "L.S. 4693" IN TOP OF CURB
- ■ INDICATES LEAD & BRASS TACK IN TOP OF CURB
- ⊗ INDICATES 4 MARKS ON MANHOLE RIM

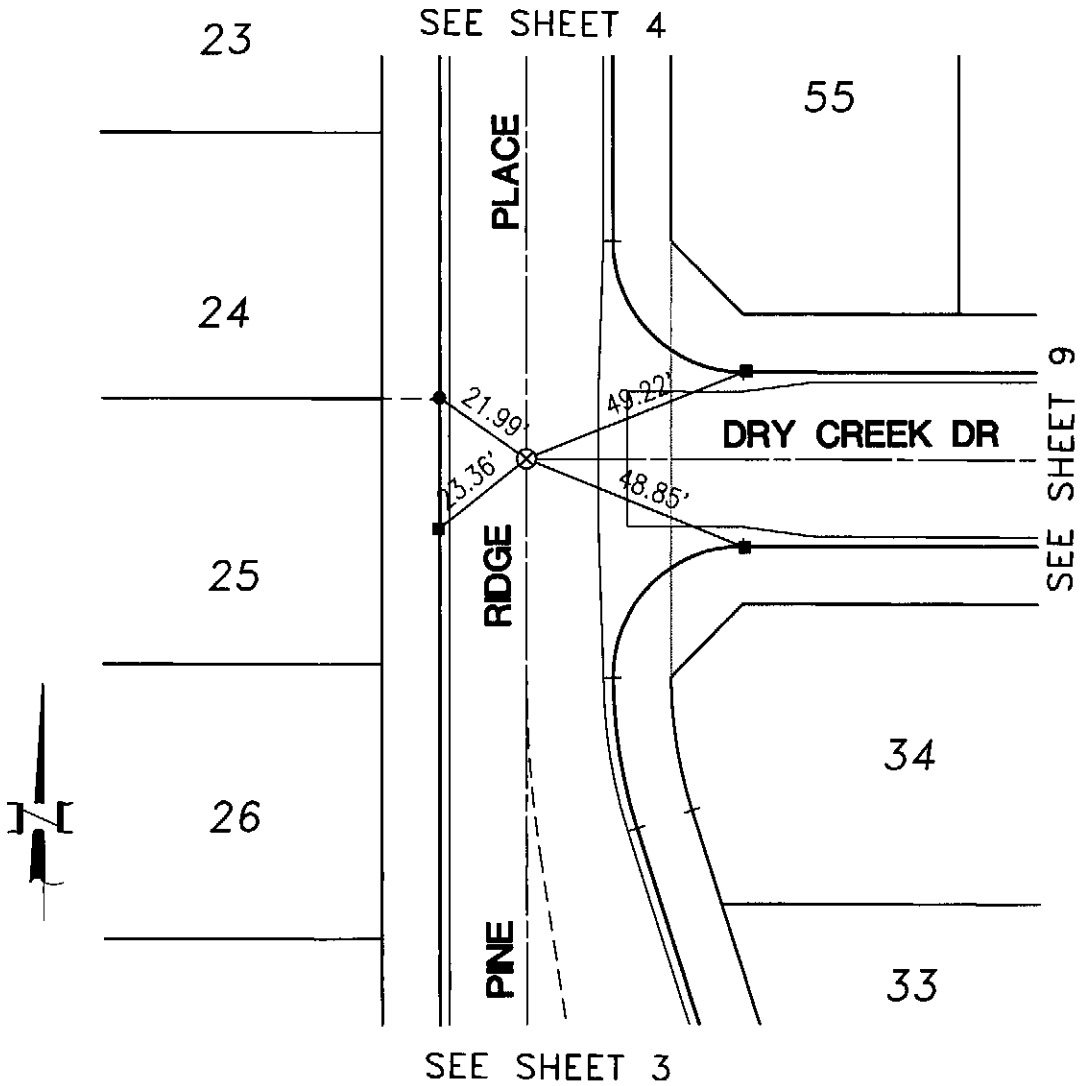

GARY W. DOKICH
L.S. 4693 EXP. 9-30-05

CITY OF RANCHO CUCAMONGA *PUBLIC WORKS DEPARTMENT*	MDS CONSULTING MOSS DOKICH SCHULTZ 17320 Redhill Ave. Suite 350 Irvine, CA 92614 Voice: 949-251-8821 FAX: 949-251-0514 PLANNERS ENGINEERS SURVEYORS	10 OF 10
CENTERLINE TIES – TRACT NO. 16312	SCALE: 1"=40'	DATE: 06-29-05

I:\CENTIES\TR16312\16312-10.dwg 8/22/05

BK 24 PG. 200